
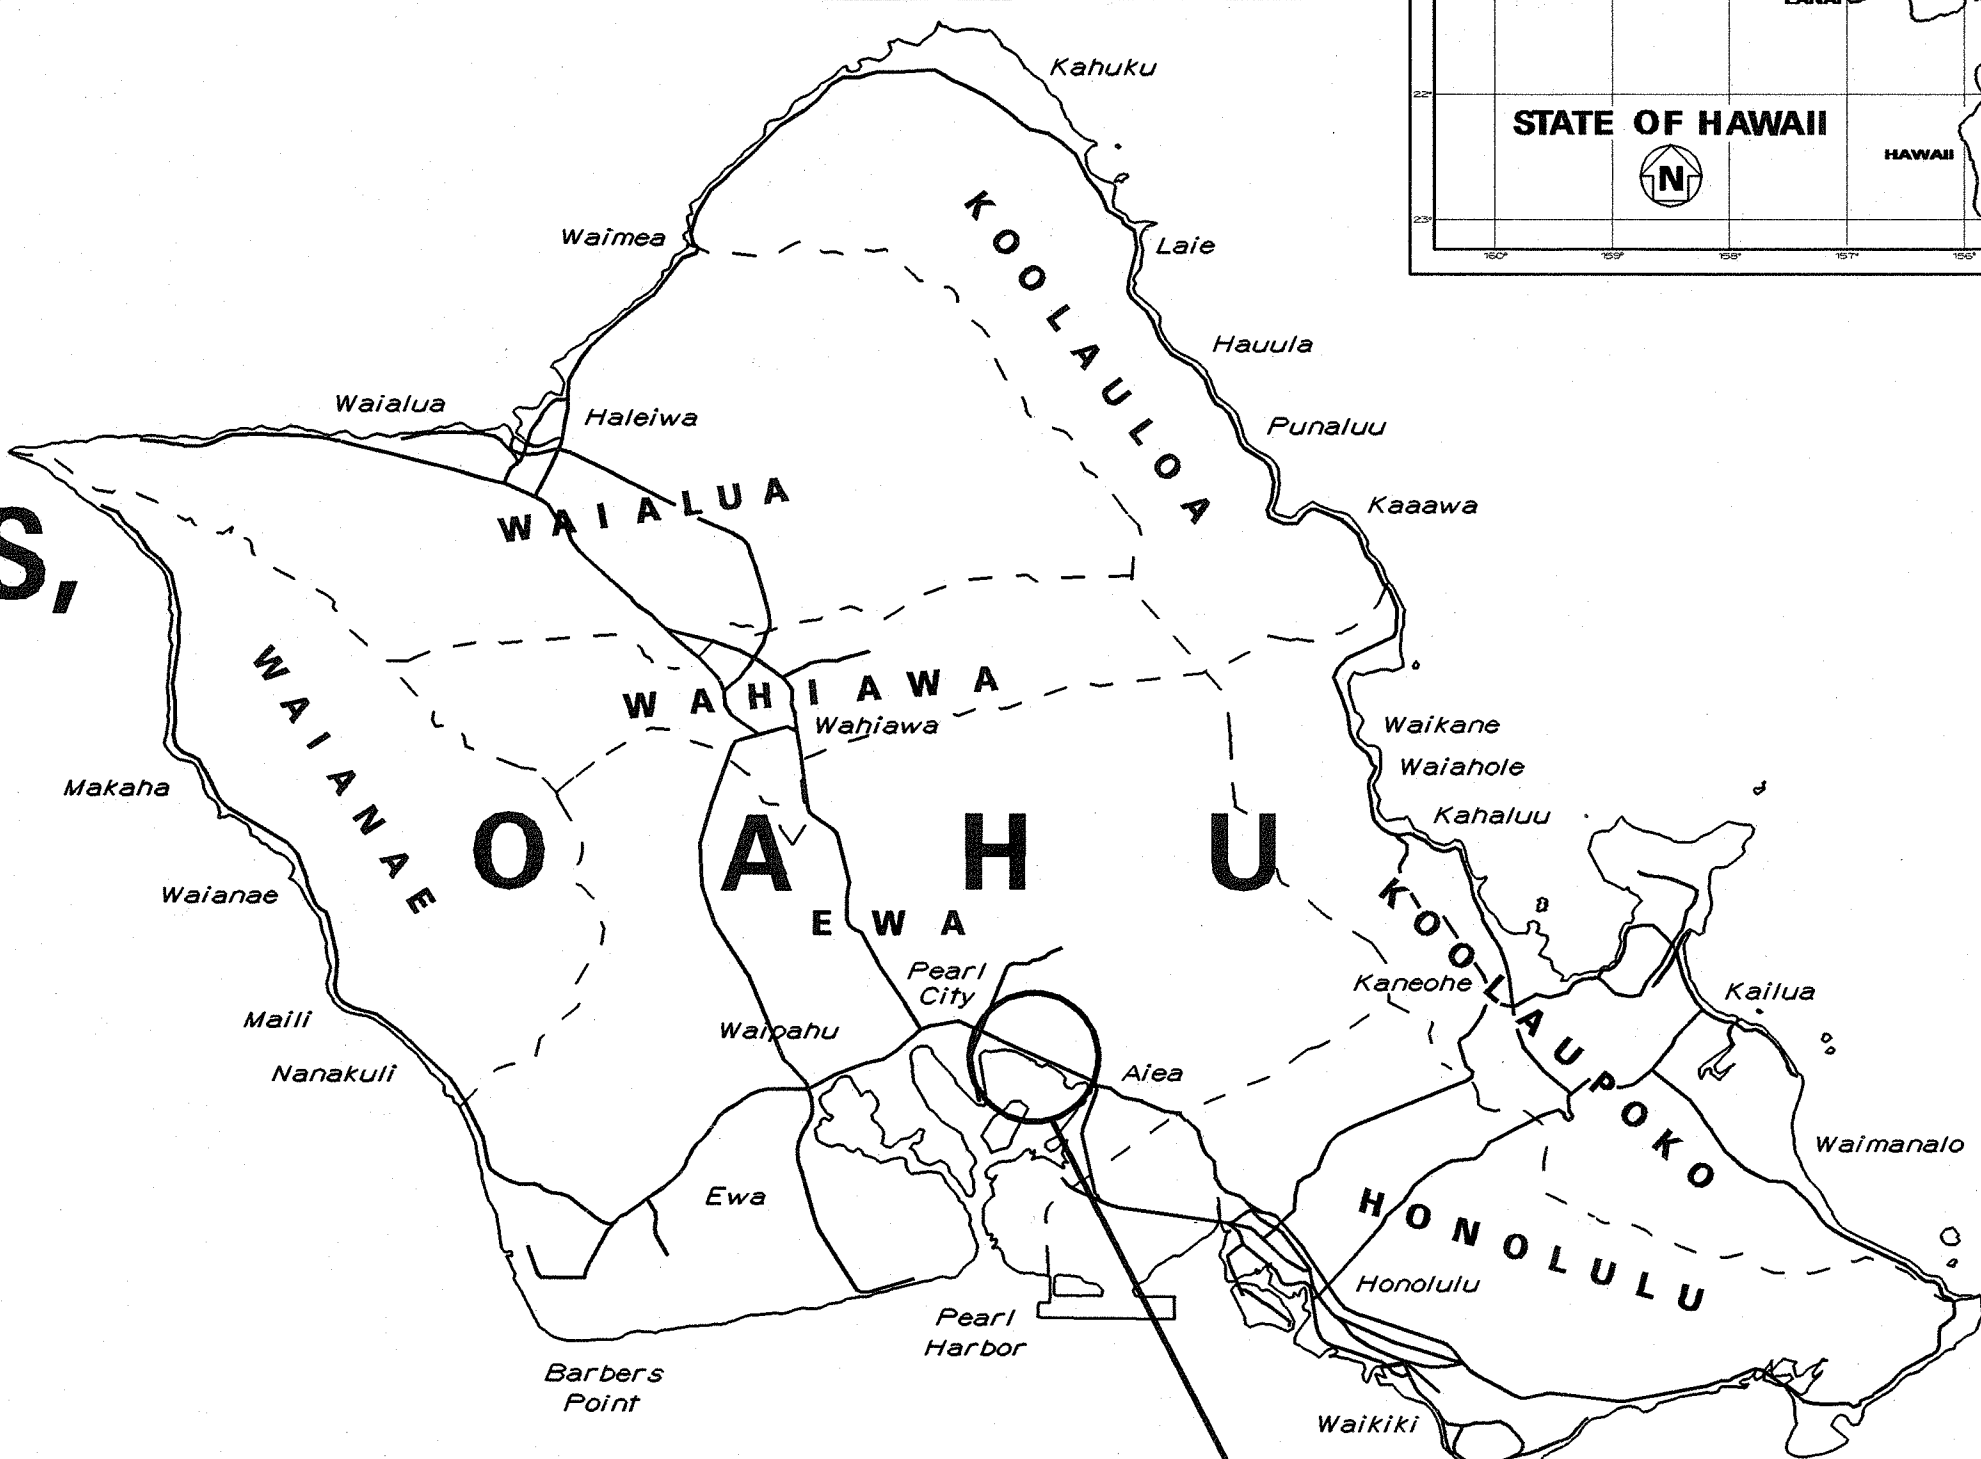
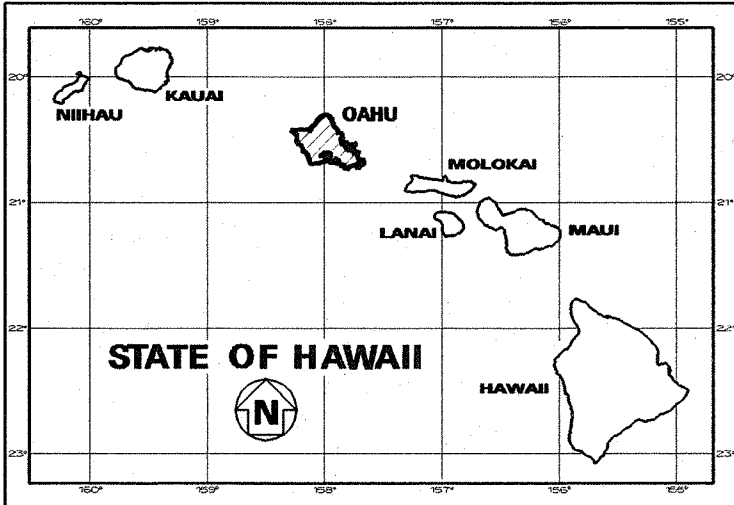


INDEX TO DRAWINGS	
SHEET NO.	DESCRIPTION
1	TITLE SHEET
2	STANDARD PLANS SUMMARY
3	NOTES
4 - 5	WATER POLLUTION AND EROSION CONTROL NOTES
	VICINITY OF PEARL CITY
6 - 7	DRAINAGE PLANS
8	DRAINAGE PROFILE
9 - 10	DRAINAGE DETAILS
	VICINITY OF AIEA
11	DRAINAGE PLAN
12 - 13	DRAINAGE DETAILS


STATE OF HAWAII
DEPARTMENT OF TRANSPORTATION
HIGHWAYS DIVISION
HONOLULU, HAWAII
"AS-BUILT" PLANS FOR
INTERSTATE ROUTE H-1,
MISCELLANEOUS DRAINAGE IMPROVEMENTS,
VICINITIES OF PEARL CITY AND AIEA
FEDERAL AID PROJECT NO. IM-H1-1(247)

DISTRICT OF EWA
ISLAND OF OAHU

FED. ROAD DIST. NO.	STATE	FED. AID PROJ. NO.	FISCAL YEAR	SHEET NO.	TOTAL SHEETS
HAWAII	HAW.	IM-H1-1(247)	2005	1	13

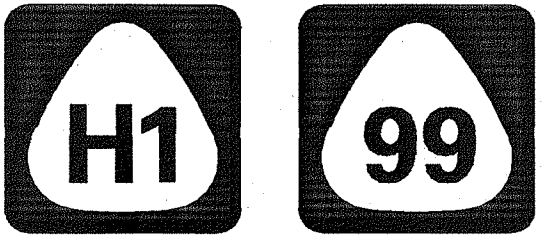


LOCATION OF PROJECT

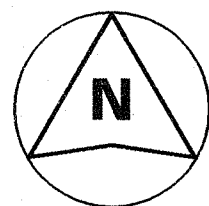

SCALE IN MILES

ROUTE H-1: MILE POST 10.92
ROUTE 99: MILE POST 20.70

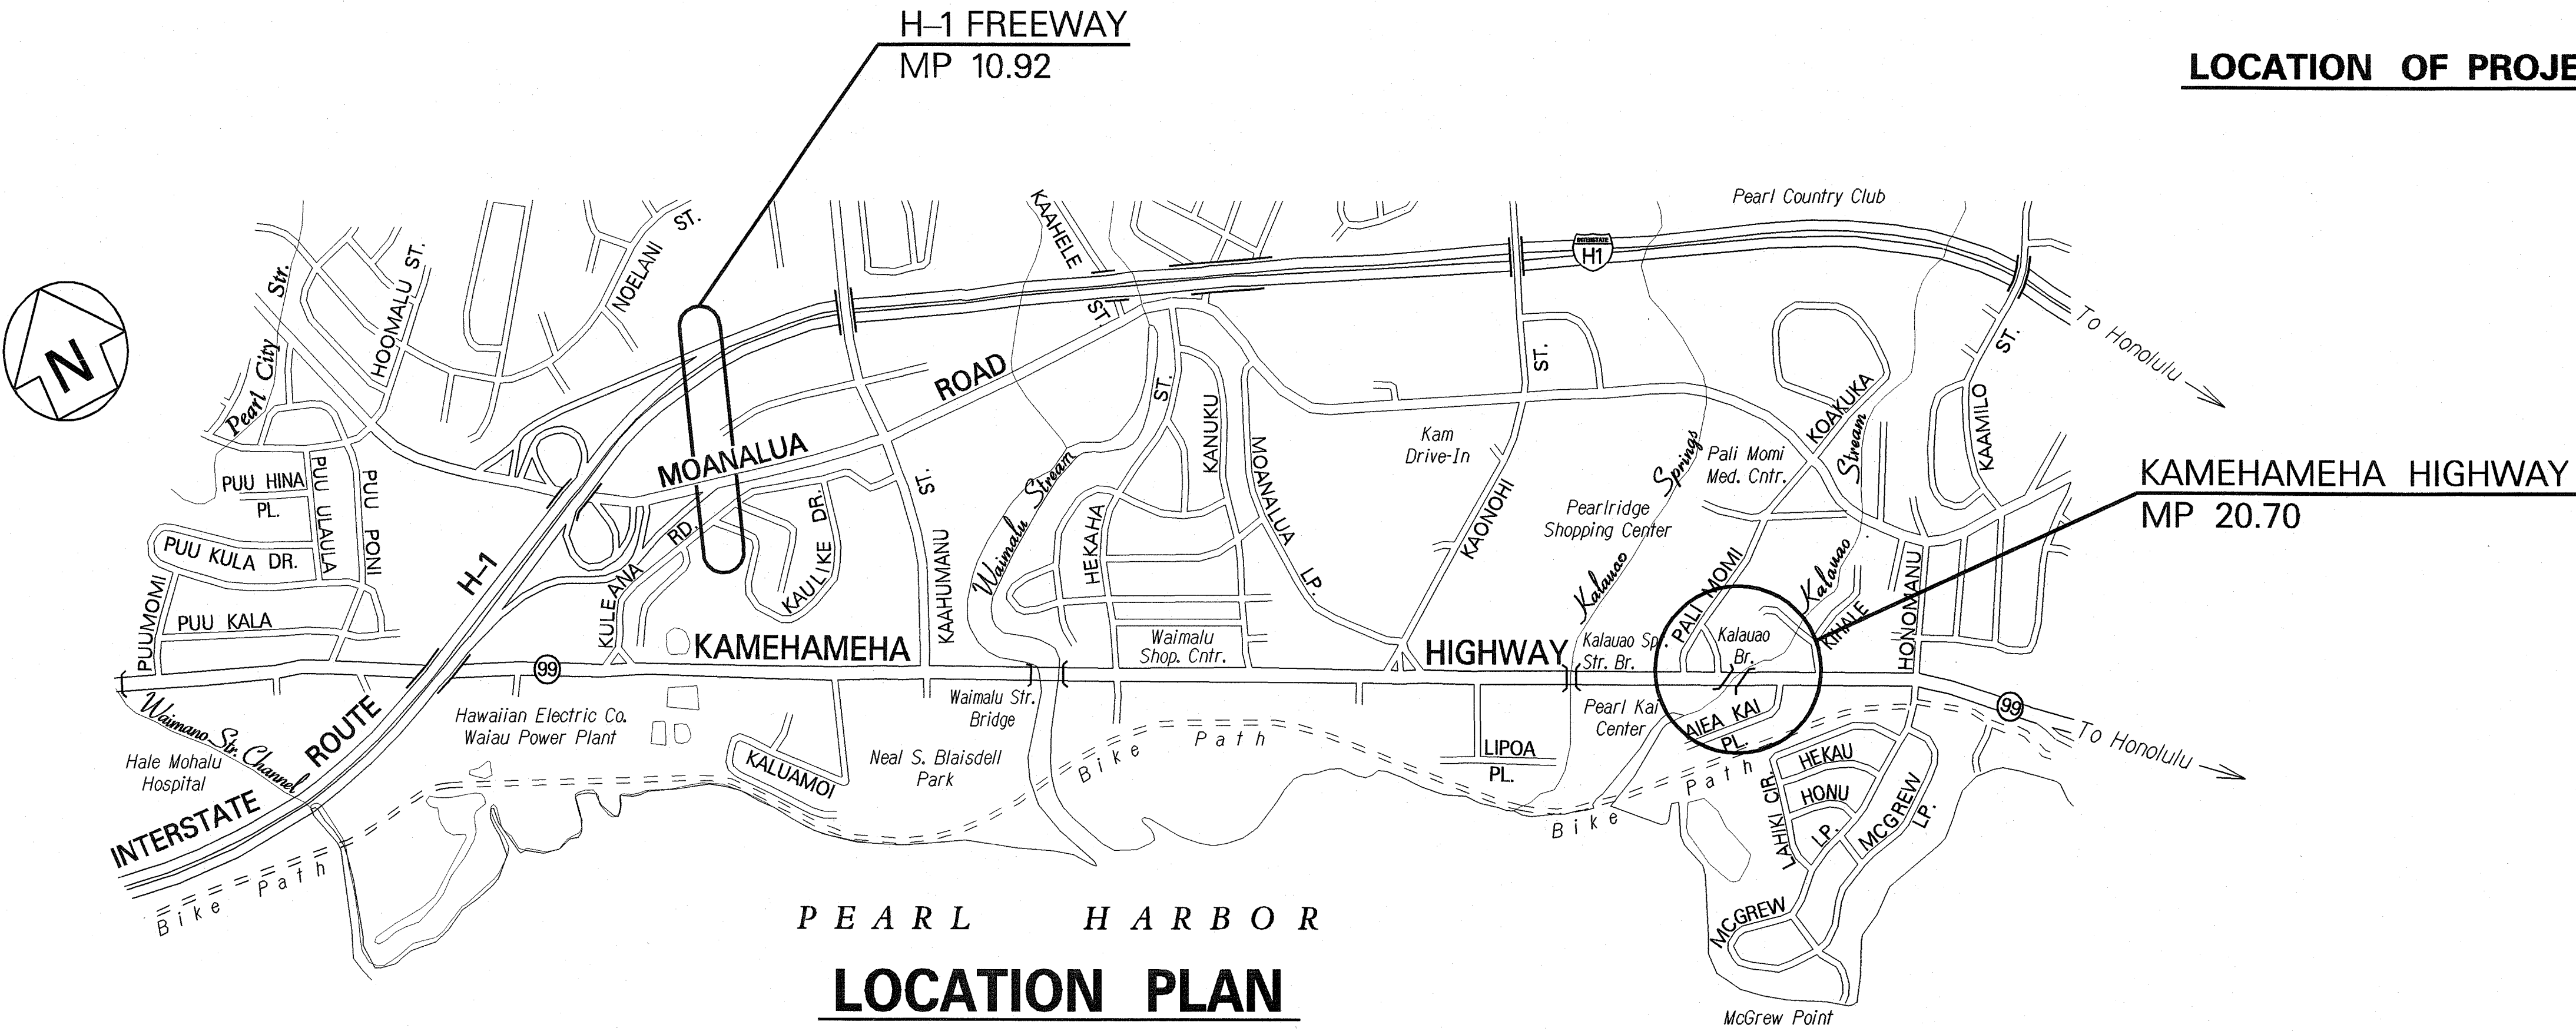

PEARL HARBOR
LOCATION PLAN



SCALE IN THOUSAND FEET

CHANGES MADE DURING CONSTRUCTION HAVE BEEN
INCORPORATED ON THESE PLANS EXCEPT CHANGES
IN THE ORIGINAL THEORETICAL QUANTITIES. FOR
ACTUAL QUANTITIES, REFER TO PROJECT LEDGER
AND/OR COMPUTATION BOOK.

RESIDENT ENGINEER
DATE

DEPARTMENT OF TRANSPORTATION
STATE OF HAWAII
APPROVED:
f. DIR. OF TRANSPORTATION
DATE

HWY-DH
P.S. & E. BY
DESIGNED BY
HWY-D
692-7561
AUG. 2004
PHONE
DATE