




FED. ROAD DIST. NO.	STATE	FED. AID PROJ. NO.	FISCAL YEAR	SHEET NO.	TOTAL SHEETS
HAWAII	HAW.	I-H2-1(8)-6	1973	120	160

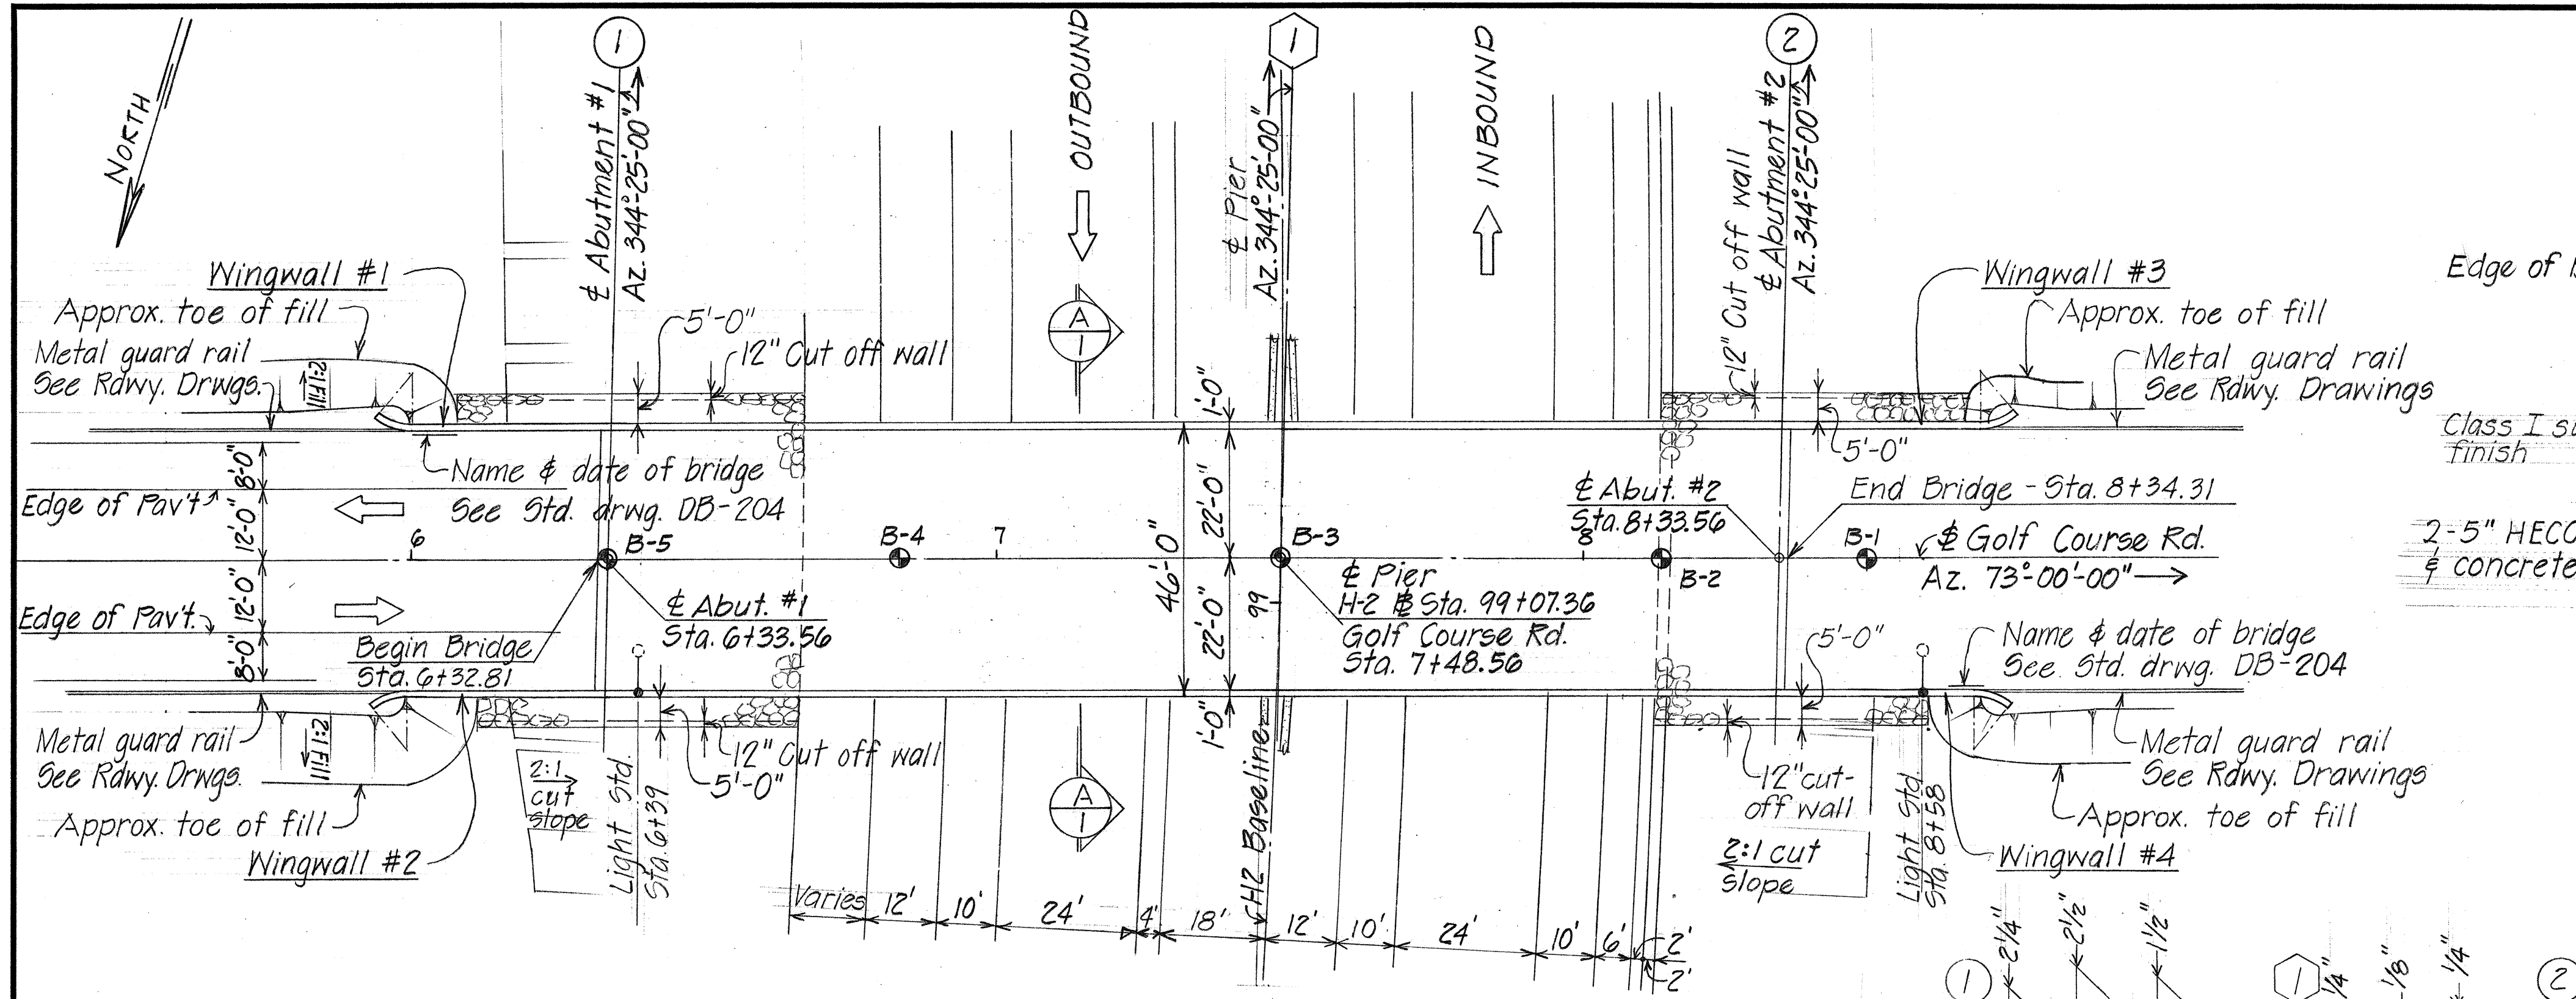


LAYOUT PLAN
SCALE 1"=20'-0"

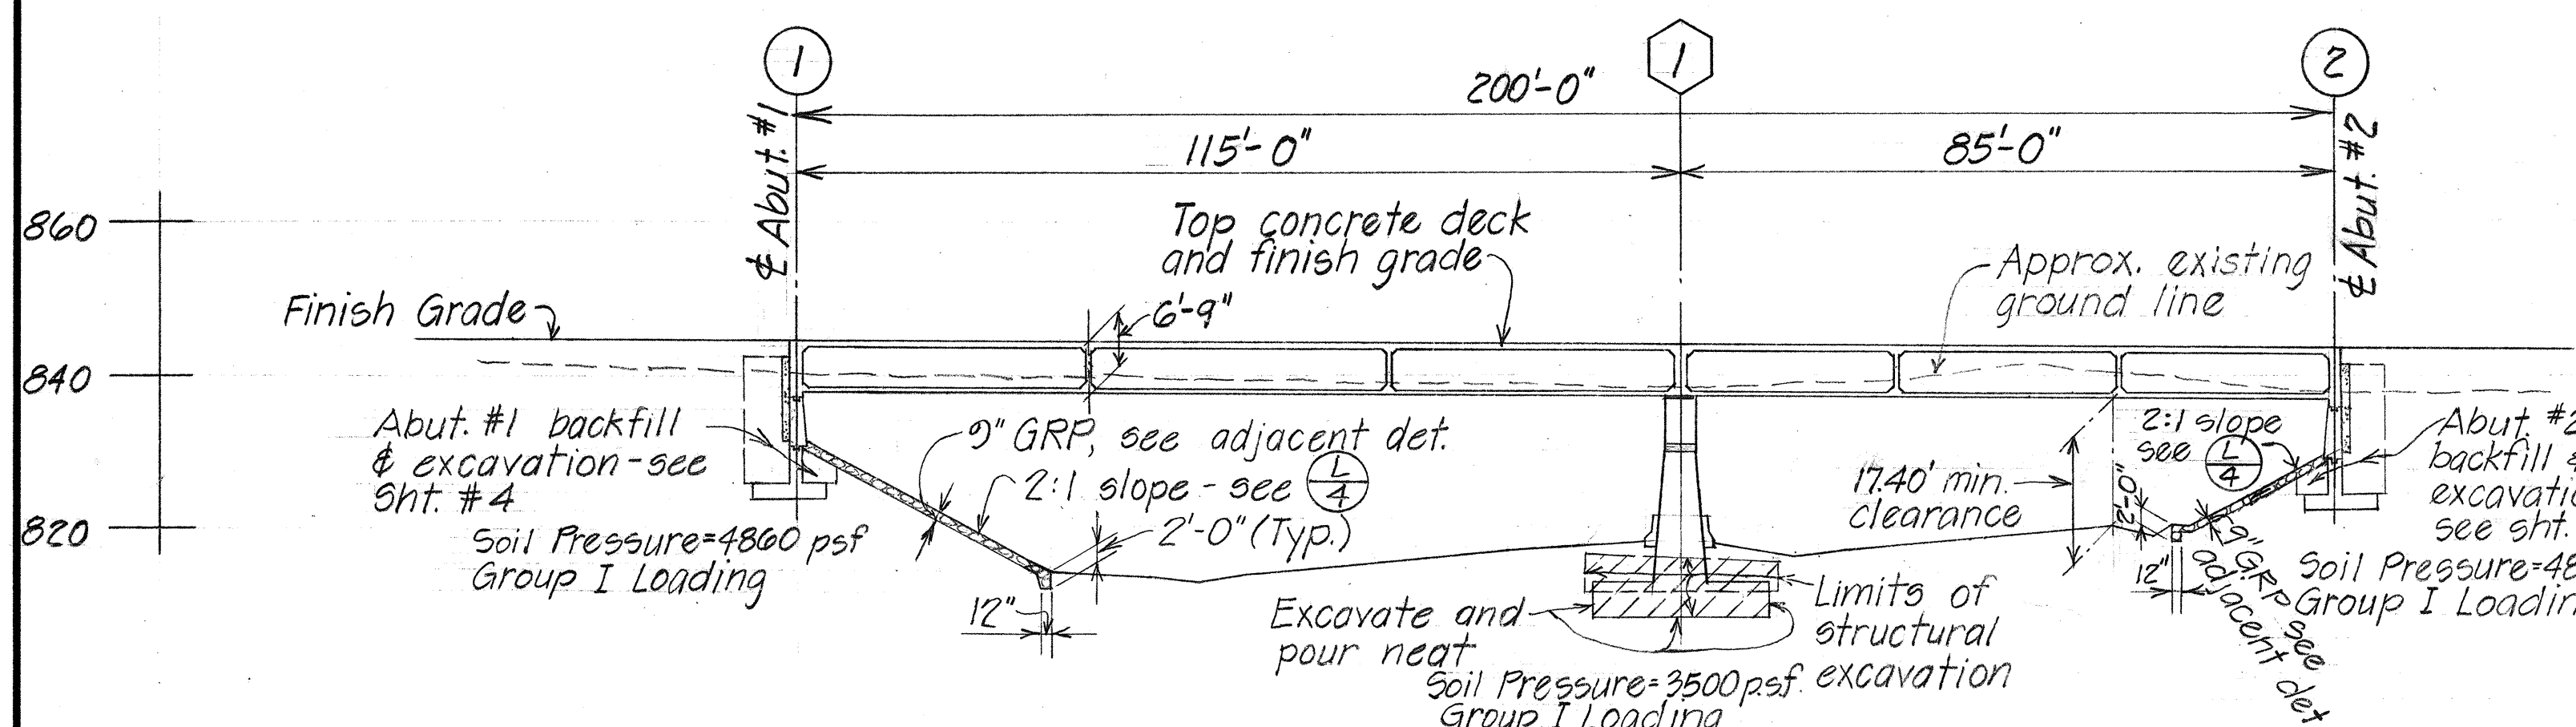


LONGITUDINAL SECTION ALONG GOLF COURSE ROAD
Scale: 1"=20'-0"

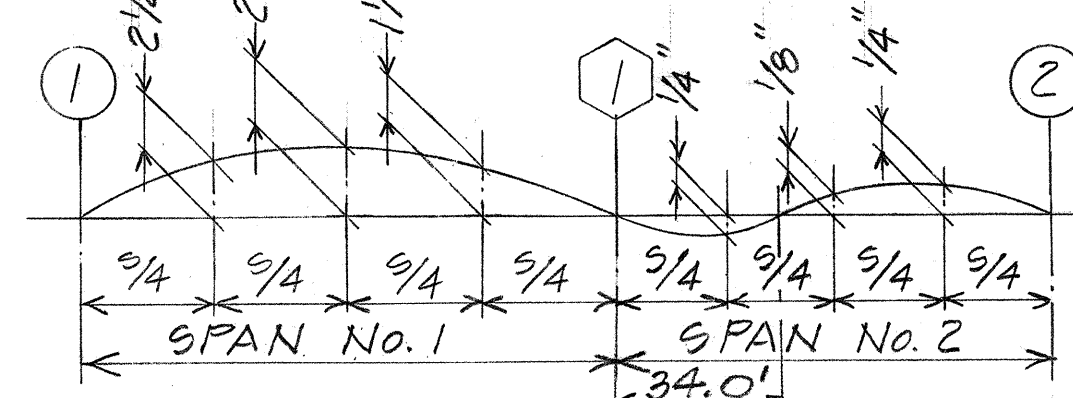


SLAB CAMBER DIAGRAM
Not to Scale

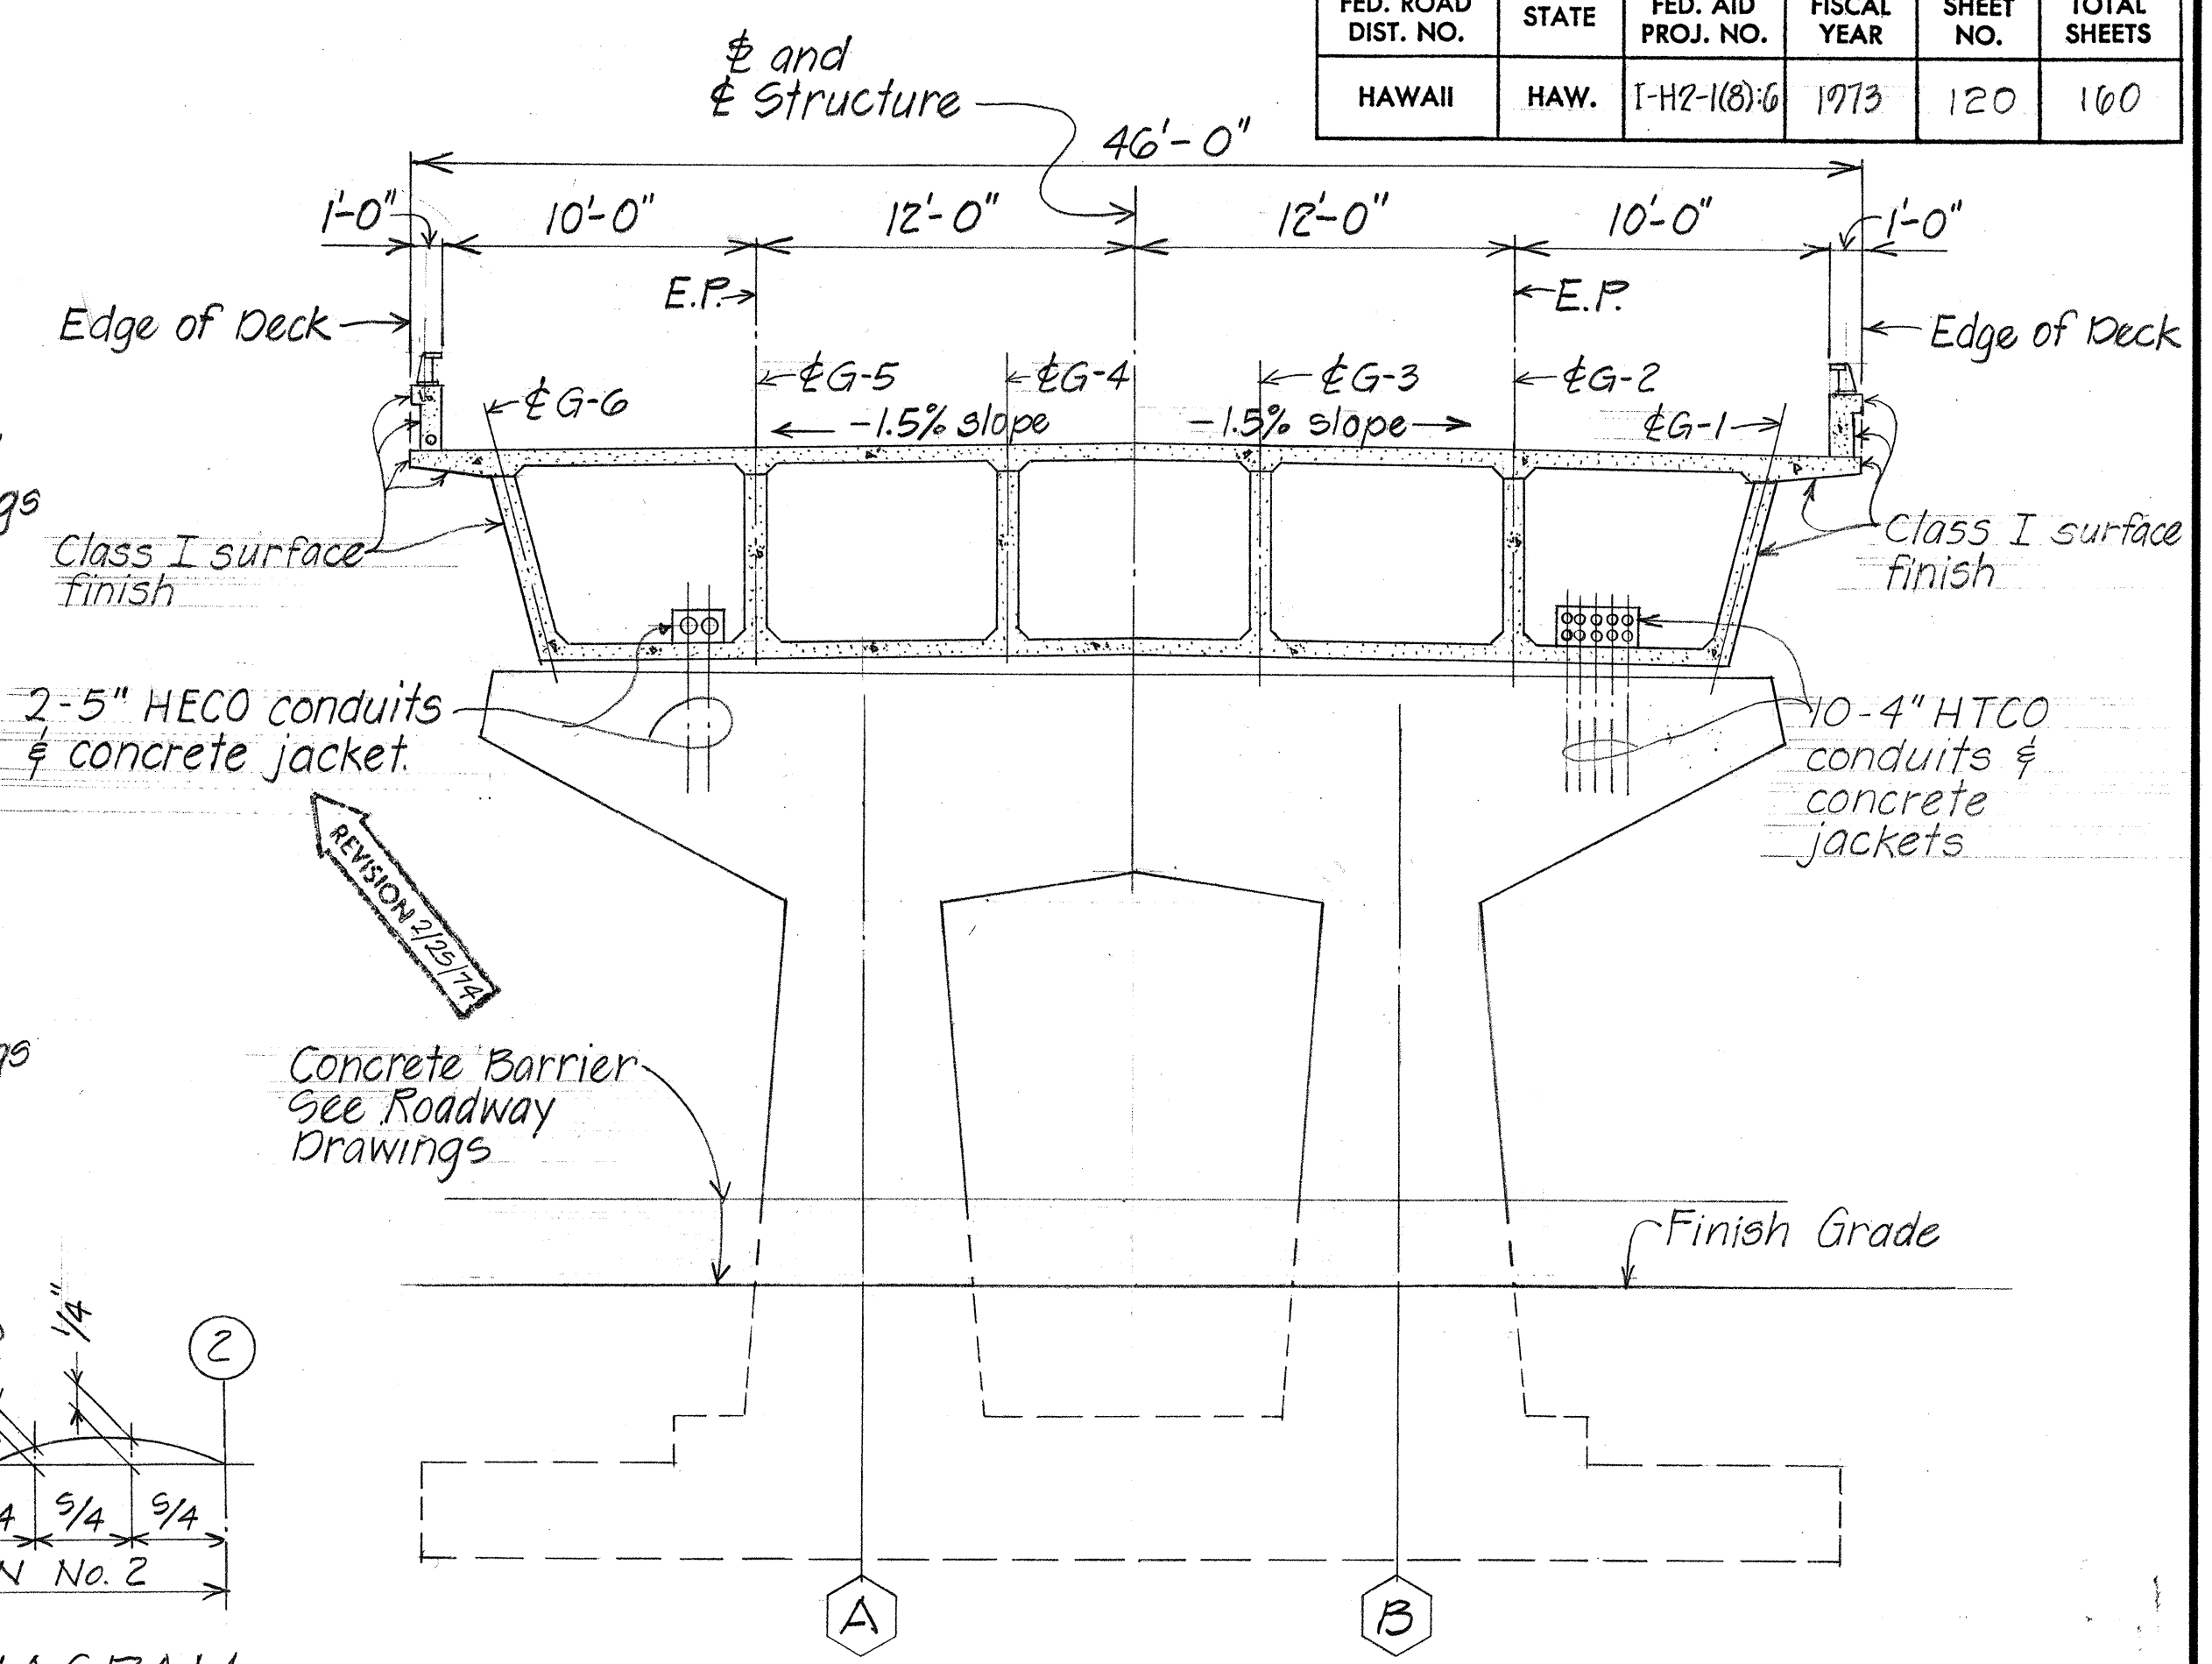

NORMAL SECTION
Scale: 3/16"=1'-0"

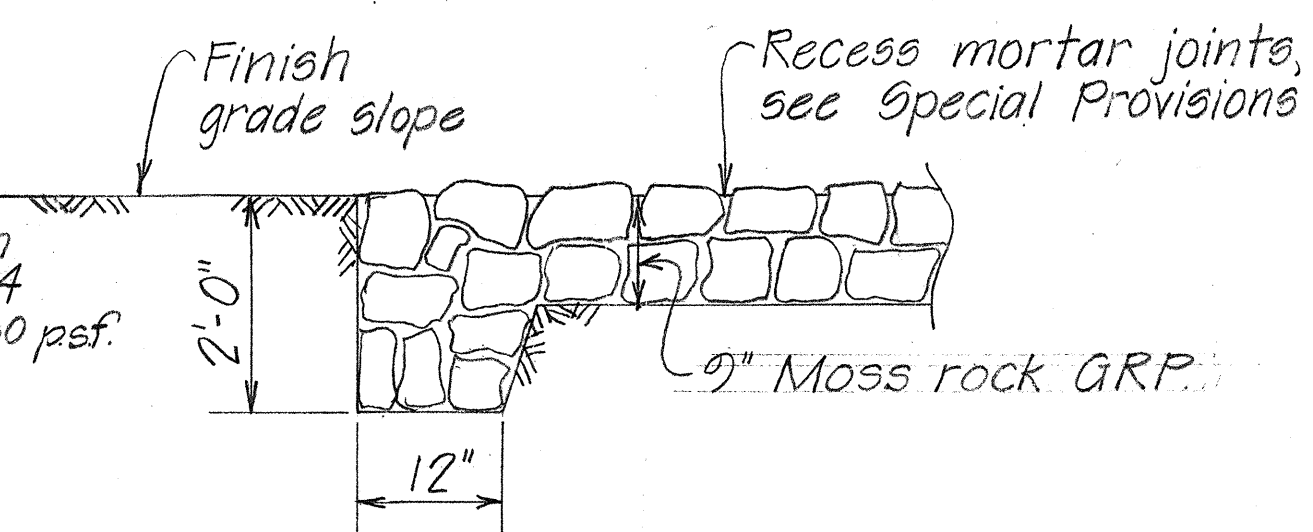


TYPICAL GRP CUT OFF WALL DETAIL
Scale: 3/4"=1'-0"

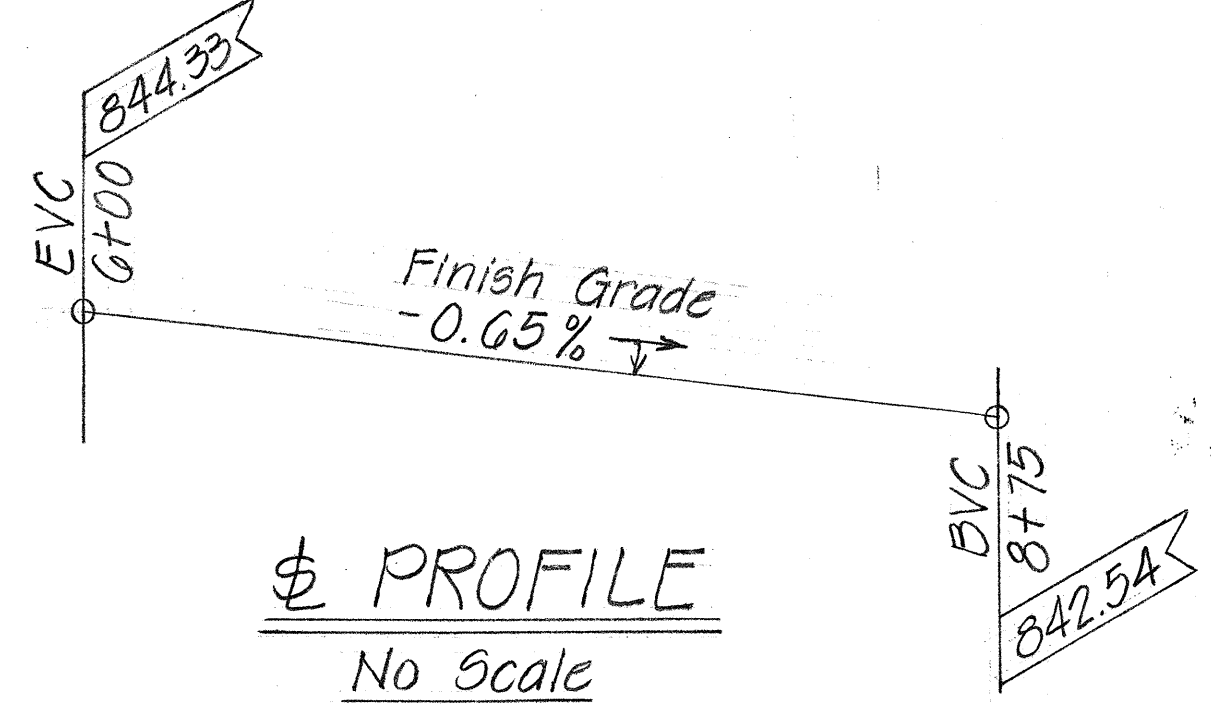

E PROFILE
No Scale

REFERENCE NOTES

1. For Design and General Notes, refer to Sht. #5
2. For Logs of Borings, refer to Sht. #6

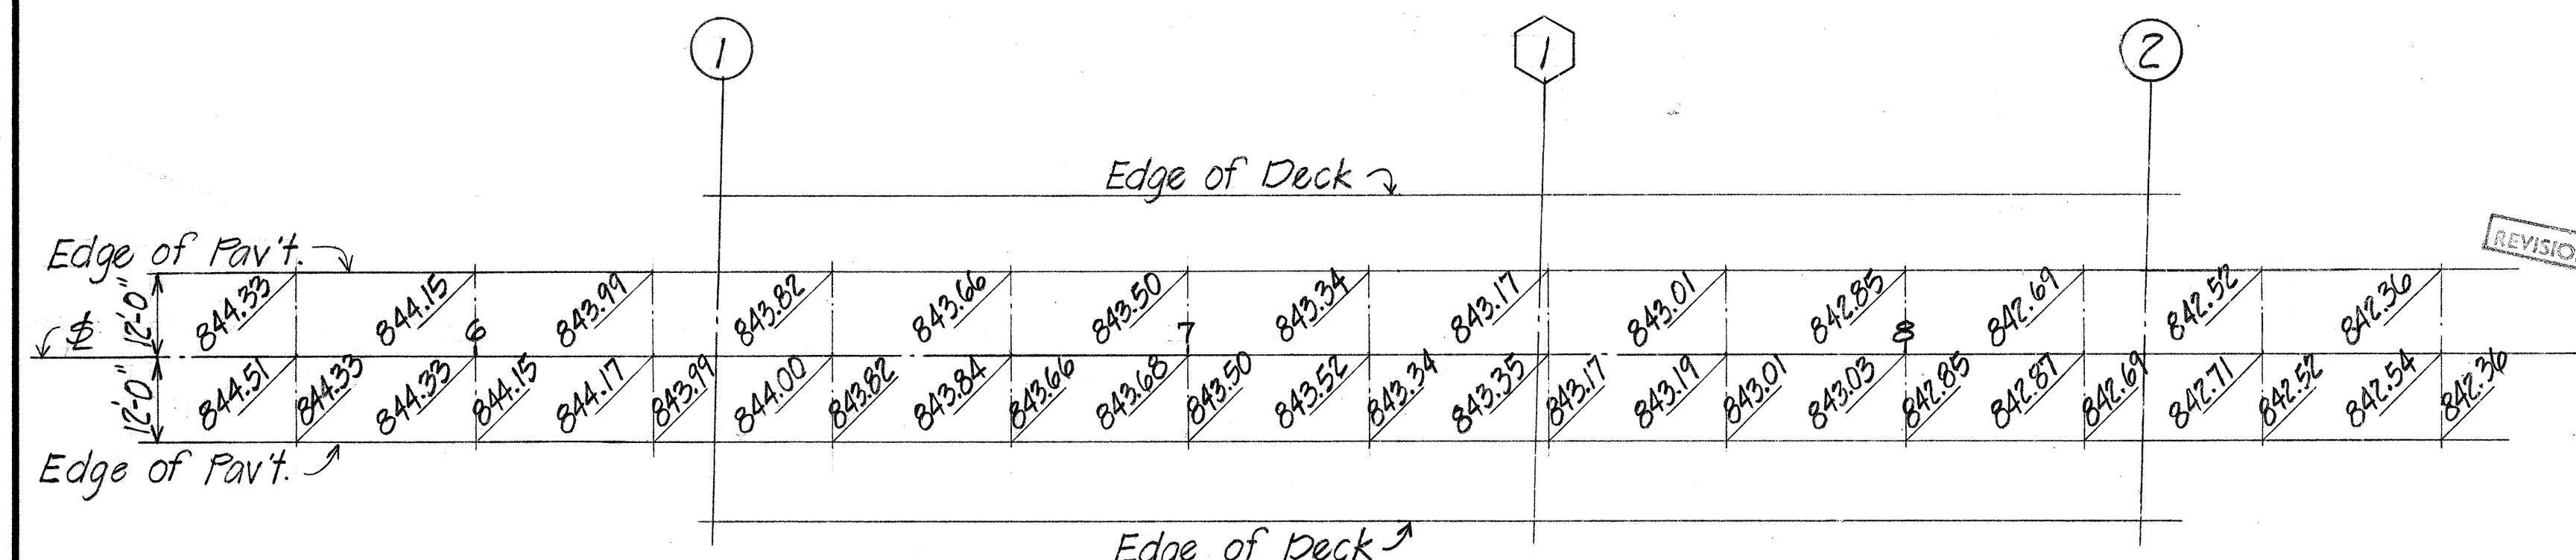

FINISH GRADE PLAN
SCALE 1"=20'-0"


ESTIMATED QUANTITIES		
Concrete - Footing	(274.0 C.Y.)	Lump Sum
Concrete - All Others	(855.0 C.Y.) (844.0 C.Y.)	Lump Sum
Reinforcing Steel	(304,750 Lbs.)	Lump Sum
Steel Bridge Railing (One Rail Tubular)	527	L.F.
Concrete Bridge Railing - Including End Posts	564	L.F.
Structure Excavation	848	C.Y.
Structure Backfill (Abutments & Wingwalls)	600	C.Y.
Filter Material	62	C.Y.
Moss Rock Grouted Rubble Paving (GRP)	114	C.Y.

2/25/74	Add -2 HECO conduits & conc. jacket between G-5 - G-6
Date	Revision


STATE OF HAWAII
DEPARTMENT OF TRANSPORTATION
HIGHWAYS DIVISION
GOLF COURSE SEPARATION
STA. 6+32.81 TO STA. 8+34.31
LAYOUT PLAN AND DETAILS
Leilehua Interchange
F.A.I. Proj. No. I-H2-1(8)-6 January, 1973
SHEET No. 1 OF 20 SHEETS

SURVEYED BY	DATE
DESIGNED BY	3/73
CHECKED BY	3/73
NOTED BY	3/73
QUANTITIES BY	3/73
CHECKED BY	3/73


FED. ROAD DIST. NO.	STATE	FED. AID PROJ. NO.	FISCAL YEAR	SHEET NO.	TOTAL SHEETS
HAWAII	HAW.	I-H2-1(8)-6	1973	121	140

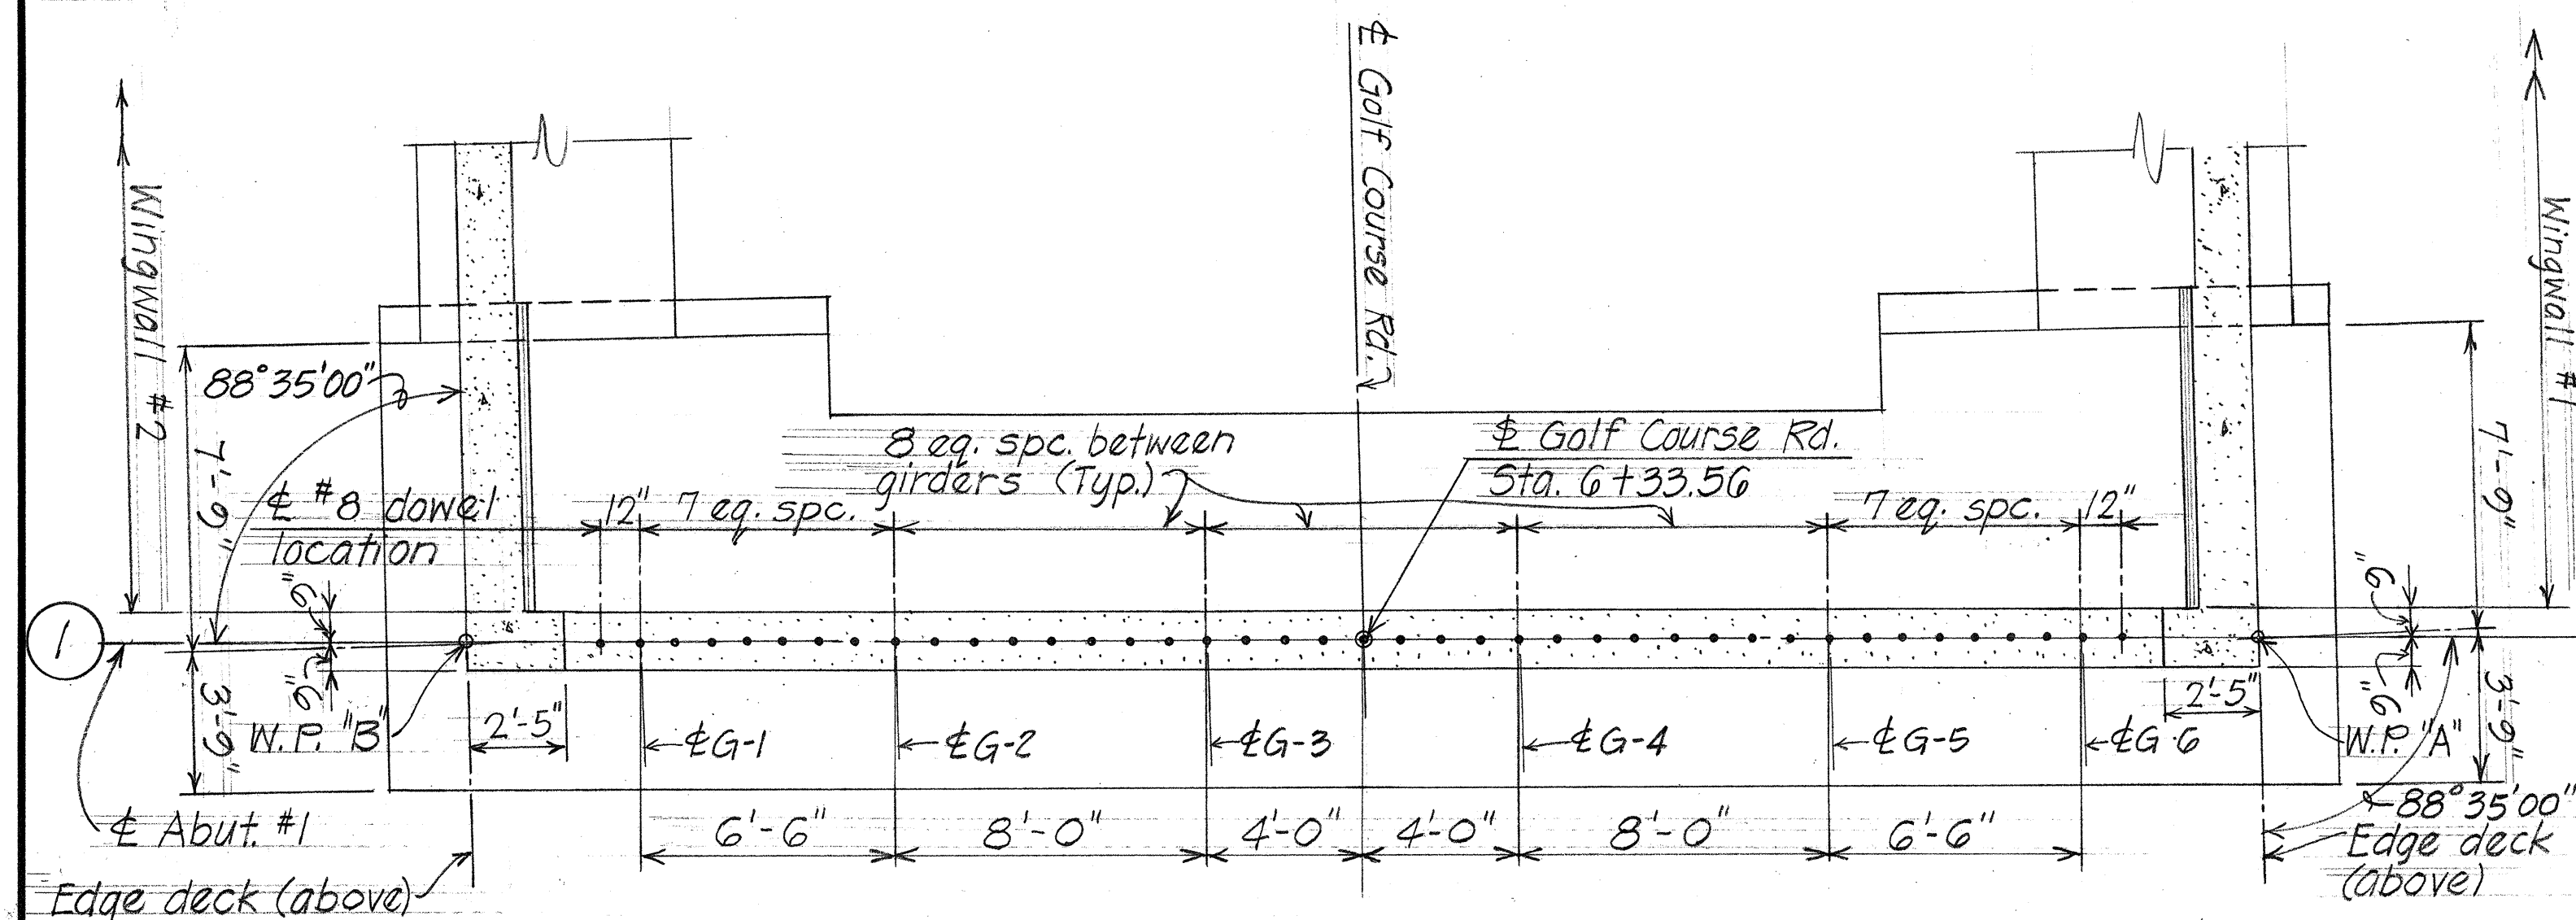


PLAN-TOP OF ABUTMENT WALL LEVEL - ABUTMENT #1
Scale: 1/4" = 1'-0"

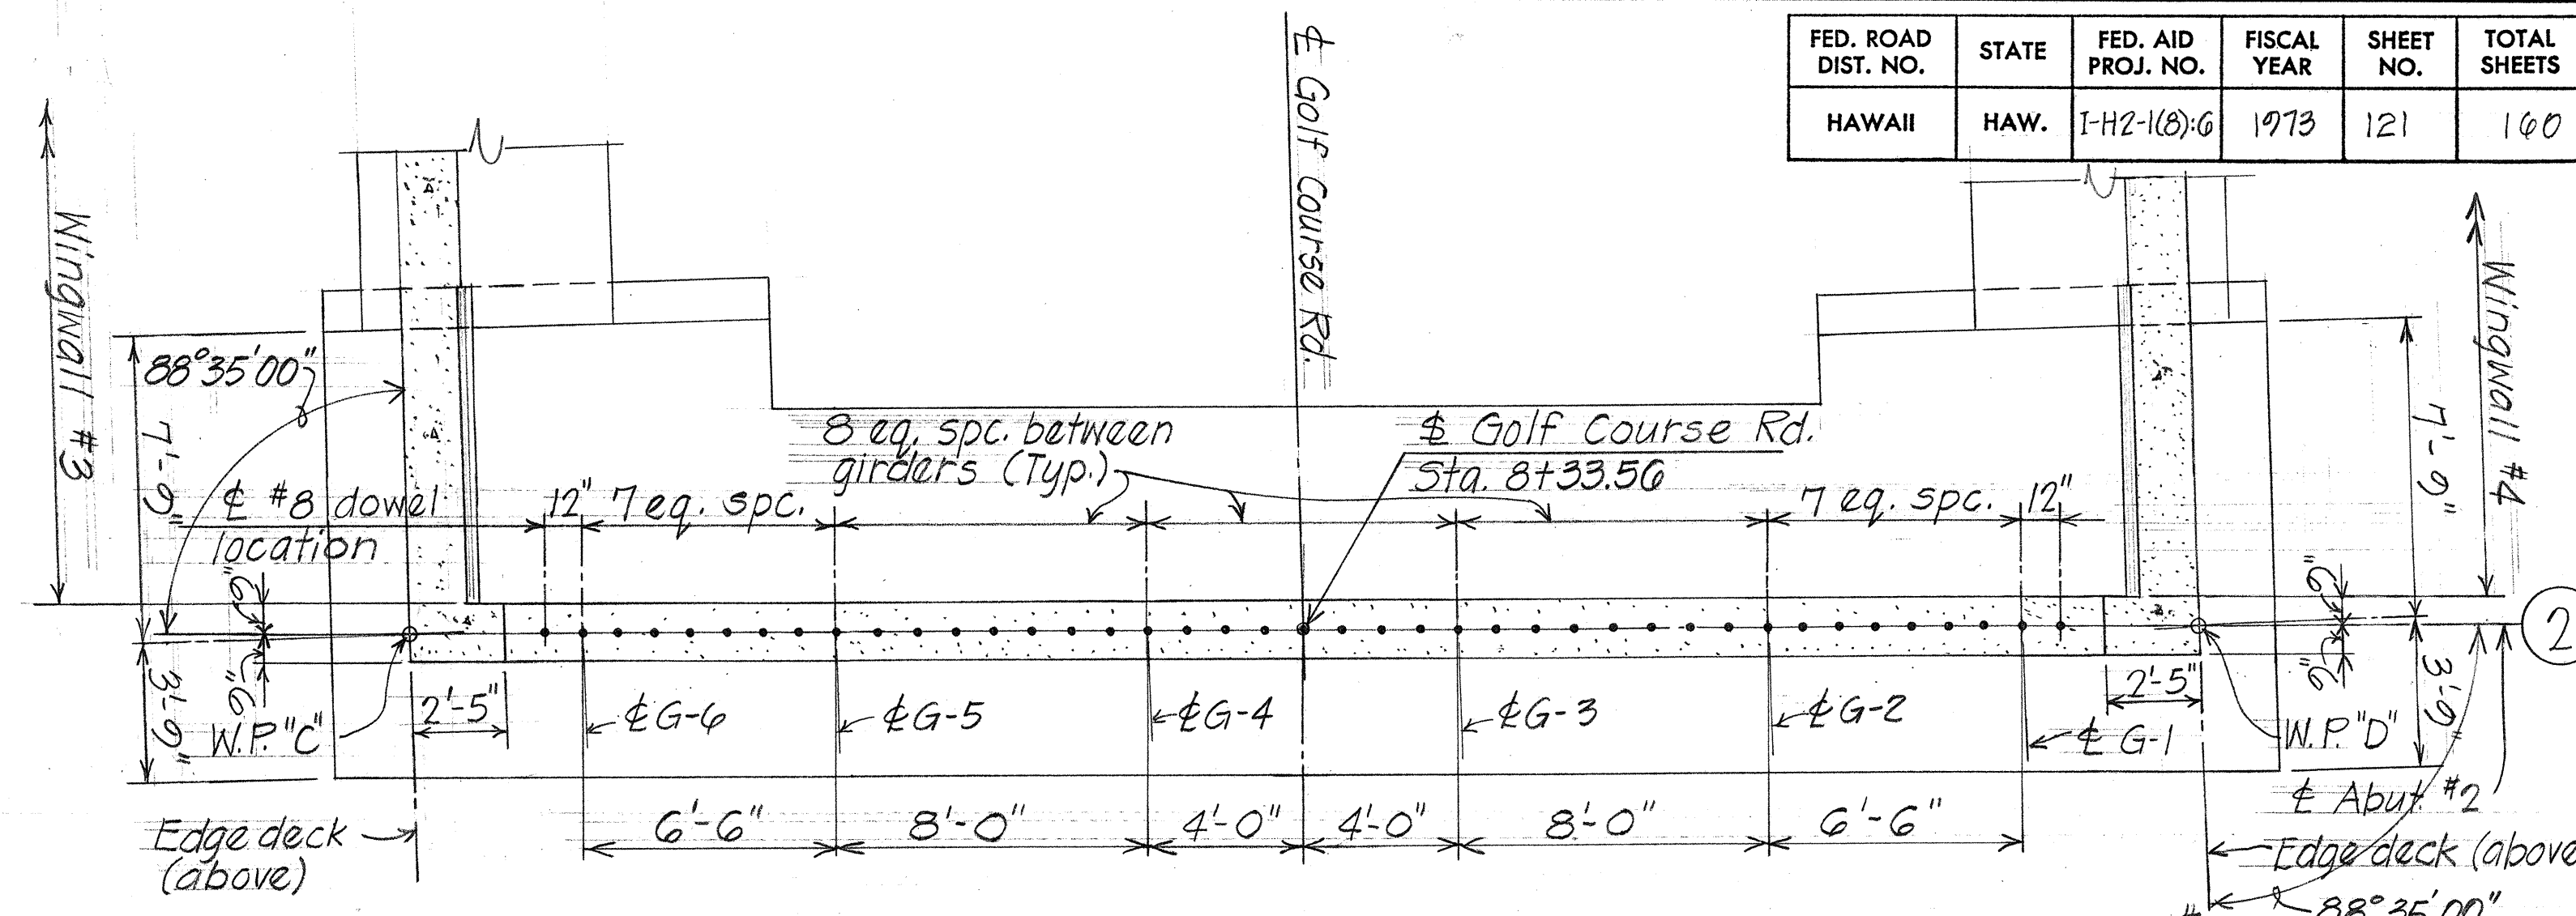

PLAN-TOP ABUTMENT WALL LEVEL - ABUTMENT #2
Scale: 1/4" = 1'-0"

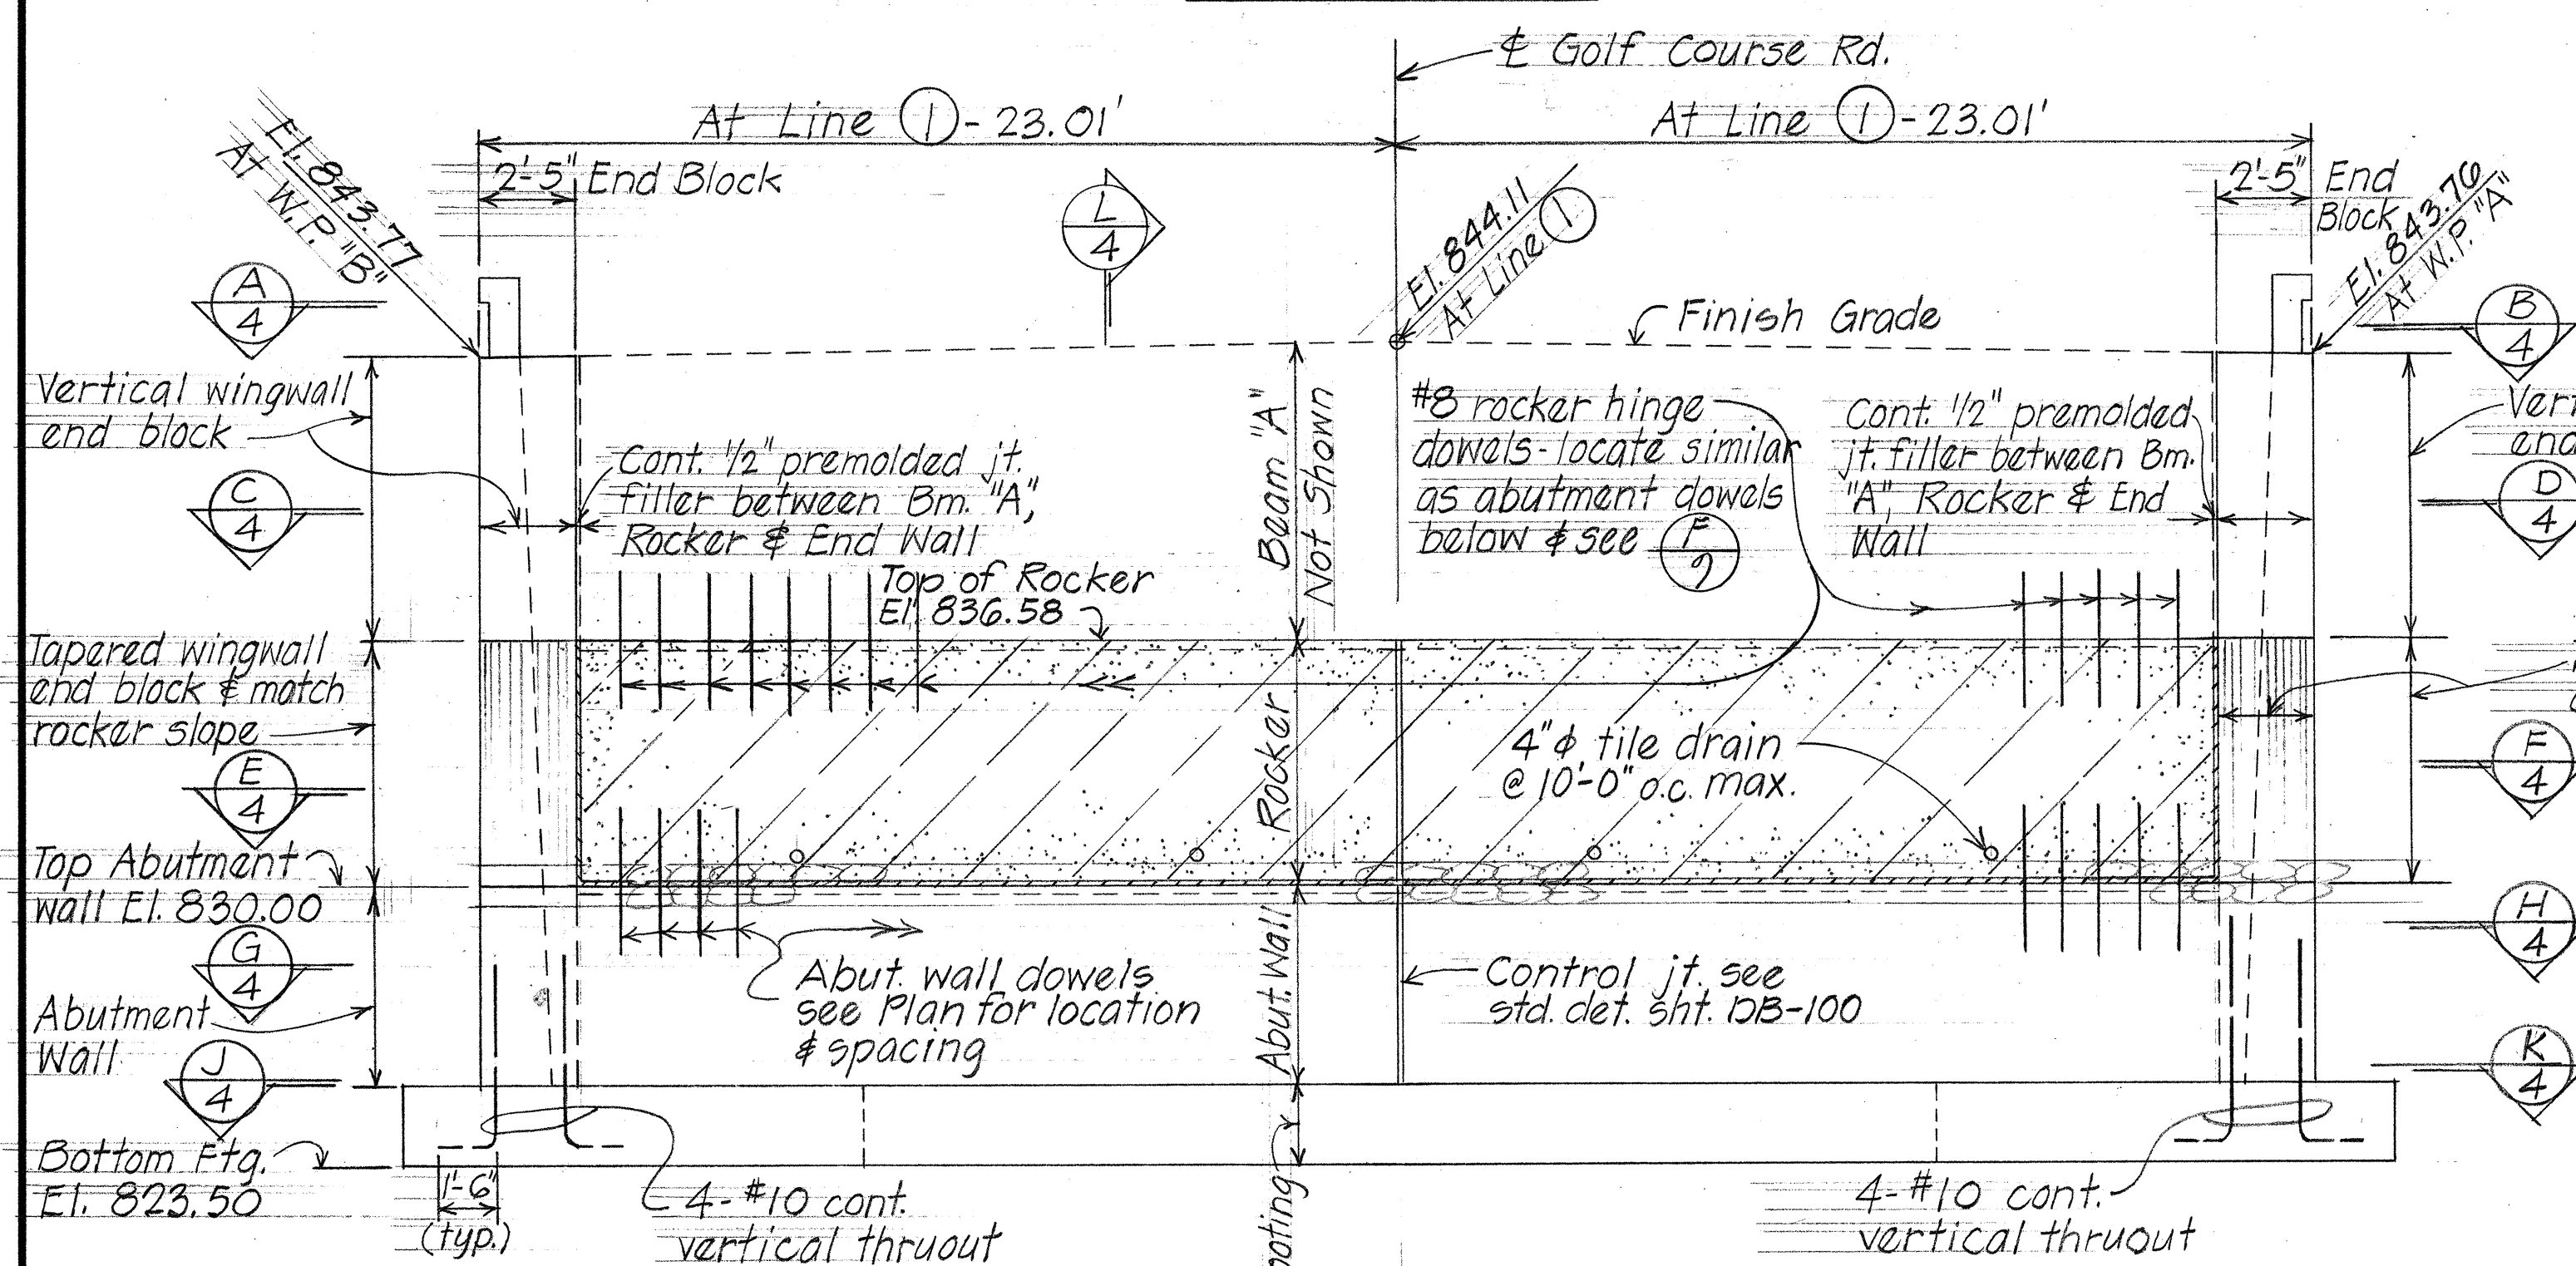

ELEVATION - ABUTMENT No. 1
Scale: 1/4" = 1'-0"

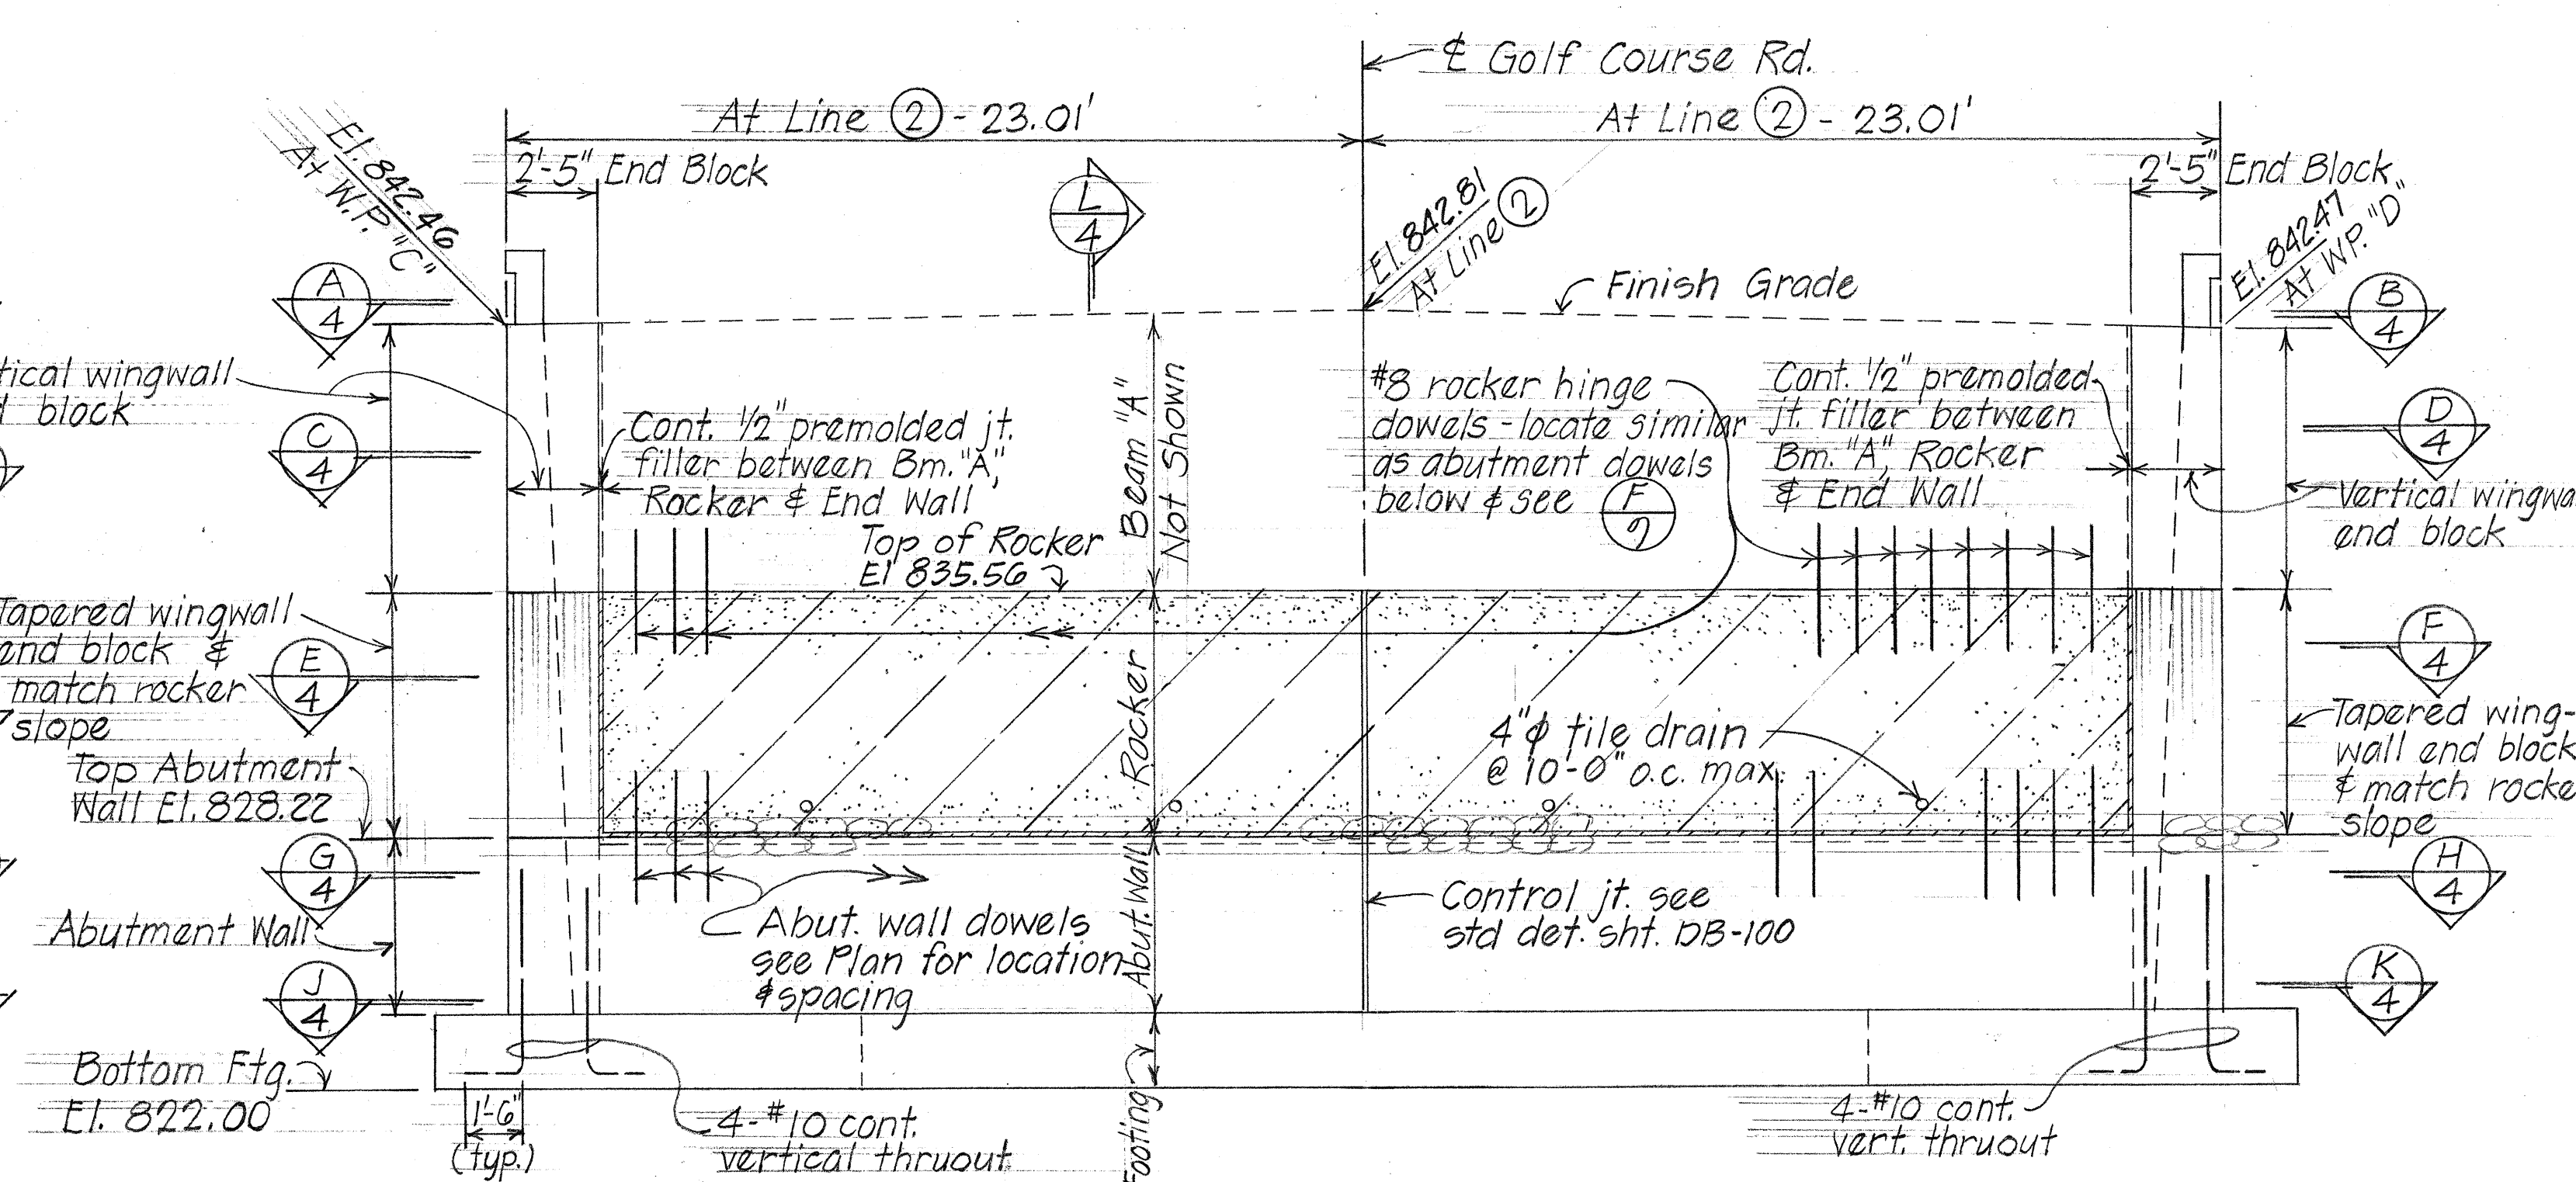


ELEVATION - ABUTMENT No. 2
Scale: 1/4" = 1'-0"


ORIGINAL PLAN	DATE
DESIGNED BY	3/73
CHECKED BY	3/73
NOTED BY	3/73
NO.	

STATE OF HAWAII
DEPARTMENT OF TRANSPORTATION
HIGHWAYS DIVISION
GOLF COURSE SEPARATION
ABUTMENT #1 AND #2 DETAILS
Leilehua Interchange
F.A.I. Proj. No. I-H2-1(8)-6 January, 1973
SHEET No. 2 OF 20 SHEETS


FED. ROAD DIST. NO.	STATE	FED. AID PROJ. NO.	FISCAL YEAR	SHEET NO.	TOTAL SHEETS
HAWAII	HAW.	I-H2-1(8)-6	1973	122	100

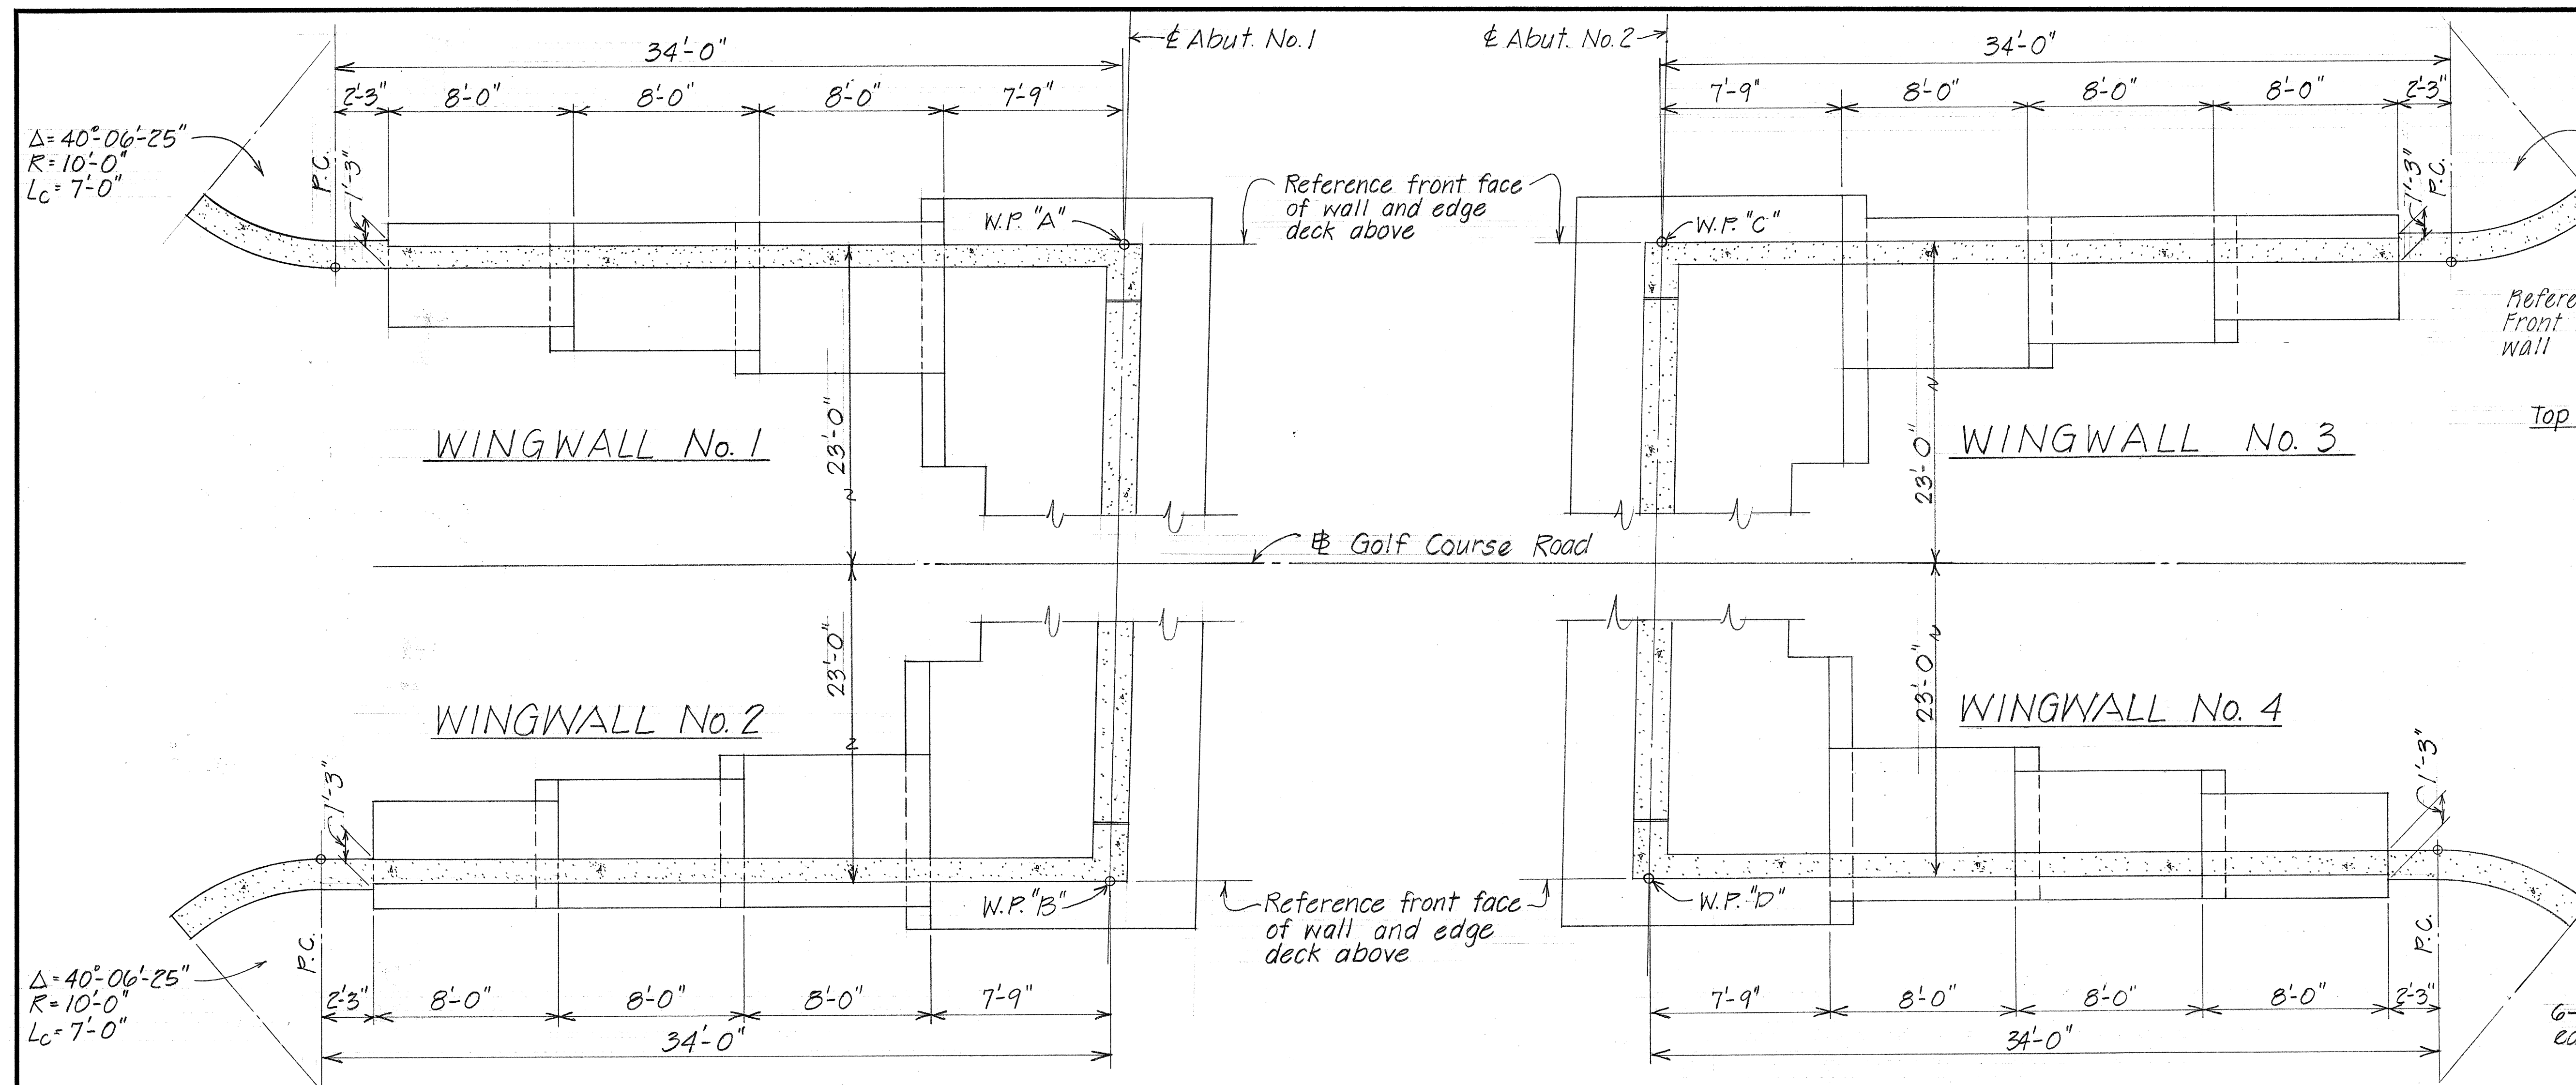


PART FOUNDATION PLAN - ABUTMENT WALL LEVEL
Scale: 1/4" = 1'-0"

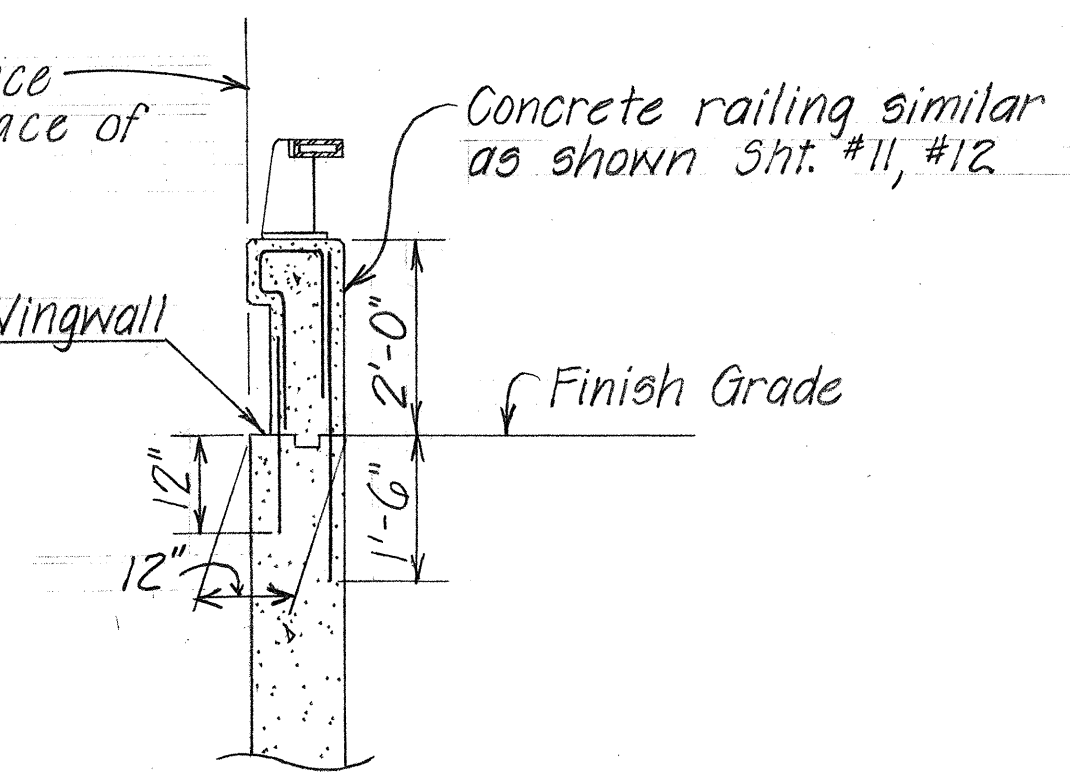


TYPICAL SECTION A-3
Scale: 1/2" = 1'-0"

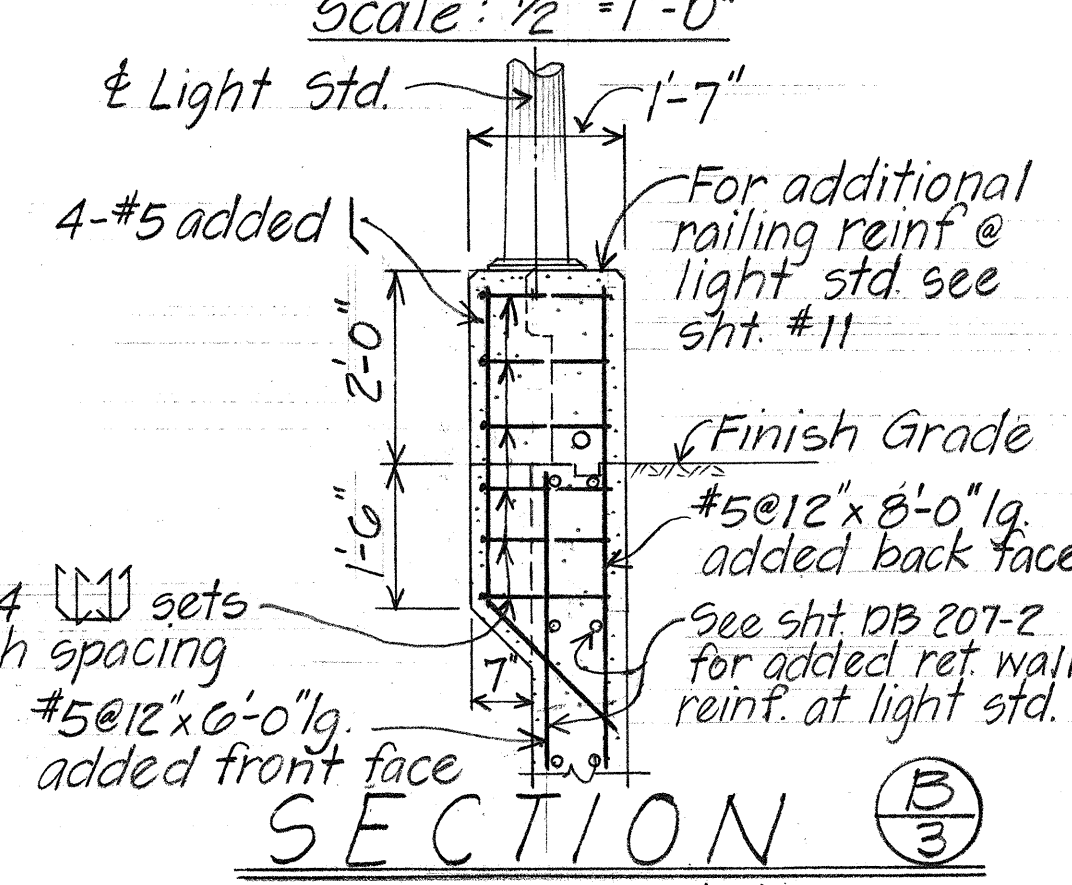


SECTION B-3
Scale: 1/2" = 1'-0"

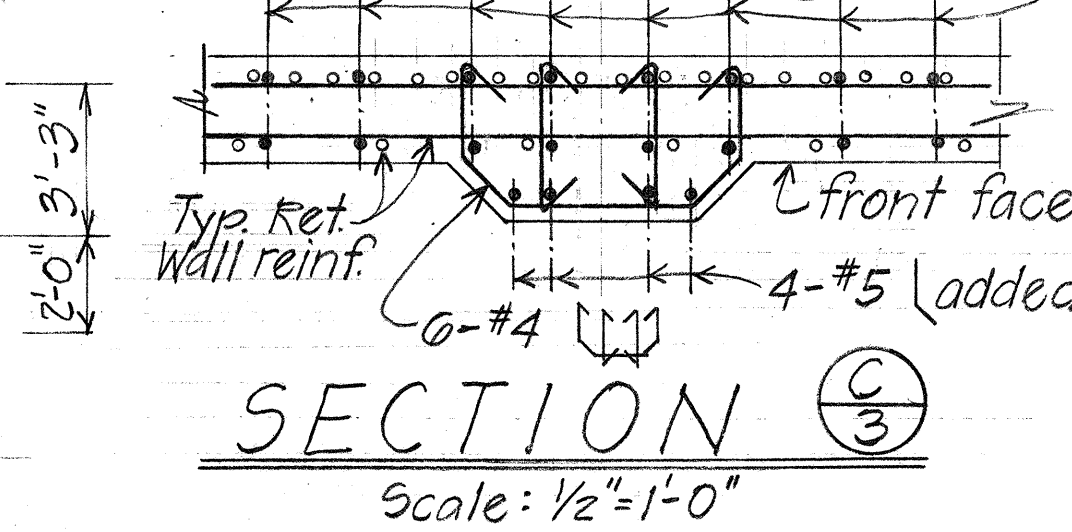

SECTION C-3
Scale: 1/2" = 1'-0"

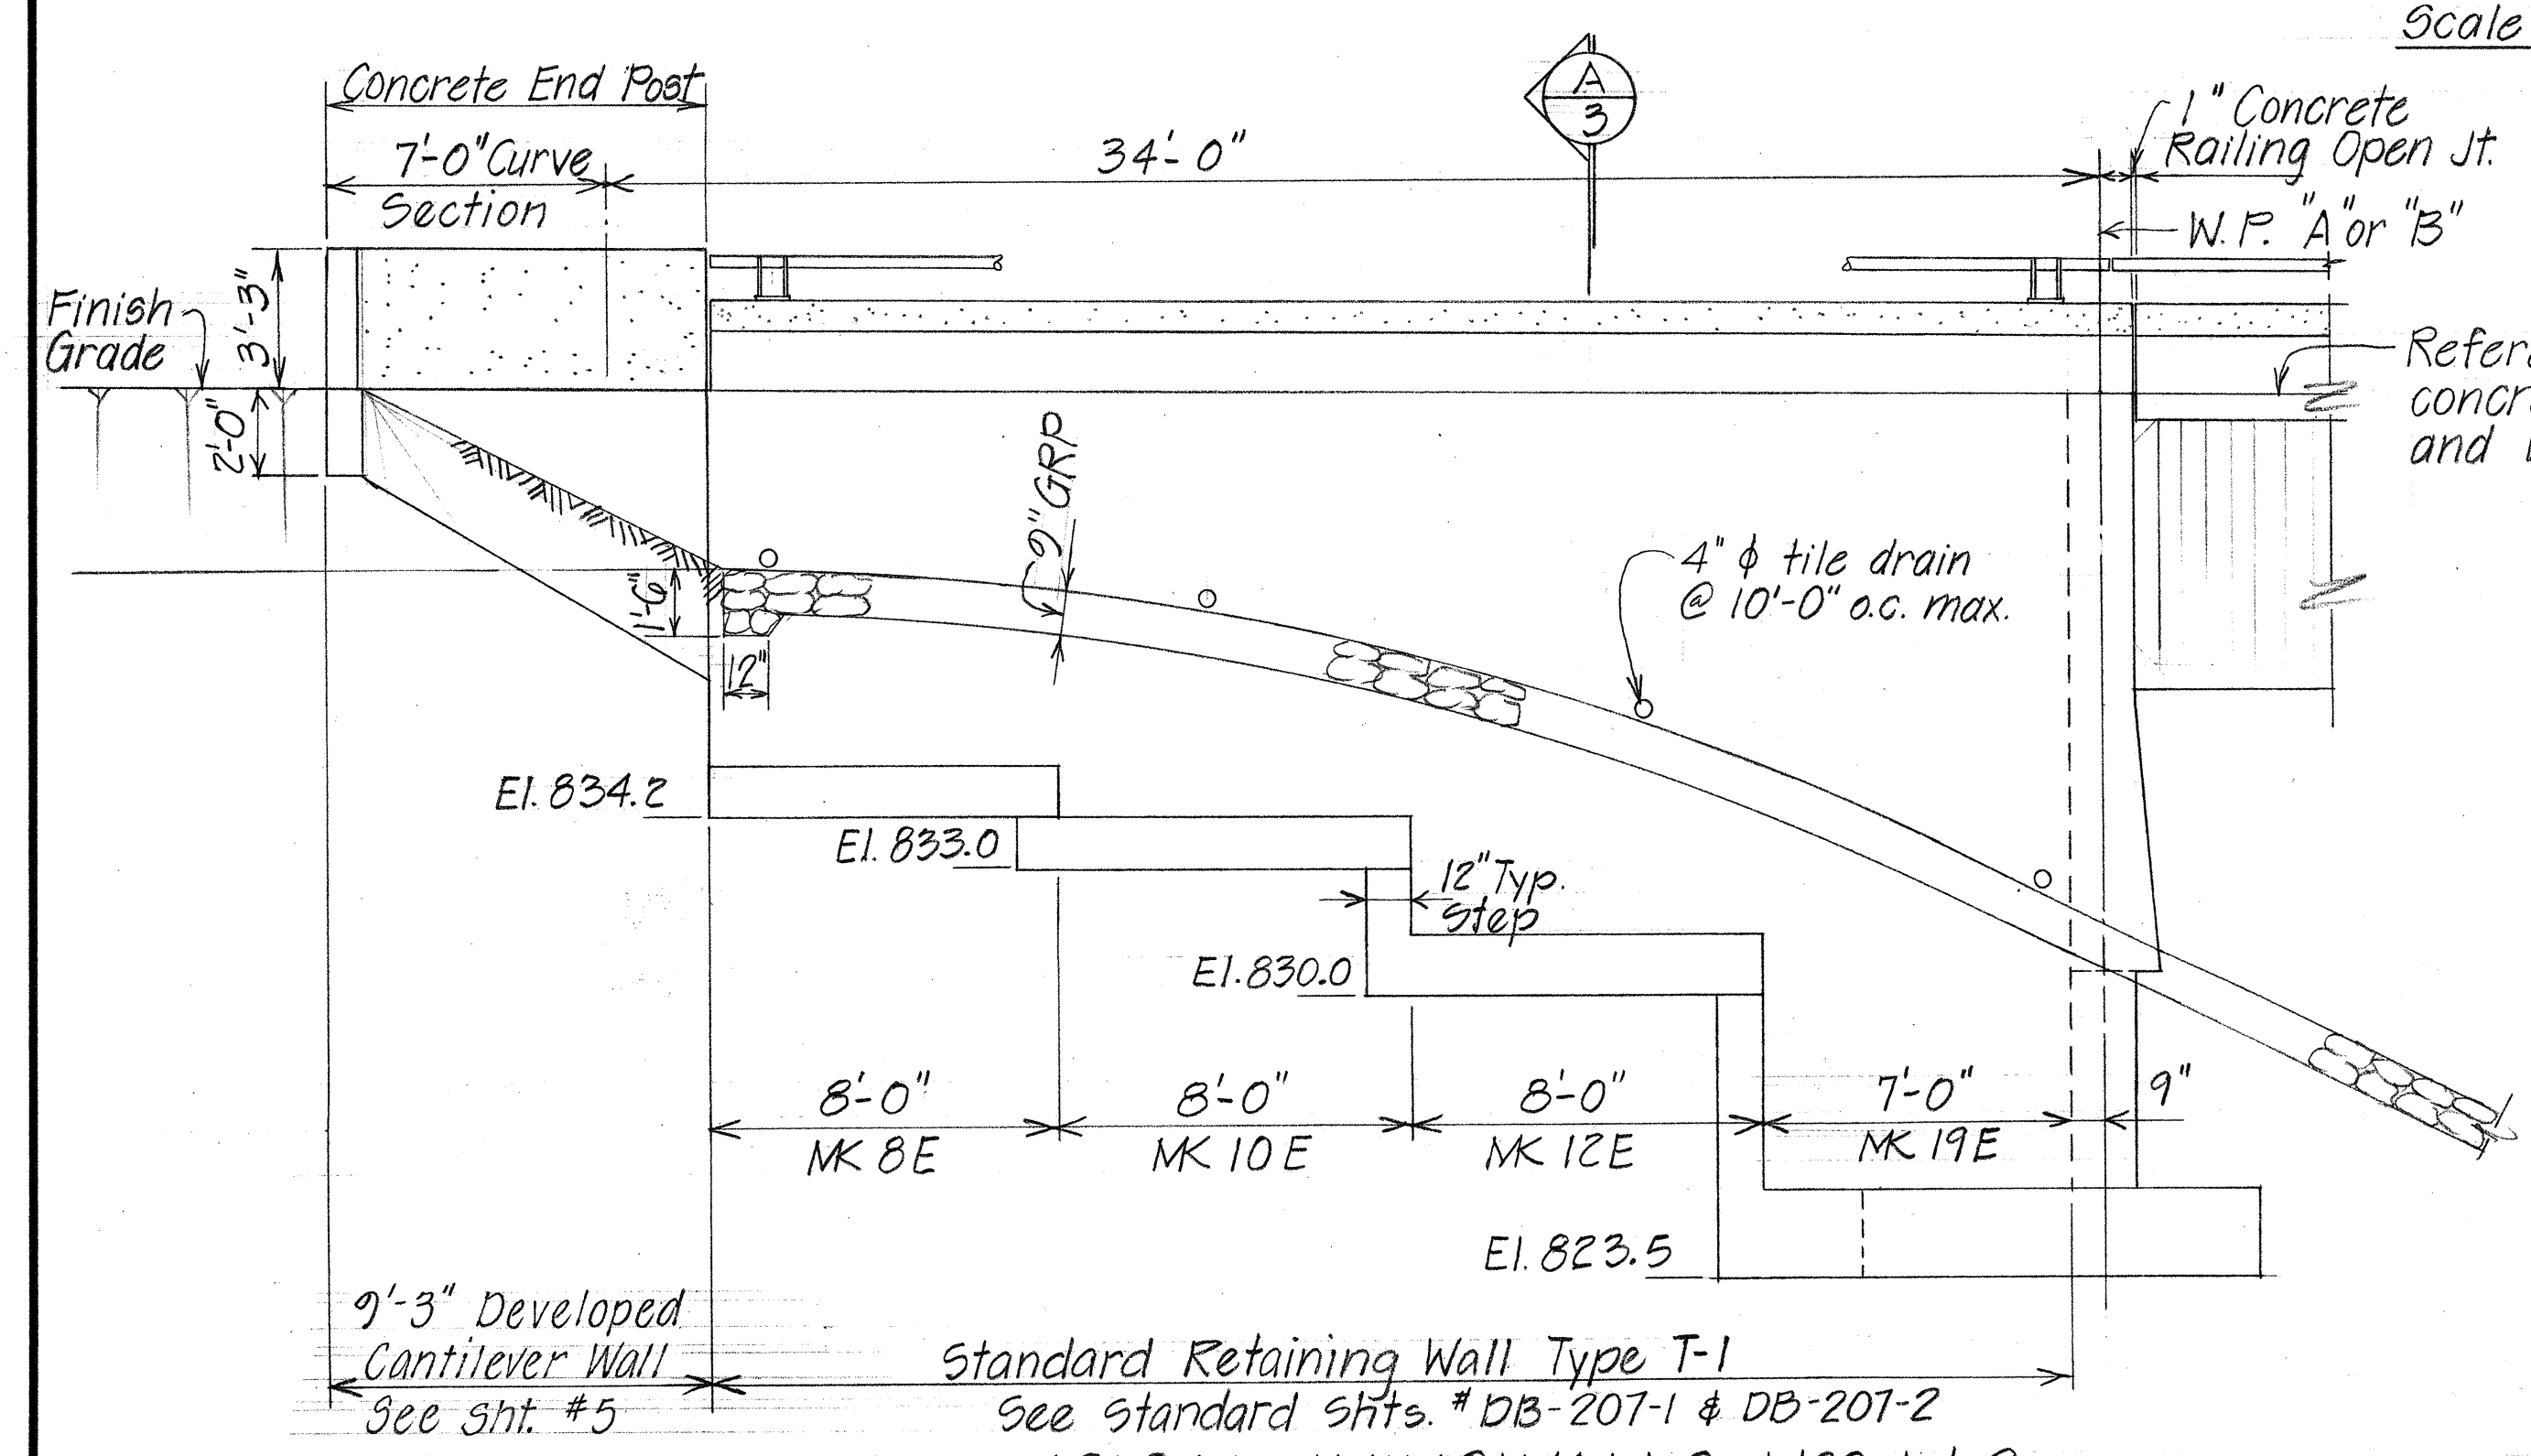













EXTERIOR ELEVATION - TYPICAL WINGWALLS NOS 1 & 2
Scale: 1/4" = 1'-0"

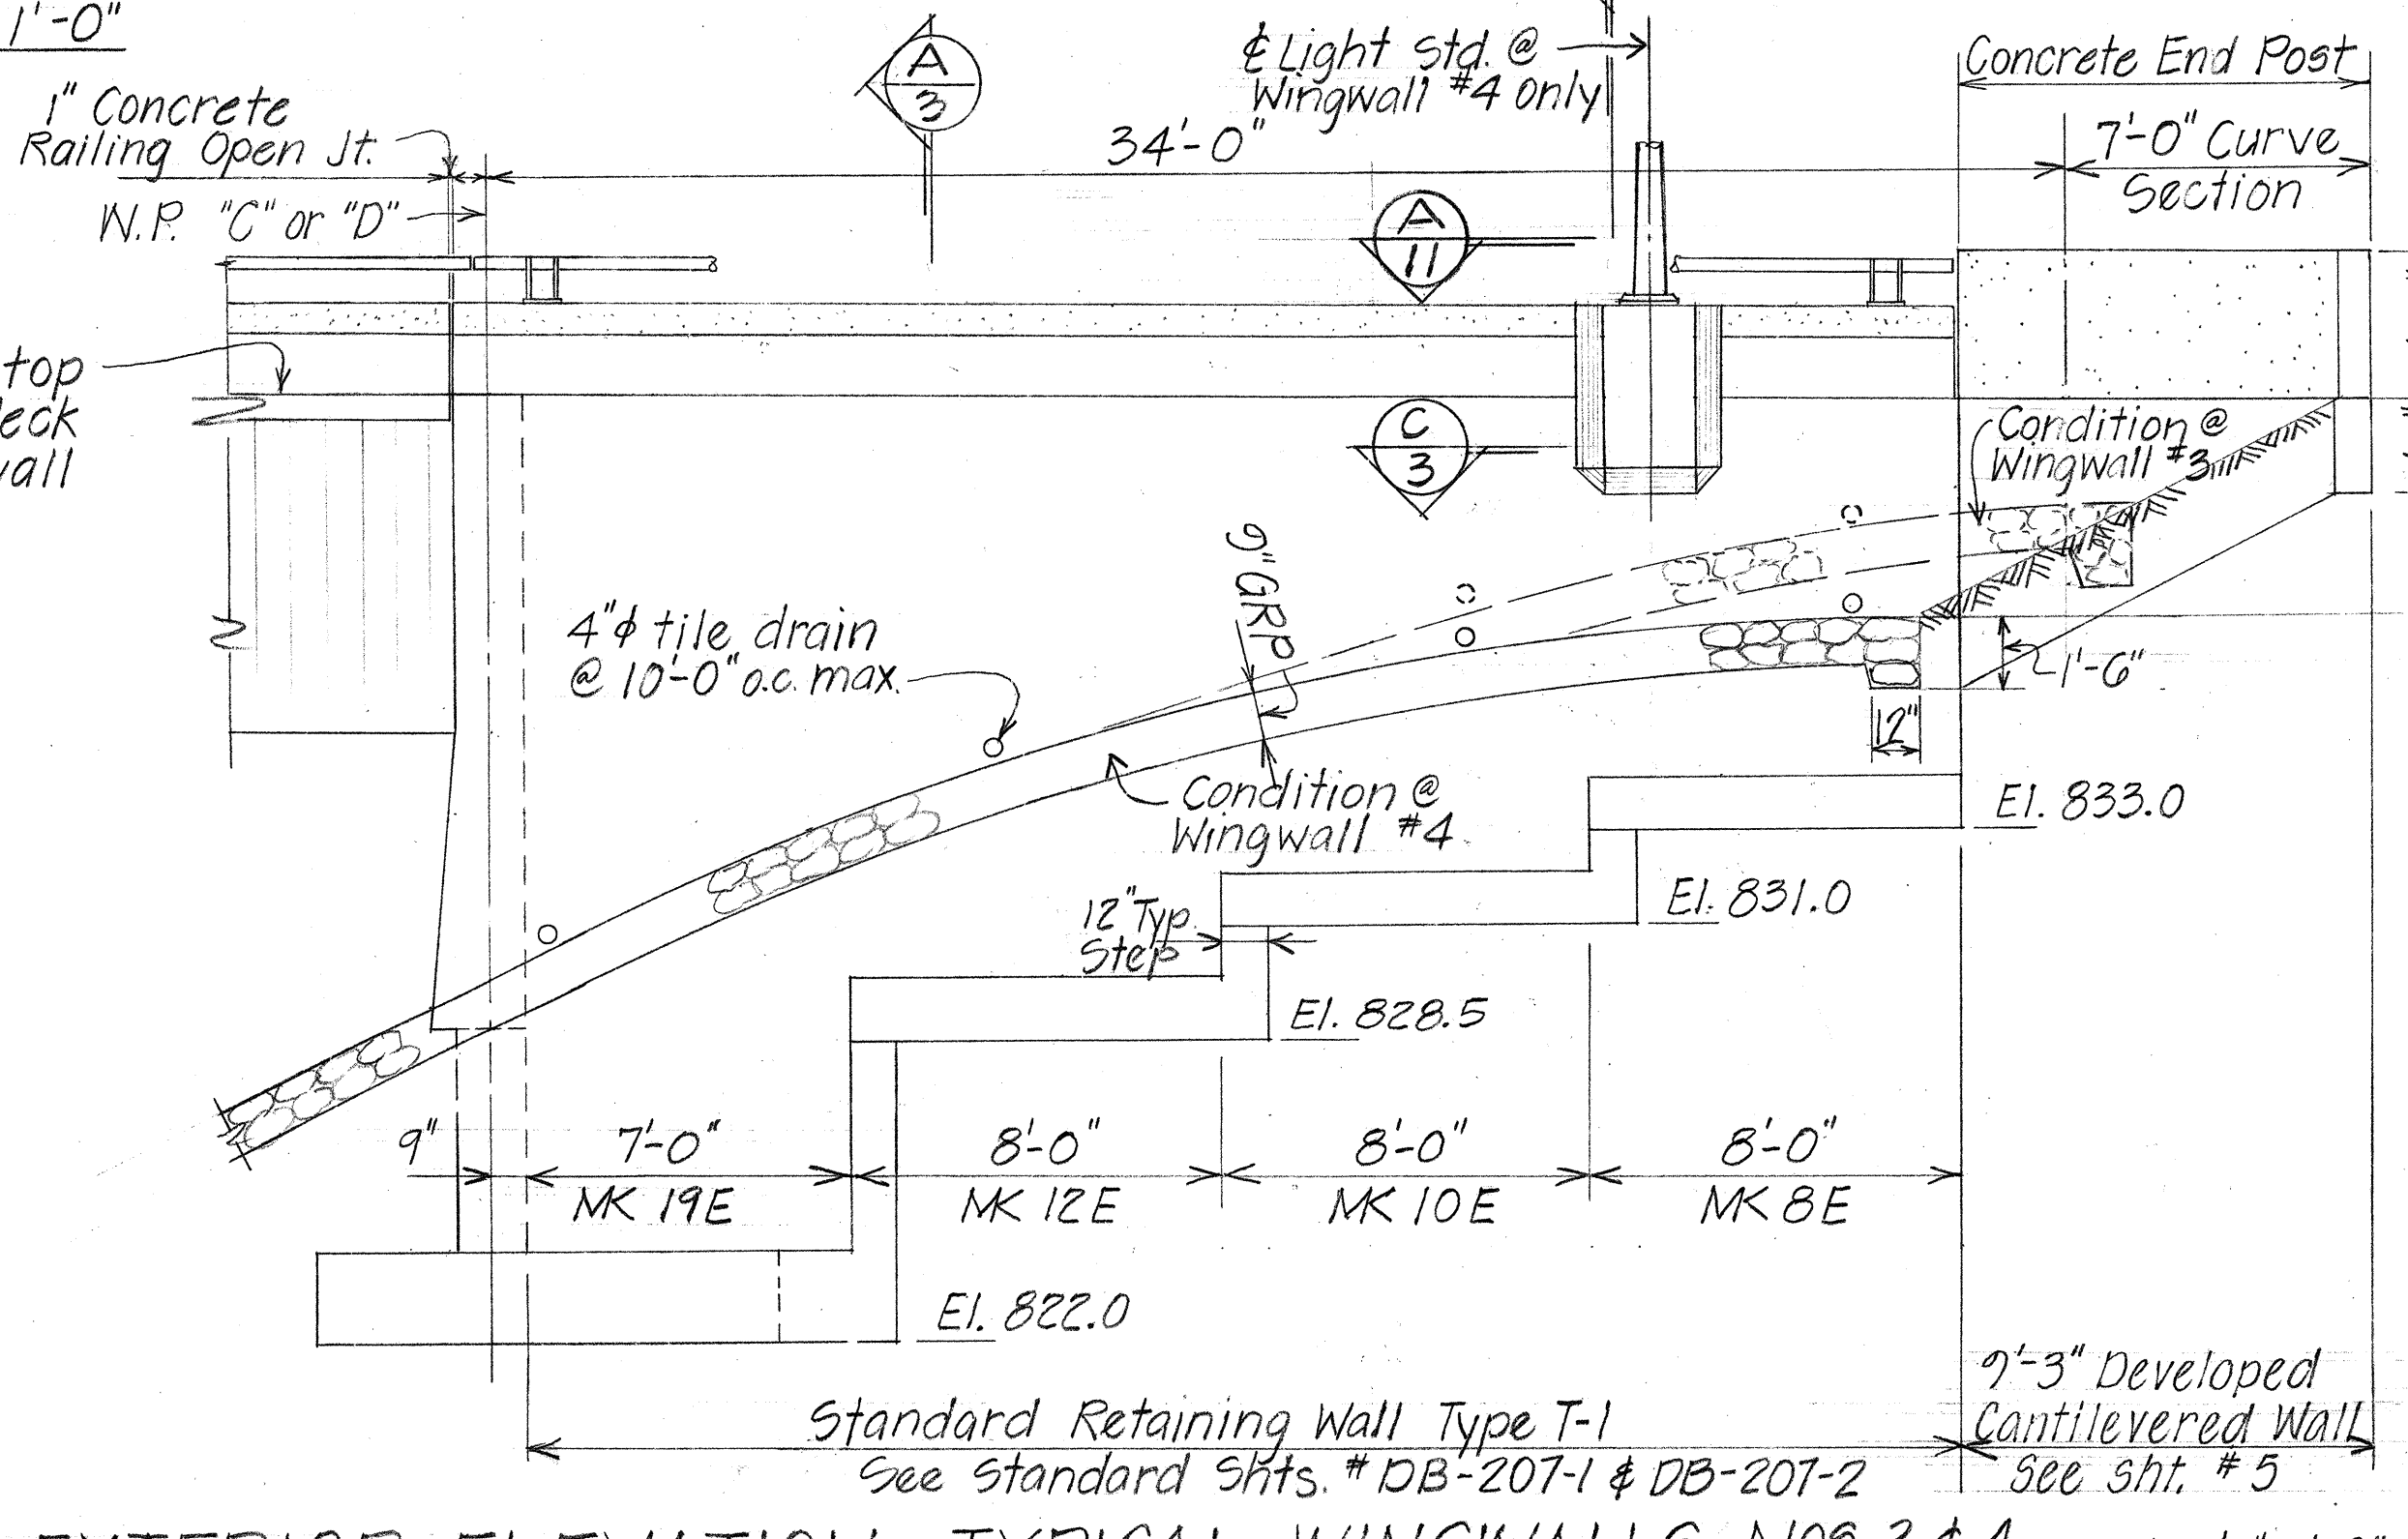

EXTERIOR ELEVATION - TYPICAL WINGWALLS NOS 3 & 4
Scale: 1/4" = 1'-0"

STATE OF HAWAII
DEPARTMENT OF TRANSPORTATION
HIGHWAYS DIVISION
GOLF COURSE SEPARATION
ABUTMENT WINGWALLS #1, #2, #3
AND #4 DETAILS
Leilehua Interchange
F.A.I. Proj. No. I-H2-1(8)-6 January, 1973
SHEET No. 3 OF 20 SHEETS

FED. ROAD DIST. NO.	STATE	FED. AID PROJ. NO.	FISCAL YEAR	SHEET NO.	TOTAL SHEETS
HAWAII	HAW.	I-H2-1(8):6	1973	123	160

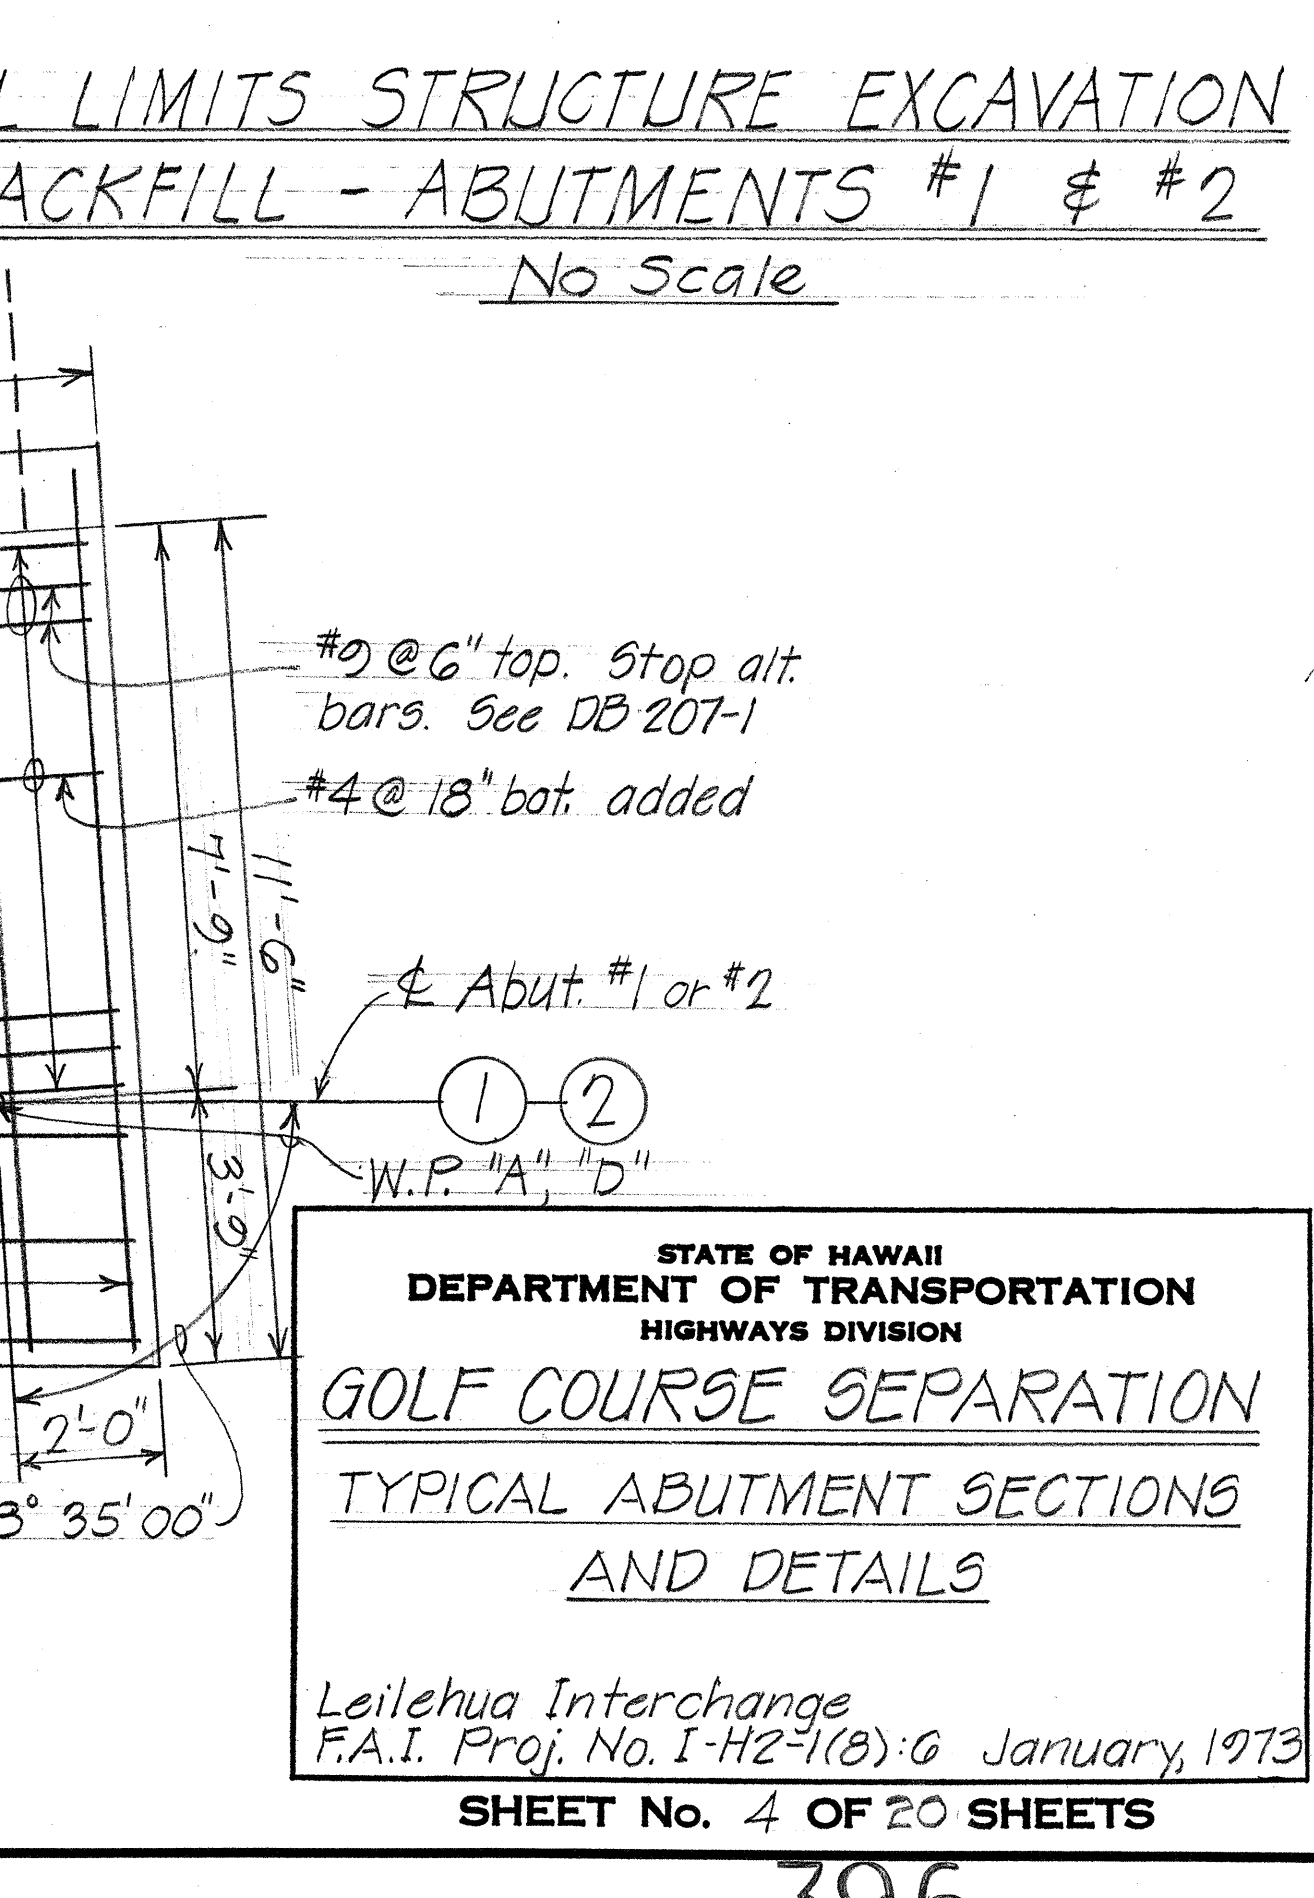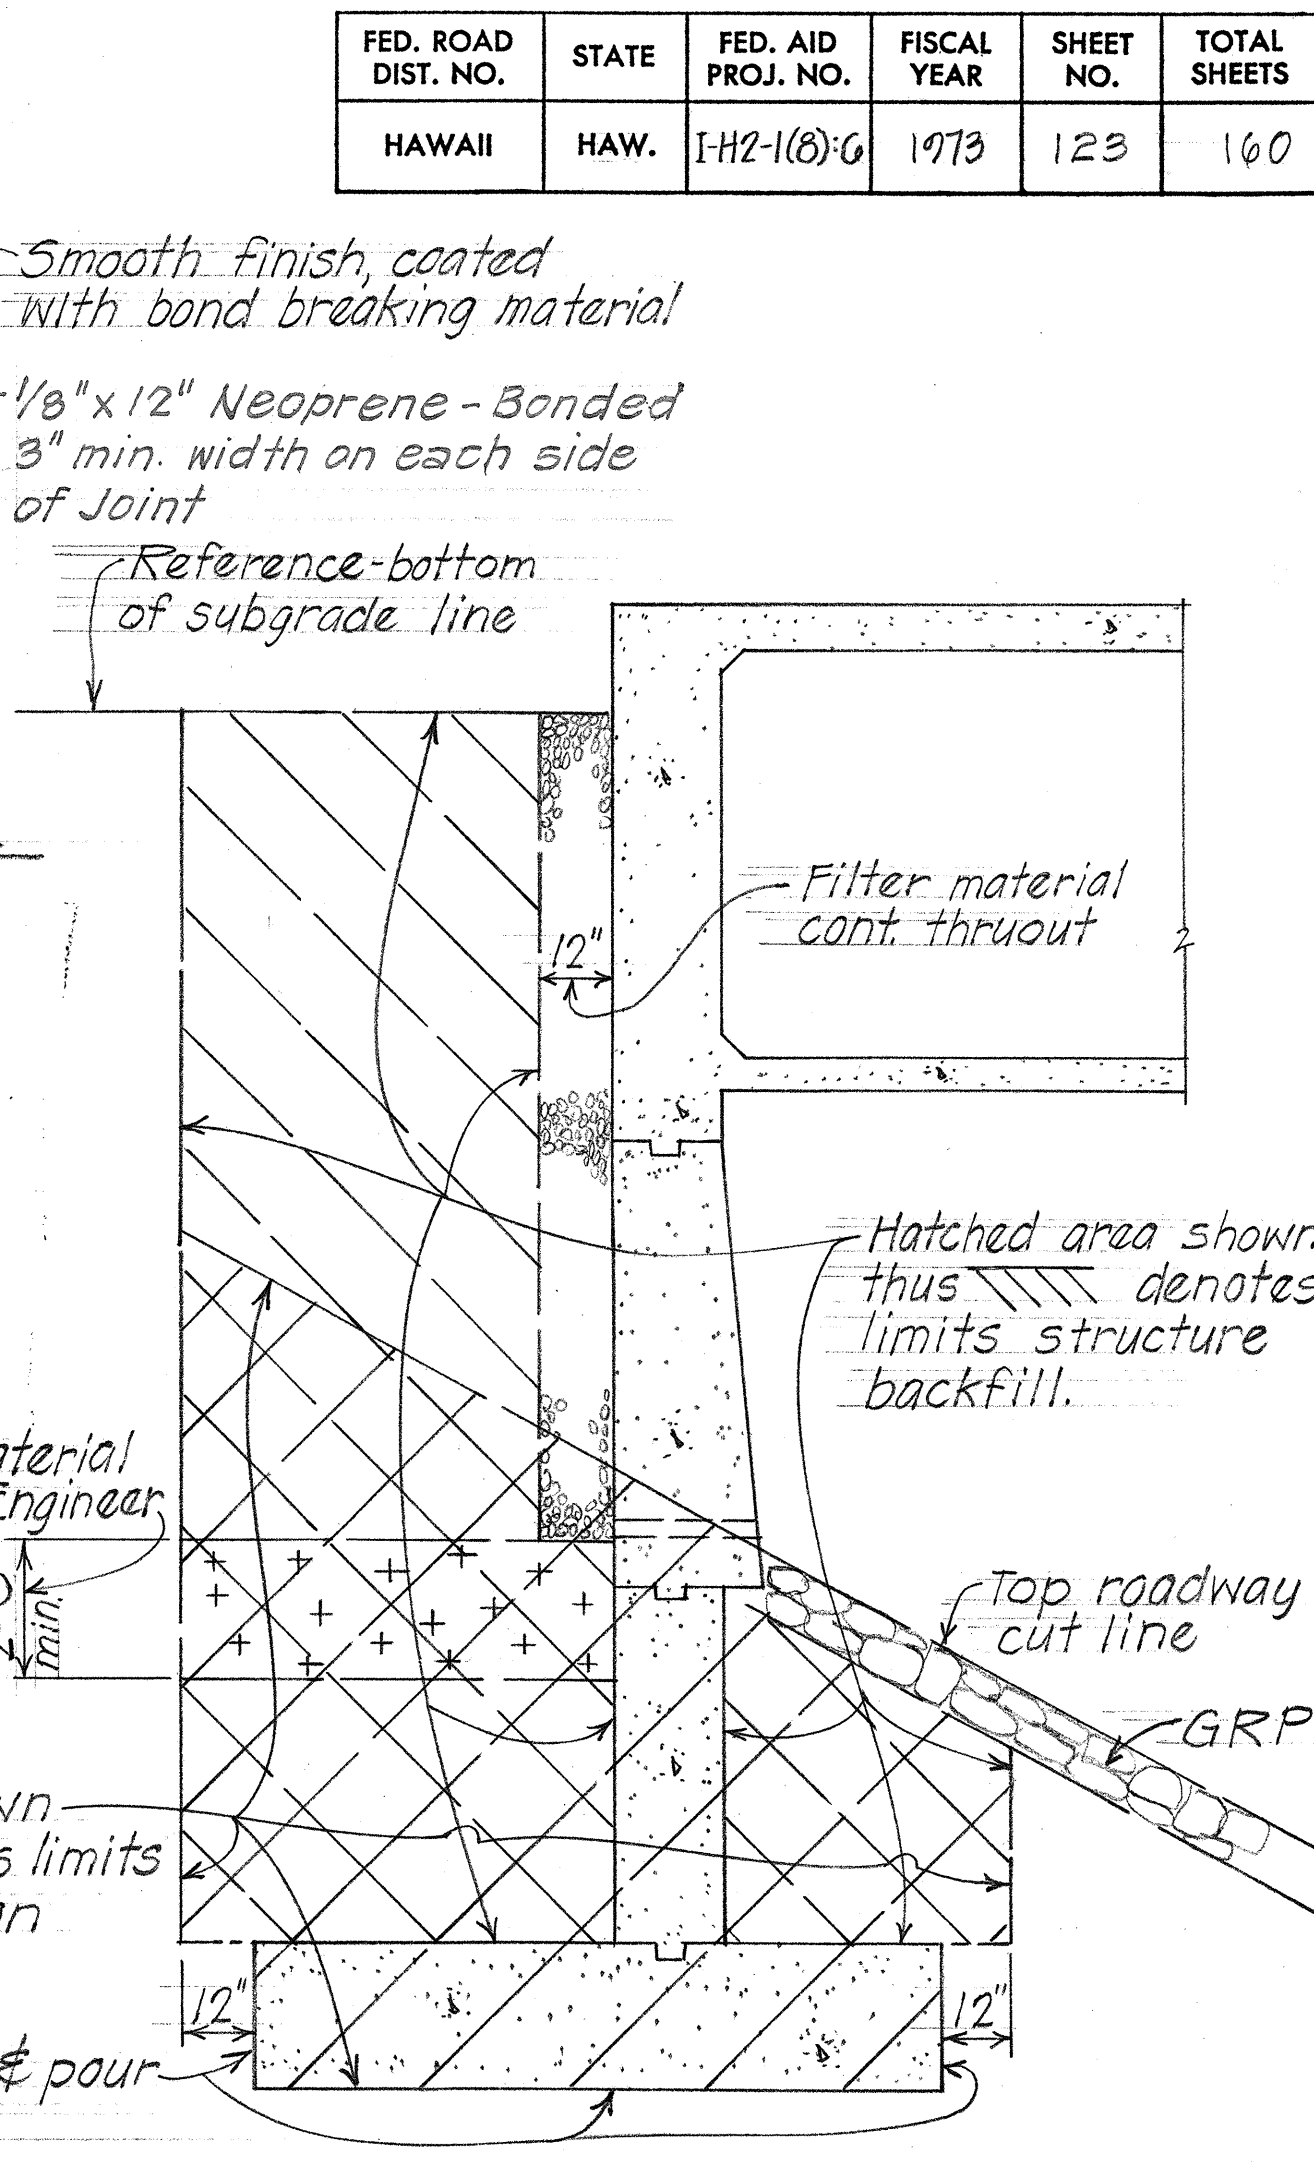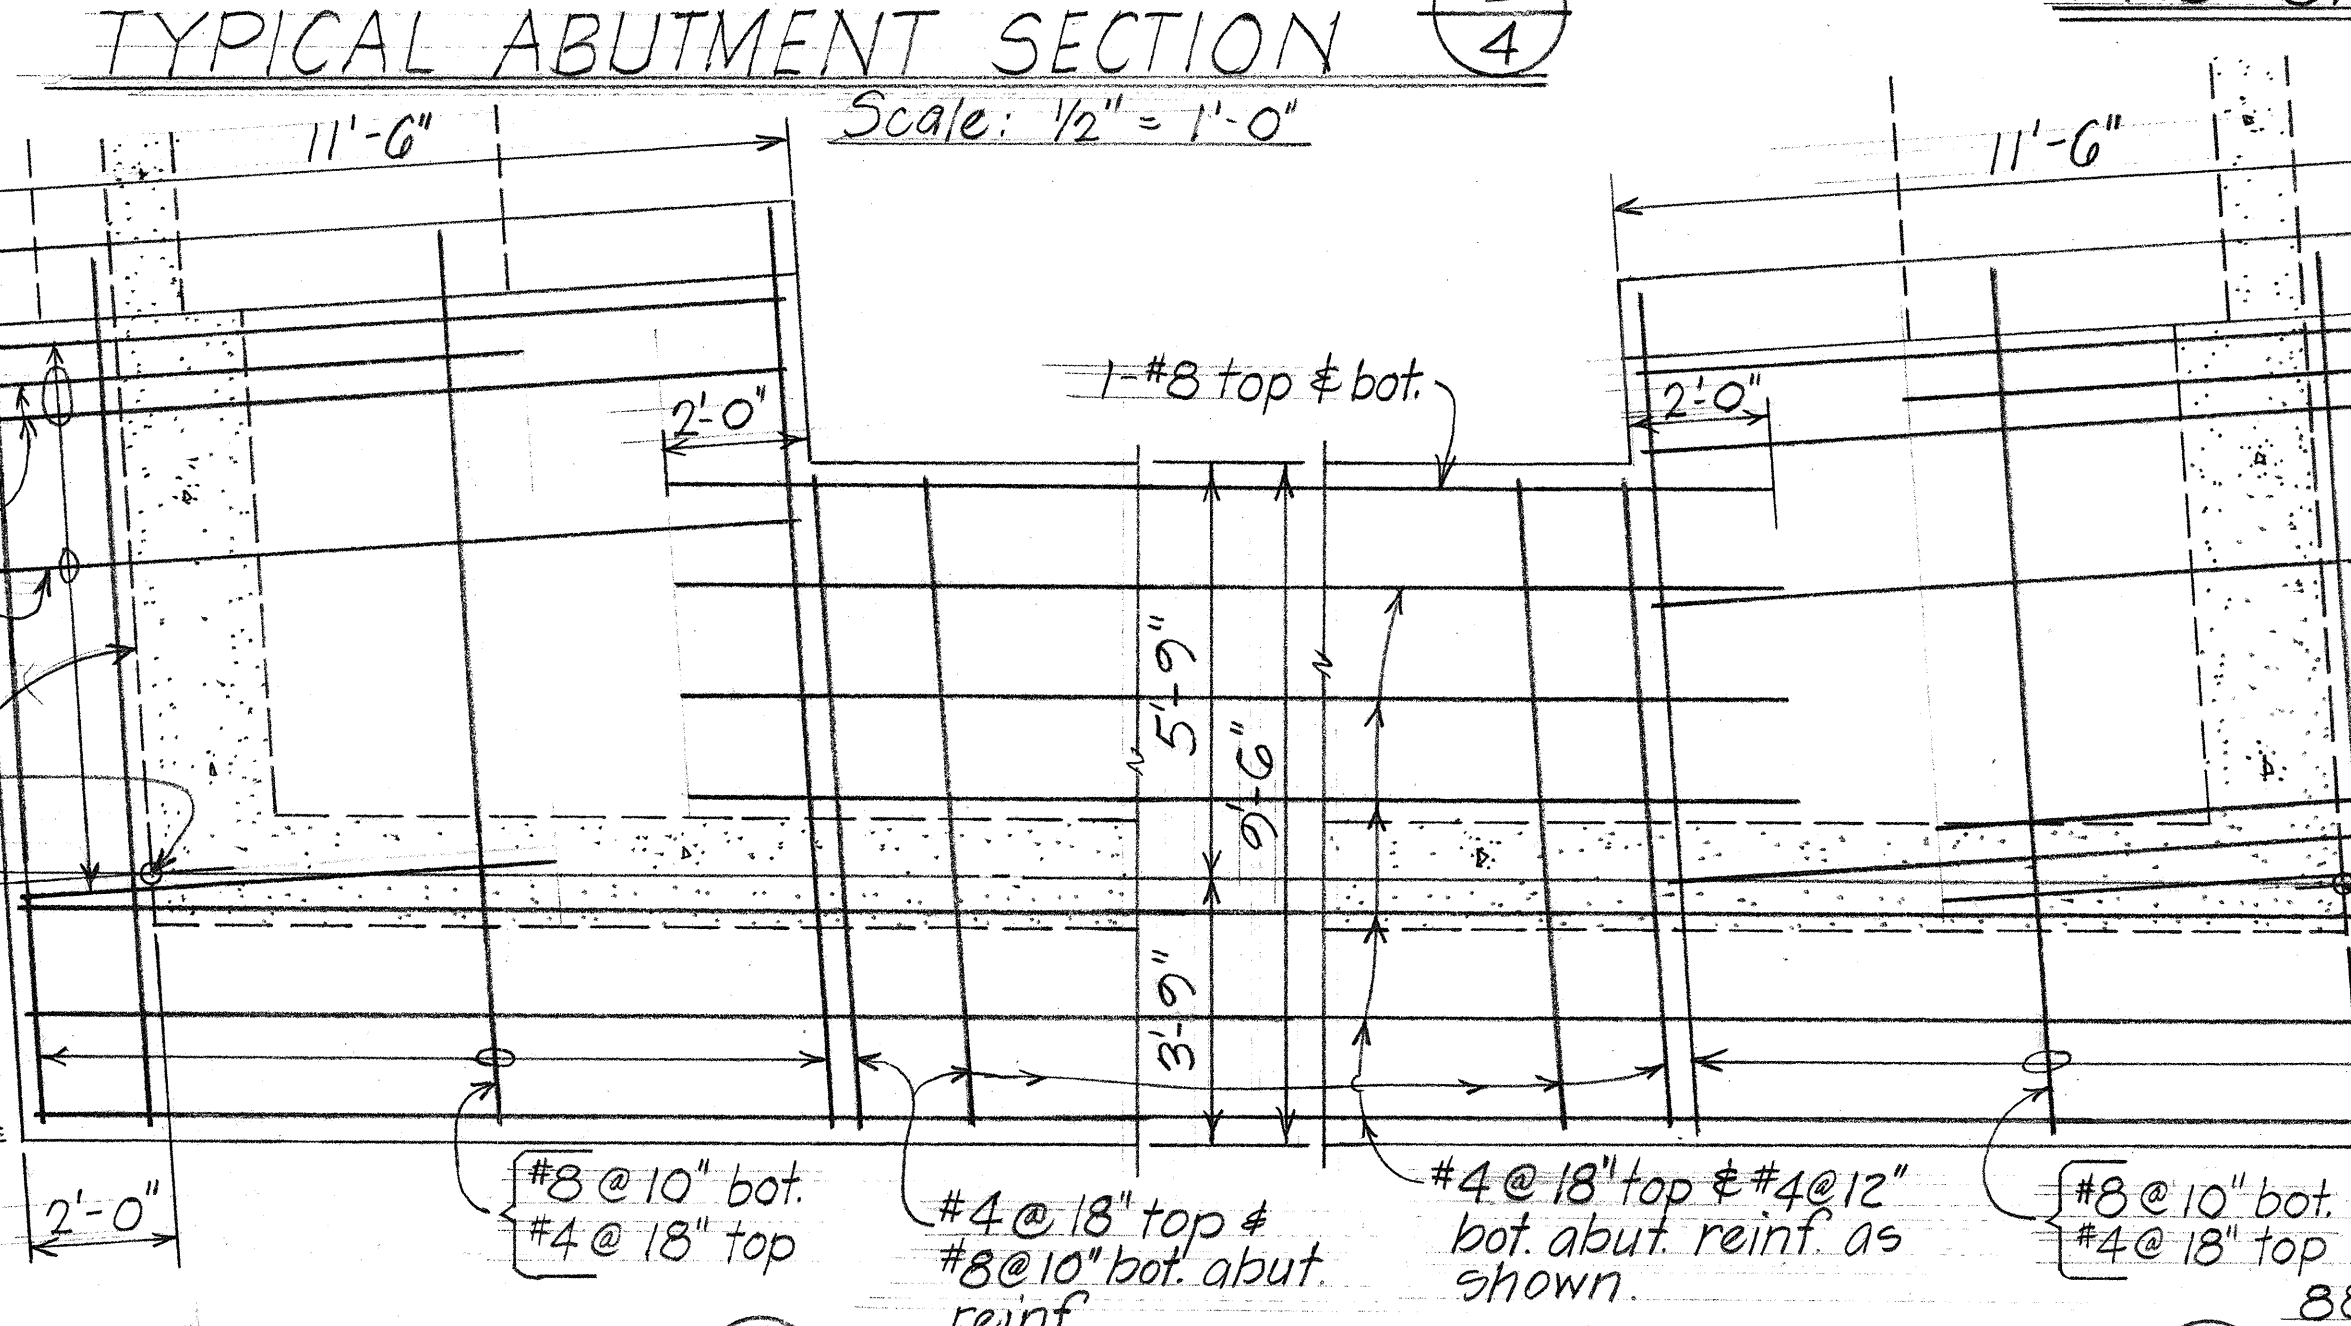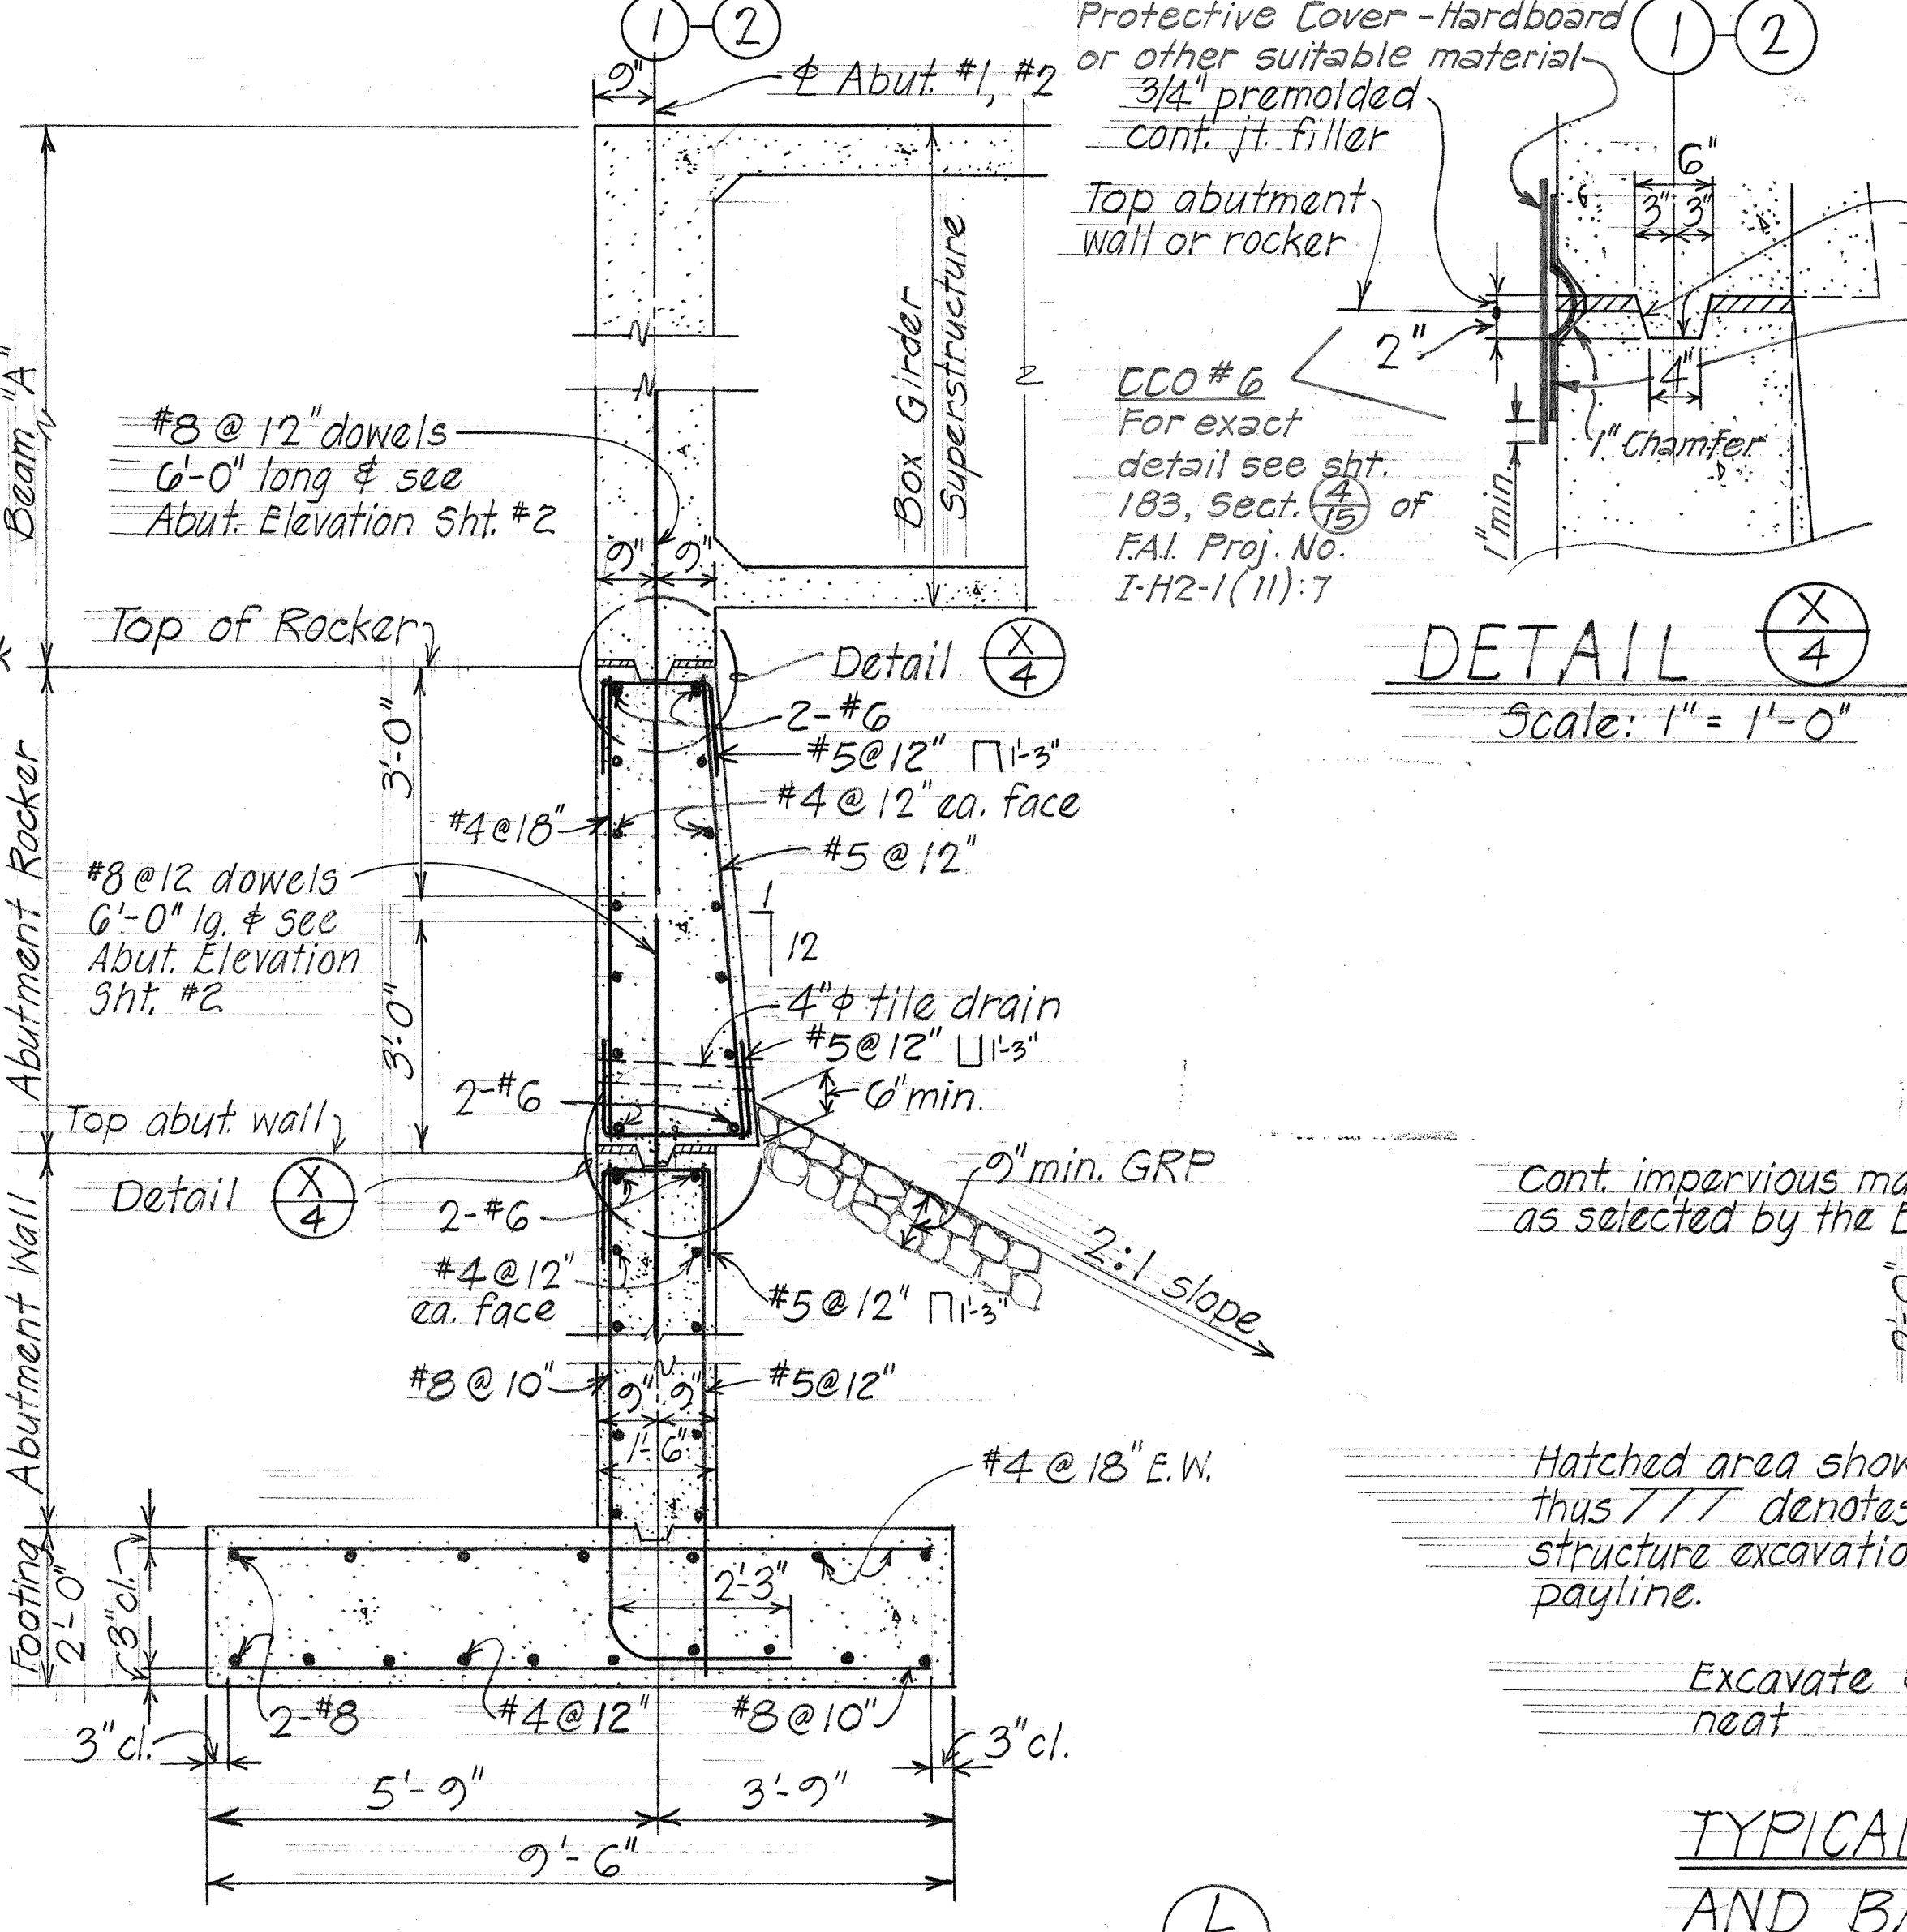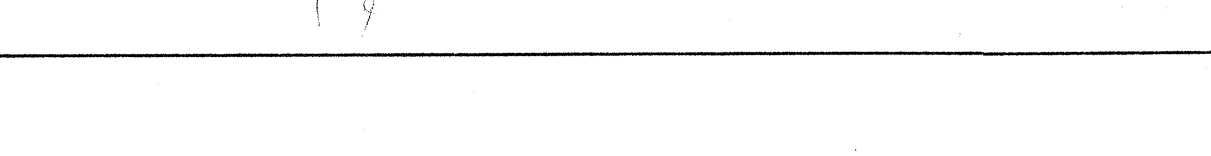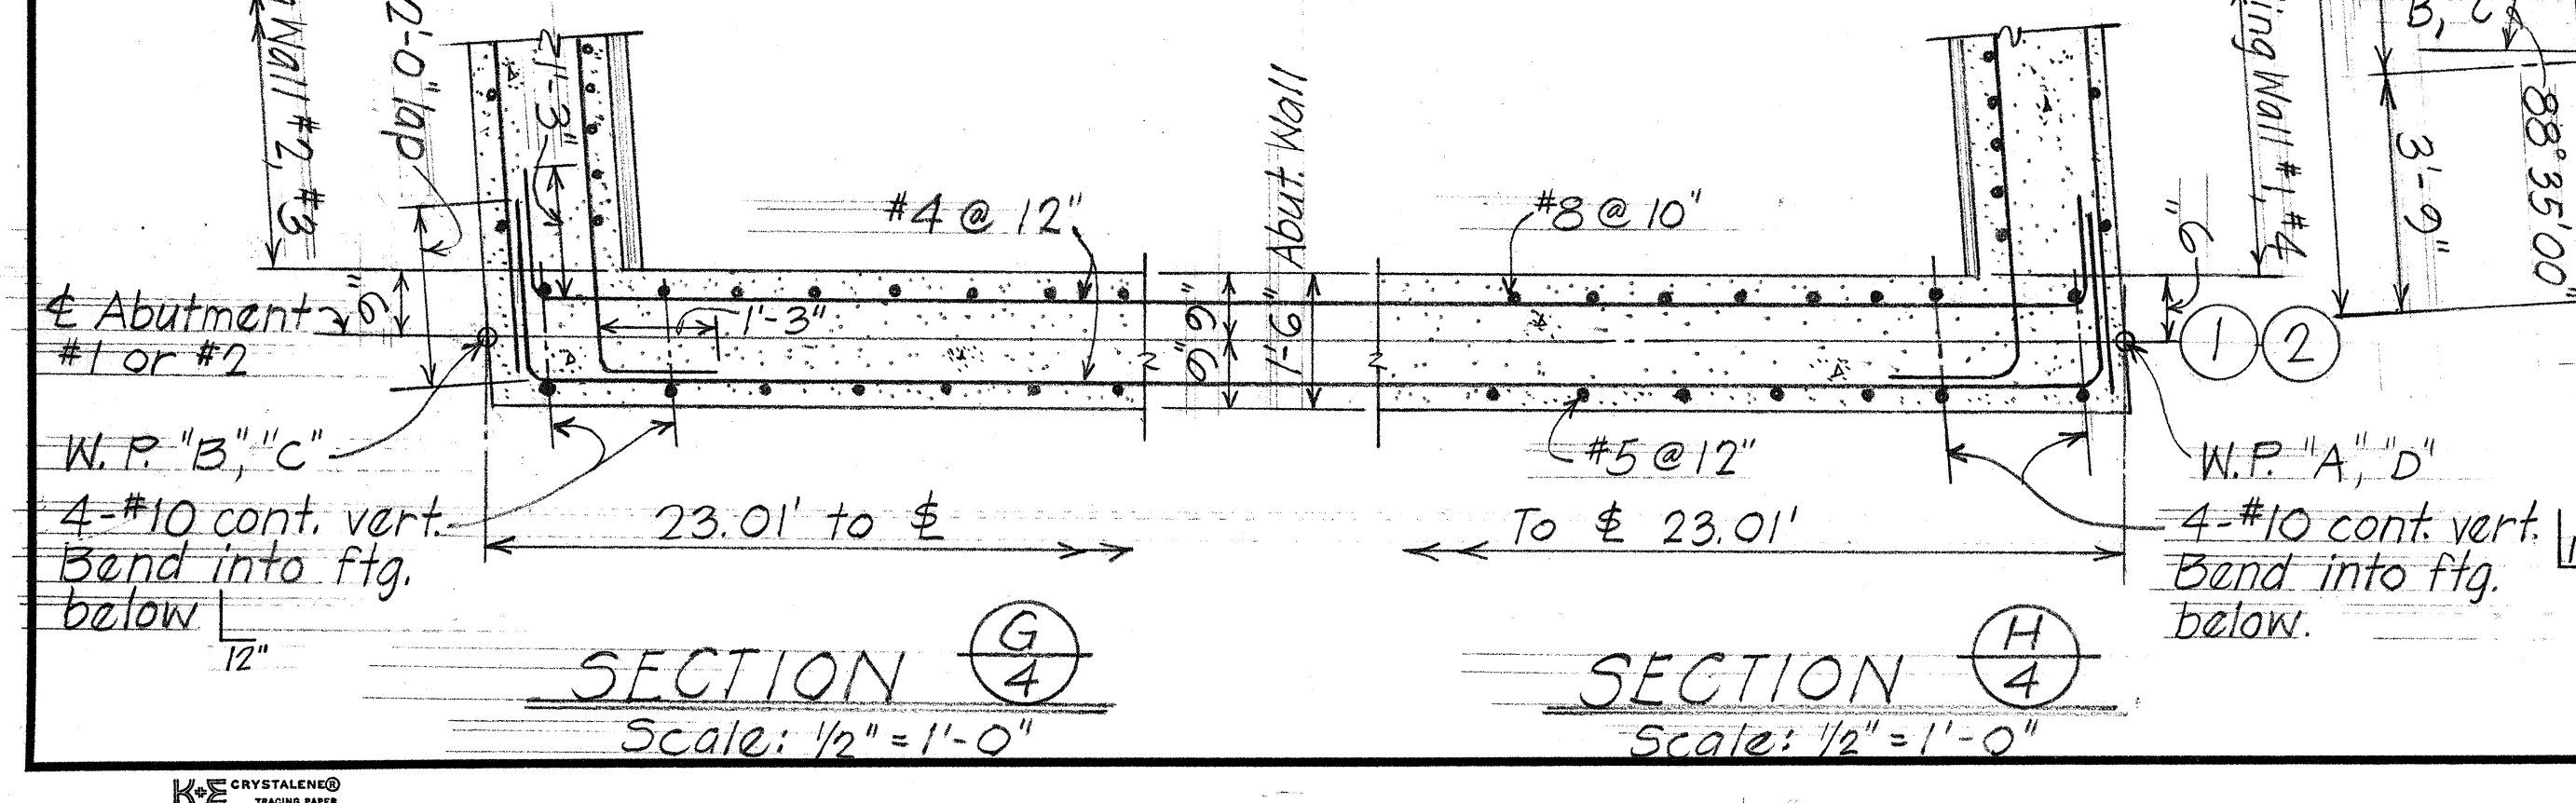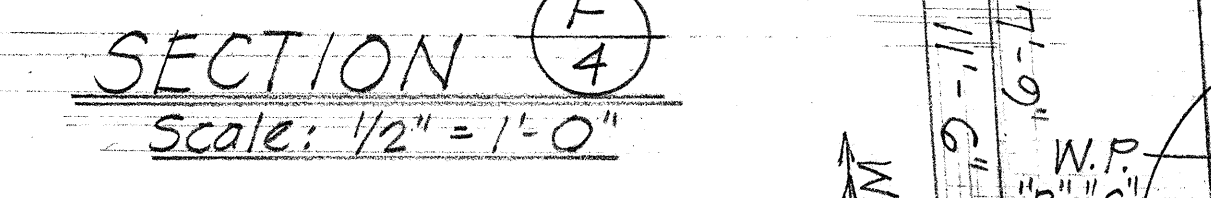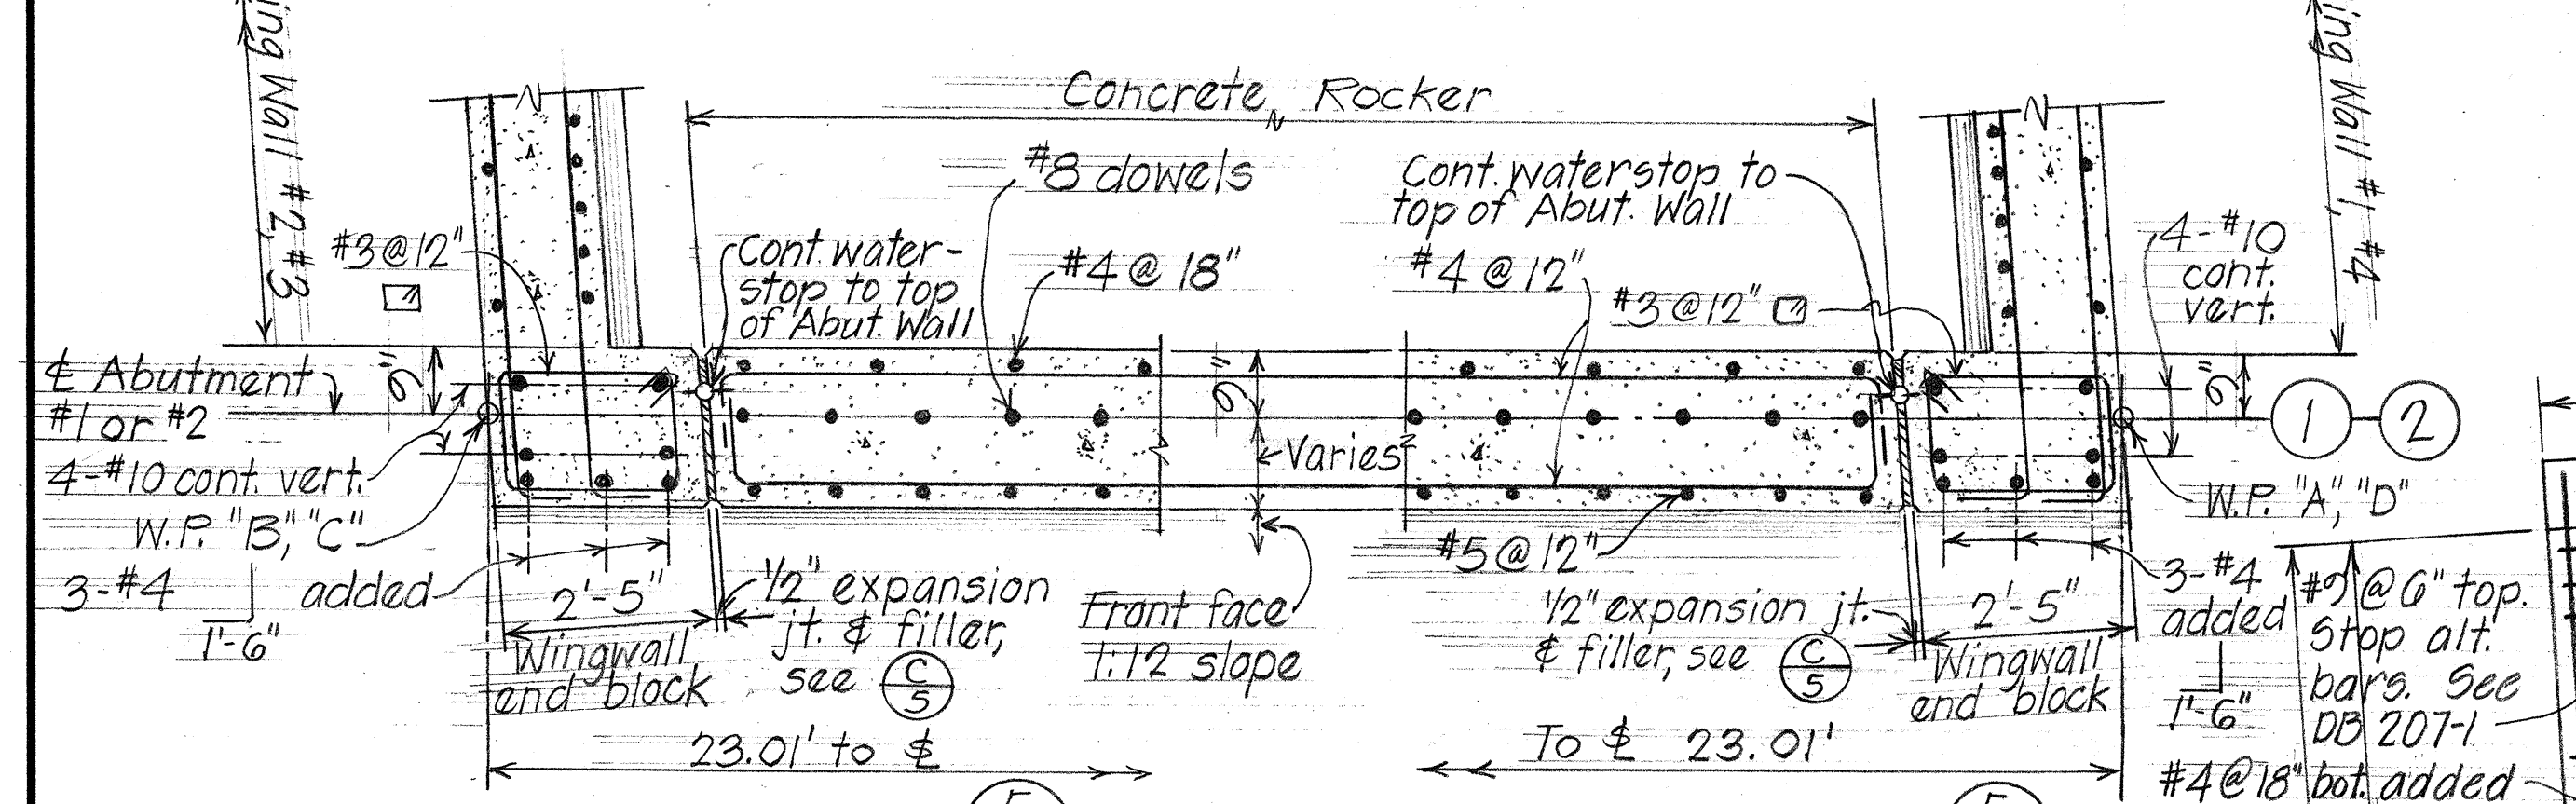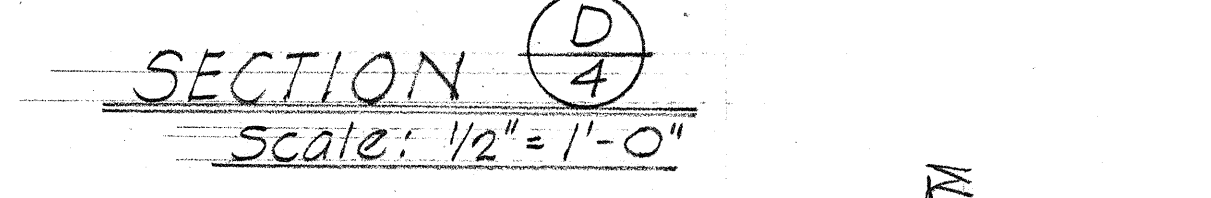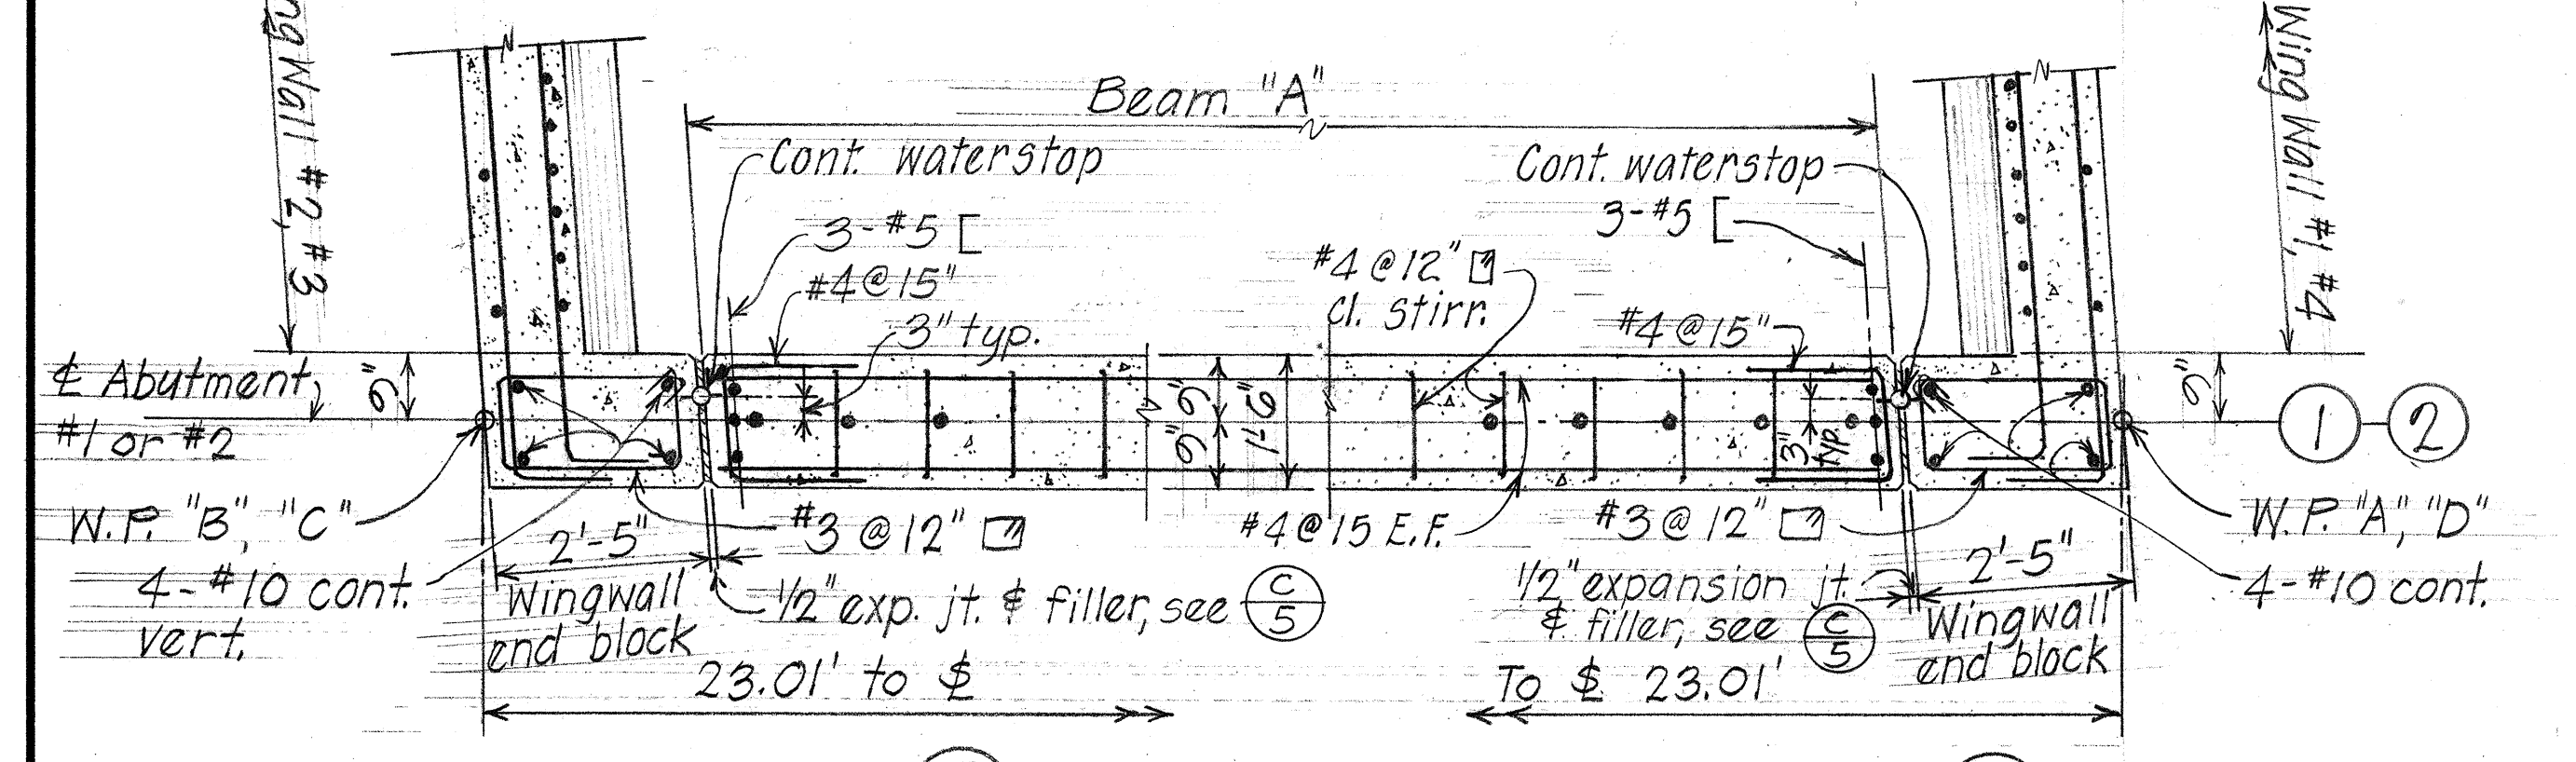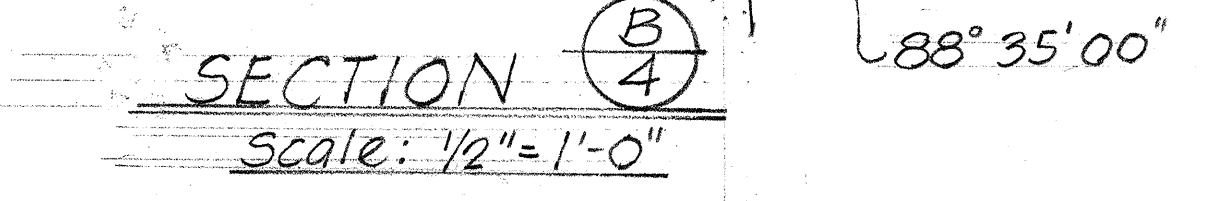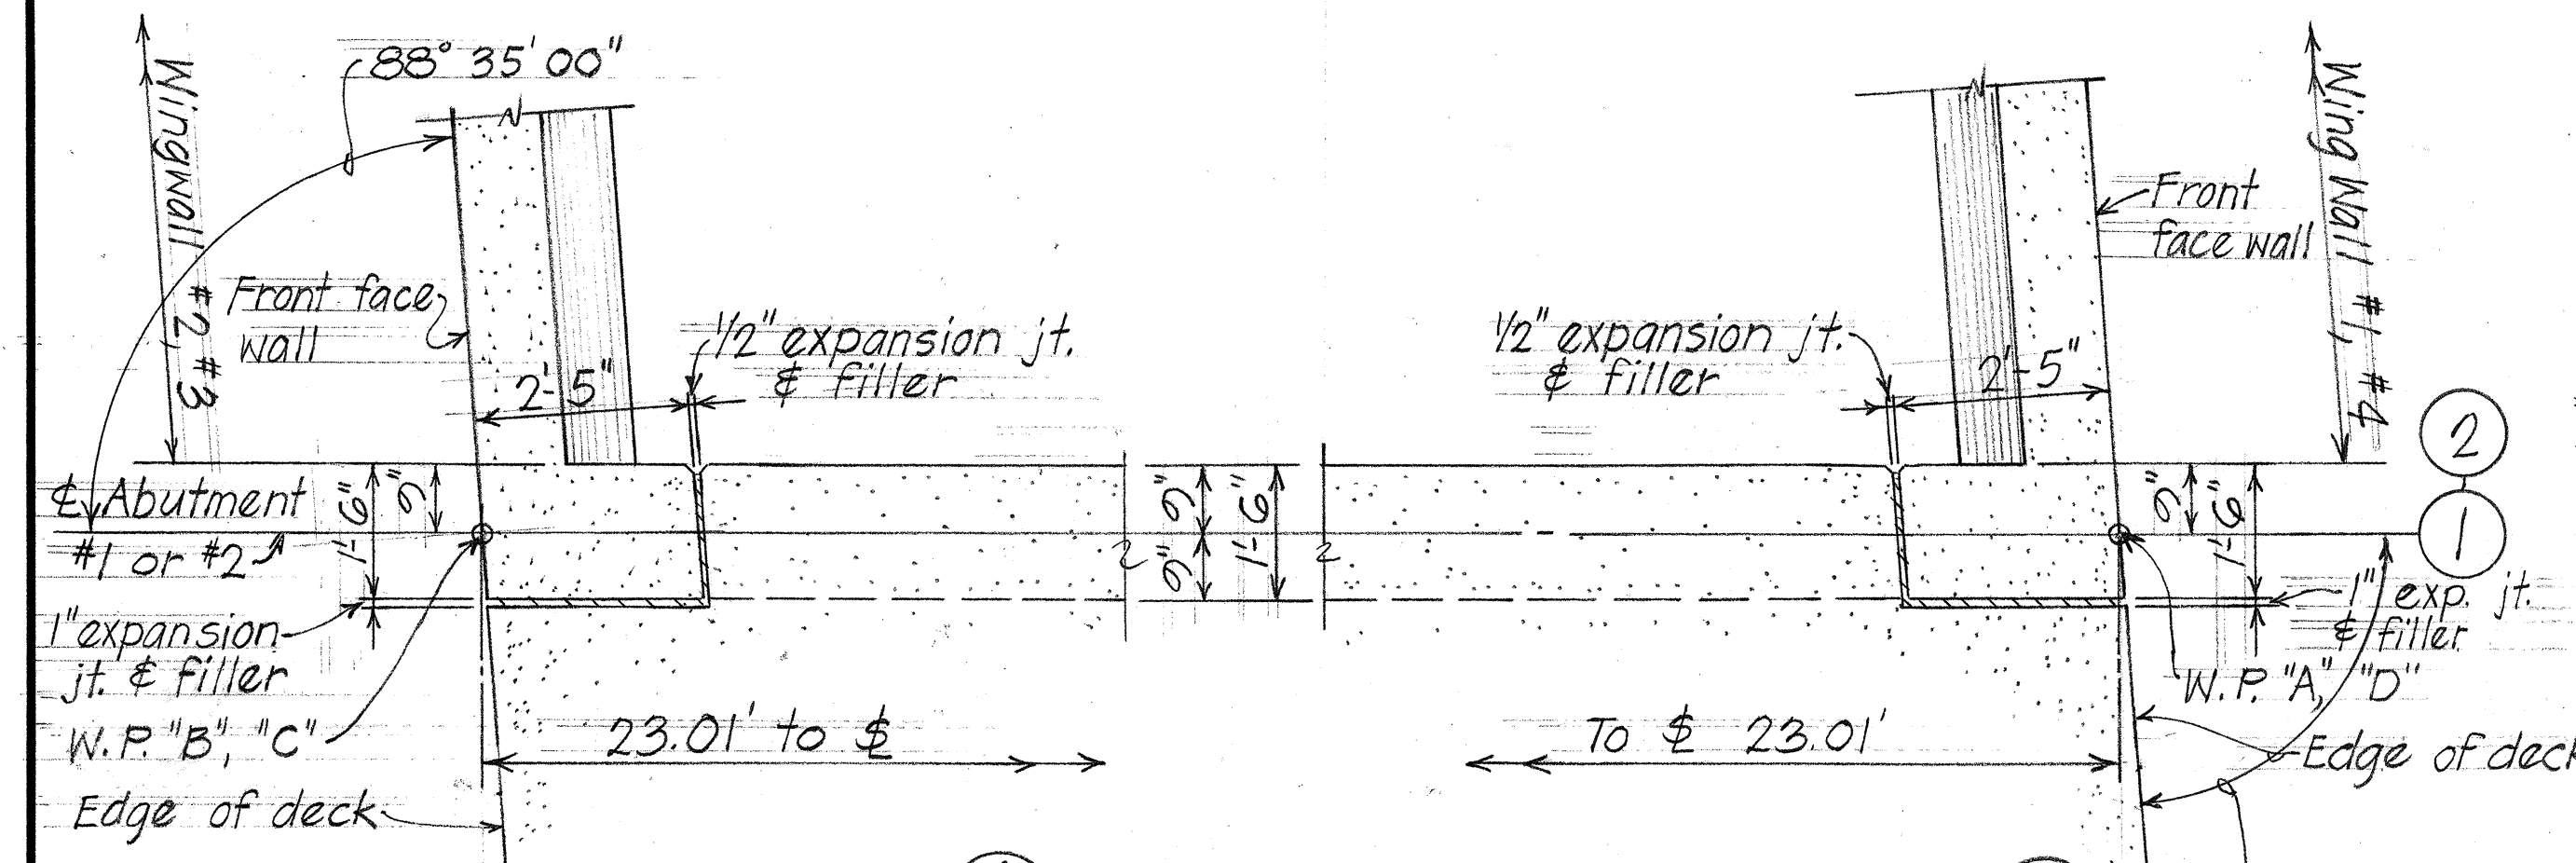

STATE OF HAWAII
DEPARTMENT OF TRANSPORTATION
HIGHWAYS DIVISION
GOLF COURSE SEPARATION
TYPICAL ABUTMENT SECTIONS
AND DETAILS
Leilehua Interchange
F.A.I. Proj. No. I-H2-1(8):6 January, 1973
SHEET No. 4 OF 20 SHEETS

DATE	3/73
DESIGNED BY	NT
DRAWN BY	NT
CHECKED BY	NT
NOTED BY	NT
QUANTITIES BY	NT
NO.	3/73

FED. ROAD DIST. NO.	STATE	FED. AID PROJ. NO.	FISCAL YEAR	SHEET NO.	TOTAL SHEETS
HAWAII	HAW.	I-H2-1(8):6	1973	124	160

GENERAL NOTES

SPECIFICATIONS: AASHTO

Standard Specifications for Highway Bridges (10th Edition) with subsequent additions and modifications.

DESIGN LOADS: HS 20-44

Class A

Class E

DESIGN STRESSES:

$f'_c = 3,000$ psi

$f'_c = 4,500$ psi

$f_c = 1,200$ psi

$f_c = 1,800$ psi

$n = 10$

$n = 8$

$f_s = 20,000$ psi tension

MATERIALS:

- All concrete shall be Class A unless otherwise noted on plans.
- All welding shall conform to the current Specifications for Welded Highway and Railway Bridges of the American Welding Society.

CONSTRUCTION METHODS:

- Splices for top & bottom slab main reinforcing shall be located near midspan for top slab and near pier support for bottom slab. All splices shall be staggered.
- Sides of footings shall be excavated and poured to neat lines.
- Abutments shall be braced until backfilling is completed. Backfilling shall be done after the superstructure girders and beams are completed. Backfill for abutments 1 and 2 shall be brought up simultaneously to prevent unbalanced earth pressures on the bridge. Check abutments for plumbness before constructing superstructure.
- In general, top of concrete deck of structure shall be constructed to follow the finish roadway vertical and horizontal curves and grades.

CAMBER:


Obtain camber by forming and shoring concrete surfaces above profile grades amount shown in camber diagram and as indicated on detailed drawings.

REFERENCE:

- Refer to Standard Detailed drawings for details not covered by these drawings.
- Typical Detail of Combination Steel Railing on concrete parapet shts. #11, #12 refer to the entire bridge in general, except for modifications as may be required with special conditions. For such modifications, refer to detailed plans.


GENERAL:

- All items noted incidental will not be paid for separately.

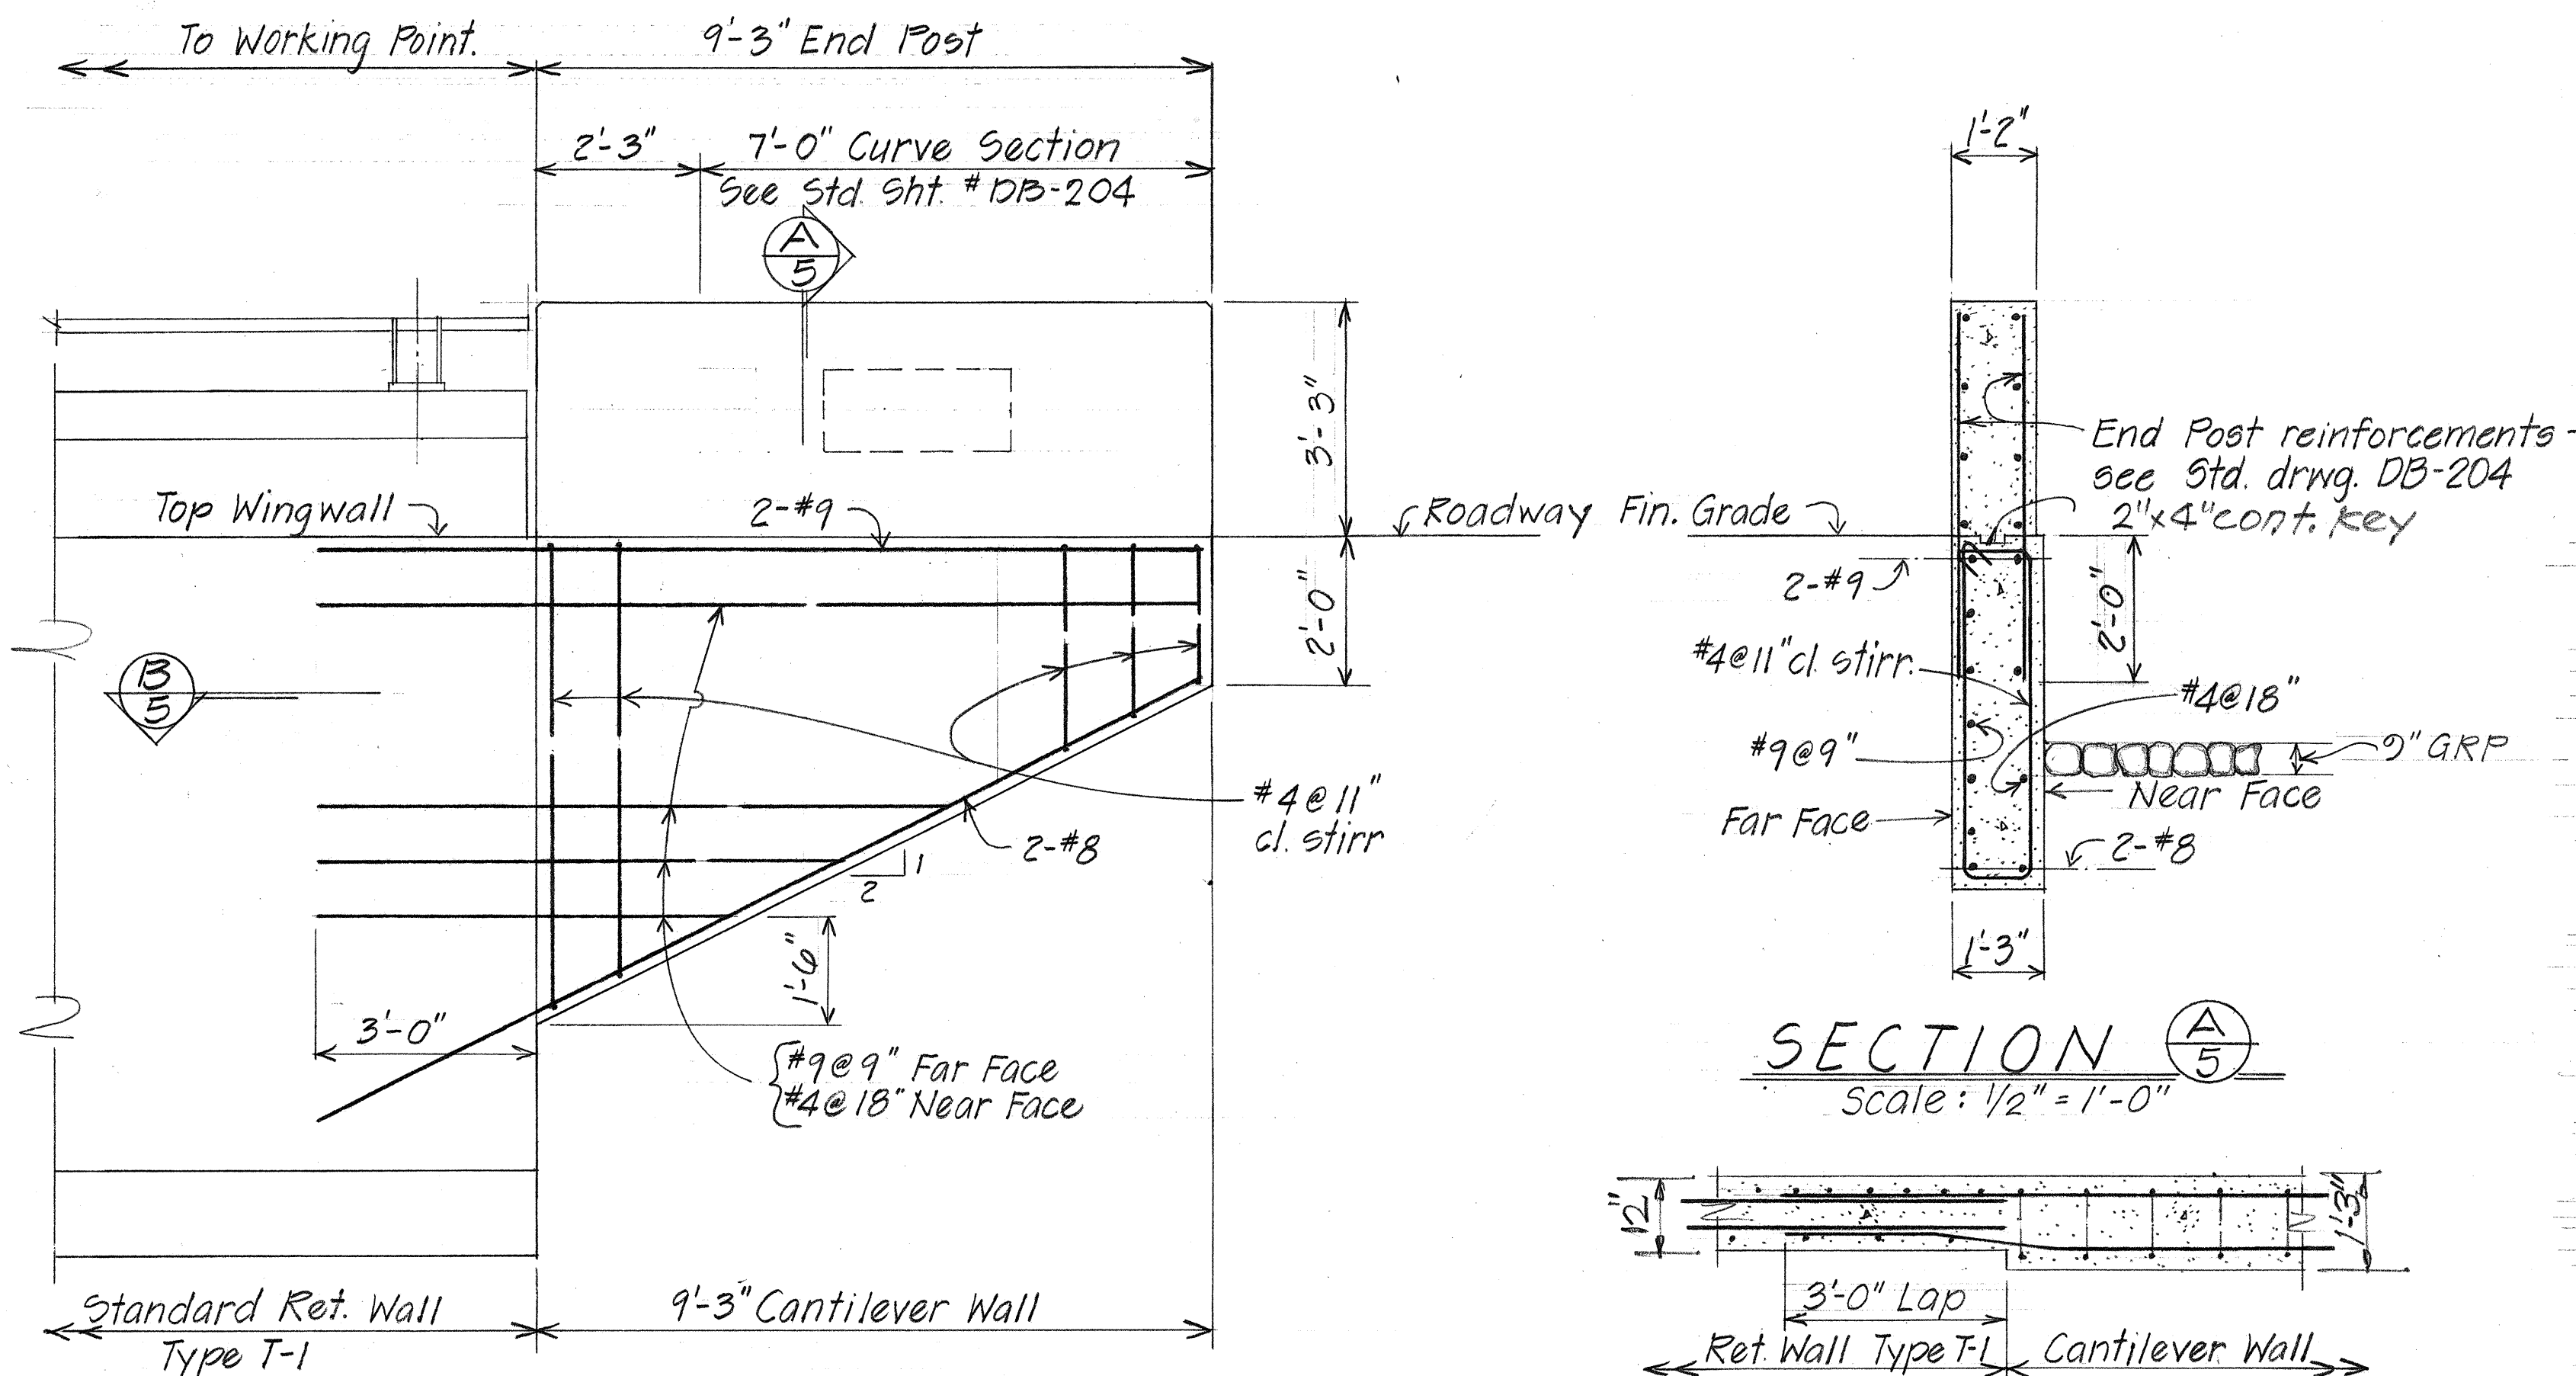

TYPICAL CANTILEVER WINGWALL DETAIL AND REINFORCEMENT-(DEVELOPED)

Scale: $\frac{1}{2}'' = 1'-0''$

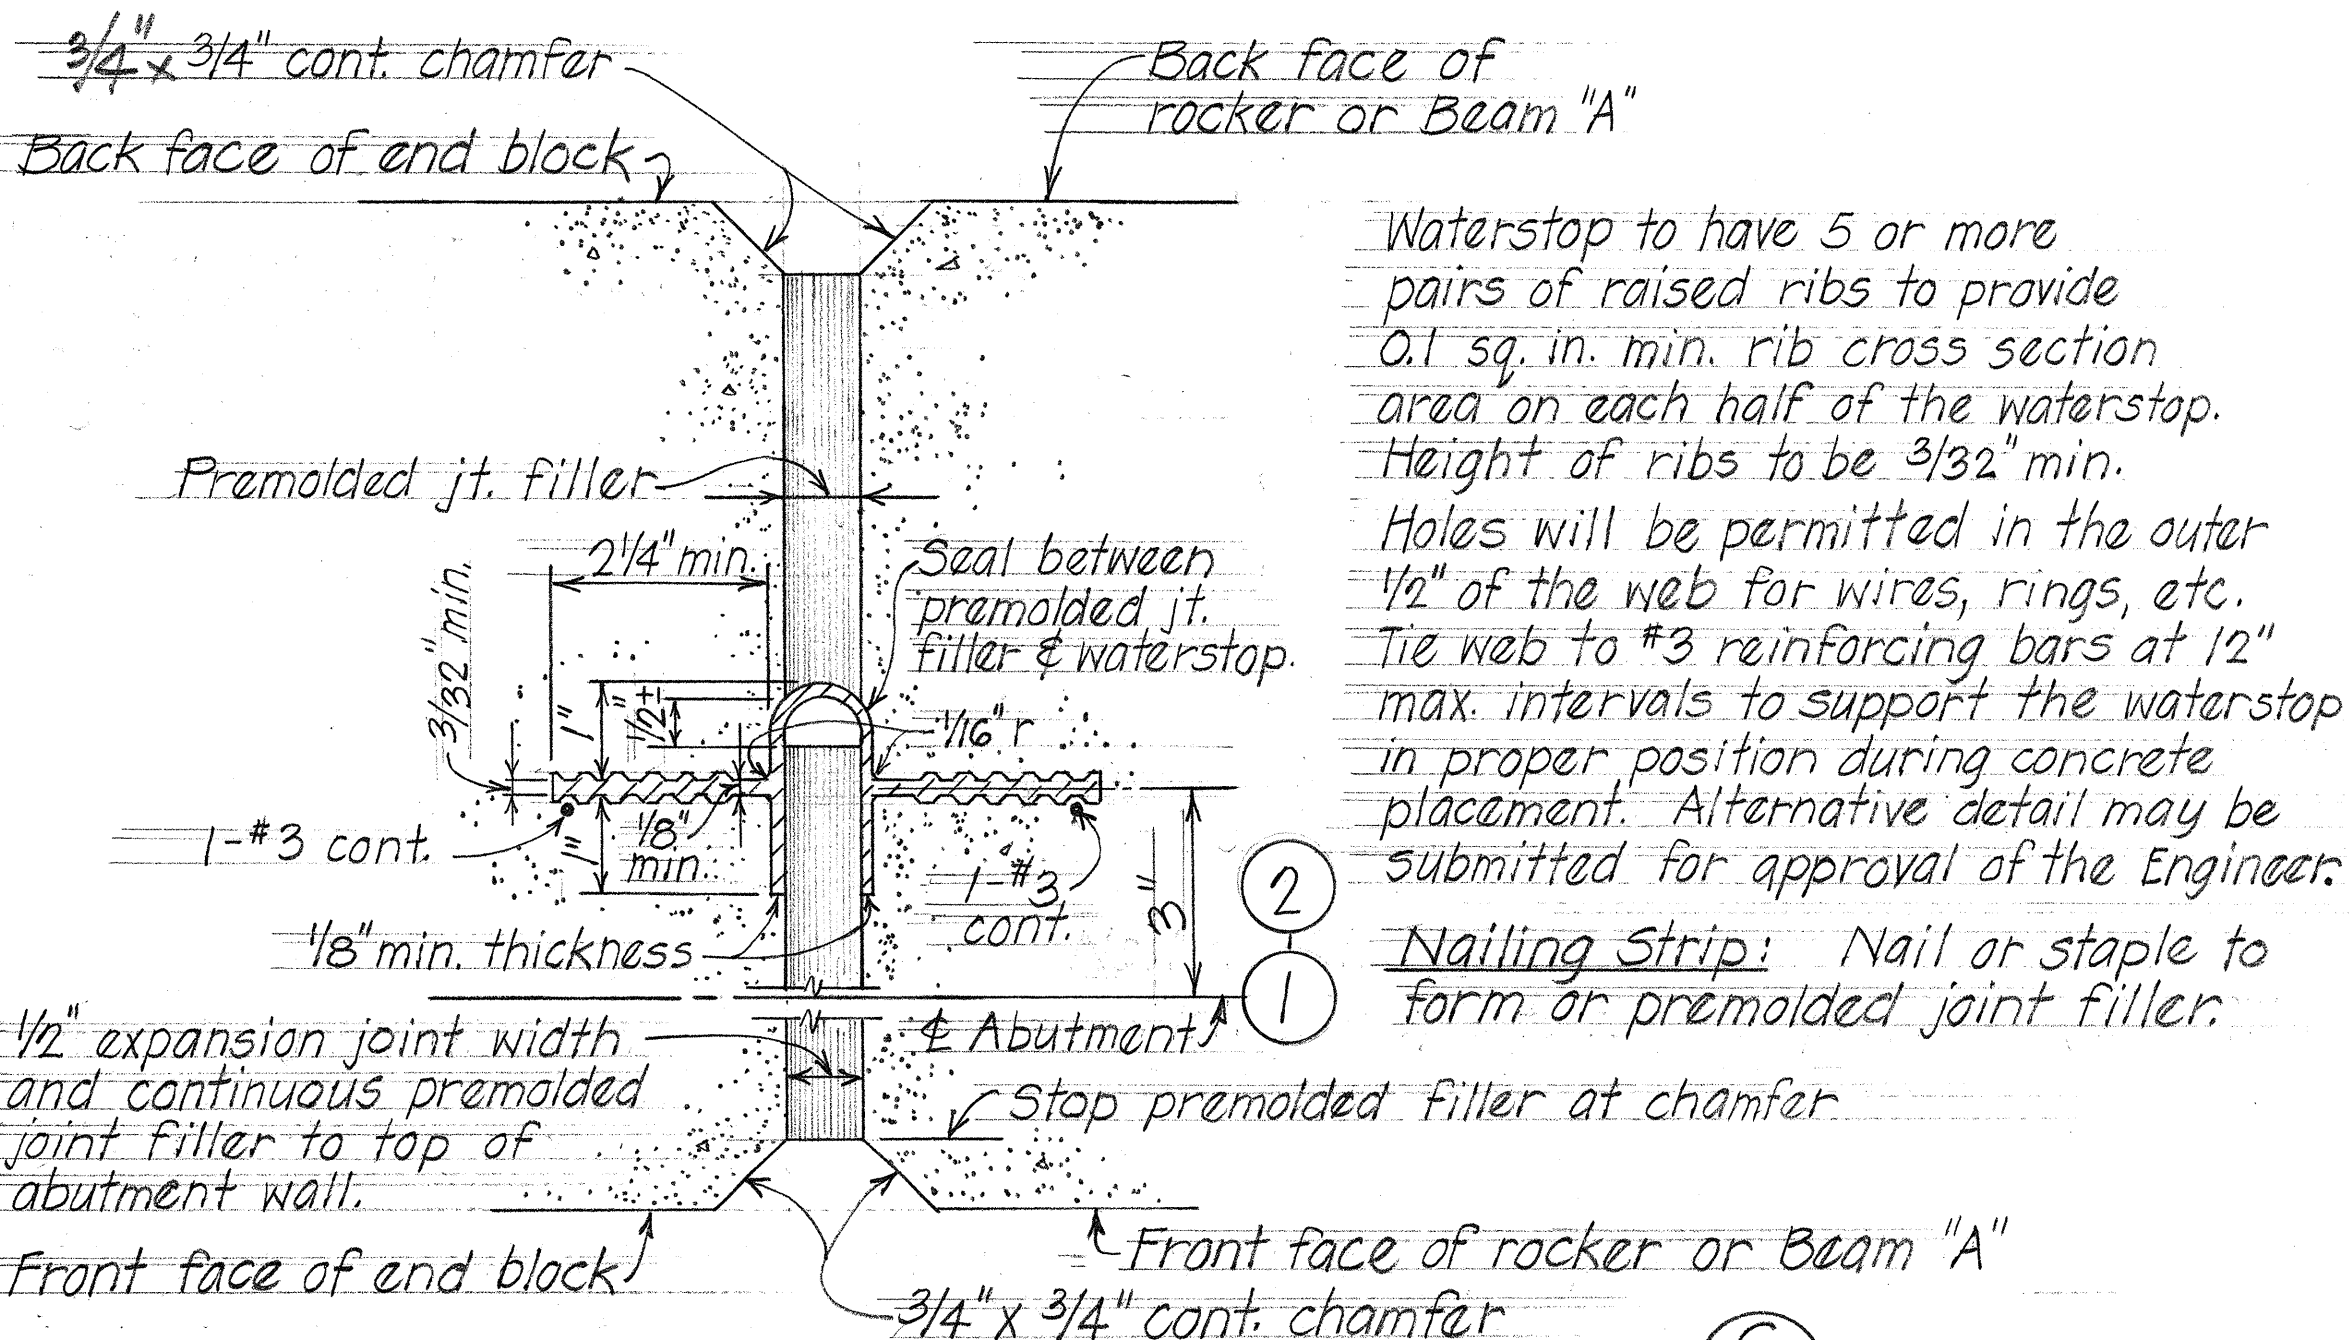


TYPICAL EXPANSION JOINT DETAIL

STATE OF HAWAII
DEPARTMENT OF TRANSPORTATION
HIGHWAYS DIVISION
GOLF COURSE SEPARATION
TYPICAL ABUTMENT SECTIONS
AND DETAILS - GENERAL NOTES


Leilehua Interchange
F.A.I. Proj. No. I-H2-1(8):6 January, 1973

SHEET No. 5 OF 20 SHEETS


FED. ROAD DIST. NO.	STATE	FED. AID PROJ. NO.	FISCAL YEAR	SHEET NO.	TOTAL SHEETS
HAWAII	HAW.	I-H2-1(8)-G	1973	125	100

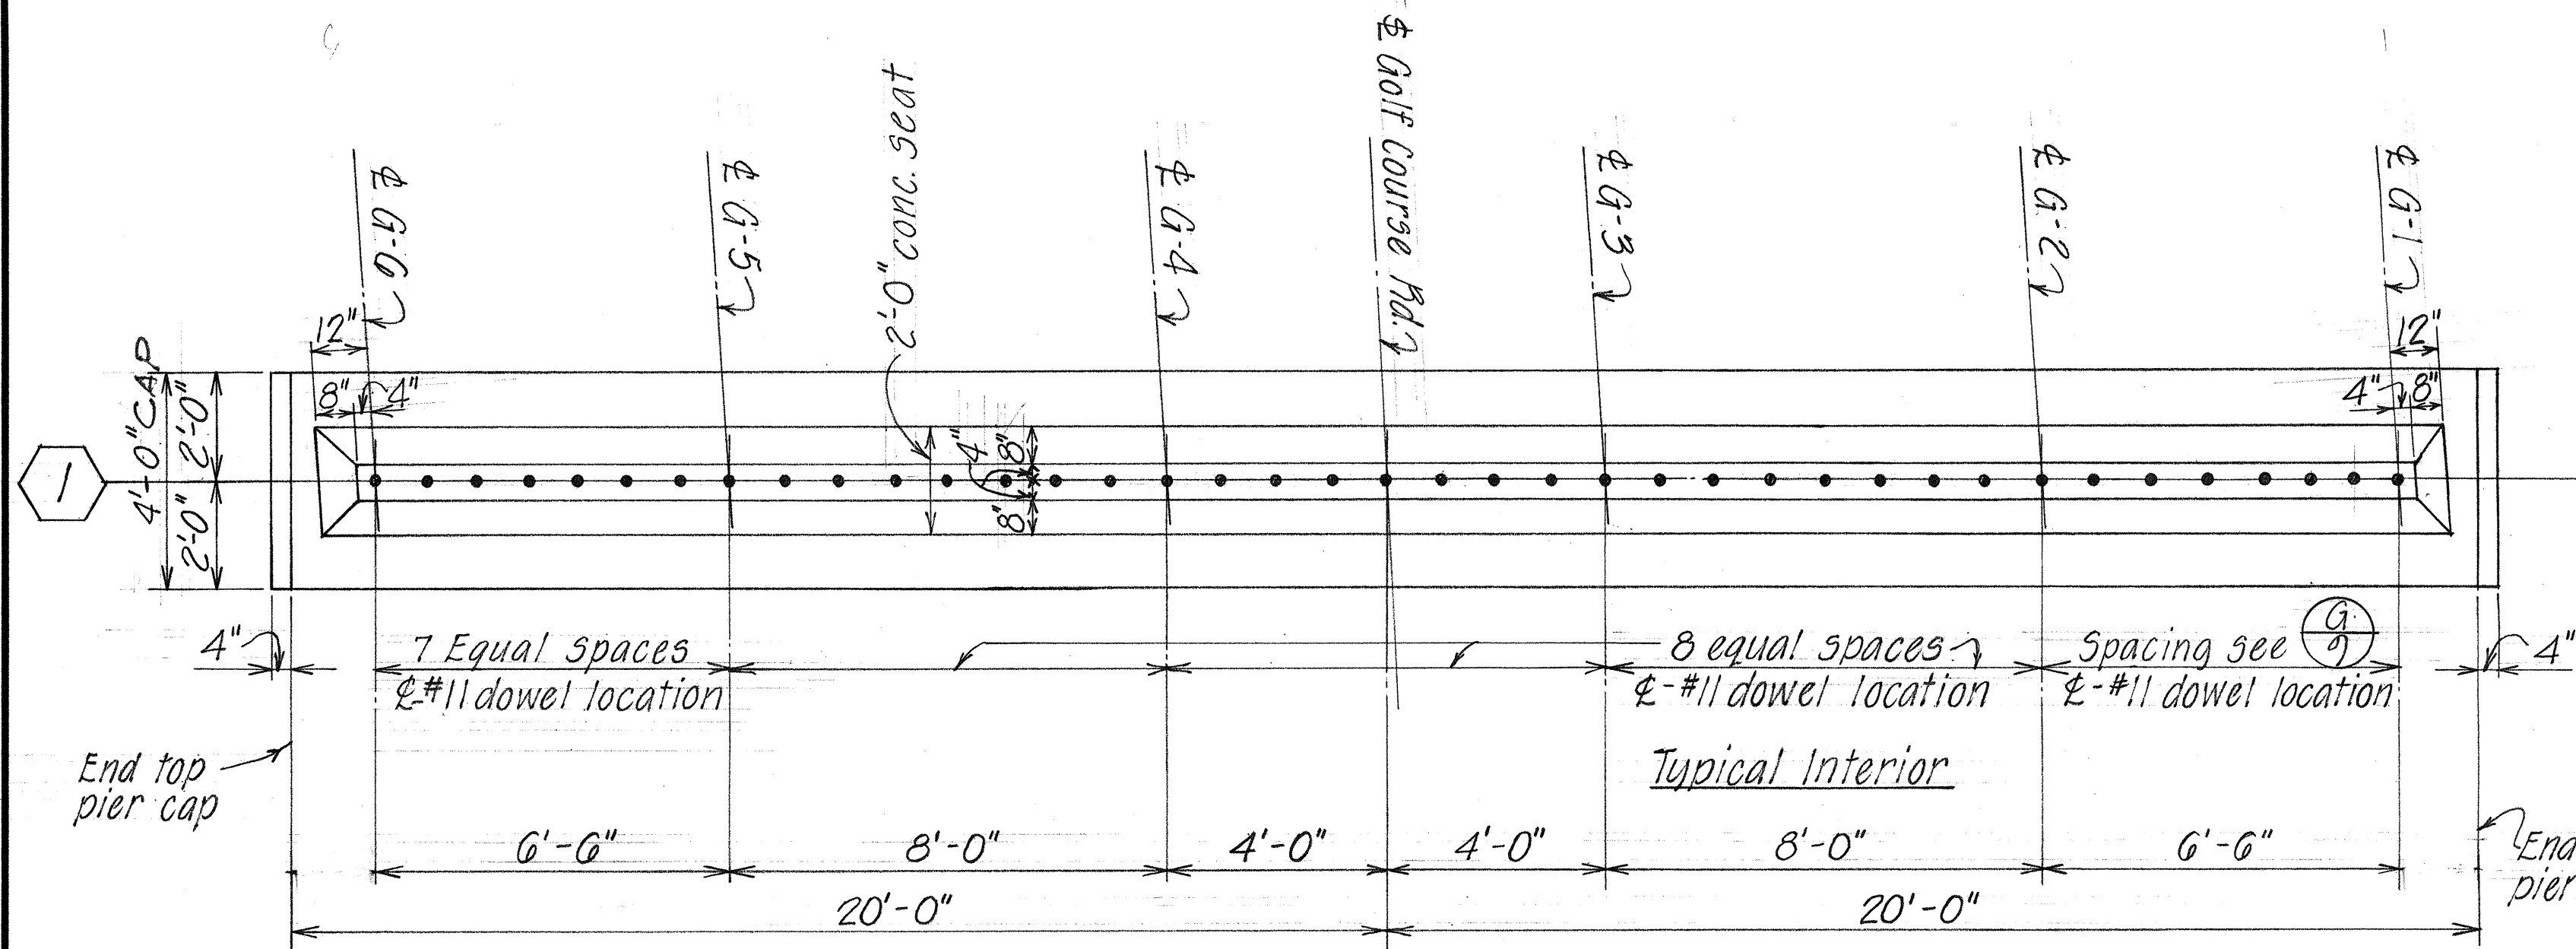


PLAN - PIER CAP
Scale: 3/8" = 1'-0"

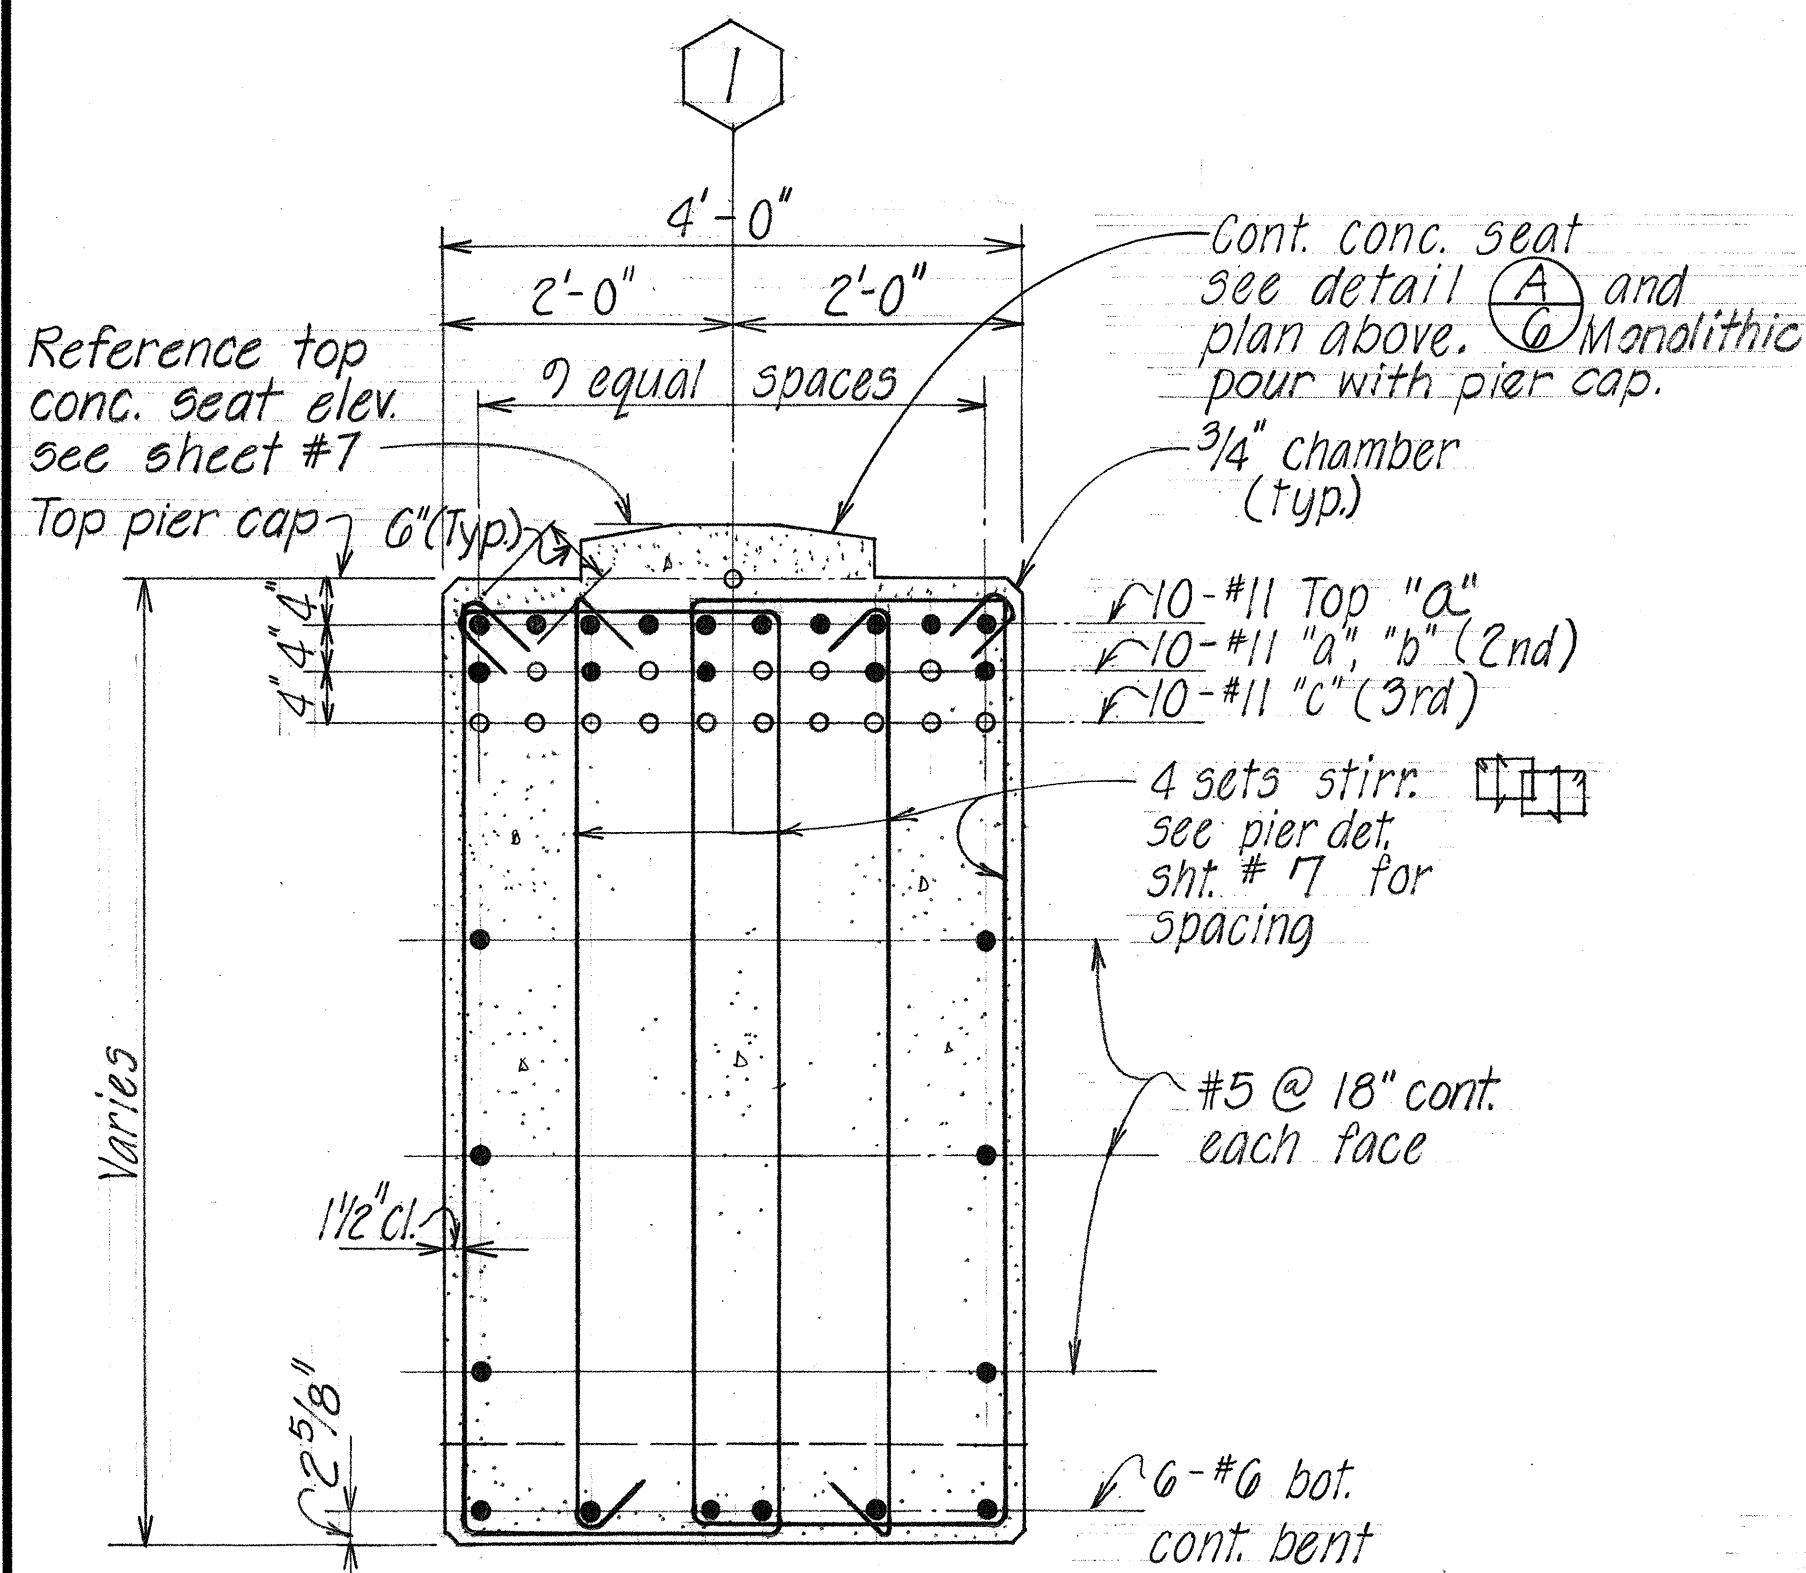


TYPICAL SECTION
Scale: 3/4" = 1'-0"

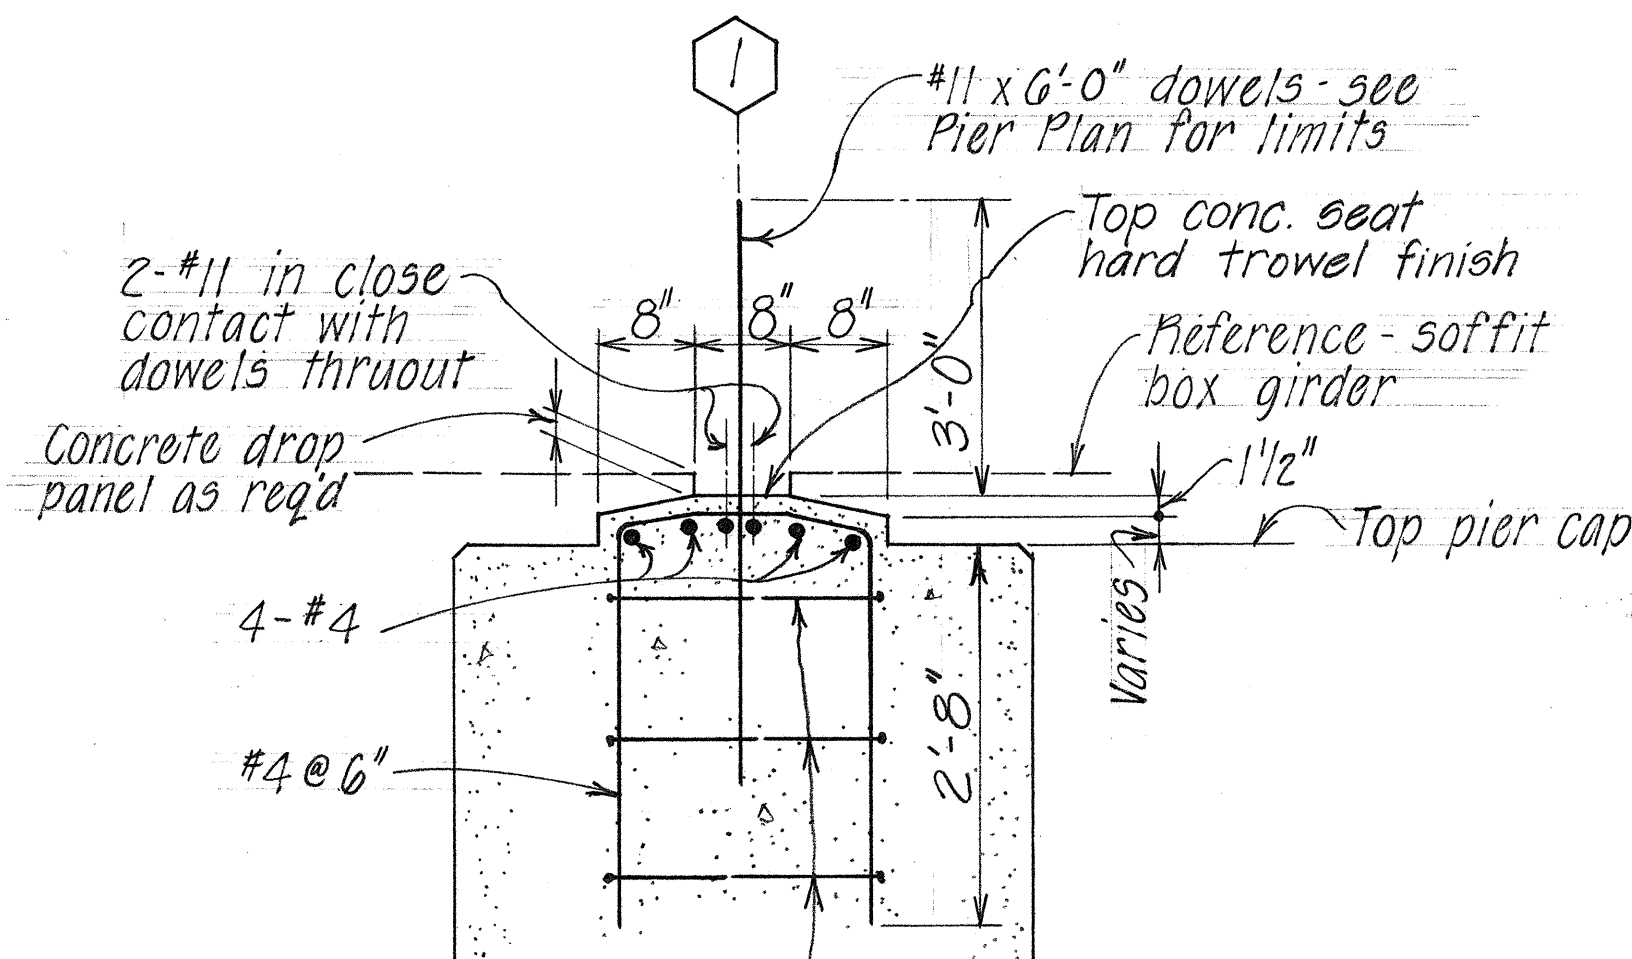

CONCRETE SEAT DETAIL
Scale: 3/4" = 1'-0"

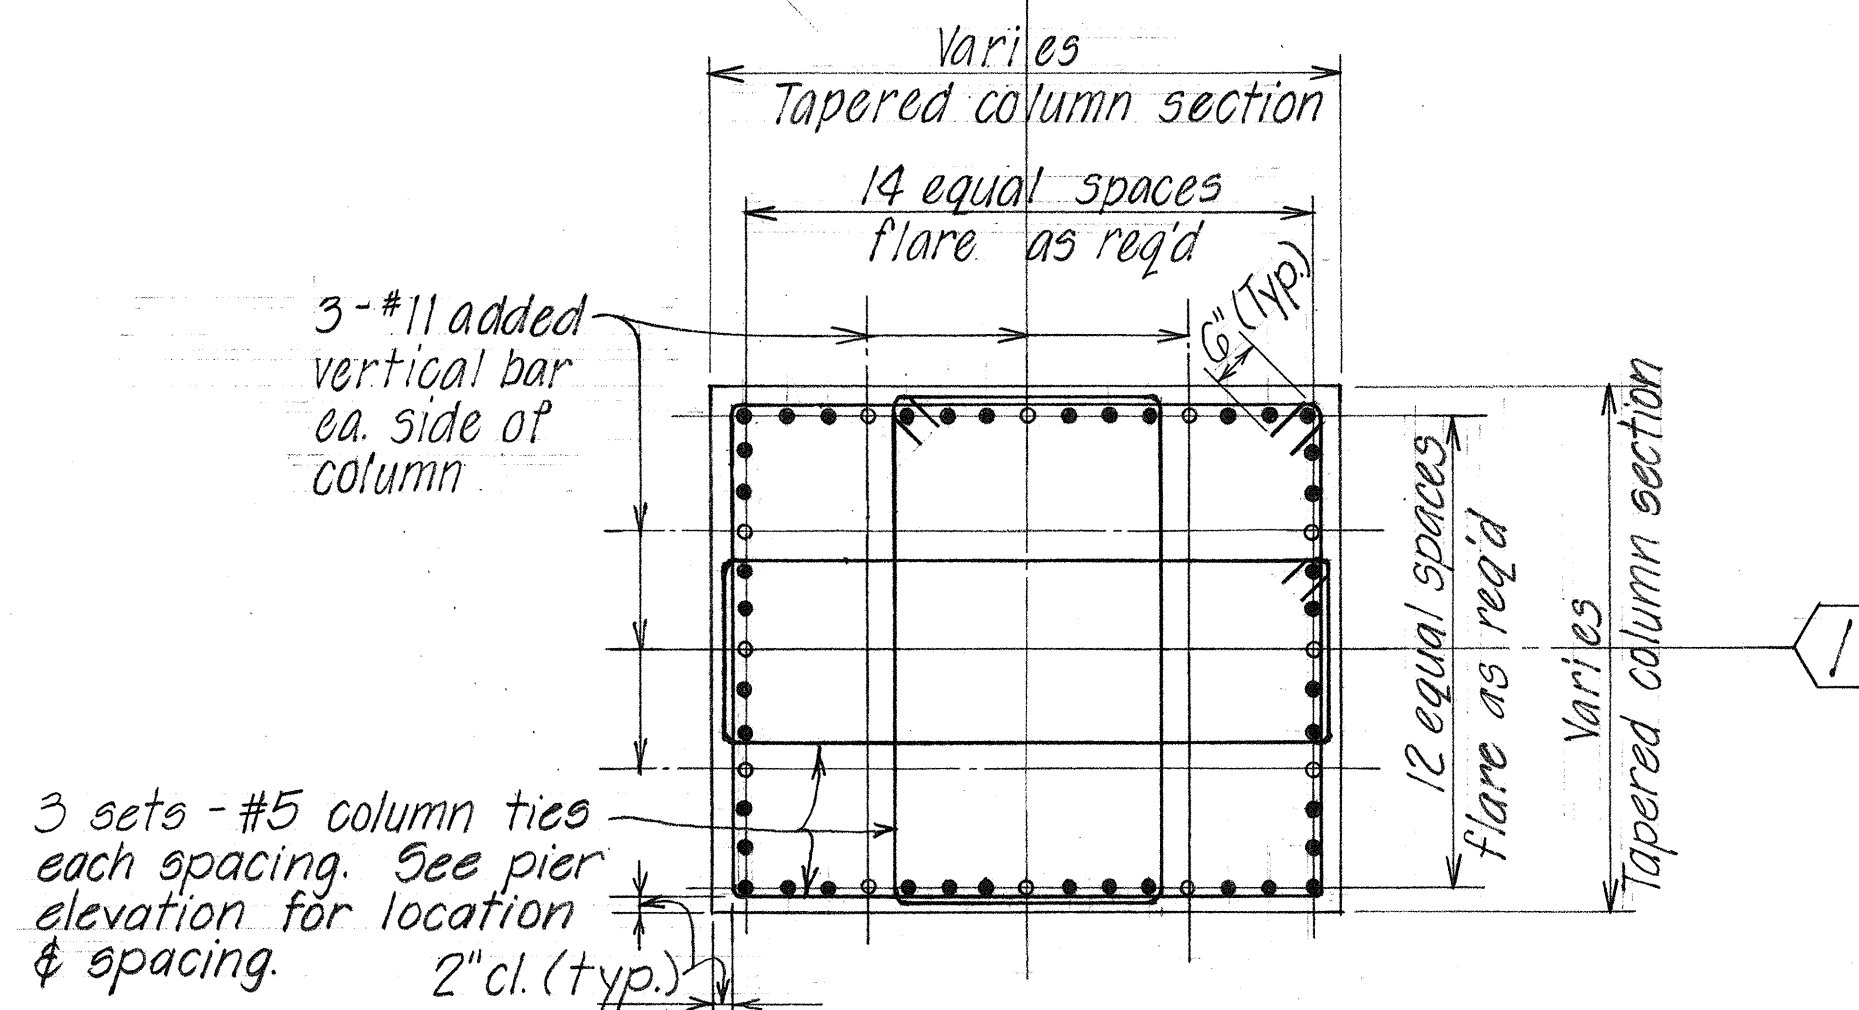

TYPICAL TAPERED COLUMN SECTION
Scale: 1/2" = 1'-0"




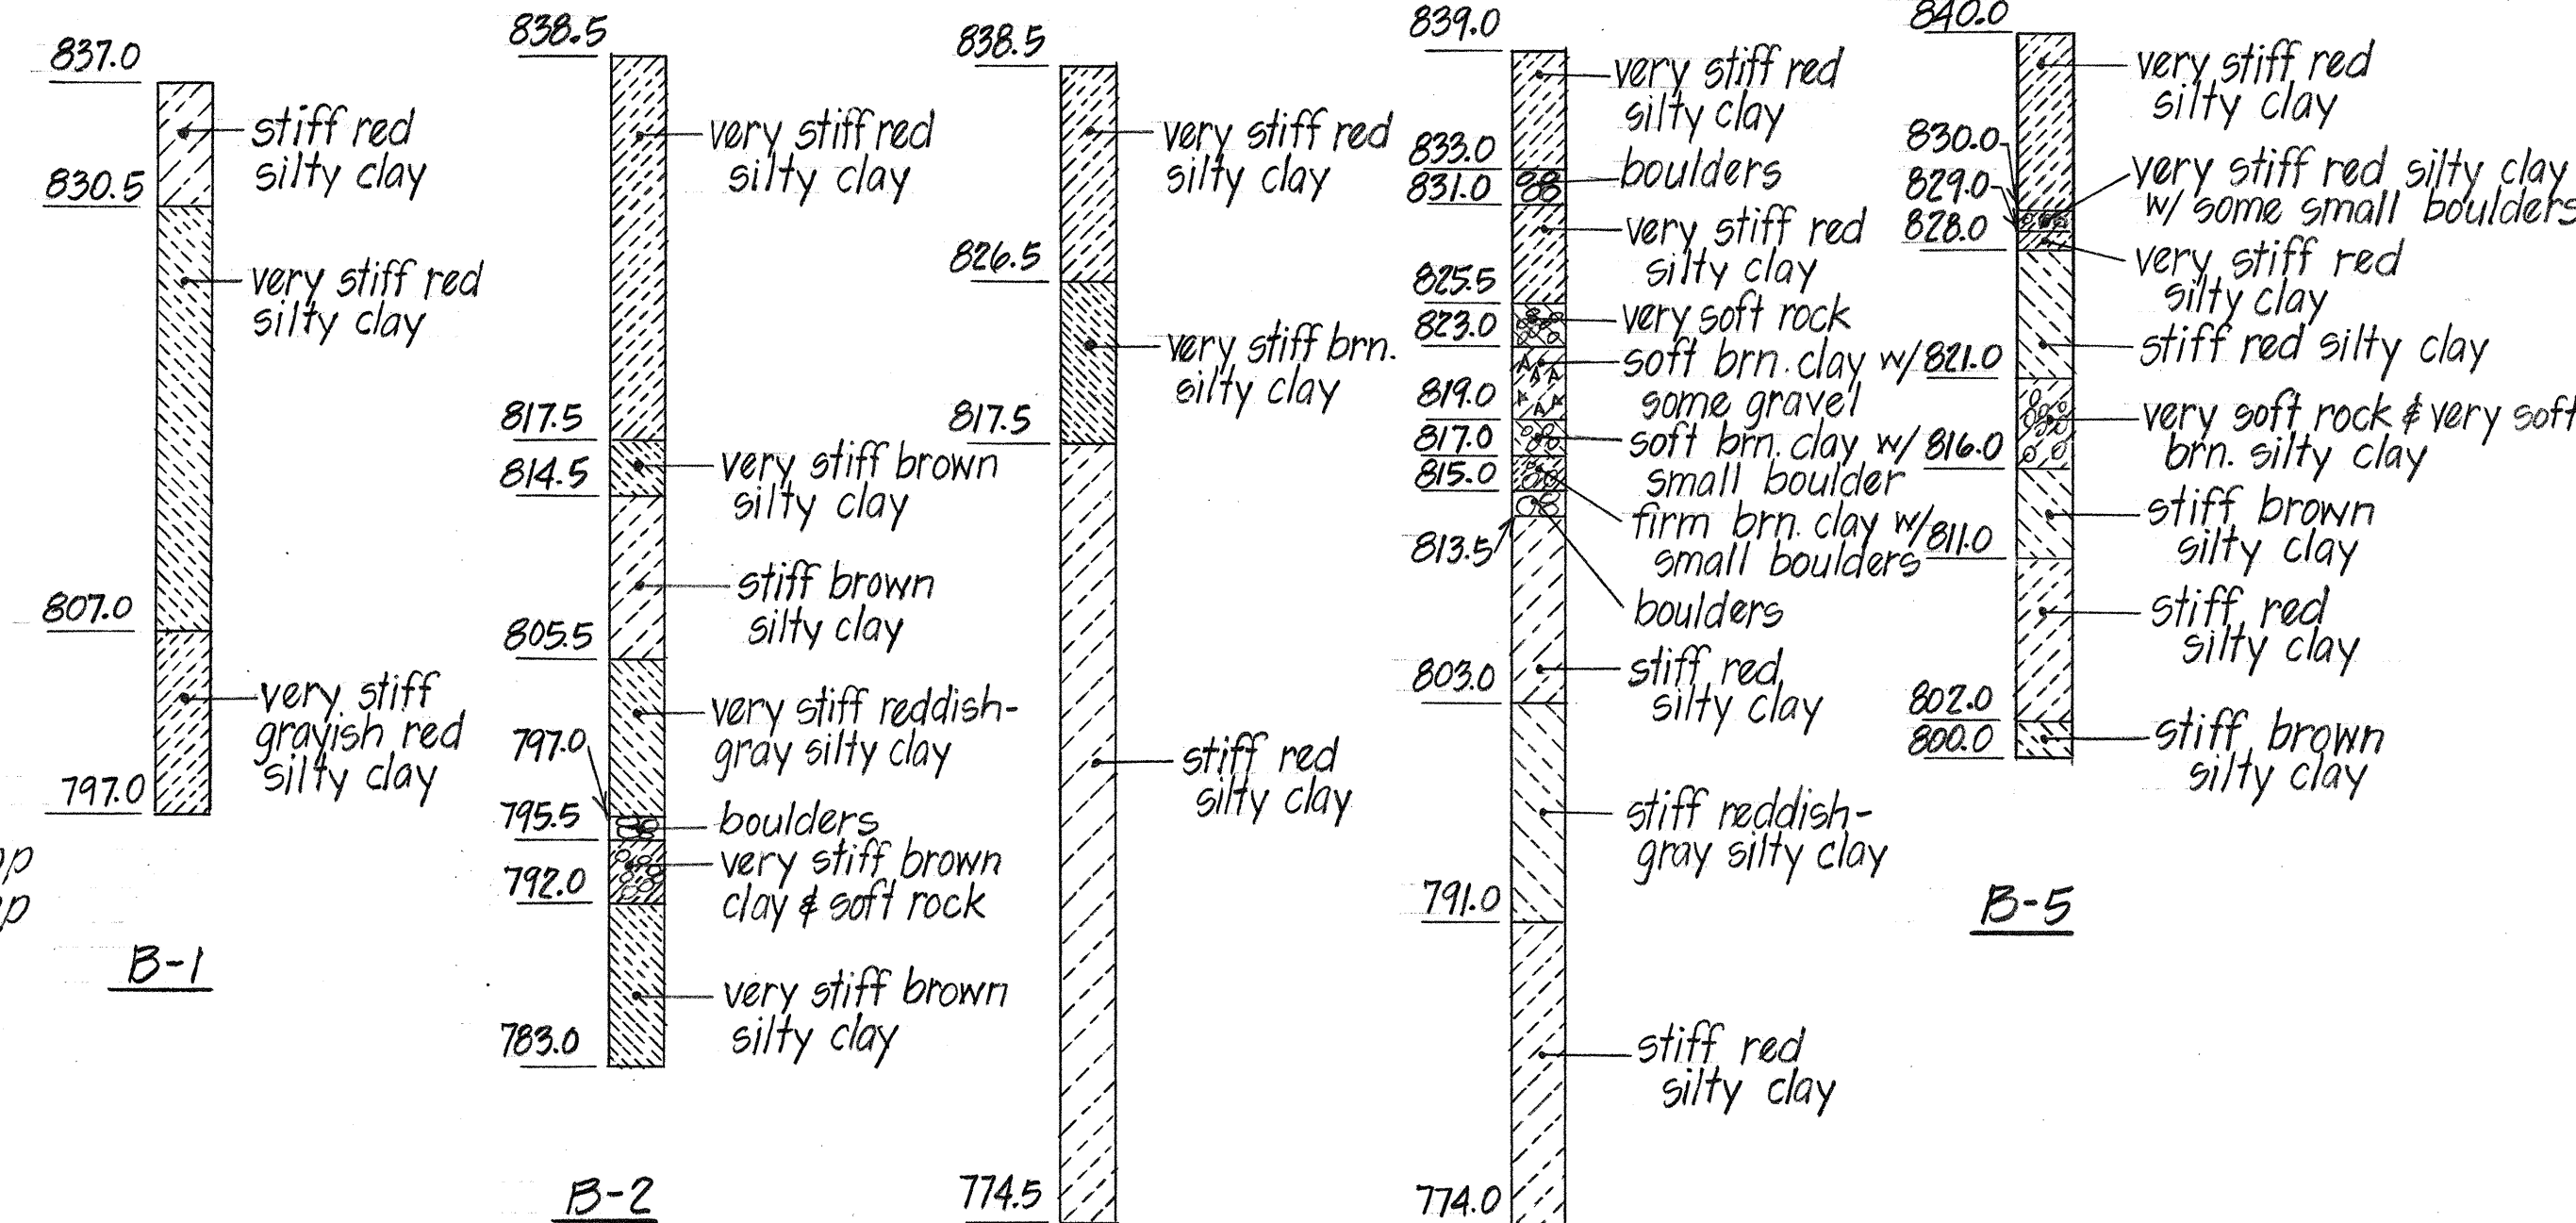


BORING LOG FOR GOLF COURSE INTERCHANGE
SCALE 1" = 10'-0"

DATE	7/13
DESIGNED BY	U.T.
CHECKED BY	U.T.
NO.	60

STATE OF HAWAII
DEPARTMENT OF TRANSPORTATION
HIGHWAYS DIVISION
GOLF COURSE SEPARATION
PIER DETAILS - BORING LOGS
Leilehua Interchange
F.A.I. Proj. No. I-H2-1(8)-G January, 1973
SHEET No. 6 OF 20 SHEETS


FED. ROAD DIST. NO.	STATE	FED. AID PROJ. NO.	FISCAL YEAR	SHEET NO.	TOTAL SHEETS
HAWAII	HAW.	I-H2-1(8)-6	1973	127	160

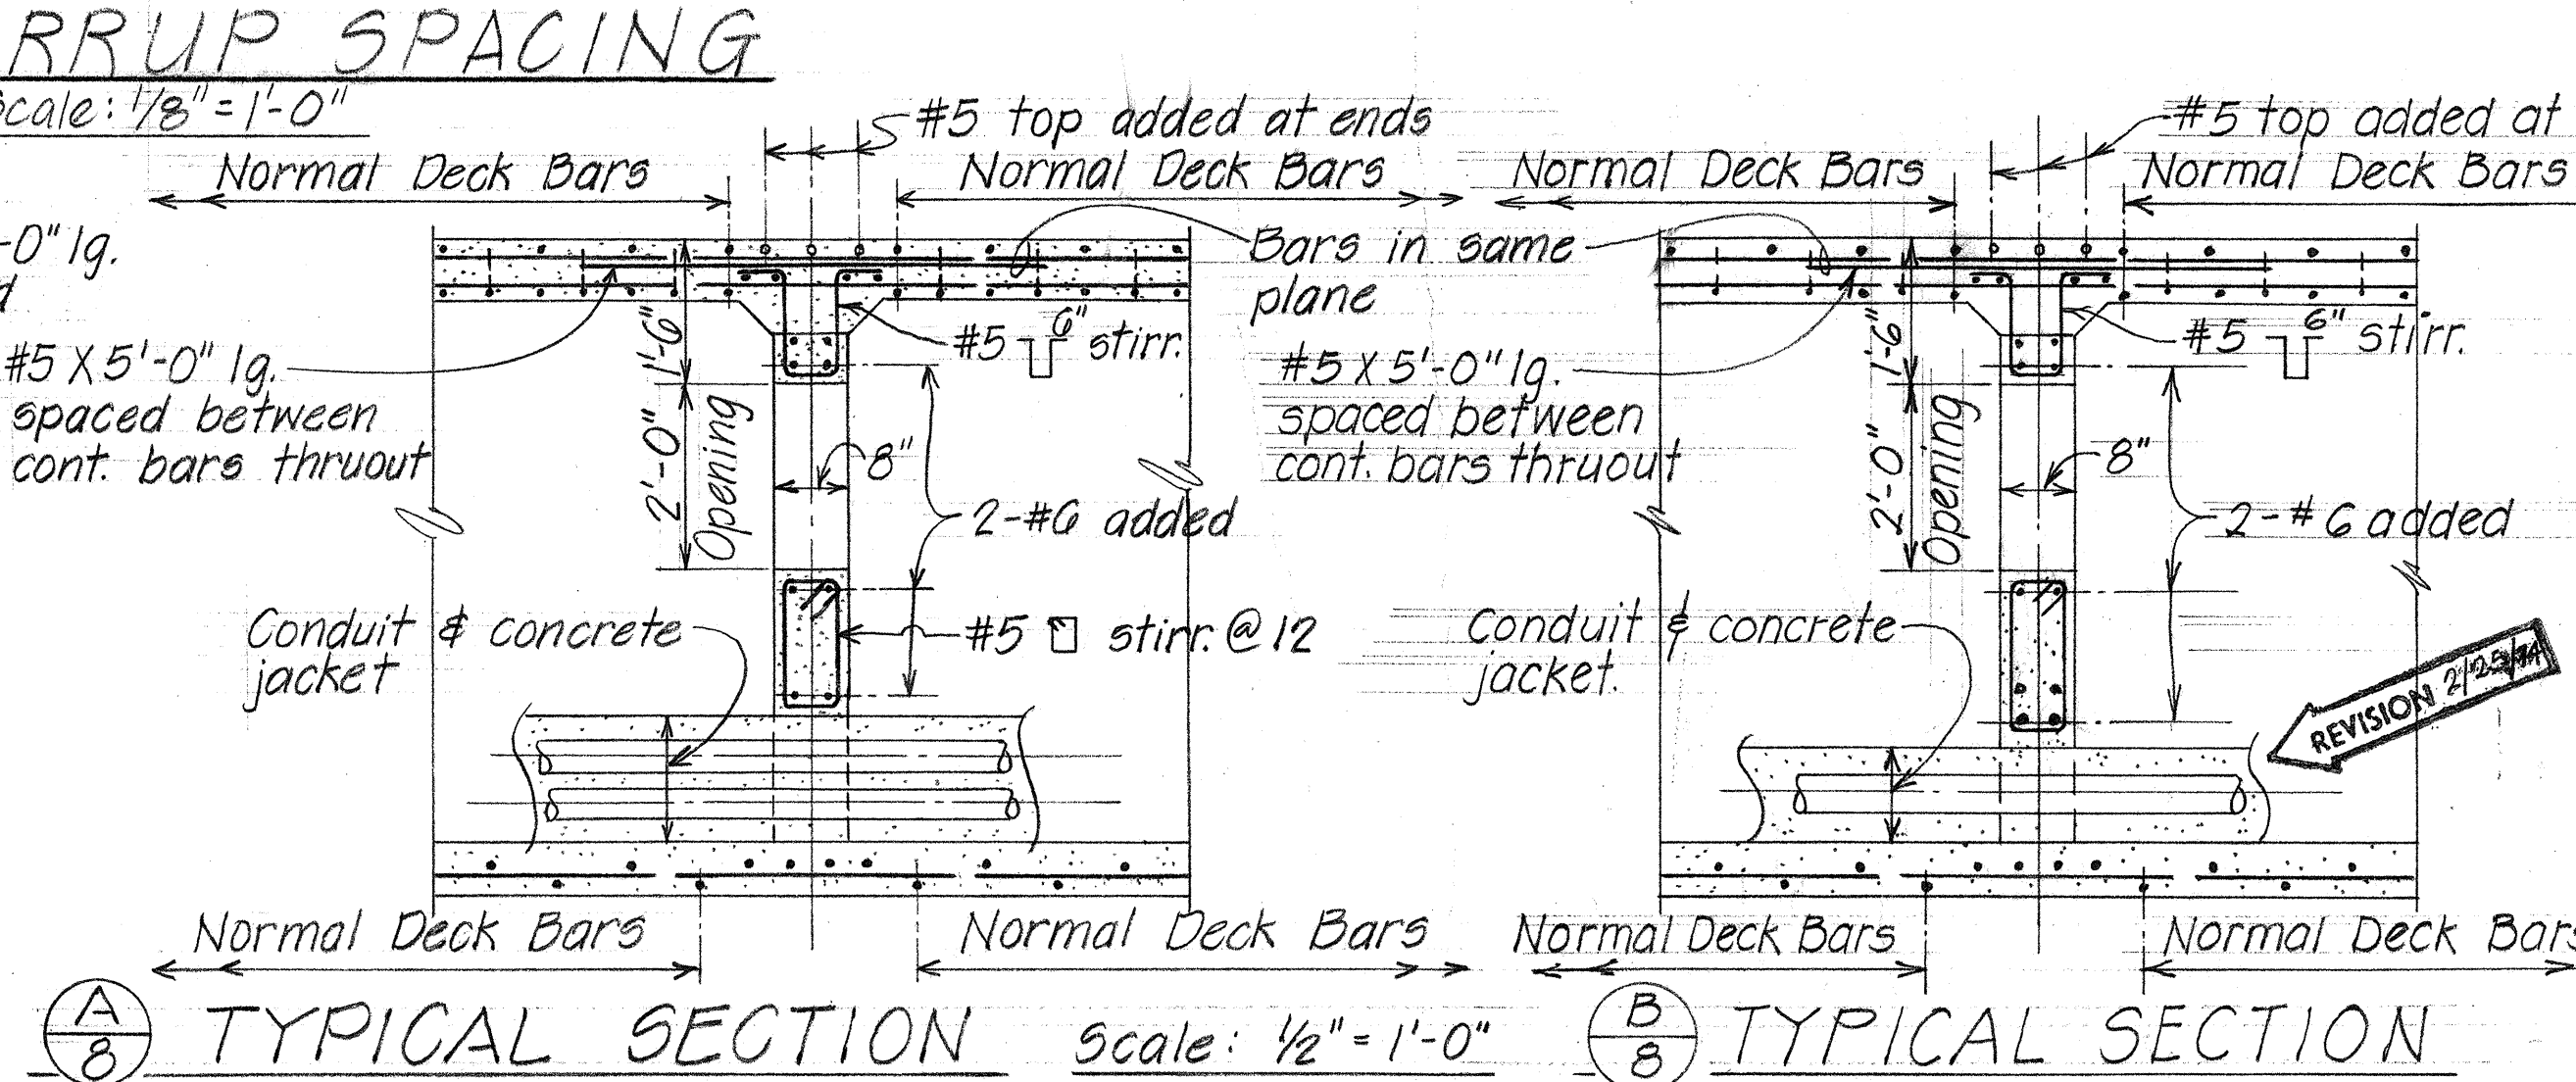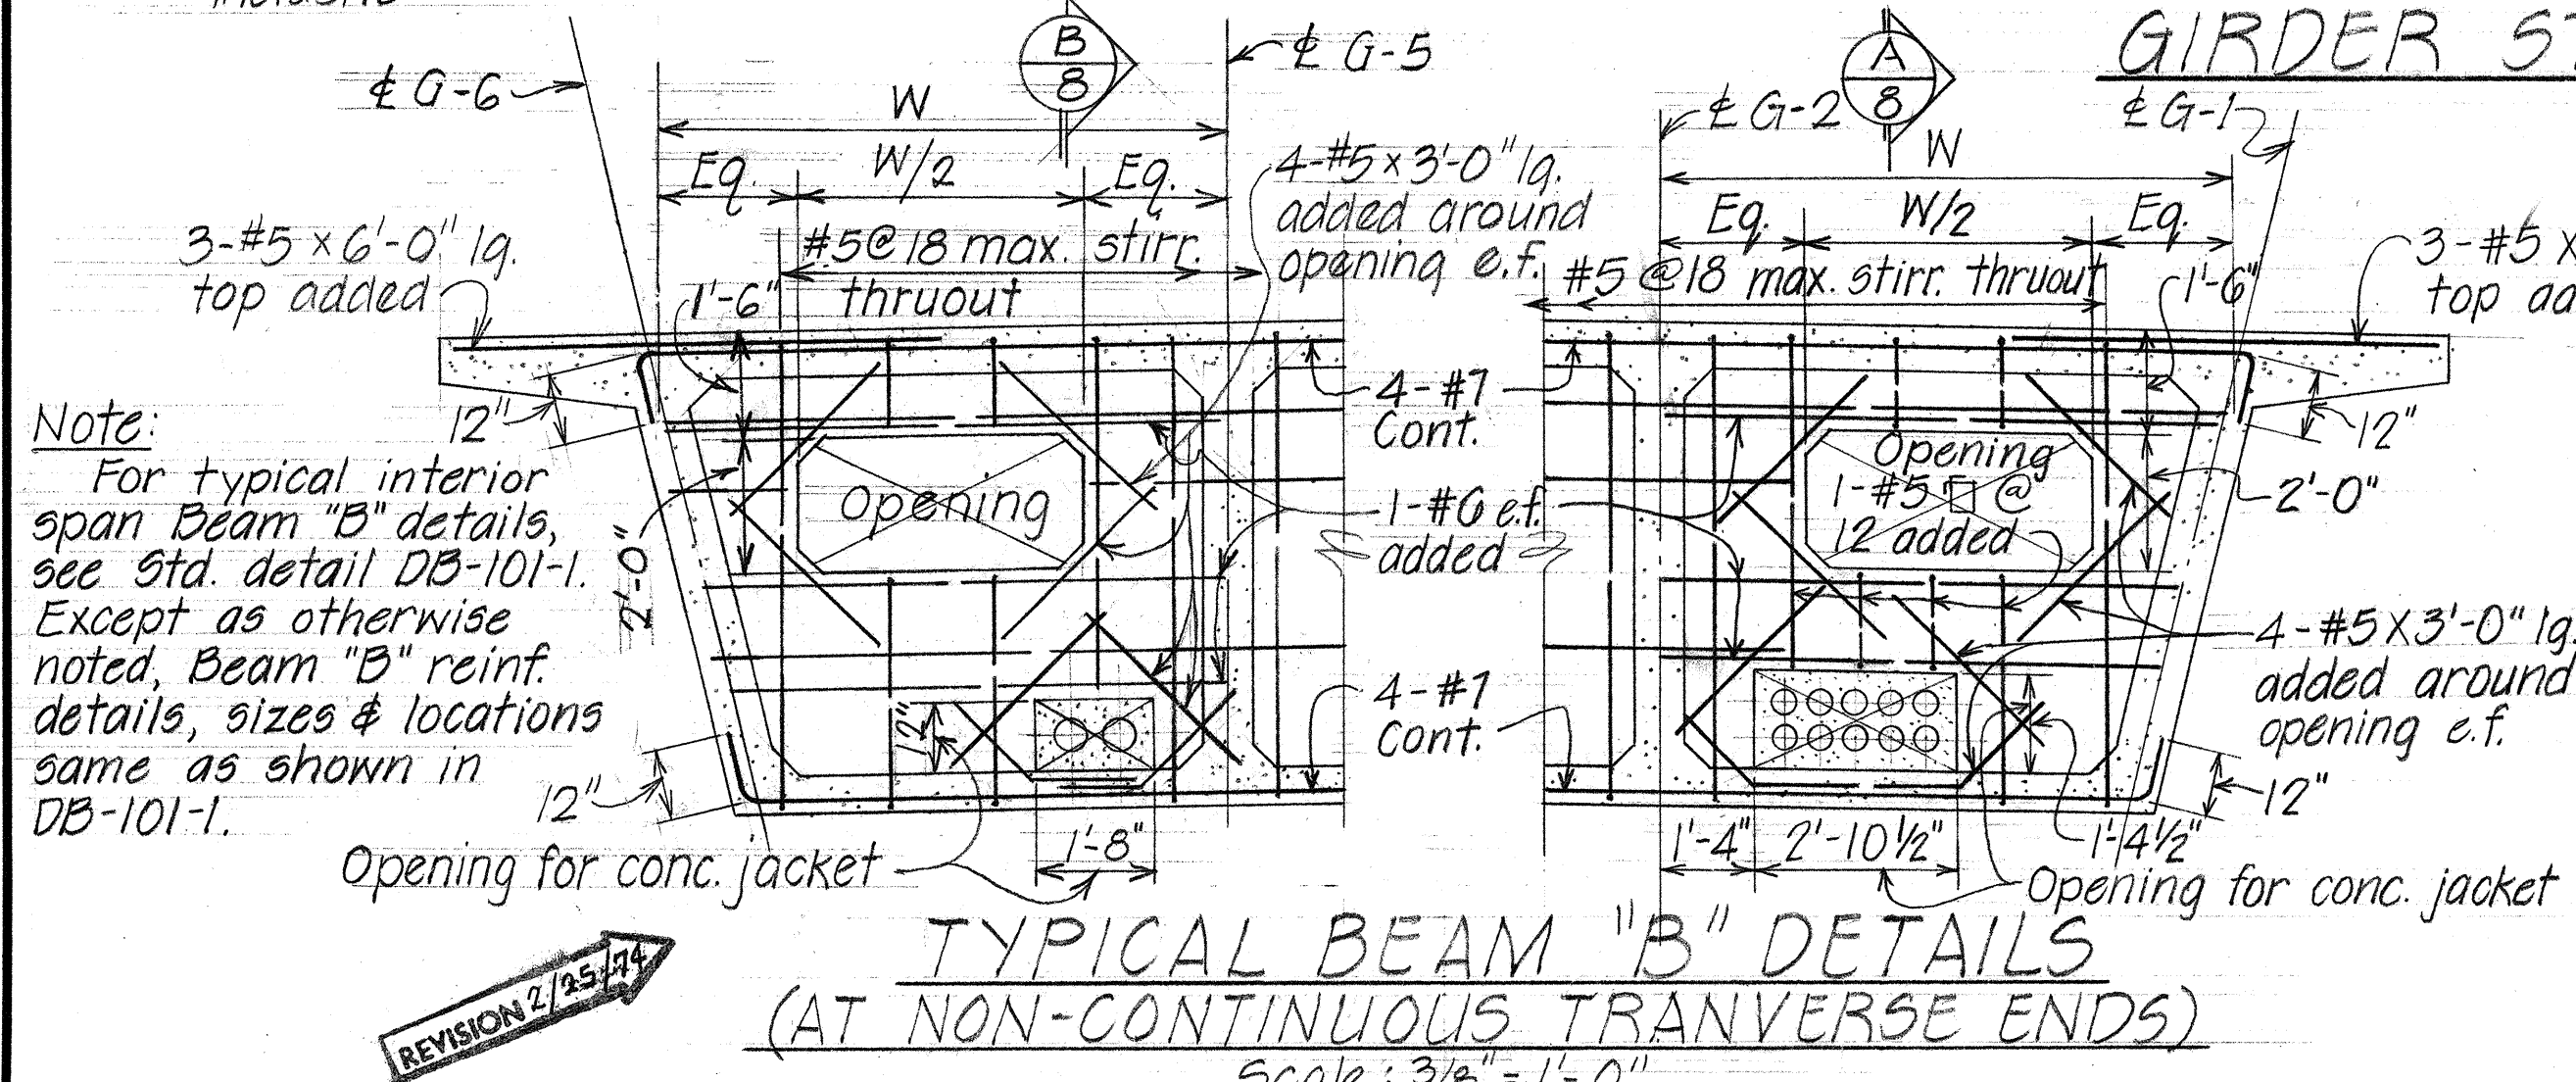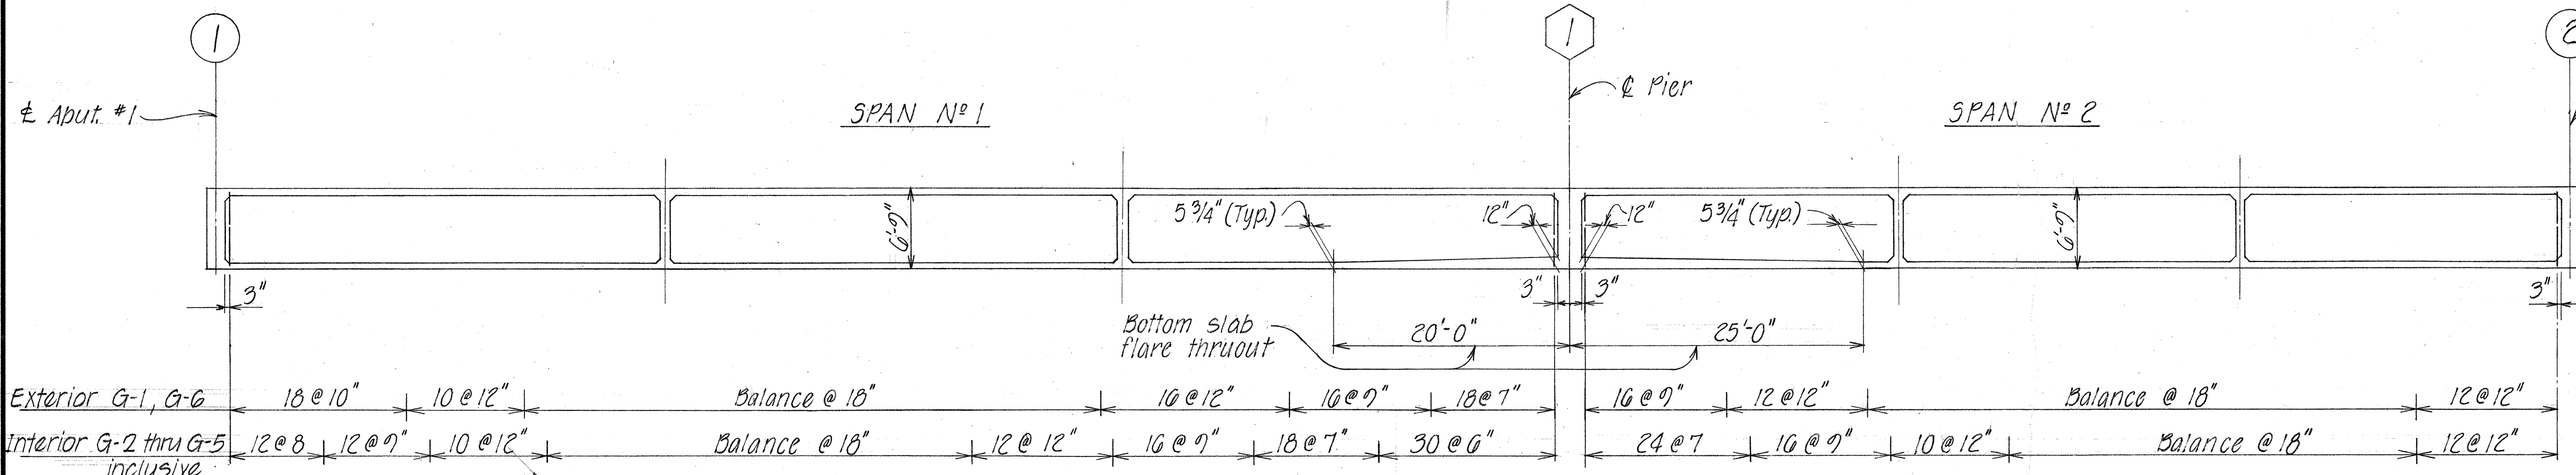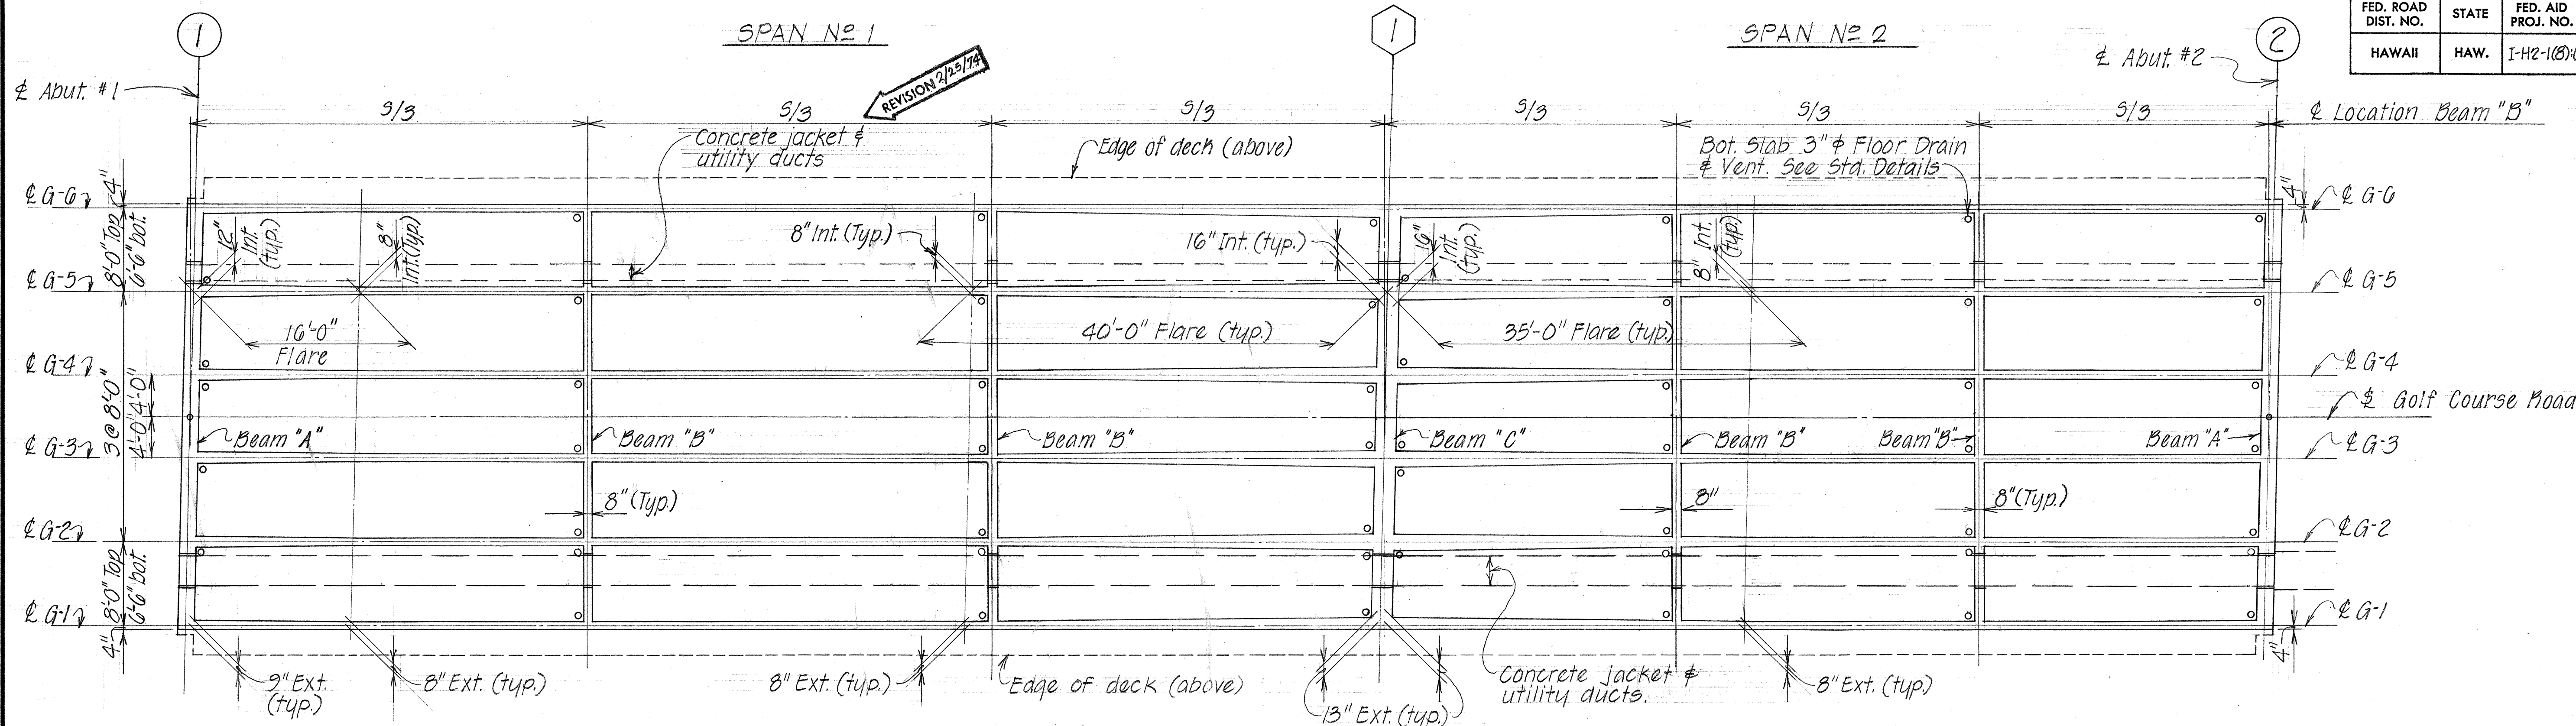


2/25/74	Added - 2 HECO conduits & conc. jacket between G-5 - G-6
Date	Revision
STATE OF HAWAII DEPARTMENT OF TRANSPORTATION HIGHWAYS DIVISION GOLF COURSE SEPARATION DECK FRAMING PLAN AND DETAILS Leilehua Interchange F.A.I. Proj. No. I-H2-1(8)-6 January, 1973 SHEET No. 8 OF 20 SHEETS	

ORIGINAL PLAN	DATE	3/7/73
DRAWN BY	LM LN	
DESIGNED BY	MT	
CHECKED BY	LA	
NO.		


FED. ROAD DIST. NO.	STATE	FED. AID PROJ. NO.	FISCAL YEAR	SHEET NO.	TOTAL SHEETS
HAWAII	HAW.	I-H2-1(8)G	1973	128	160

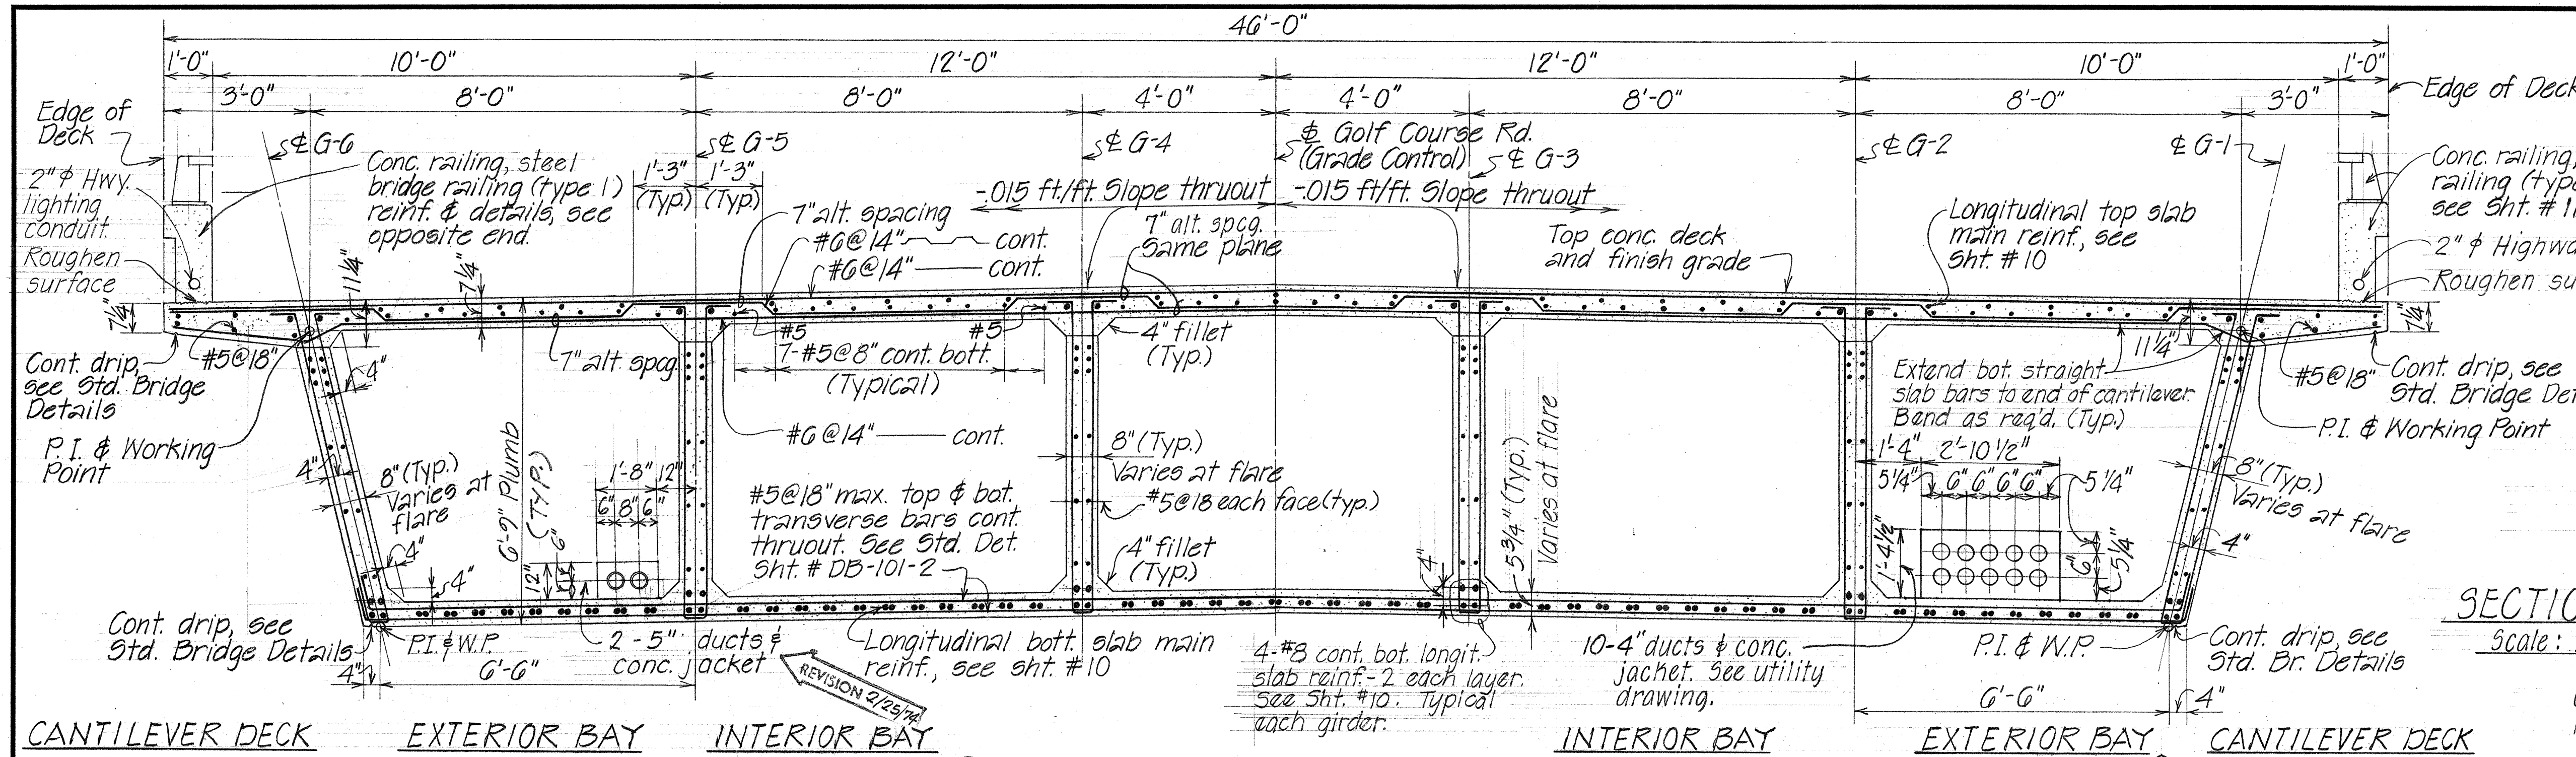


SECTION ①
NORMAL DECK SECTION
Scale: 1/2" = 1'-0"

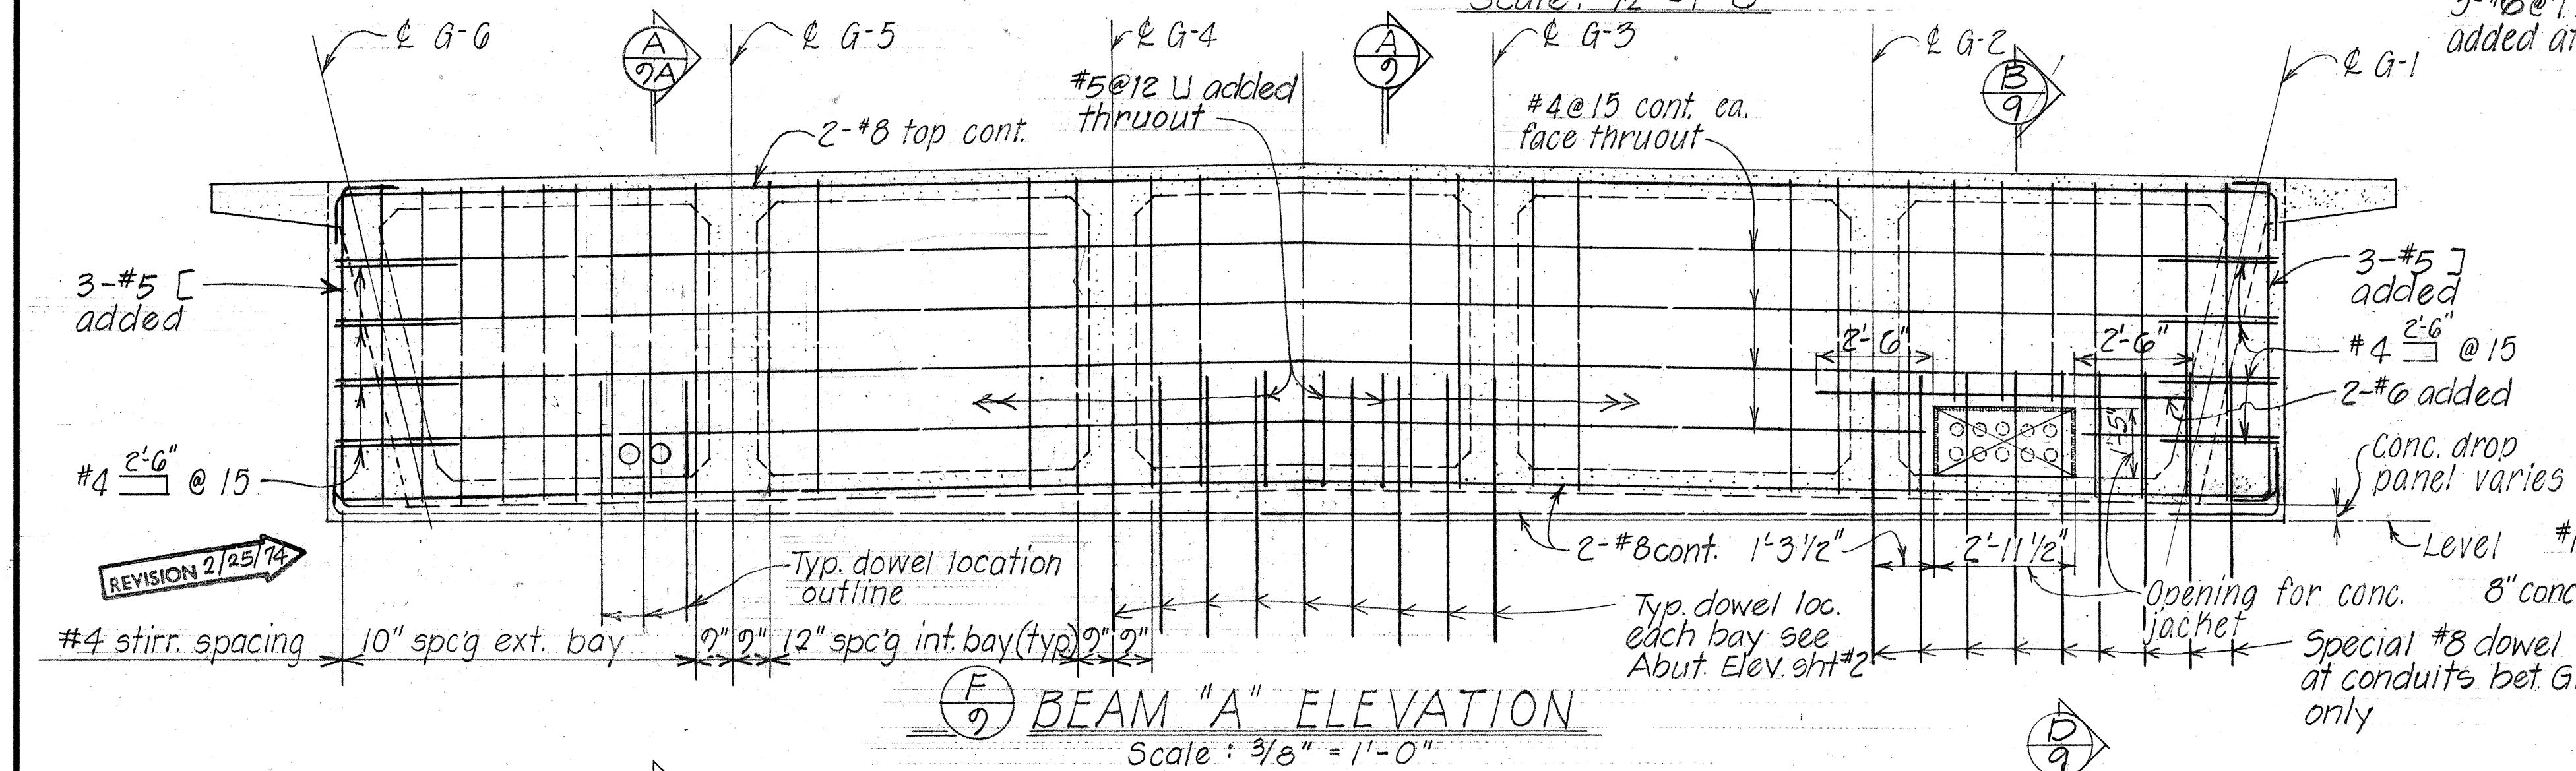


SECTION ②
BEAM "A" ELEVATION
Scale: 3/8" = 1'-0"

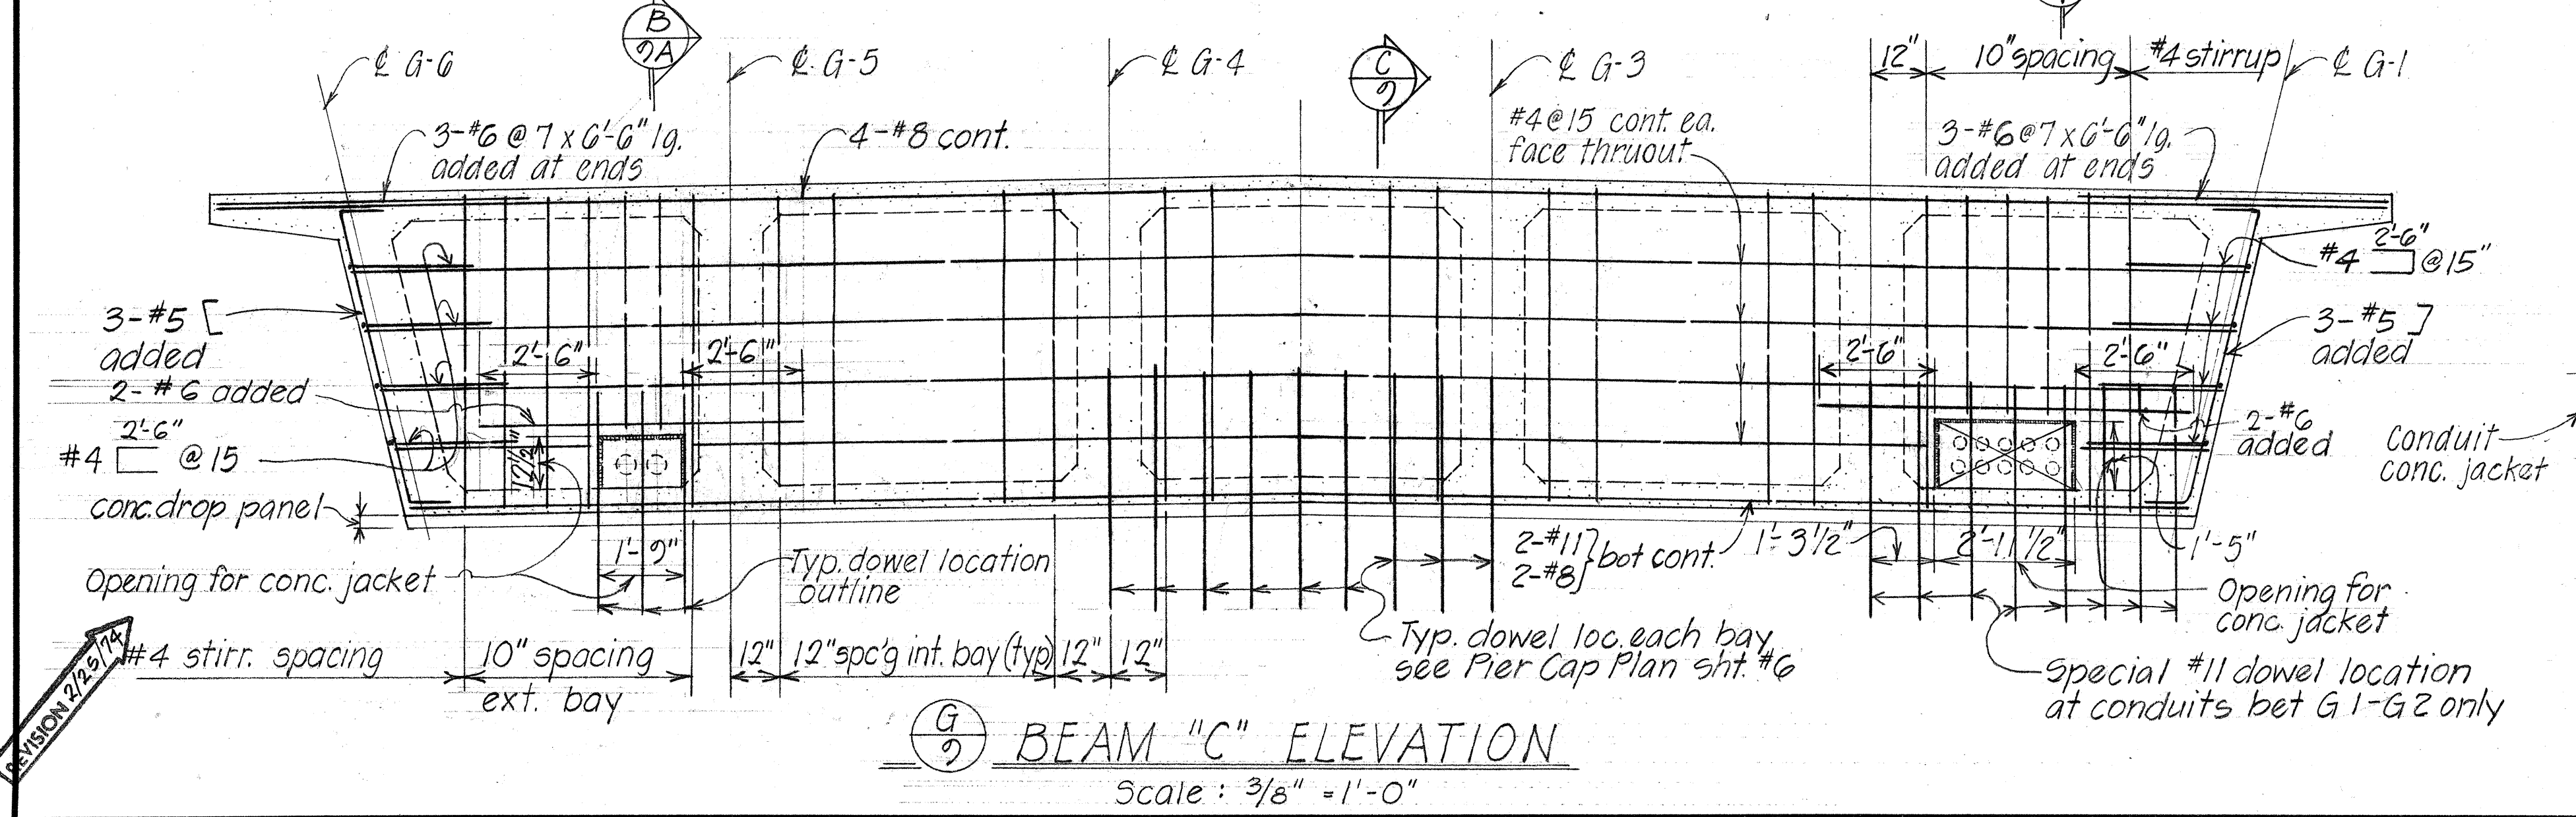


SECTION ③
BEAM "C" ELEVATION
Scale: 3/8" = 1'-0"

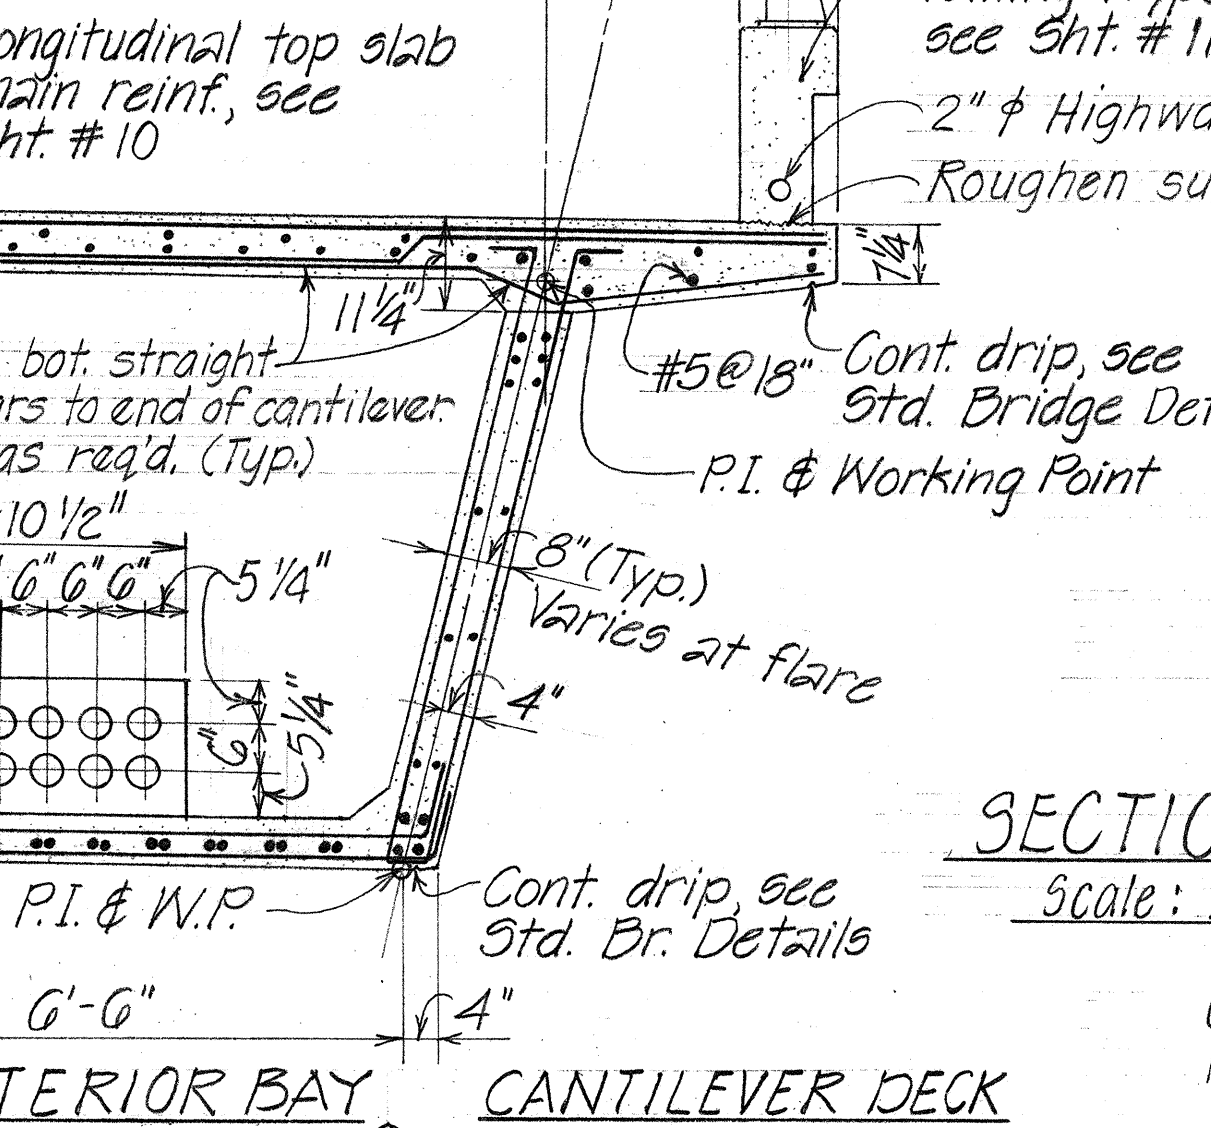



SECTION ④
Scale: 1/2" = 1'-0"

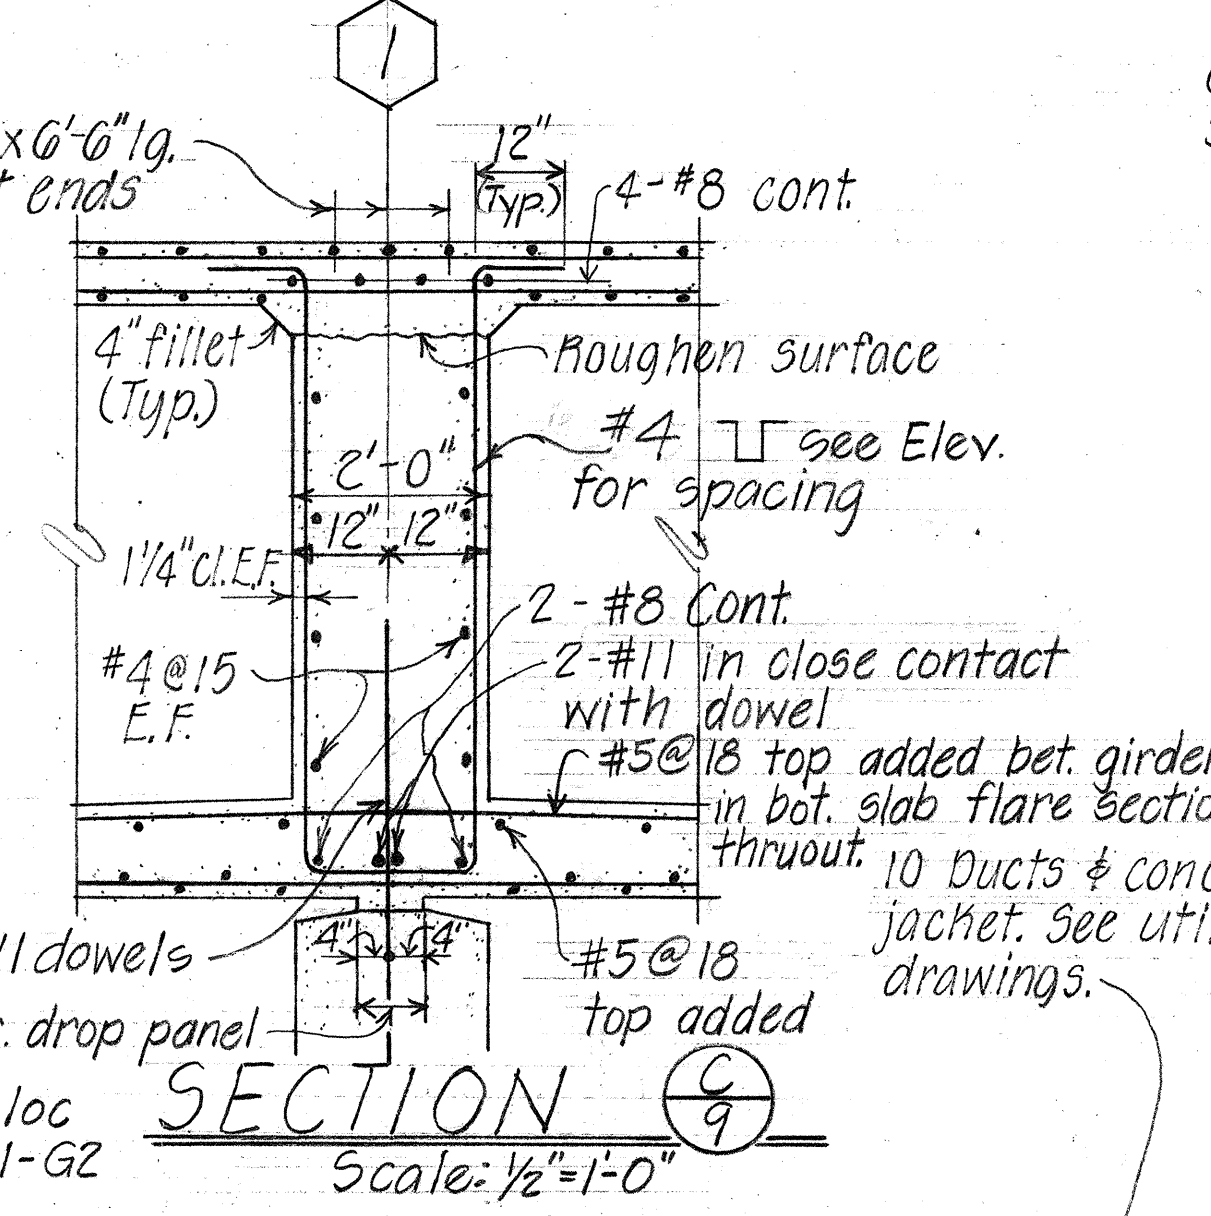


SECTION ⑤
Scale: 1/2" = 1'-0"

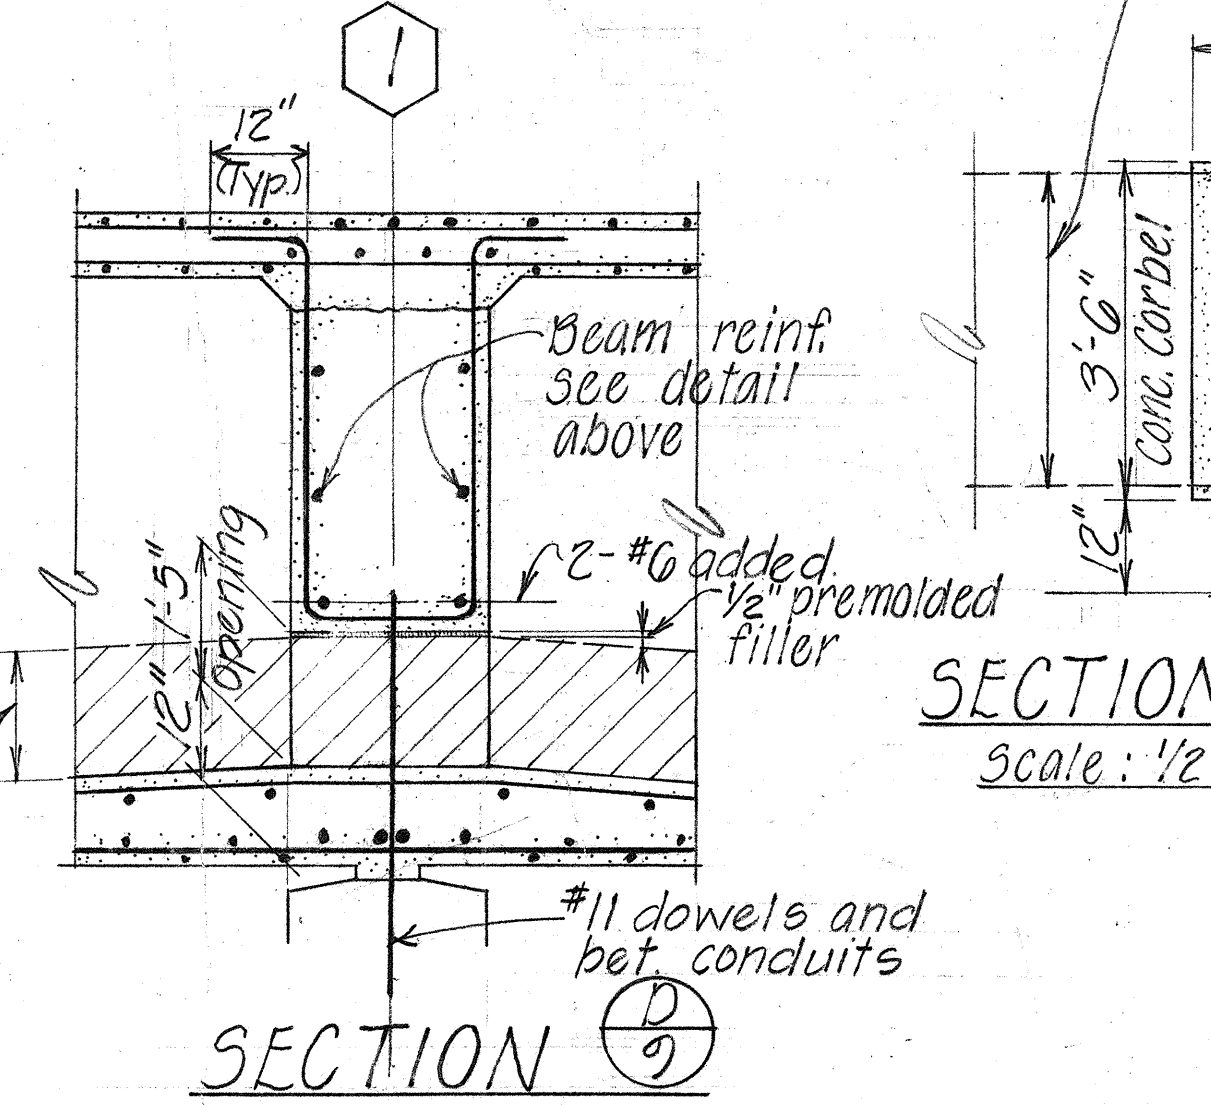

SECTION ⑥
Scale: 1/2" = 1'-0"

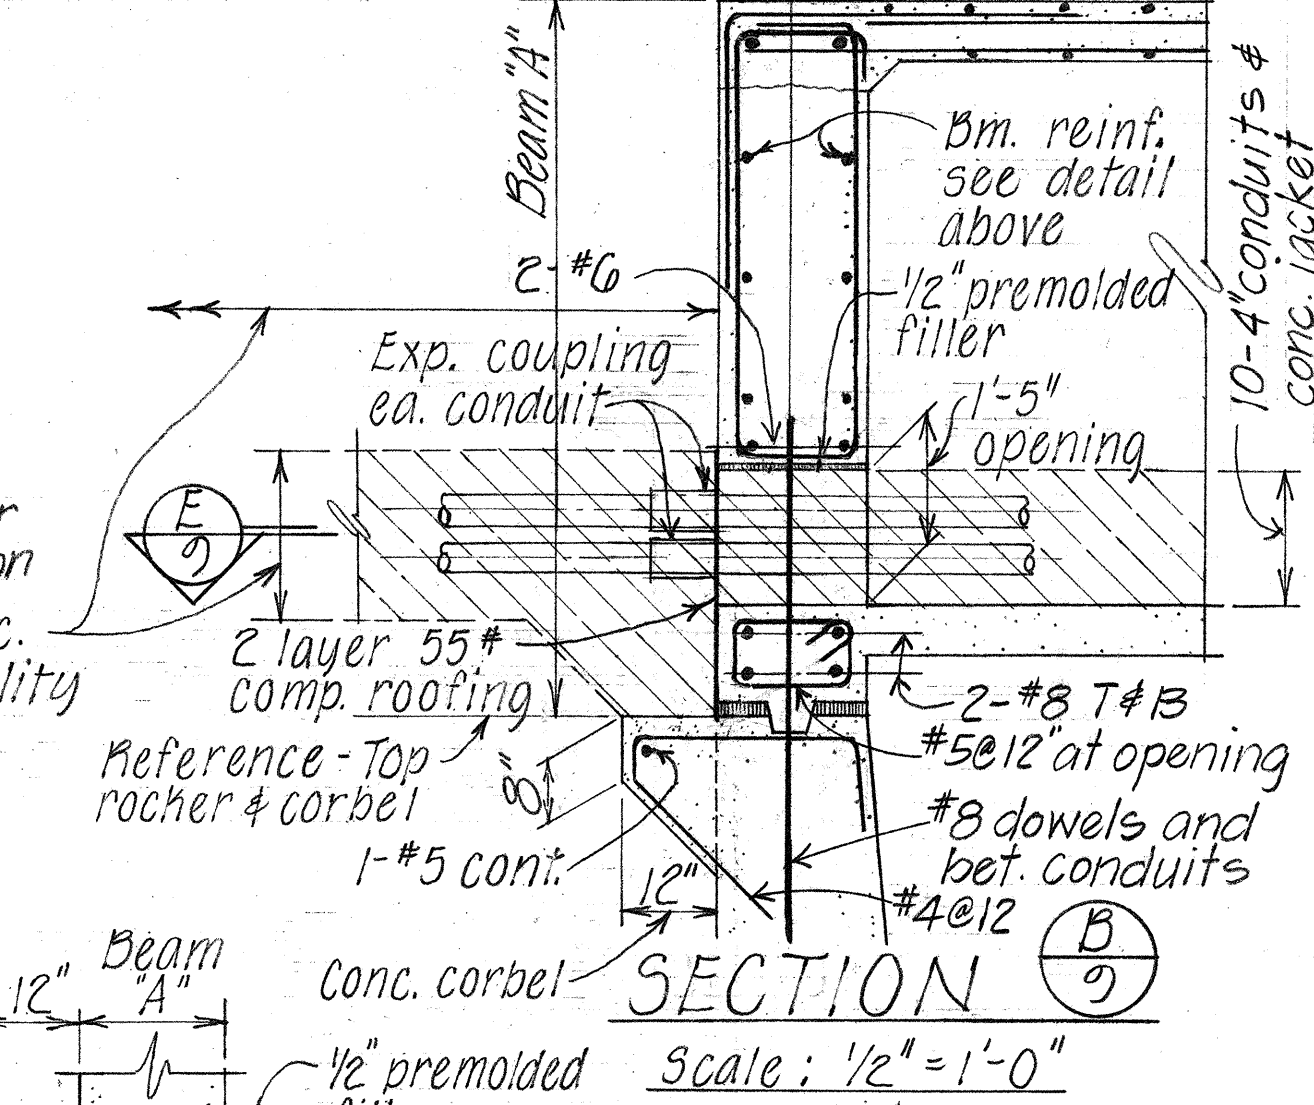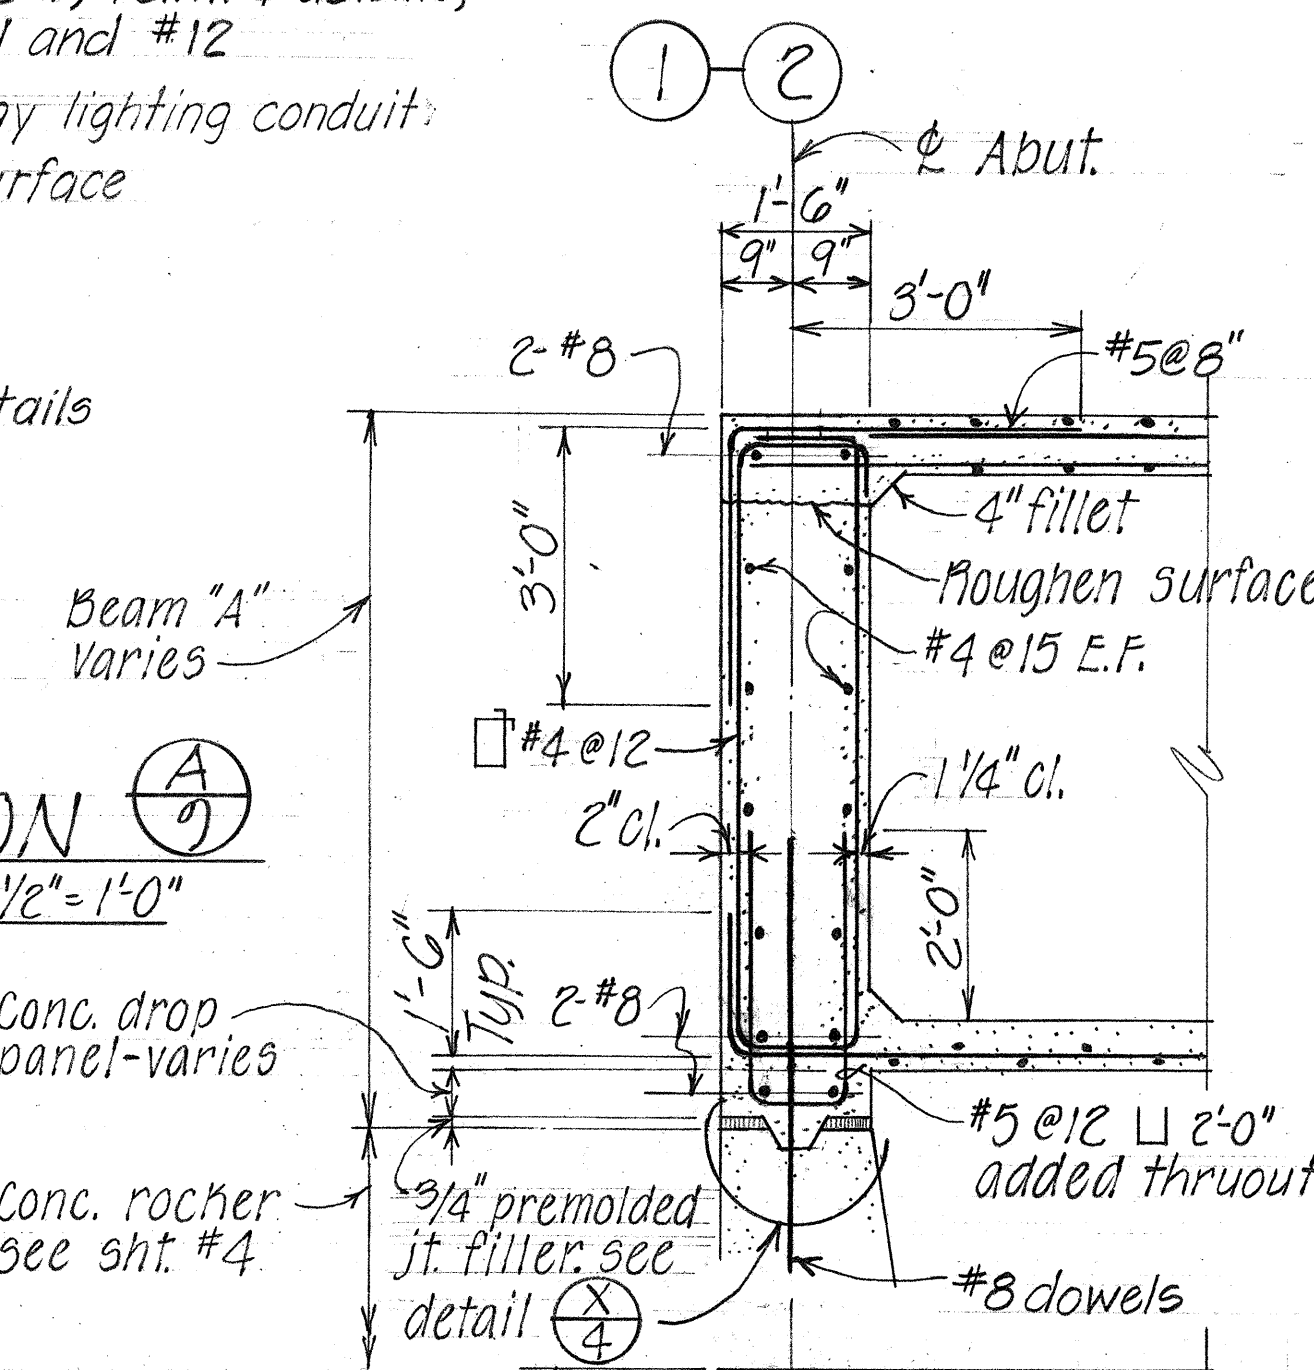

SECTION ⑦
Scale: 1/2" = 1'-0"

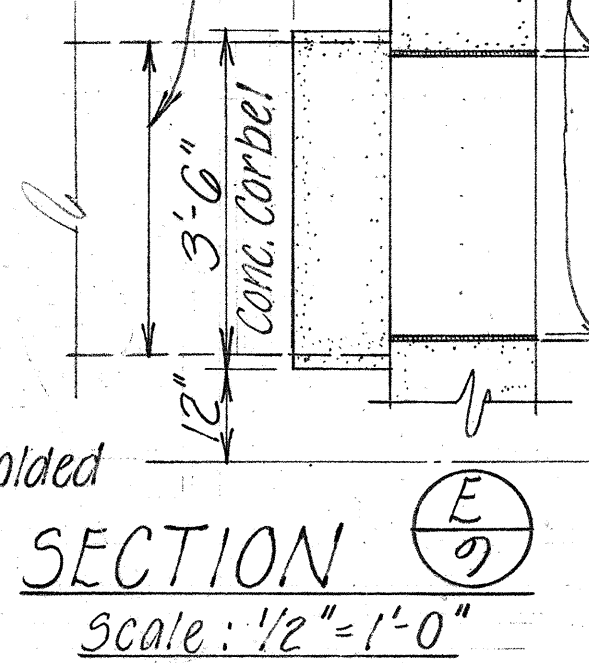


SECTION ⑧
Scale: 1/2" = 1'-0"

STATE OF HAWAII
DEPARTMENT OF TRANSPORTATION
HIGHWAYS DIVISION
GOLF COURSE SEPARATION
DECK SECTIONS AND DETAILS
Leilehua Interchange
F.A.I. Proj. No. I-H2-1(8)G January, 1973
SHEET NO. 9 OF 20 SHEETS

SURVEY PLOTTED BY	DATE
PLAN	2/73
DESIGNED BY	2/73
NOTED BY	2/73
CHECKED BY	2/73


2/25/74	Added - 2 HECO conduit & conc. jacket between G-5 - G-6
Date	Revision

FED. ROAD DIST. NO.	STATE	FED. AID PROJ. NO.	FISCAL YEAR	SHEET NO.	TOTAL SHEETS
HAWAII	HAW.	I-H2-1(8)G	1973	120	160

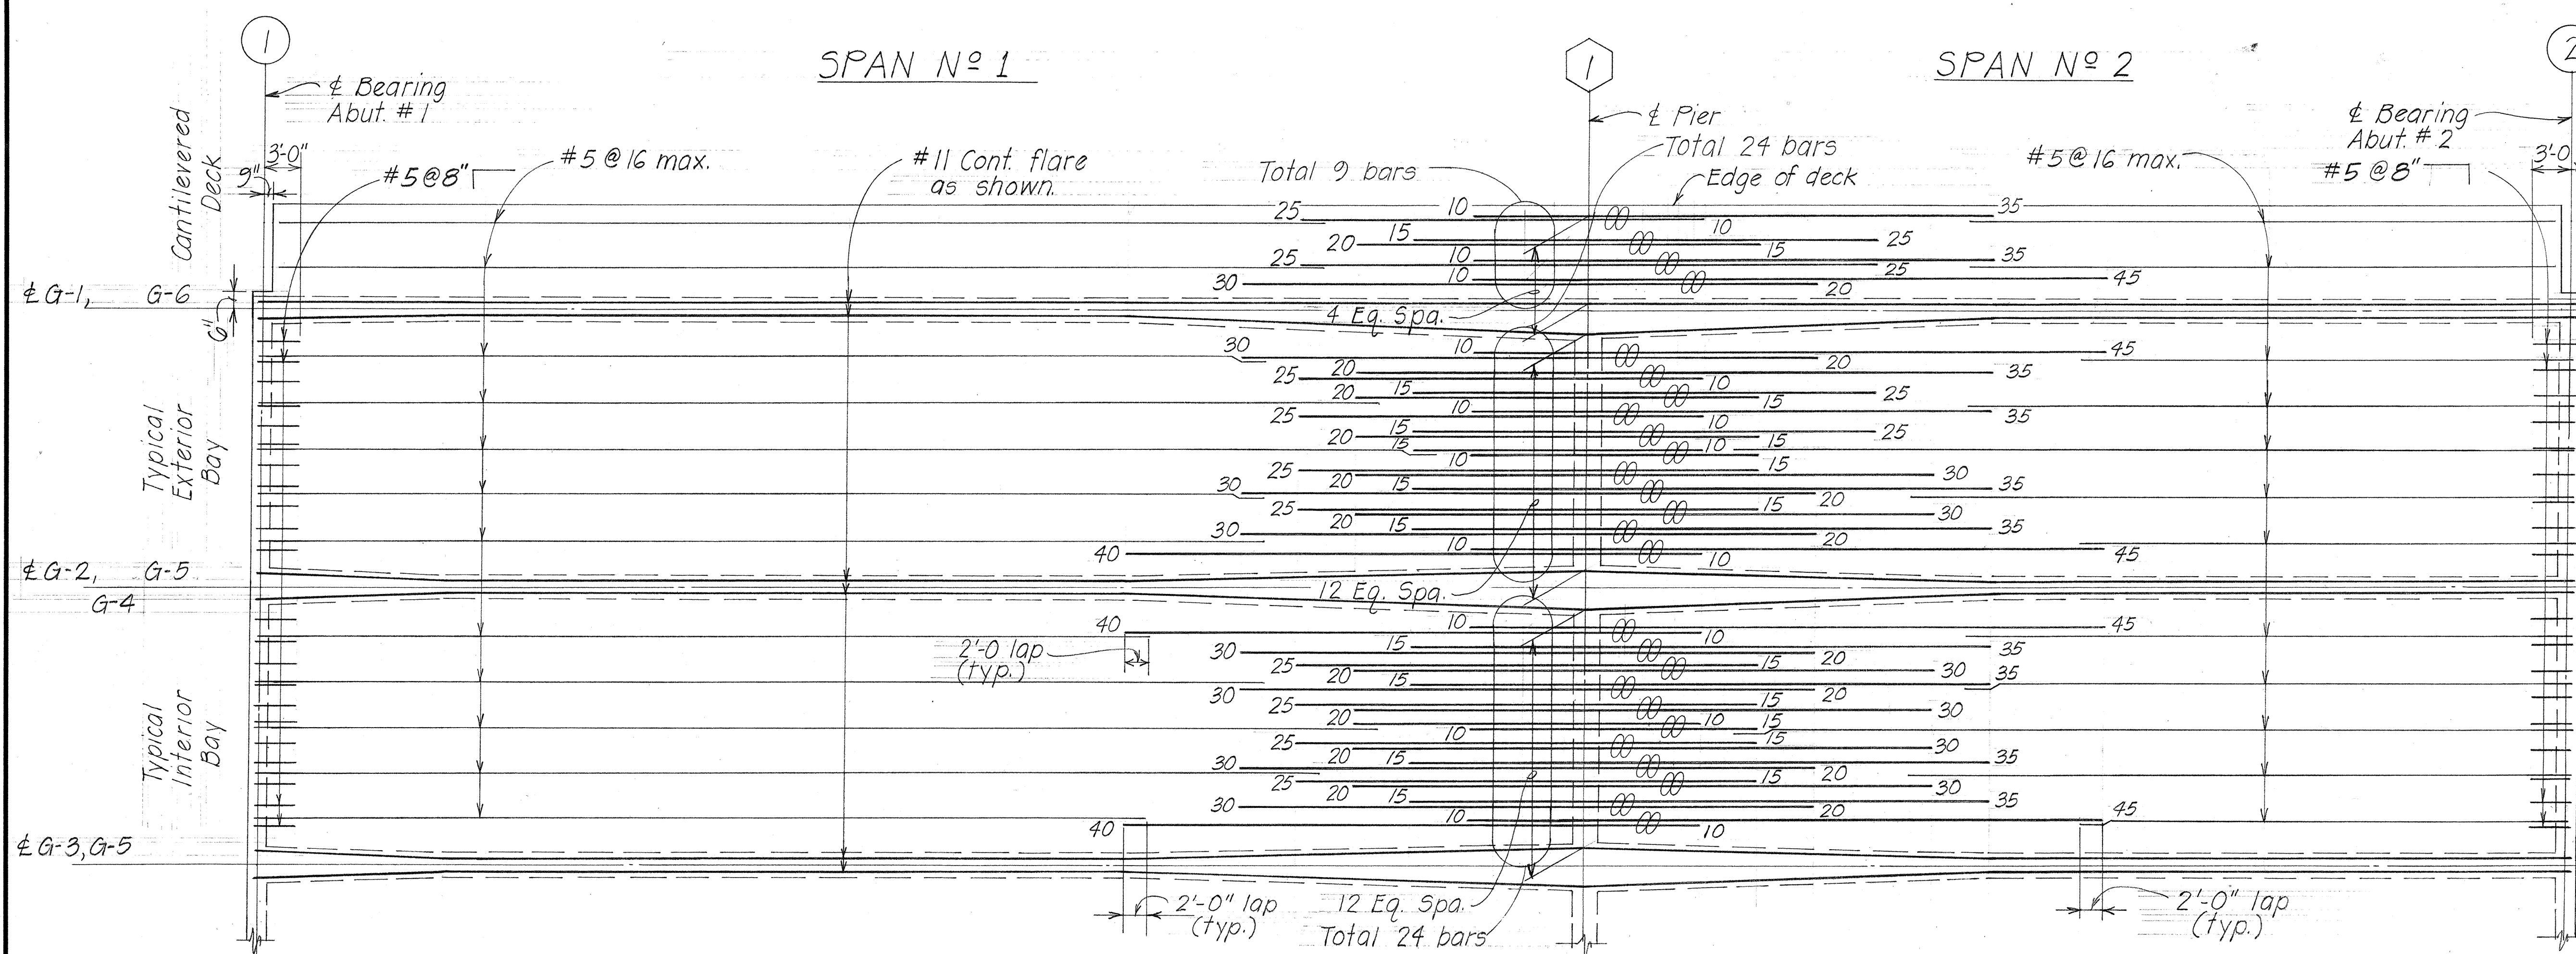

LONGITUDINAL TOP SLAB MAIN REINFORCEMENT Scale: Vert. : 3/8" = 1'-0" Horiz. : 1/8" = 1'-0"

NOTES:
 All reinforcement #11 unless otherwise noted.
 Numbers at ends of bars indicate distance in feet from adjacent & Pier for top reinforcement and & Span for bottom.
 ∞ indicates bundle bars in groups of two.
 For additional slab reinf. details - see sht. numbers DB-101-1, 2, 3 Normal Sections.
 All #5 & #6 bars shall be extended & lapped with the adjacent #11 bars as shown.
 Continuous added are bars from one span extended partially into the adjacent span or spans.

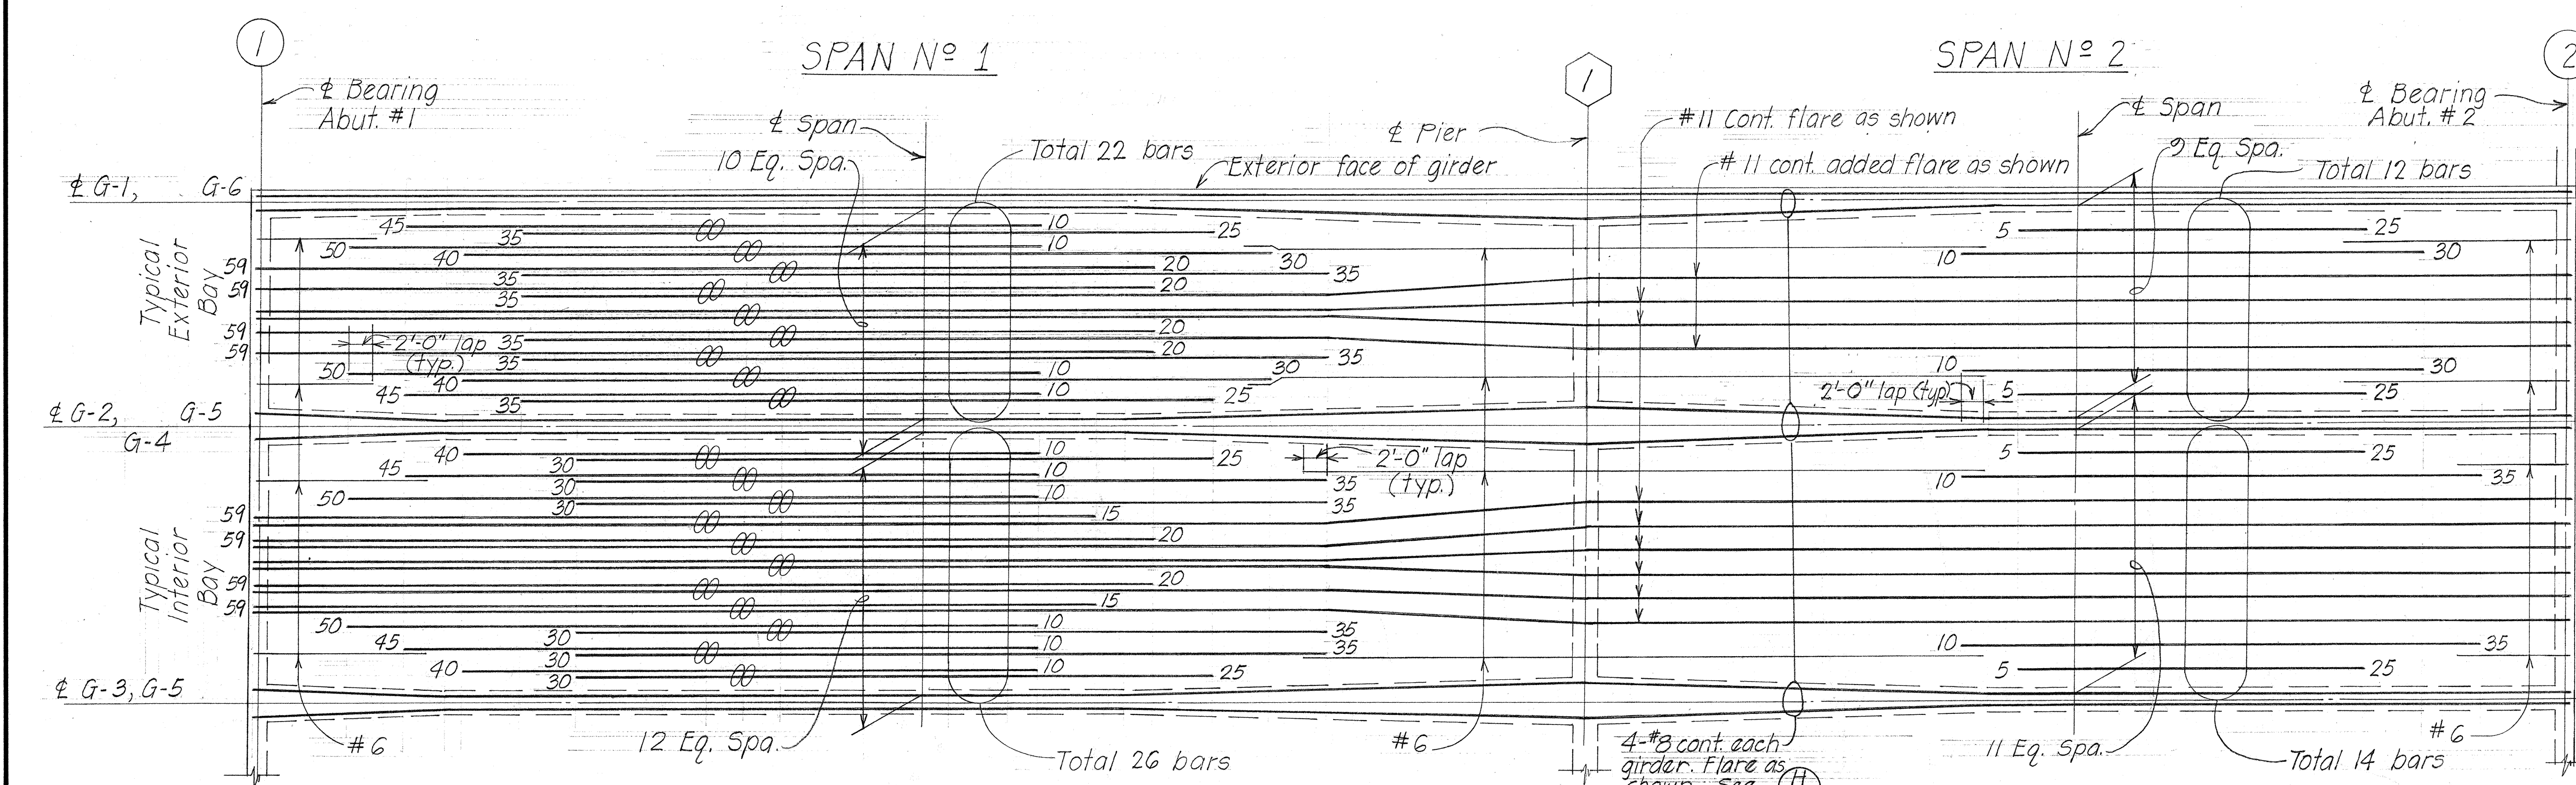


LONGITUDINAL BOTTOM SLAB MAIN REINFORCEMENT Scale: Vert. : 3/8" = 1'-0" Horiz. : 1/8" = 1'-0"

DESIGNED BY	DATE
CHECKED BY	3/73
NOTED BY	3/73
ORIGINAL PLAN	3/73
NOTE BOOK	3/73
NO.	3/73


STATE OF HAWAII
 DEPARTMENT OF TRANSPORTATION
 HIGHWAYS DIVISION
GOLF COURSE SEPARATION
TYPICAL DECK REINFORCEMENT
 Leilehua Interchange
 F.A.I. Proj. No. I-H2-1(8)G January, 1973
 SHEET No. 10 OF 20 SHEETS

FED. ROAD DIST. NO.	STATE	FED. AID PROJ. NO.	FISCAL YEAR	SHEET NO.	TOTAL SHEETS
HAWAII	HAW.	I-H2-1006	1973	130	100

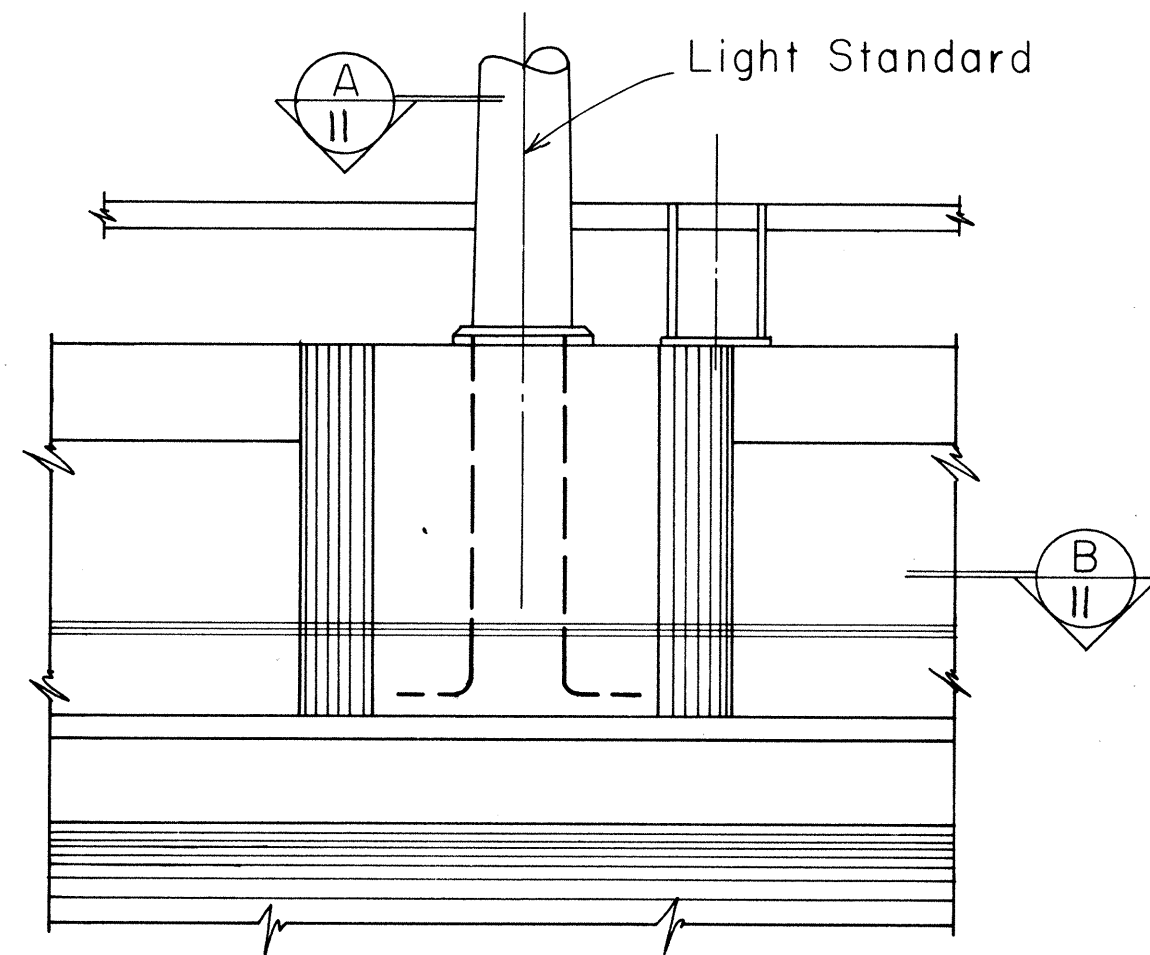


EXTERIOR ELEVATION

Scale: $\frac{3}{4}'' = 1'-0''$

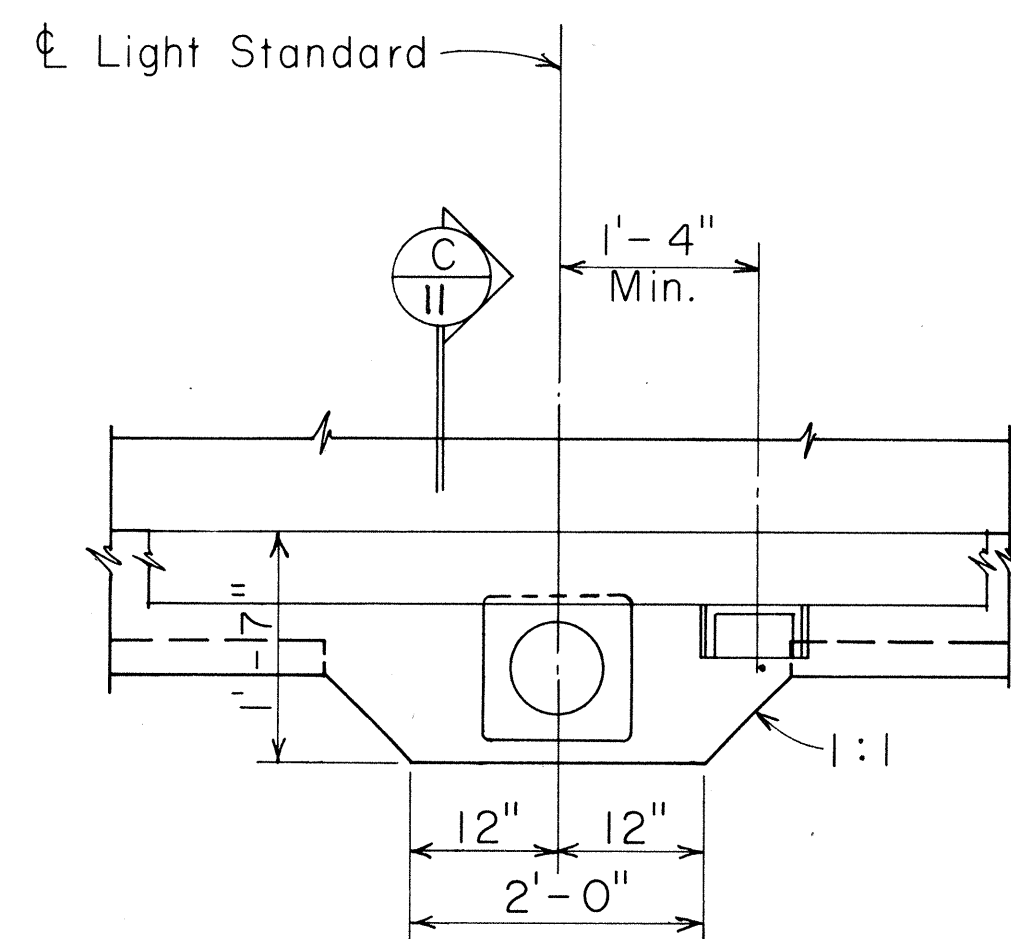


PLAN

Scale: $\frac{3}{4}'' = 1'-0''$

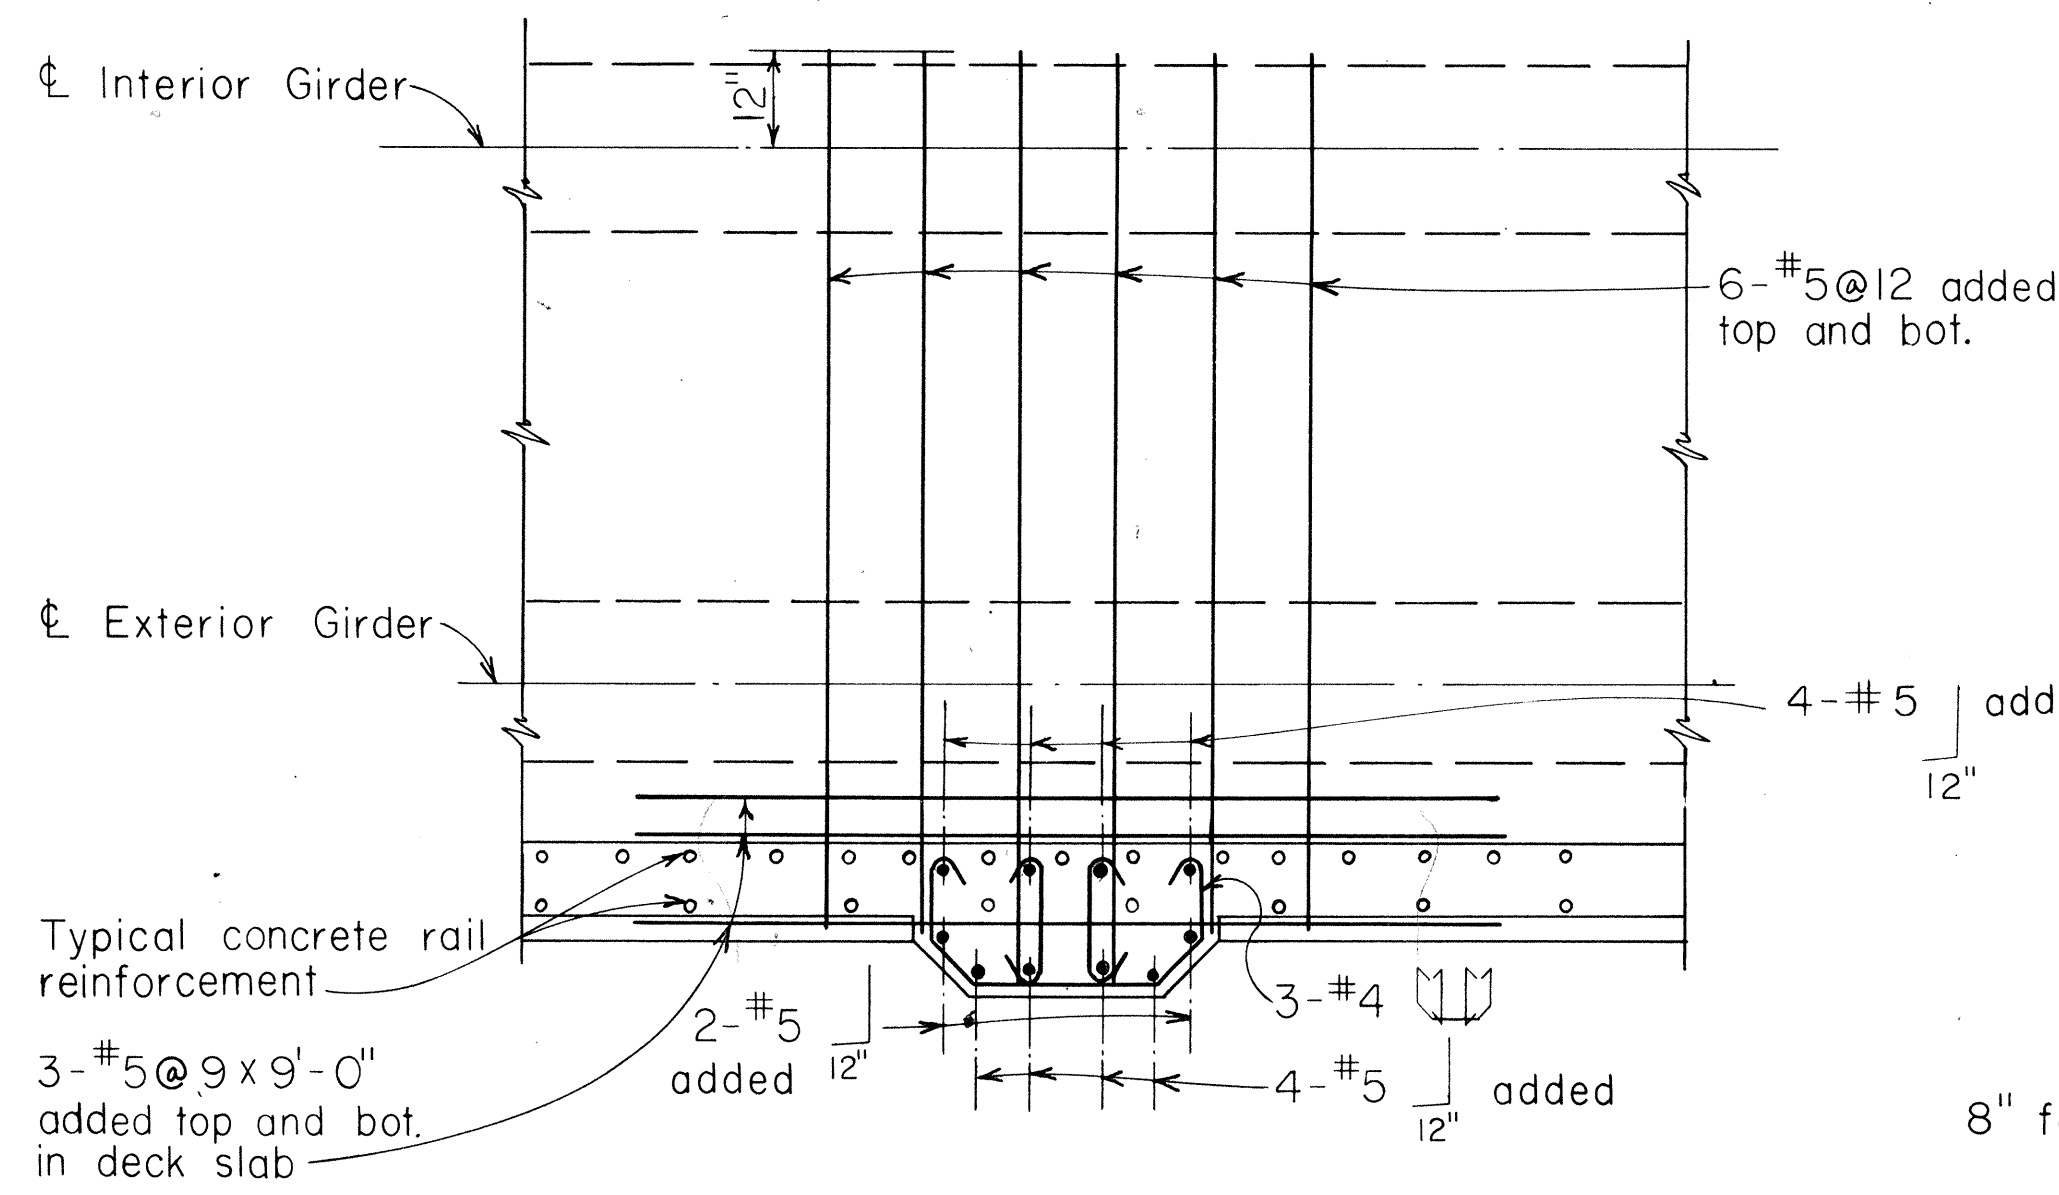

SECTION

Scale: $\frac{1}{2}'' = 1'-0''$

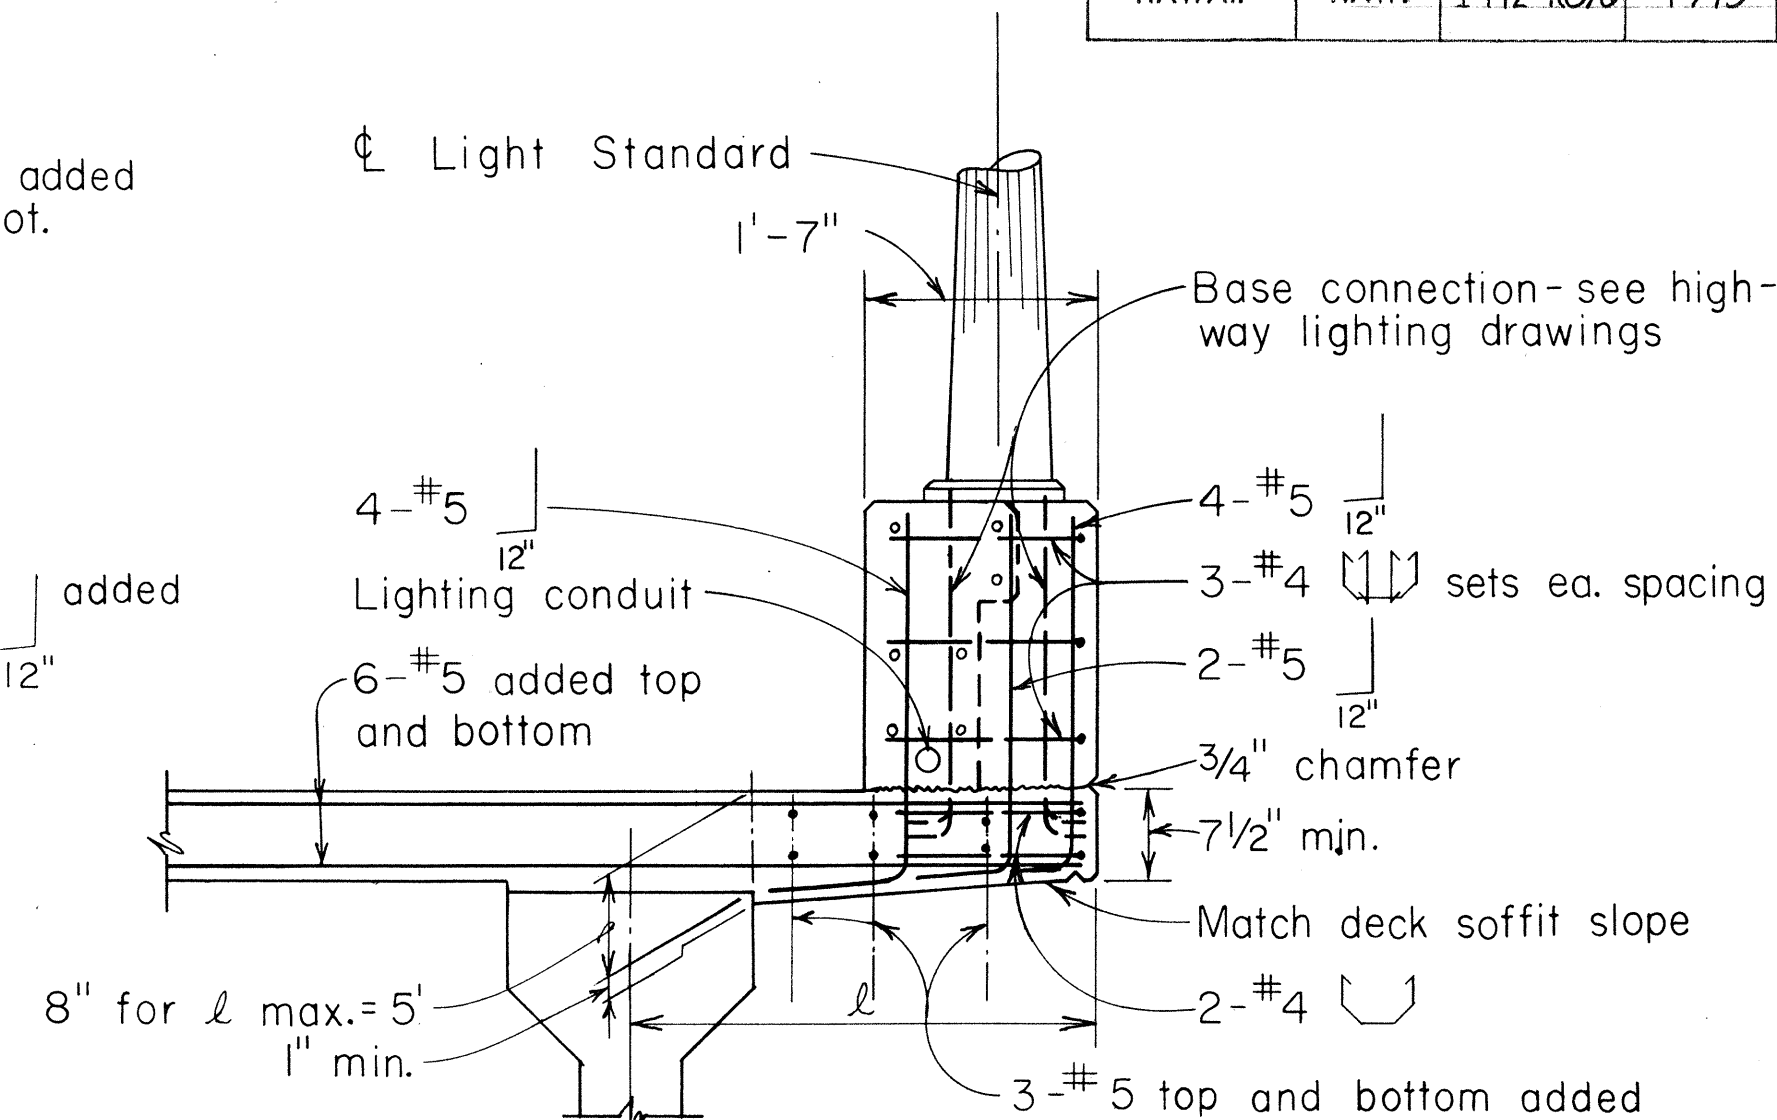


SECTION

Scale: $\frac{3}{4}'' = 1'-0''$

DETAILS AT LIGHT STANDARD

Scale: As Noted

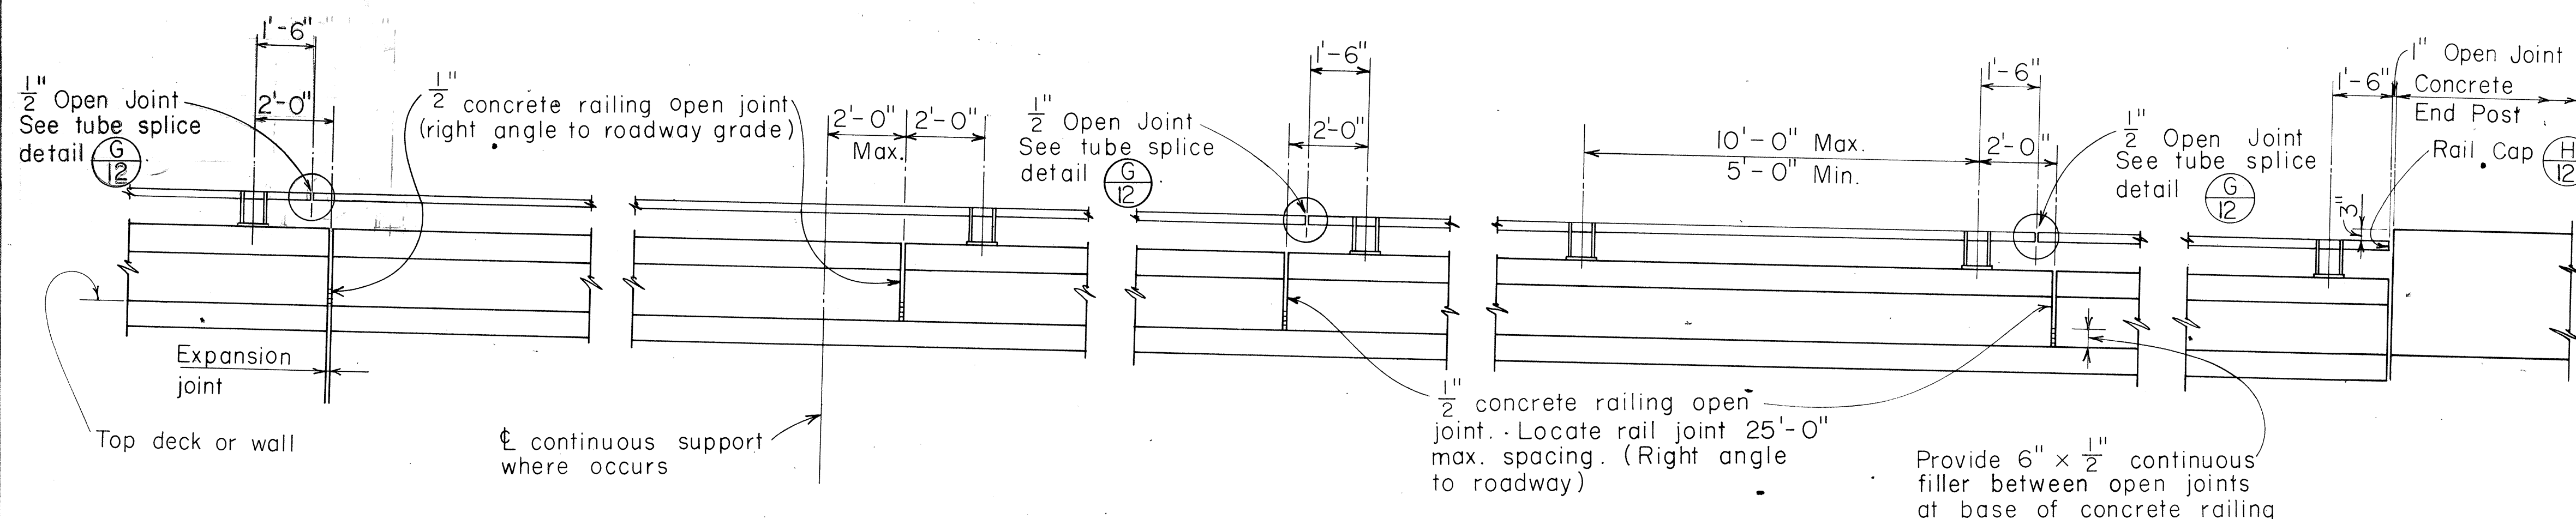

AT EXPANSION JOINT


AT CONTINUOUS SUPPORT

INTERMEDIATE

AT CONCRETE
END POST

EXTERIOR ELEVATION

Scale: $\frac{3}{8}'' = 1'-0''$

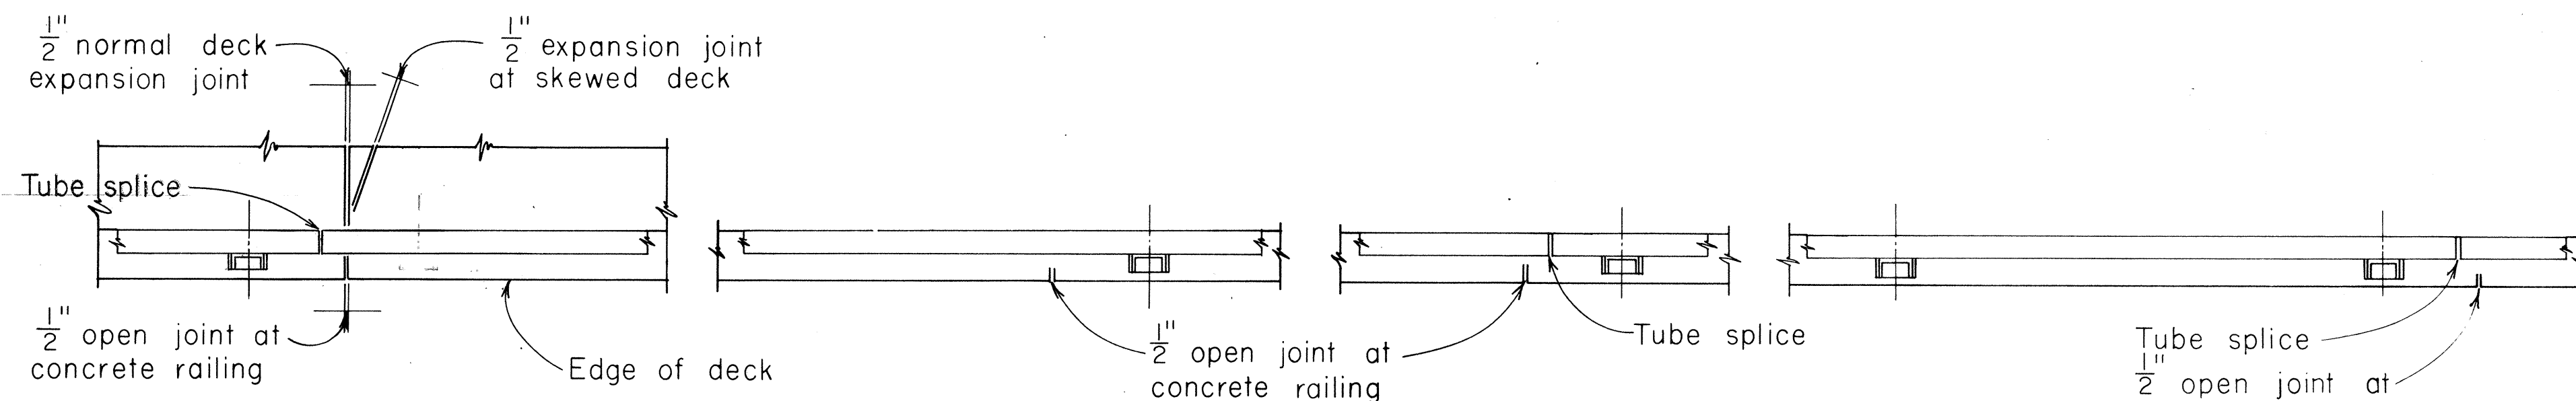

AT EXPANSION JOINT

AT CONTINUOUS SUPPORT

INTERMEDIATE

PLAN

Scale: $\frac{3}{8}'' = 1'-0''$

NOTES

- Tubing shall be shop bent to fit horizontal curve when radius is less than 950 ft.
Post shall be normal to grade.
Concrete railing and metal rail joints shall be located at all deck joints.
Tubing shall be continuous over not less than 3 posts except as noted on plans.
All exposed corner of metal railing shall be ground smooth.
Rail assemblage shall be galvanized after fabrication.
All anchor bolts, bolts, nuts, plates and washers shall be galvanized.
Welding shall meet the requirement of Section 501 of the Standard Specifications.

- Material shall conform to the following requirements:
1. Tubular steel rails ASTM A500 Grade B.
2. Steel posts ASTM A36.
3. Sleeves for tubular rails ASTM A36.
4. Stud bolts ASTM A108 Grades 1015 to 1020.
5. Anchor bolts, bolts, nuts and washers ASTM A325.
6. Shims commercial quality galvanized steel.
7. Sleeve bolts and nuts ASTM A108 Grades 1015 to 1020.


For additional railing details, see sht. #12.

NO.	REVISION	APPROVED BY	DATE


STATE OF HAWAII DEPARTMENT OF TRANSPORTATION HIGHWAYS DIVISION	
TYPICAL DETAIL	
STEEL BRIDGE RAILING (TUBULAR) ONE RAIL COMBINATION TYPE ON PARAPET (TYPE 2)	
Leilehua Interchange F.A.I. Proj. N2 I-H2-1006	January 1973

SHEET No. 11 OF 20 SHEETS


FED. ROAD DIST. NO.	STATE	FED. AID PROJ. NO.	FISCAL YEAR	SHEET NO.	TOTAL SHEETS
HAWAII	HAW.	I-H2-1(8)-6	1973	131	160

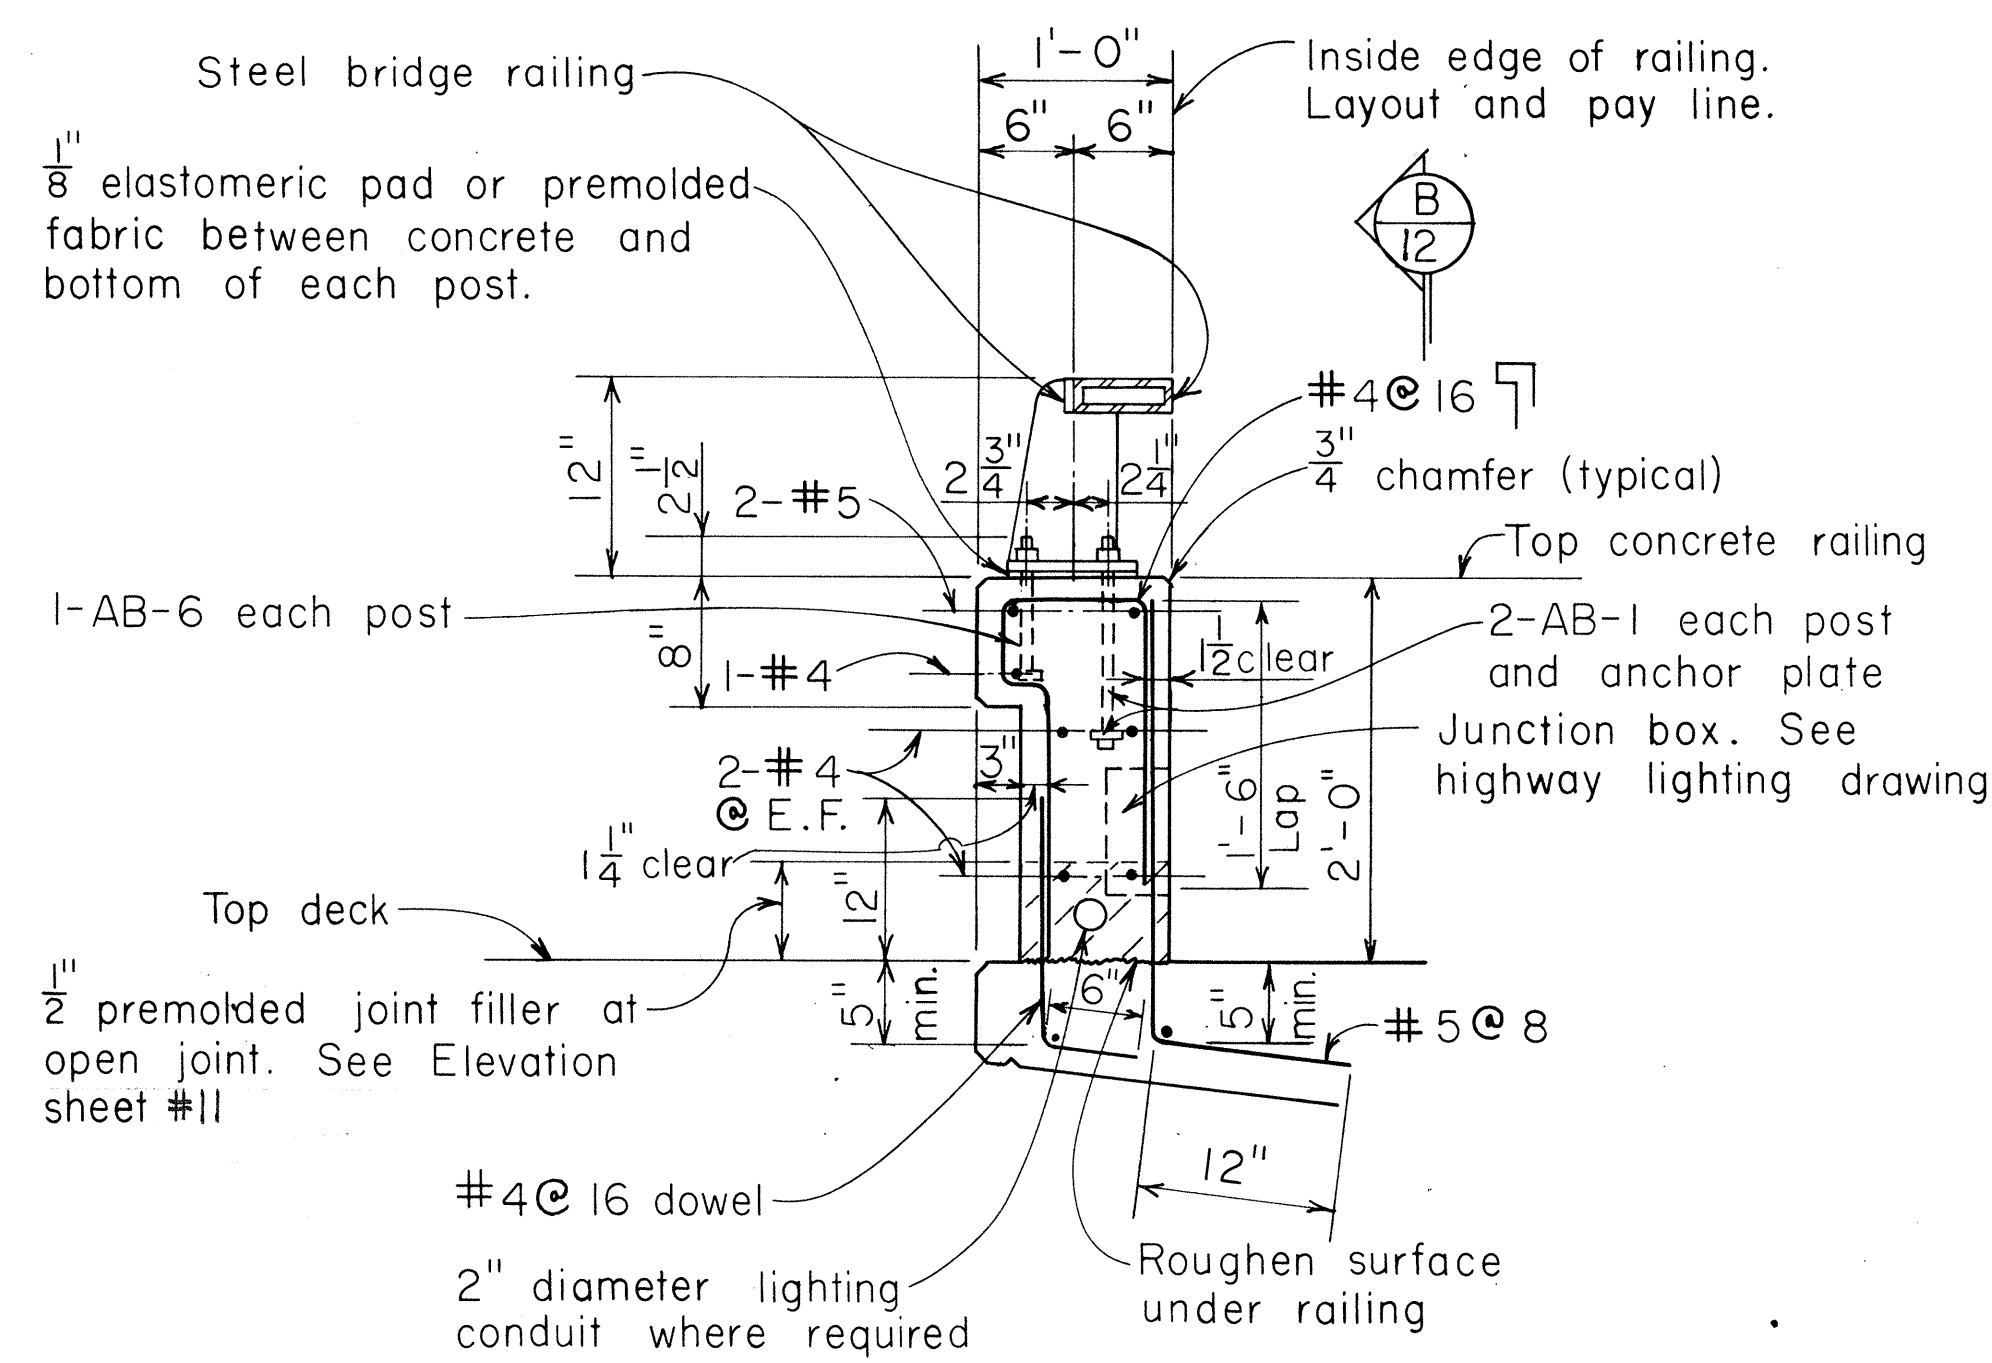


TYPICAL SECTION Scale: 1" = 1'-0"

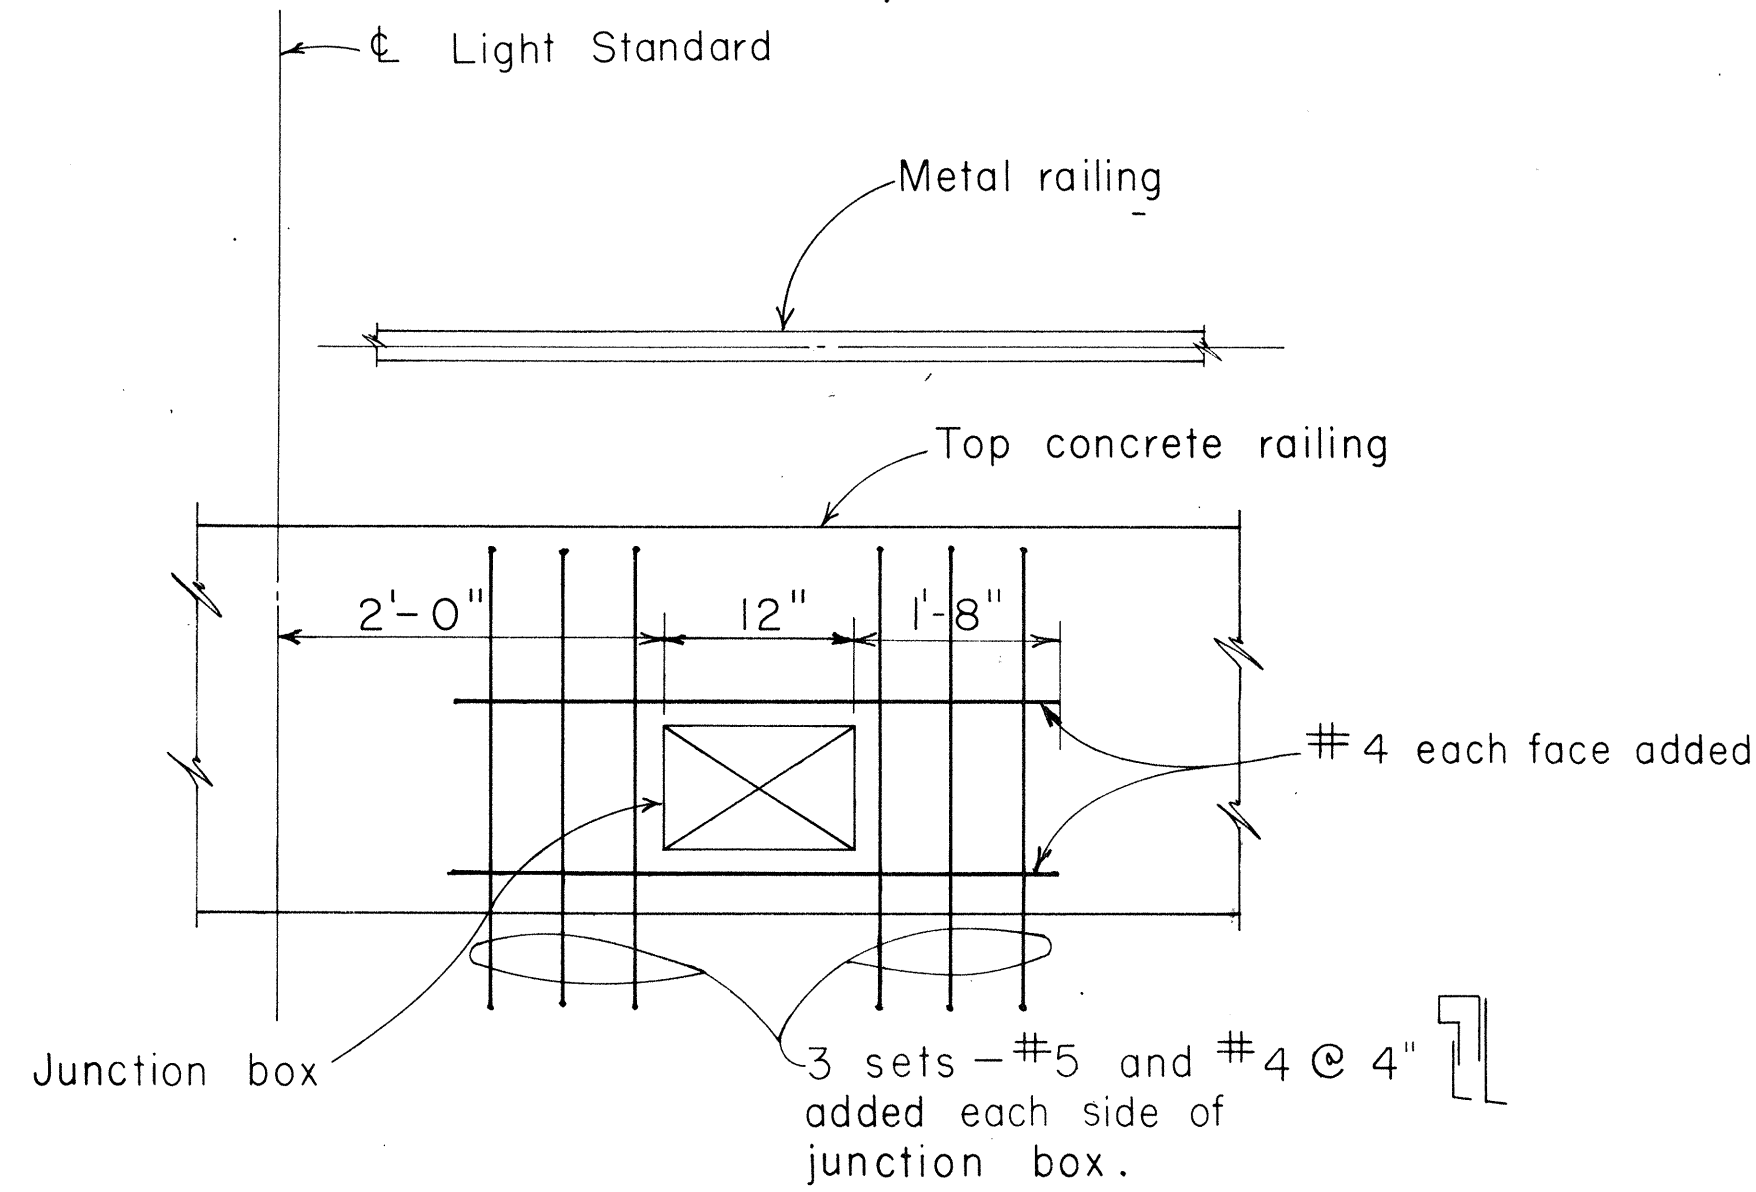


ELEVATION (B/12) ADDED
REINFORCEMENT AT JUNCTION BOX Scale: 1" = 1'-0"

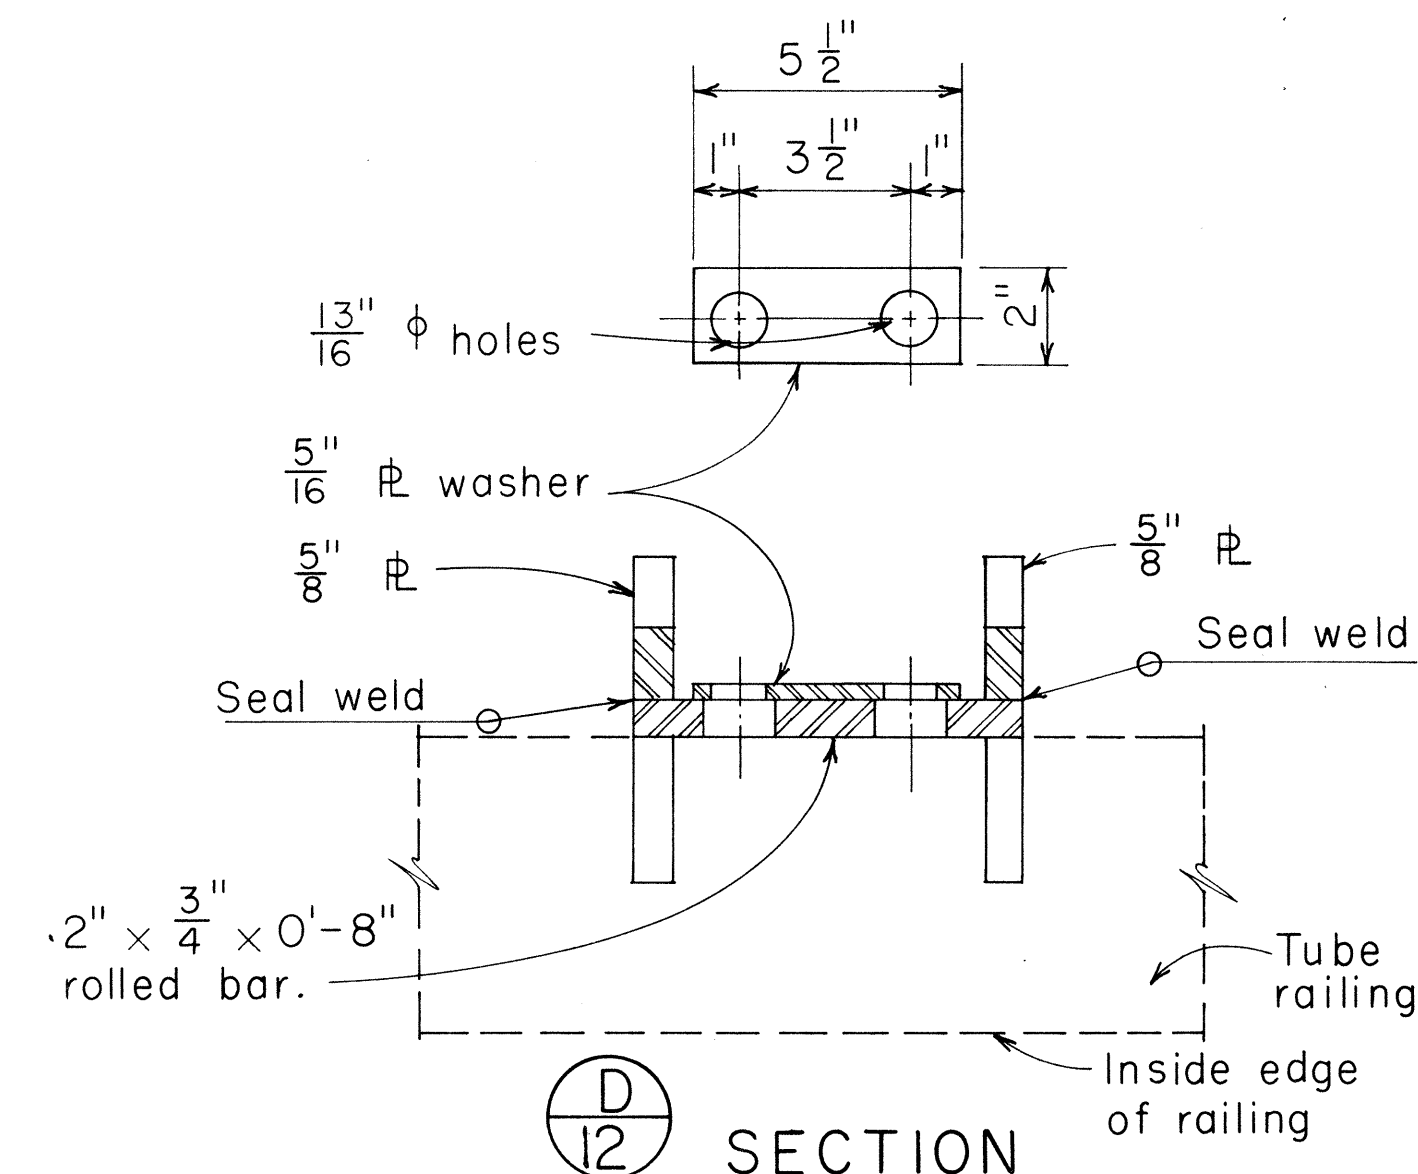

SECTION (D/12)

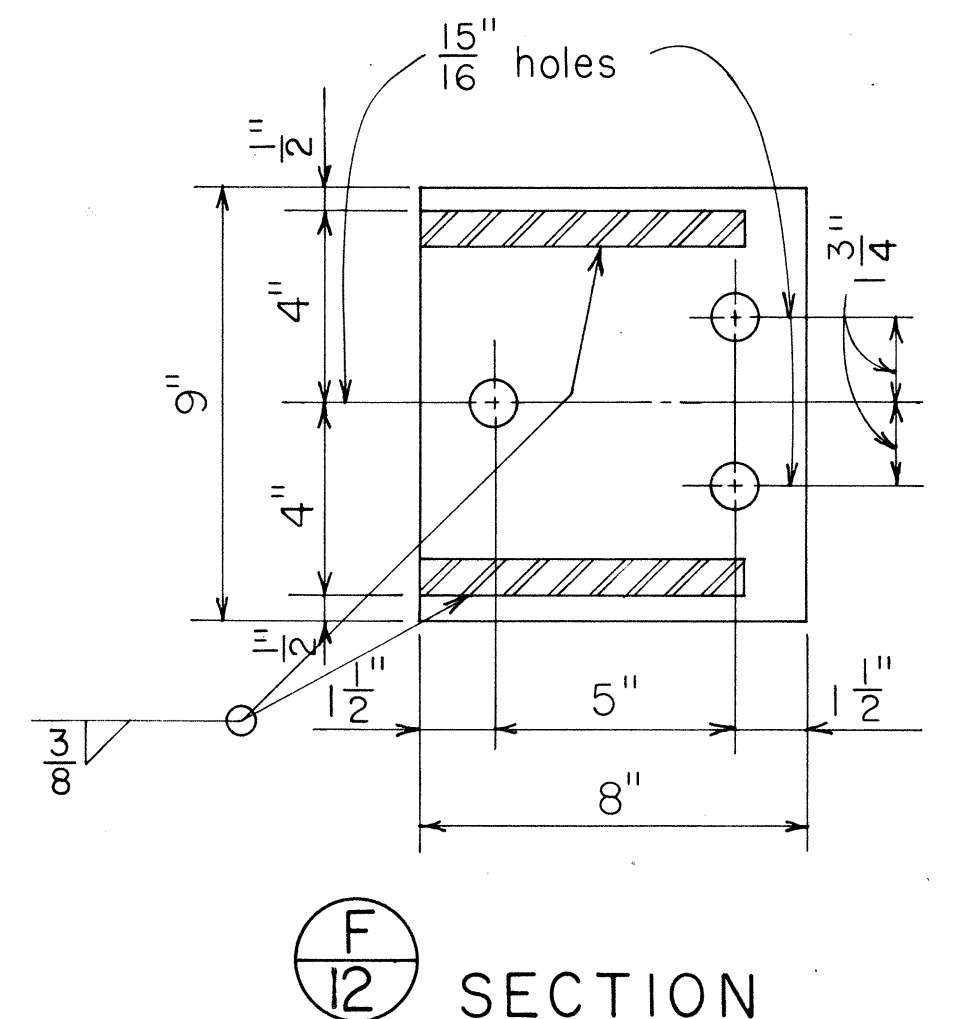


SECTION (F/12)

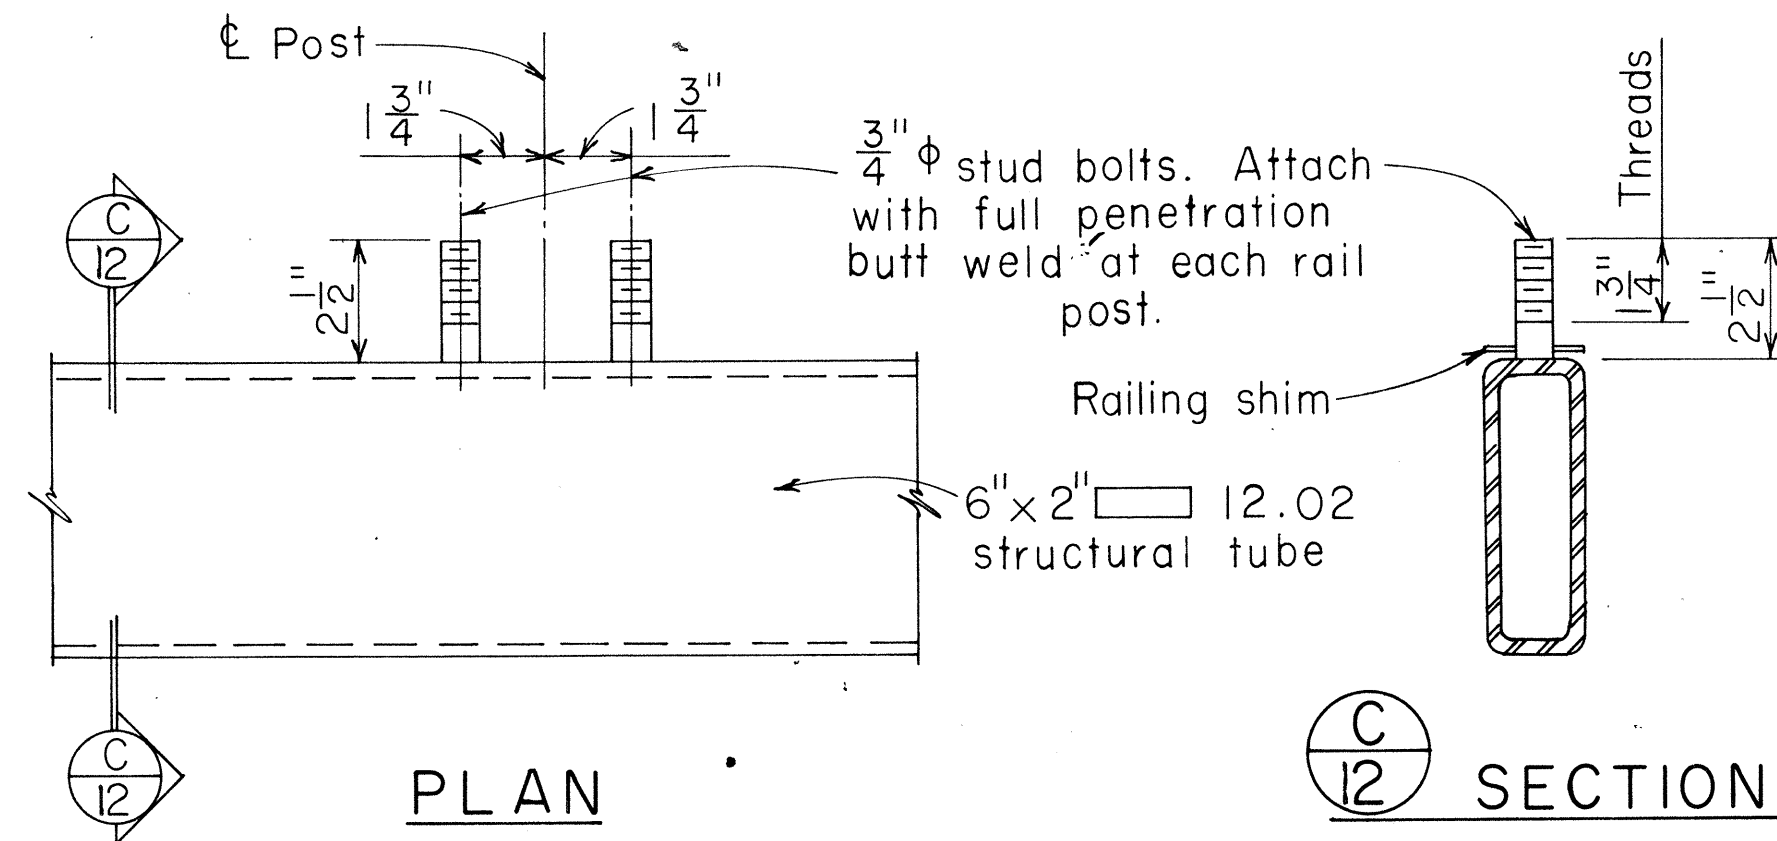


PLAN (C/12)

TUBE RAIL DETAILS Scale: 3" = 1'-0"


SECTION (C/12)

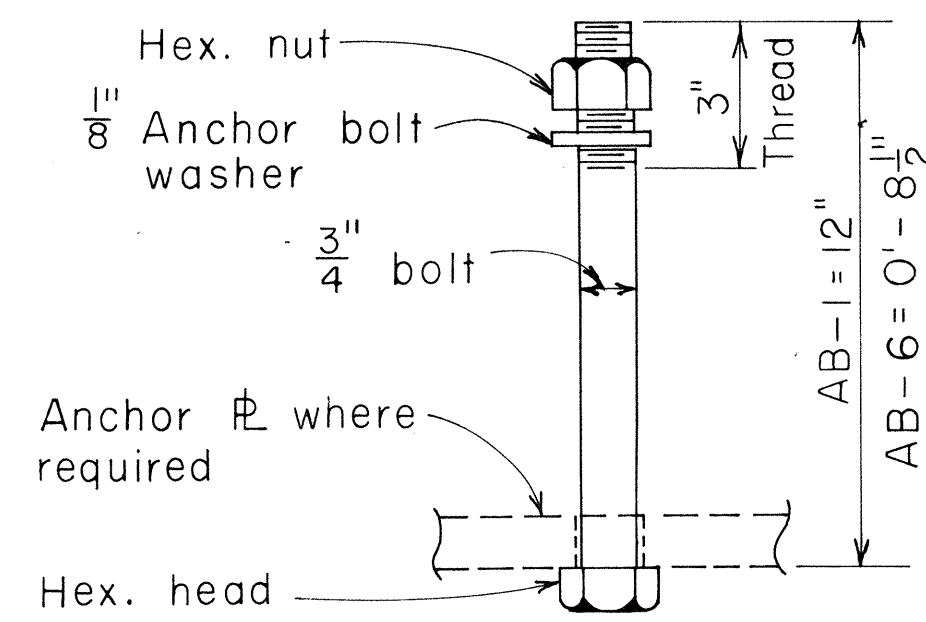


TYPICAL ANCHOR BOLT (AB) ASSEMBLY

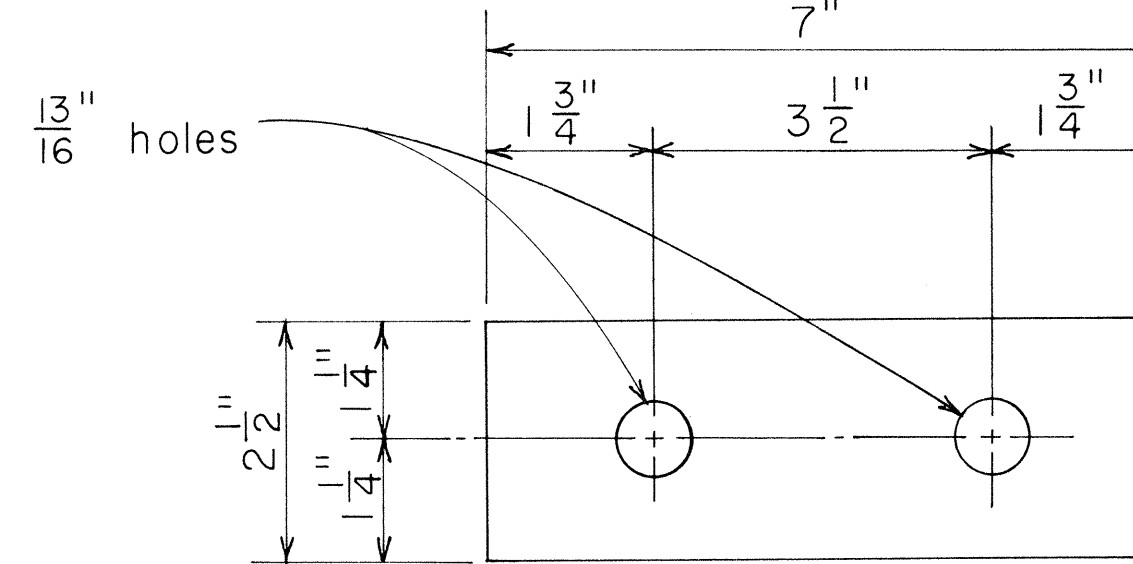


PLAN

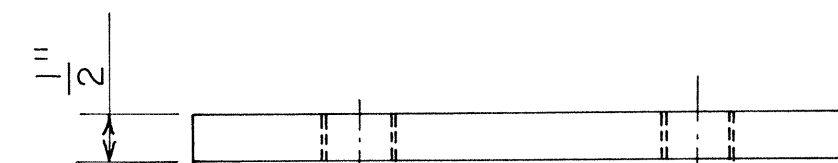


ELEVATION

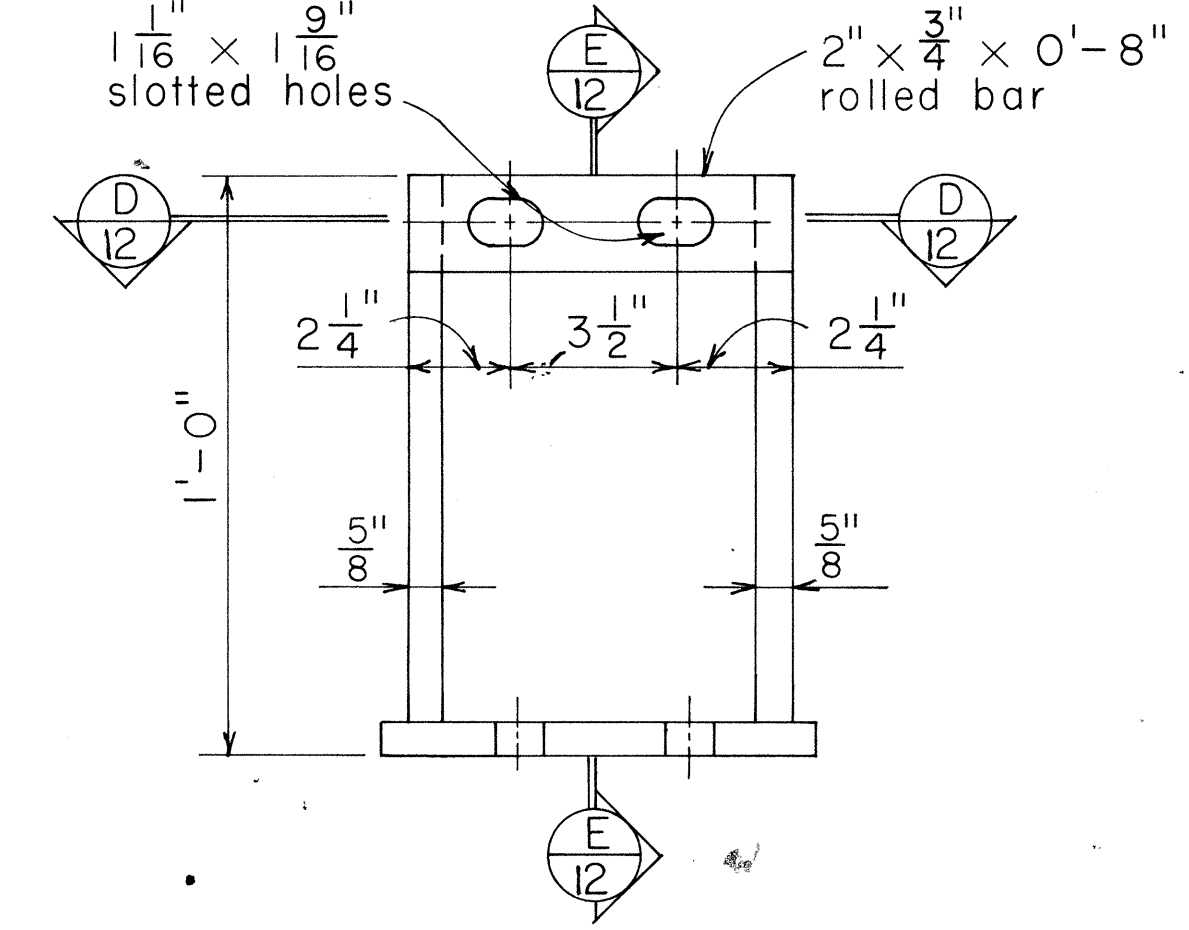


ELEVATION (E/12)

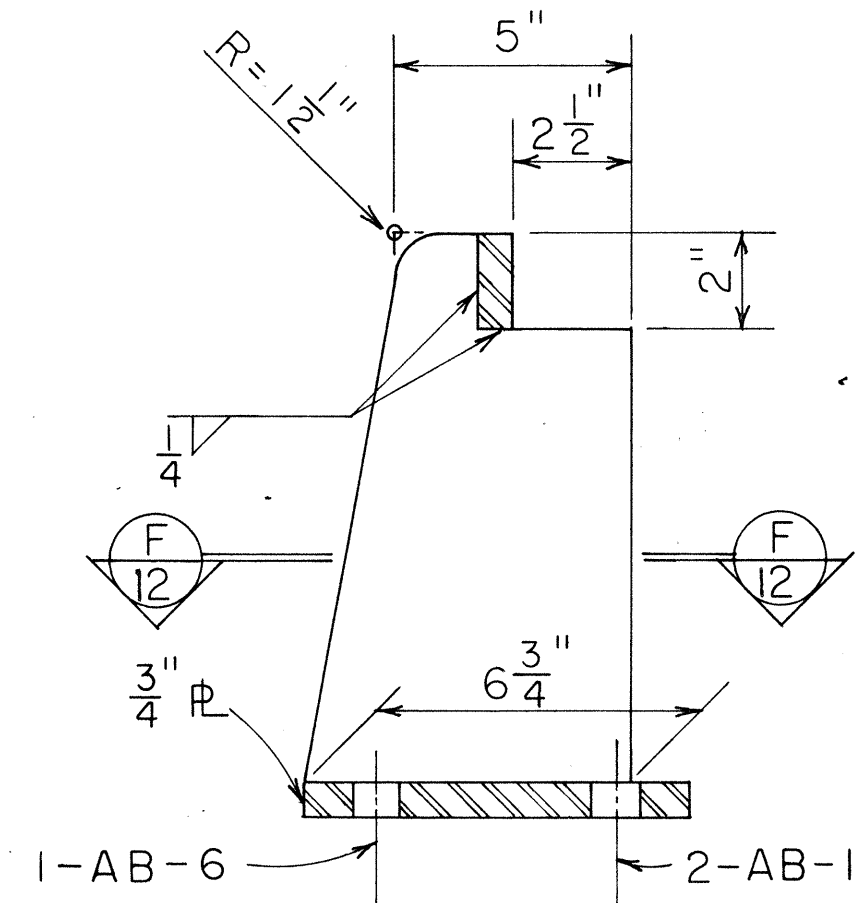

SECTION (E/12)

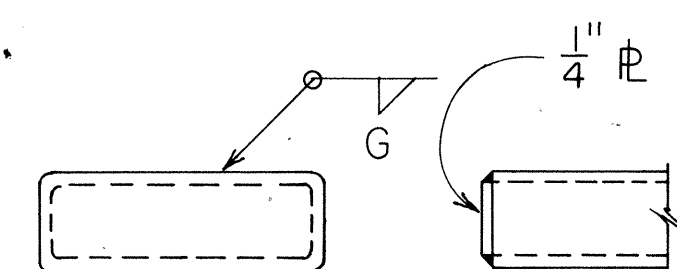


(H/12) RAIL CAP Scale: 3" = 1'-0"

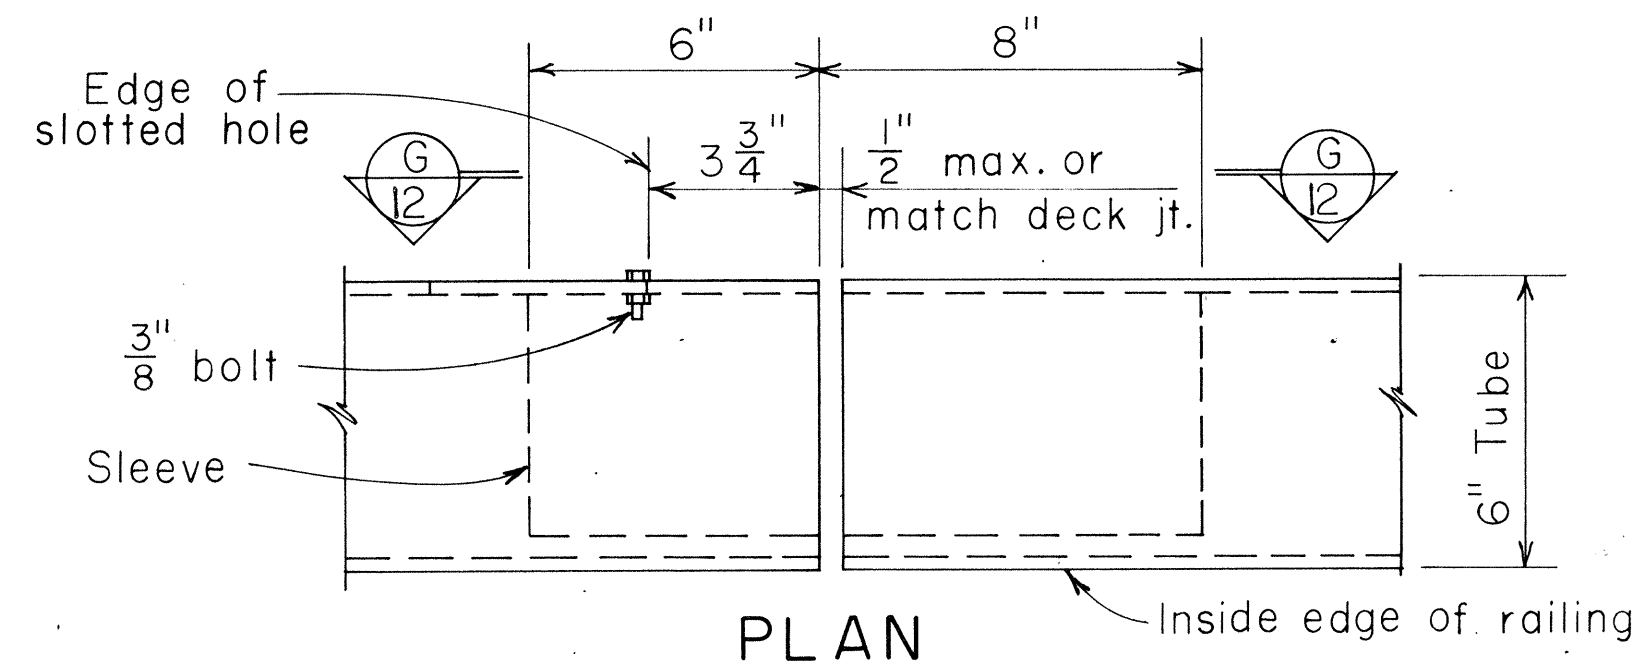

PLAN (G/12)


TYPICAL ANCHOR BOLT DETAIL Scale: Half Size

RAIL POST DETAILS Scale: 3" = 1'-0"

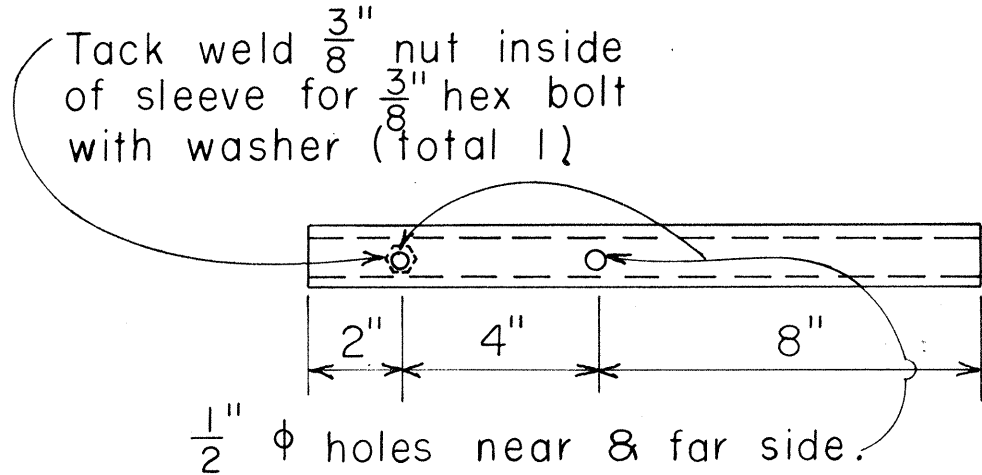


SLEEVE

Sleeve formed of 3/16" ϕ , bent thus: for sliding fit inside of rail tube.

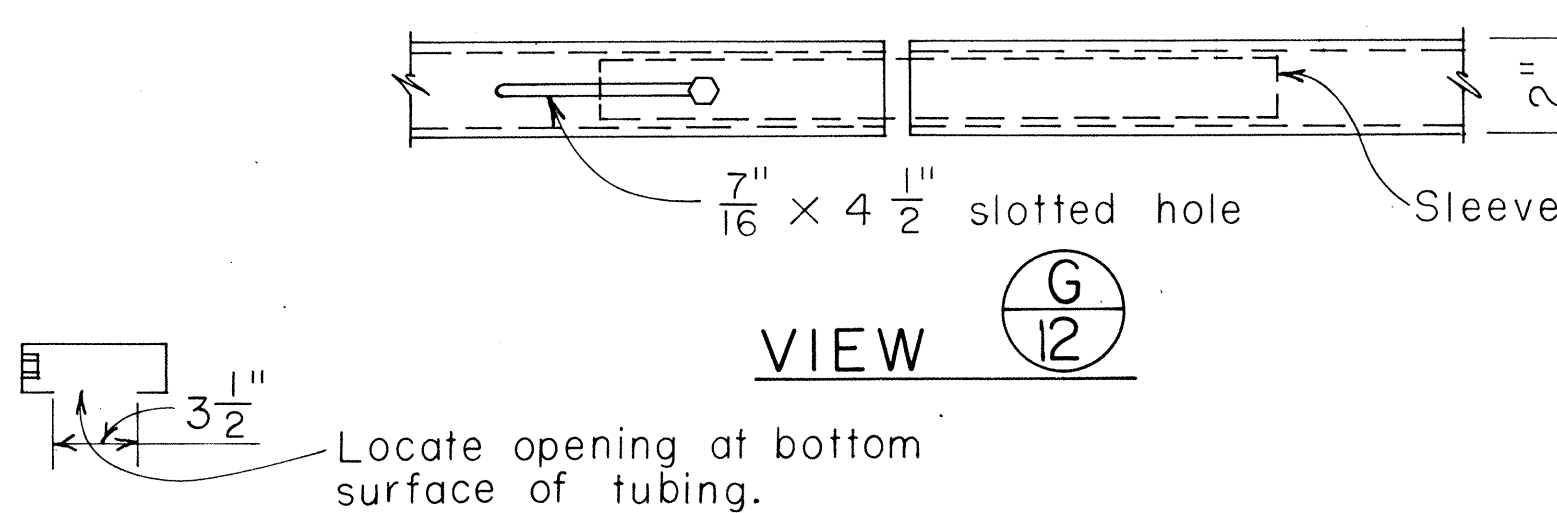

TUBE SPLICE DETAIL Scale: 3" = 1'-0"

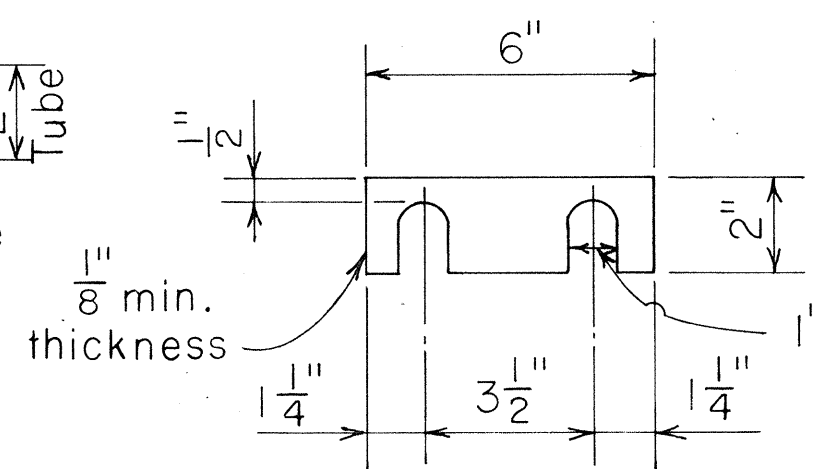


RAILING SHIM DETAIL Scale: 3" = 1'-0"

NO.	REVISION	APPROVED BY	DATE


STATE OF HAWAII DEPARTMENT OF TRANSPORTATION HIGHWAYS DIVISION TYPICAL DETAIL STEEL BRIDGE RAILING (TUBULAR) ONE RAIL COMBINATION TYPE ON PARAPET (TYPE 2) Leilehua Interchange F.A.I. Proj. No I-H2-1(8)-G January 1973 SHEET No. 12 OF 20 SHEETS			
--	--	--	--

GENERAL NOTES


- All concrete shall be Class A unless otherwise noted.
- Reinforcing shall be detailed in accordance with A.C.I. Manual of Standard Practice for Detailing Reinforced Concrete Highway Structures unless otherwise noted.
- Clearance for reinforcing bars shall be as follows, unless otherwise noted.
 - 1 1/2" For stirrups of beams & pier caps.
 - 2" For ties of columns.
 - 2" For formed walls.
 - 3" For footings.
- Minimum spacing between parallel bars shall be 2 1/2 times the diameter of bars, but in no case shall the clear distance between the bars be less than 1 1/2 times the maximum size of the coarse aggregate.
- All dimensions relating to reinforcing are to centers of bars unless otherwise noted.
- Reinforcing bars shall be securely tied at all intersections & lap splices & shall be held in place during pouring to maintain their proper locations as shown on plans.
- Vertical column bars shall be arranged in such a manner as to miss pier cap bars above as directed by the Engineer.
- Except as otherwise noted on drawings, all exterior corners & re-entrant angles in concrete work shall be chamfered 3/4" x 3/4".
- Concrete seats receiving steel plates, lead plates or neoprene pads shall be poured monolithically with supporting structures & top of concrete seats shall be finished with a steel trowel to a smooth level, surface at the elevation shown on the plans.
- Elastomeric Pads: Bottom of bridge bearing pads shall be secured against displacement with adhesives approved by the Engineer. Pads shall be incidental to concrete and will not be paid for separately.
- Forms for all exposed surfaces of separation structures and surfaces of retaining walls visible from a traveled way or from a populated area shall be plywood except that metal forms may be permitted provided a surface finish satisfactory to the Engineer can be obtained and the use of such forms is approved in writing by the Engineer. Forms for round columns shall be made of materials that will give a smooth finish and true dimensions as given in the plans. Forms for prestressed concrete members shall be either metal or plywood.
- Gothic letters and figures approximating dimensions shown will be acceptable if approved by the Engineer.
- The contractor shall verify the location of all existing utility lines and notify the respective owners before commencing work of excavation or driving of piles.
- Standard Detail Drawings refer to all structures in general, except for modifications as may be required for special conditions. For such modifications refer to the corresponding detailed drawings.

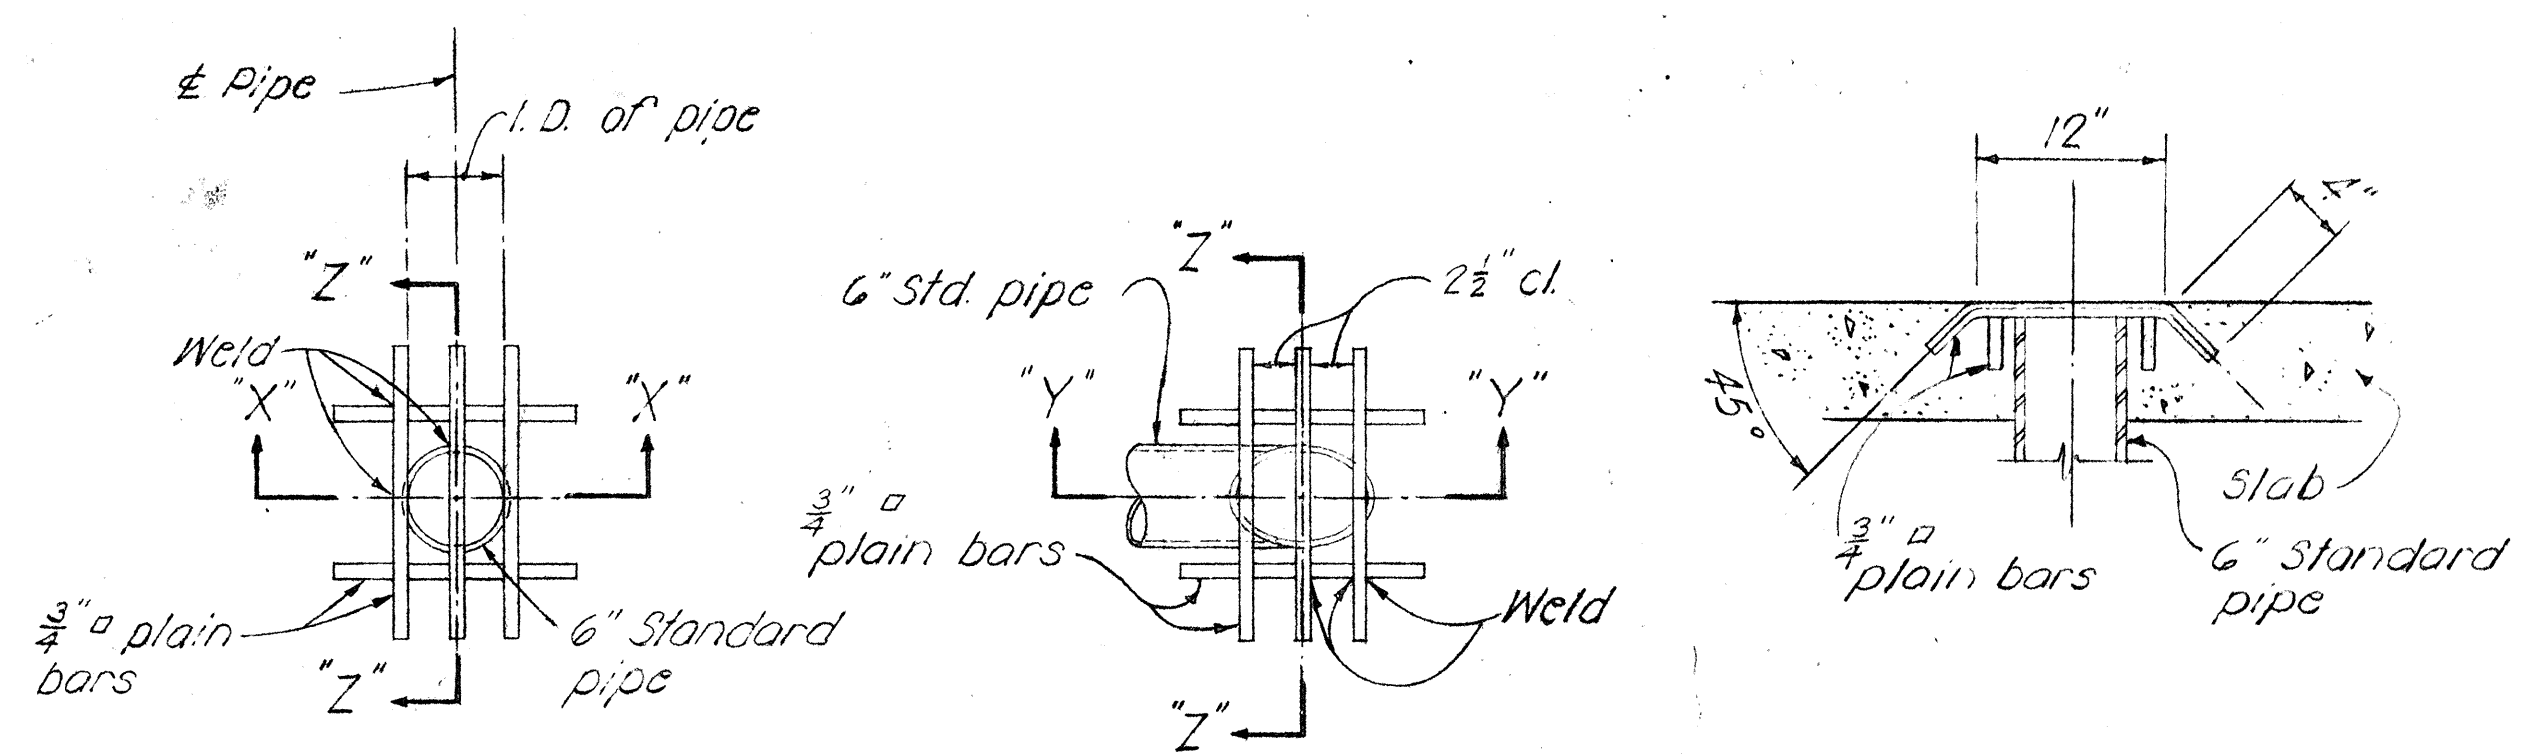

TYPICAL CONCRETE GROOVE DETAIL

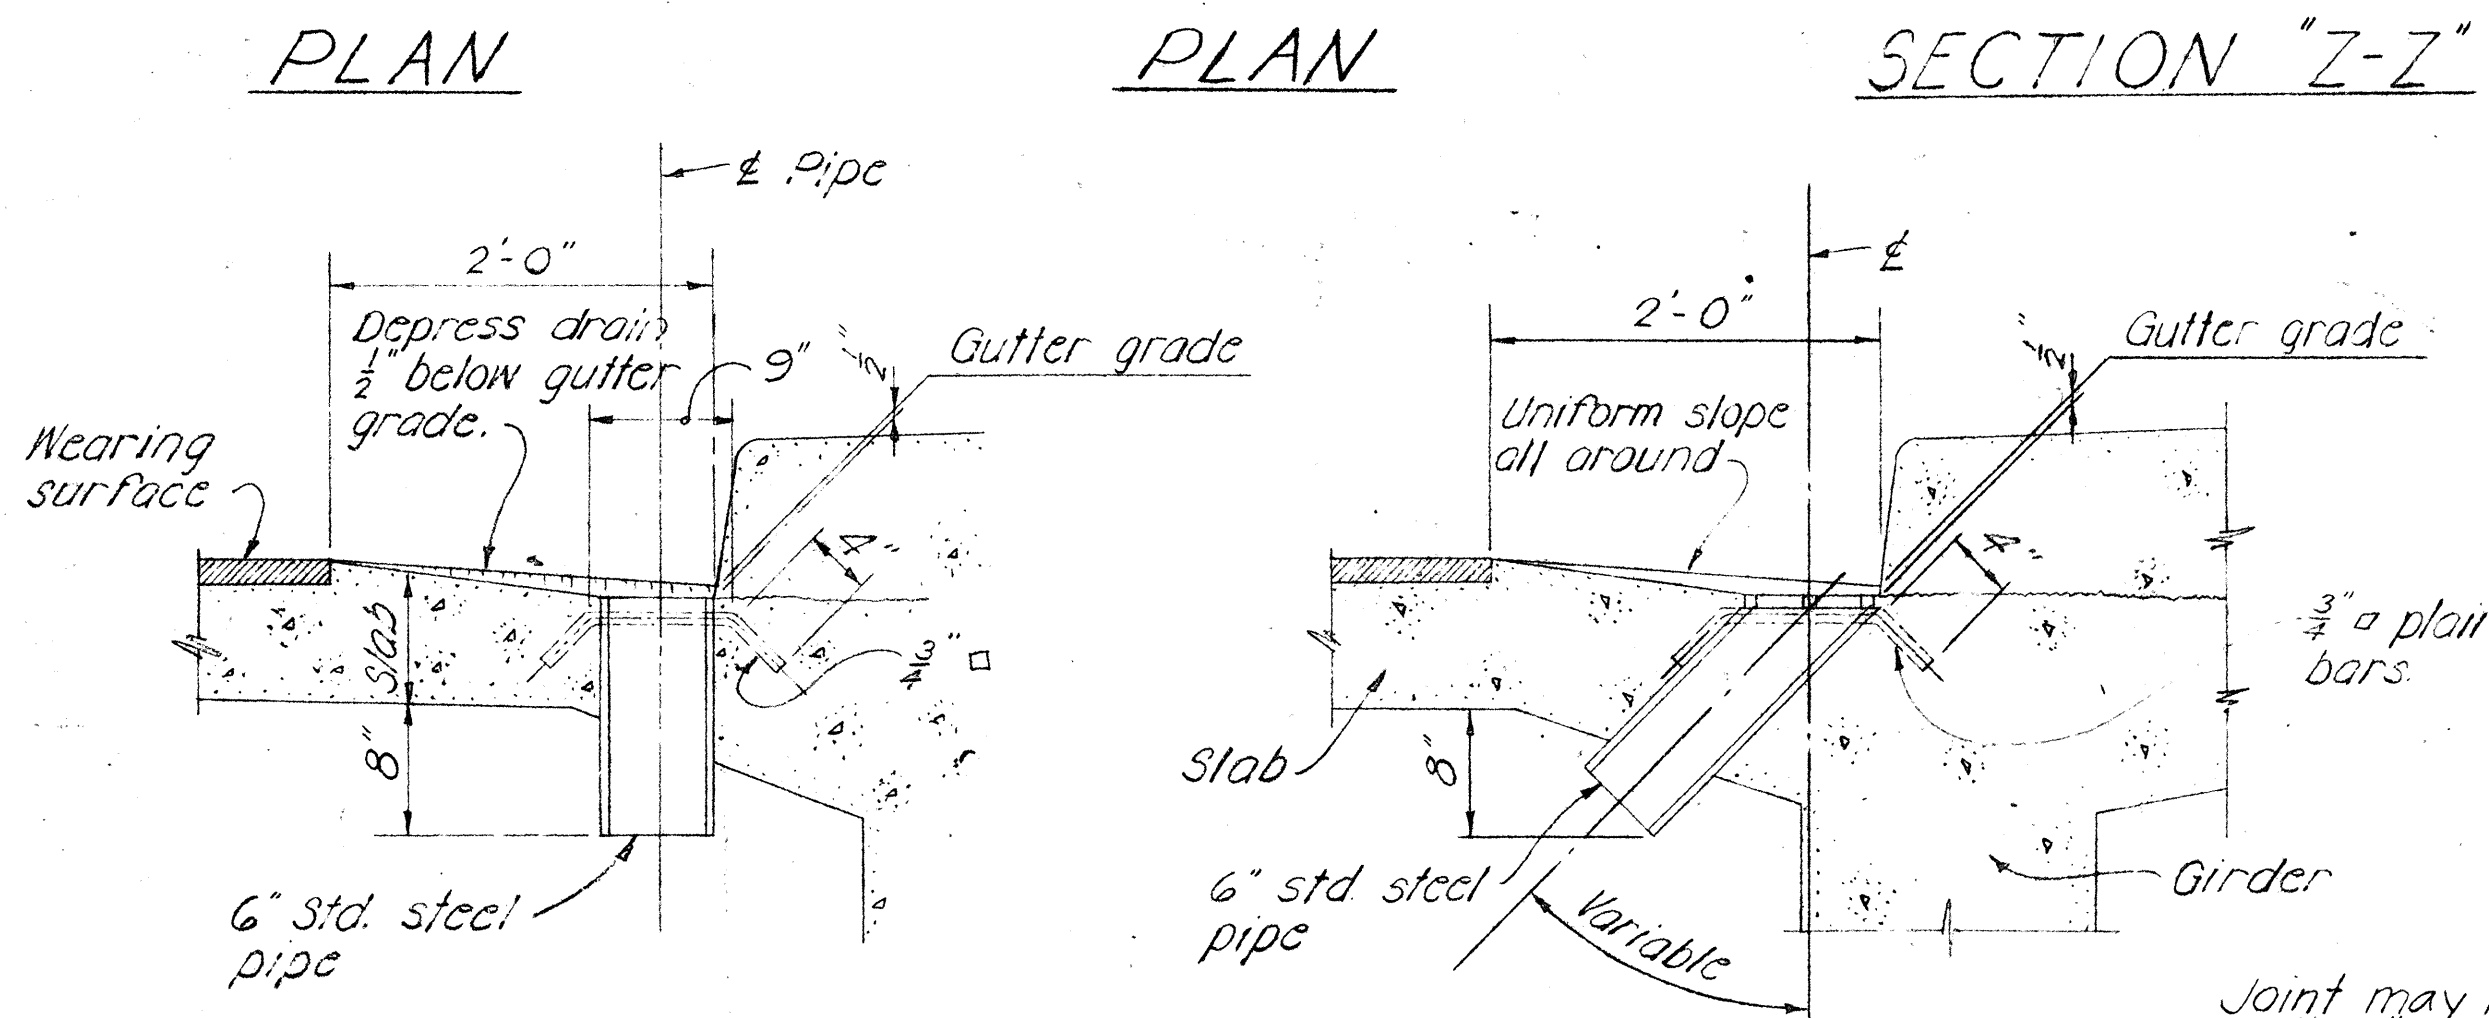


DRIP DETAIL

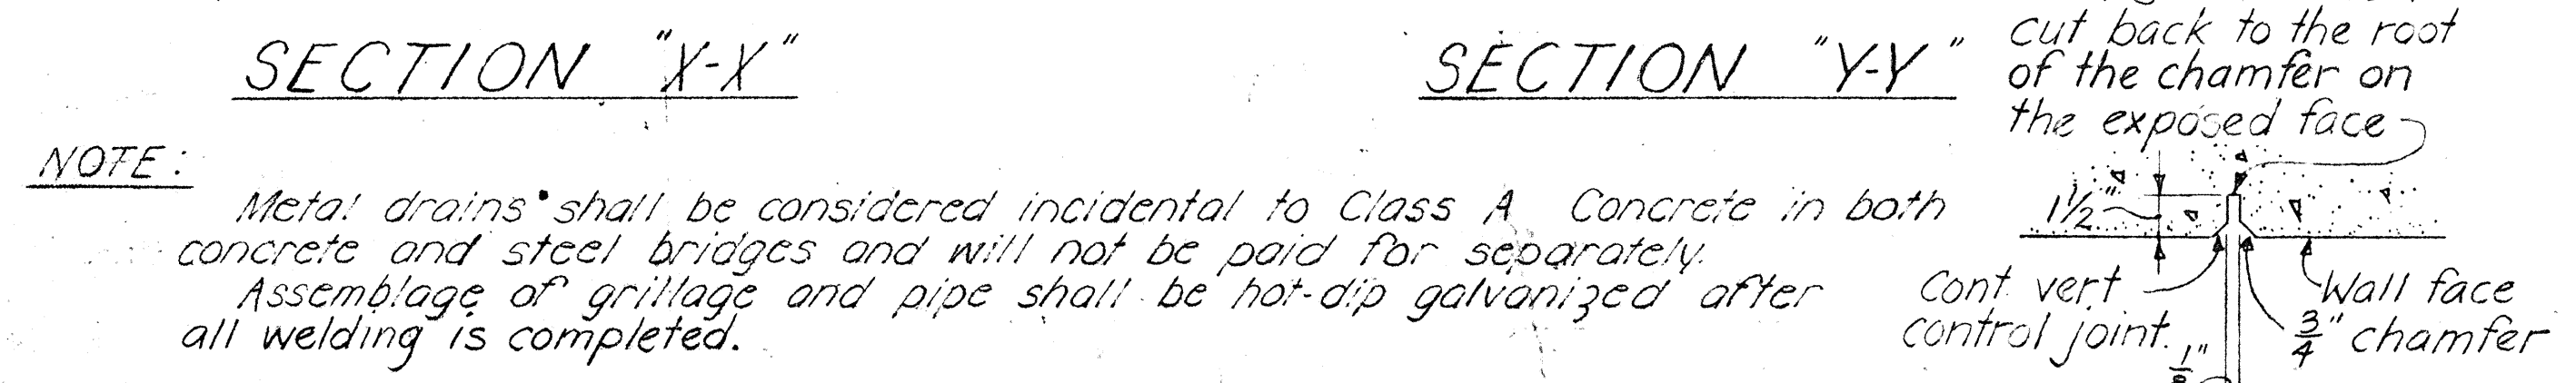


NOTE: Metal drains shall be considered incidental to Class A Concrete in both concrete and steel bridges and will not be paid for separately. Assembly of grillage and pipe shall be hot-dip galvanized after all welding is completed.


TYPICAL DRAINAGE DETAILS

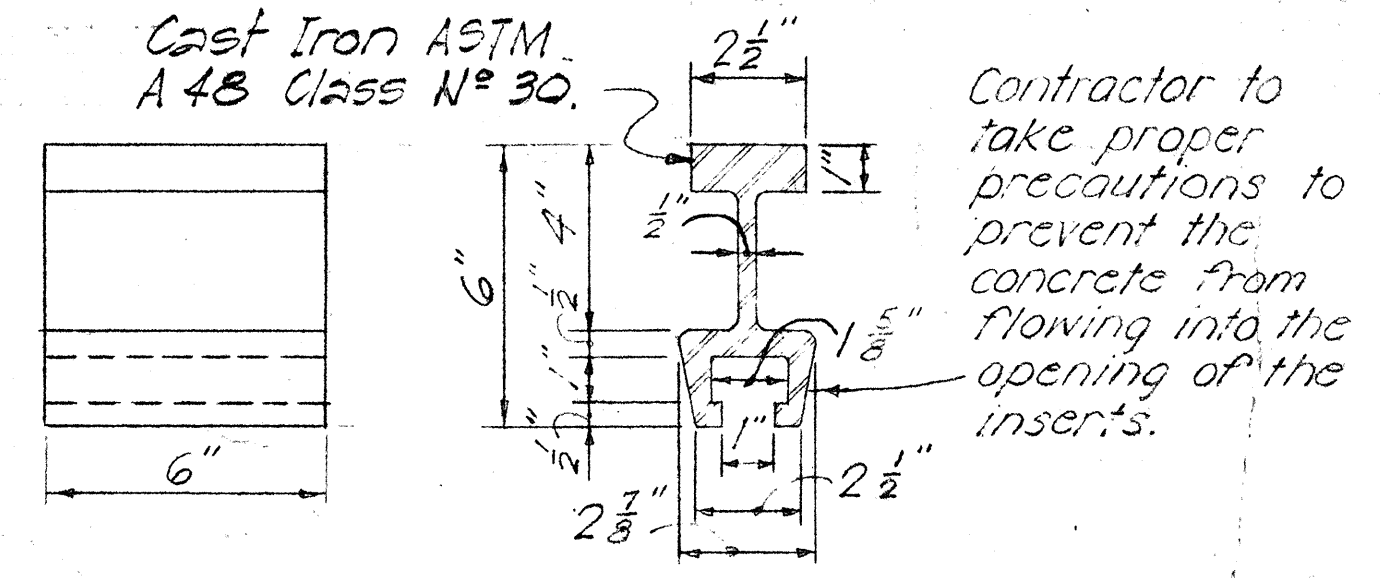


INSERT DETAIL

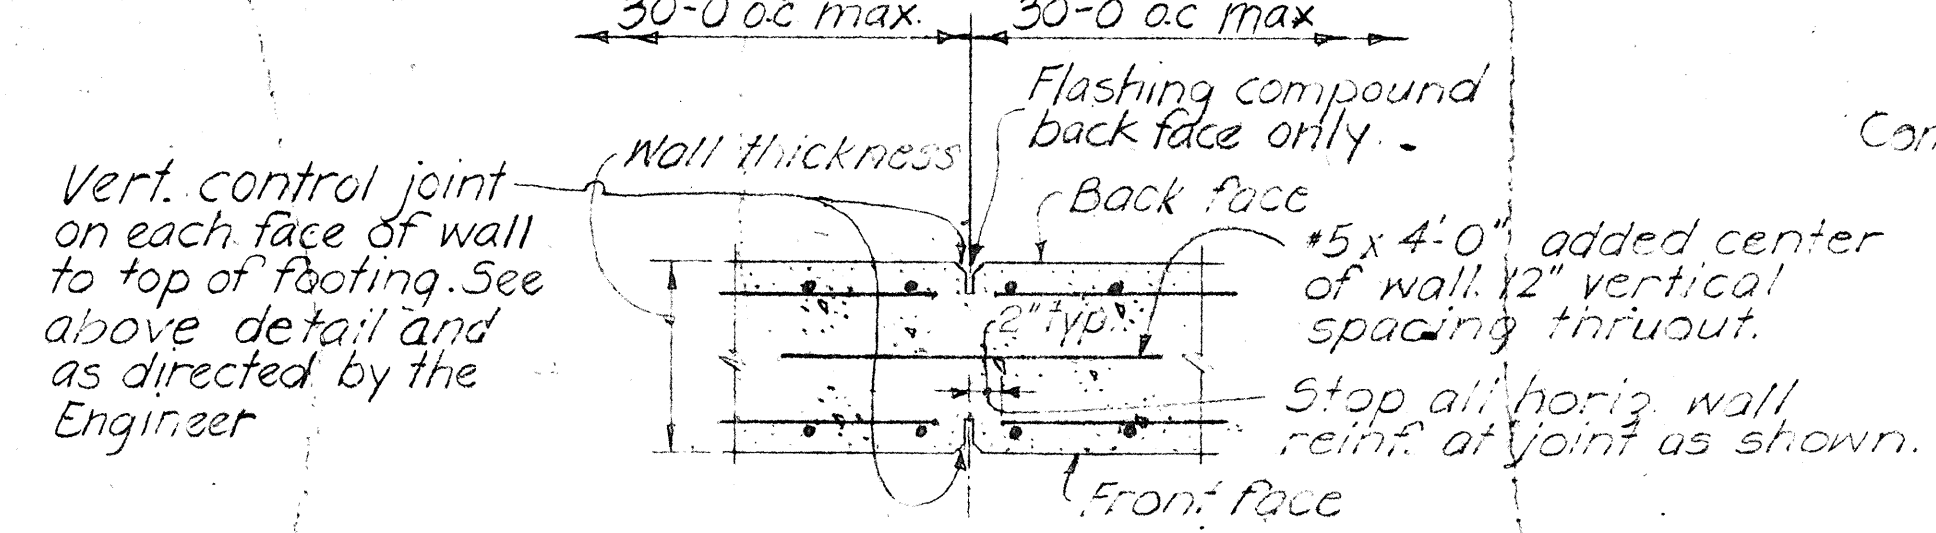

CONTROL JOINT DETAILS

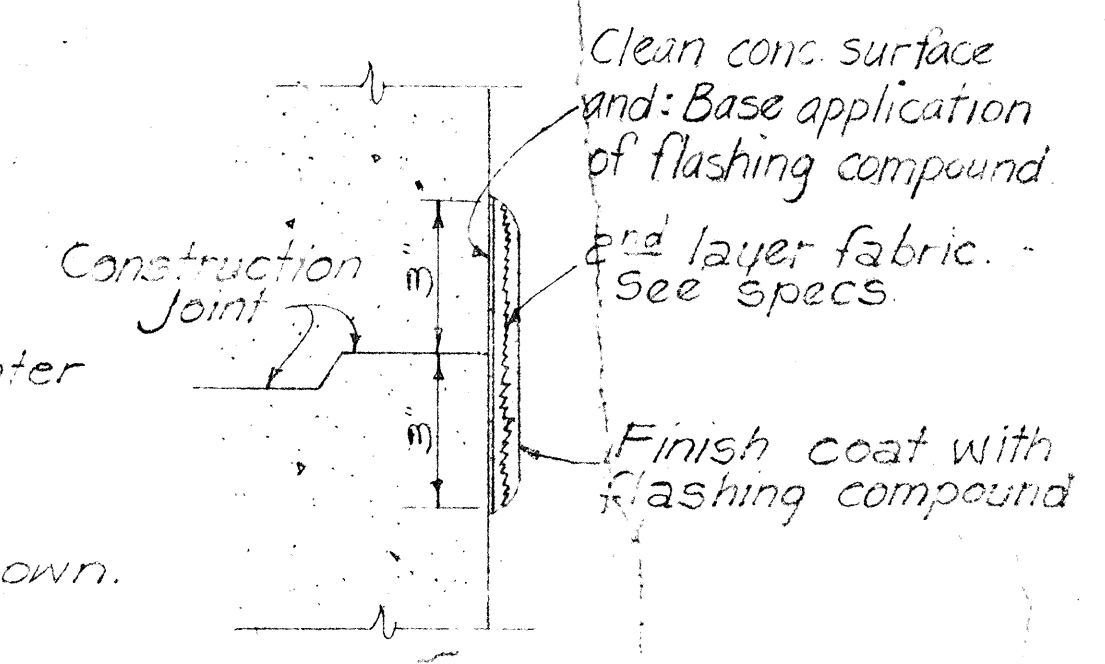

TYP. FLASHING COMPOUND WATERPROOFING DETAIL

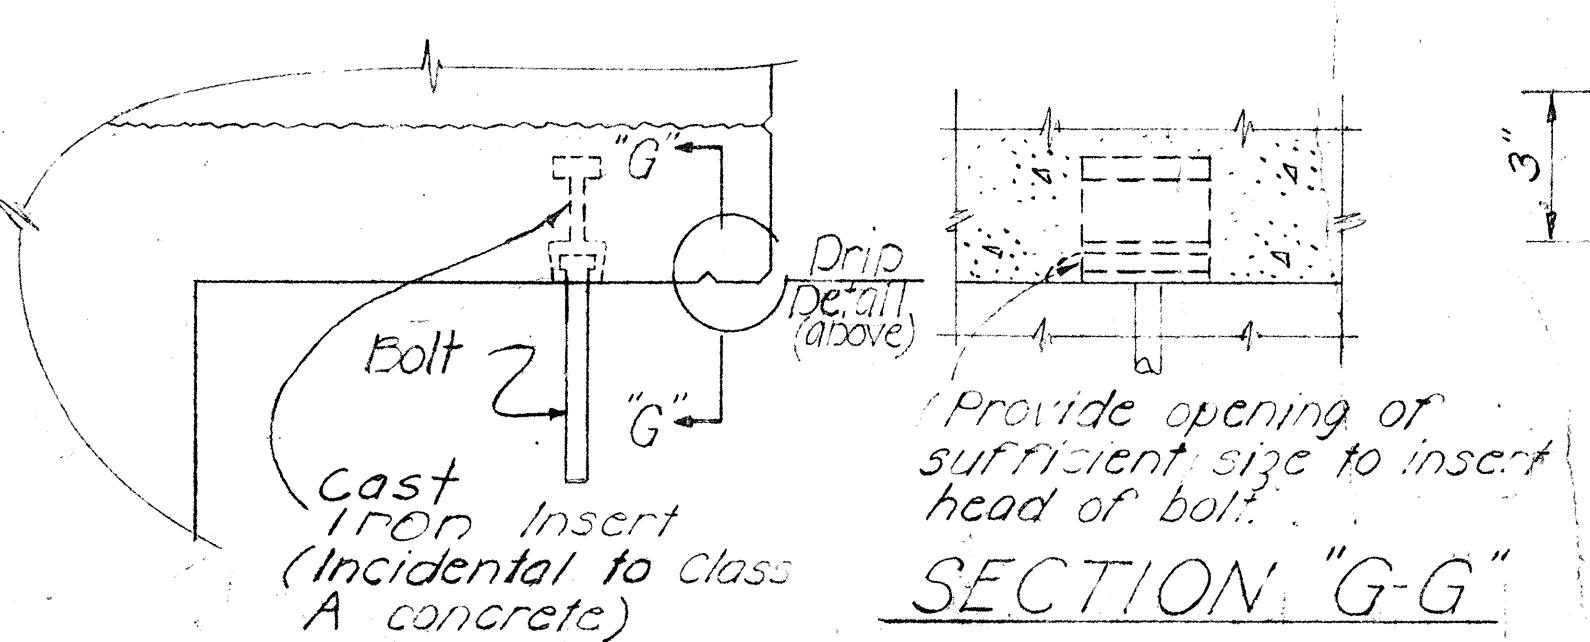


DETAIL of PIPE HANGERS & INSERTS

NAME DATE

Use correct name of bridge Date of Year built
NOTE: Refer to corresponding detail drawings for placement of such names & dates at end post. Exact details & spacing of letters & figures shall be as directed by the Engineer. See Note #12

TYPICAL DETAIL OF LETTERS & FIGURES AT CONCRETE END POST

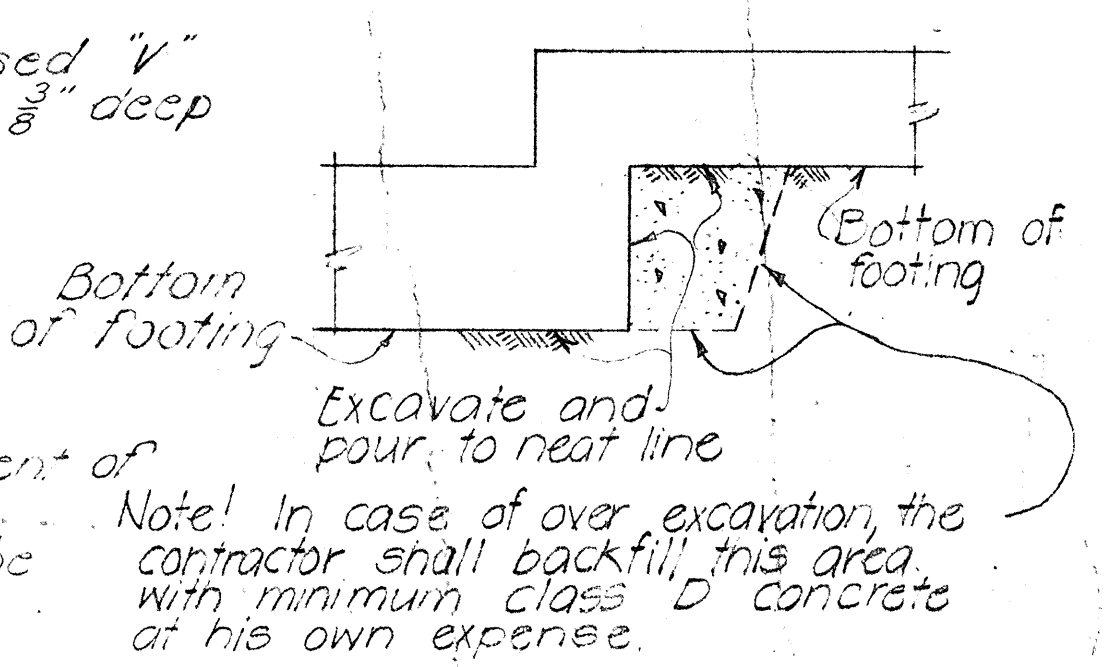


TYPICAL EXCAVATION FOR CONTINUOUS FOOTING STEP-UP

APPROVAL RECOMMENDED:
 Paul T. Yamashita 1-23-70
 BRIDGE DESIGN ENGINEER DATE

APPROVED:
 Paul T. Yamashita 1-28-70
 ASSISTANT CHIEF, ENGINEERING DATE

NO.	REVISION	APPROVED BY	DATE

STATE OF HAWAII
 DEPARTMENT OF TRANSPORTATION
 HIGHWAYS DIVISION
STANDARD DETAILS
 NOTES AND MISCELLANEOUS
 DETAILS
 Date: October 1969
 SHEET No. 13 OF 20 SHEETS DB-100

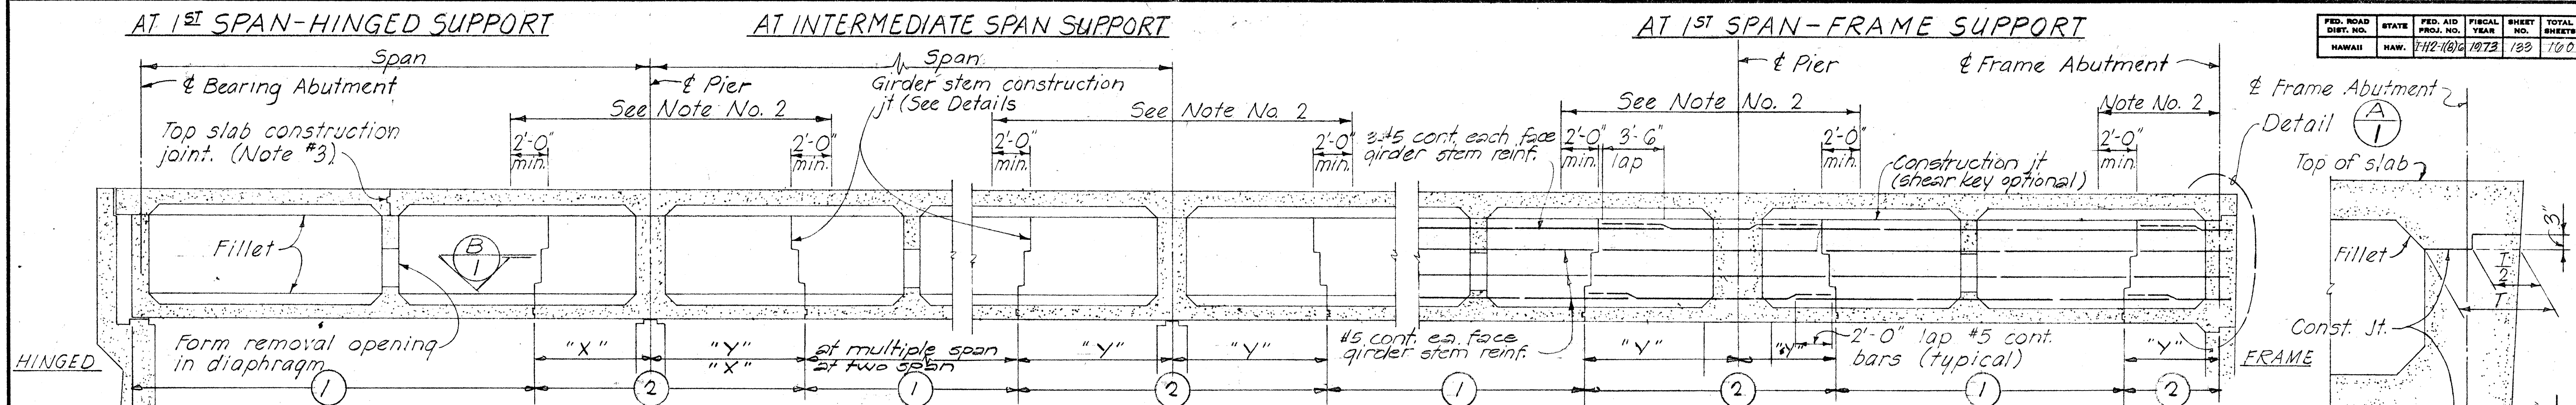


PLACING DIAGRAM FOR SUPERSTRUCTURE CONCRETE

NOTE:


- Numbers ① & ② indicate sequence of placing bottom slab & girder stem concrete. ② may be placed with ① when approved by the Engineer provided that the ① sections adjoining the ② sections are placed in this pour. For any deviation from the above the Contractor shall submit a diagram to the Engineer for approval.
- No top slab construction joint or form removal opening shall be located in the region over the piers as noted, nor in the supporting section of a hinged span.
- When top slab is not poured continuously, and top slab forms are not removed, construction joint in top slab shall be located over an intermediate diaphragm.
- Top slab concrete shall be placed separately from the stem. Top slab concrete may be placed continuously or in parts as approved by the Engineer, providing pour is not in conflict with the above notes.
- Dimension "X" = 1/4 span. "Y" = 1/5 span.
- No lapping of main bars shall be permitted at construction joints.

For vertical chamfer detail: see Typical Vertical Chamfer Det.

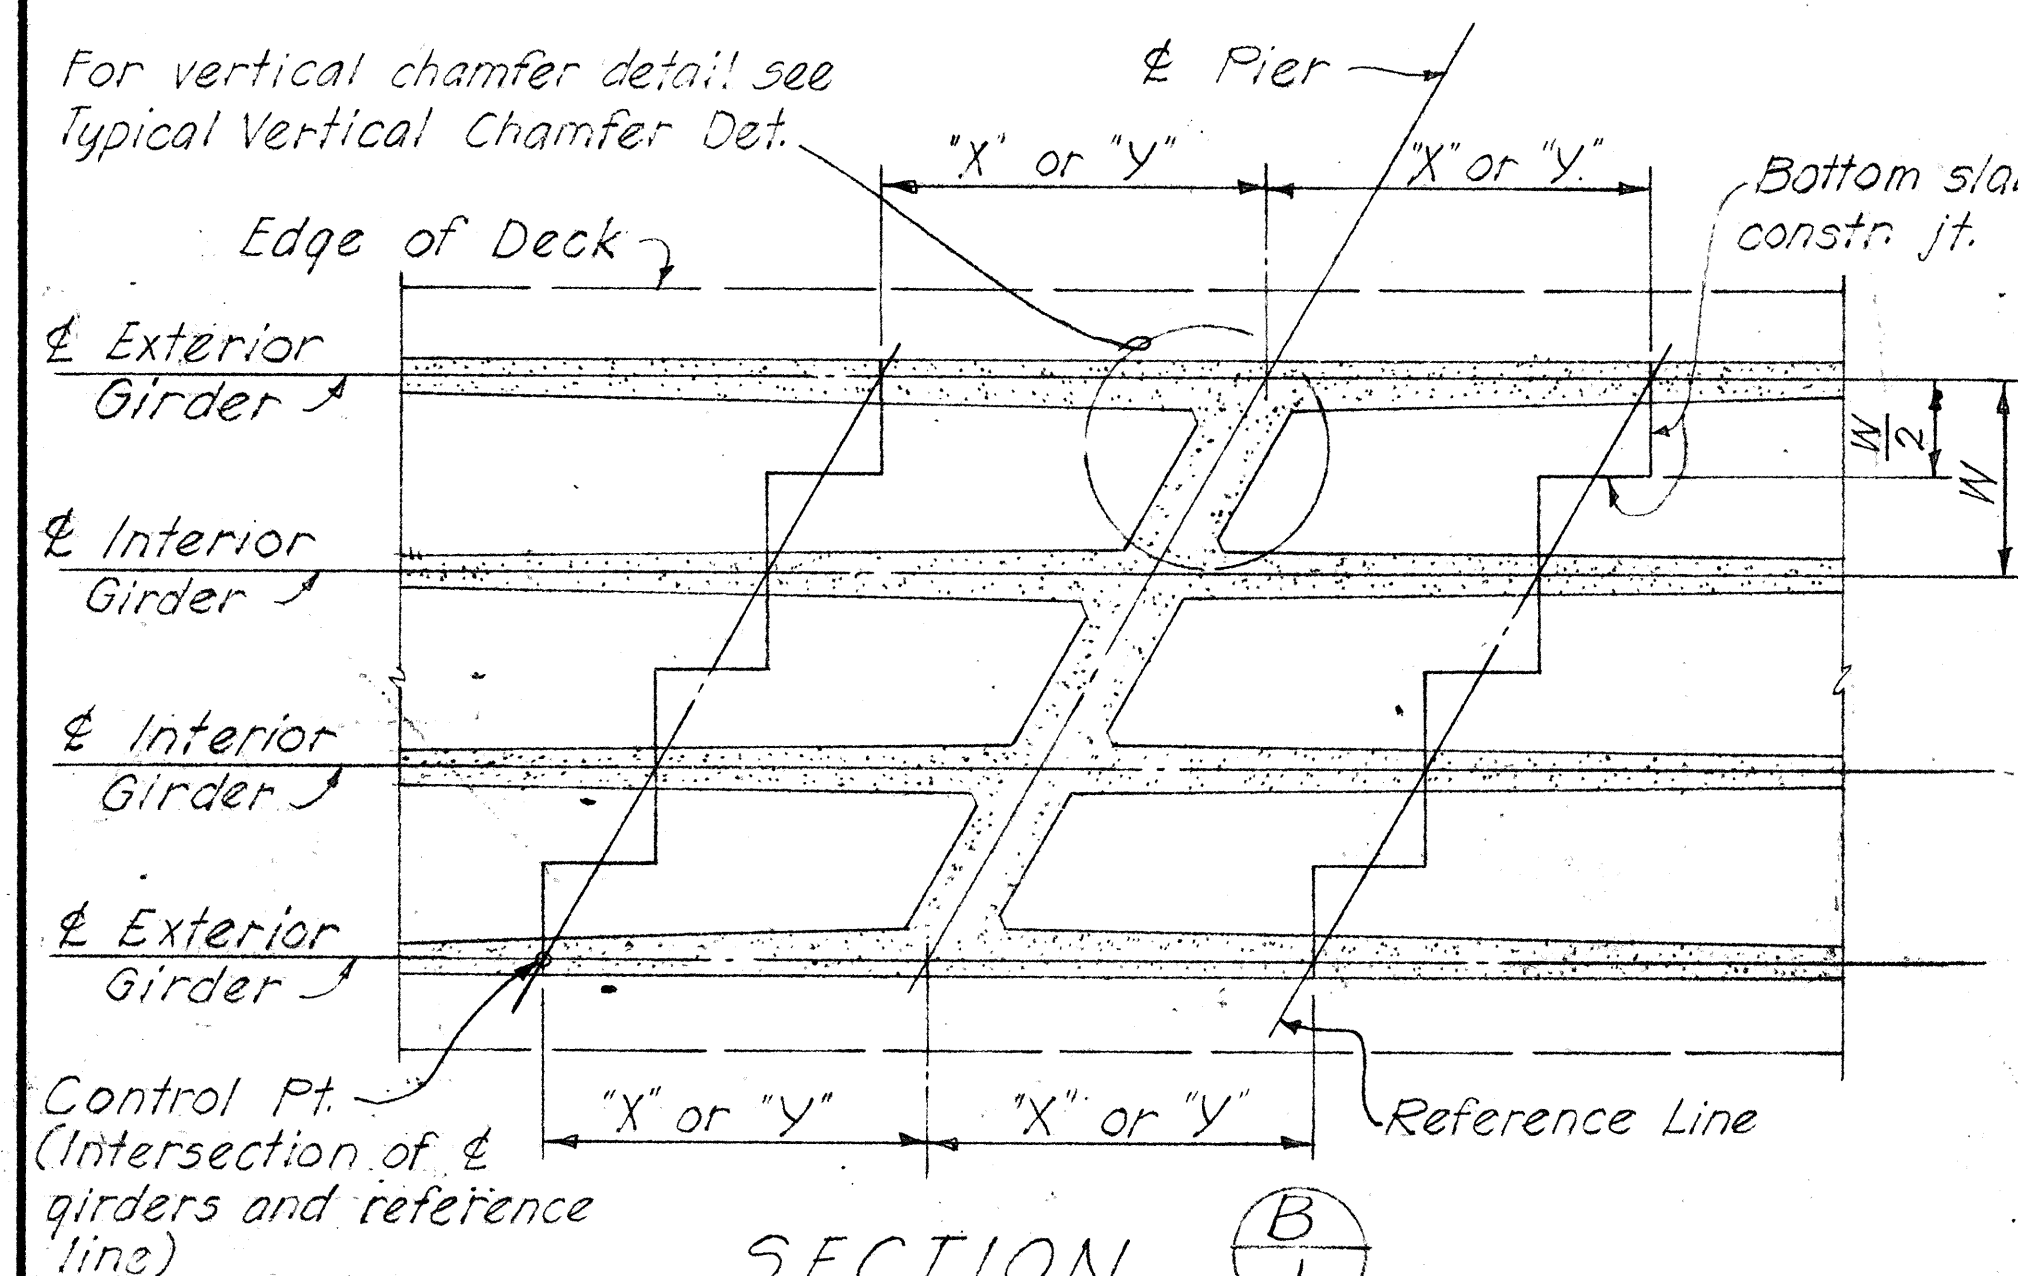

SECTION B-1


TREATMENT OF CONSTRUCTION JOINT BRIDGES ON SKEW

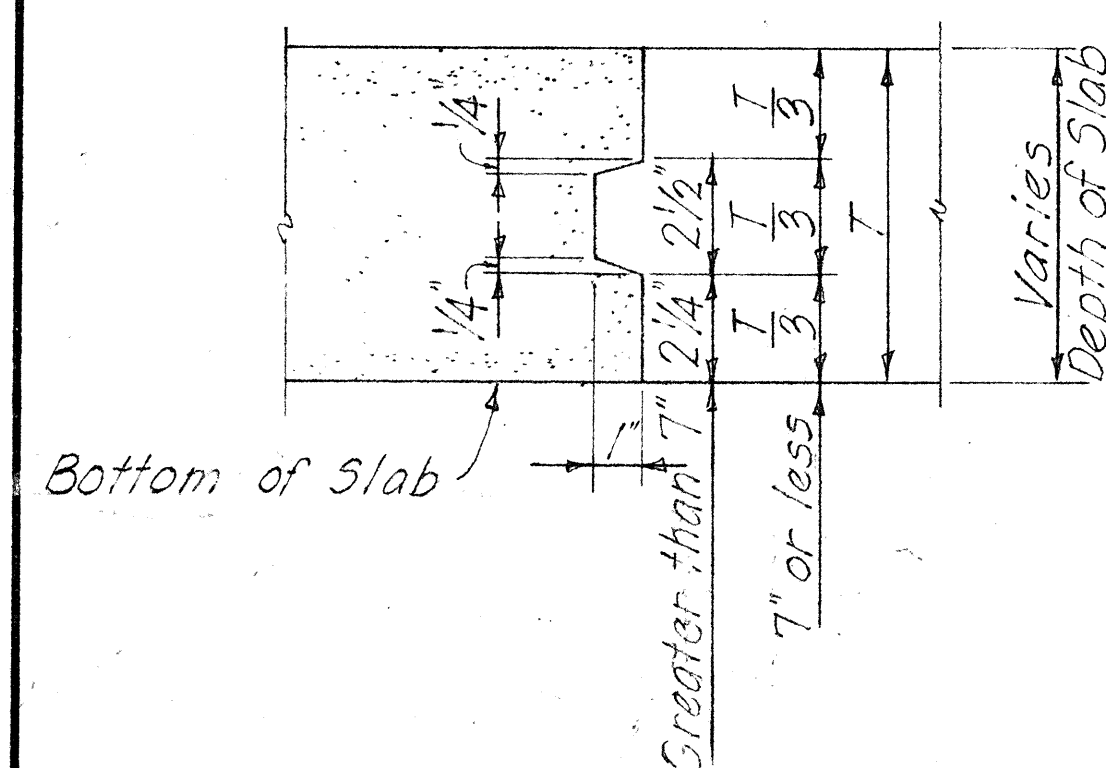

TYPICAL SLAB CONSTRUCTION JOINT DETAIL

NOTE:


If the Contractor elects to leave top slab forms in place, form removal opening shall be omitted and replaced by 3" vent.
No vertical shoring shall be placed in the center half of top slab span W.

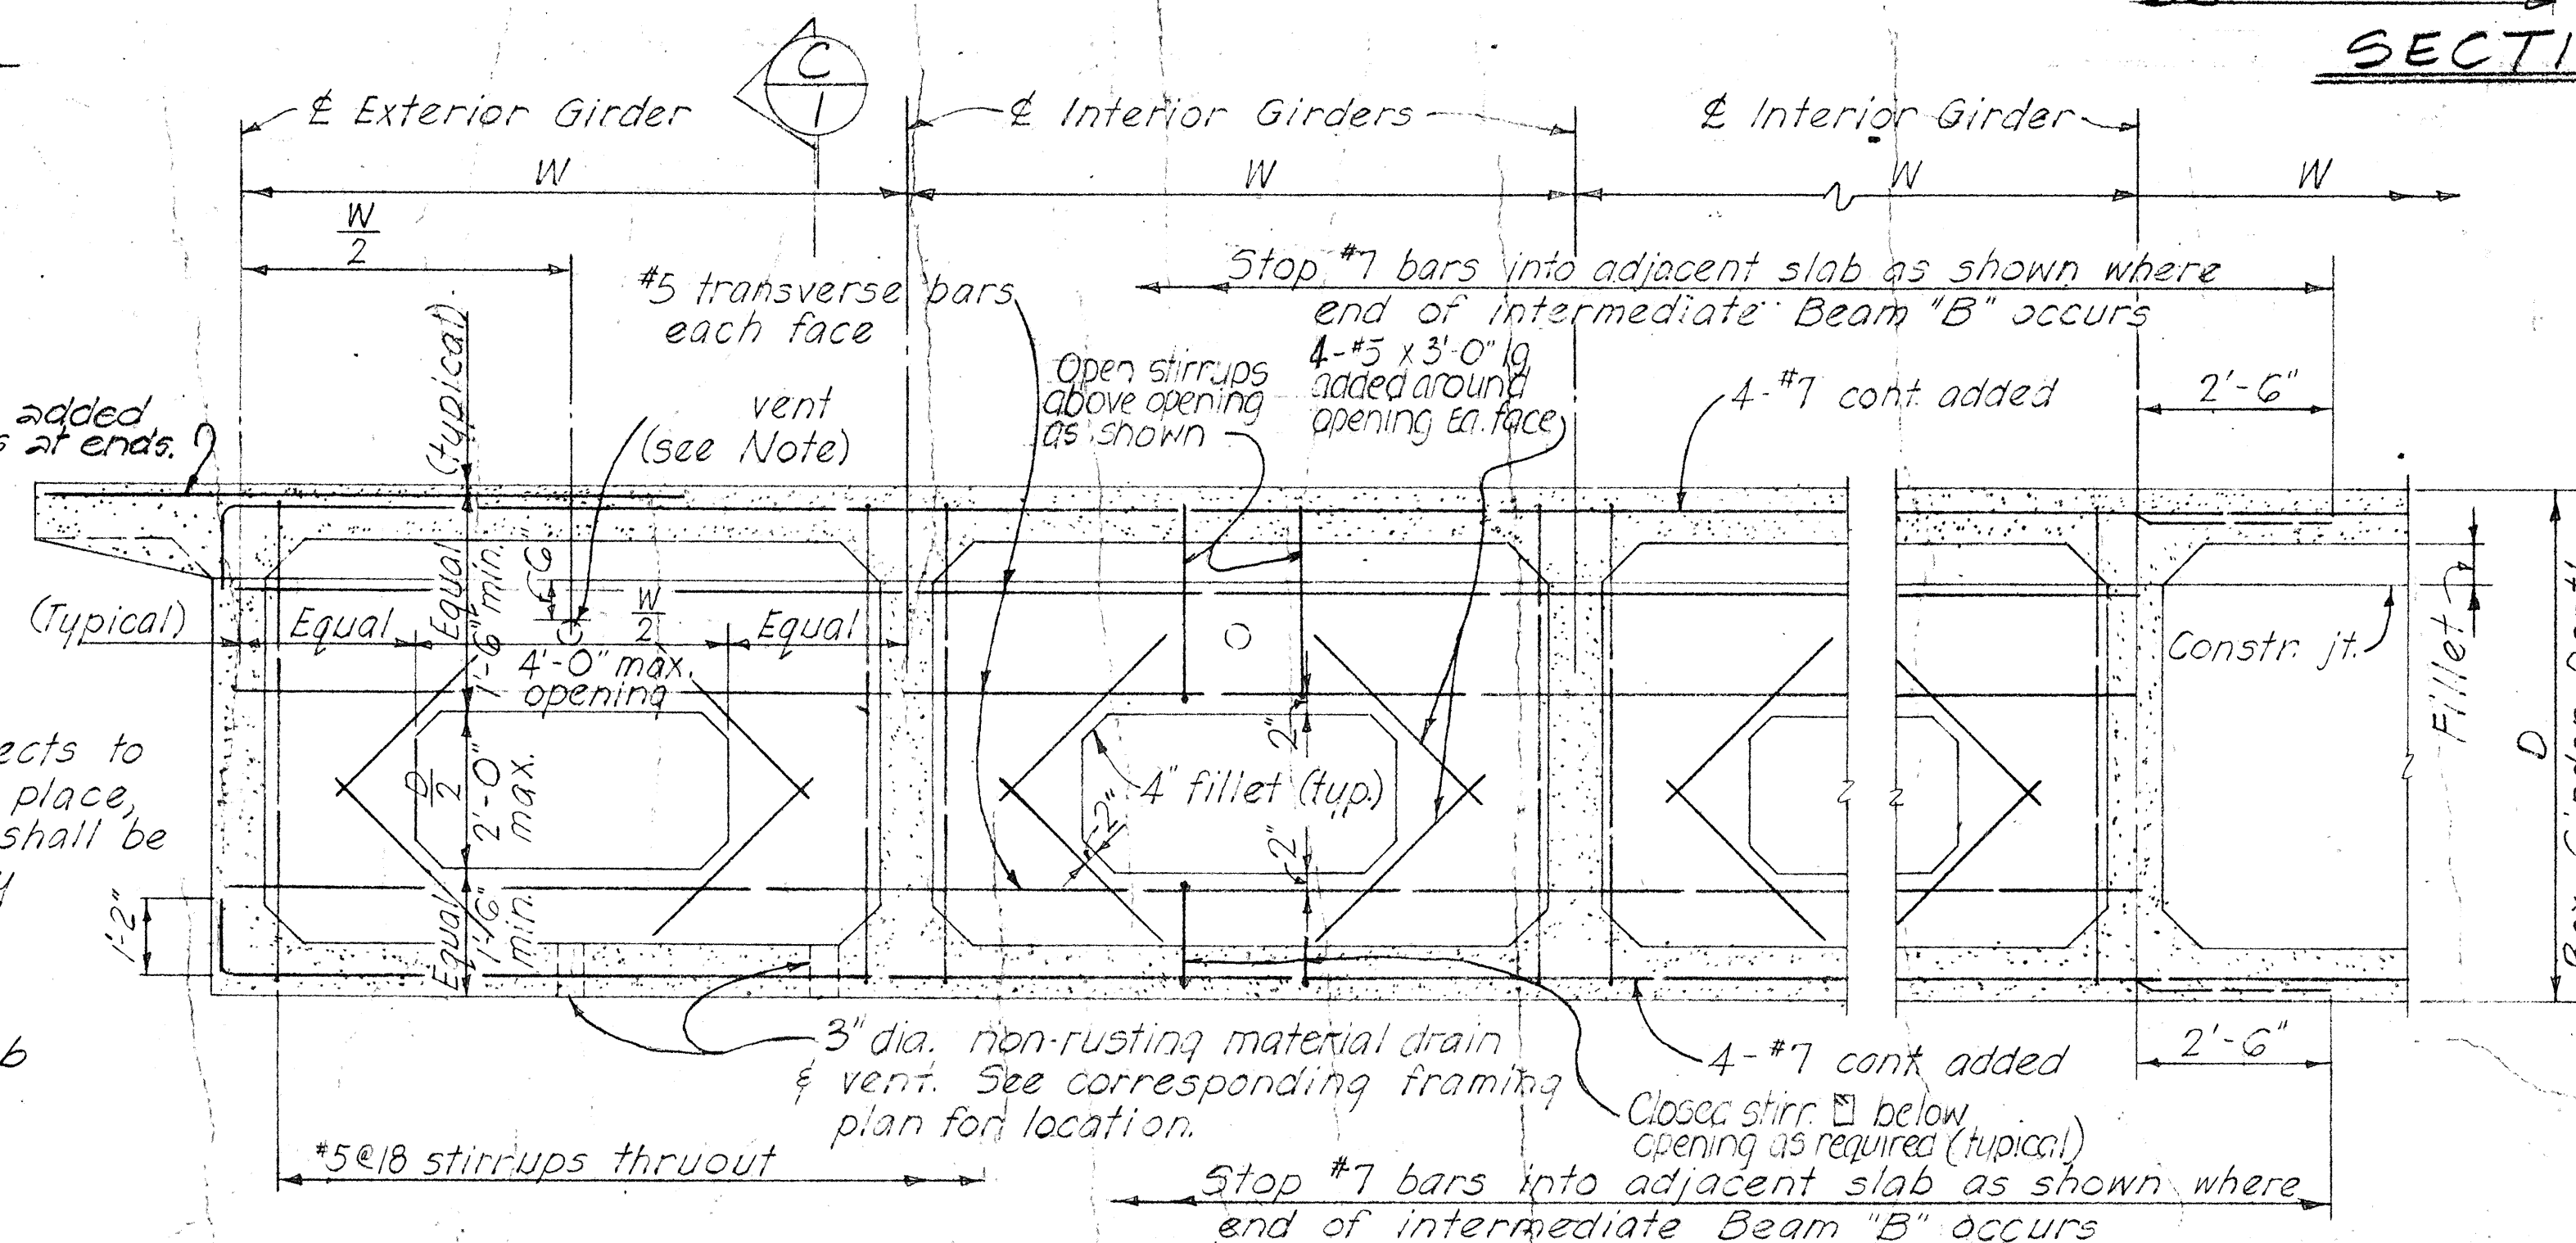

AT NON-CONTINUOUS ENDS

TYPICAL INTERIOR SPAN

TYPICAL BEAM "B" DETAILS

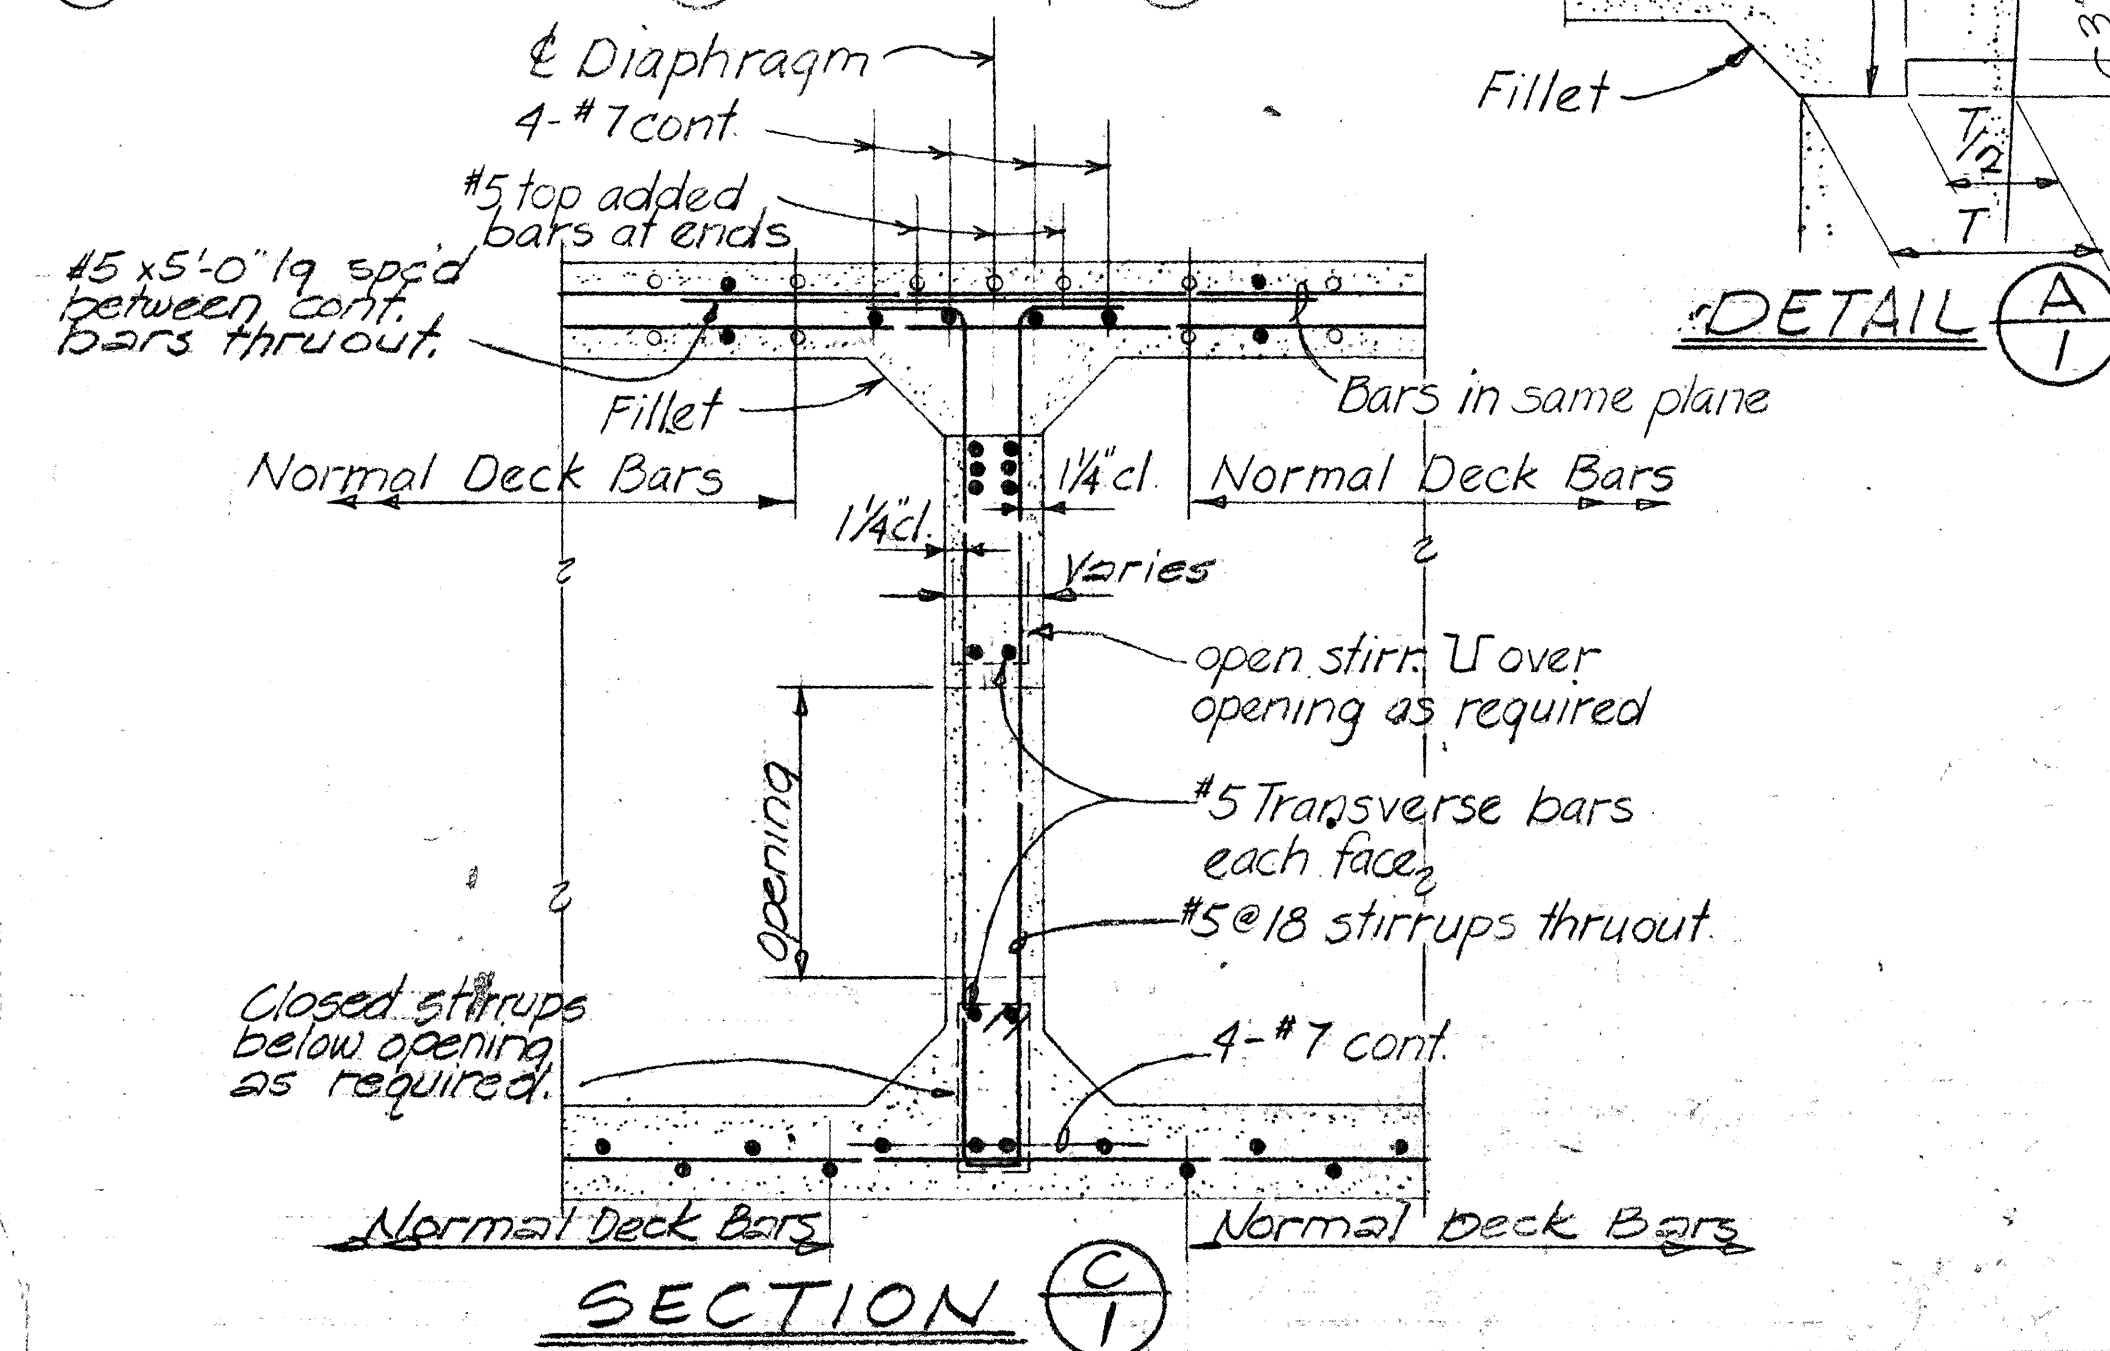

SECTION C-1

NO.	REVISION	APPROVED BY	DATE

APPROVAL RECOMMENDED:

Paul T. Uemeshita
BRIDGE DESIGN ENGINEER

1-23-70
DATE


APPROVED

Paul T. Uemeshita
For ASSISTANT CHIEF, ENGINEERING

1-28-70
DATE

STATE OF HAWAII
DEPARTMENT OF TRANSPORTATION
HIGHWAYS DIVISION



STANDARD DETAILS CONCRETE BOX GIRDER

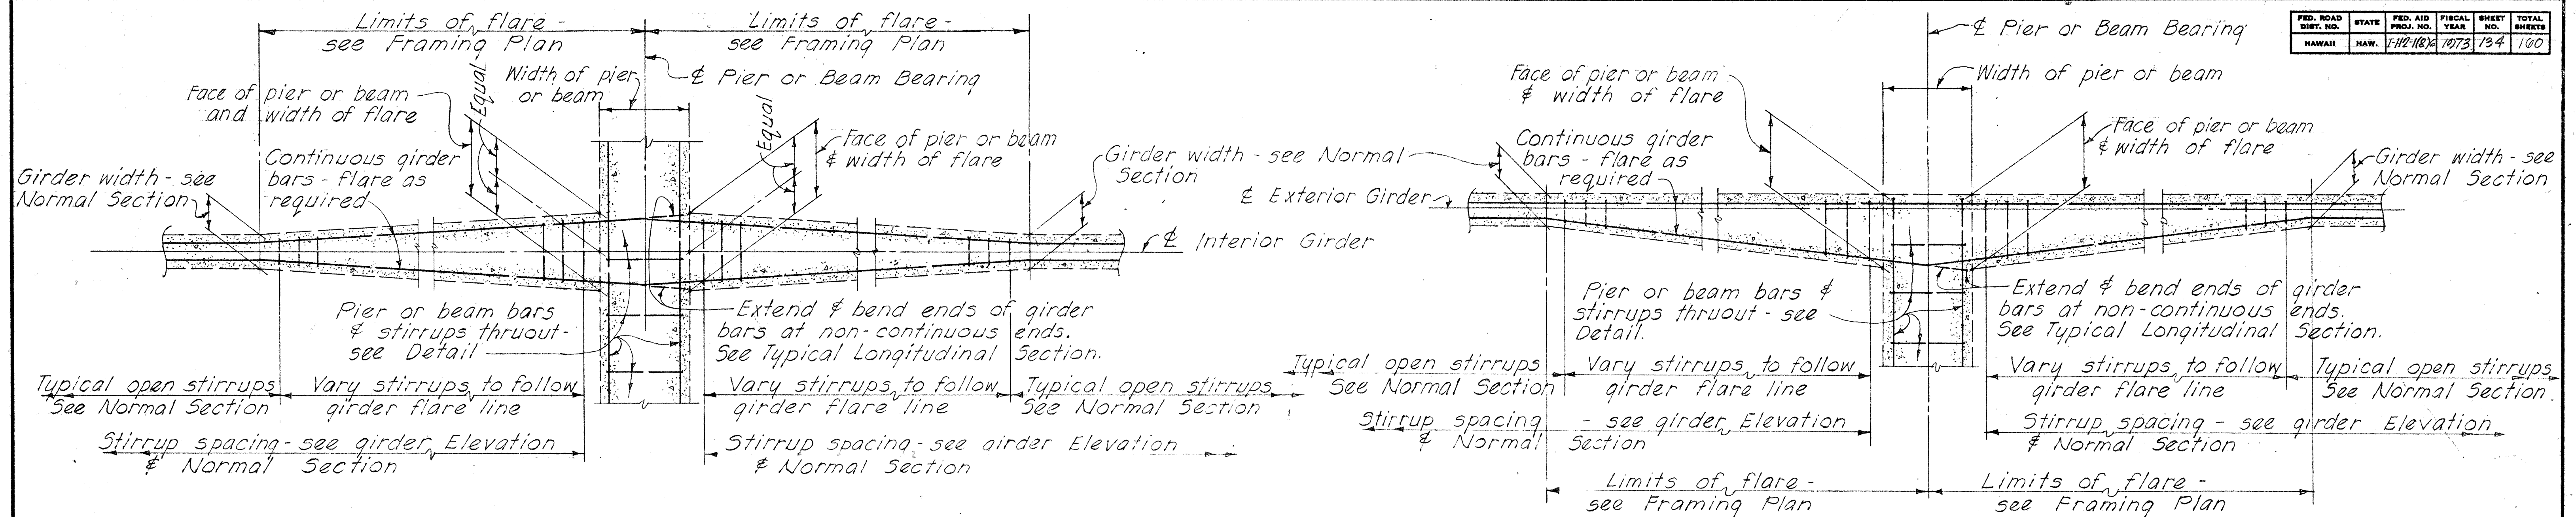

INTERIOR GIRDER

EXTERIOR GIRDER

TYPICAL DETAILS OF GIRDER FLARE AT NORMAL OR RADIAL SUPPORTS - CONTINUOUS ENDS AS SHOWN (NON-CONTINUOUS ENDS SIMILAR EXCEPT AS OTHERWISE NOTED)

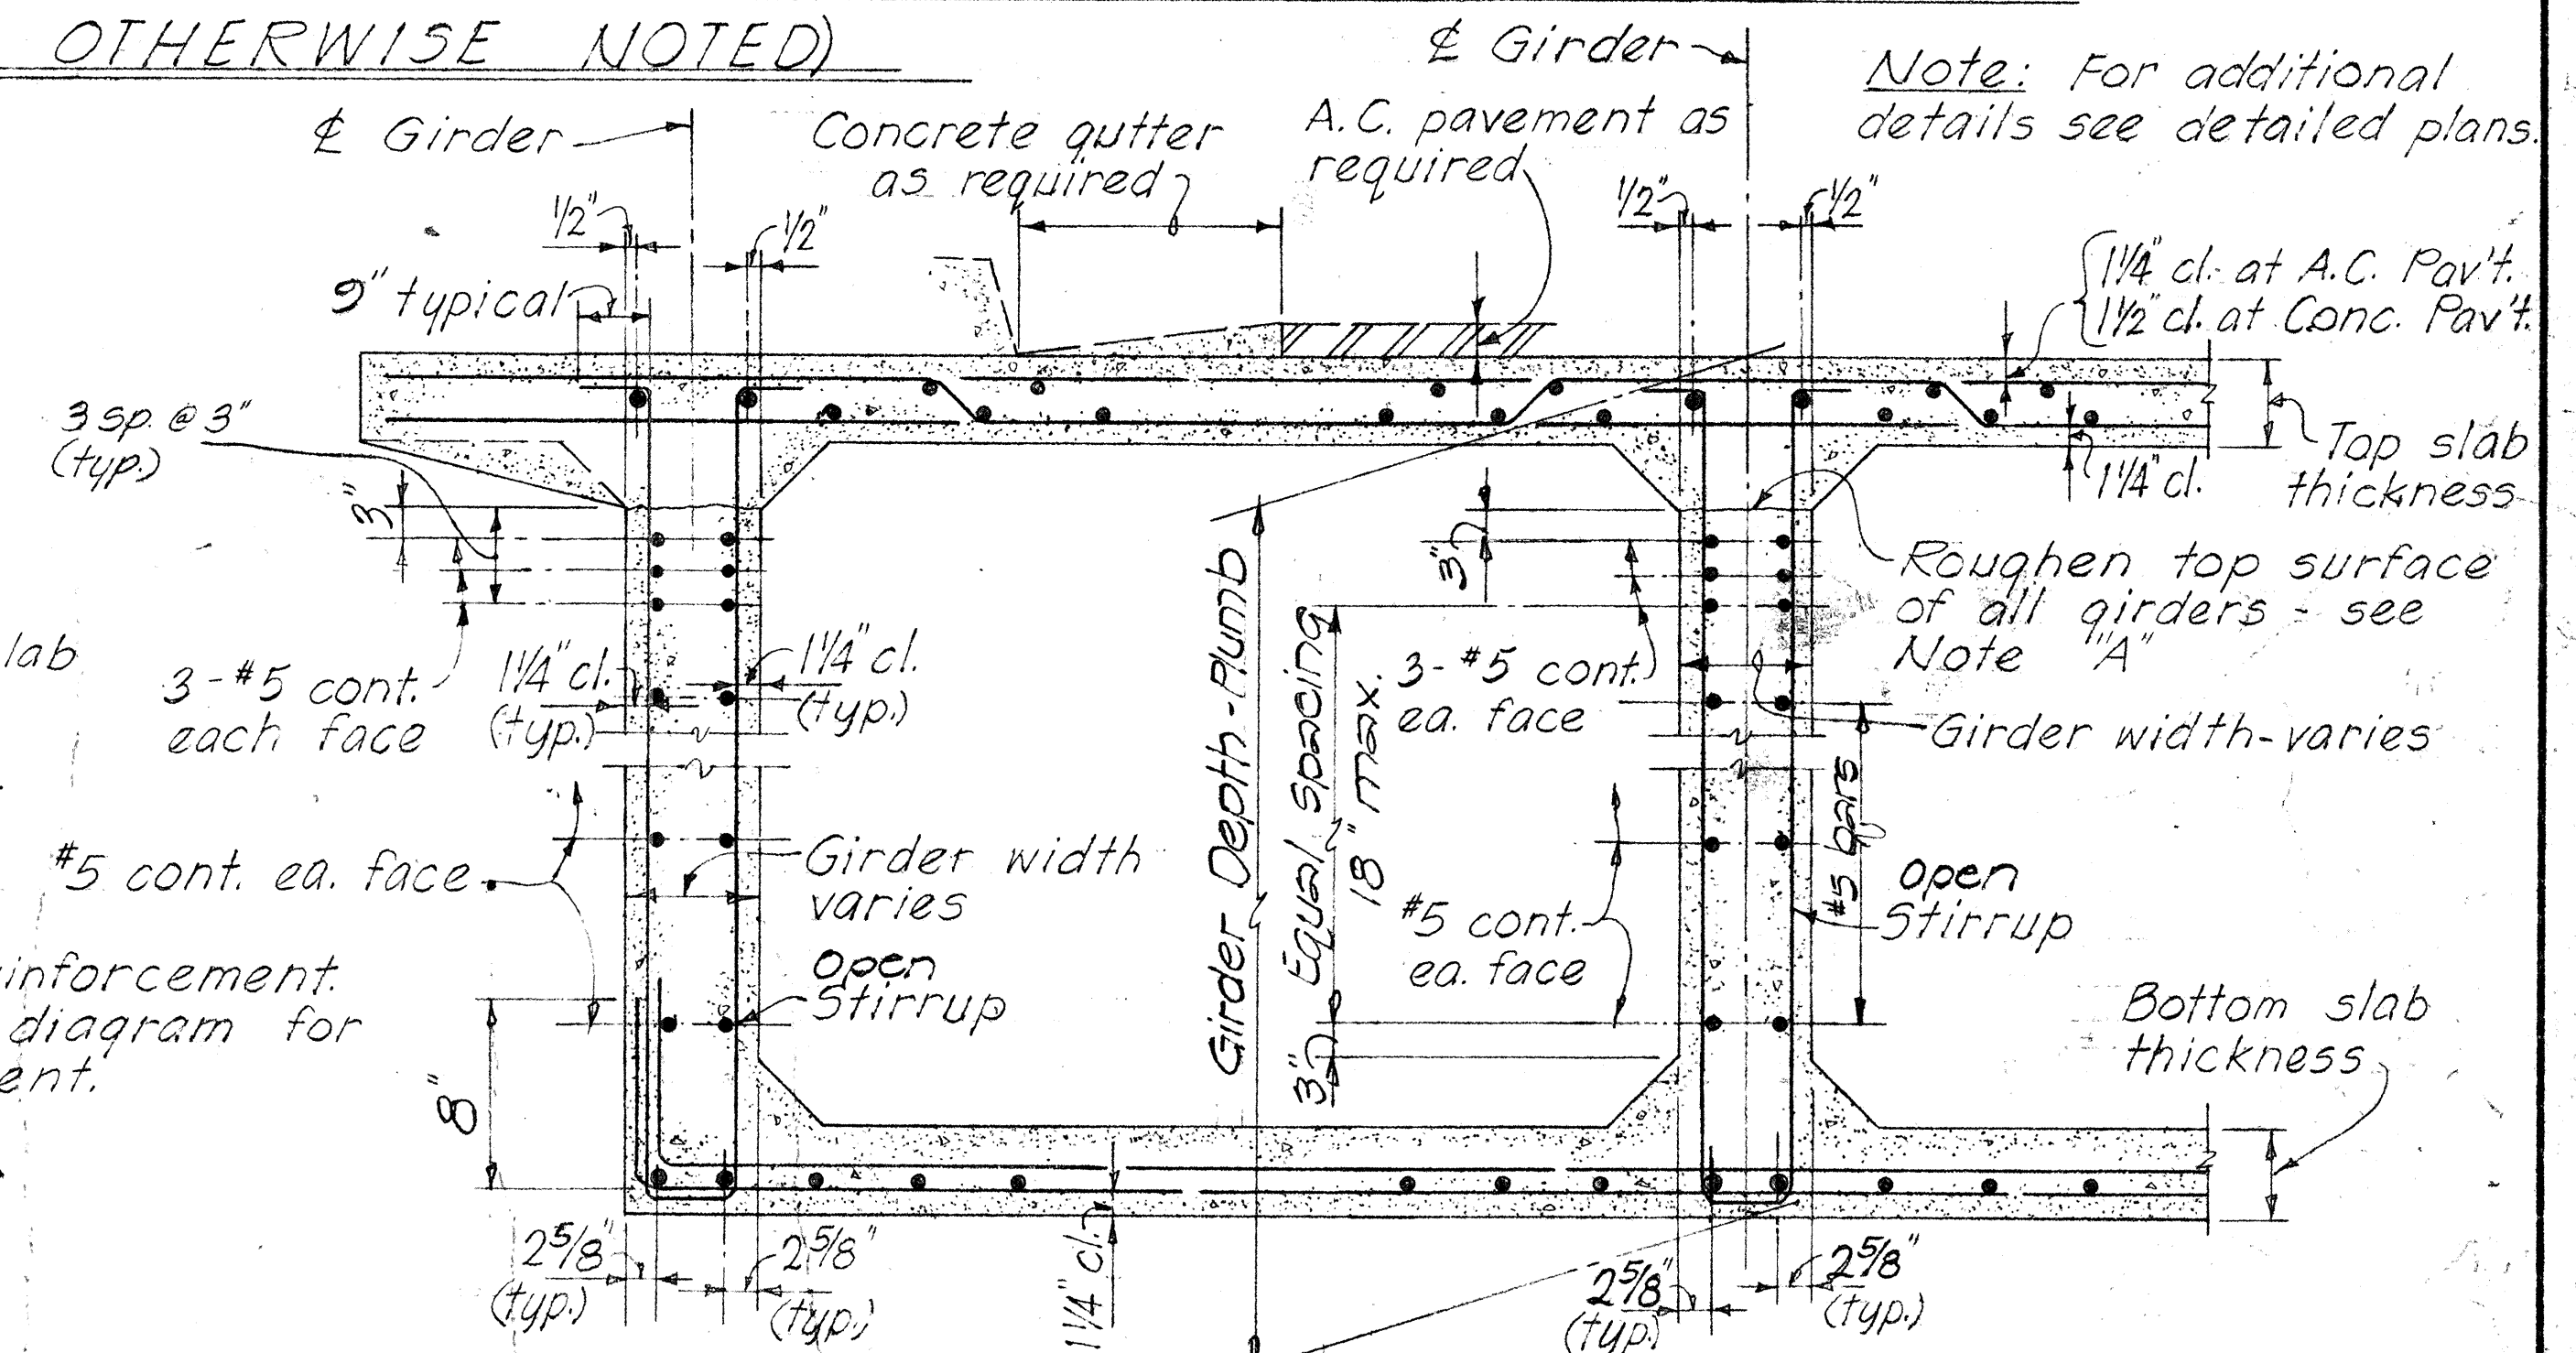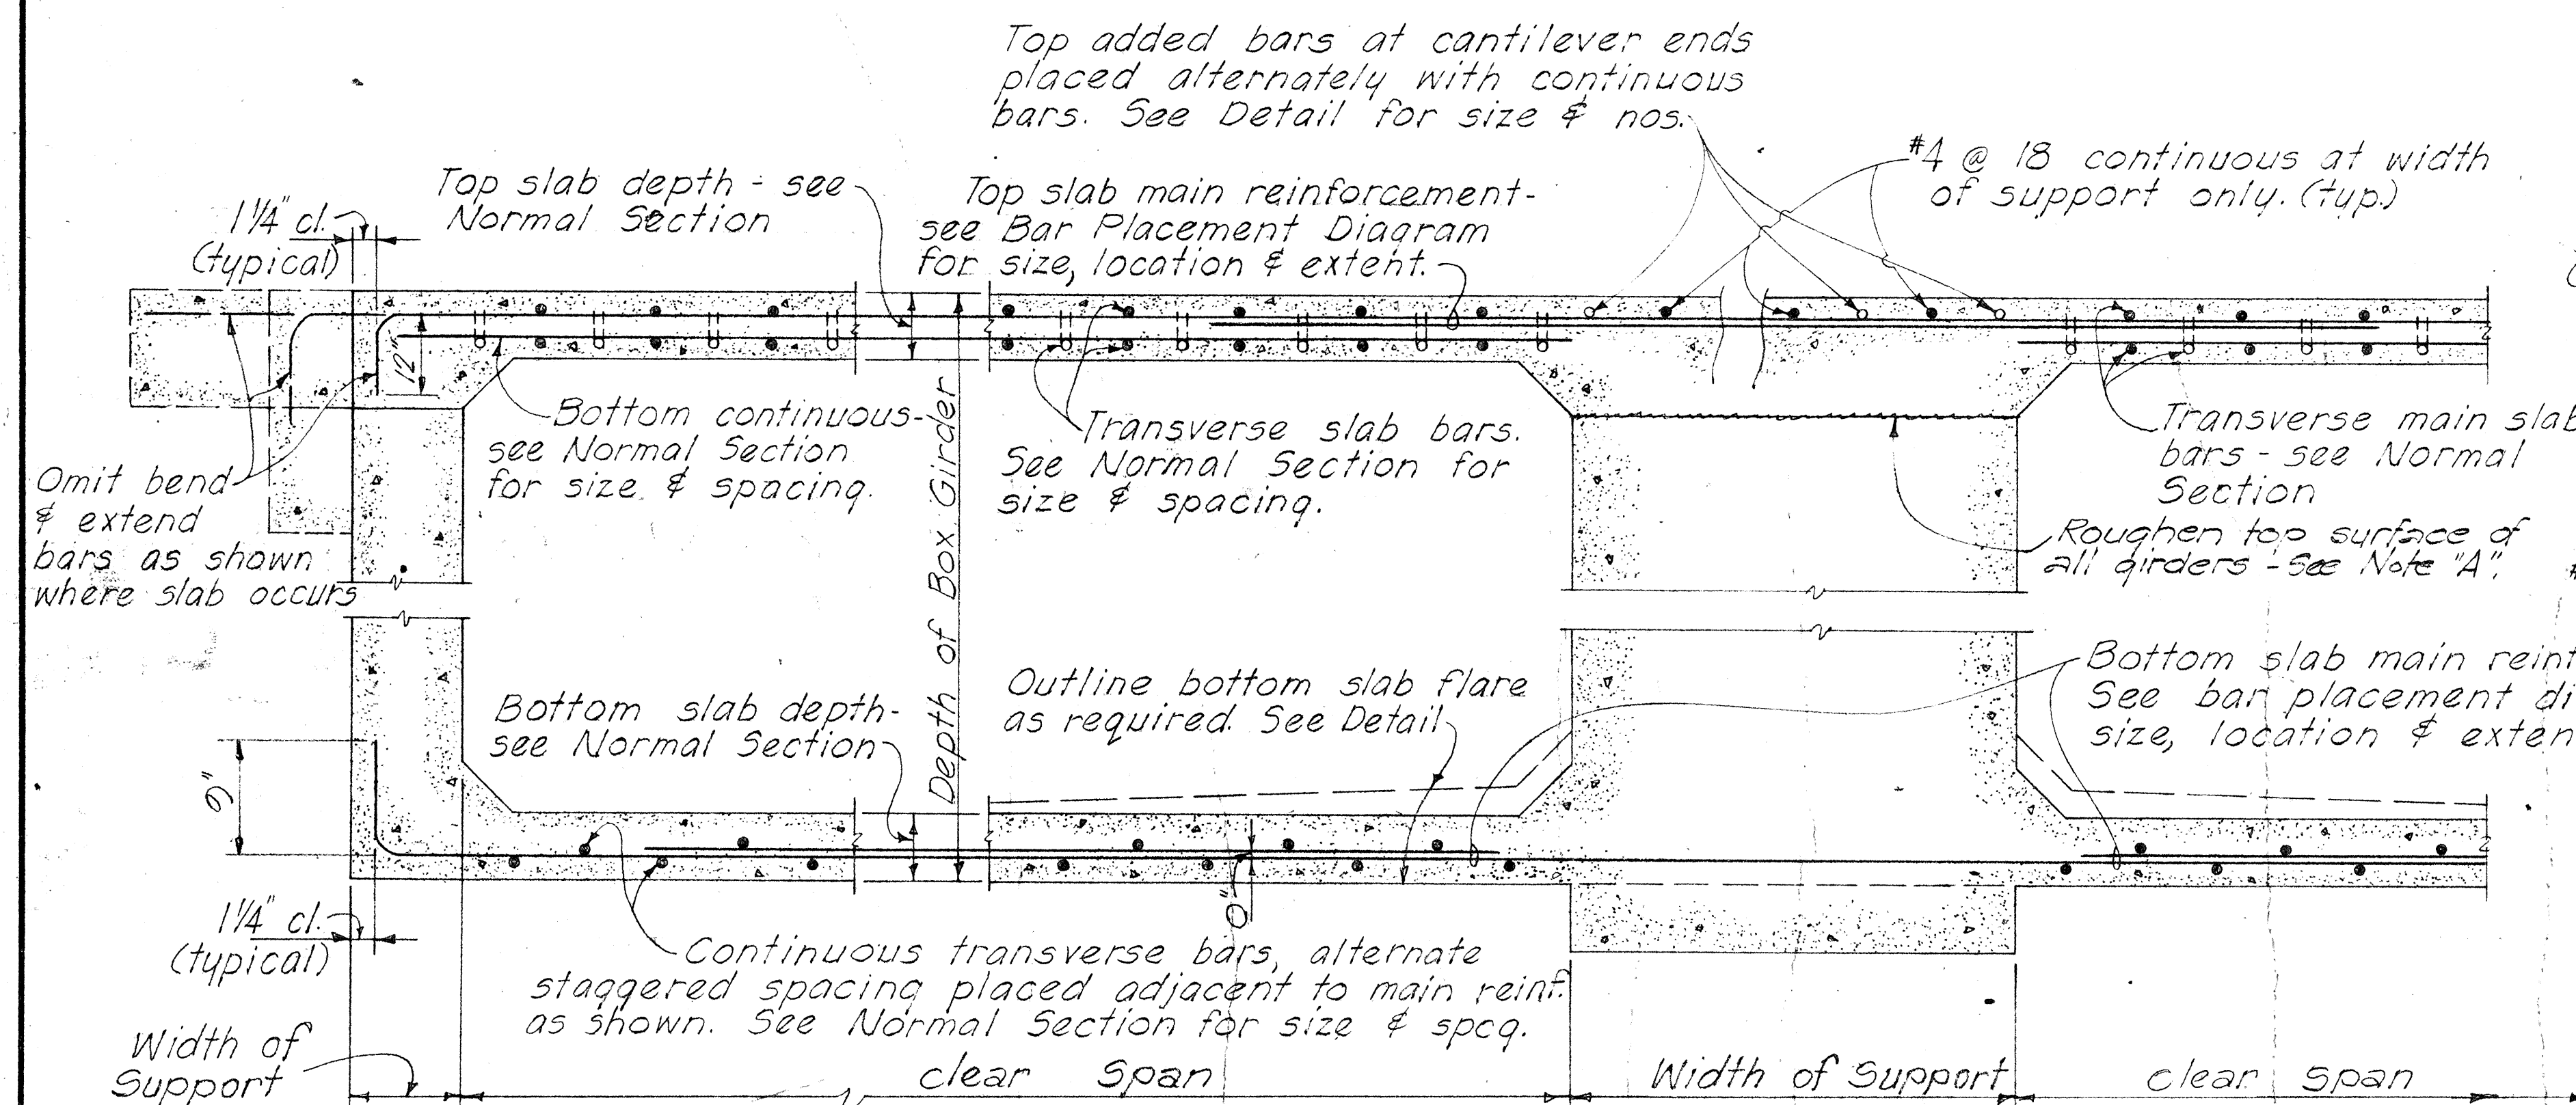

EXTERIOR GIRDER

INTERIOR GIRDER

TYPICAL NORMAL BOX GIRDER SECTION

AT NON-CONTINUOUS END

AT CONTINUOUS SUPPORT

TYPICAL LONGITUDINAL DECK SECTION ALONG GIRDER AT NORMAL OR RADIAL SUPPORTS

Note "A" The entire surface of the joint shall be thoroughly cleaned of surface laitance, curing compound, and other material foreign to the concrete, and clean aggregate be exposed by abrasive blast cleaning after the curing period or immediately before placing concrete at the joint.

NO.	REVISION	APPROVED BY	DATE

APPROVAL RECOMMENDED

Paul T. Yamashita
BRIDGE DESIGN ENGINEER

1-23-70
DATE

APPROVED

Paul T. Yamashita
For ASSISTANT CHIEF, ENGINEERING


1-28-70
DATE

STATE OF HAWAII
DEPARTMENT OF TRANSPORTATION
HIGHWAYS DIVISION

STANDARD DETAILS
CONCRETE BOX GIRDER

NOTE:


D = Depth of girder stem to bottom of slab.
S = Spacing of #5 cont. girder stem longitudinal bars.
For additional details see Normal Section of the Plans.

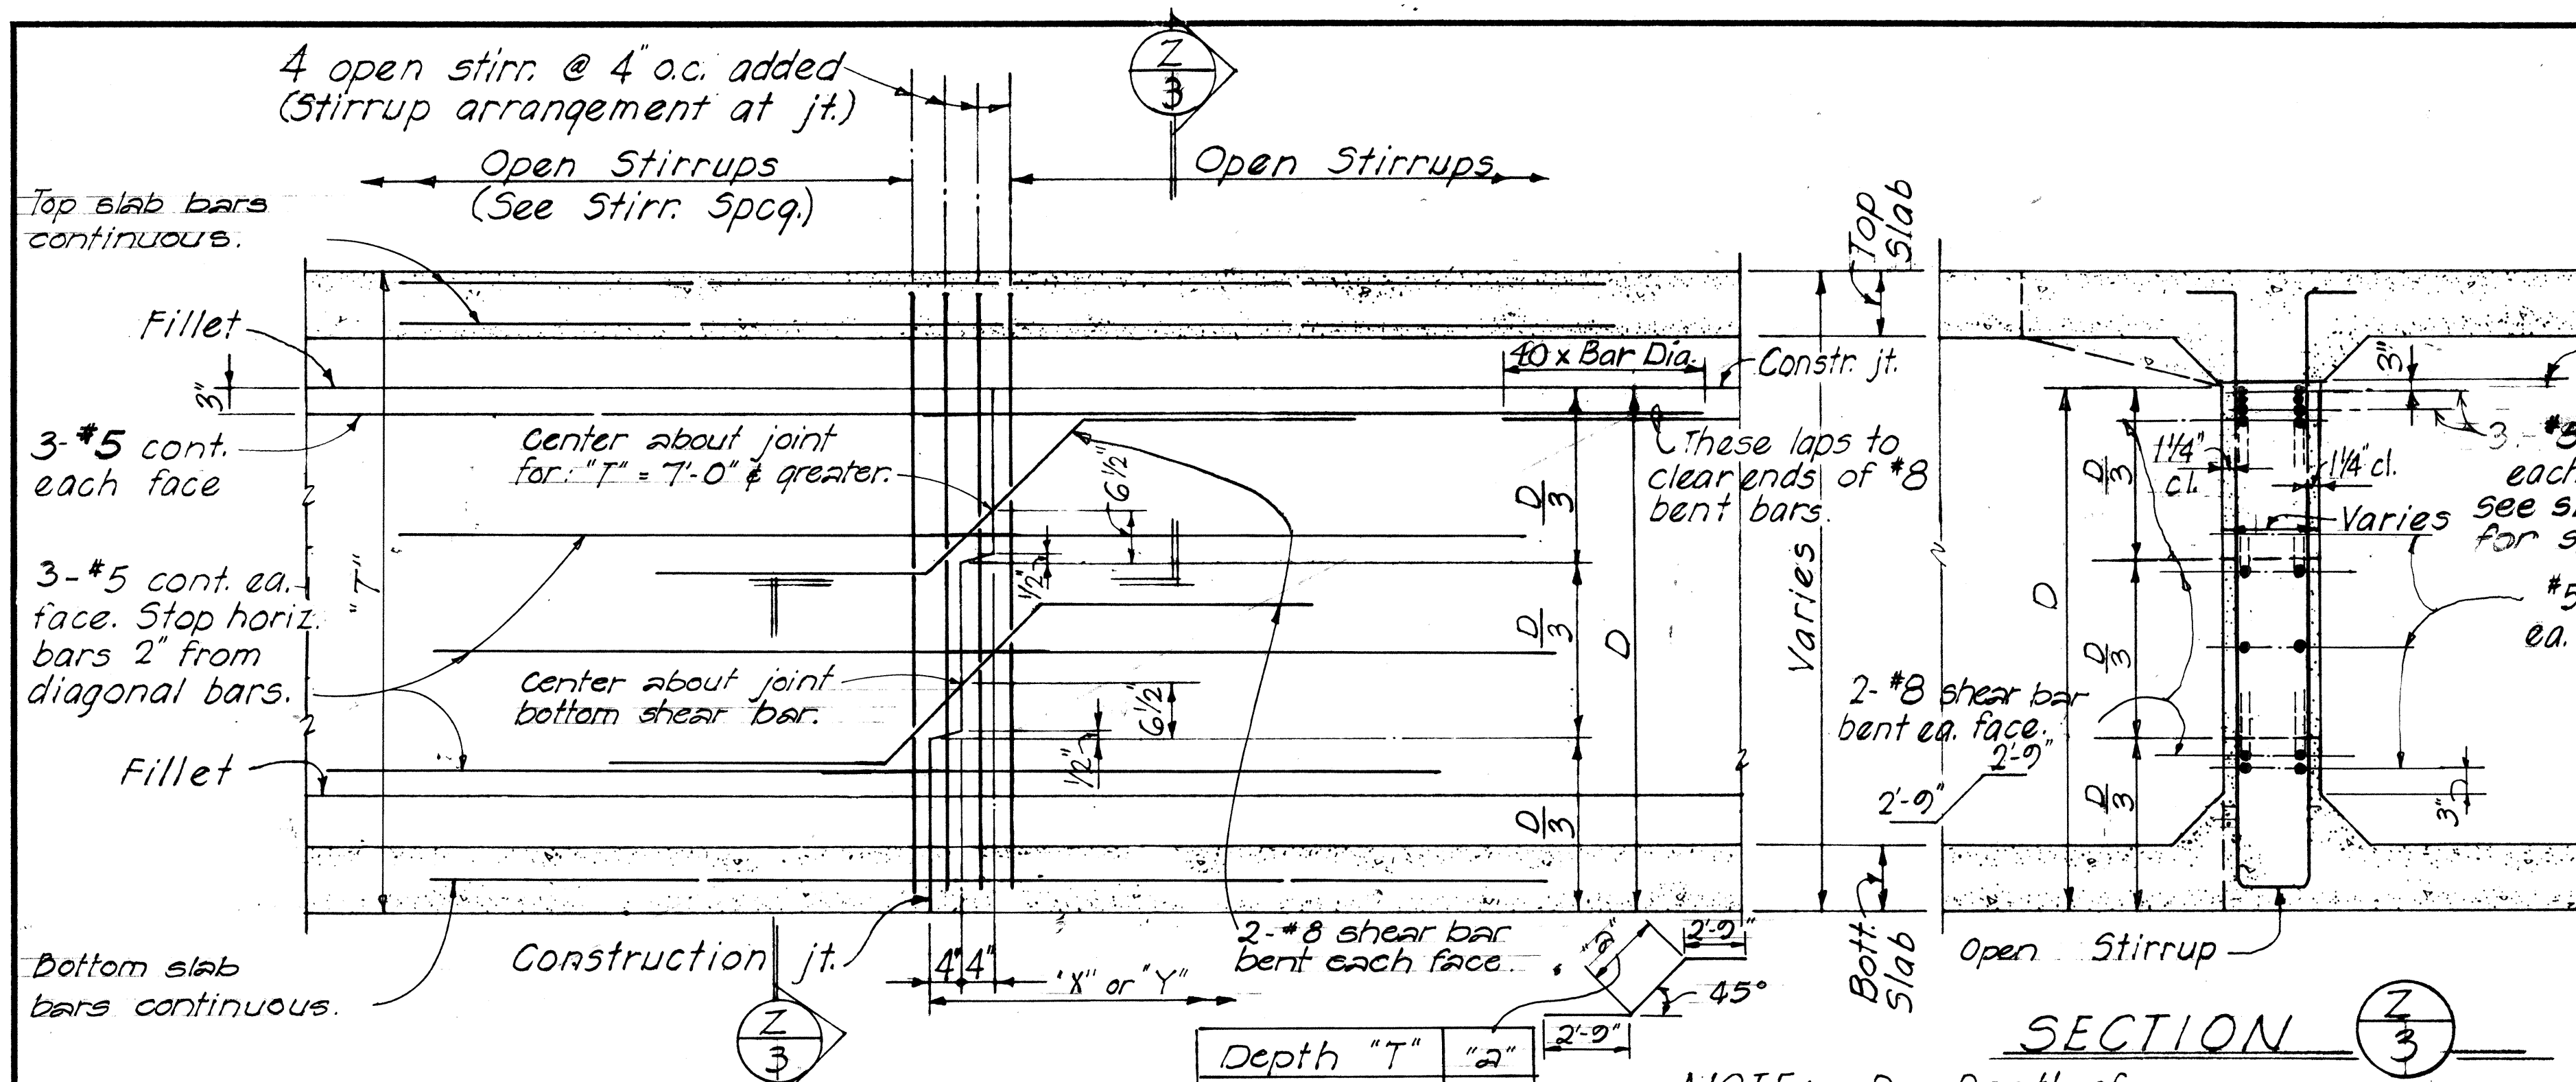

GIRDER STEM CONSTRUCTION JOINT

Depth "T"	"a"
4'-11" & smaller	1'-0"
5'-0" to 5'-11"	2'-0"
6'-0" to 6'-11"	2'-3"
7'-0" & greater	3'-0"


NOTE: D = Depth of girder stem to bott. of slab.

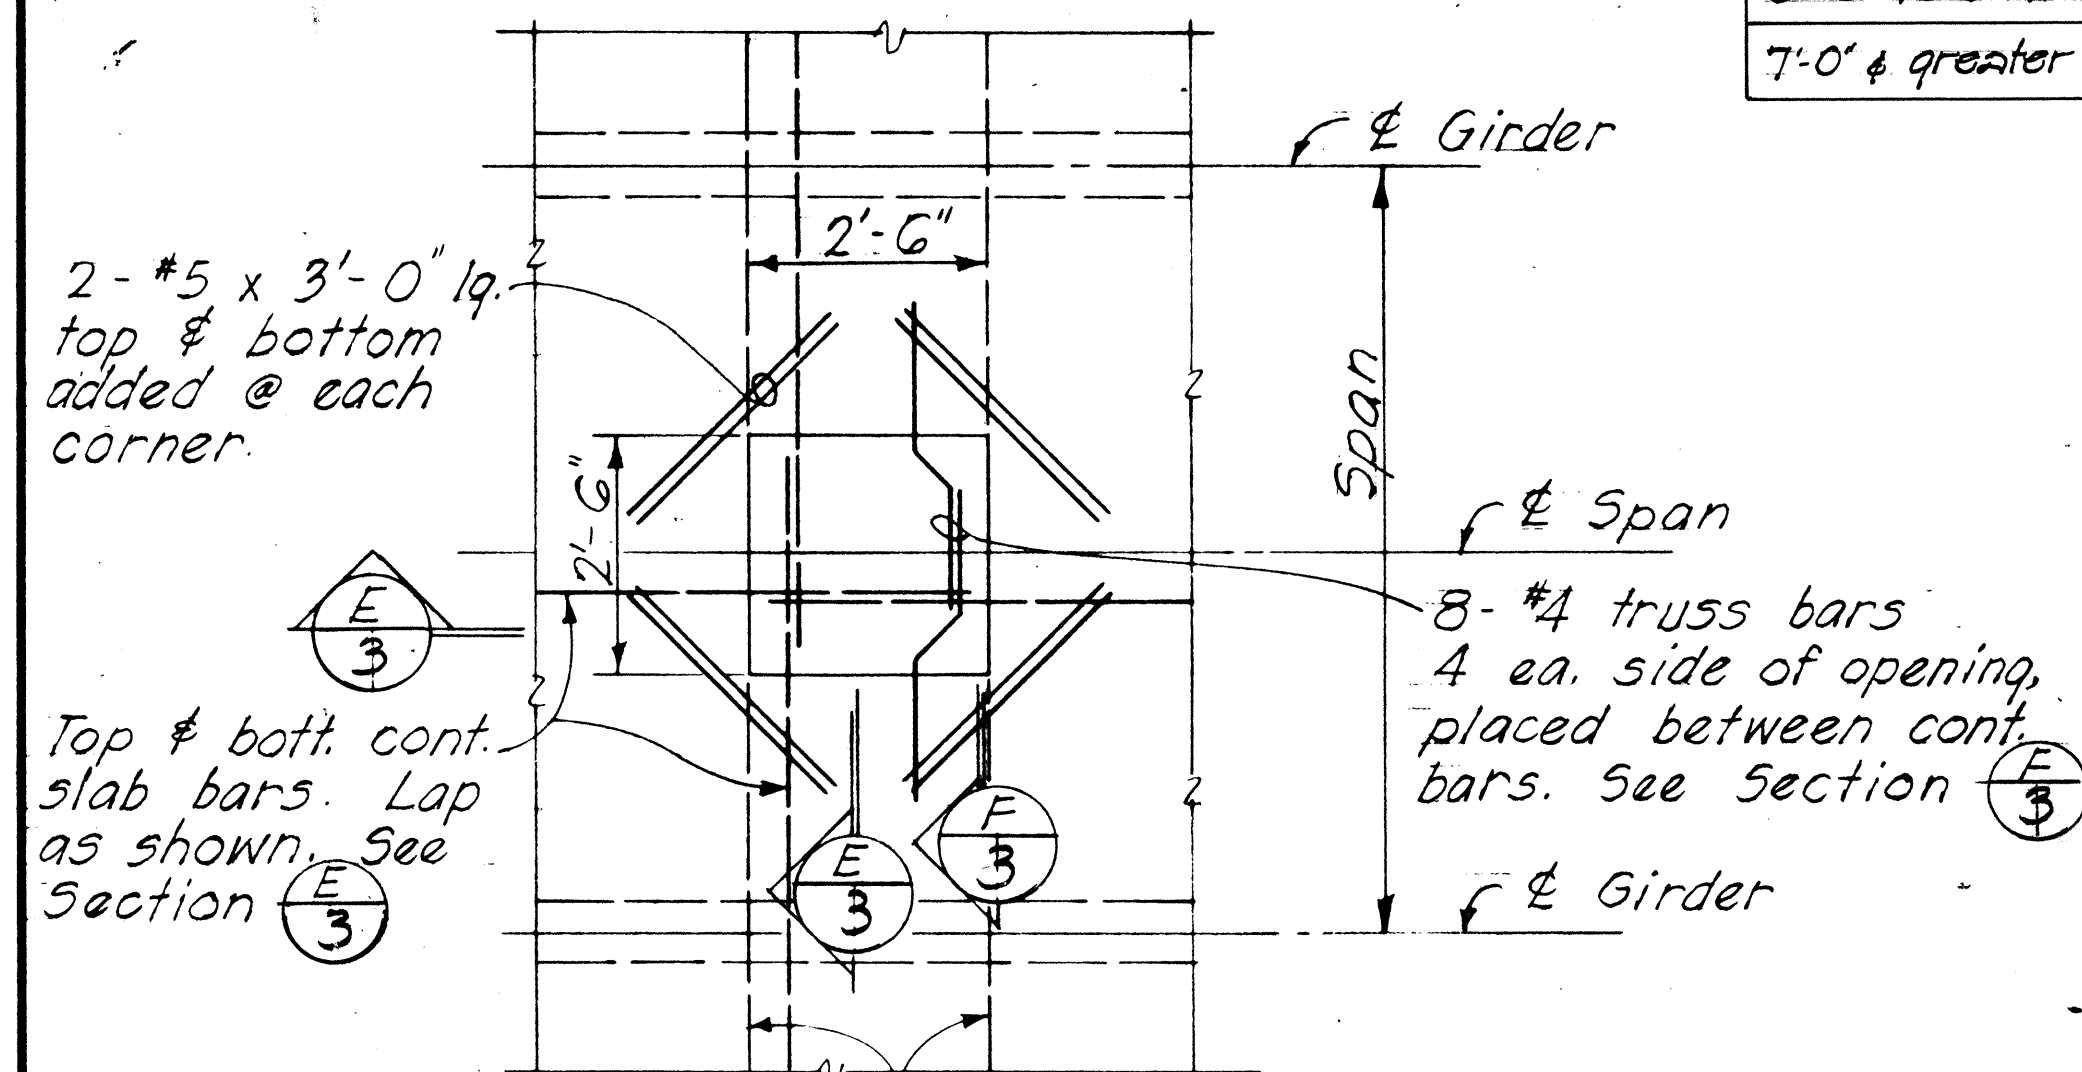


Note: Final location of opening shall be determined by the Engineer.

Form removal opening may extend from edge of deck with approval of the Engineer. Lap small longitudinal deck bars as shown on Section (E/3)

PART PLAN - DECK SHOWING FORM REMOVAL OPENING

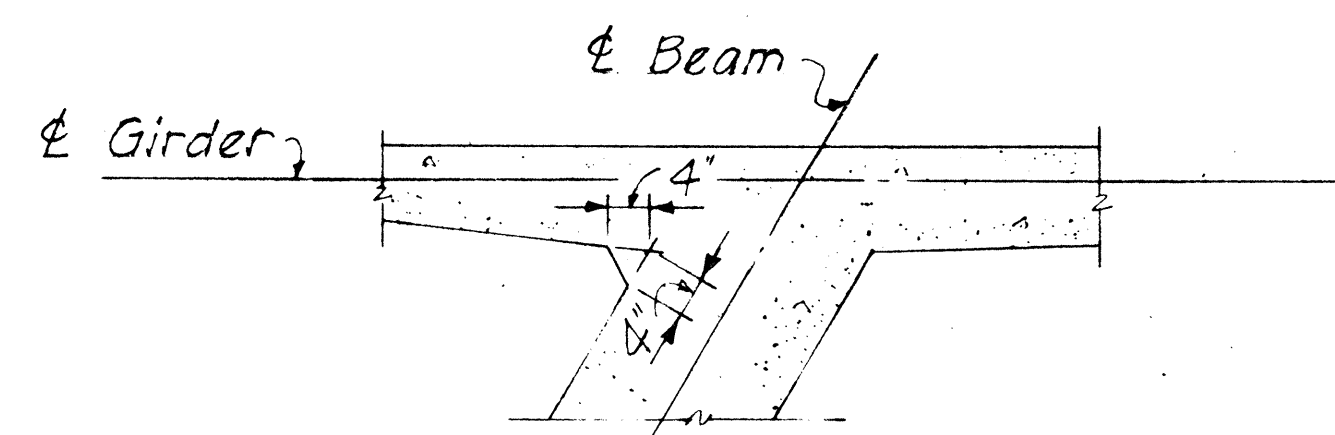


TYPICAL DETAIL OF VERTICAL CHAMFER AT ACUTE INTERSECTION OF SKEWED CONCRETE MEMBER

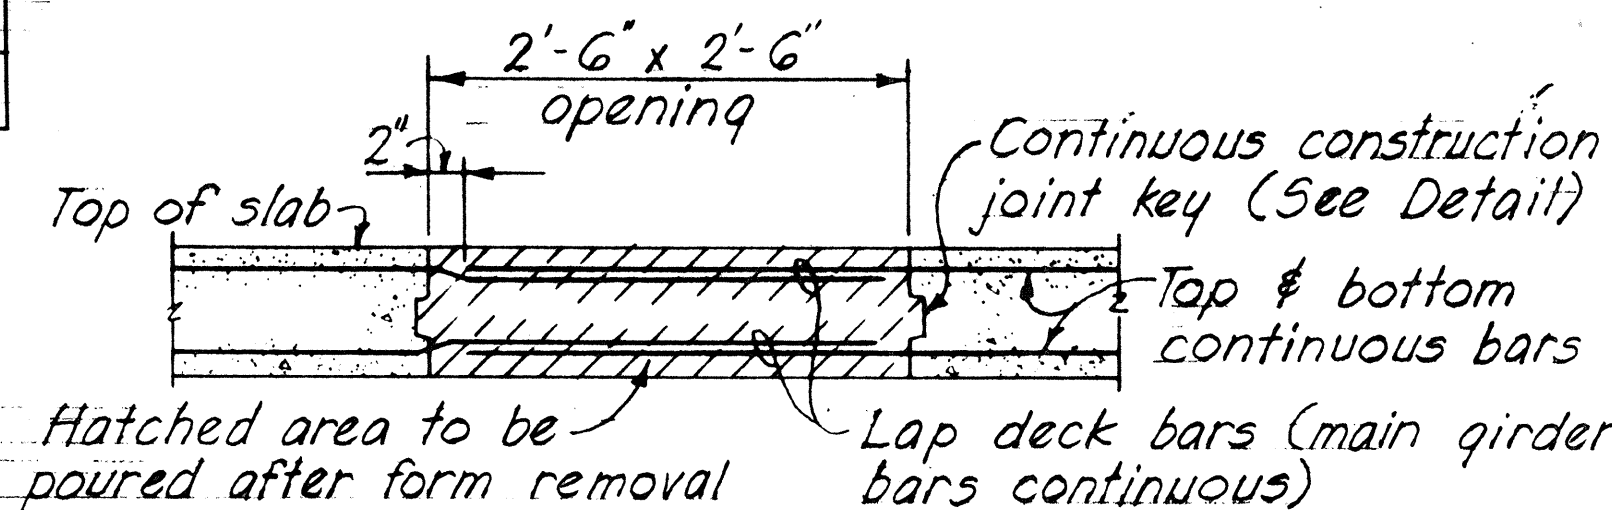

SECTION (E/3)

Note: Form removal opening at top slab shall not be located where main girder bars occur.

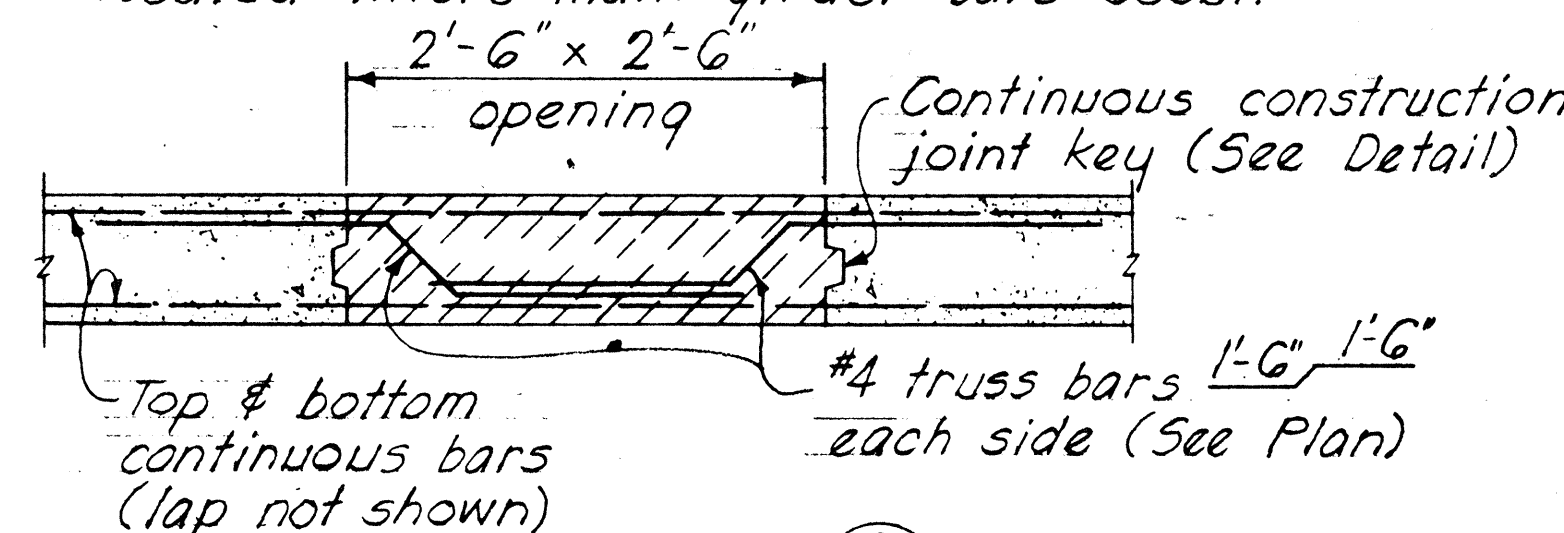


SECTION (E/3)

Within limits of triangular panel add # @ o.c. bottom transverse straight bars between continuous straight, "alternate spacing." See Typical Section at Non-continuous End.

Bott. layer added straight #

Typical bent up slab bars extend to ends as shown

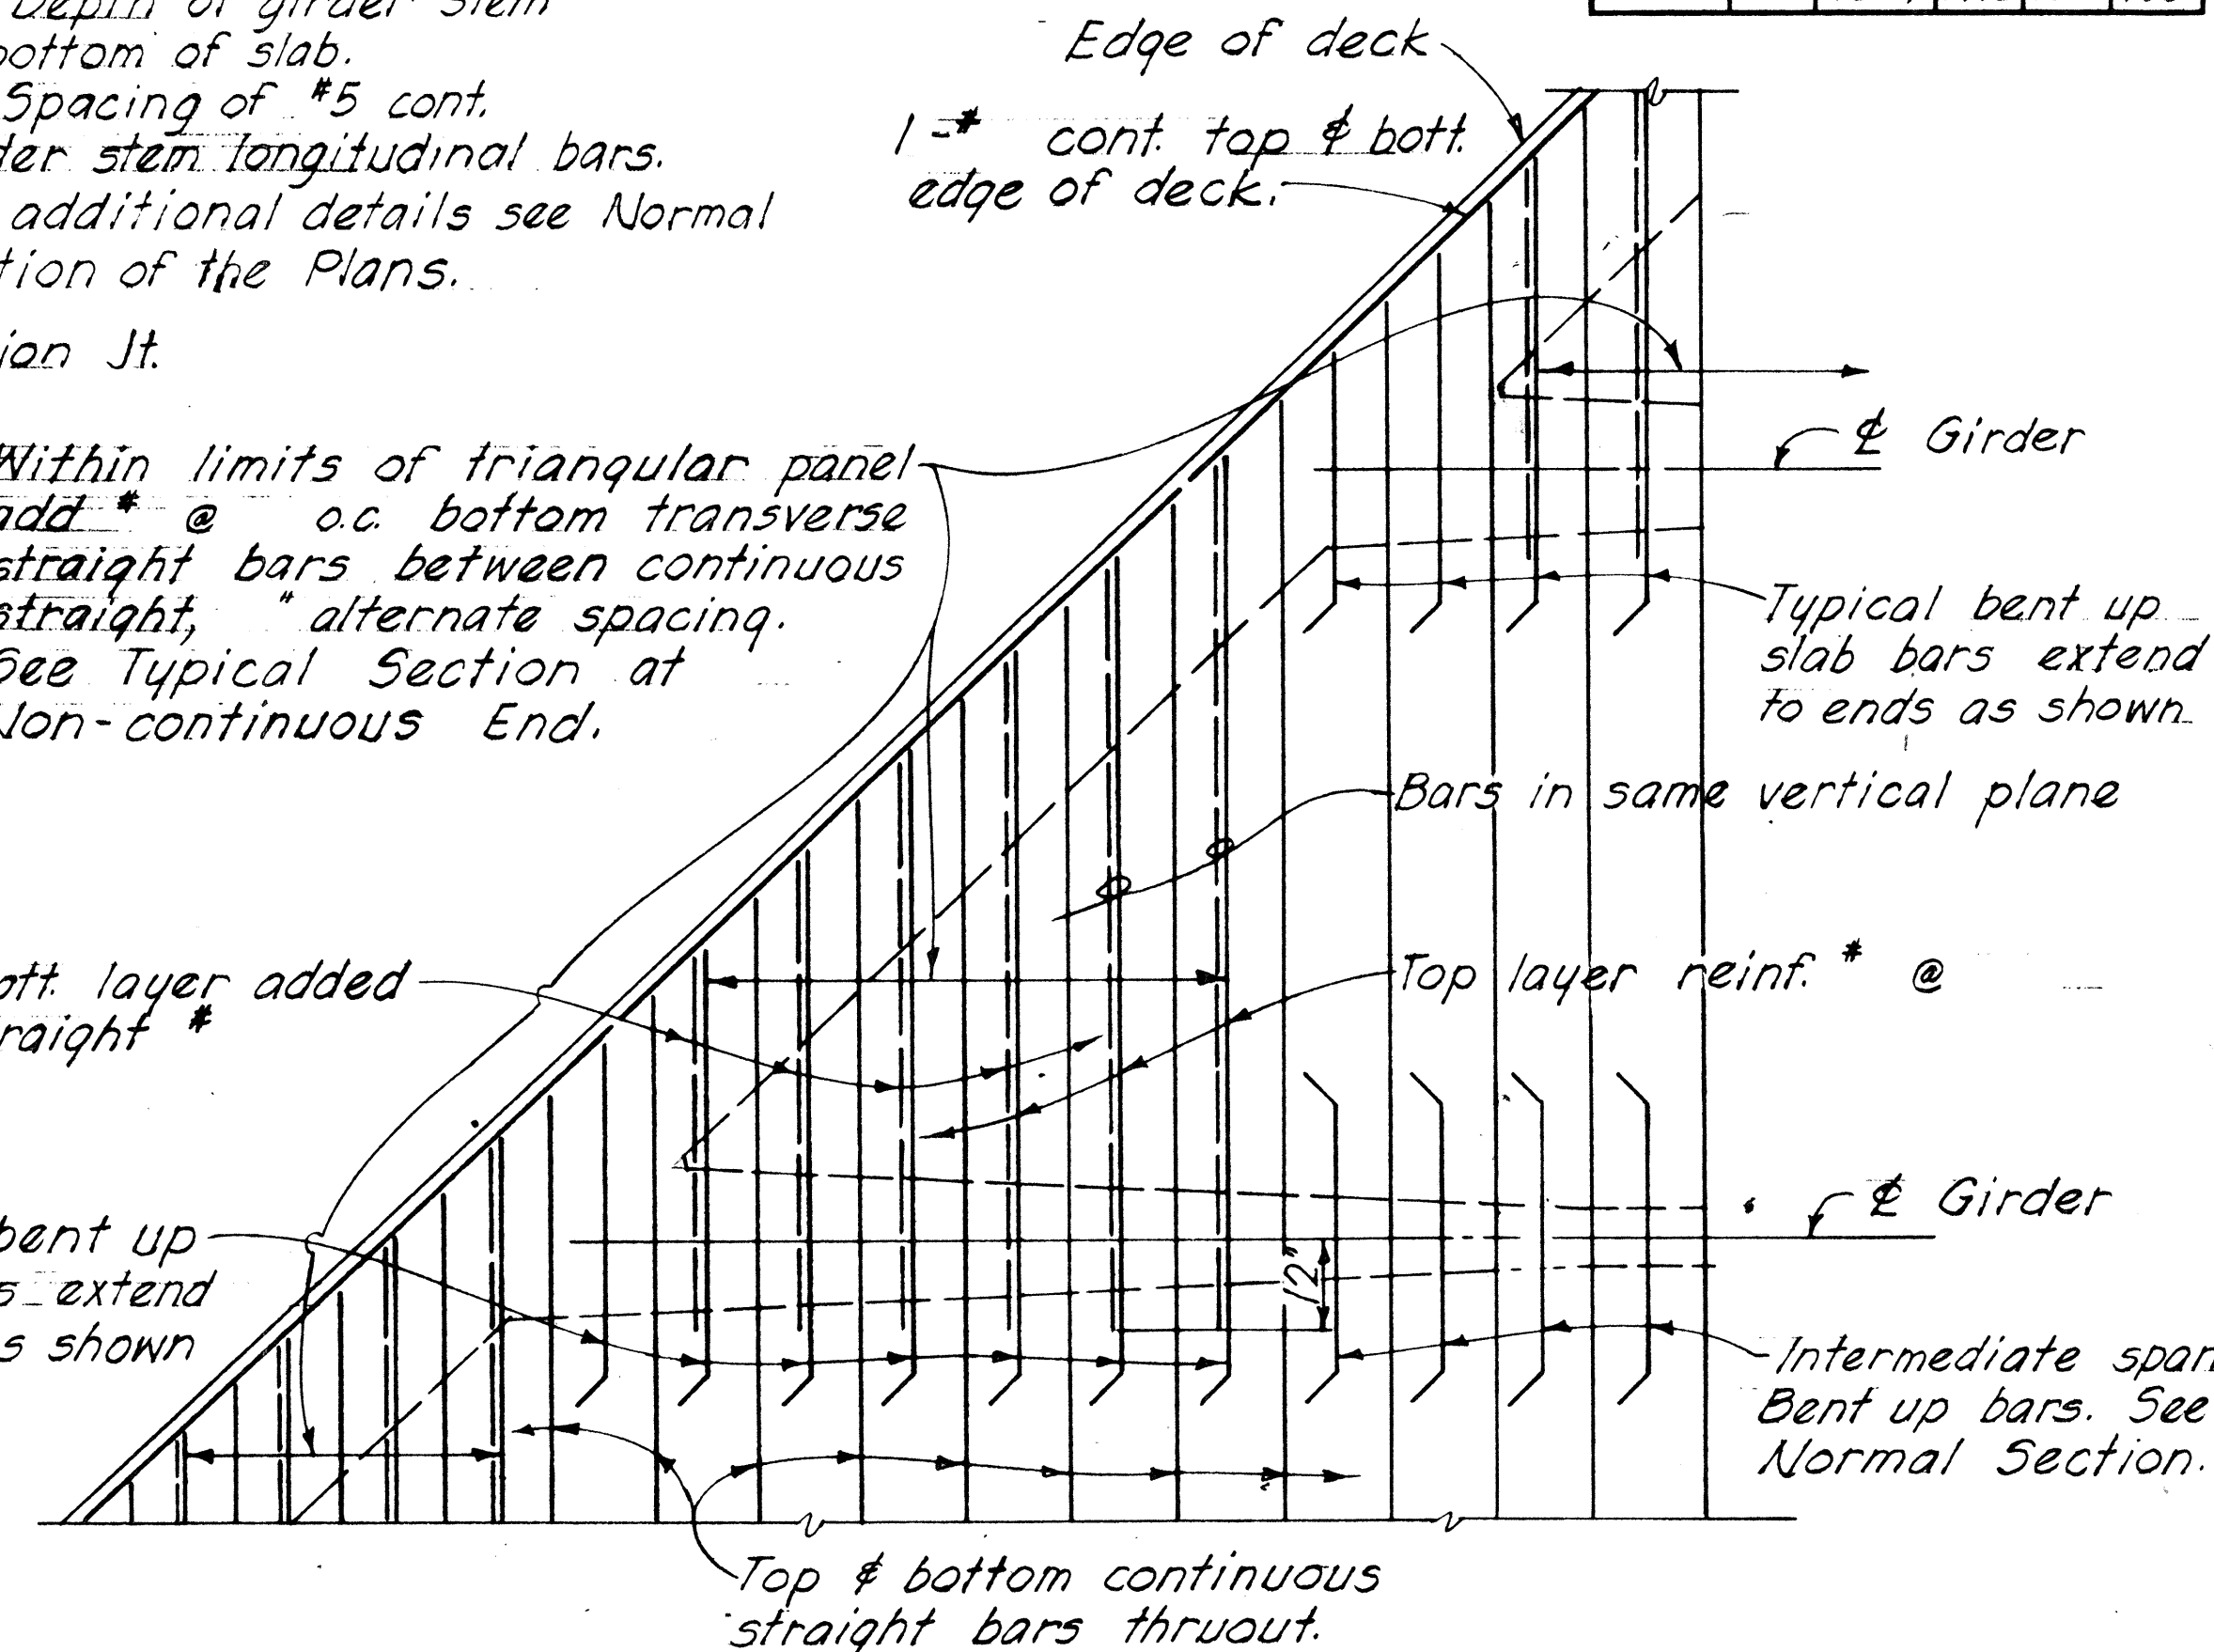

PART PLAN - TYPICAL ARRANGEMENT OF TOP SLAB REINFORCEMENT AT SKEWED ENDS

APPROVAL RECOMMENDED: Paul T. Yamashita 1-23-70
BRIDGE DESIGN ENGINEER DATE

APPROVED: Paul T. Yamashita 1-28-70
For ASSISTANT CHIEF, ENGINEERING DATE

NO.	REVISION	APPROVED BY	DATE


STATE OF HAWAII
DEPARTMENT OF TRANSPORTATION
HIGHWAYS DIVISION

STANDARD DETAILS
CONCRETE BOX GIRDER

SCALE AS NOTED

SHEET No. 16 OF 20 SHEETS DB-101-3



⌀ Reference line and ⌀ $\frac{3}{4}$ " x $2\frac{1}{2}$ " bolt slot for $\frac{5}{8}$ " ⌀ x $7\frac{1}{4}$ " long-Anchor Bolt.

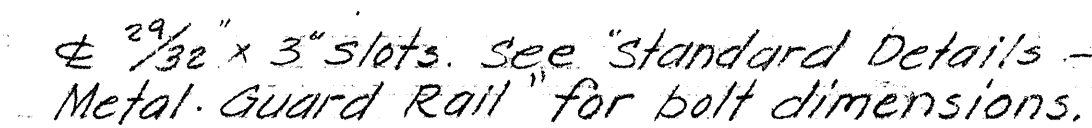




End of End Post $\rightarrow$

PLAN scale: 1"=1'-0"


* 10'-0" End Post

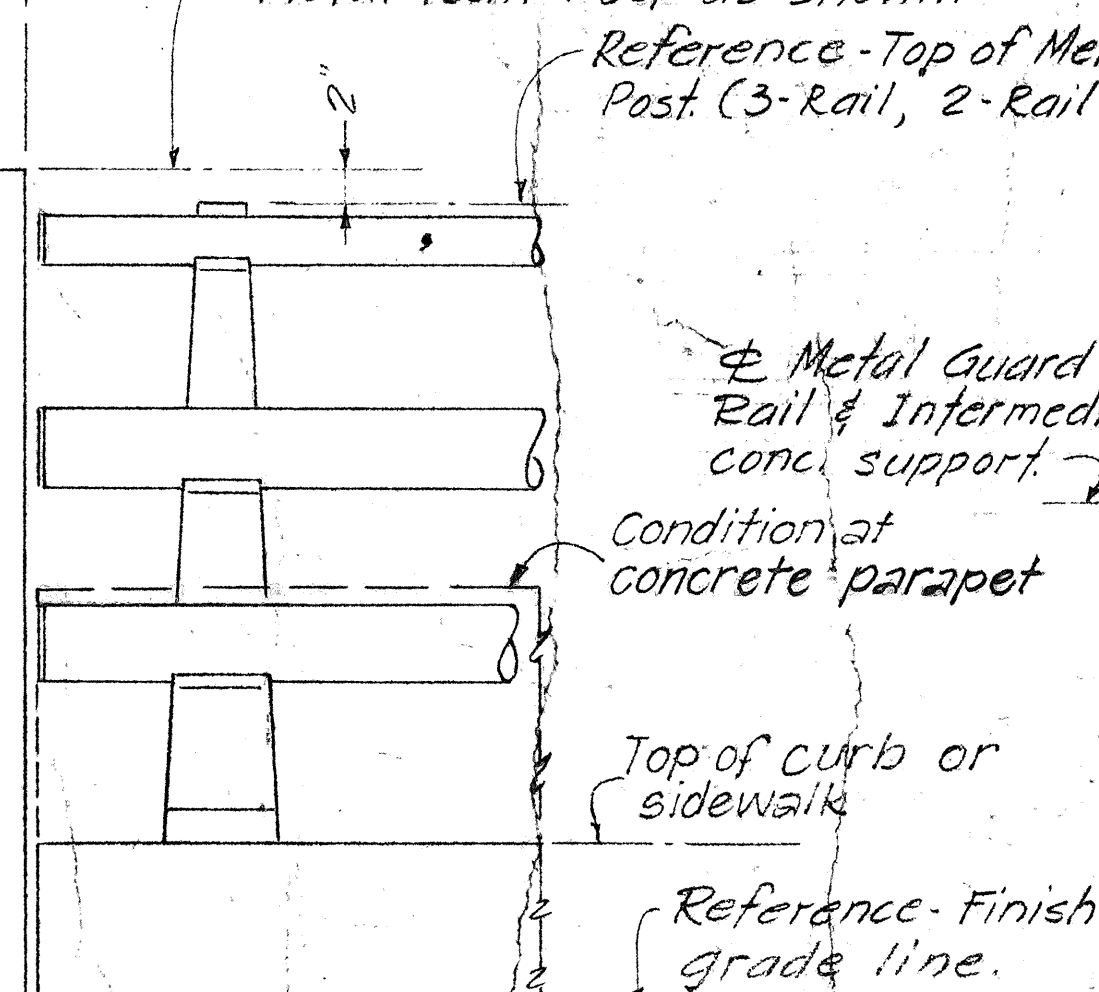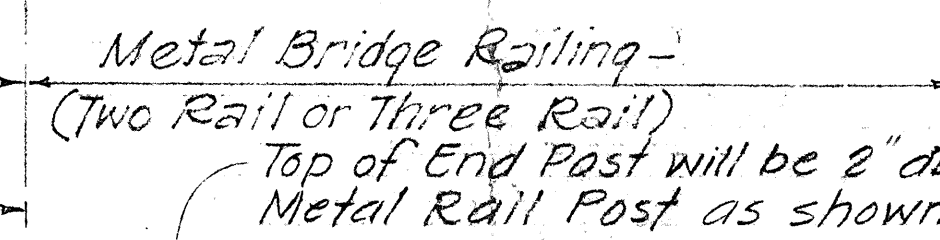

Ref. Front face of End Post₂
Intermediate conc.
support varies from
10 1/8" @ end to 0.

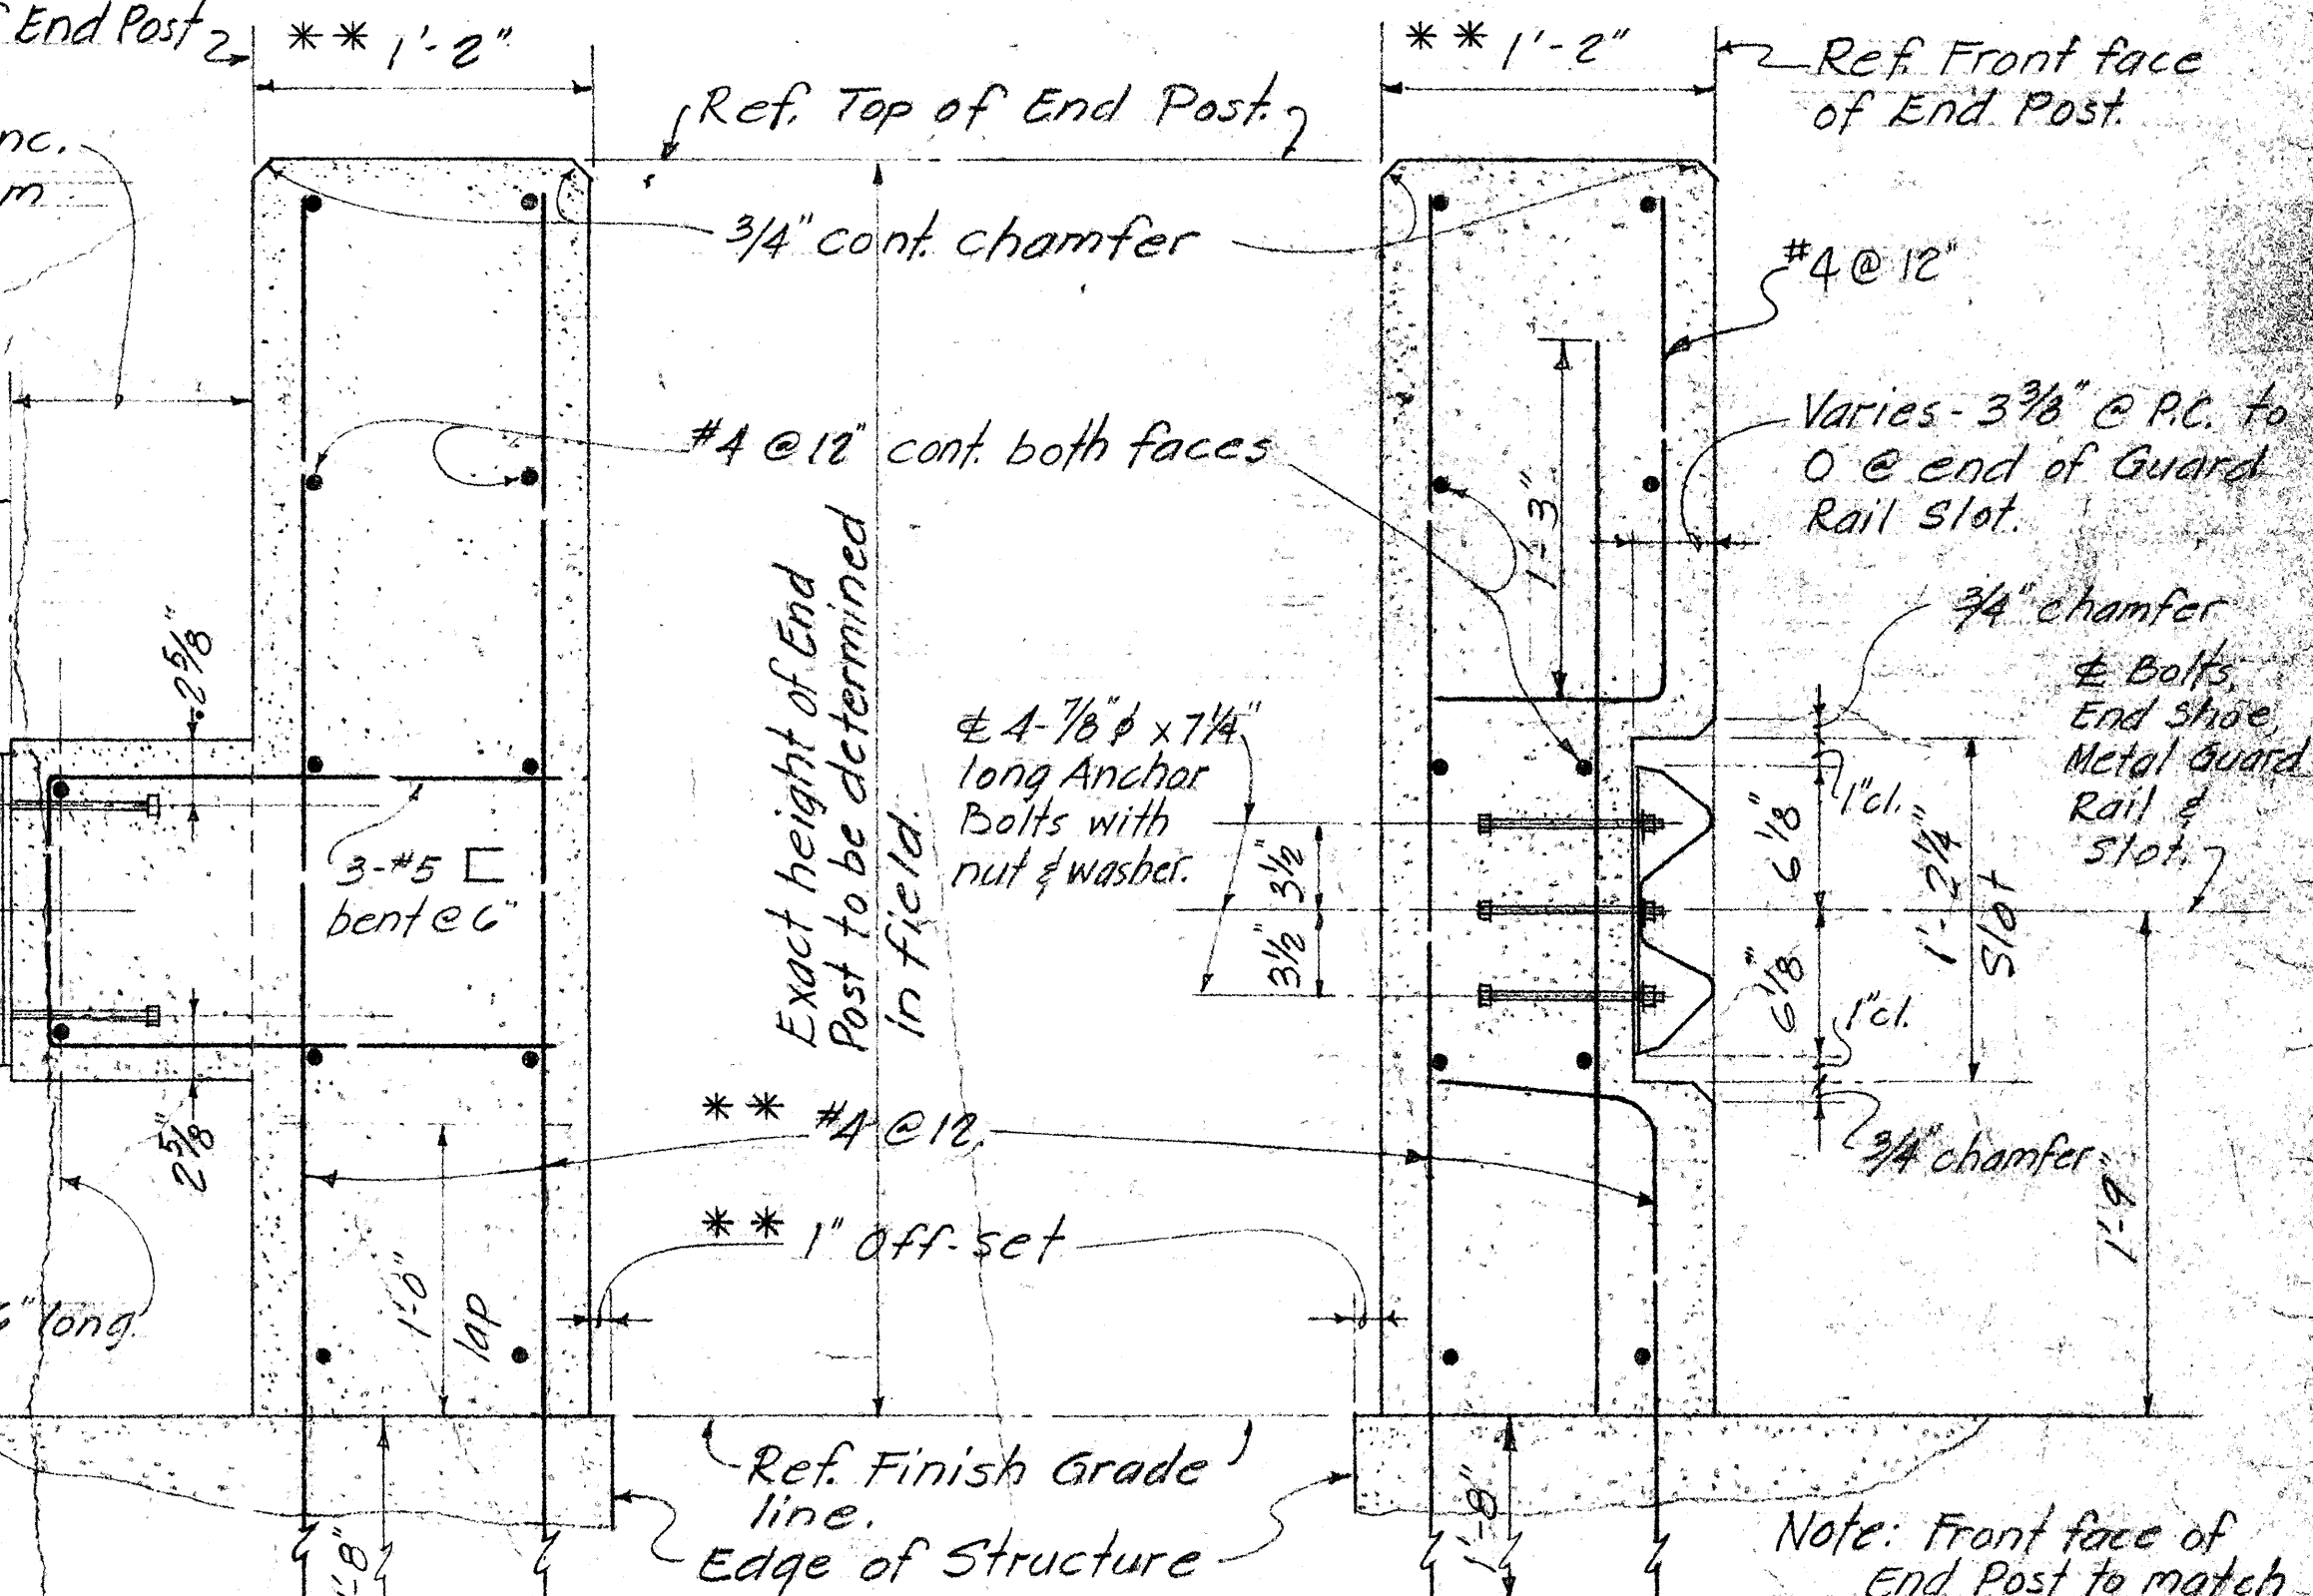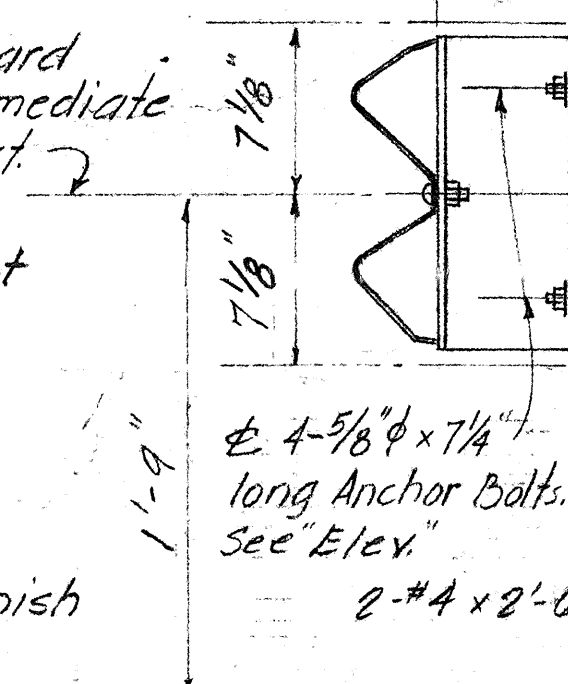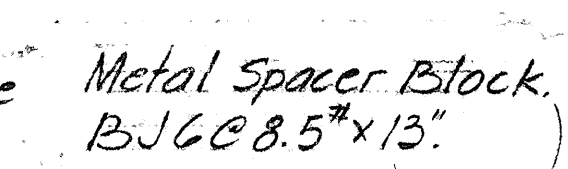

* * Dimensions and Reinf. size and spacing to be as detailed except as otherwise noted on detail drawings.

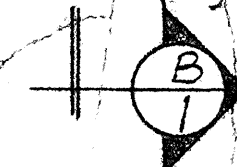

NOTES:

1. All Anchor Bolts shall be High Strength bolts conforming to the requirements of ASTM A-325.
2. All shoe assembly, including anchor bolts, nuts and washers, shall be galvanized.
3. Special End Shoe shall be Fabricated from 10 gage steel conforming to the requirements of AASHTO 180.

4. First 25'-0" of guard rail adjoining "Special End Shoe" shall be galvanized steel.
5. Anchor Bolt length given under bolt head.
6. These details are applicable for Connections to Retaining walls also.
7. Place name of structure as shown. For location, see "Plan" on Contract Drawing. Date shown will be year structure is completed. Letter size and detail see standard Drawing DB-100.

APPROVAL RECOMMENDED:
Paul T. Yamashita
BRIDGE DESIGN ENGINEER

APPROVED *Paul F. Thomas*
FOR ASSISTANT CHIEF, ENGINEERING

1-28-74
DATE

SECTION $\textcircled{B}$ Scale $1\frac{1}{2}" = 1'-0"$

STATE OF HAWAII
DEPARTMENT OF TRANSPORTATION
HIGHWAYS DIVISION


STANDARD DETAILS
METAL GUARD RAIL CONNECTION
AT VERTICAL FACE TYPE END POST

Scale: As shown


SHEET No. 17 OF 20 SHEETS DB-20M

411



FED. ROAD DIST. NO.	STATE	FED. AID PROJ. NO.	FISCAL YEAR	SHEET NO.	TOTAL SHEETS
HAWAII	HAW.	I-H2-1(8)-6	1973	199	100

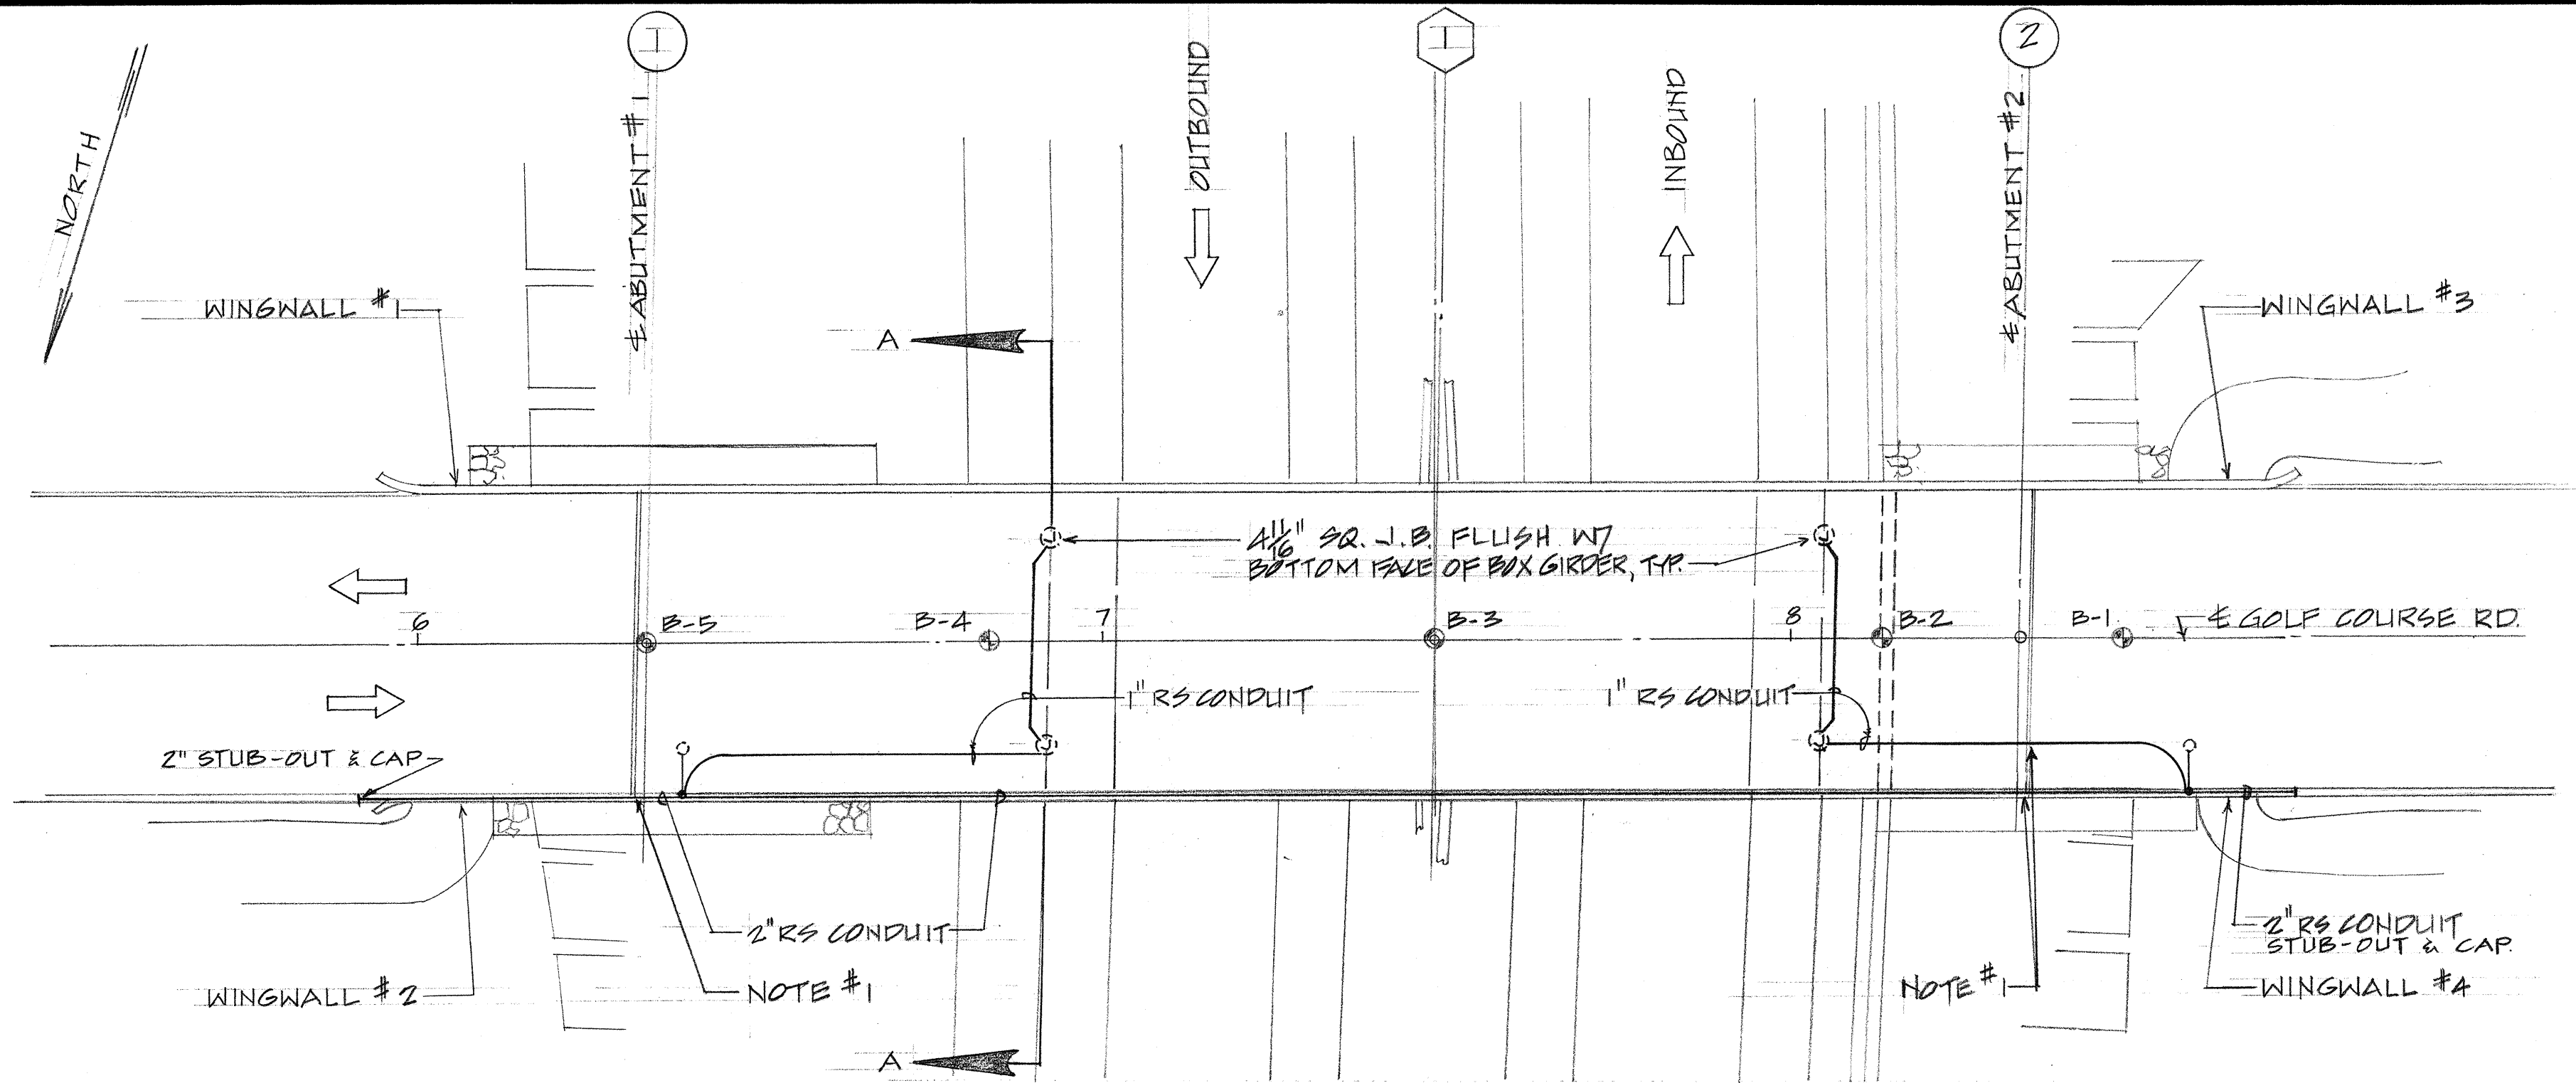

LIGHTING PLAN
SCALE: 1" = 30'-0"

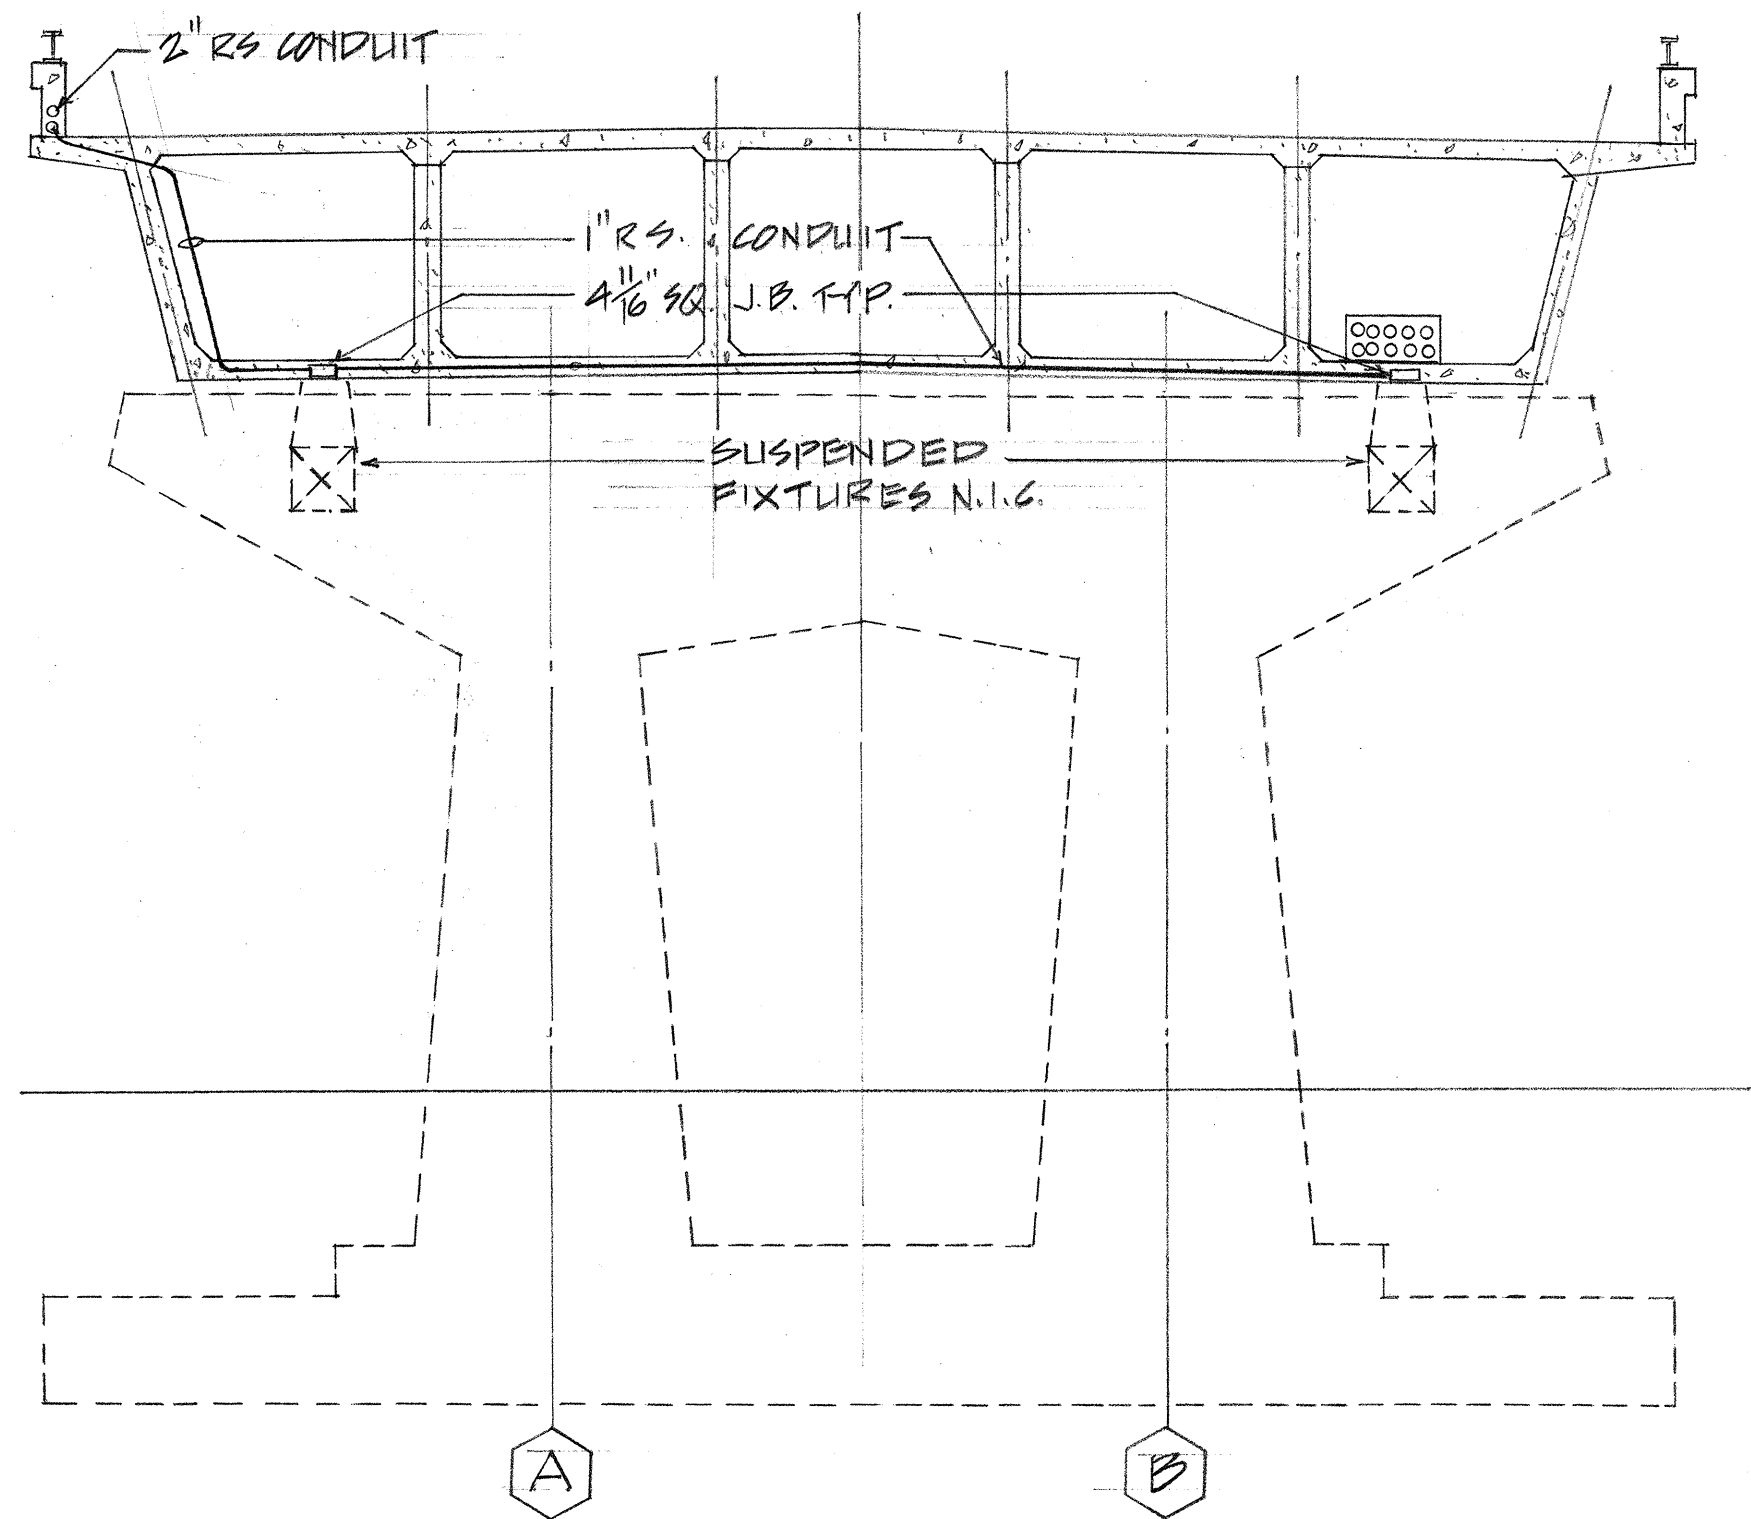

NORMAL SECTION "A-A"
SCALE: 3/16" = 1'-0"

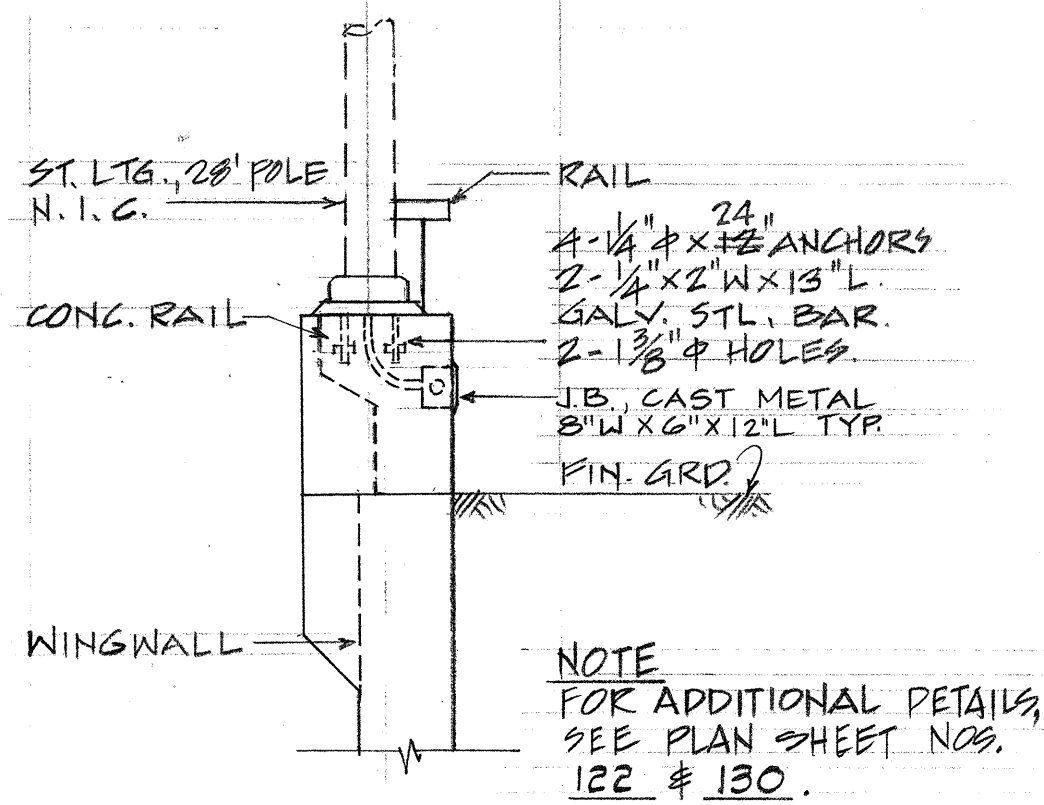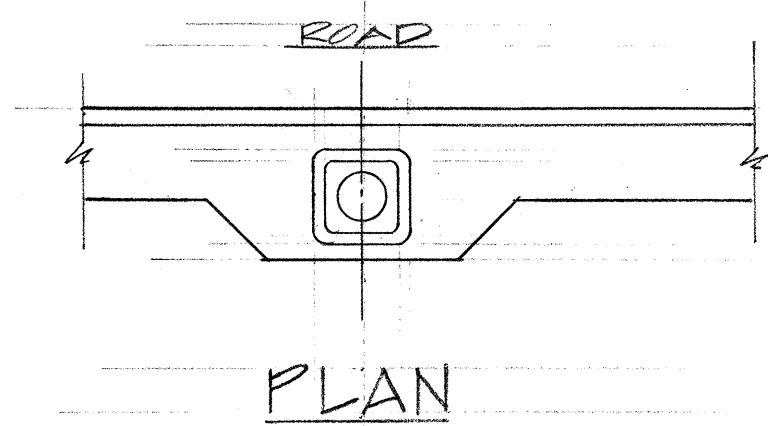

SECTION WING WALL
SCALE: 1/2" = 1'-0"

- NOTES:
1. GRADE SEPARATION ABUTMENT, PROVIDE EXP. COUPLING AT EACH CONDUIT.
 2. SEE STRUCTURAL DRAWINGS FOR CONCRETE PORTION OF WORK.
 3. SEE PLAN SHEET NO. 64 FOR ADDITIONAL HWY LIGHTING DETAILS.

STATE OF HAWAII

DEPARTMENT OF TRANSPORTATION

HIGHWAYS DIVISION

GOLF COURSE SEPARATION

STA. 6+32.81 TO STA. 8+34.31

LIGHTING PLAN

LEILEHUA INTERCHANGE

P.A.I. PROJ. NO. I-H2-1(8)-6 DATE: APR., '73

SHEET No. 20 OF 20 SHEETS

412

SURVEY PLOTTED BY	DATE
DRAWN BY	
DESIGNED BY	
QUANTITIES BY	
CHECKED BY	
ORIGINAL PLAN	
NOTE BOOK	
No.	