
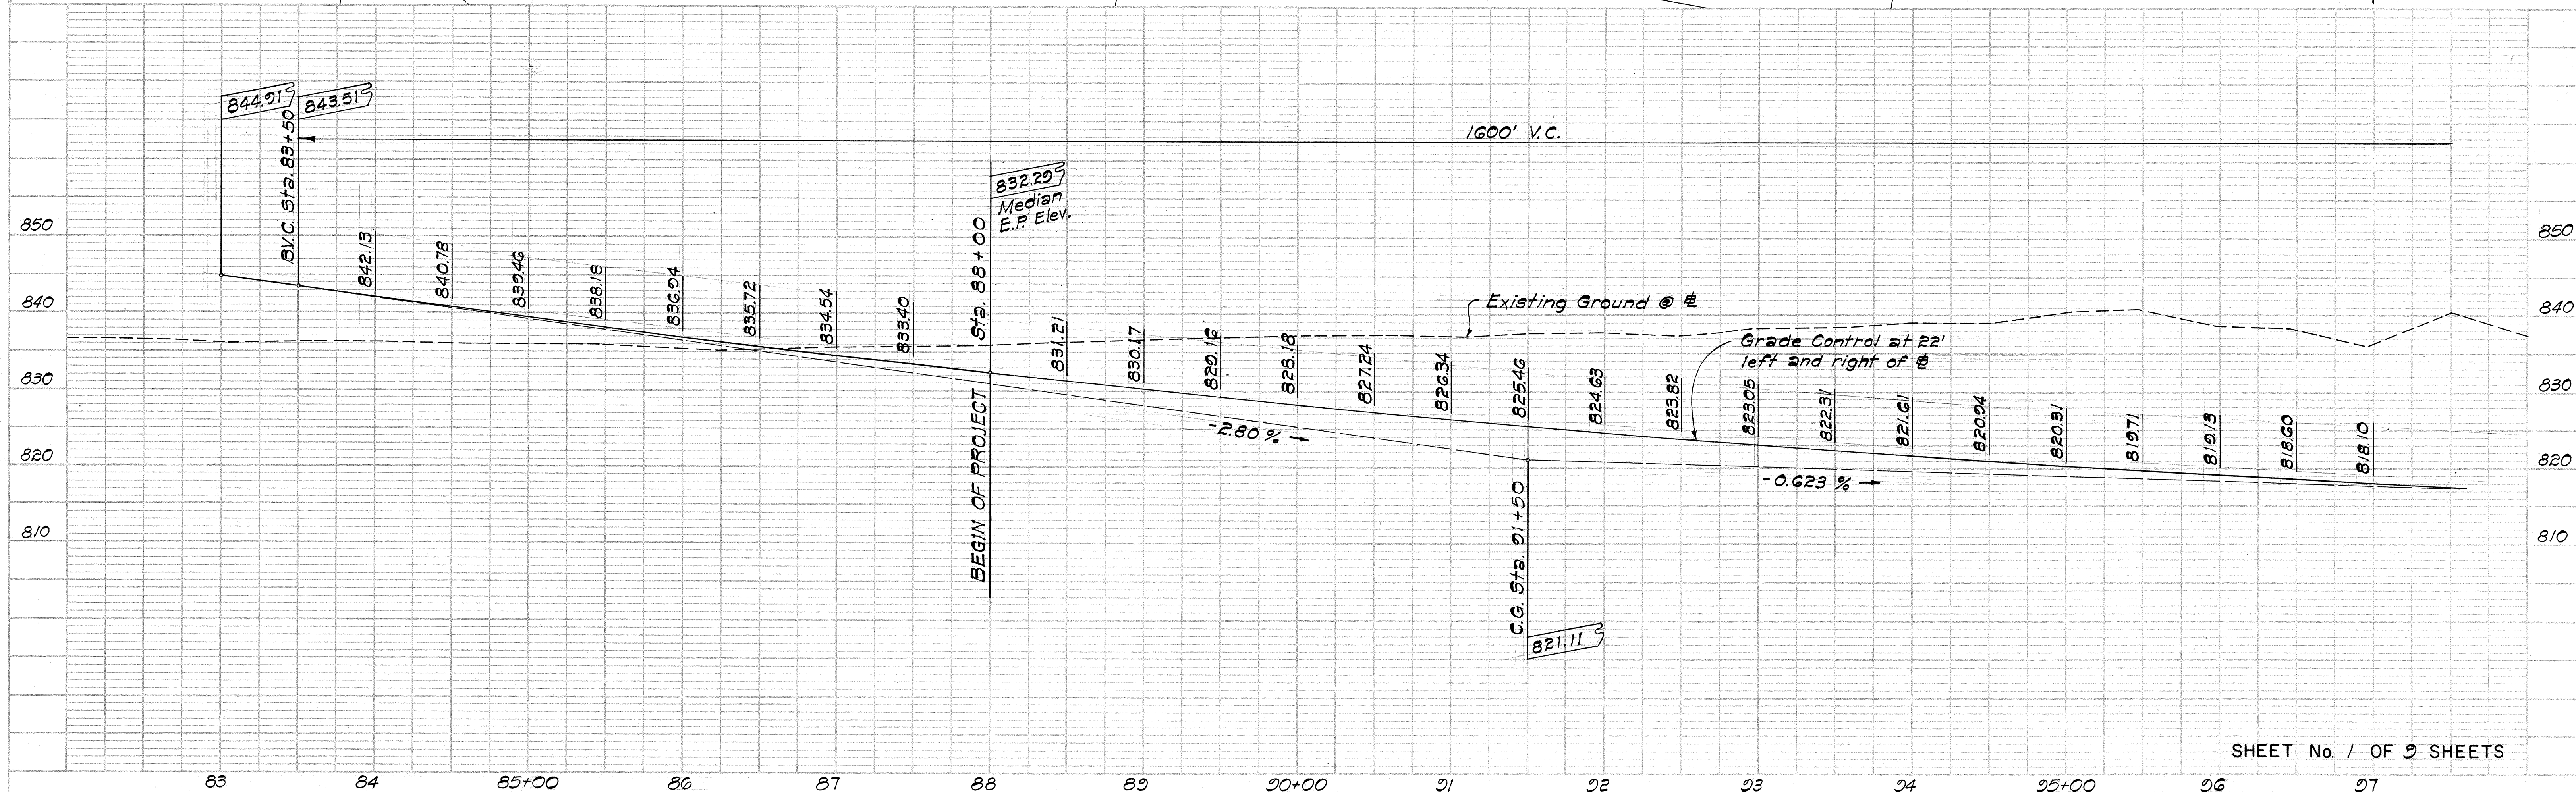



NOTES:

1. The boring data shown on Plan Sheet No. 20 and on the structural plans are for design purposes only and for the convenience of the Engineer in control of earthwork.
2. The borings were carefully taken, however the Department assumes no responsibility to the accuracy or sufficiency of borings or of the interpretation thereof, and will not make any guarantee of any of the same.
3. Origin of Azimuths and Coordinates is "Central Meridian 158°00'00" (Zone III)."
4. Bench Marks are referred to Mean Sea Level Datum.

FED. ROAD DIST. NO.	STATE	FED. AID PROJ. NO.	FISCAL YEAR	SHEET NO.	TOTAL SHEETS
HAWAII	HAW.	I-H2-1(8)G	1973	9	160

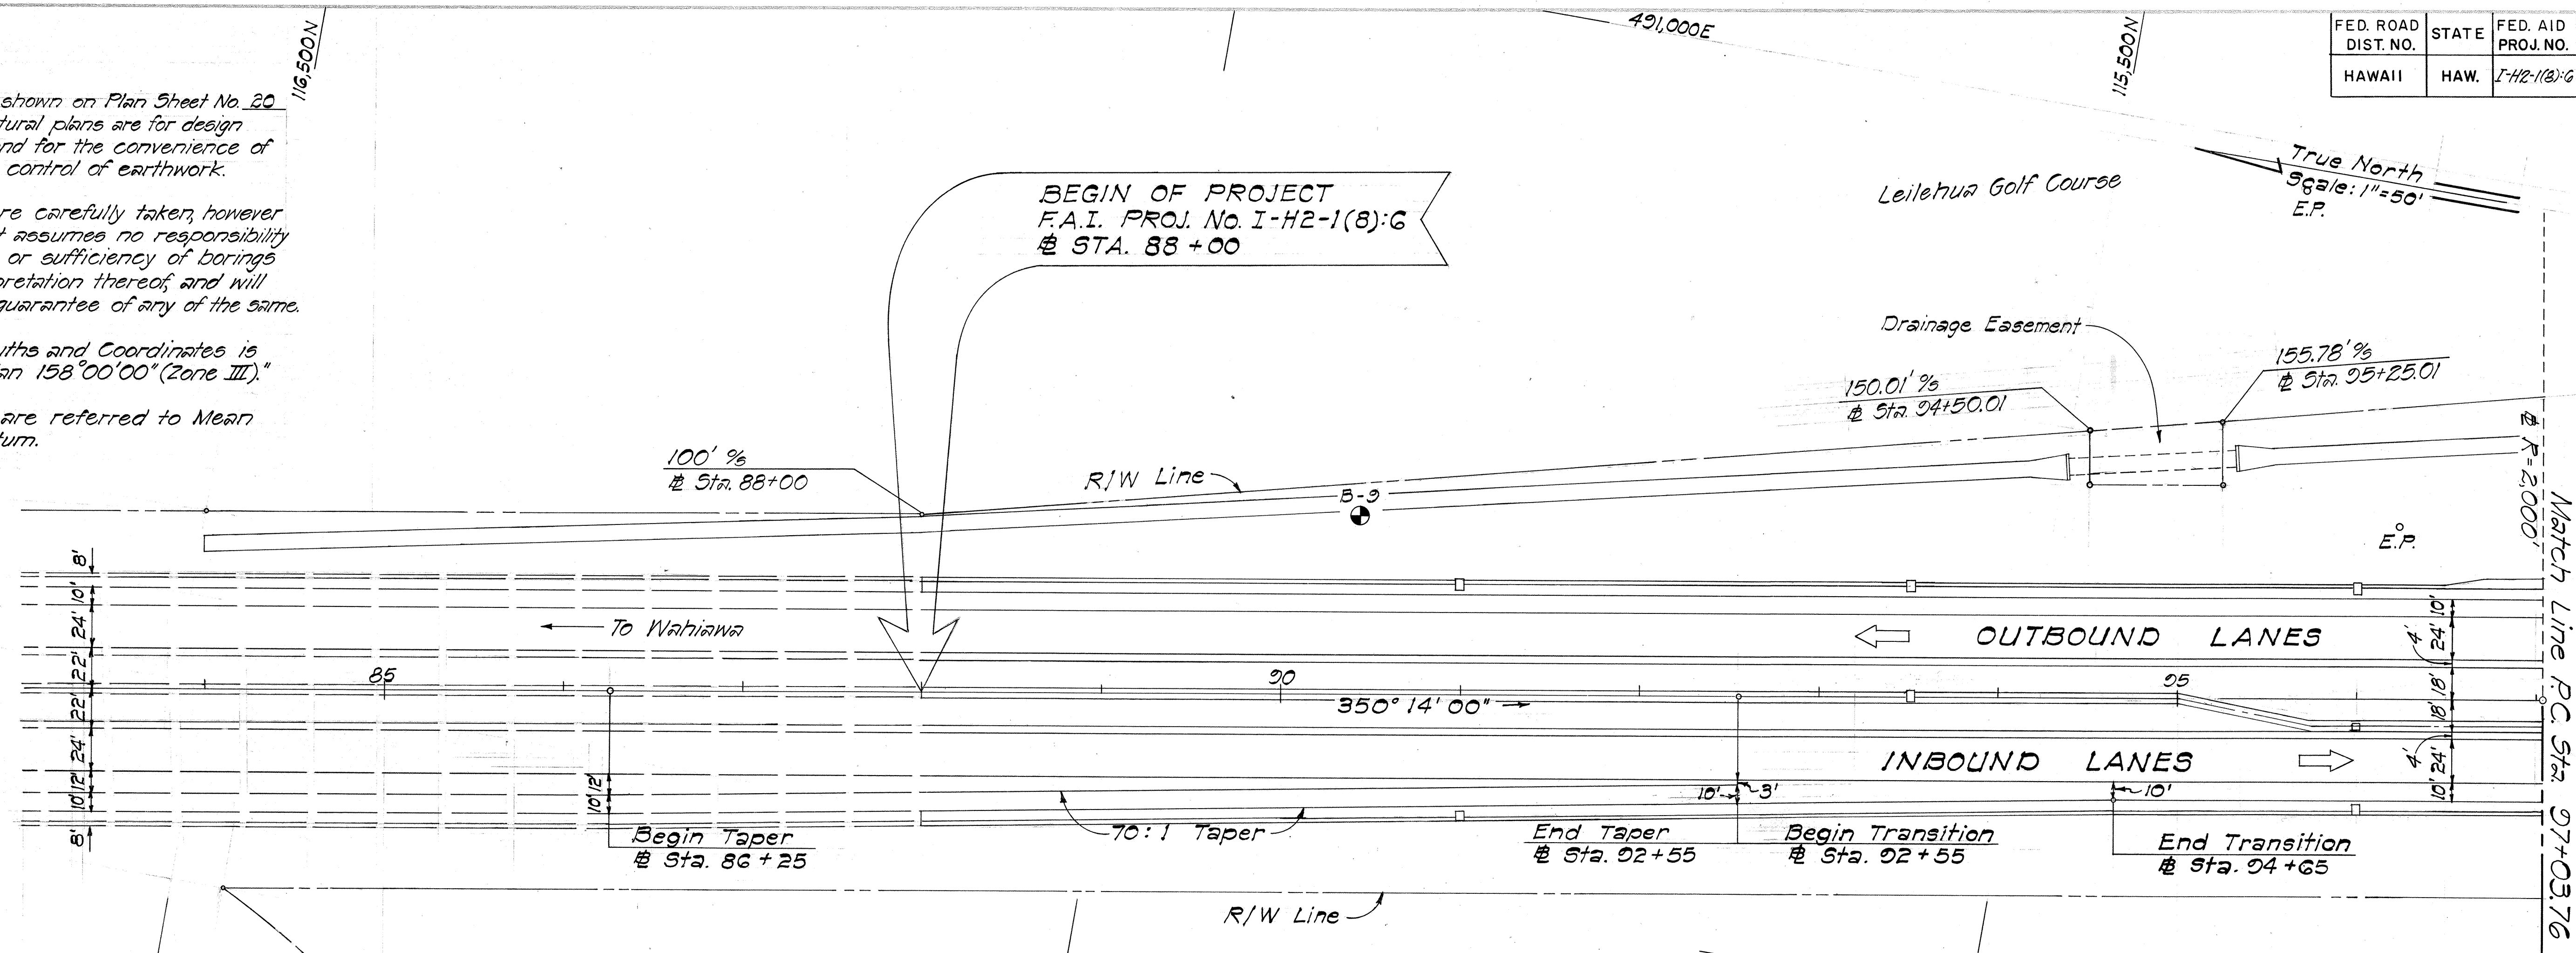

FED. ROAD DIST. NO.	STATE	FED. AID PROJ. NO.	FISCAL YEAR	SHEET NO.	TOTAL SHEETS
HAWAII	HAW.	I-H2-1(8):6	1973	10	160

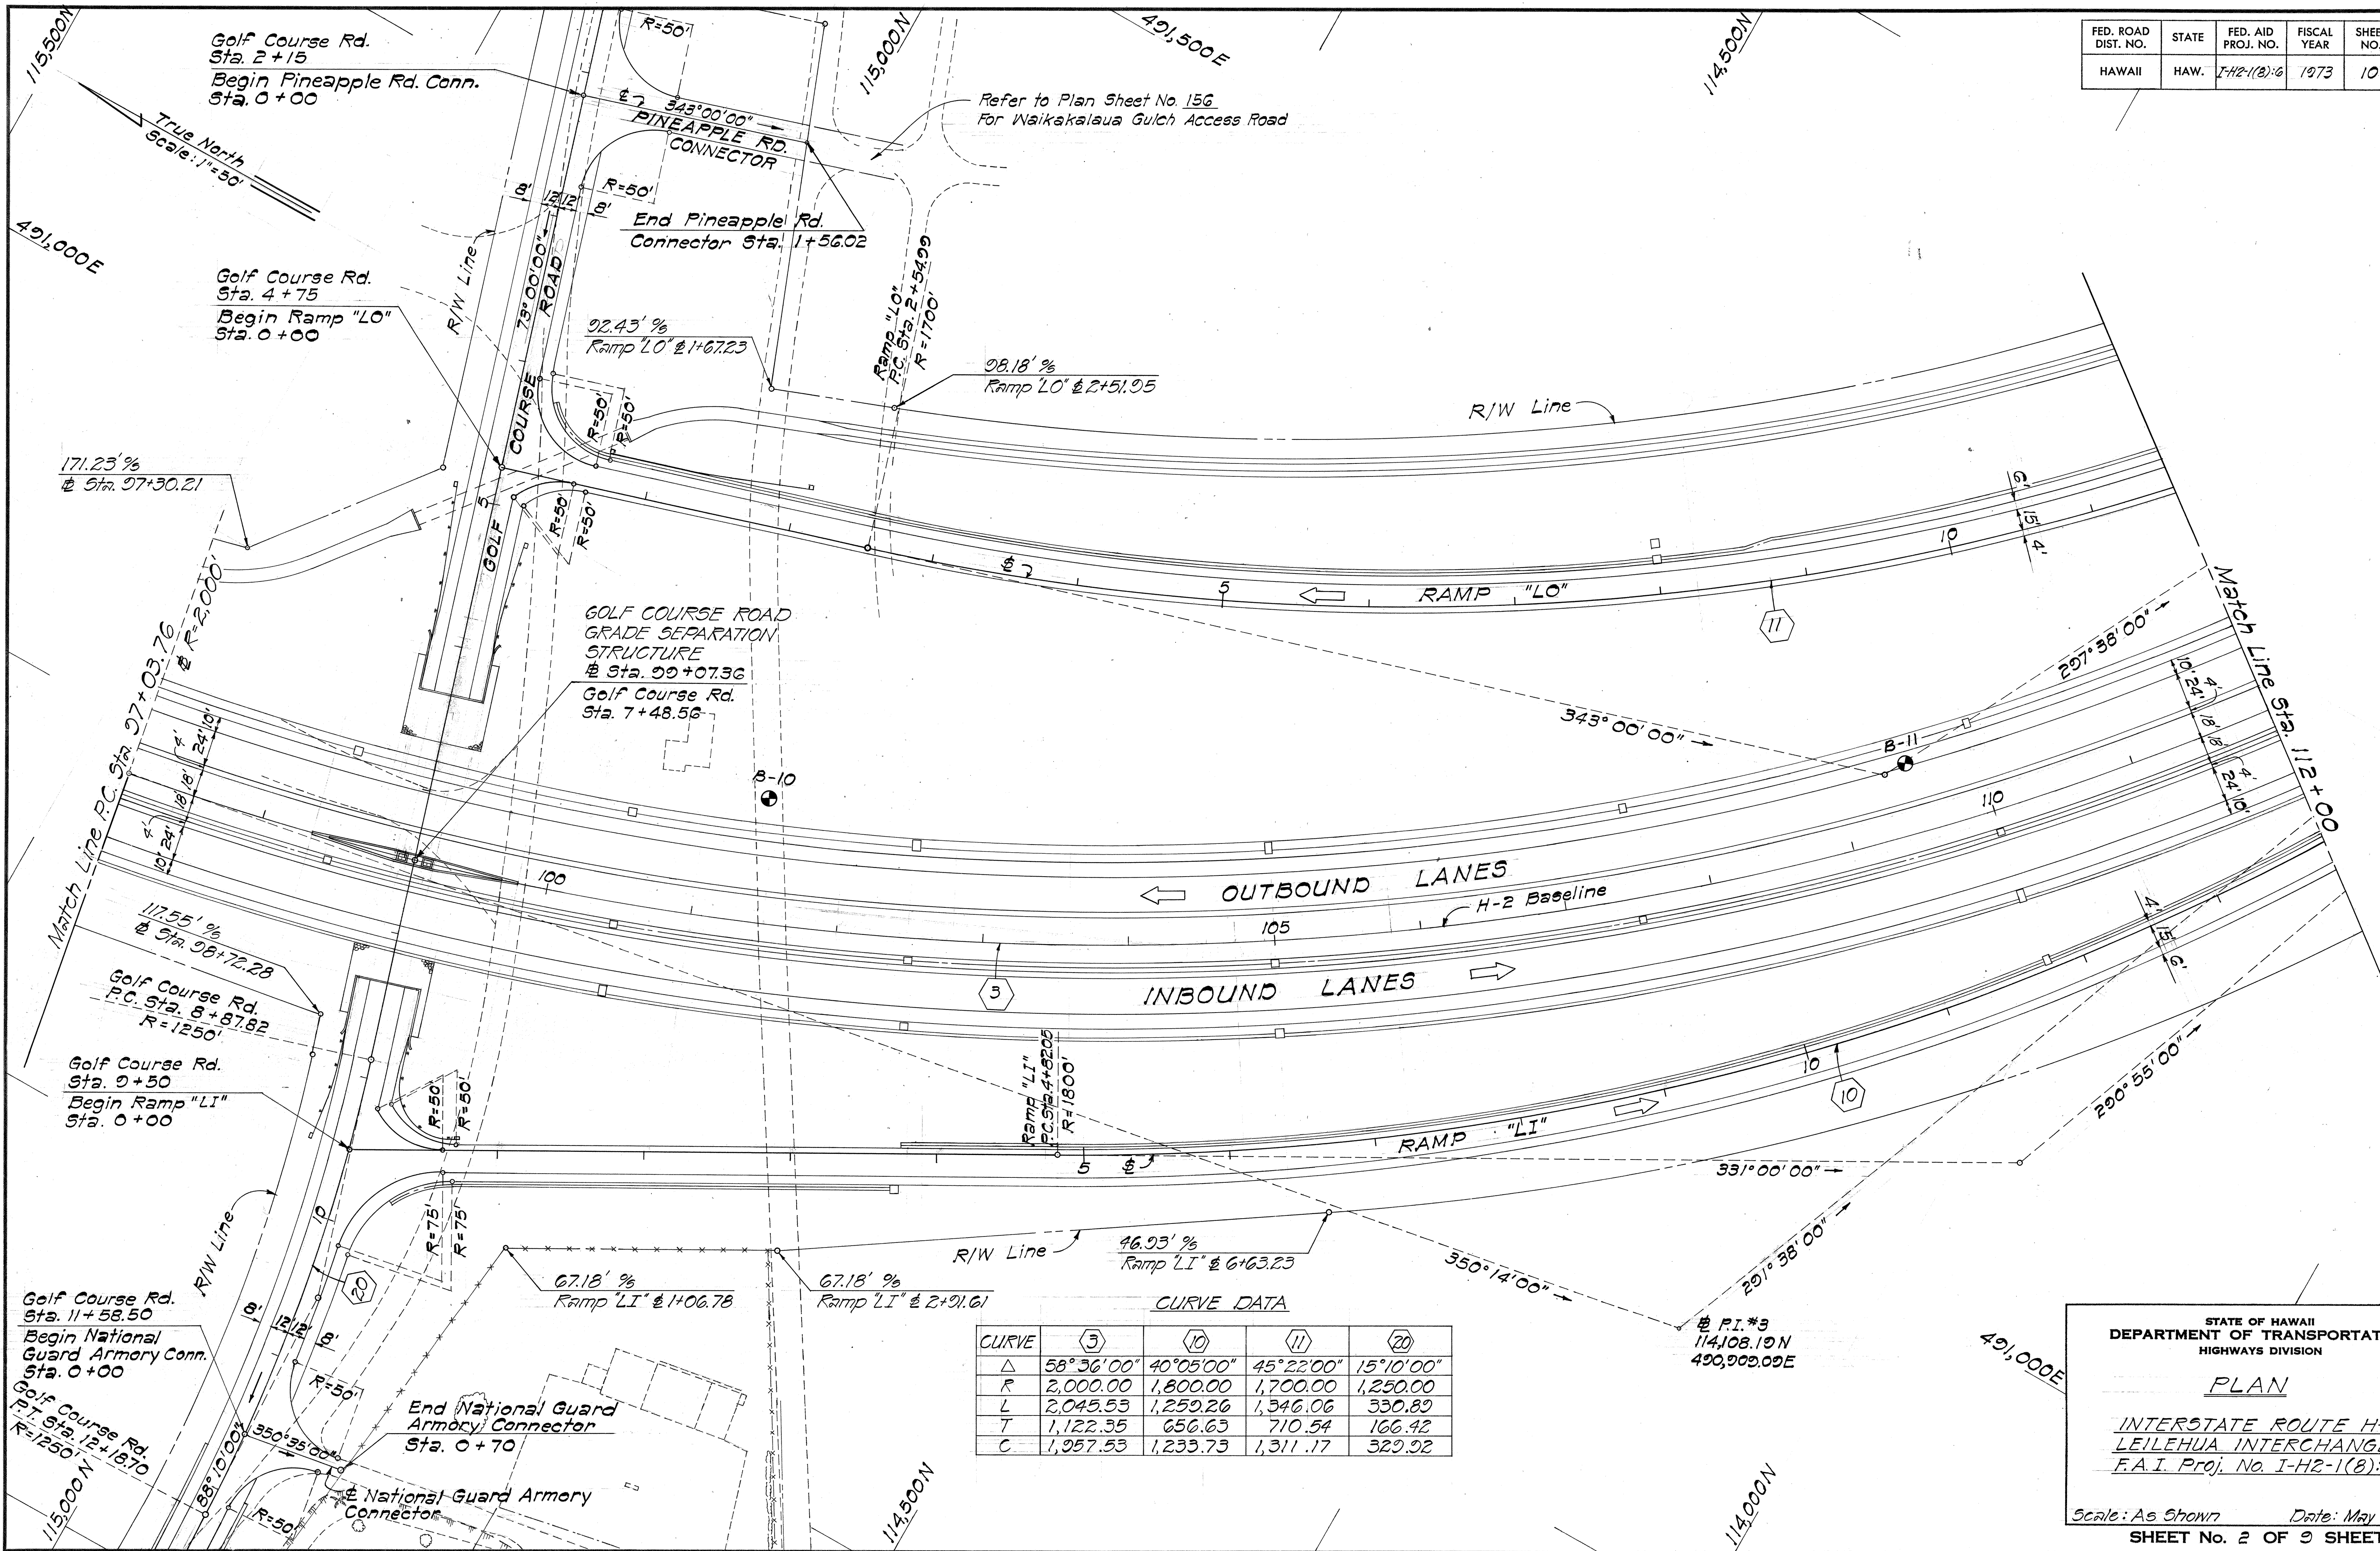

CURVE DATA

CURVE	(3)	(10)	(11)	(20)
Δ	58°36'00"	40°05'00"	45°22'00"	15°10'00"
R	2,000.00	1,800.00	1,700.00	1,250.00
L	2,045.53	1,250.26	1,346.06	330.89
T	1,122.35	656.63	710.54	166.42
C	1,957.53	1,233.73	1,311.17	329.92

SURVEY PLOTTED BY	DATE
DRAWN BY	
CHECKED BY	
DESIGNED BY	
NOTED BY	
QUANTITIES BY	
CHECKED BY	
ORIGINAL PLAN	
NOTE BOOK	
No.	

STATE OF HAWAII
DEPARTMENT OF TRANSPORTATION
HIGHWAYS DIVISION

PLAN

INTERSTATE ROUTE H-2
LEILEHUA INTERCHANGE
F.A.I. Proj. No. I-H2-1(8):6


Scale: As Shown Date: May 1973

SHEET No. 2 OF 9 SHEETS


FED. ROAD DIST. NO.	STATE	FED. AID PROJ. NO.	FISCAL YEAR	SHEET NO.	TOTAL SHEETS
HAWAII	HAW.	I-42-1(2)-6	1973	11	100

FINAL SURVEY	BY	DATE
SURVEYED		
NOTE BOOK		
AREAS		
CHECKED		

ORIGINAL SURVEY	BY	DATE
SURVEYED		
NOTE BOOK		
AREAS		
CHECKED		

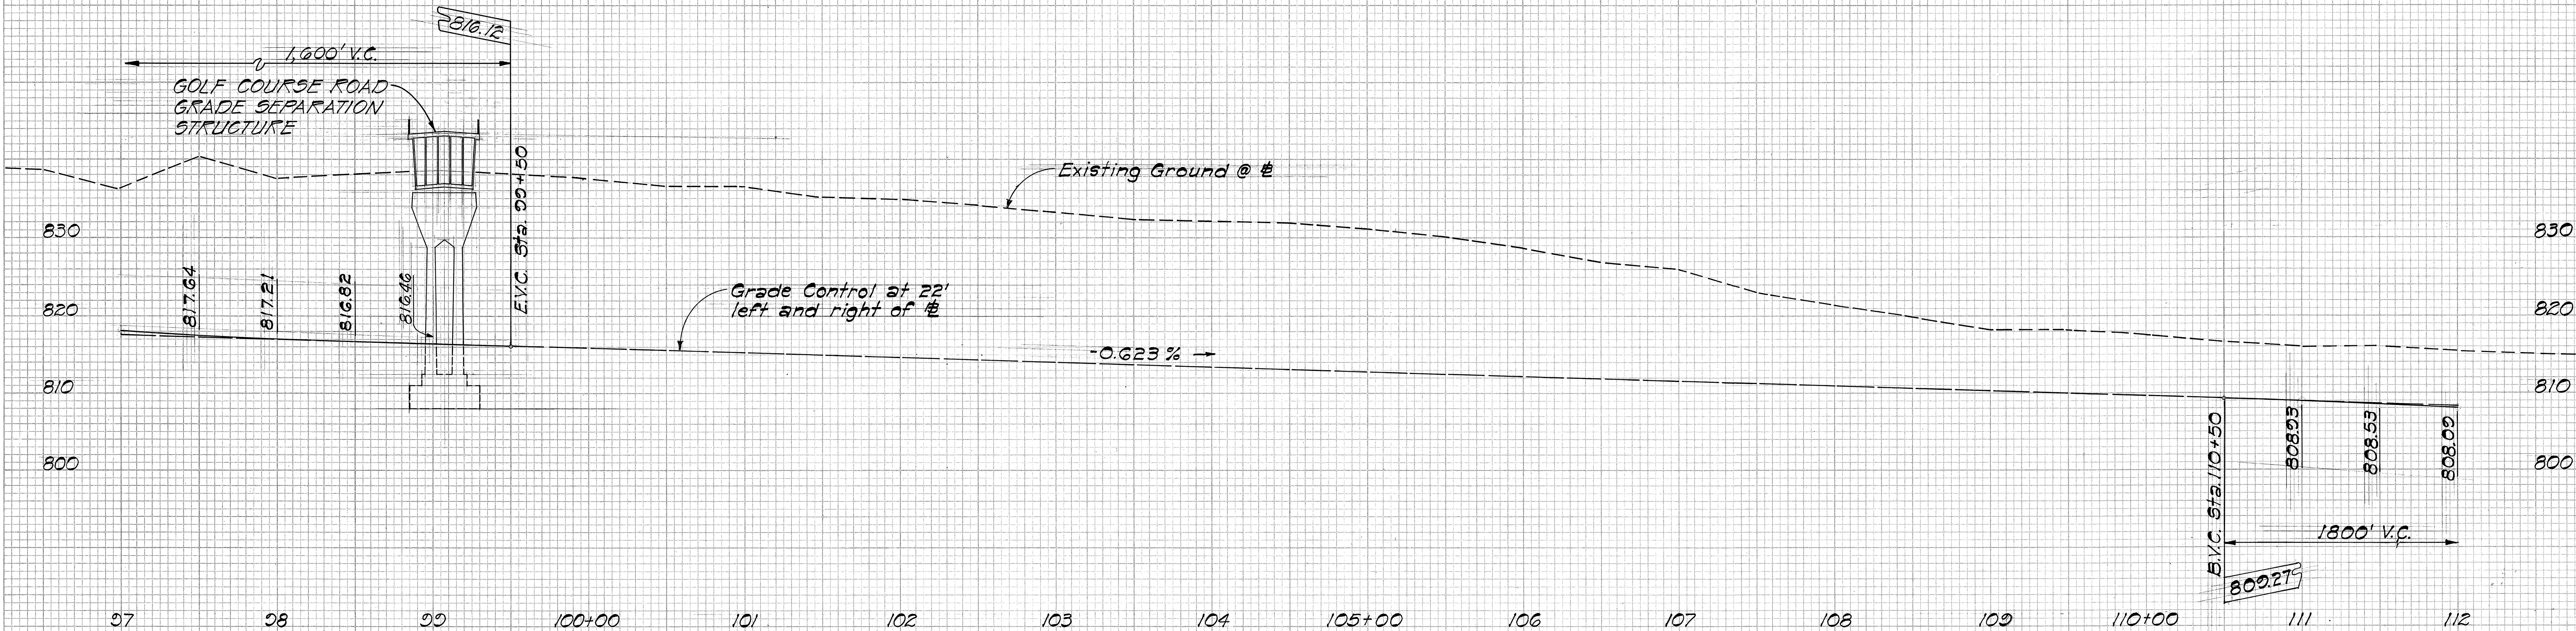

FED. ROAD DIST. NO.	STATE	FED. AID PROJ. NO.	FISCAL YEAR	SHEET NO.	TOTAL SHEETS
HAWAII	HAW.	I-H2-1(8):6	1973	12	160

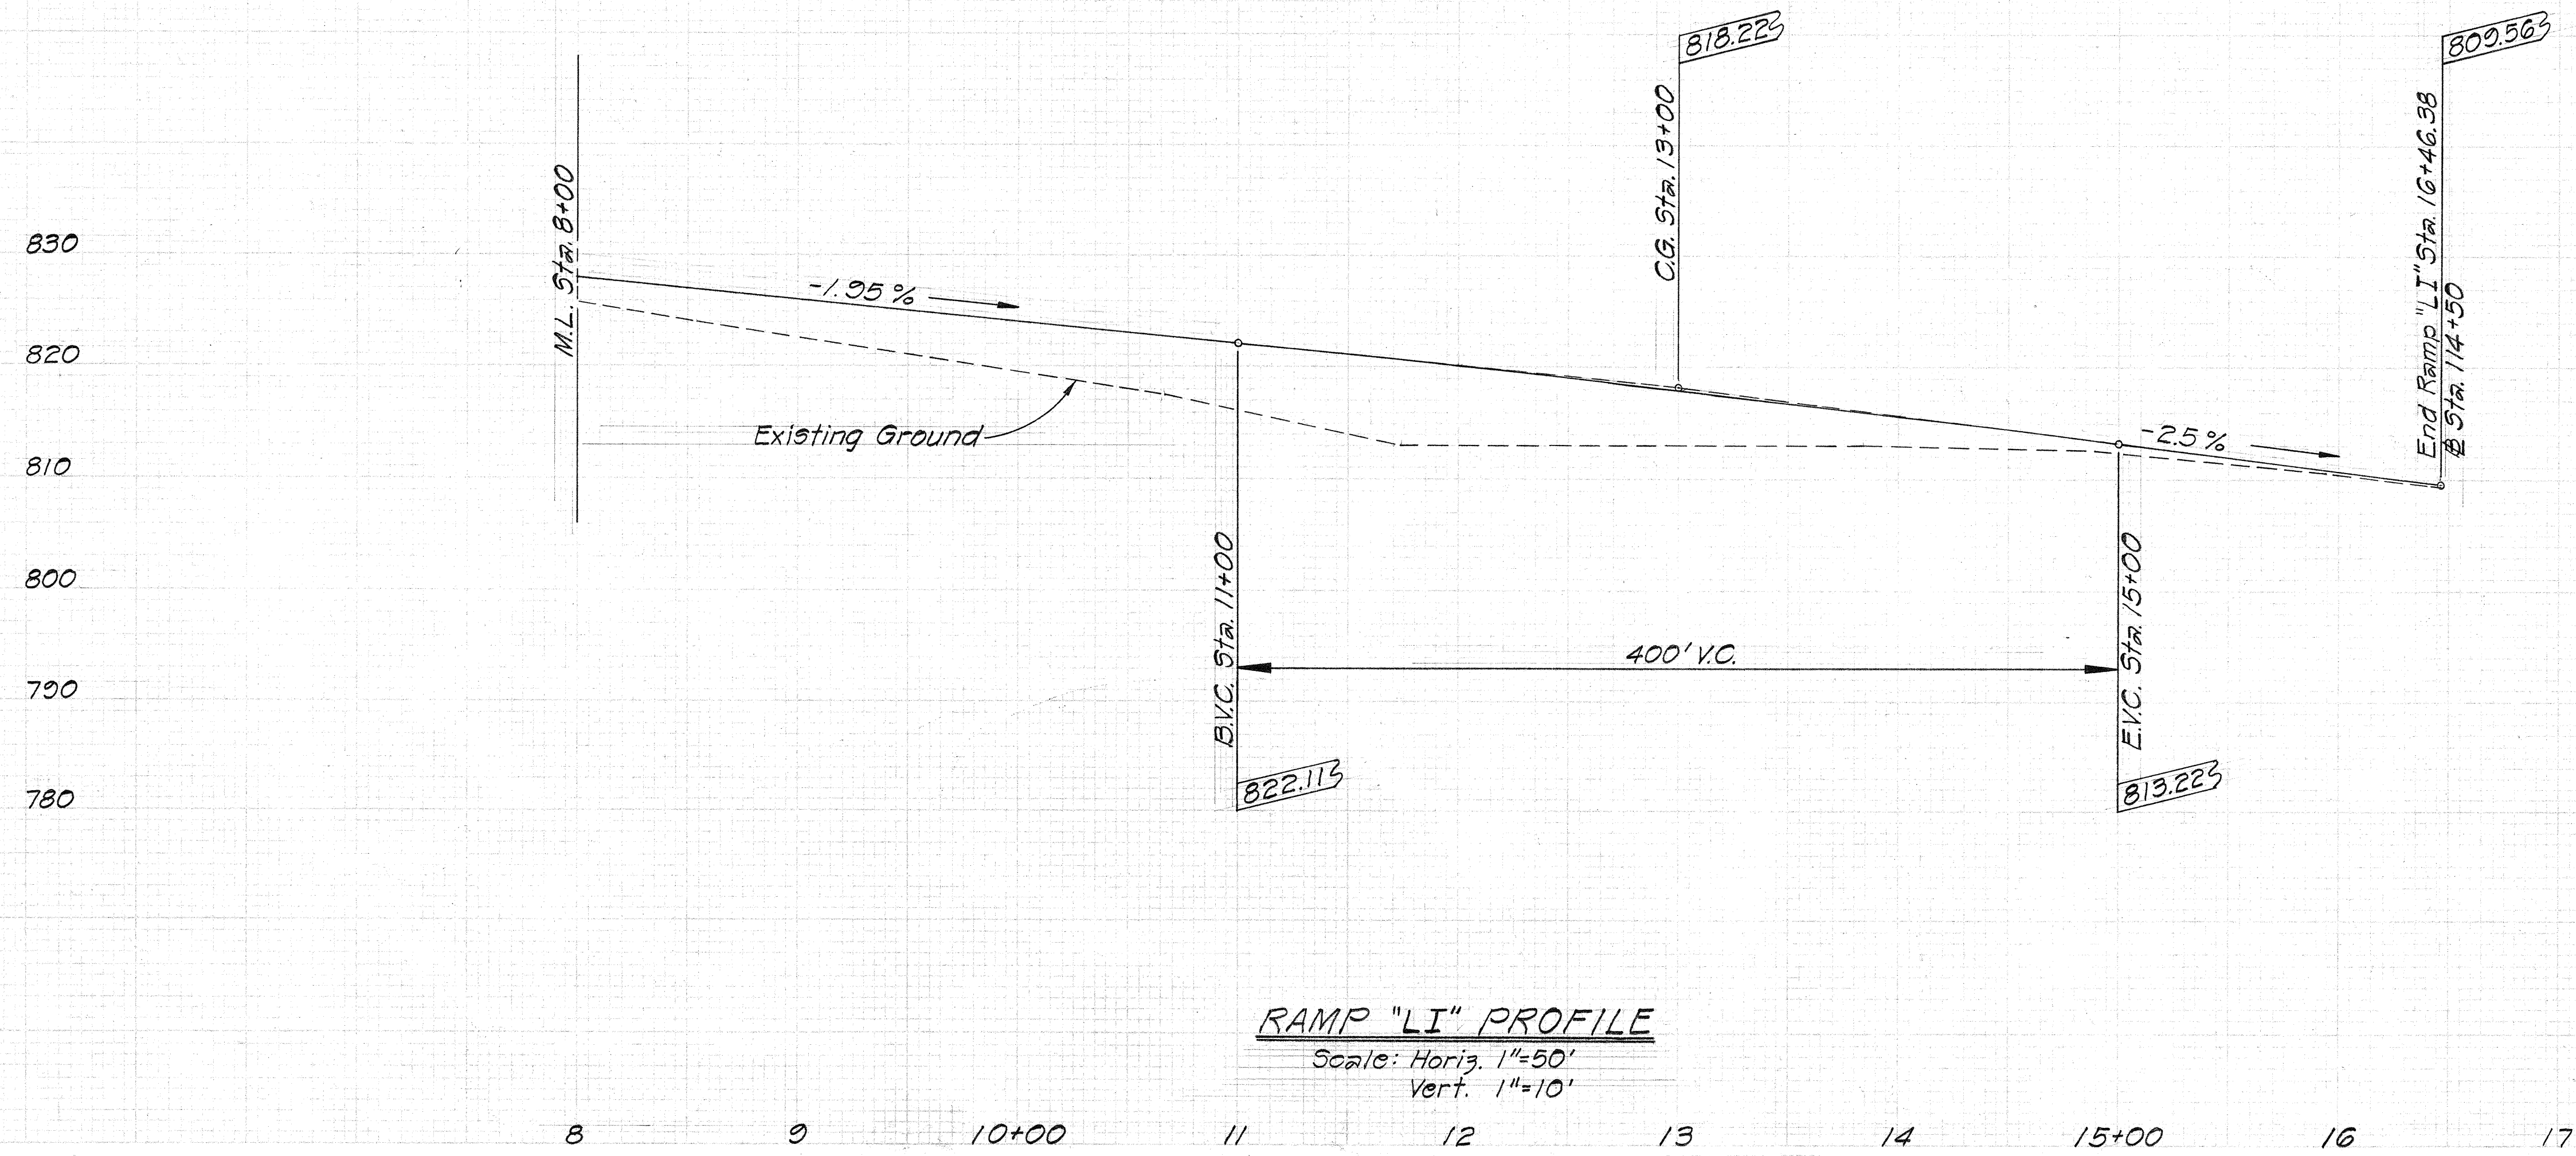

RAMP "LI" PROFILE
 Scale: Horiz. 1"=50'
 Vert. 1"=10'

STATE OF HAWAII
 DEPARTMENT OF TRANSPORTATION
 HIGHWAYS DIVISION


RAMP "LI" PROFILE
 INTERSTATE ROUTE H-2
 LEILEHUA INTERCHANGE
 F.A.I. Proj. No. I-H2-1(8):6

Scale: Horiz. 1"=50'
 Vert. 1"=10' Date: May 1973


SHEET No. 4 OF 9 SHEETS

FED. ROAD DIST. NO.	STATE	FED. AID PROJ. NO.	FISCAL YEAR	SHEET NO.	TOTAL SHEETS
HAWAII	HAW	I-H2-1(8)-6	1973	13	100

FINAL	SURVEY	DATE
NO. 10	NO. 10	NO. 10

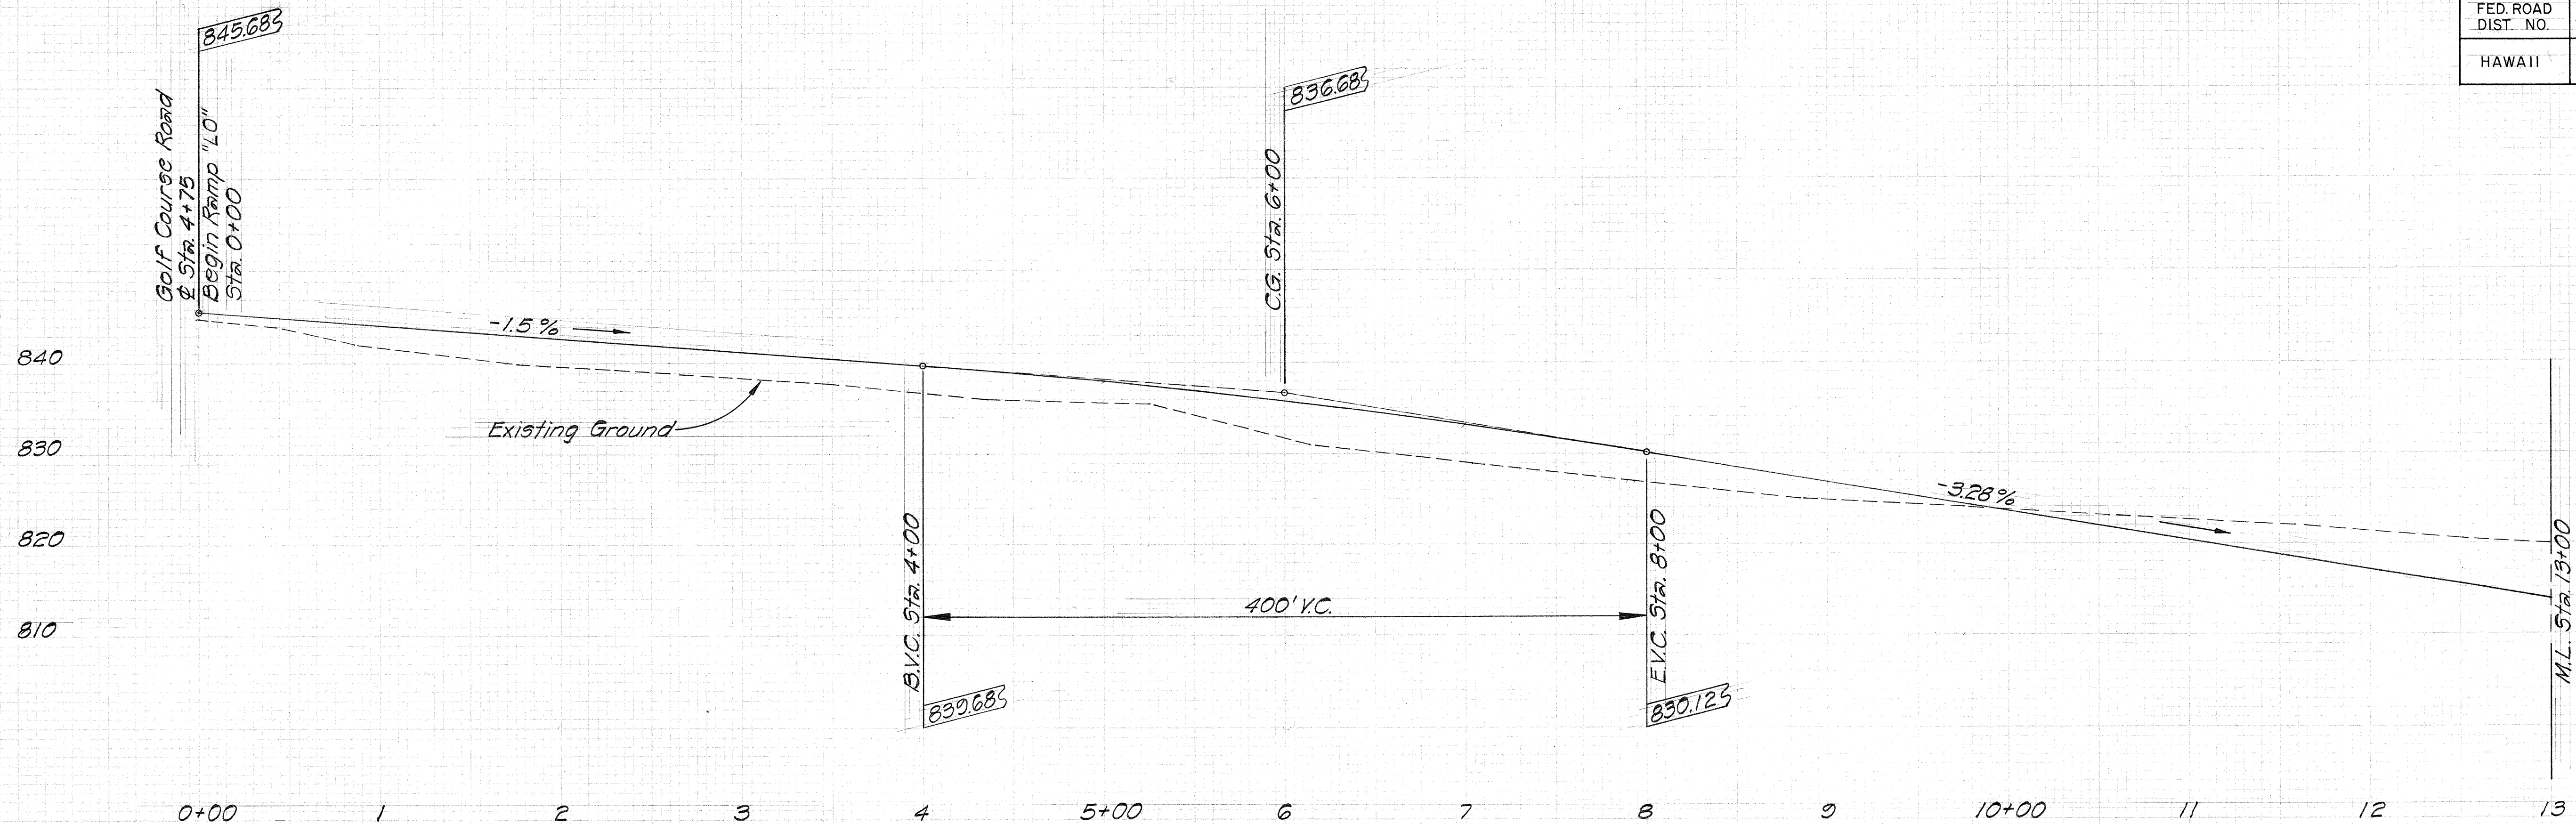

ORIGINAL	SURVEY	DATE
NO. 10	NO. 10	NO. 10

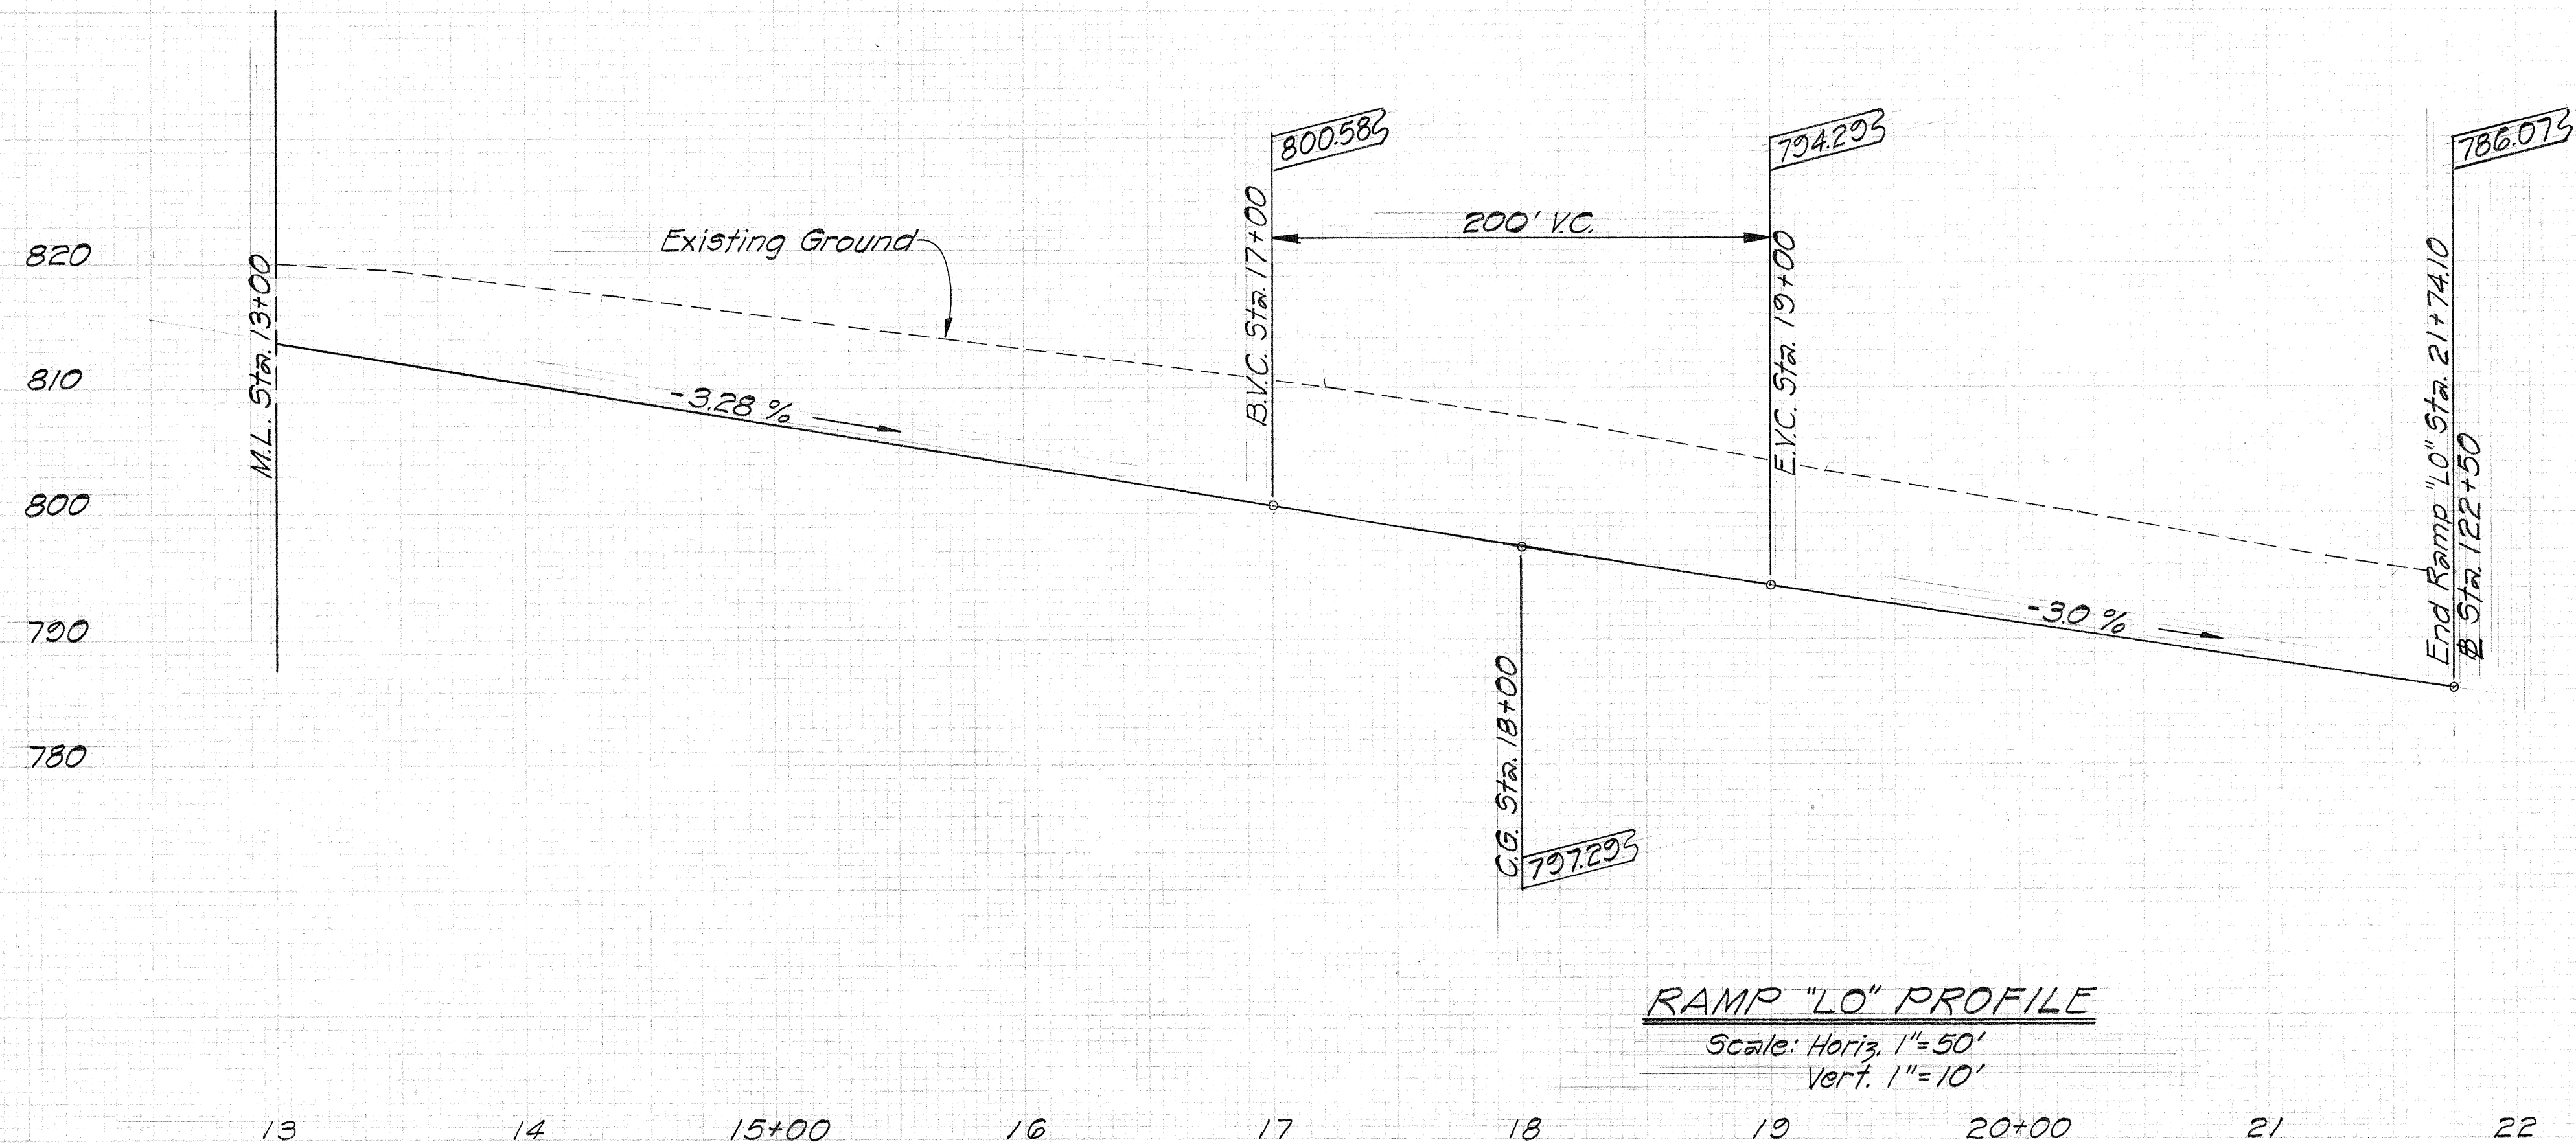

RAMP "LO" PROFILE
Scale: Horiz. 1"=50'
Vert. 1"=10'

STATE OF HAWAII
DEPARTMENT OF TRANSPORTATION
HIGHWAYS DIVISION


RAMP "LO" PROFILE
INTERSTATE ROUTE H-2
LEILEHUA INTERCHANGE
F.A.I. Proj. No. I-H2-1(8)-6

Scale: Horiz. 1"=50'
Vert. 1"=10' Date: May 1973

SHEET No. 5 OF 9 SHEETS

B.M. 559-14 (Disk)
Elev. = 802.38'
443' $\frac{9}{16}$ Lt. $\oplus$ Sta. 126+06



Ramp "LO" @ 18+62.17

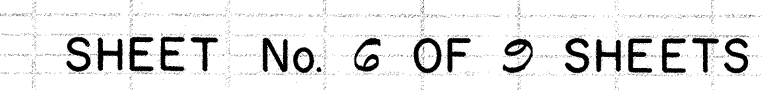

FED. ROAD DIST. NO.	STATE	FED. AID PROJ. NO.	FISCAL YEAR	SHEET NO.	TOTAL SHEETS
HAWAII	HAW.	I-H2-1(B)-6	1973	15	160

PLAN	DATE
SURVEYED	
PLOTTED	
CHECKED	
DATE	

PROFILE	DATE
SURVEYED	
GRADES CHECKED	
DATE	

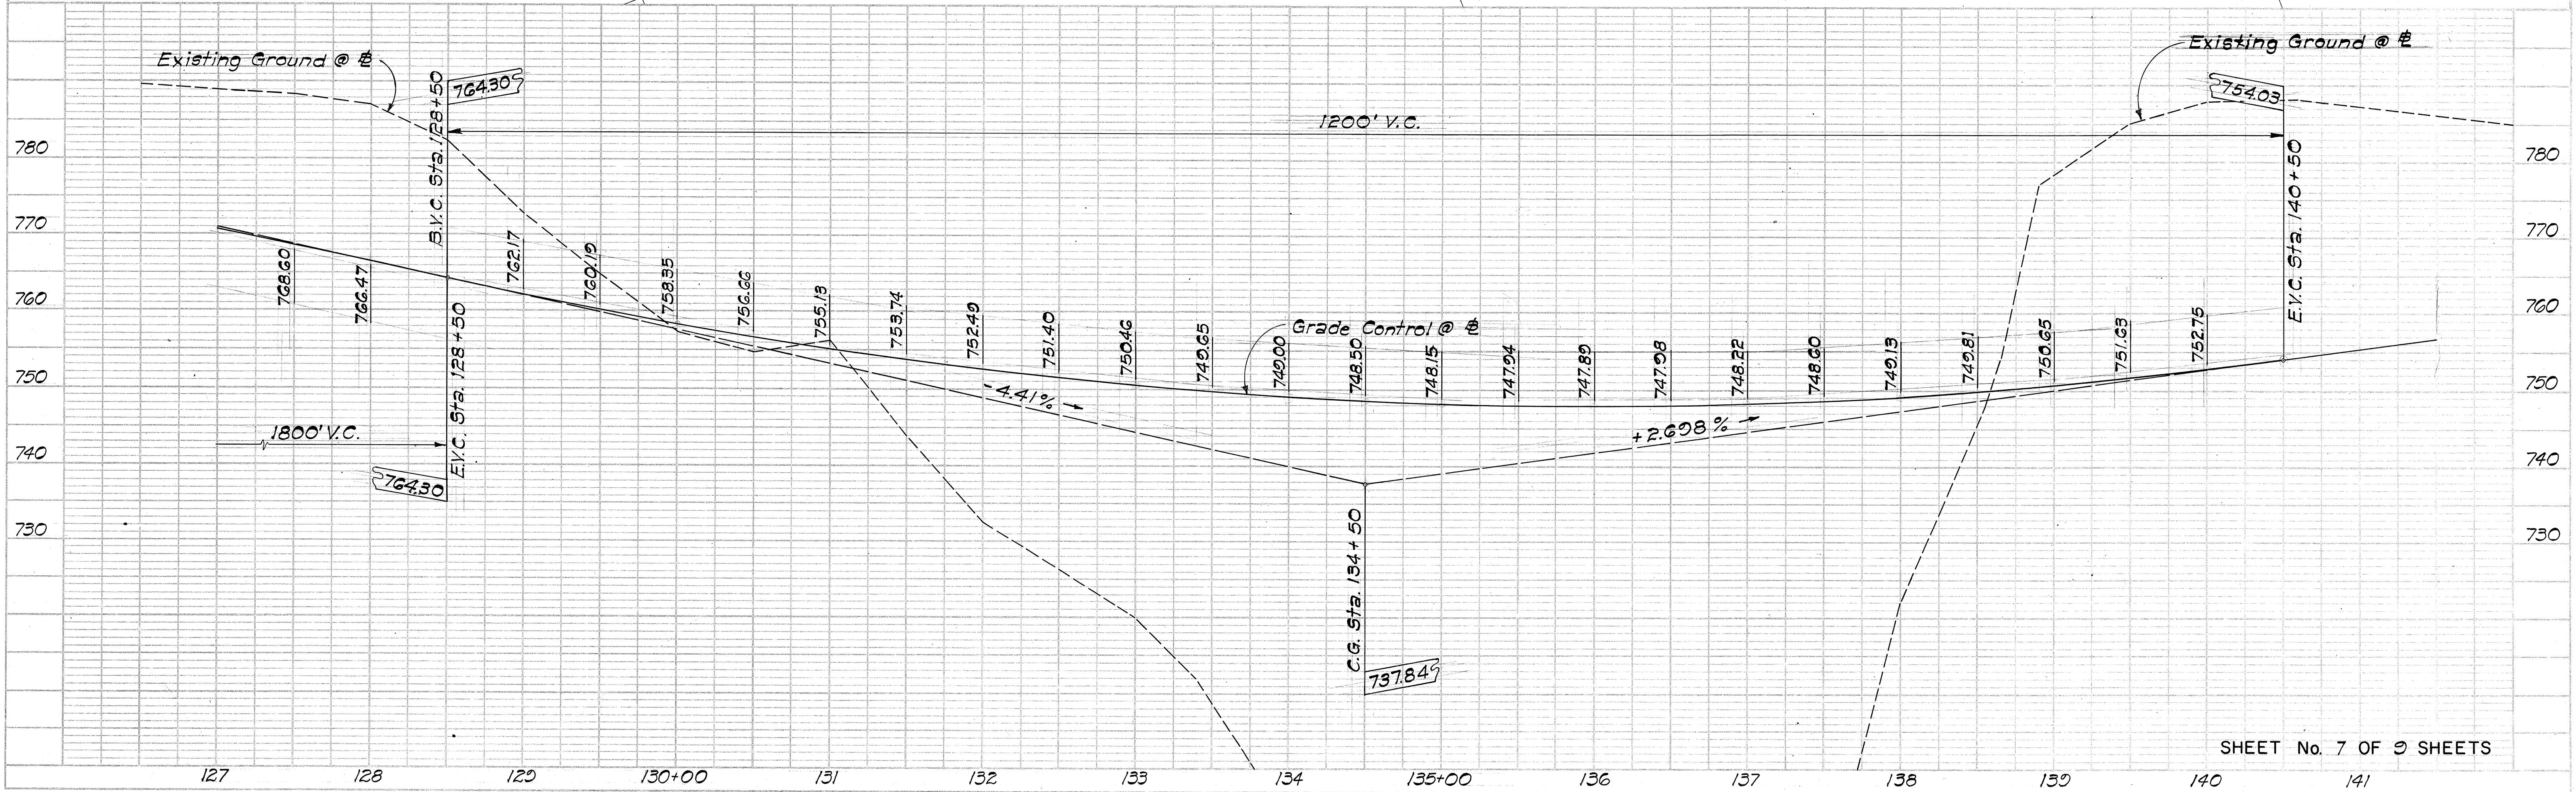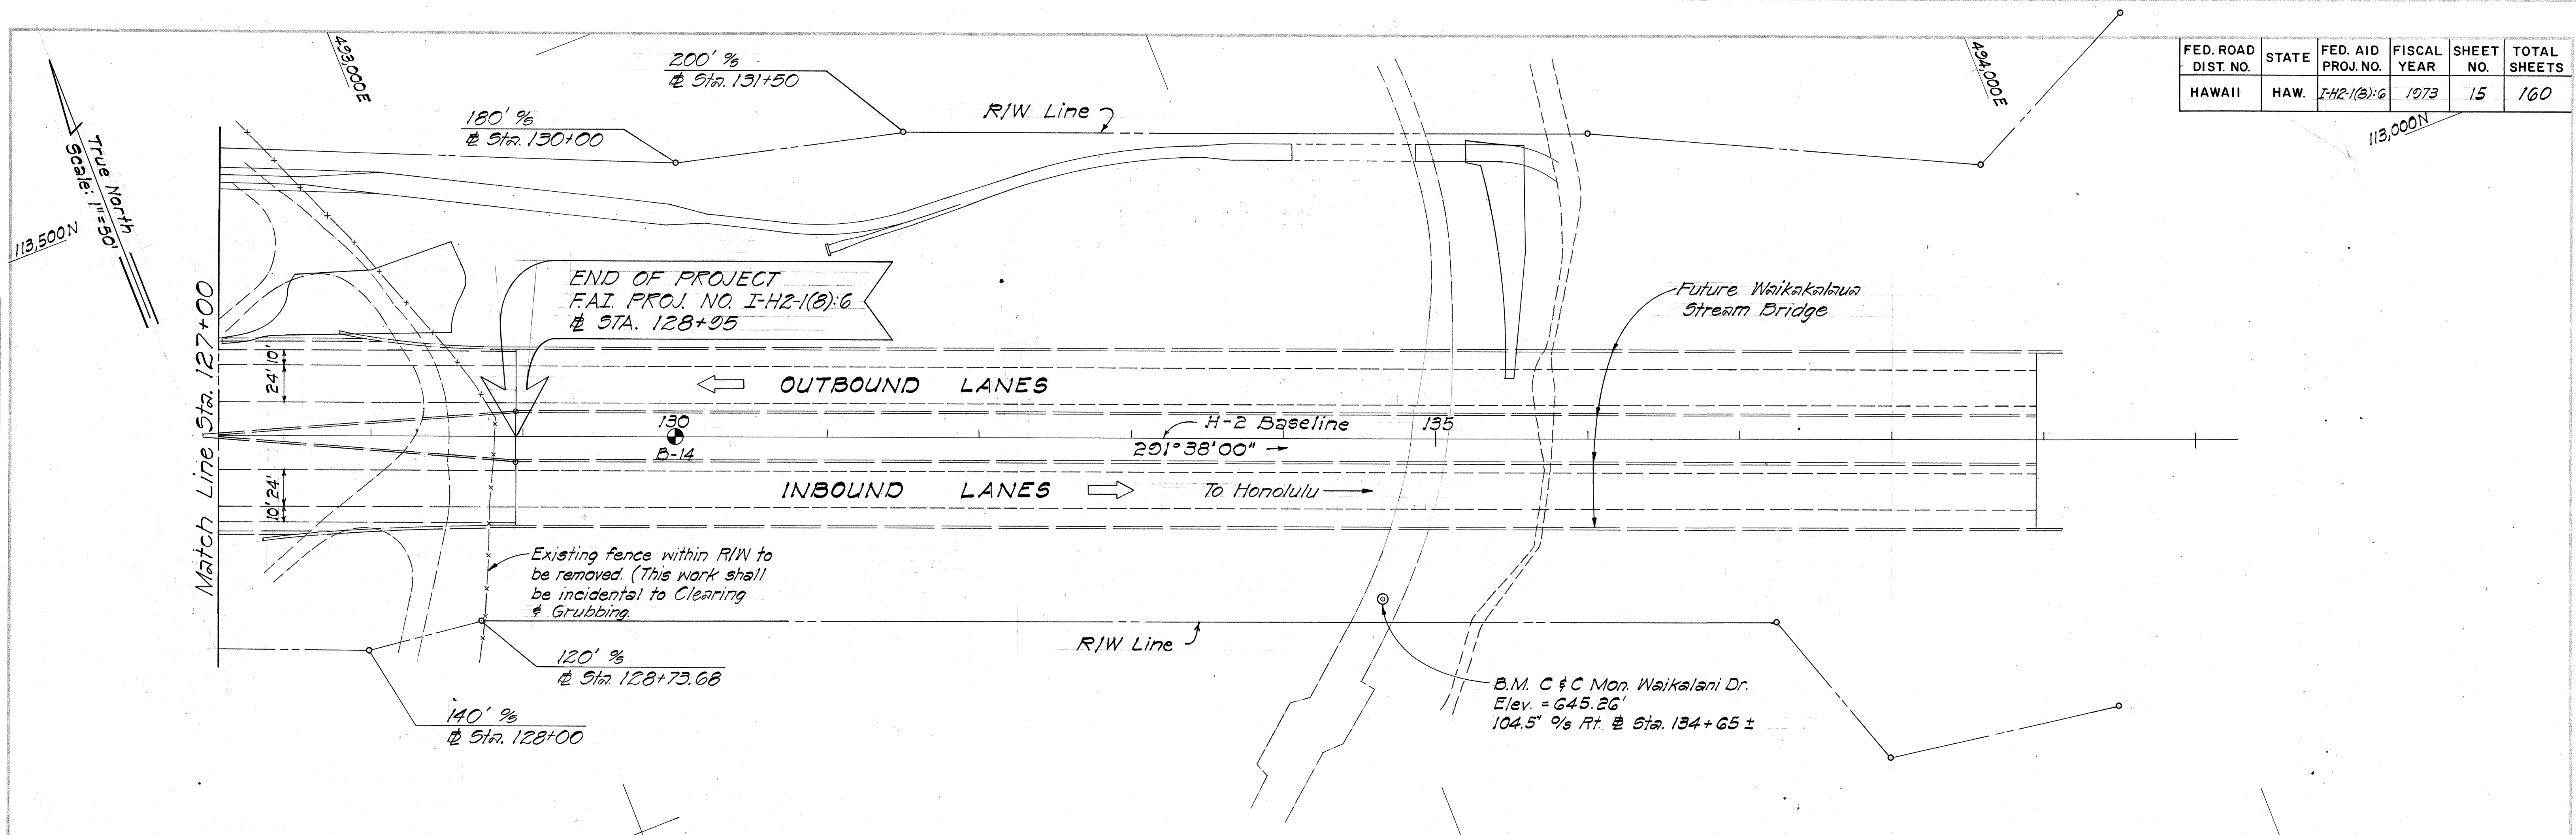


SHEET No. 7 OF 2 SHEETS

FED. ROAD DIST. NO.	STATE	FED. AID PROJ. NO.	FISCAL YEAR	SHEET NO.	TOTAL SHEETS
HAWAII	HAW.	I-H2-1(8)-6	1973	16	160

NOTE:

Prior to obliterating the existing Pineapple Service Road the Contractor shall complete the construction of Pineapple Road Connector and provide adequate access to pineapple fields on the left of the highway baseline.

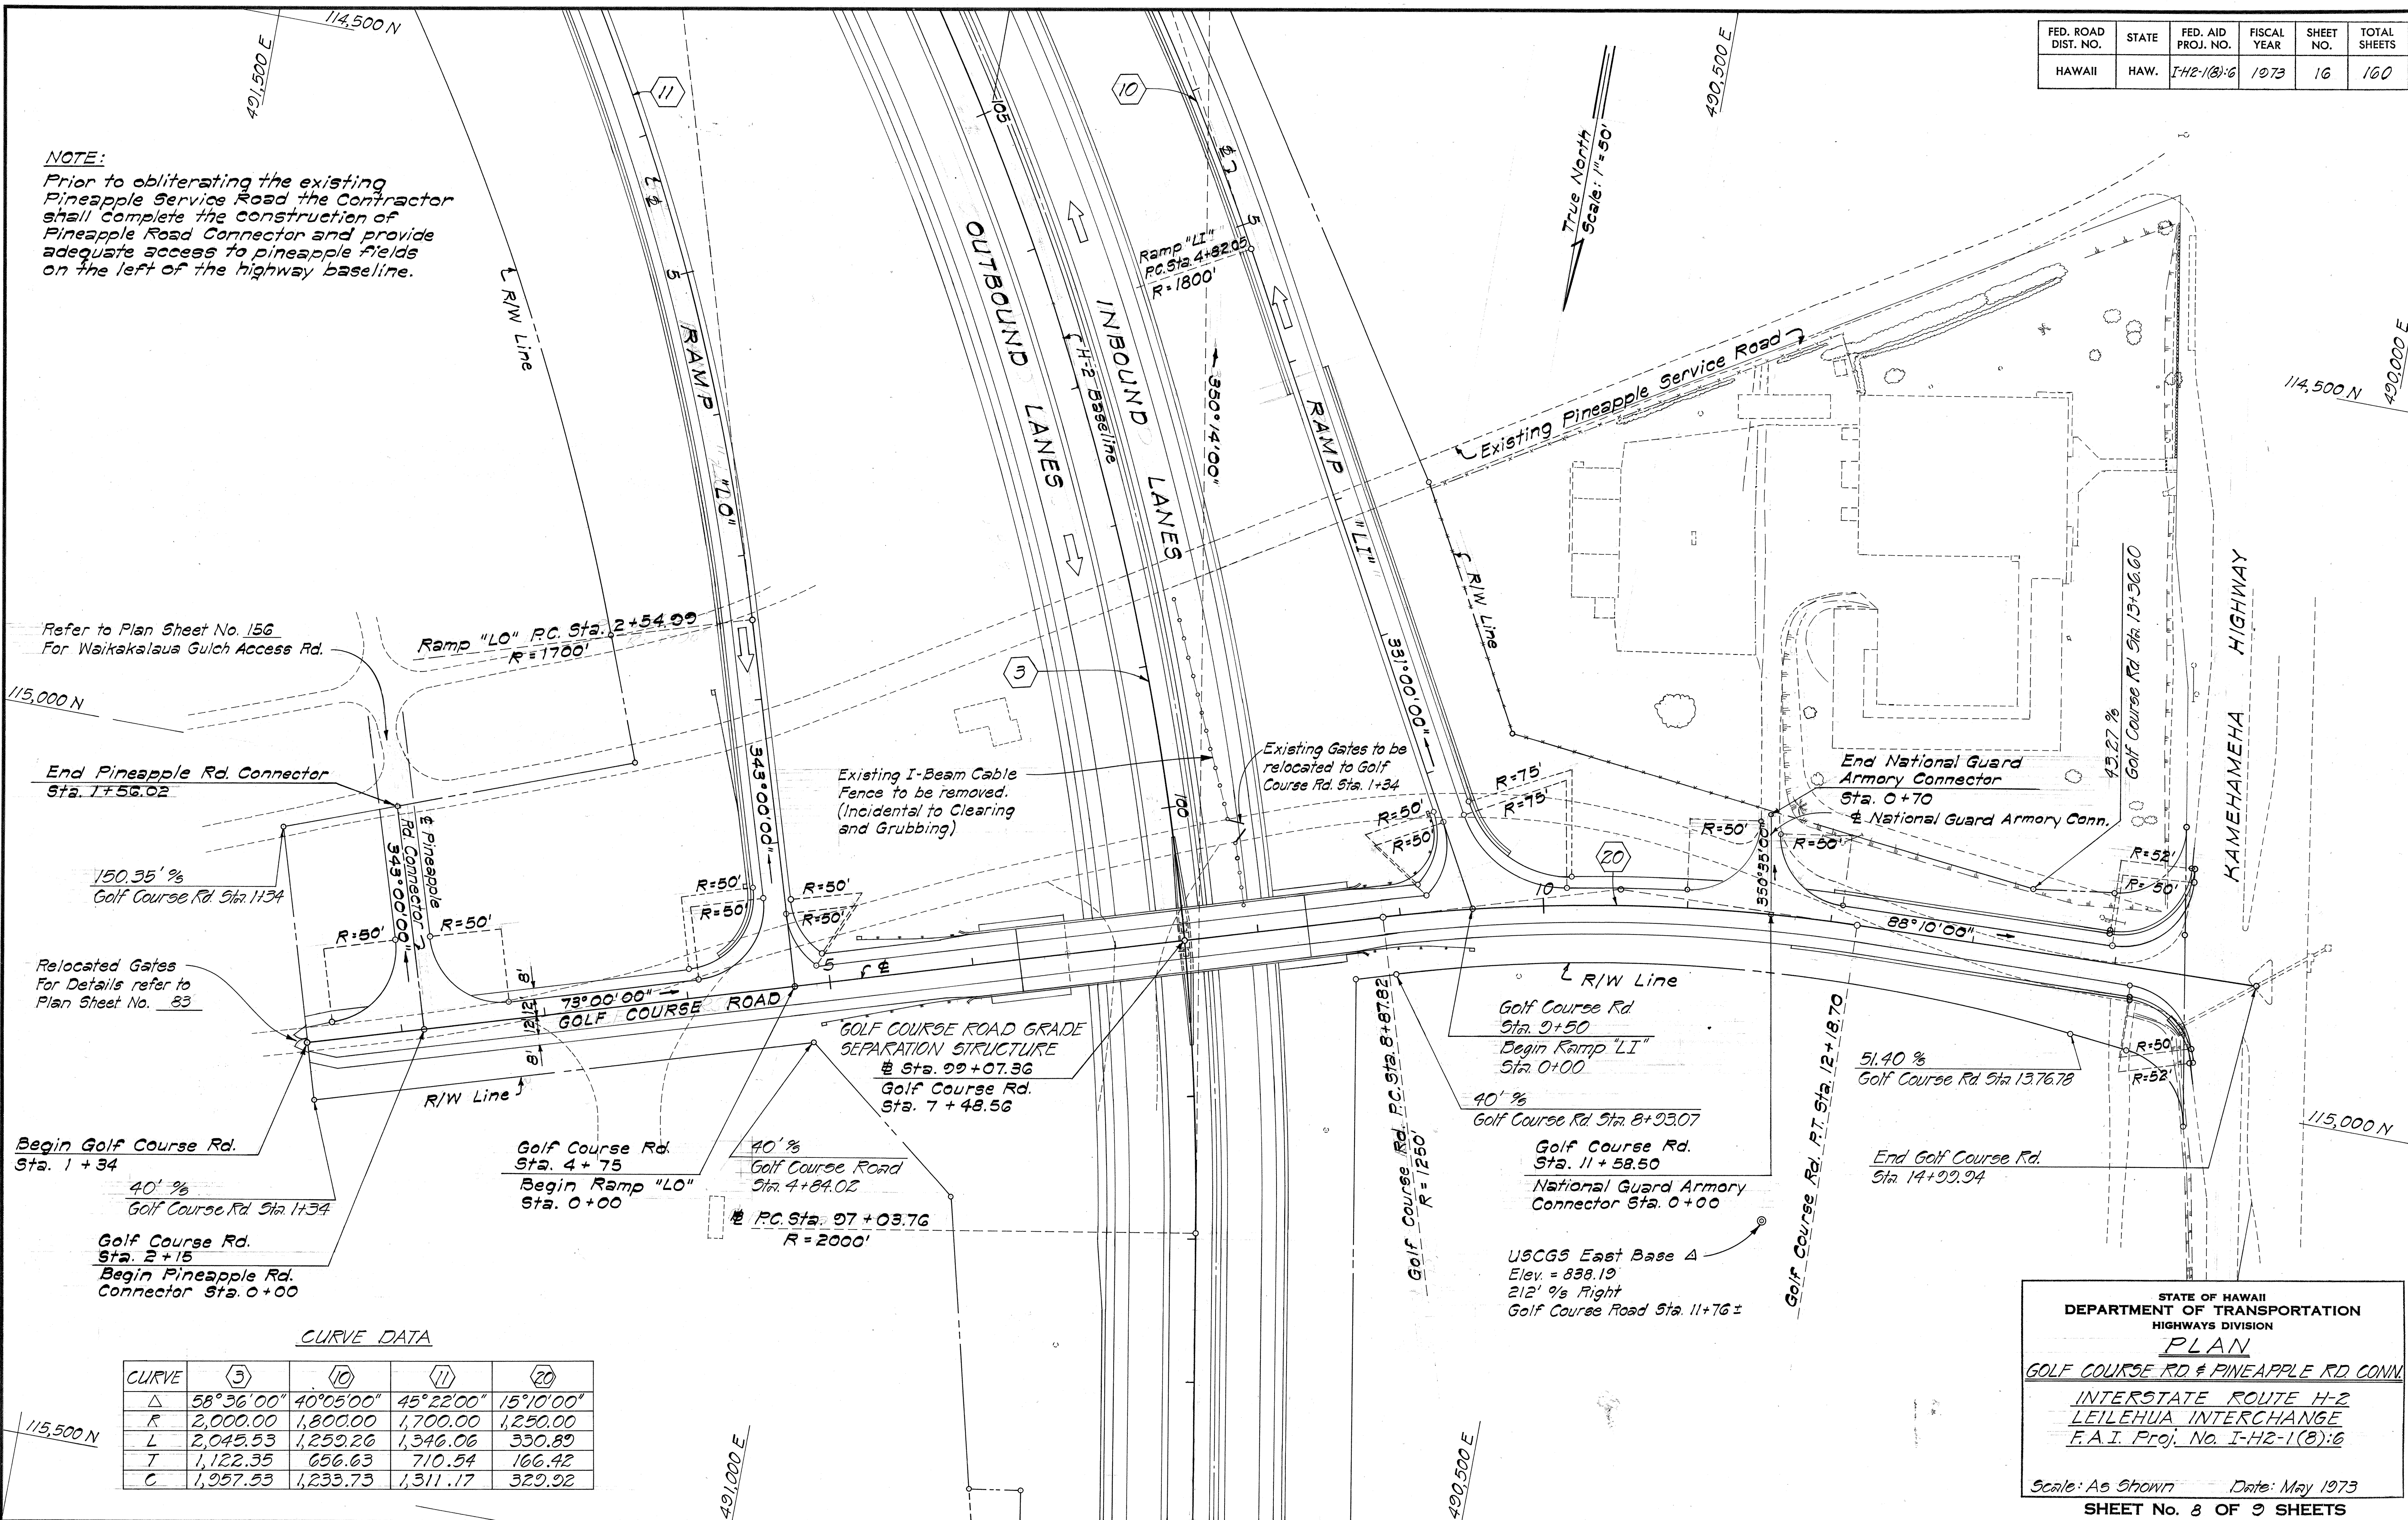

CURVE DATA


CURVE	③	⑩	⑪	②①
Δ	58°36'00"	40°05'00"	45°22'00"	15°10'00"
R	2,000.00	1,800.00	1,700.00	1,250.00
L	2,045.53	1,252.26	1,346.06	330.89
T	1,122.35	656.63	710.54	166.42
C	1,957.53	1,233.73	1,311.17	329.92

STATE OF HAWAII
DEPARTMENT OF TRANSPORTATION
HIGHWAYS DIVISION
PLAN
GOLF COURSE RD & PINEAPPLE RD CONN.
INTERSTATE ROUTE H-2
LEILEHUA INTERCHANGE
F.A.I. Proj. No. I-H2-1(8)-6
Scale: As Shown Date: May 1973
SHEET No. 8 OF 9 SHEETS


DATE	_____
SURVEY PLOTTED BY	_____
DRAWN BY	_____
CHECKED BY	_____
NOTE BOOK	_____
NO.	_____

FED. ROAD DIST. NO.	STATE	FED. AID PROJ. NO.	FISCAL YEAR	SHEET NO.	TOTAL SHEETS
HAWAII	HAW.	I-42-1(8)-6	1973	17	160

14 15+00

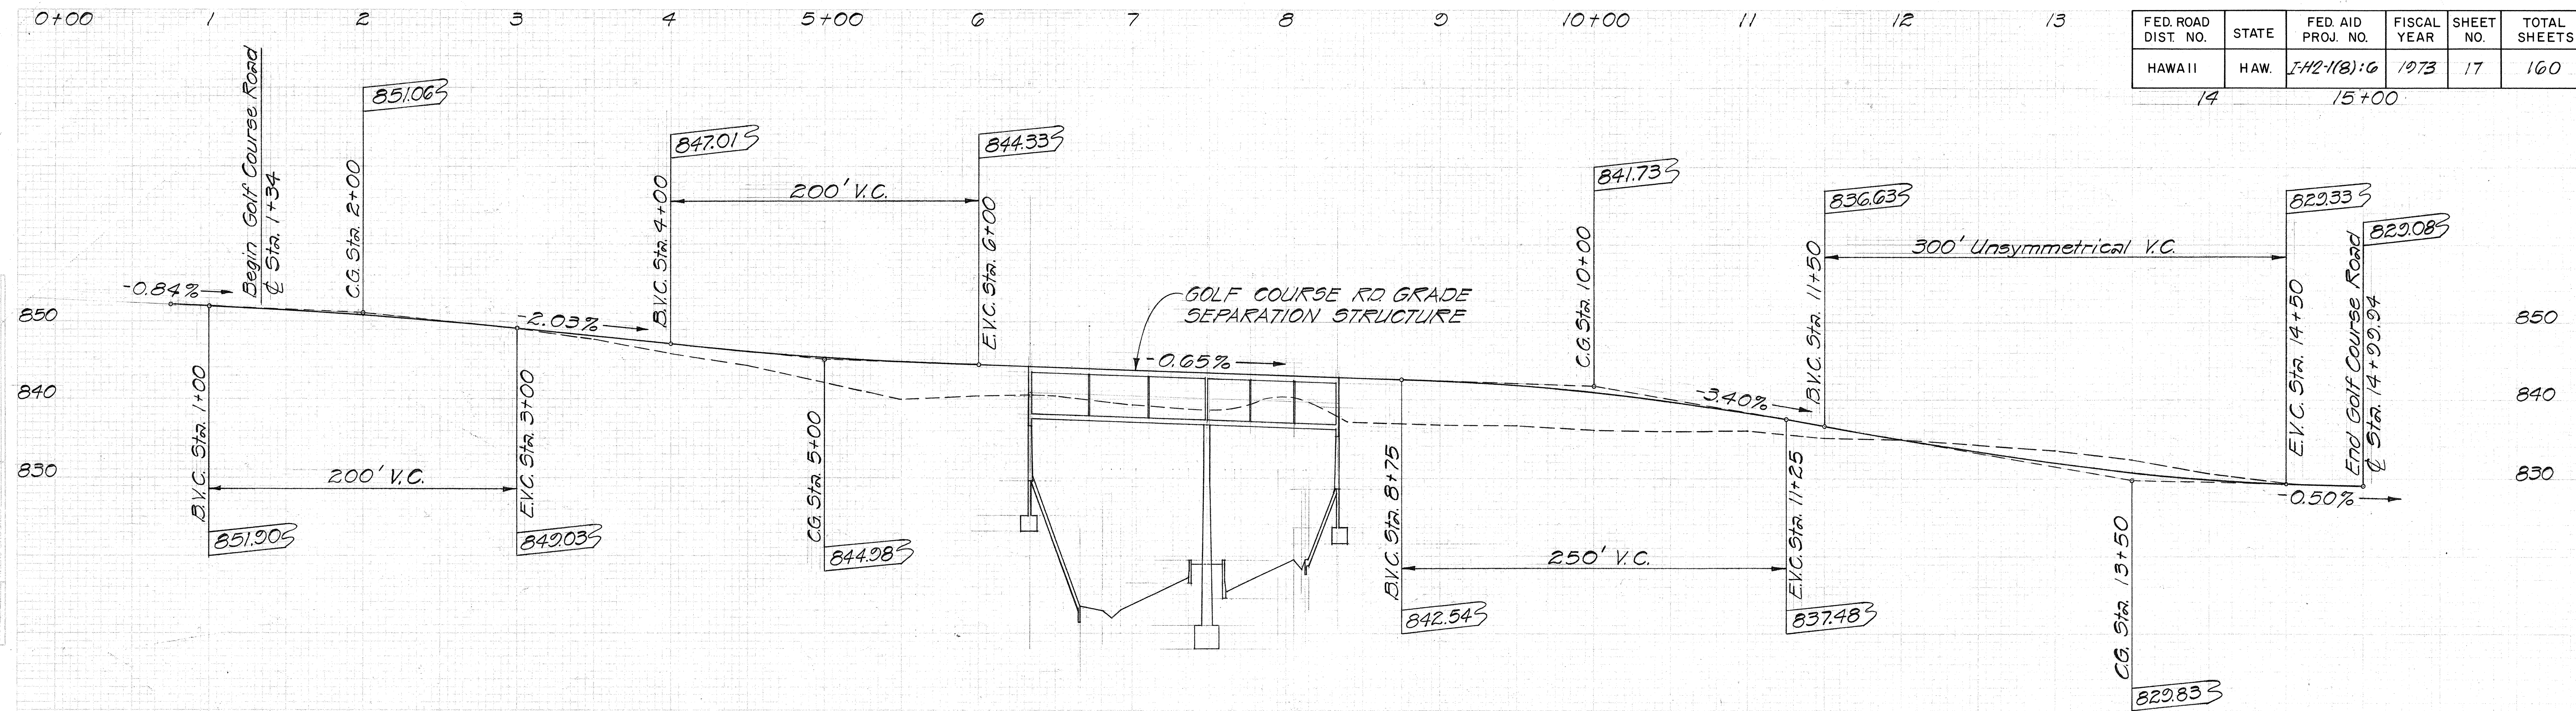

PROFILE - GOLF COURSE ROAD
 Scale: Horiz. = 1" = 50'
 Vert. = 1" = 10'

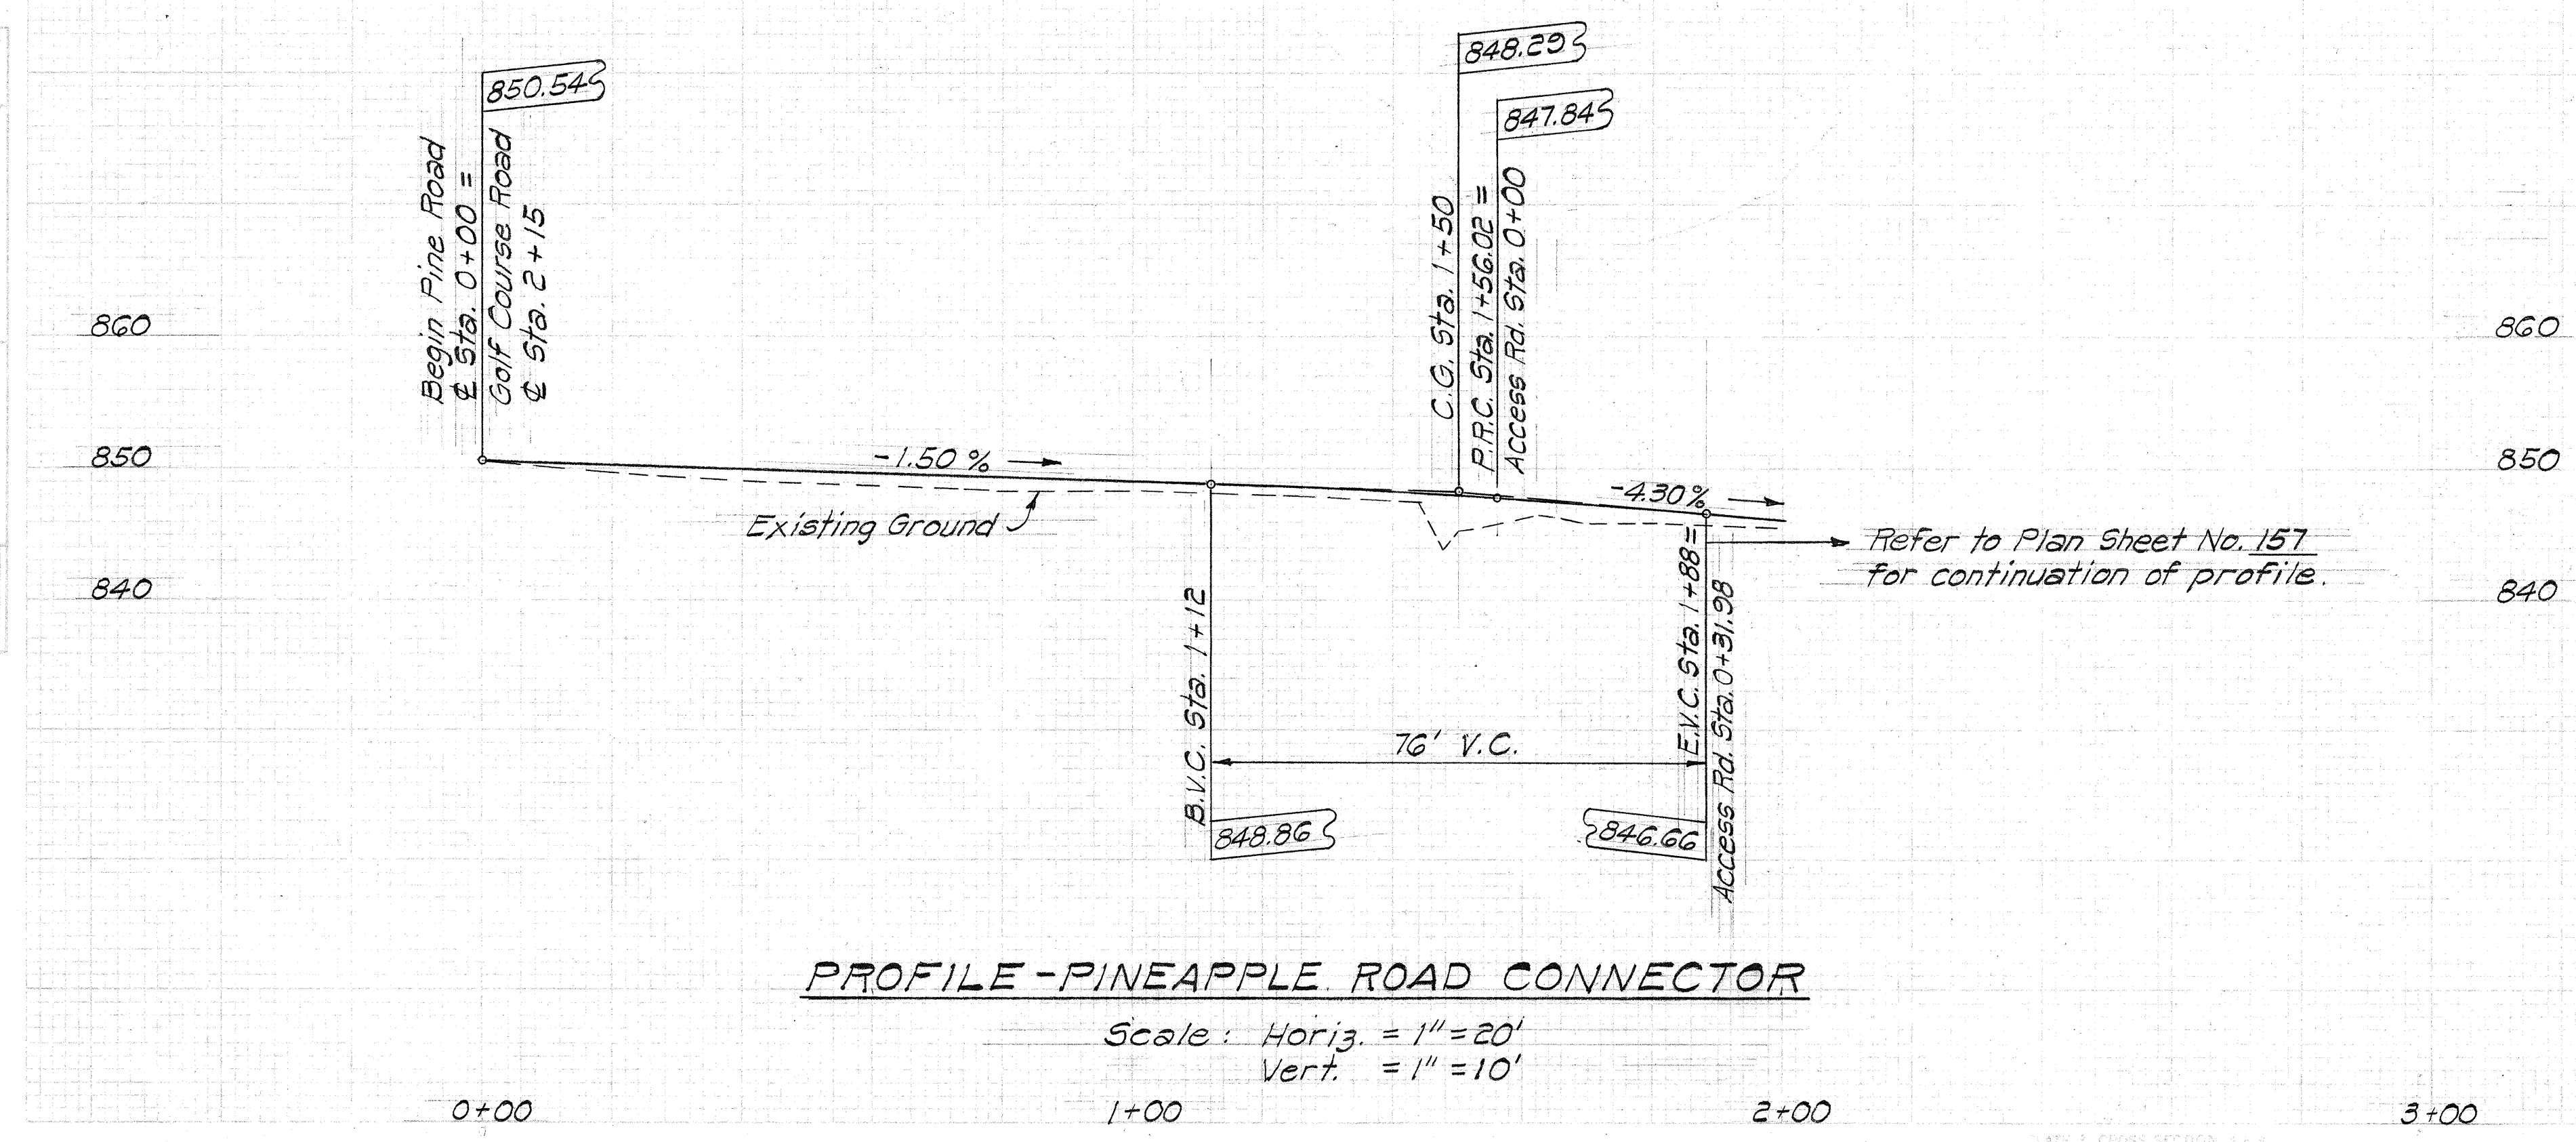

PROFILE - PINEAPPLE ROAD CONNECTOR
 Scale: Horiz. = 1" = 20'
 Vert. = 1" = 10'

STATE OF HAWAII
 DEPARTMENT OF TRANSPORTATION
 HIGHWAYS DIVISION

PROFILES
GOLF COURSE RD. & PINEAPPLE RD. CONNECTOR
 INTERSTATE ROUTE H-2
 LEILEHUA INTERCHANGE
 F.A.I. Proj. No. I-H2-1(8)-6

Scale: As Shown Date: May 1973
 SHEET No. 9 OF 9 SHEETS