




FED. ROAD DIST. NO.	STATE	FED. AID PROJ. NO.	FISCAL YEAR	SHEET NO.	TOTAL SHEETS
HAWAII	HAW.	I-H2-1(8):6	1973	18	160

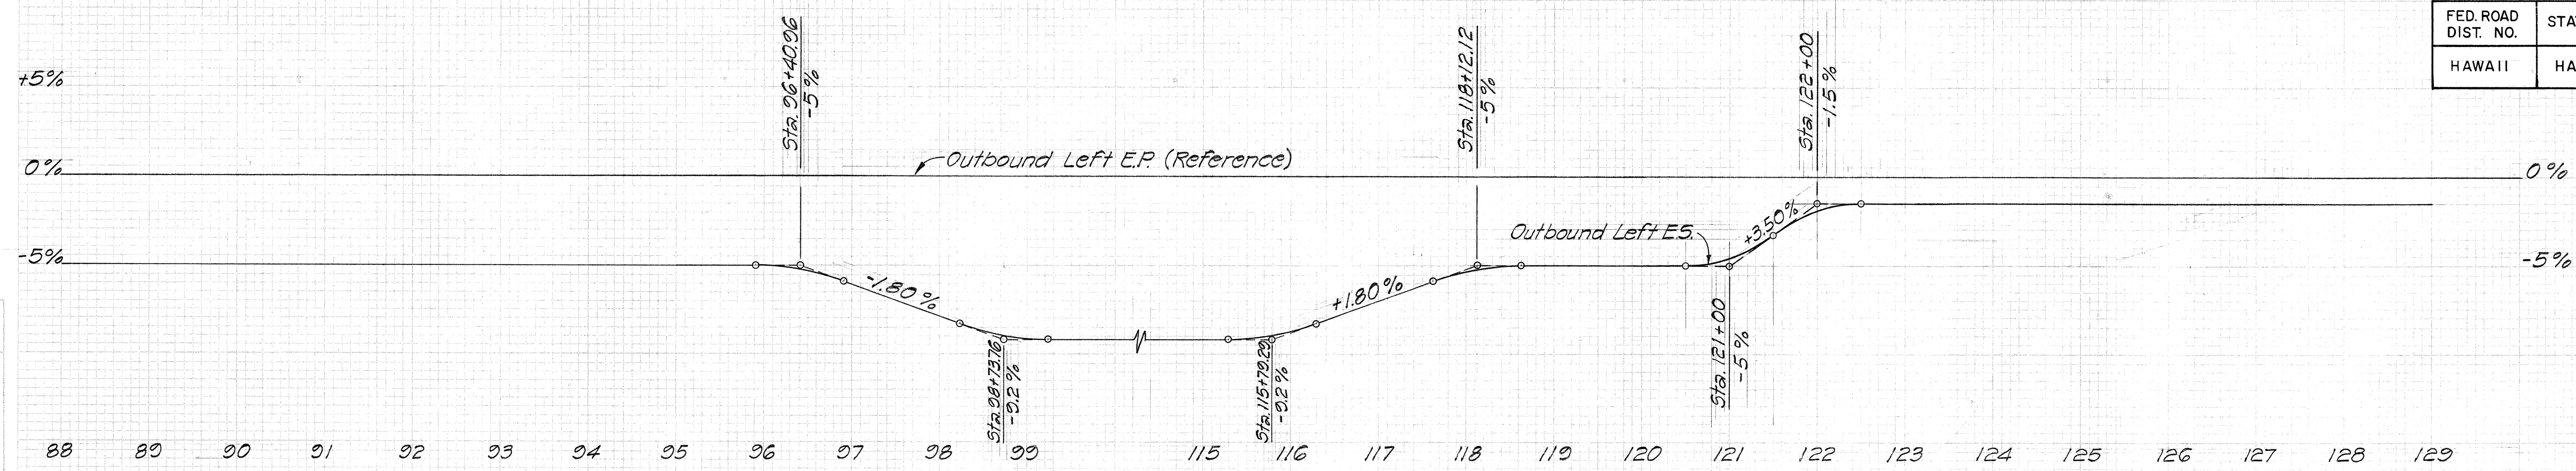

SUPERELEVATION OF OUTBOUND OUTER SHOULDER

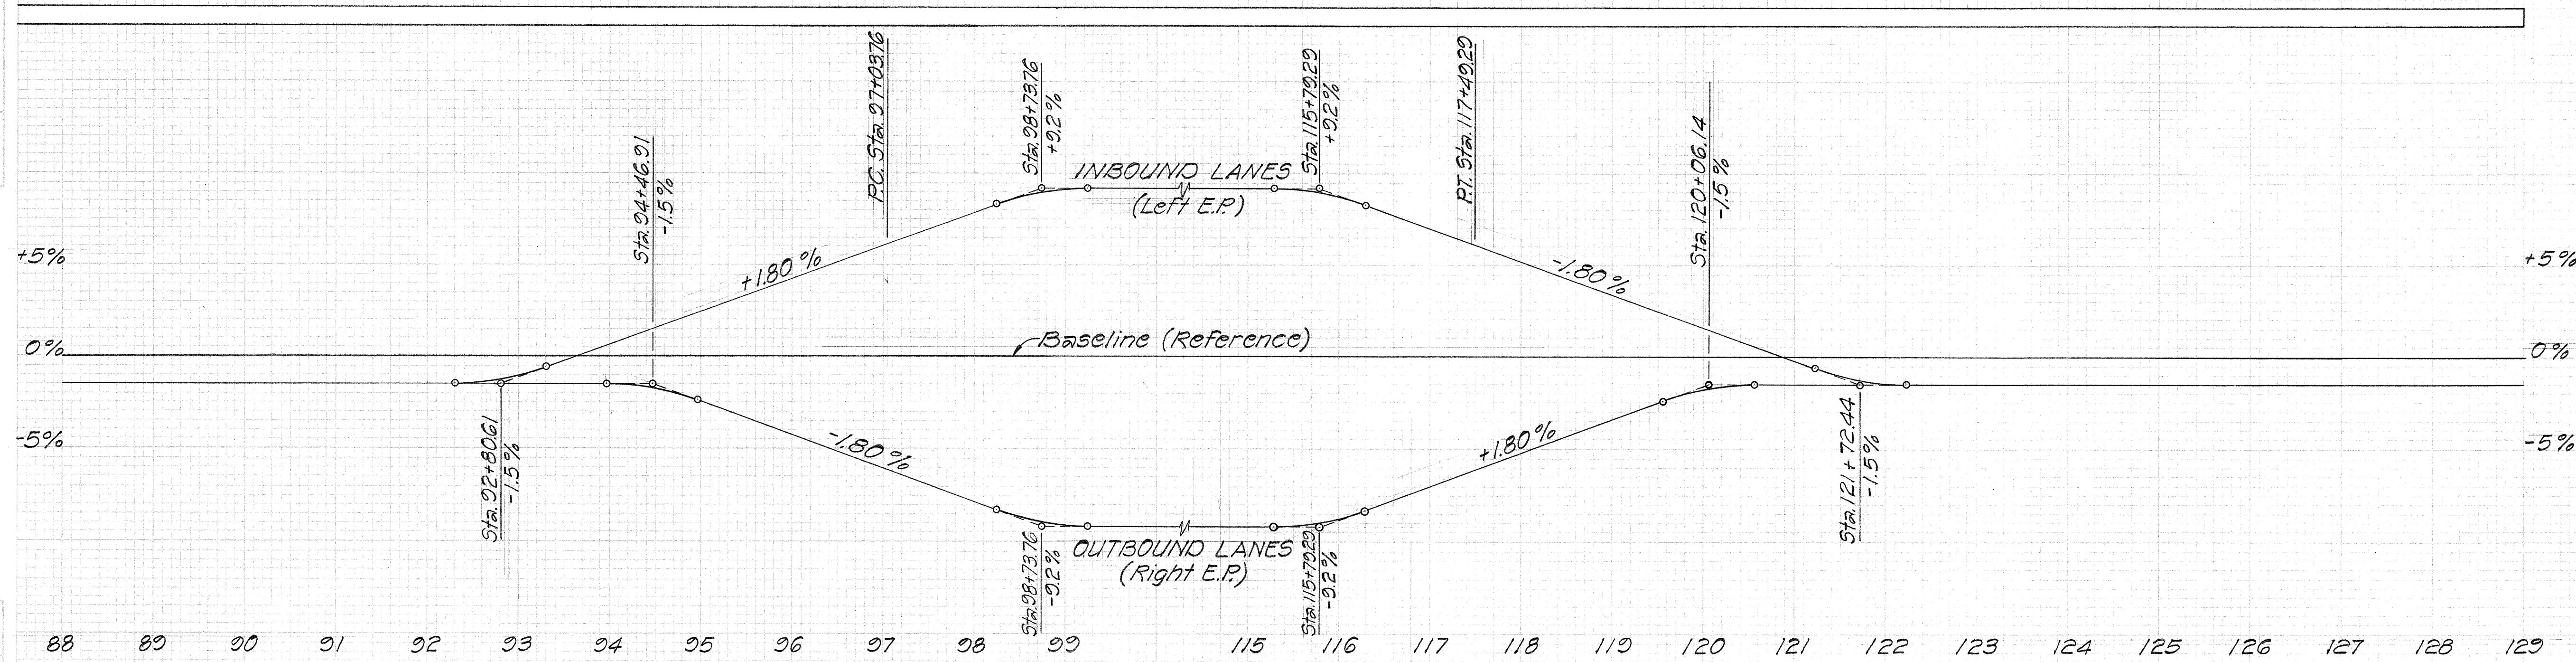

SUPERELEVATION OF OUTBOUND & INBOUND LANES

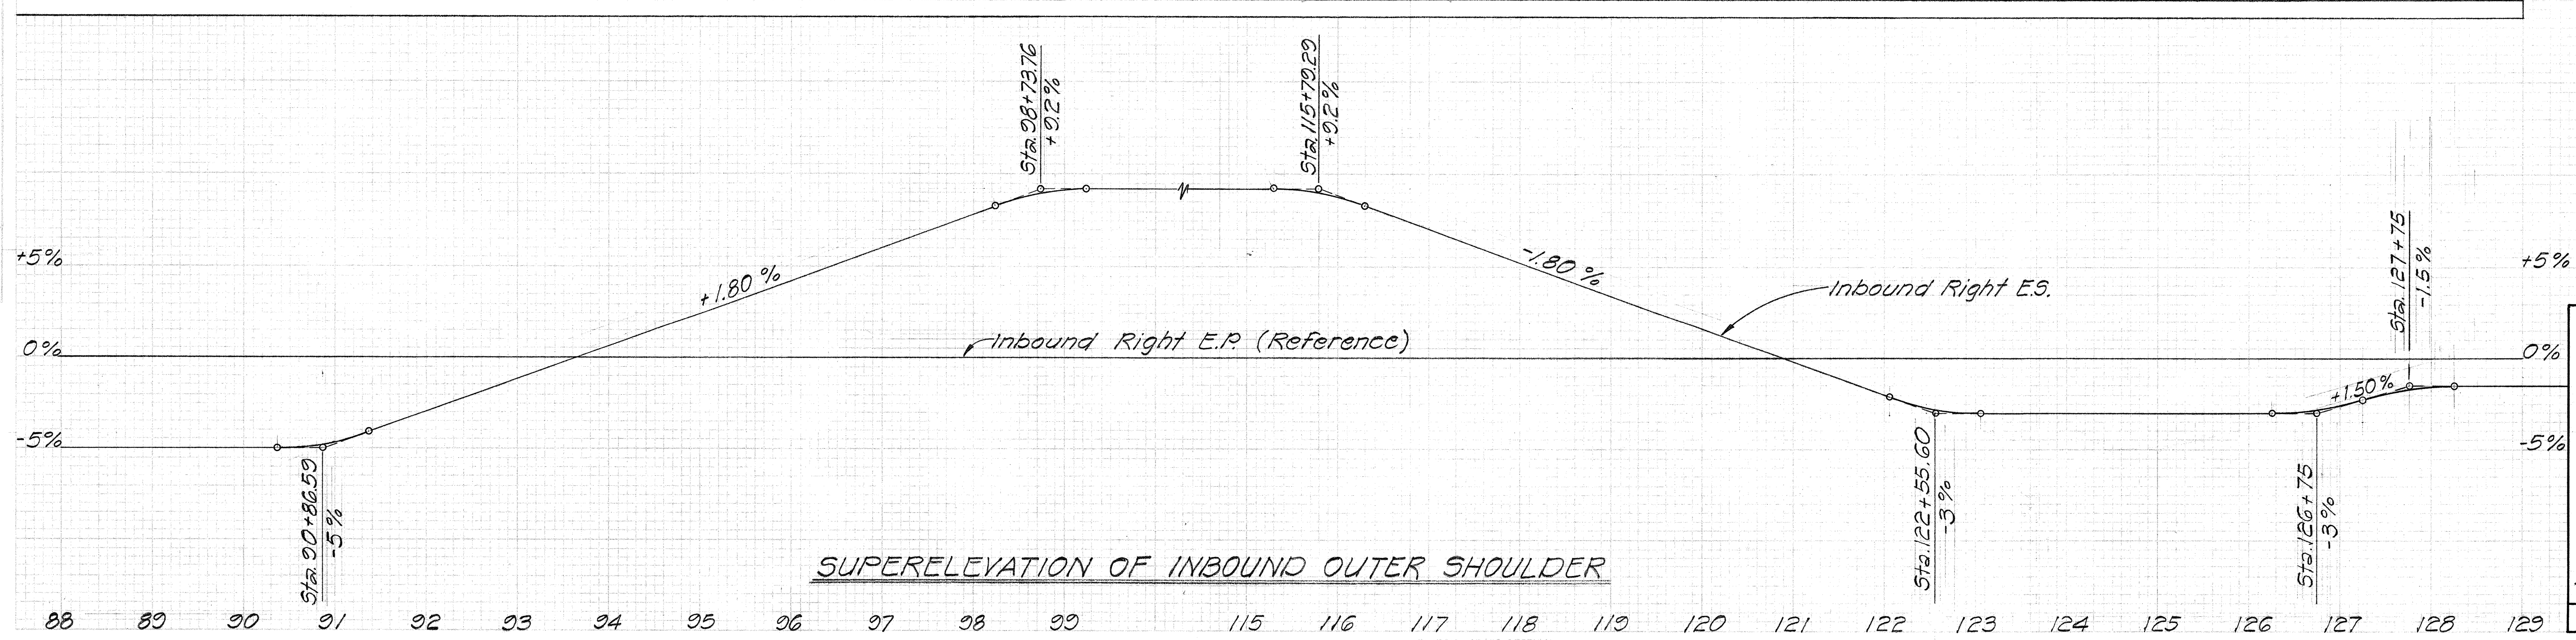

SUPERELEVATION OF INBOUND OUTER SHOULDER

NOTE: All Vertical Curves are 100'.

STATE OF HAWAII
DEPARTMENT OF TRANSPORTATION
HIGHWAYS DIVISION




SUPERELEVATION DIAGRAMS
INTERSTATE ROUTE H-2
LEILEHUA INTERCHANGE
F.A.I. Proj. No. I-H2-1(8):6

Scale: Horiz. 1"=100'
Vert. 1"= 5%

Date: May 1973
SHEET No. 1 OF 2 SHEETS

FED. ROAD DIST. NO.	STATE	FED. AID PROJ. NO.	FISCAL YEAR	SHEET NO.	TOTAL SHEETS
HAWAII	HAW.	I-H2-1(8):6	1973	13	100

ORIGINAL	SURVEYED	DATE
SHEET	NOTED	
NOTE BOOK	AREA	
NO.	CHECKED	

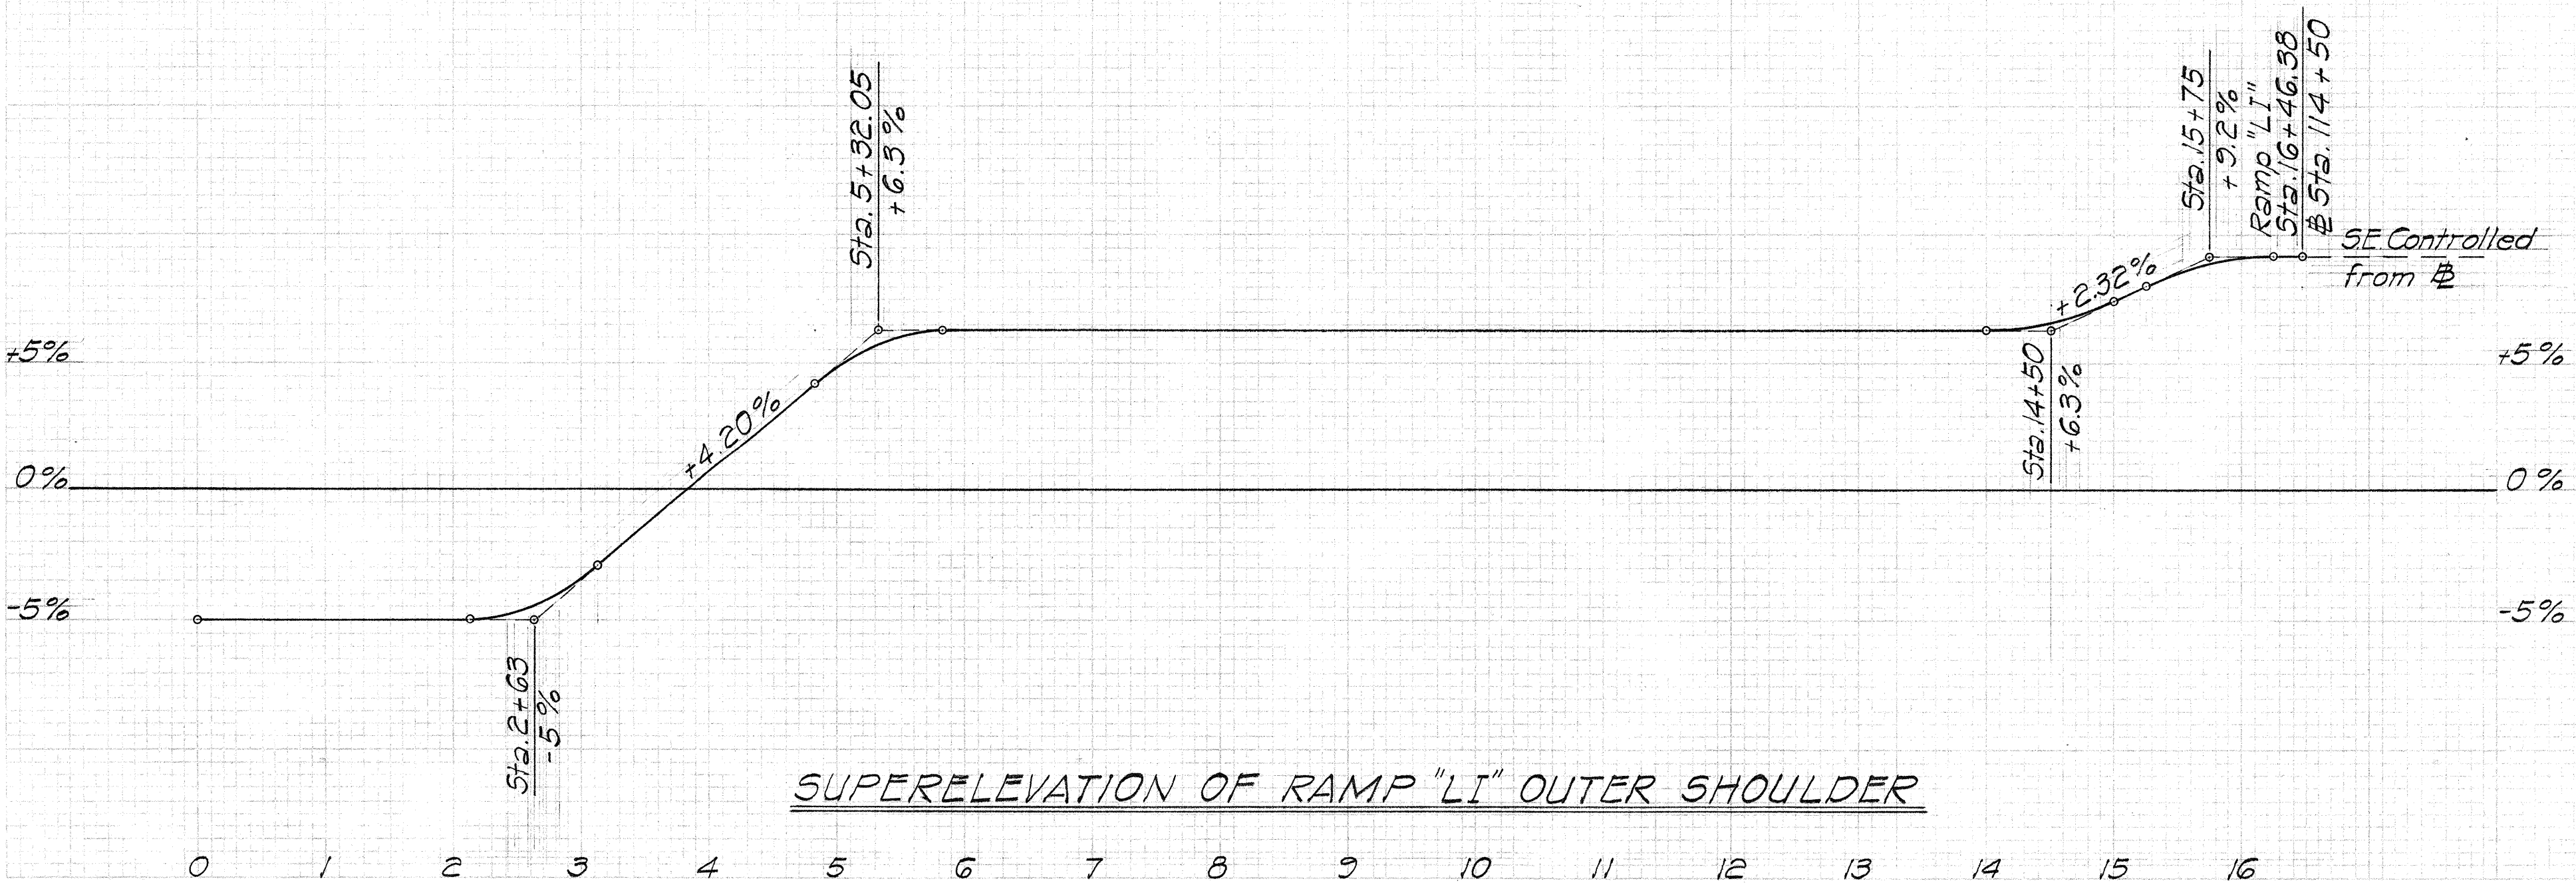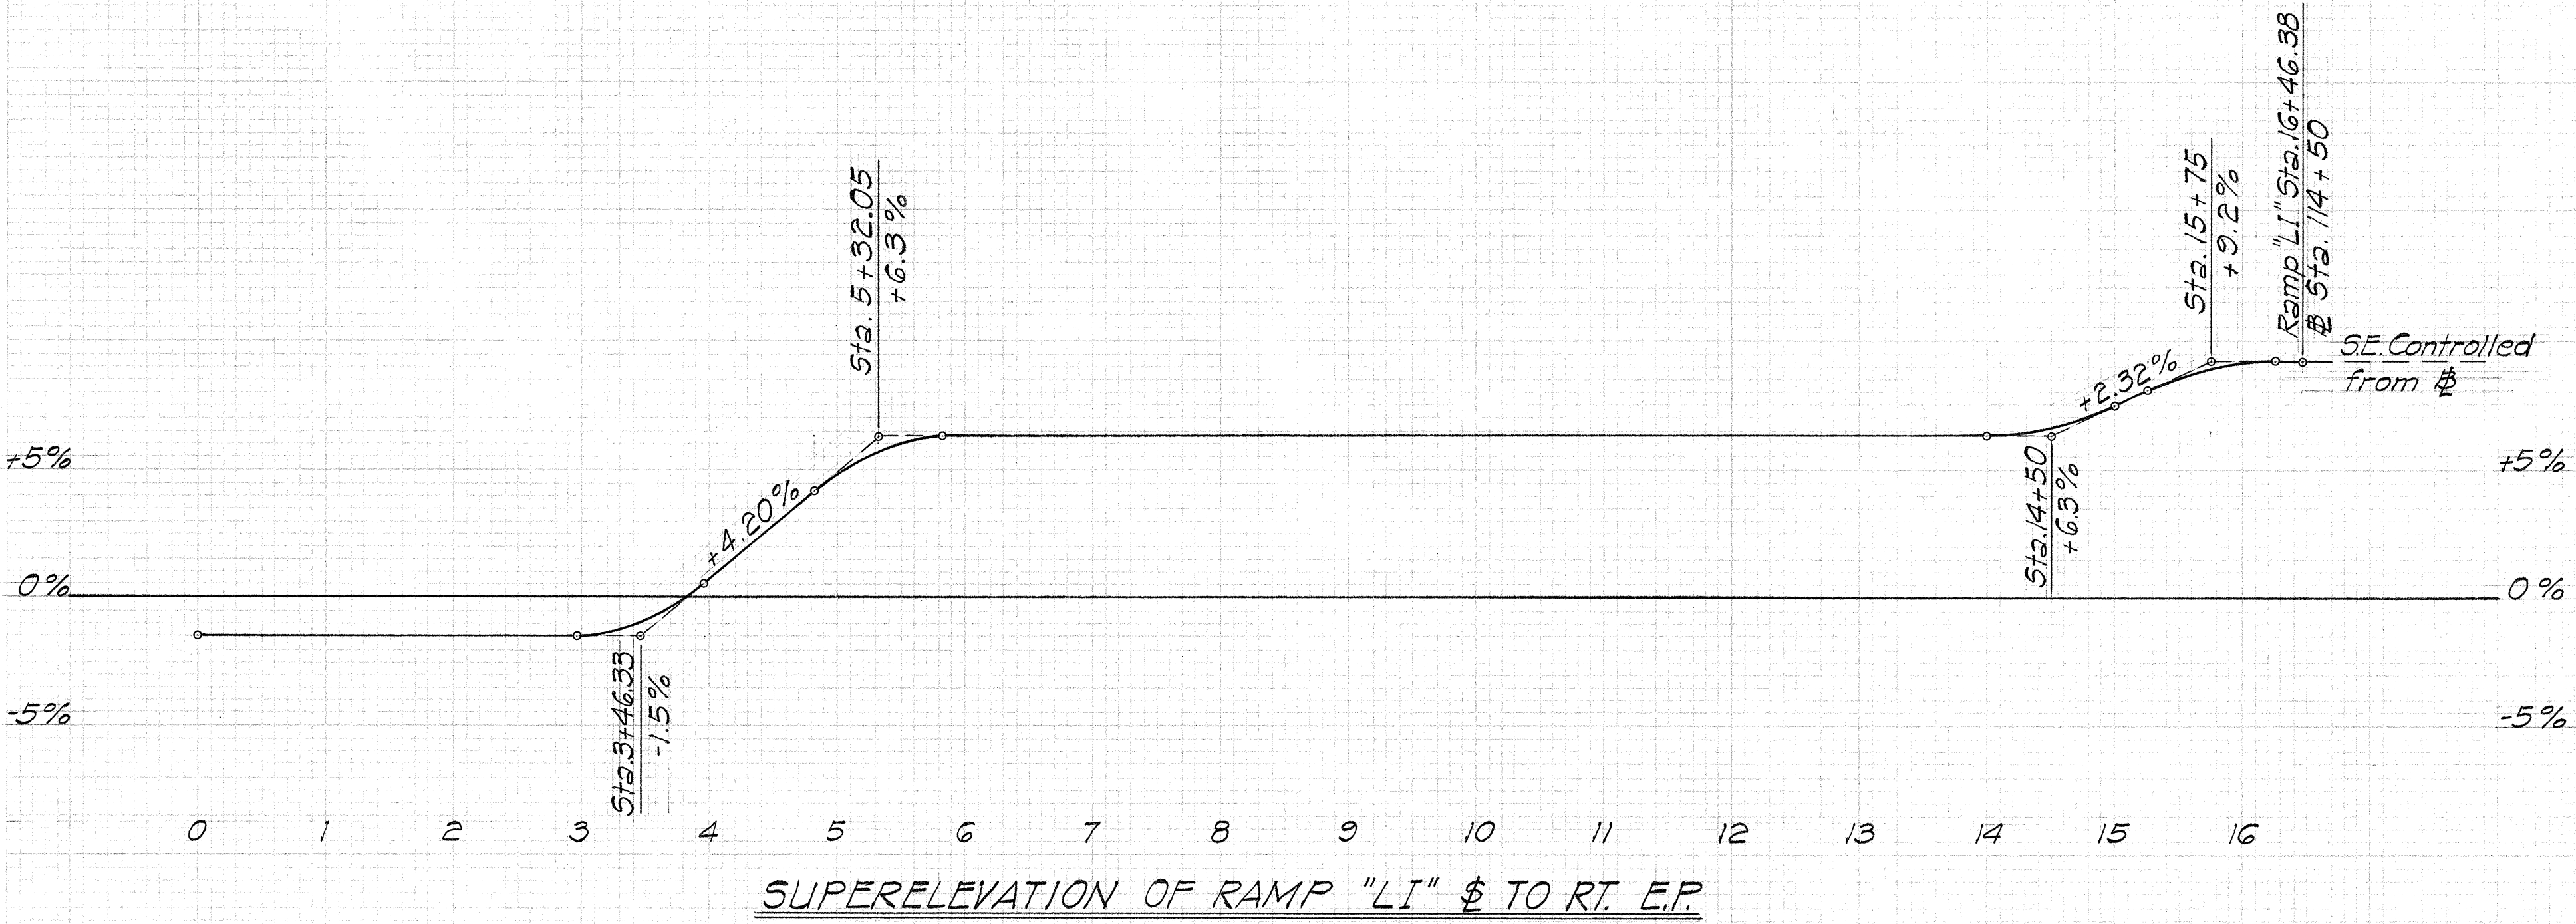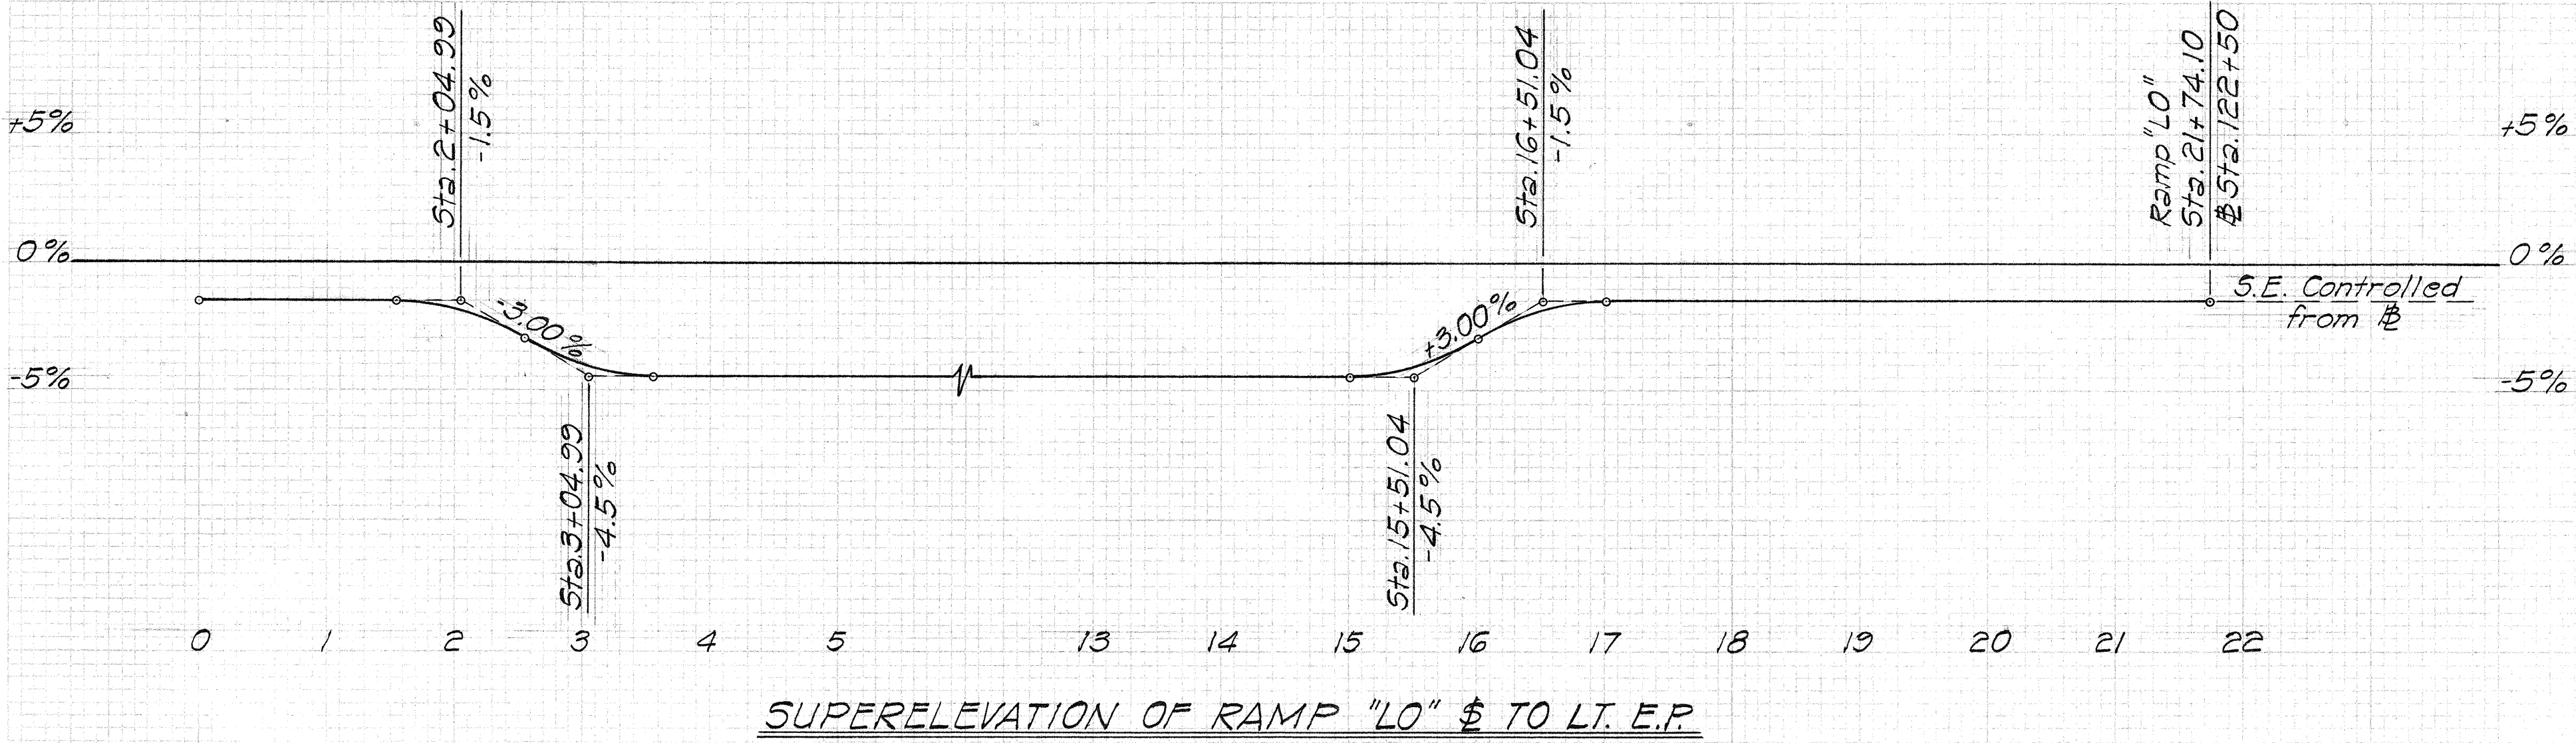

STATE OF HAWAII
DEPARTMENT OF TRANSPORTATION
HIGHWAYS DIVISION

SUPERELEVATION DIAGRAMS

INTERSTATE ROUTE H-2
LEI LEHUA INTERCHANGE
F.A.I. Proj. No. I-H2-1(8):6

Scale: Horiz. 1" = 100'
Vert. 1" = 5% Date: May 1973

SHEET No. 2 OF 2 SHEETS