

INDEX TO DRAWINGS		COMPOSITE SHEET NO.
SHEET NO.	DESCRIPTION	
1	TITLE SHEET	274
2-8	TYPICAL SECTION	275-281
9-17	PLAN & PROFILE	282-290
18-19	SUPER ELEVATION DIAGRAMS	291-292
20	ROADWAY BORING LOGS	293
21-38	DETAIL PLAN OF ROADWAY	294-311
39-43	MISC. ROADWAY PLANS	312-316
44-47	EROSION CONTROL	317-320
48-60	CONSTRUCTION DETOUR & TRAF- FIC SIGNING PLANS & DETAILS	321-333
61-75	MISC. & STANDARD RDWY. DETAILS	334-348
76-86	RIGHT OF WAY CONSTRUCTION	349-359
87-93	UTILITY	360-366
94-119	DRAINAGE PLANS & DETAILS	367-392
120-139	GOLF COURSE ROAD GRADE SEPARATION STRUCTURE	393-412*
140-154	CROSS SECTIONS	413-427
155-160	WAIKAKALAU ACCESS ROAD	428-433
*C040IS-1		

TOTAL SHEET COUNT AFTER "AS-BUILT"
POSTINGS: 161 SHEETS

STATE OF HAWAII

DEPARTMENT OF TRANSPORTATION

HIGHWAYS DIVISION

HONOLULU, HAWAII

"AS BUILT"

PLANS FOR CONSTRUCTION OF

INTERSTATE ROUTE H-2


LEILEHUA INTERCHANGE (PHASE I)

(GOLF COURSE ROAD TO WAIKAKALAU GULCH)

FED. AID INTERSTATE PROJ. NO. I-H2-I(8):6

DISTRICTS OF WAHIAWA AND EWA

ISLAND OF OAHU

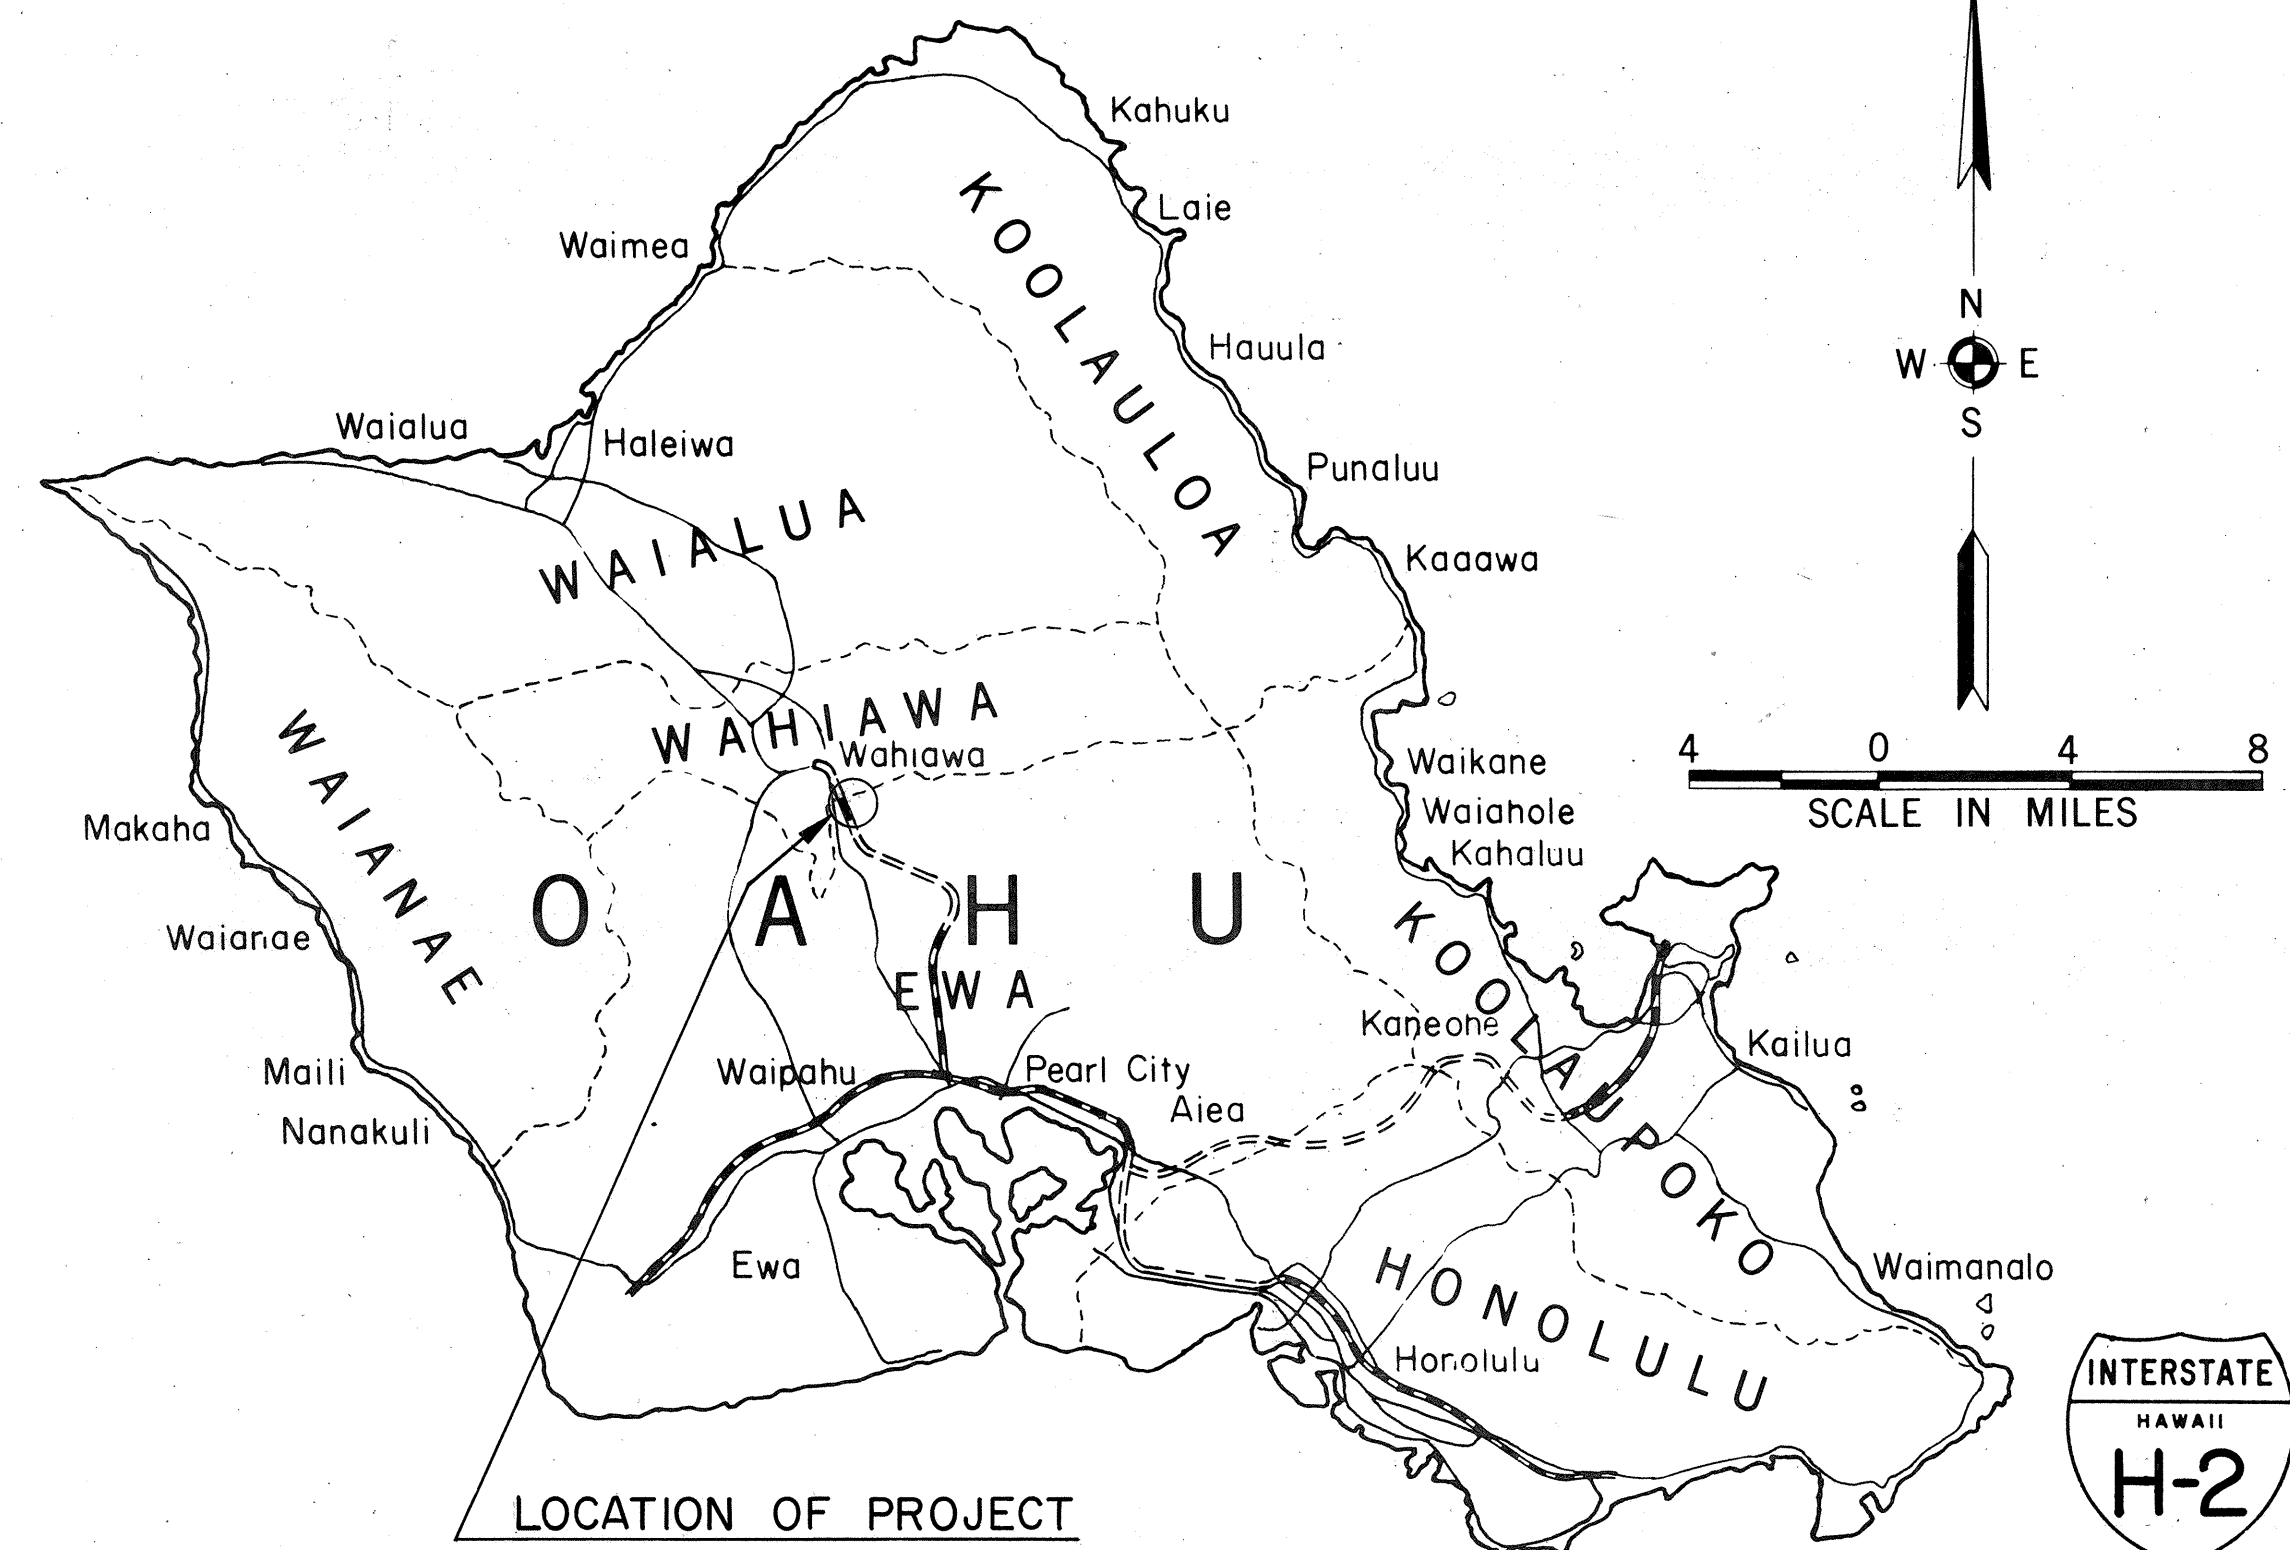


NOTE:
ALL CHANGES MADE DURING CONSTRUCTION
HAVE BEEN INCORPORATED ON THESE PLANS
IN RED EXCEPT CHANGES IN THE ORIGINAL
THEORETICAL QUANTITIES. FOR ACTUAL
QUANTITIES, REFER TO PROJECT LEDGER
AND/OR COMPUTATION BOOK.

David Samashiro
PROJECT ENGINEER
11/3/77
DATE

DESIGN CLASSIFICATION

CURRENT ADT (1973) 0
INTERIM ADT (1977) 20,500
DESIGN ADT (1993) 35,900
DHV 10 %
D 55/45
T₂₄ 1,200
V 70 mph
CONTROL OF ACCESS FULL

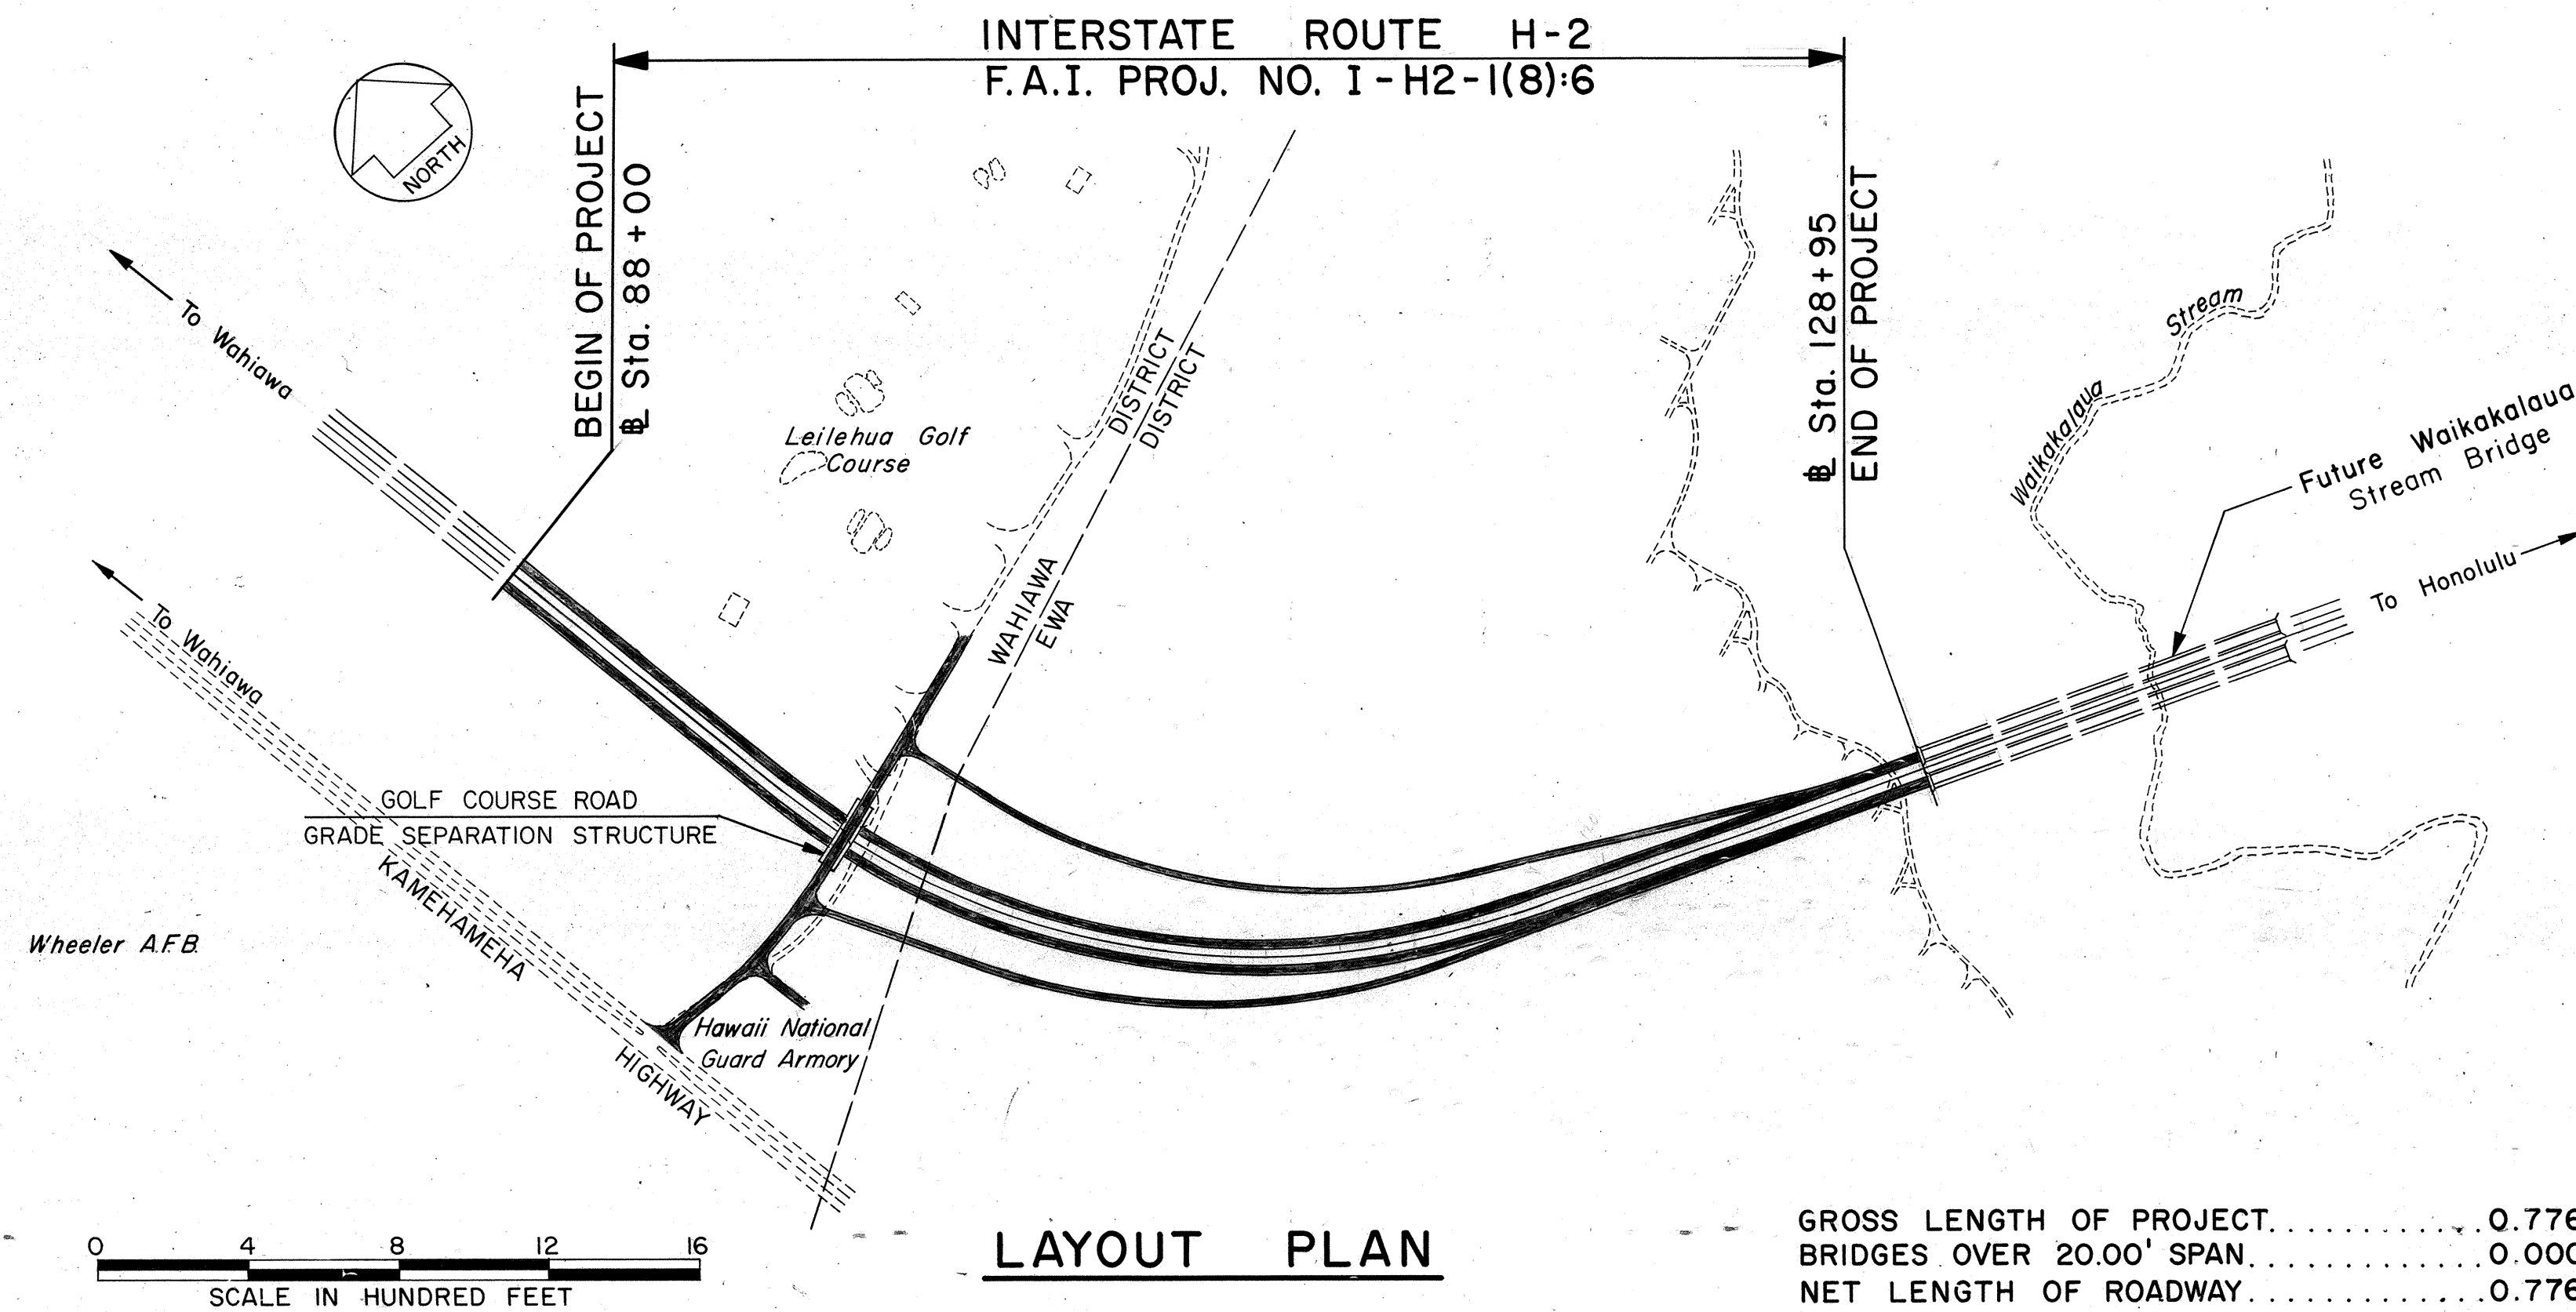

LAYOUT PLAN

GROSS LENGTH OF PROJECT 0.776 MI.
BRIDGES OVER 20.00' SPAN 0.000 MI.
NET LENGTH OF ROADWAY 0.776 MI.

DEPARTMENT OF TRANSPORTATION
FEDERAL HIGHWAY ADMINISTRATION
APPROVED:
[Signature]
DIVISION ENGINEER
5.14.73
DATE

DEPARTMENT OF TRANSPORTATION
STATE OF HAWAII
APPROVED:
[Signature]
FOR DIR. OF TRANSPORTATION
5/9/73
DATE