

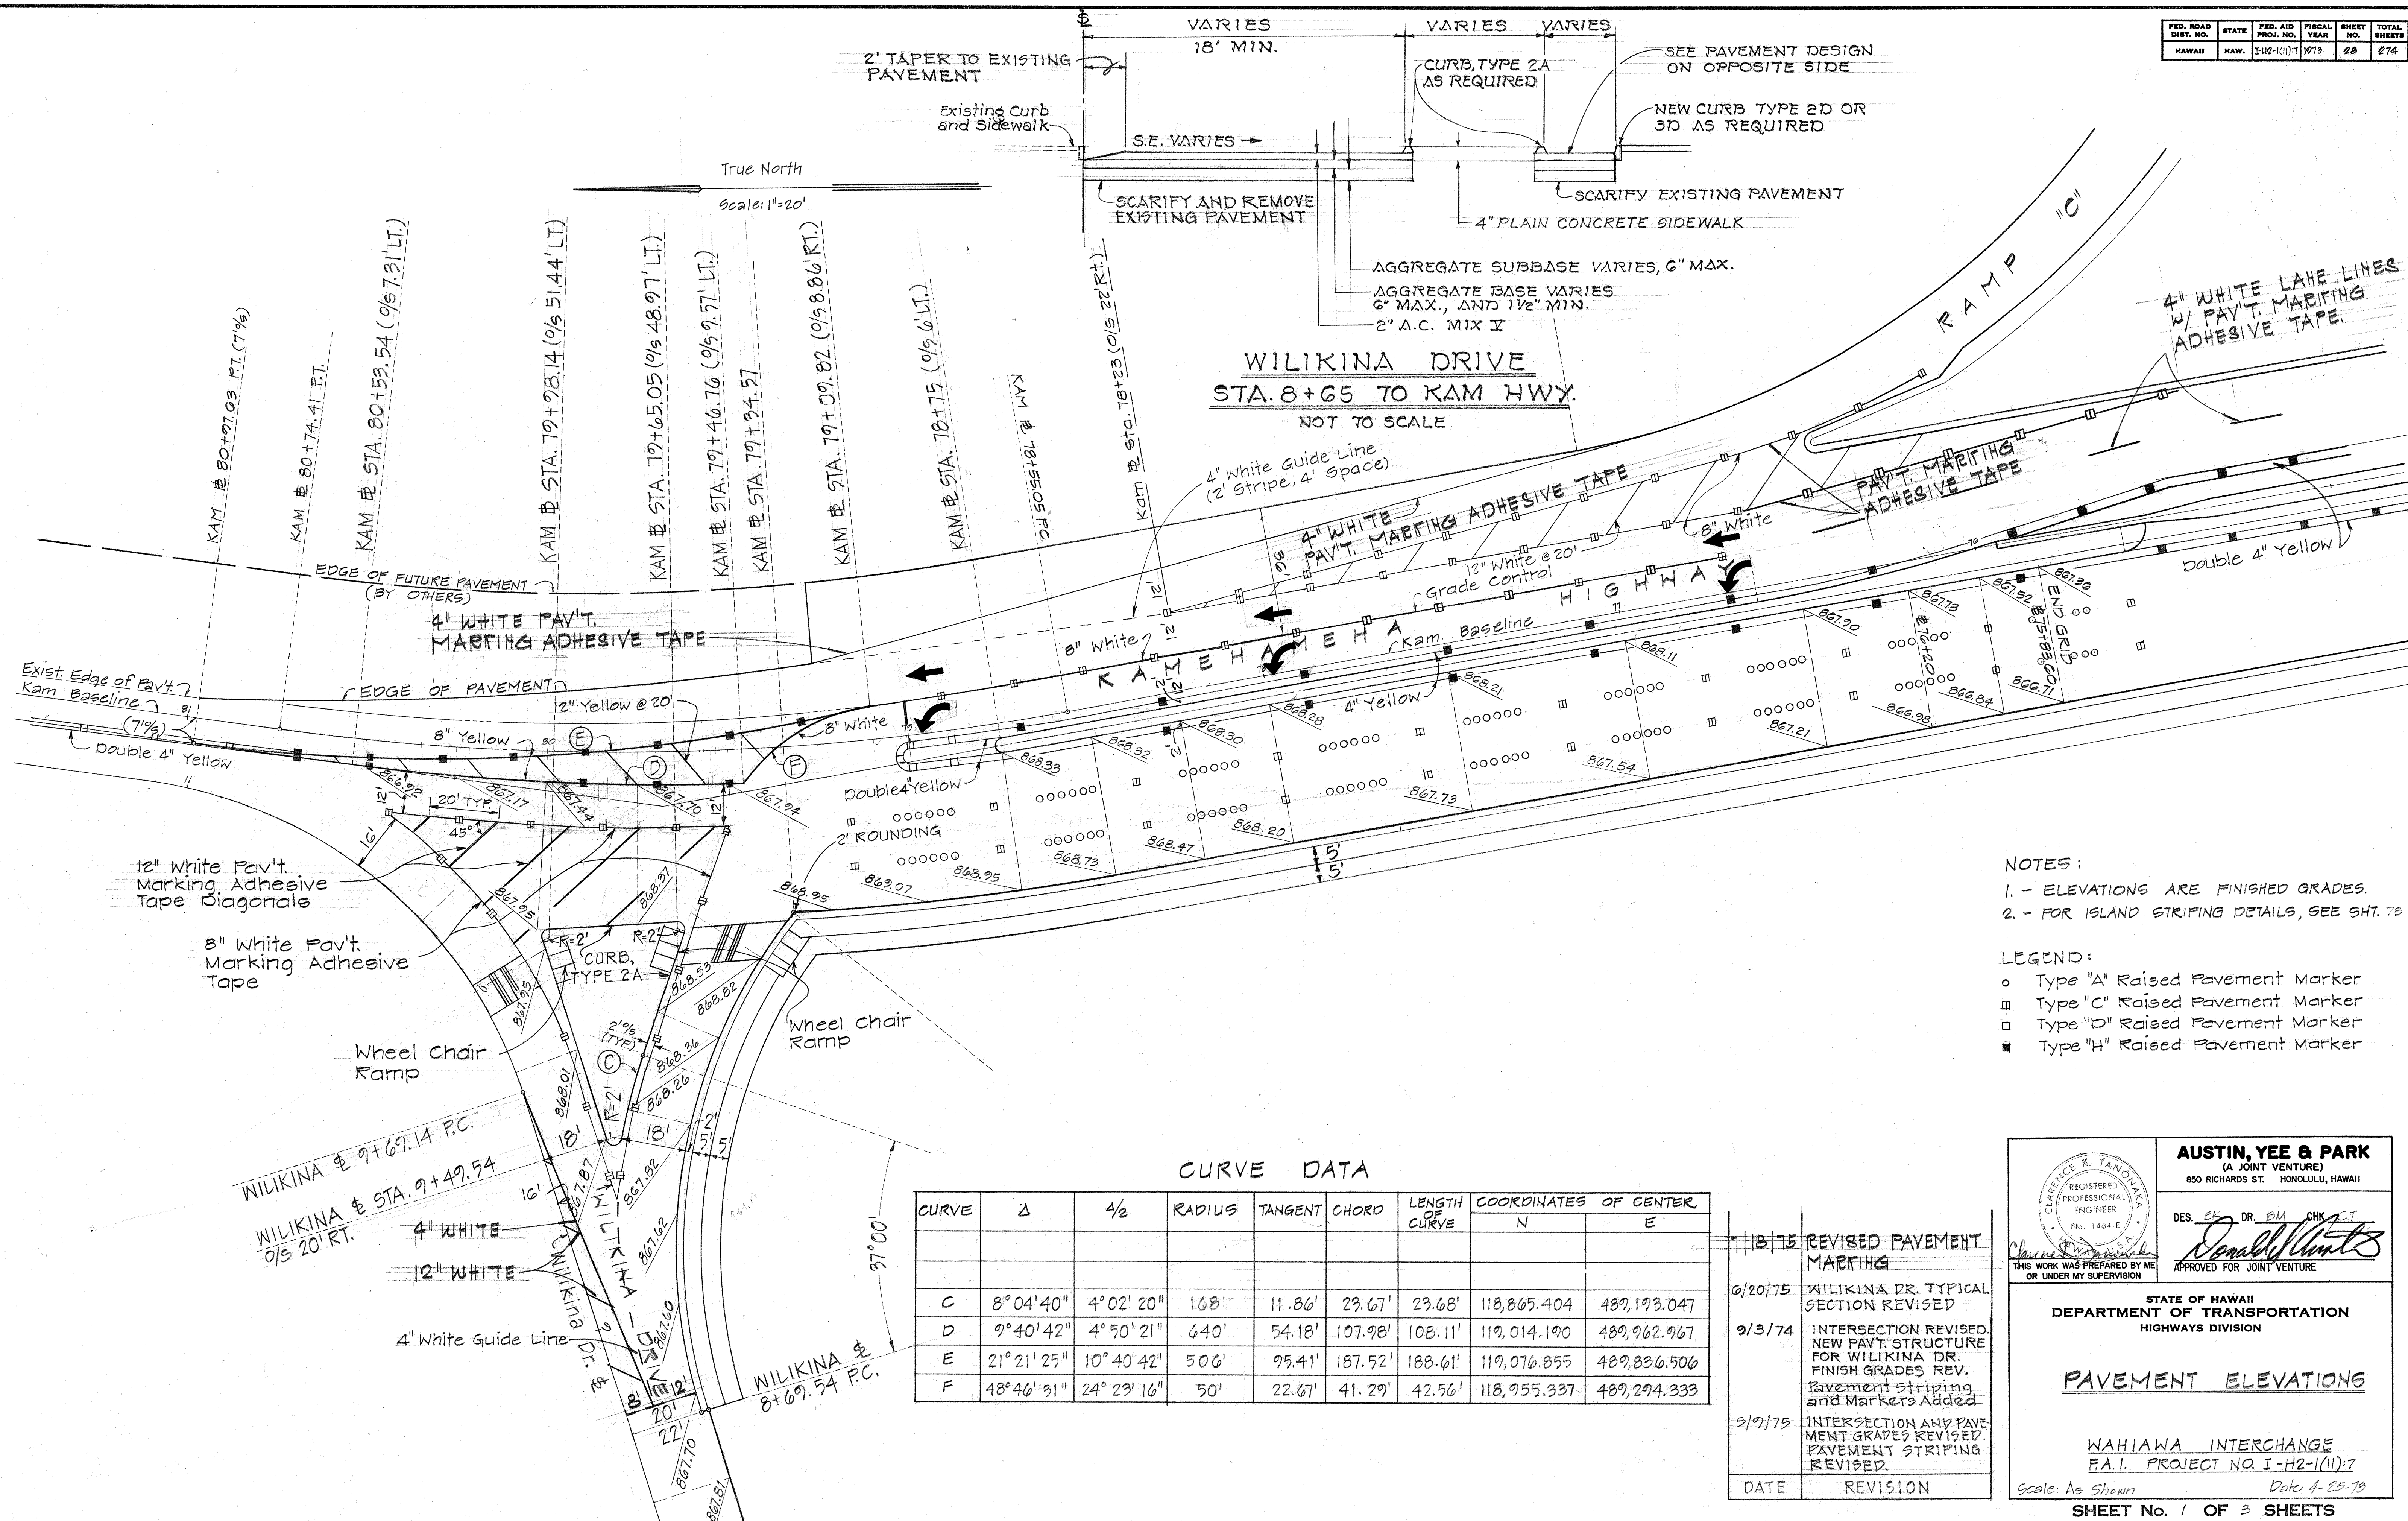


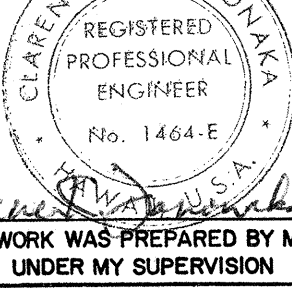

CURVE	Δ	$\frac{1}{2}$	RADIUS	TANGENT	CHORD	LENGTH CURVE	COORDINATES OF CENTER	
							N	E
C	8°04'40"	4°02'20"	168'	11.86'	23.67'	23.68'	118,865.404	489,193.047
D	9°40'42"	4°50'21"	640'	54.18'	107.98'	108.11'	119,014.190	489,962.967
E	21°21'25"	10°40'42"	506'	95.41'	187.52'	188.61'	119,076.855	489,836.506
F	48°46'31"	24°23'16"	50'	22.67'	41.29'	42.56'	118,955.337	489,294.333

	AUSTIN, YEE & PARK (A JOINT VENTURE) 850 RICHARDS ST. HONOLULU, HAWAII DES. <u>EK</u> DR. <u>BM</u> CHK. <u>CT</u> <i>Donald M. Austin</i>
THIS WORK WAS PREPARED BY ME OR UNDER MY SUPERVISION	
STATE OF HAWAII DEPARTMENT OF TRANSPORTATION HIGHWAYS DIVISION <u>PAVEMENT ELEVATIONS</u> <u>WAHIAWA INTERCHANGE</u> <u>F.A.I. PROJECT NO. I-H2-1(11):7</u> Scale: As Shown Date: 4-25-79	
SHEET No. 1 OF 3 SHEETS	

ORIGINAL PLAN	SURVEY PLOTTED BY.....		DATE.....
	DRAWN BY.....	TRACED BY.....	"
NOTE BOOK	DESIGNED BY.....	"	"
	QUANTITIES BY.....	"	"
	CHECKED BY.....	"	"
No.			

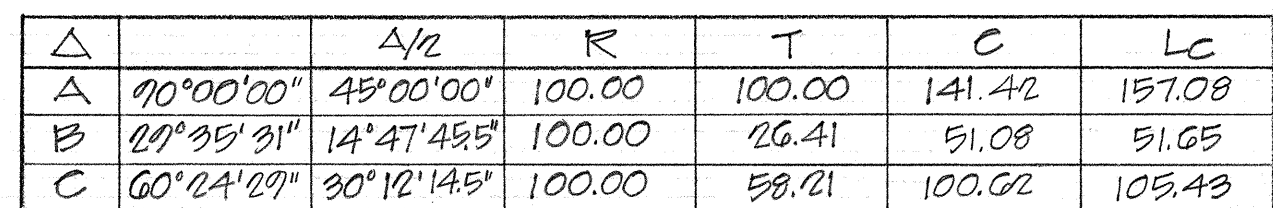

A hand-drawn plan view of a highway interchange. At the top, a line points to the right with the text "TRUE NORTH". Below this, the word "NORTHBOUND" is written in large, bold, capital letters. The main horizontal line represents Interstate 90, with stationing markers at 81, 82, and 83. On the left side of this line, stationing is marked at 100, 90, and 80. On the right side, stationing is marked at 100 and 90. A vertical line crosses Interstate 90 at station 82, with a right-pointing arrow indicating the direction of travel. To the right of this vertical line, the word "SOUTHBOUND" is written in large, bold, capital letters. Below the main horizontal line, a diagonal line represents Ramp "D", with a right-pointing arrow indicating the direction of travel. The ramp is labeled "RAMP 'D'" and has stationing markers at 84, 83, 82, 1, 0. The ramp is labeled "GUTTER TYPE 7 (G1G14)". At the bottom, the text "INTERSTATE 90 RAMP 'D'" is written in large, bold, capital letters. Below this, the scale "SCALE: 1" = 20'" is written.

PRINTED ON NO. 1000H CLEARPRINT

