

Revised: June 13, 1973





TRUE NORTH
SCALE: 1"=50.0'

BEGINNING OF
PROJECT NO. 1-H-2-1(11):7
BASELINE S.A. 42+20
P.C. 0+00
P.T. 0+40

SYMBOL						PLANT TYPE						EXISTING						RELOCATED						HEIGHT OF TREE						CALIPER OF TRUNK					
RELOCATION & EXIST'G TREE LIST																																			
AA	4	30	18"	SILVER OAK / GREVILLEA ROBUSTA																															
AB	4	30	18"	"																															
AC	4	40	30"	"																															
AD	4	25	26"	AFRICAN TULIP / SPATHODEA CAMPANULATA																															
AE	4	25	26"	SHOWER																															
AF	4	40	32"	SHOWER																															
AG	4	20	22"	MONKEYPOD / SAMANEA SAMAN																															
AH	4	25	24"	AFRICAN TULIP / SPATHODEA CAMPANULATA																															
AI	4	25	27"	"																															
AJ	4	15	18"	"																															
AK	4	8"	5"	"																															
AL	4	5"	5"	"																															
AM	4	30	19"	SILVER OAK / GREVILLEA ROBUSTA																															
AN	4	30	19"	"																															
AO	4	30	19"	"																															
AP	4	20	15"	MONKEYPOD / SAMANEA SAMAN																															
AQ	4	30	22"	SILVER OAK / GREVILLEA ROBUSTA																															
AR	4	24	20"	SIAMESE SHOWER / CASSIA SIAMEA																															
AS	4	20	20"	"																															
AT	4	20	26"	AFRICAN TULIP / SPATHODEA CAMPANULATA																															
AU	4	25	36"	BENJAMIN BANYAN / FICUS BENJAMINA																															
AV	4	20	12"	MAHOGANY / SWIETENIA MAHAGONI																															
AW	4	20	27"	BANYAN (CHINESE) / FICUS RETUSA																															
AX	4	20	27"	BANYAN																															
AY	4	20	12"	RUBBER BANYAN / FICUS ELASTICA																															
AZ	4	35	40"	"																															
BA	4	35	38"	"																															
BB	4	30	18"	MONKEYPOD / SAMANEA SAMAN																															
BC	4	30	18"	KUKUI / ALEURITES MOLUCCANA																															
BD	4	30	20"	MONKEYPOD / SAMANEA SAMAN																															
BE	4	30	20"	ALBIZZIA																															
BF	4	30	20"	"																															
CG	4	30	20"	"																															
GV																																			


COMPLETE PLANT LIST			
SYMBOLS	QUANTITY	COMMON AND BOTANIC NAME	SIZE AND SPACING
	46	JACARANDA / JACARANDA ACUTIFOLIA	25 G.C. 12' HT. 5' SPD 3' CAL.
	52	BAUHINIA / BAUHINIA BLAKEANA	25" 8' 4' 2'
	26	MAHOGANY / SWietenia MAHAGONI	25" 12' 5' 3'
	31	AZALEA / FRAXINUS UHDEI	25" 12' 5' 3'
	58	TRIPLARIS / TRIPLARIS AMERICANA	10" 7' 2' 1 1/2'
	85	RAINFOREST SHRUB / CASSIA JAVANICA x C. FISTULA	25" 10' 4' 2'
	62	KOEBERLINIA / KOEBERLINIA PANICULATA	25" 8' 4' 2'
	46	PINETOPIA / TABERBERGIA PENTAPHYLLA	25" 8' 4' 2'
	16	YELLOW TECOMA / TABERBERGIA ARGENTIA	25" 8' 4' 2'
	129	BOTTLEBRUSH / CALLISTEMON CITRINUS	25" 8' 4' 2'
	82	KULUHI / ALEURITES MOLUCCANA	25" 10' 4' 2'
	2188	BUTTERFLY HIBISCUS / HIBISCUS SCHIZOPETALLUS	5 G.C. 2' 6" HT. @ 3' OC.
	959	OLEANDER / NEROLIUM OLEANDER (SALMON)	5 G.C. 2' 6" HT. @ 3' OC.
	69150	WEDELIA / WEDELIA TRILOBATA	CUTTINGS @ 12" OC. 10' RUNNERS
	330	CREEPING FIG / FIGUS FUMIDA	1 QT. CAN @ 2' OC. 10' RUNNERS
	765445	HONAN GRASS / EREMOCHLOA OPHIURIDES	SPRIGS @ 8' OC.

PLANT LIST			
SYMBOLS	QUANTITY	COMMON & BOTANICAL NAME	SIZE AND SPACING
	69,150 #	WEDELIA / WEDELIA TRILOBATA	CUTTINGS @ 12" OC. 10' RUNNERS
	765,445 #	HONAN GRASS / EREMOCHLOA OPHIURIDES	SPRIGS @ 8' OC.

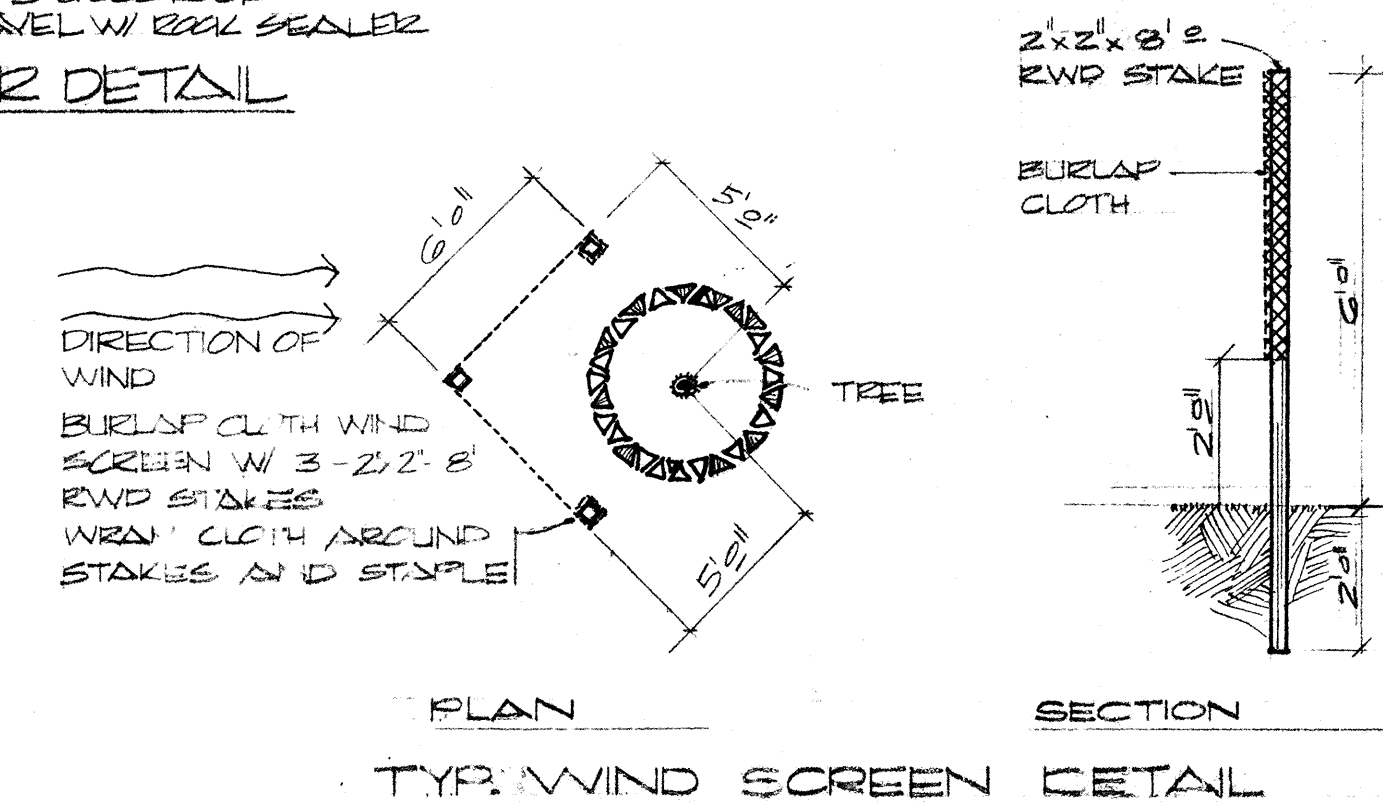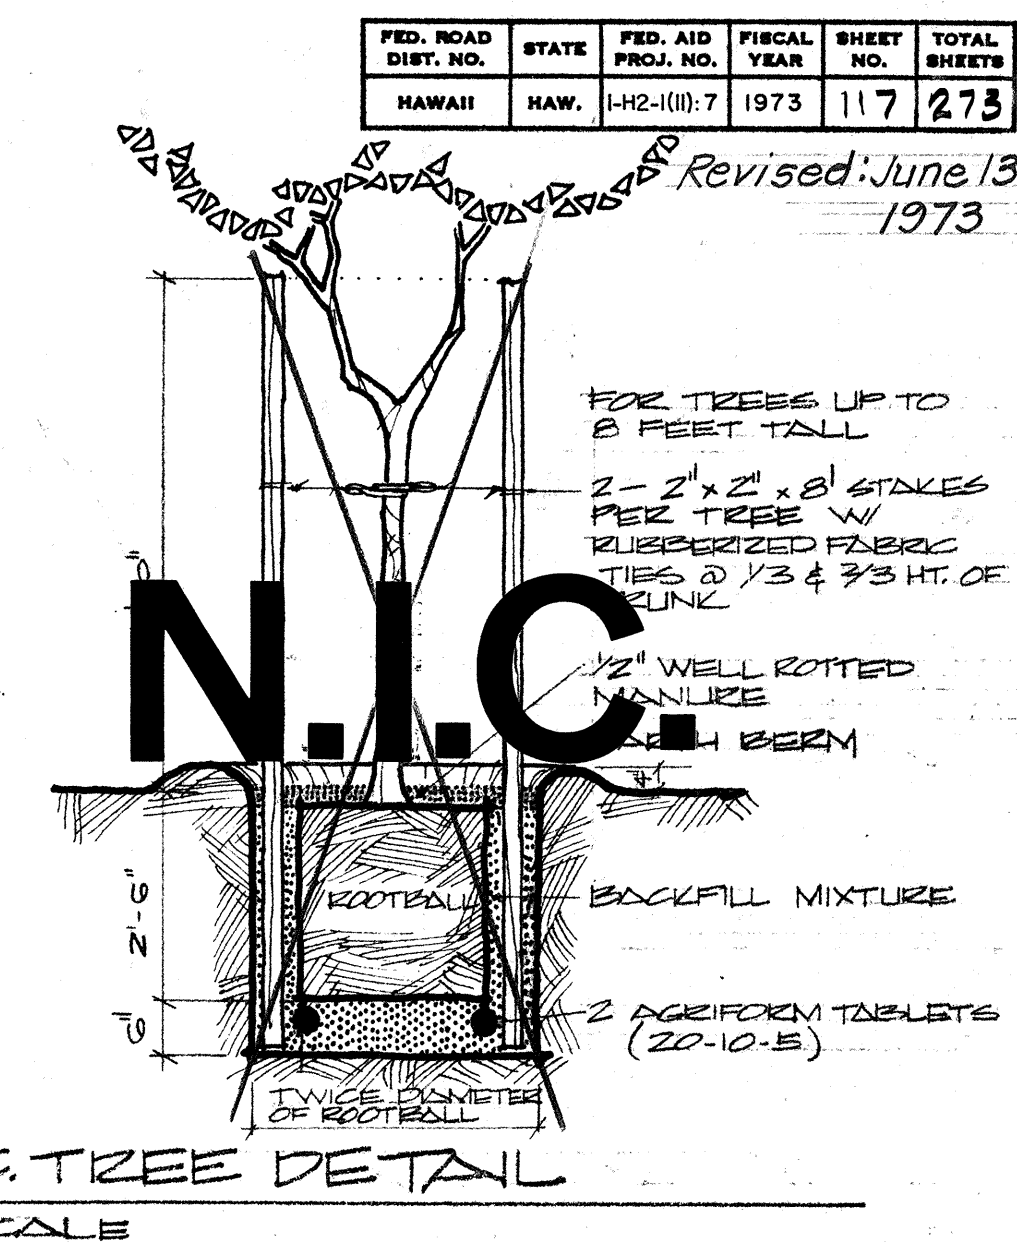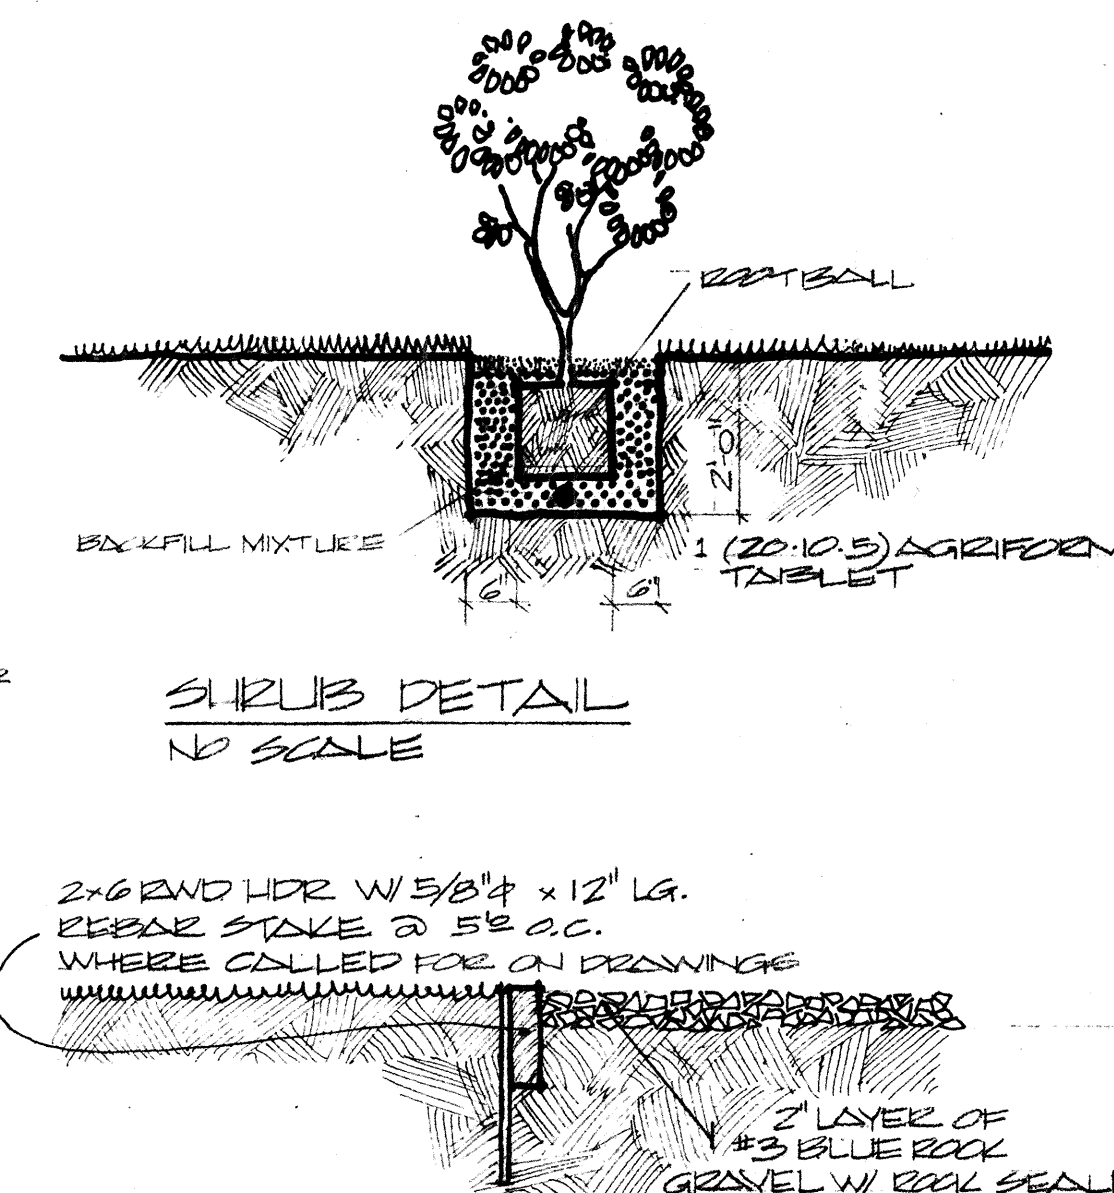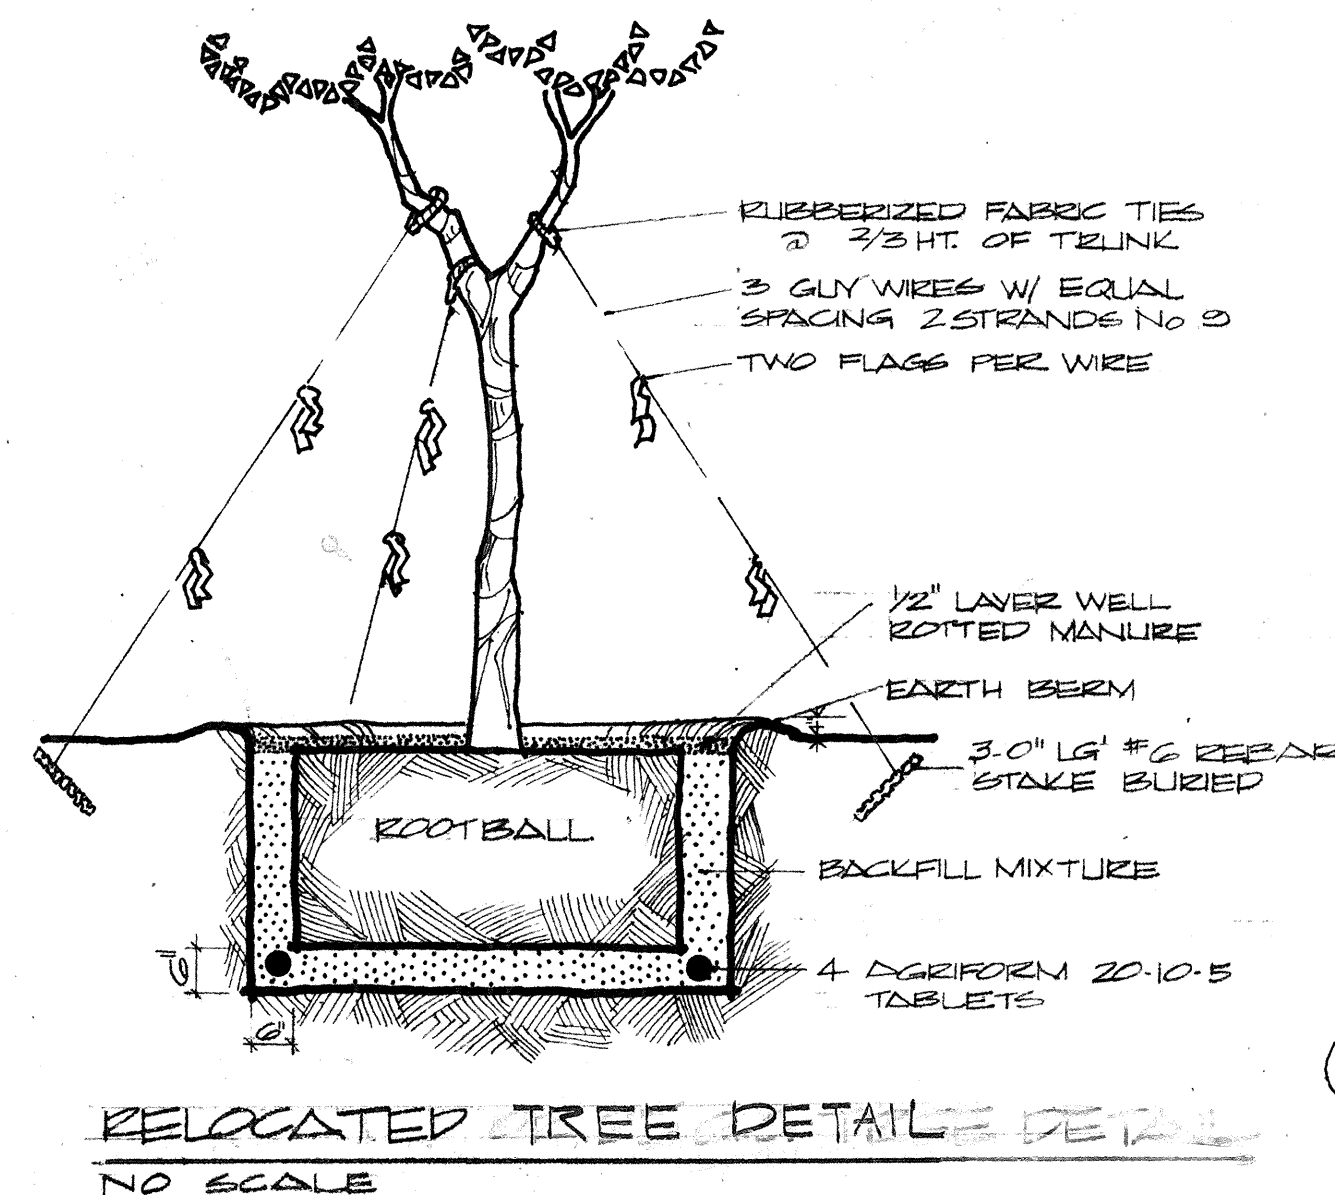

PLANS FOR RELOCATION OF EXISTING TREES & PLANTING HONAN GRASS & WEDELIA.

NOTE:
1. PRIOR TO EXCAVATION ALL TREE PLANTING LOCATIONS SHALL BE STAKED-OUT BY THE CONTRACTOR FOR APPROVAL BY THE ENGINEER

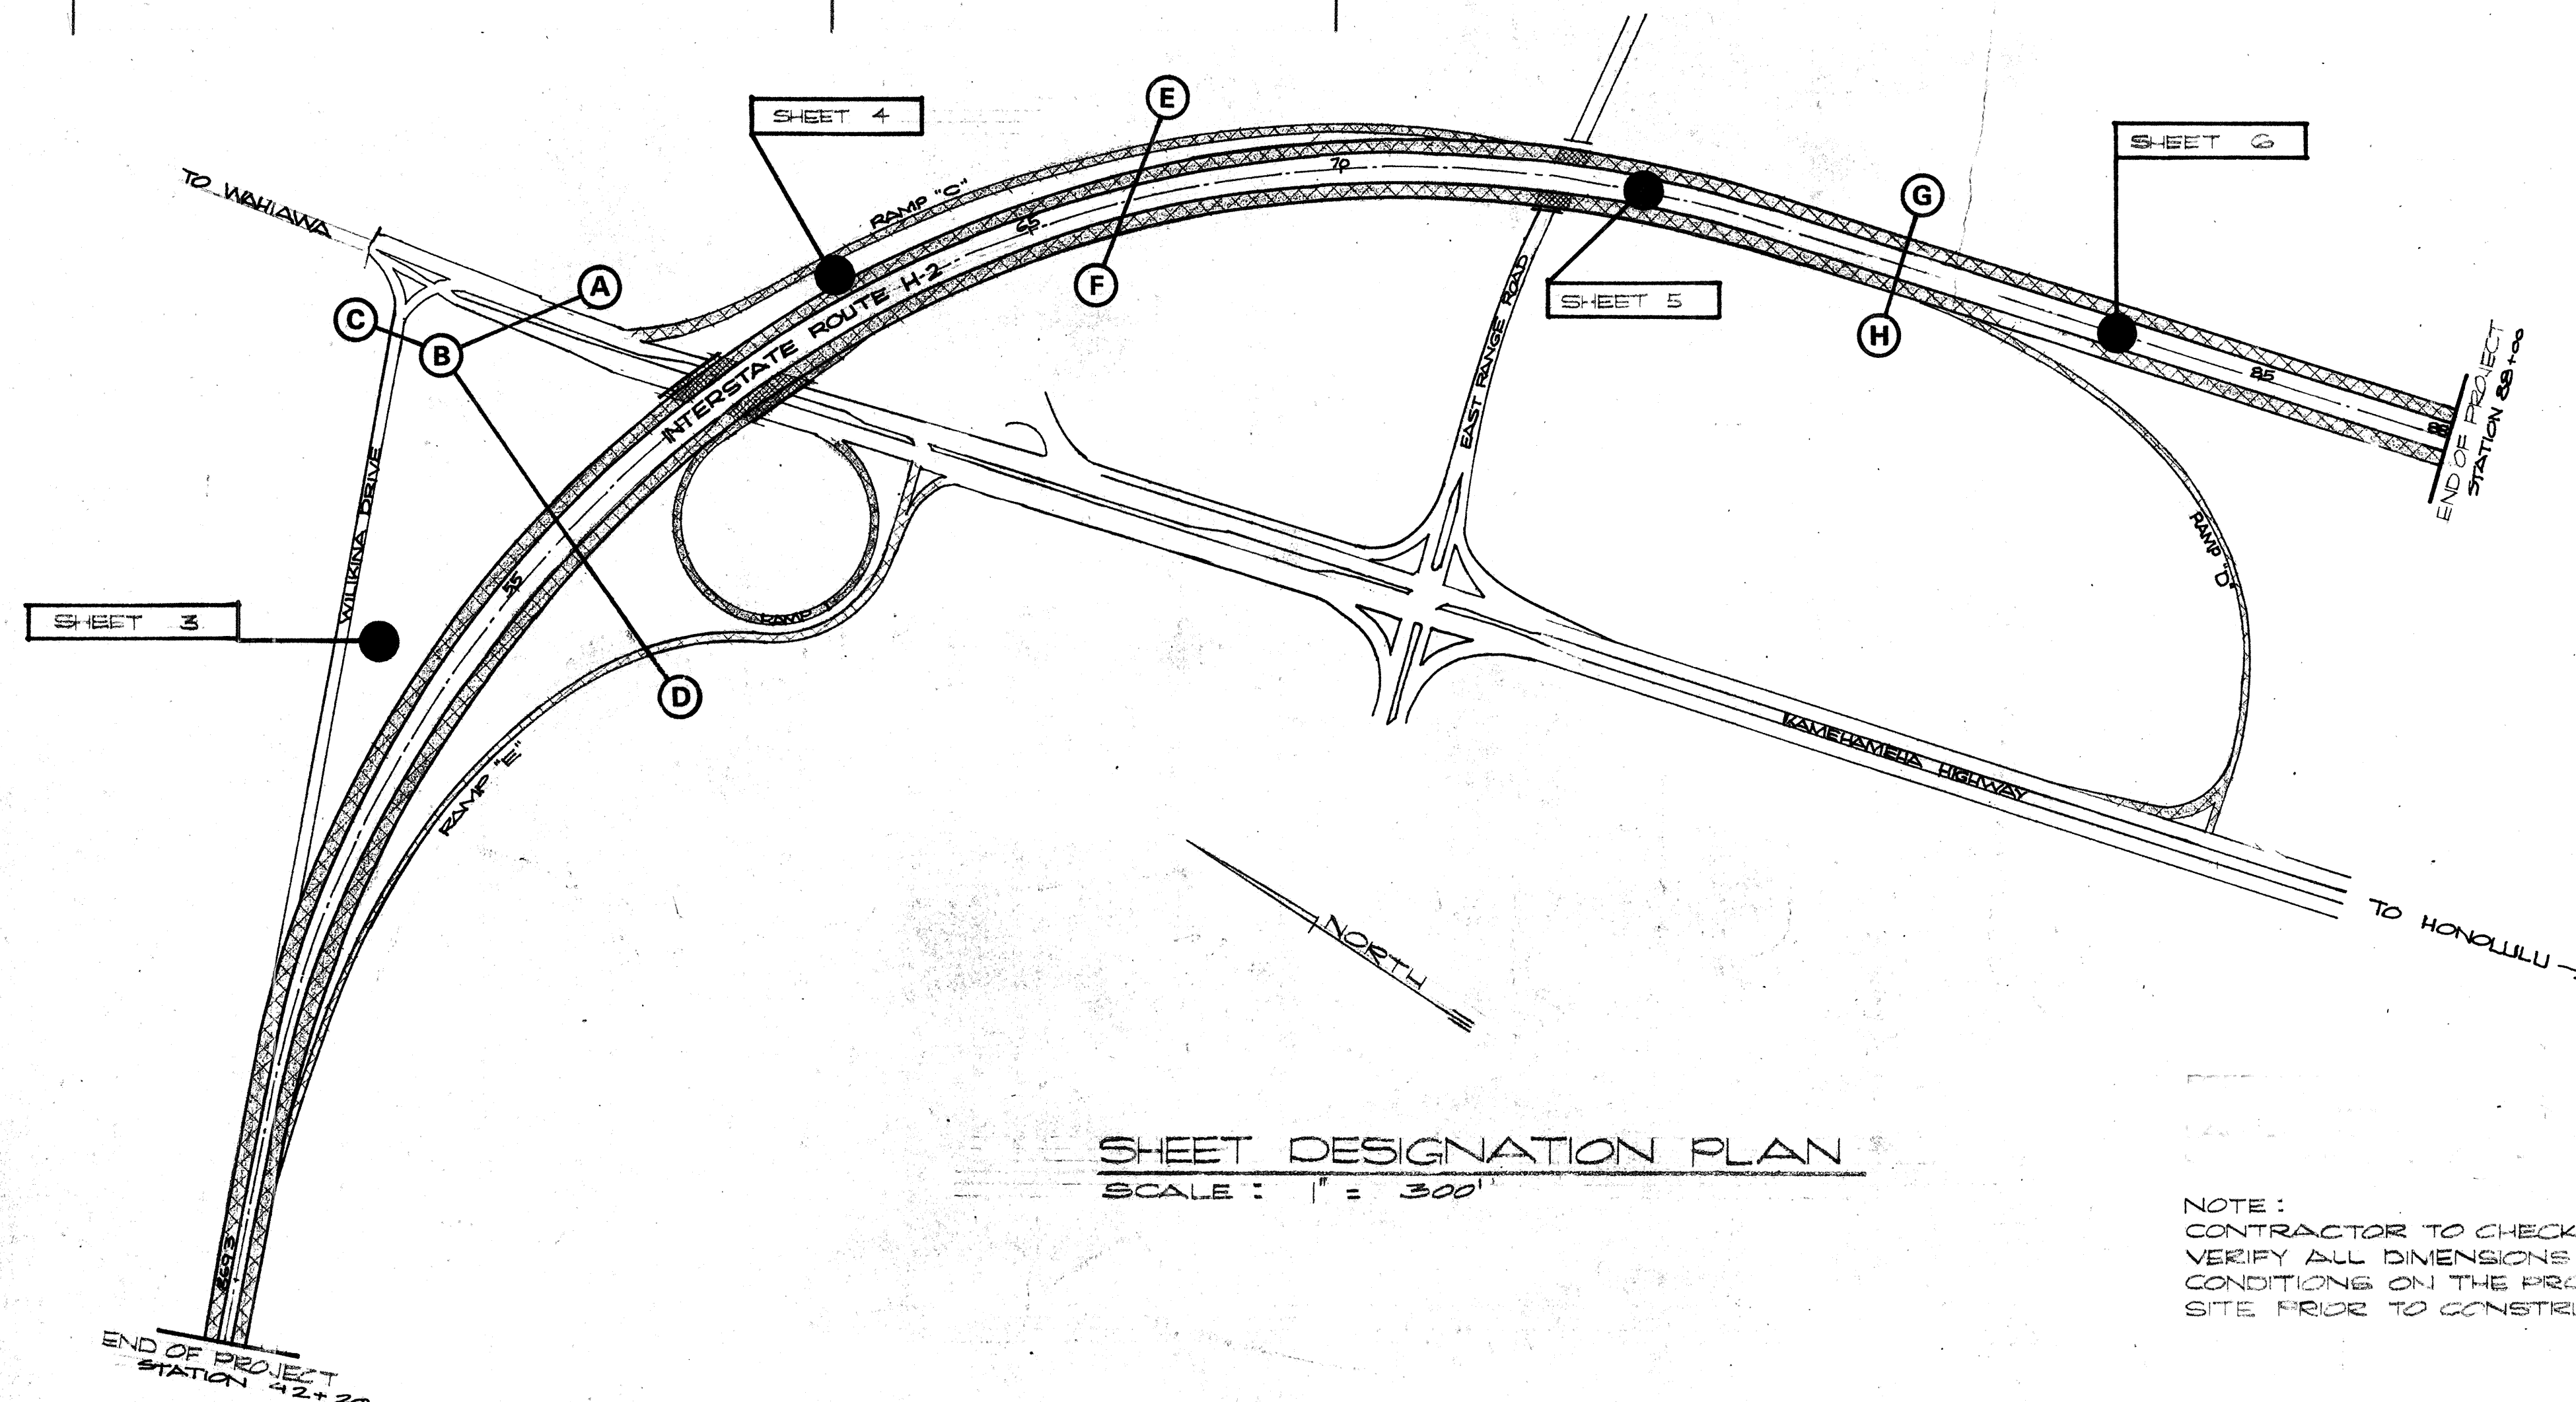

NOTE:
CONTRACTOR TO CHECK AND VERIFY ALL DIMENSIONS AND CONDITIONS ON THE PROJECT SITE PRIOR TO CONSTRUCTION

AUSTIN, YEE & PARK (A JOINT VENTURE) 745 FORT STREET HONOLULU, HAWAII DES. DR. CHK. <i>Donald M. Austin</i> APPROVED FOR JOINT VENTURE	
THIS WORK WAS PREPARED BY ME OR UNDER MY SUPERVISION GEORGE S. WAILES REGISTERED PROFESSIONAL LANDSCAPE ARCHITECT No. 2651 HAWAII, U.S.A.	STATE OF HAWAII DEPARTMENT OF TRANSPORTATION HIGHWAYS DIVISION LANDSCAPE PLAN FOR WAHIAVA INTERCHANGE H-2 FAI. PROJECT No. I-HZ-1C11 2:7 THIS WORK WAS PREPARED BY ME OR UNDER MY SUPERVISION. <i>James M. Yee</i> Date: 4-25-73

SHEET No. L-2 OF 5 SHEETS

DATE	
SURVEY PLOTTED BY	
DRAWN BY	
DESIGNED BY	
QUANTITIES BY	
CHECKED BY	
ORIGINAL PLAN	
NOTE BOOK	
No.	




N.I.C.

ORIGINAL PLAN	SURVEY PLOTTED BY _____ DATE _____	
	DRAWN BY _____	_____
	TRACED BY _____	_____
	DESIGNED BY _____	_____
	QUANTITIES BY _____	_____
NOTE BOOK	CHECKED BY _____	_____
	No. _____	_____

NOTE:
CONTRACTOR TO CHECK AND
VERIFY ALL DIMENSIONS AND
CONDITIONS OF PROJECT SITE
PRIOR TO CONSTRUCTION

SHEET No. 1-3 OF 5 SHEETS

REVISED: JUNE 13, 1973

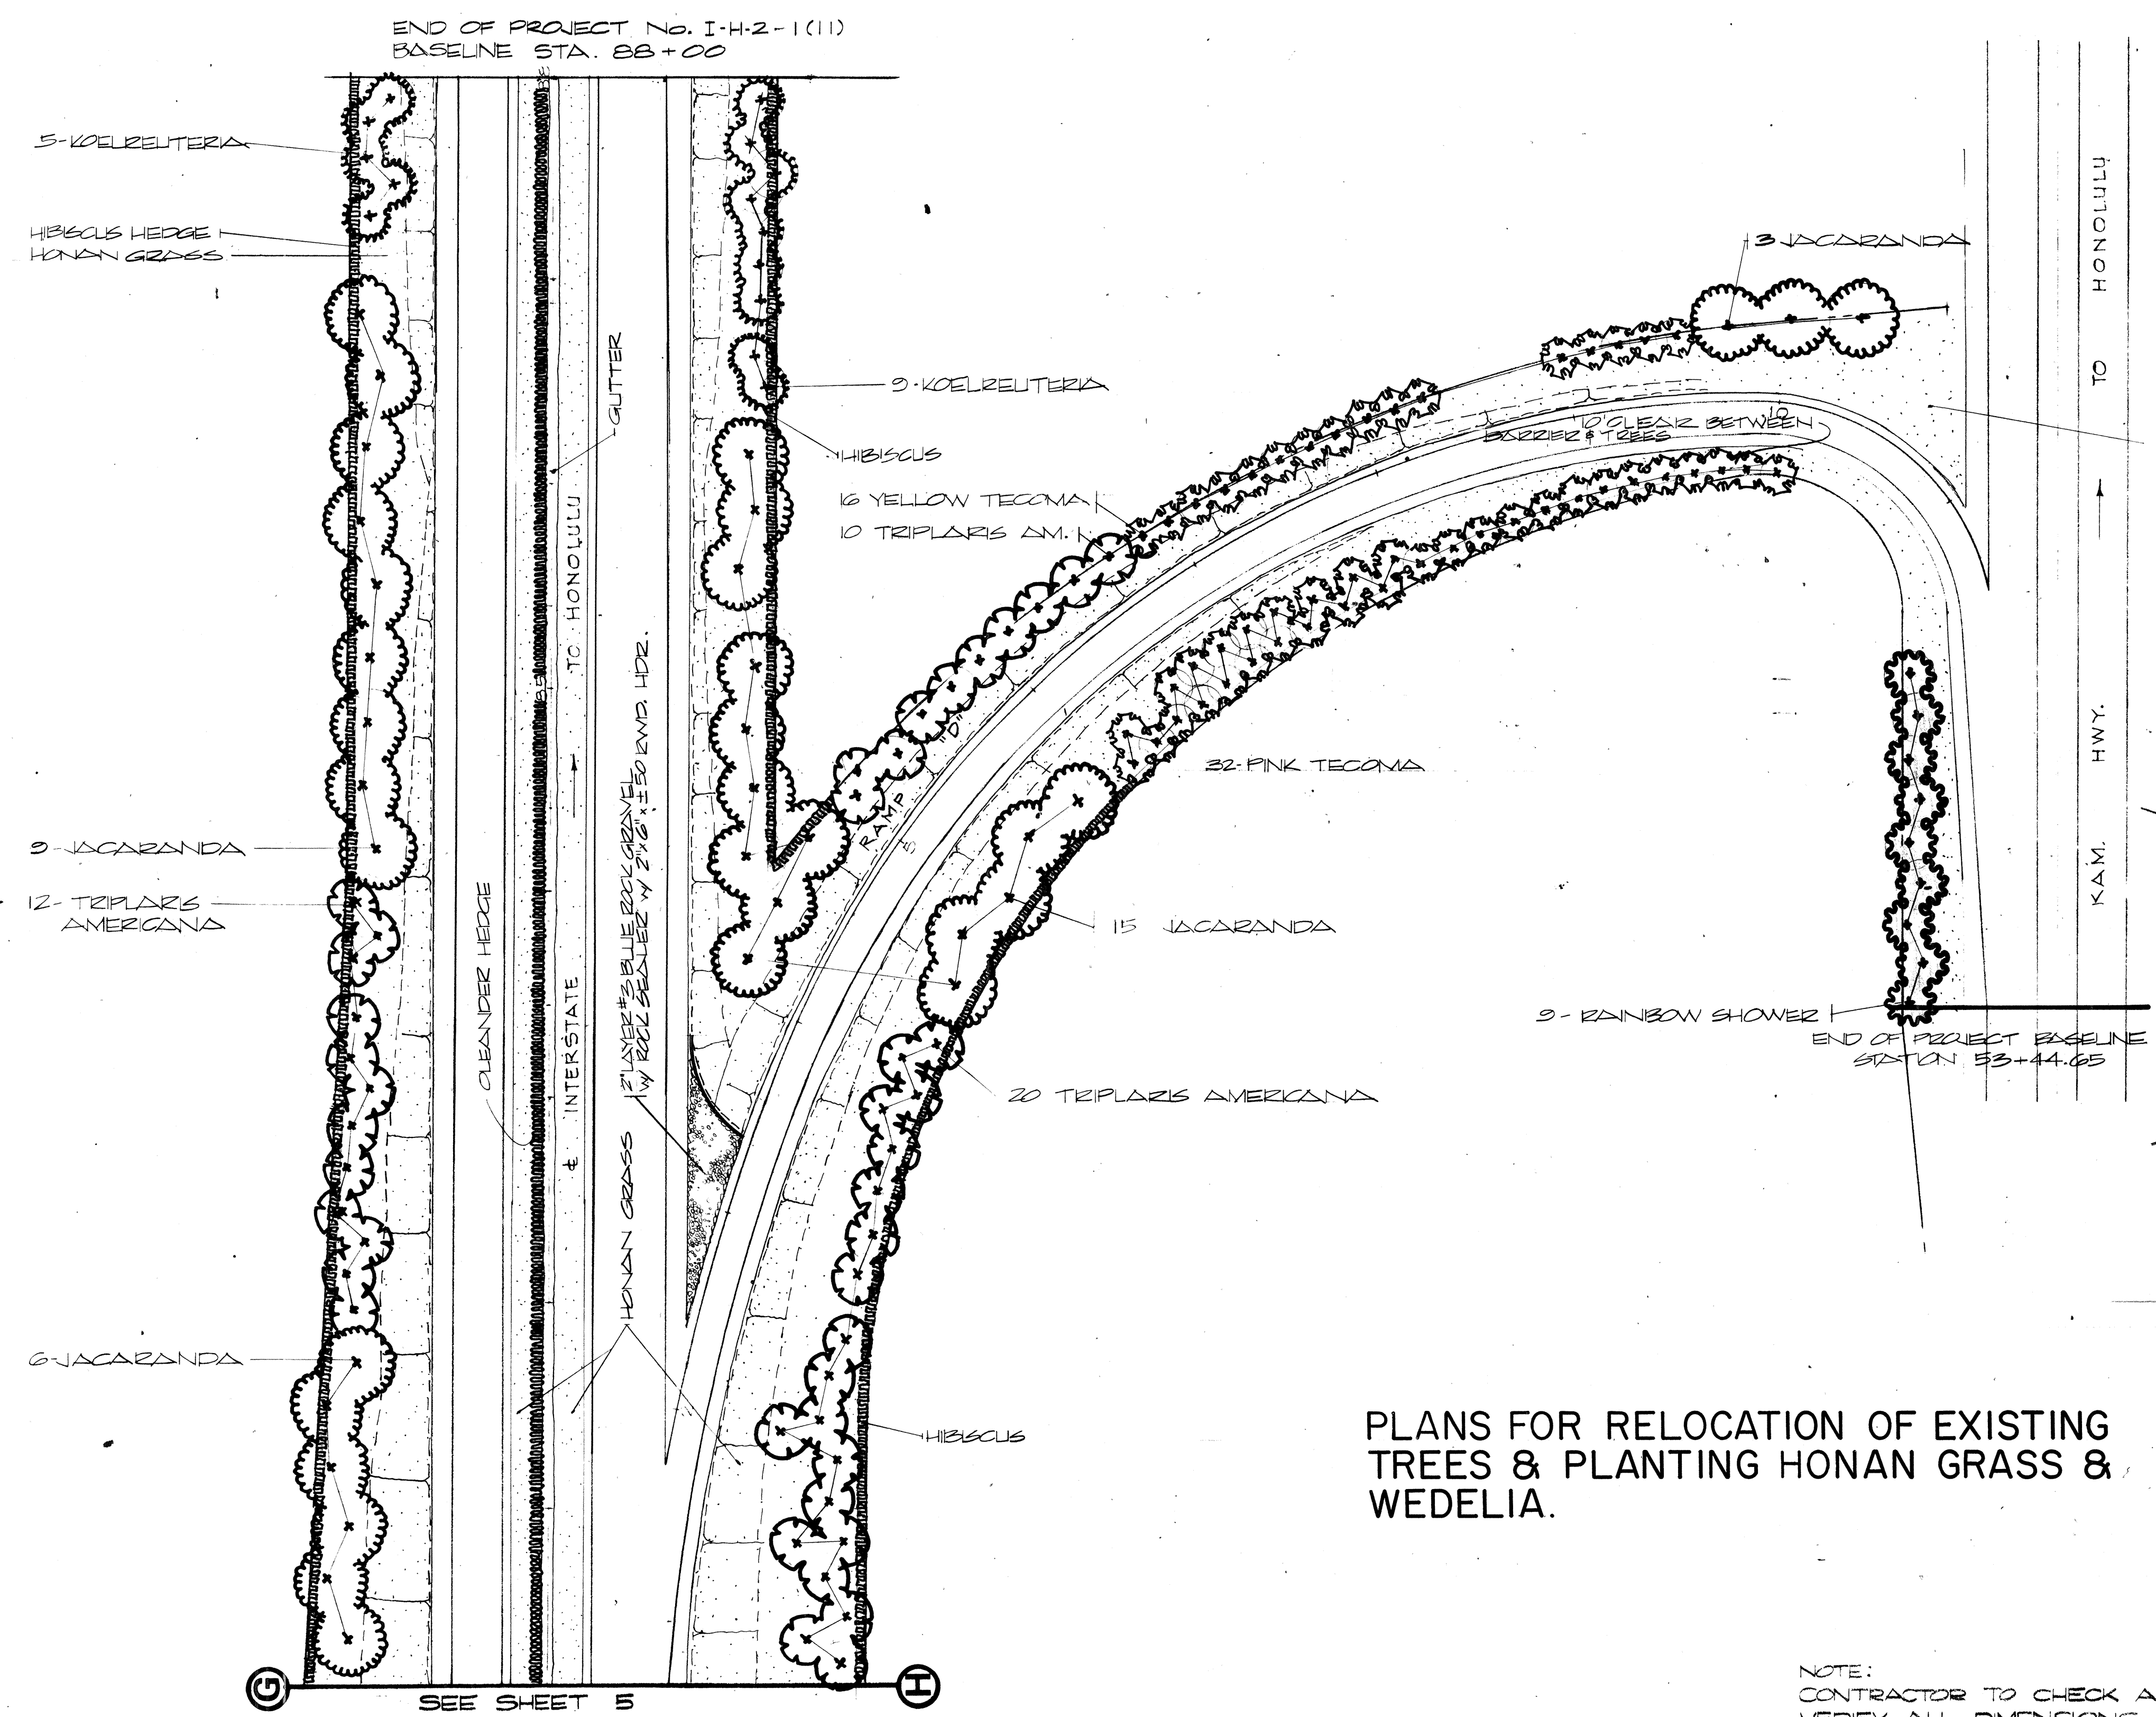

NOTE: 1) HYDRO-MULCH OVER SHADED GRASSED AREAS & ALL GRASSED AREAS WITH SLOPES 2 TO 1 OR GREATER
2) SEE PAGE THREE FOR RELOCATED & EXISTING TREE LIST

PLANT LIST		
QUAN.	COMMON & BOTANICAL NAME	SIZE & SPACING
33	JACARANDA - JACARANDA ACUTIFOLIA	25' x 12' HT 5' SPD 3' x 2'
42	TRIPLARIS - TRIPLARIS AMERICANA	10' x 7' HT 2' SPD 1' x 2'
9	RAINBOW SHOWER - COEQUISETIA ACUTIFOLIA	25' x 10' HT 4' SPD 2' x 2'
16	YELLOW TECOMA - TECOMA ARGENTEA	25' x 8' HT 4' SPD 2' x 2'
32	PINK TECOMA - TECOMA PINK	25' x 8' HT 4' SPD 2' x 2'
14	KOELREUTERIA - KOELREUTERIA PANICULATA	25' x 8' HT 4' SPD 2' x 2'
265	CLEANDER - NEELUM CLEANDER (SALMON COLOR)	5' x 30' HT 3' x 3' x 3'
563	BUTTERFLY HIBISCUS - HIBISCUS SCHIZOPETALUS	5' x 30' HT 3' x 3' x 3'
13,500	WEDELIA - WEDELIA TRILOBATA	
13,500	HONAN GRASS - EREMOPHILA OPHIUROIDES	SPRIGS @ 8' x 8'

PLANT LIST		
QUAN.	COMMON & BOTANICAL NAME	SIZE & SPACING
13,500	HONAN GRASS - EREMOPHILA OPHIUROIDES	SPRIGS @ 8' x 8'

PLANS FOR RELOCATION OF EXISTING TREES & PLANTING HONAN GRASS & WEDELIA.

NOTE: CONTRACTOR TO CHECK AND VERIFY ALL DIMENSIONS AND CONDITIONS ON THE PROJECT SITE PRIOR TO CONSTRUCTION

DESIGNED BY: *CSK* OR *JY & CSK* OR *GW*

APPROVED FOR JOINT VENTURE: *[Signature]*

THIS WORK WAS PREPARED BY ME OR UNDER MY SUPERVISION

AUSTIN, YEE & PARK
(A JOINT VENTURE)
745 FORT STREET HONOLULU, HAWAII

STATE OF HAWAII
DEPARTMENT OF TRANSPORTATION
HIGHWAYS DIVISION

LANDSCAPE PLAN FOR
WAIHANA INTERCHANGE H-2
FAI PROJECT NO. I-H2-1(1):7

DATE: 4-25-73

SHEET No. 43 OF 5 SHEETS

SURVEY PLOTTED BY	DATE
DRAWN BY	
CHECKED BY	
NOTED BY	
ORIGINAL PLAN	
NOTE BOOK	