

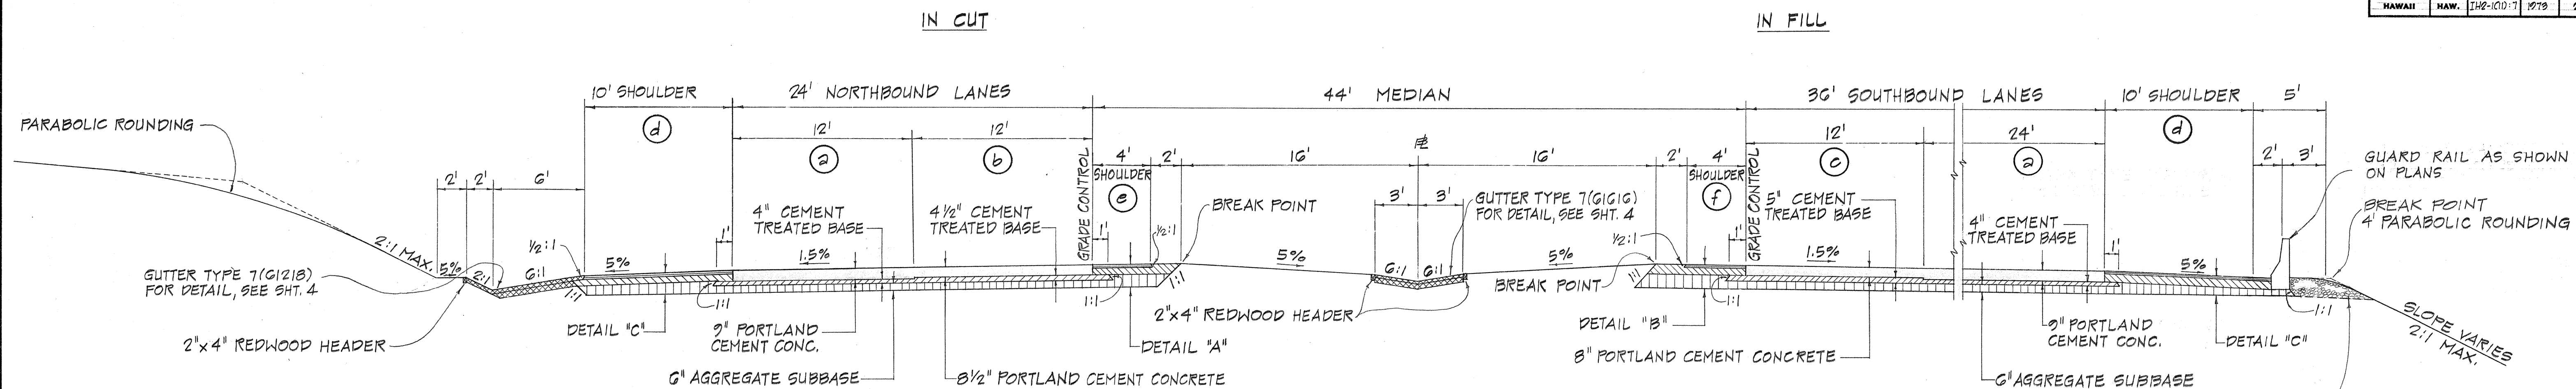


FED. ROAD DIST. NO.	STATE	FED. AID PROJ. NO.	FISCAL YEAR	SHEET NO.	TOTAL SHEETS
HAWAII	HAW.	142-100-7	1973	2	274

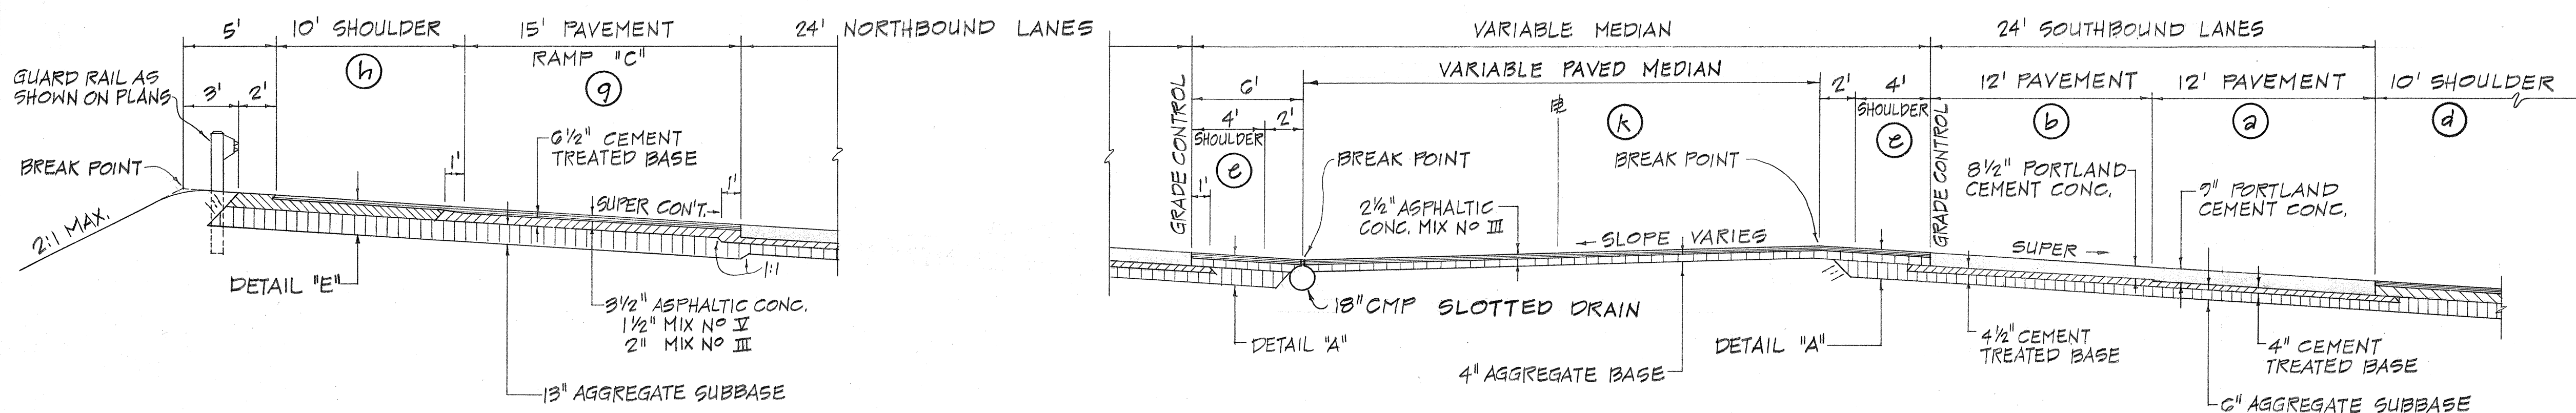







INTERSTATE ROUTE H-2 ~ TANGENT SECTION

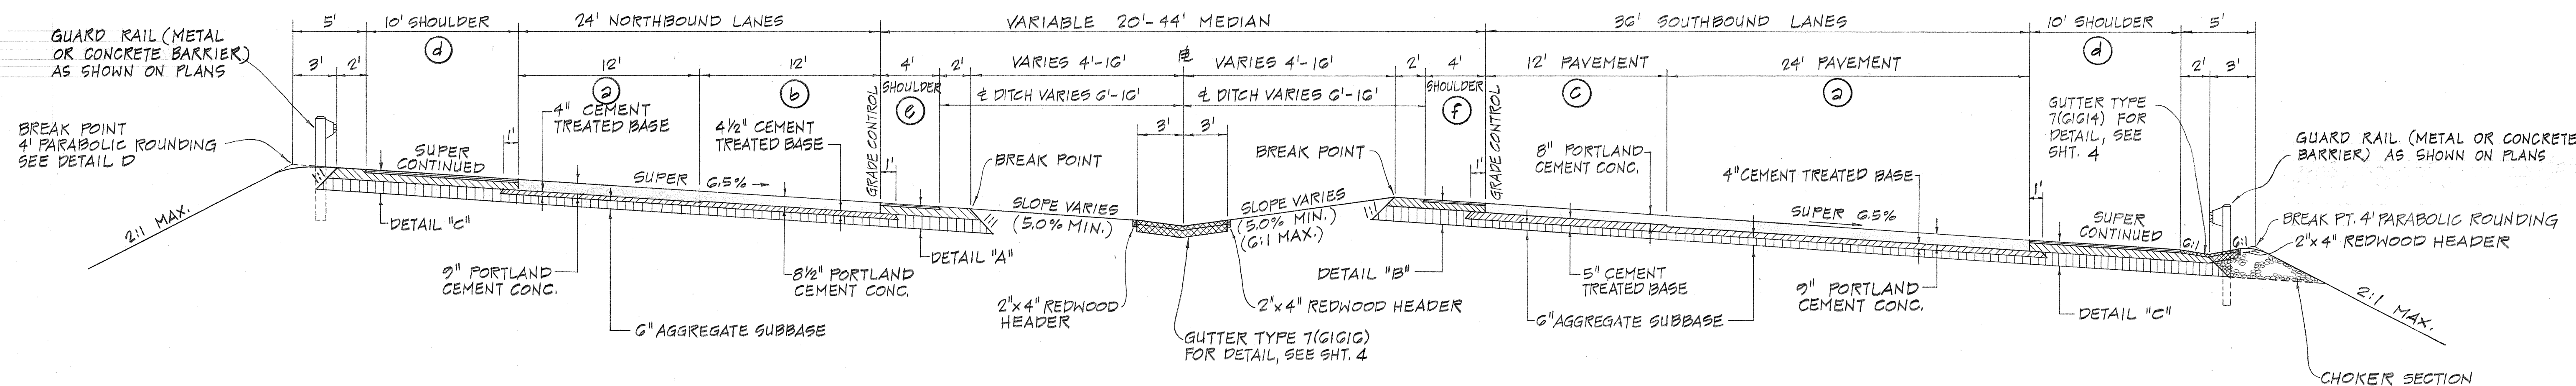

INTERSTATE ROUTE H-2 ~ SUPERELEVATION SECTIONS

	AUSTIN, YEE & PARK (A JOINT VENTURE) 745 FORT STREET, HONOLULU, HAWAII
	DES. EM. DR. PM. CHK. CT.
THIS WORK WAS PREPARED BY ME OR UNDER MY SUPERVISION	
STATE OF HAWAII DEPARTMENT OF TRANSPORTATION HIGHWAYS DIVISION	
TYPICAL ROADWAY SECTIONS	
WAHIAWA INTERCHANGE	
F.A.I. Project No. I-H2-100-7	
Scale: 3/16" = 1'-0"	Date: 4-25-73
SHEET NO. 1 OF 3 SHEETS	

FED. ROAD DIST. NO.	STATE	FED. AID PROJ. NO.	FISCAL YEAR	SHEET NO.	TOTAL SHEETS
HAWAII	HAW.	548-100-1	1978	3	274

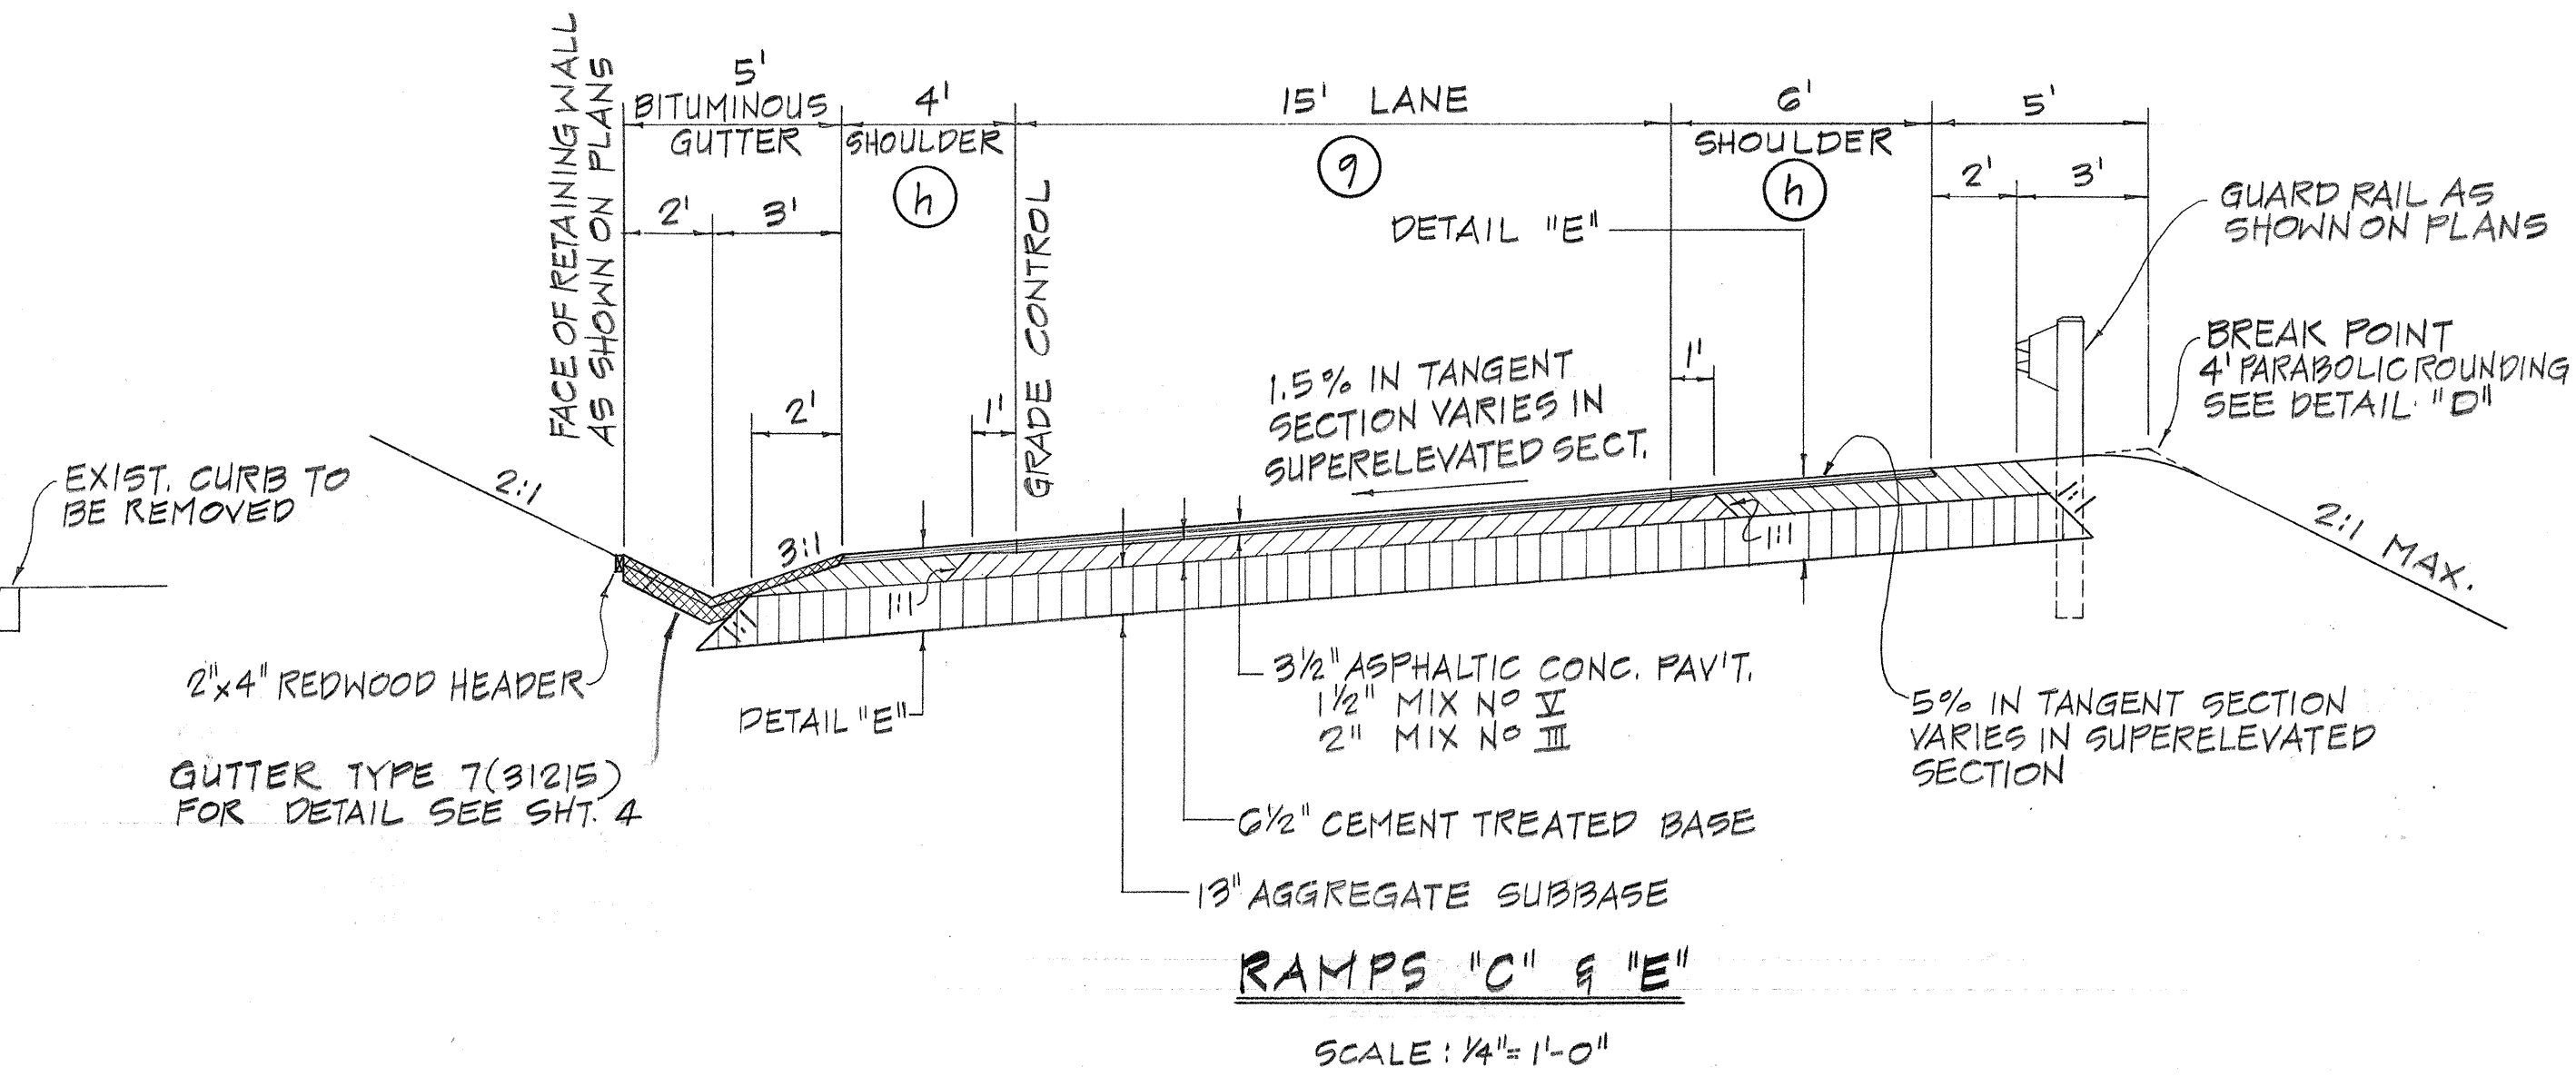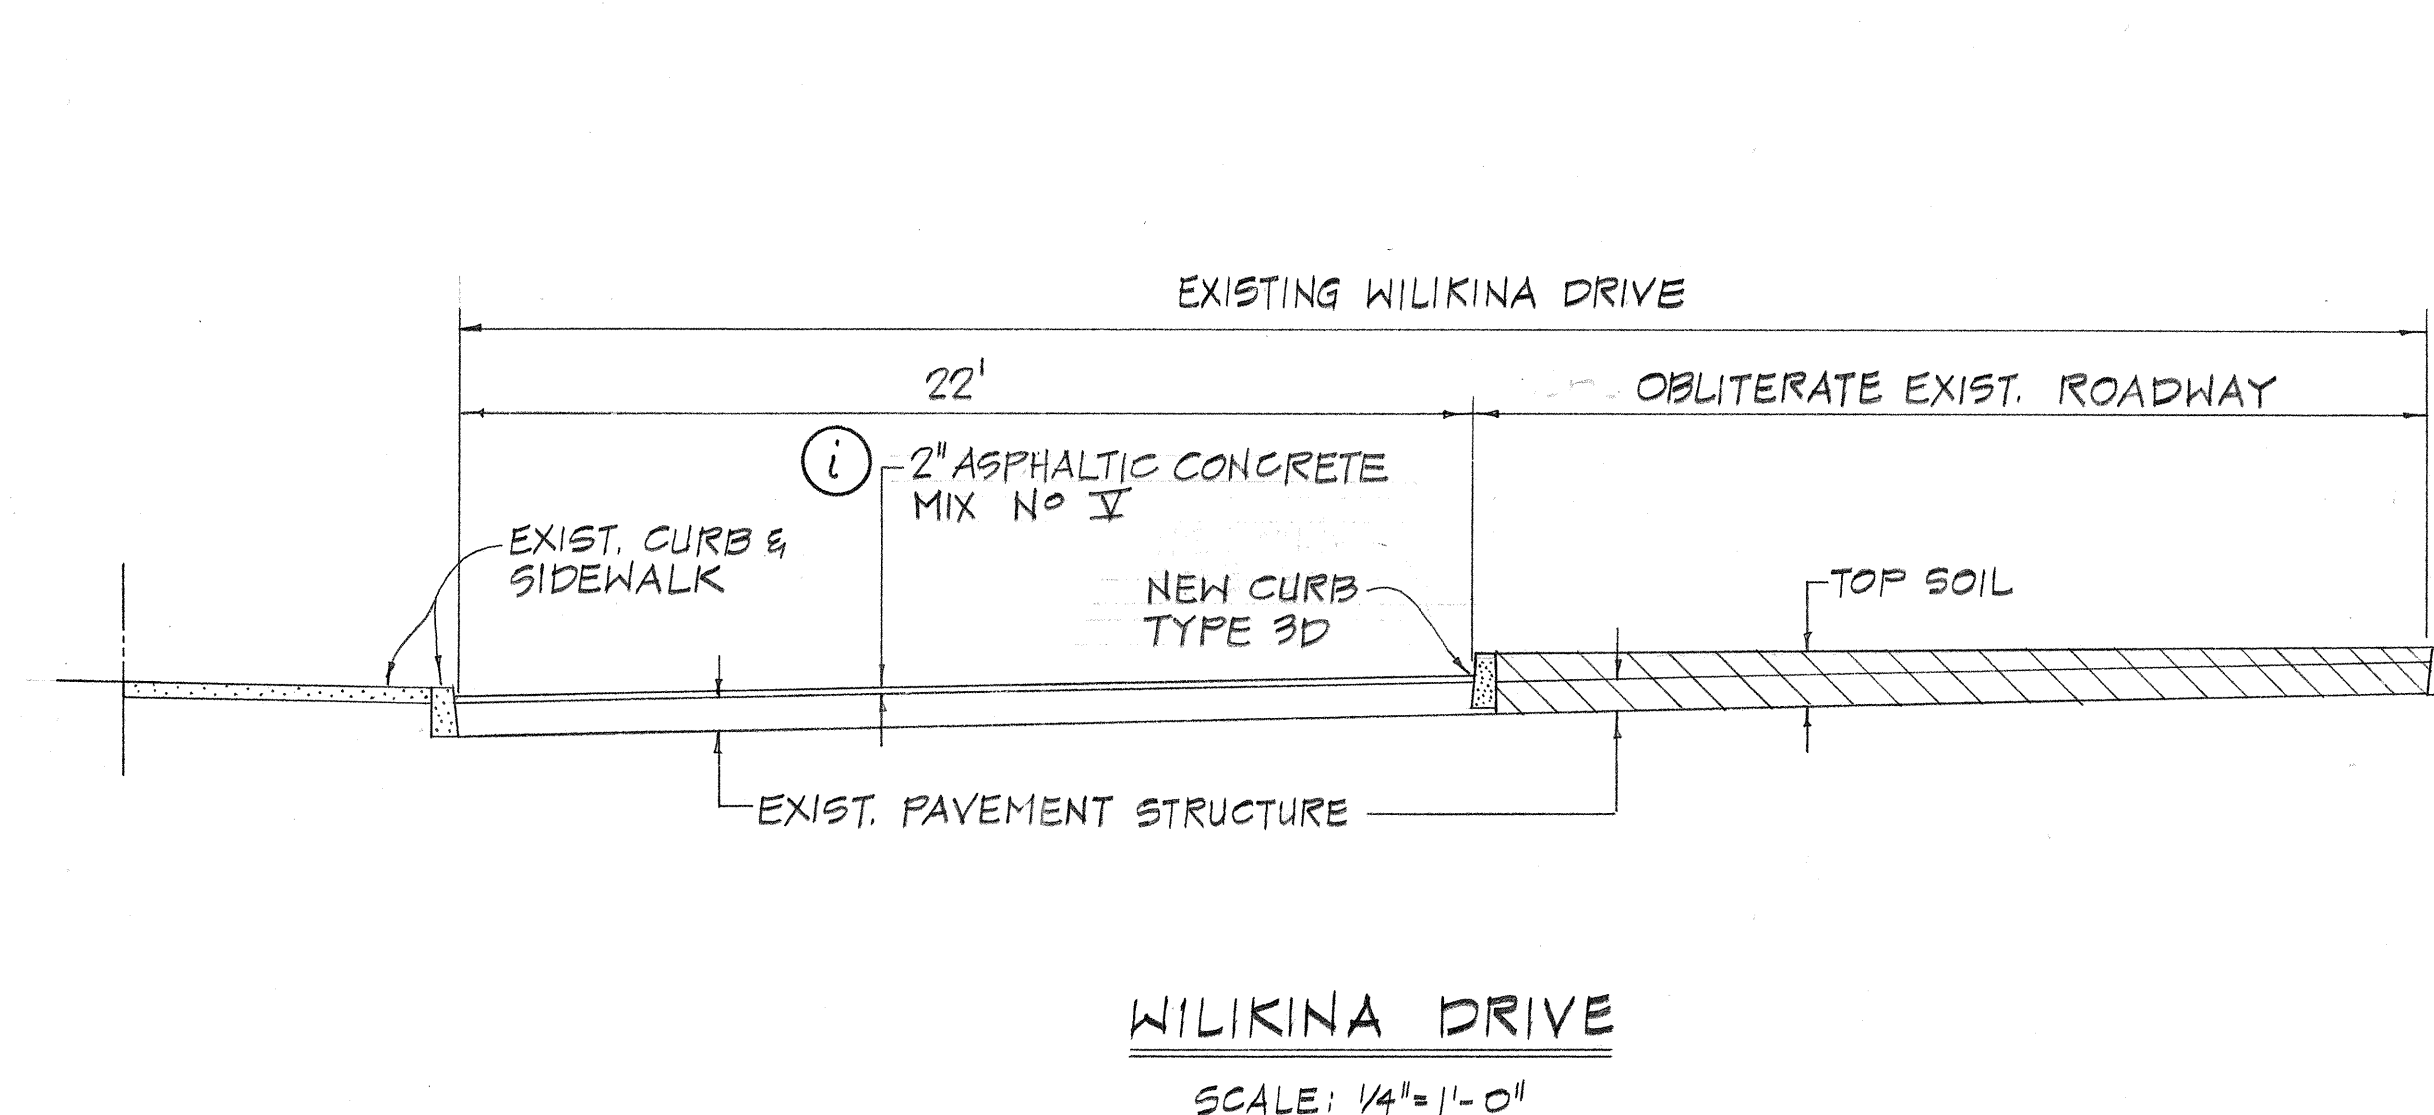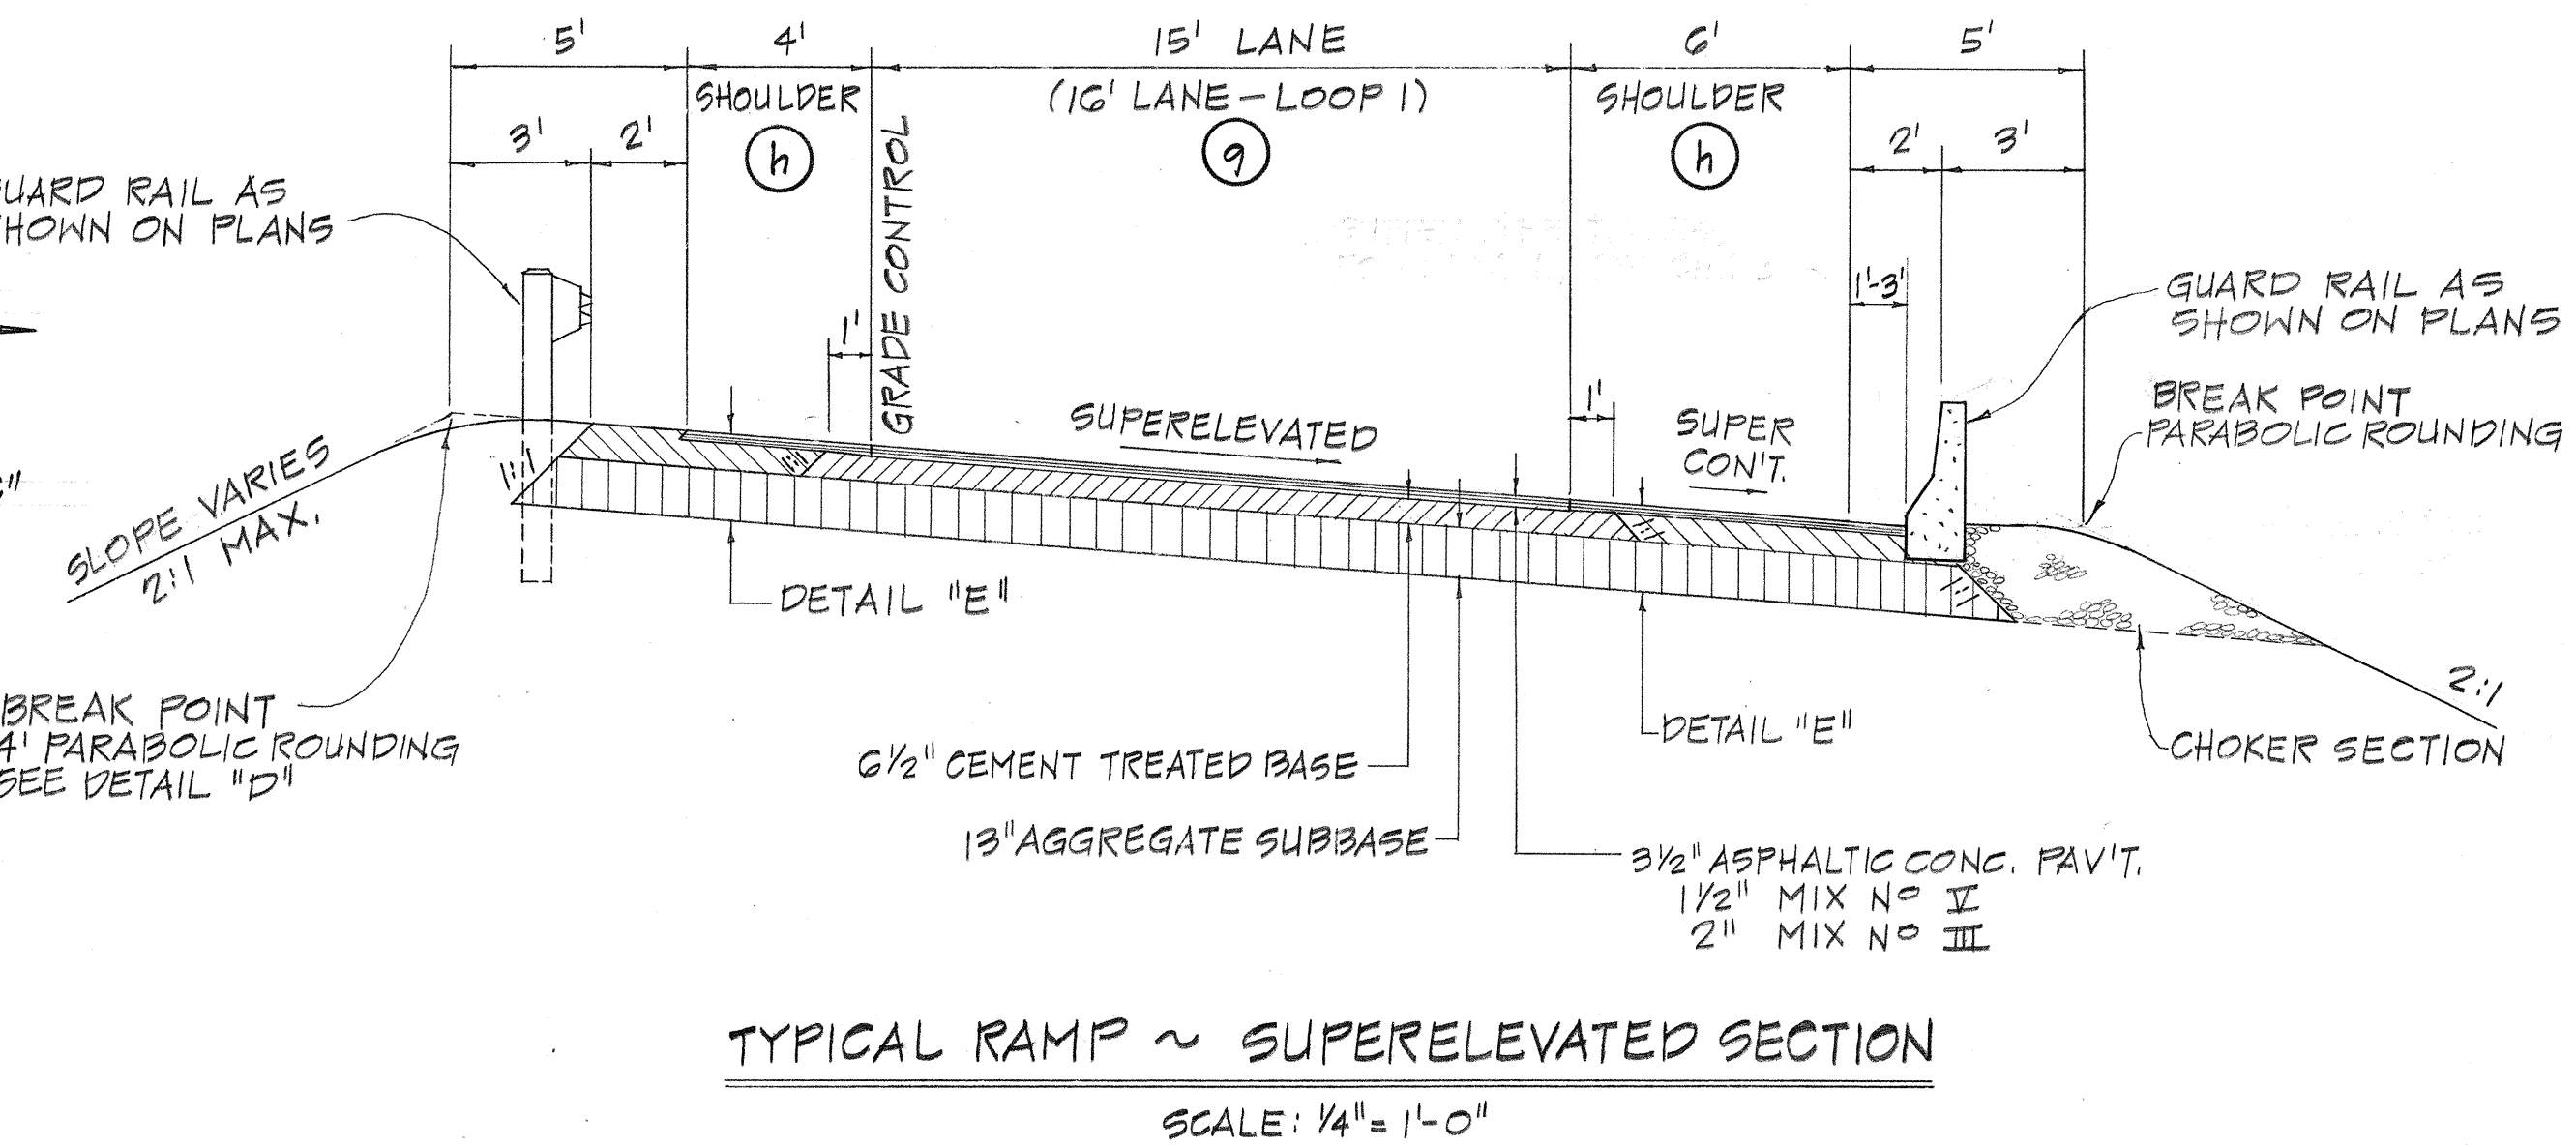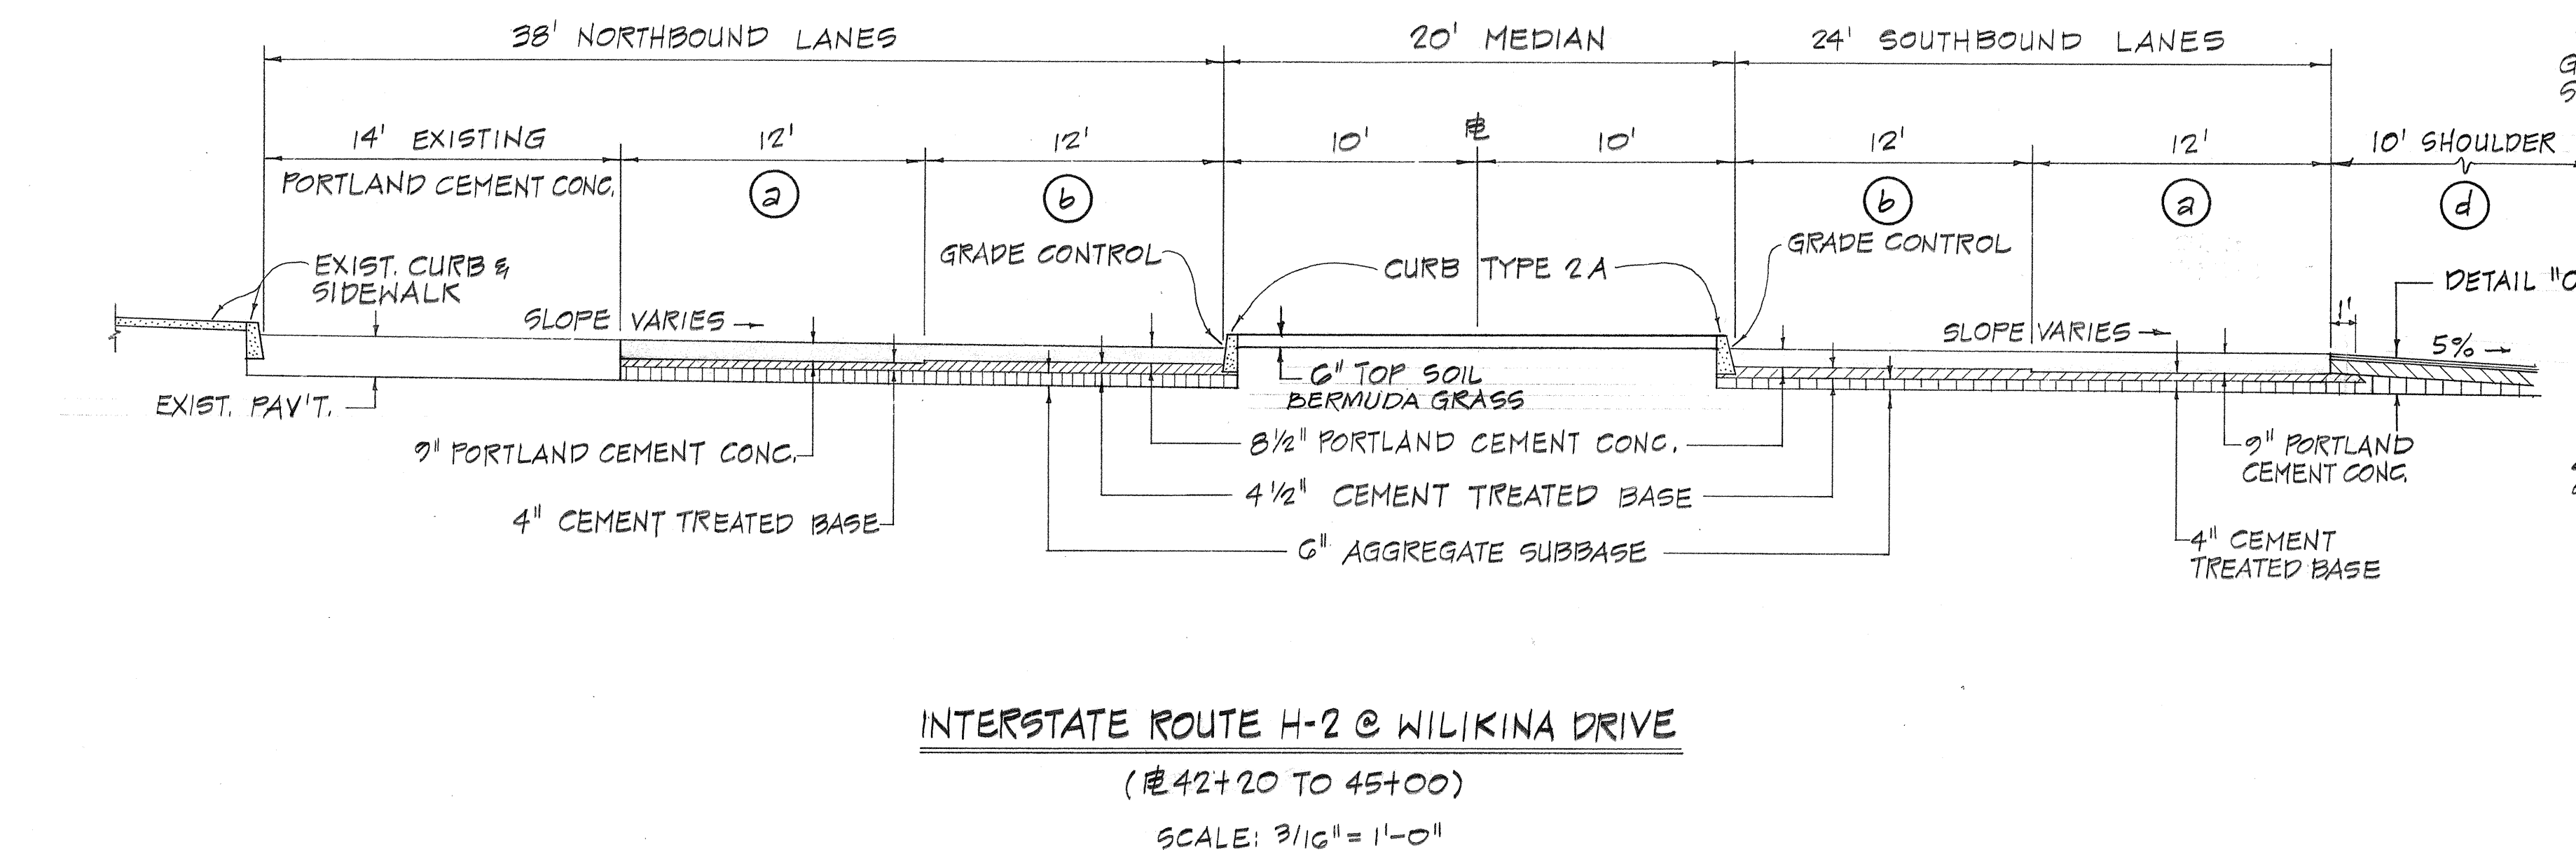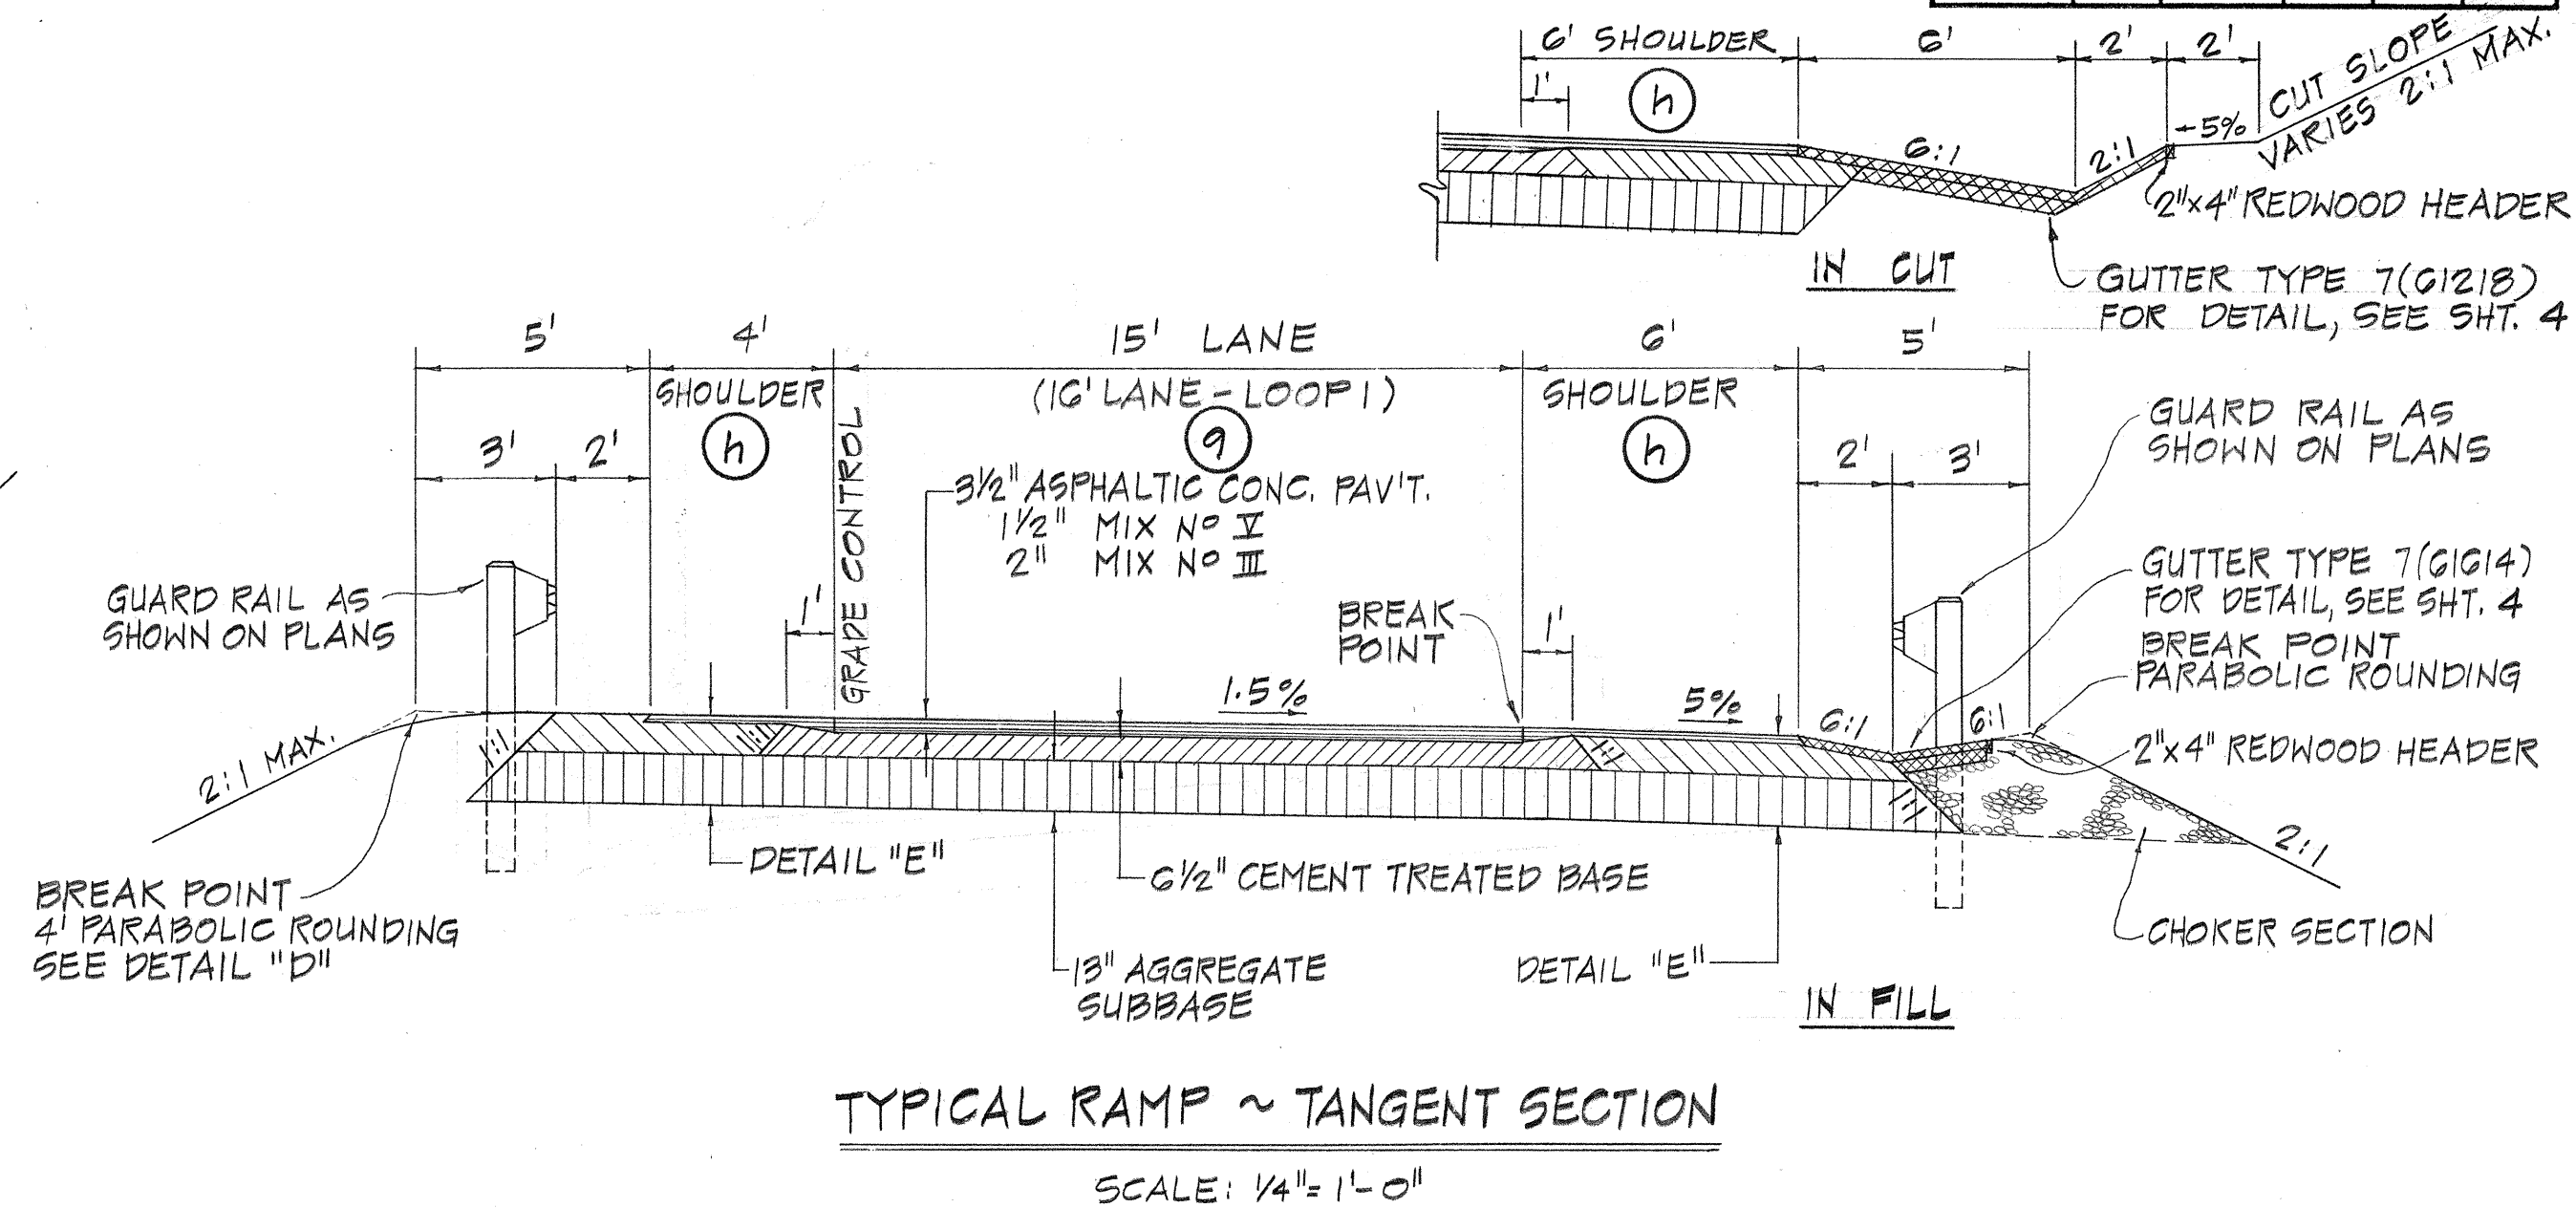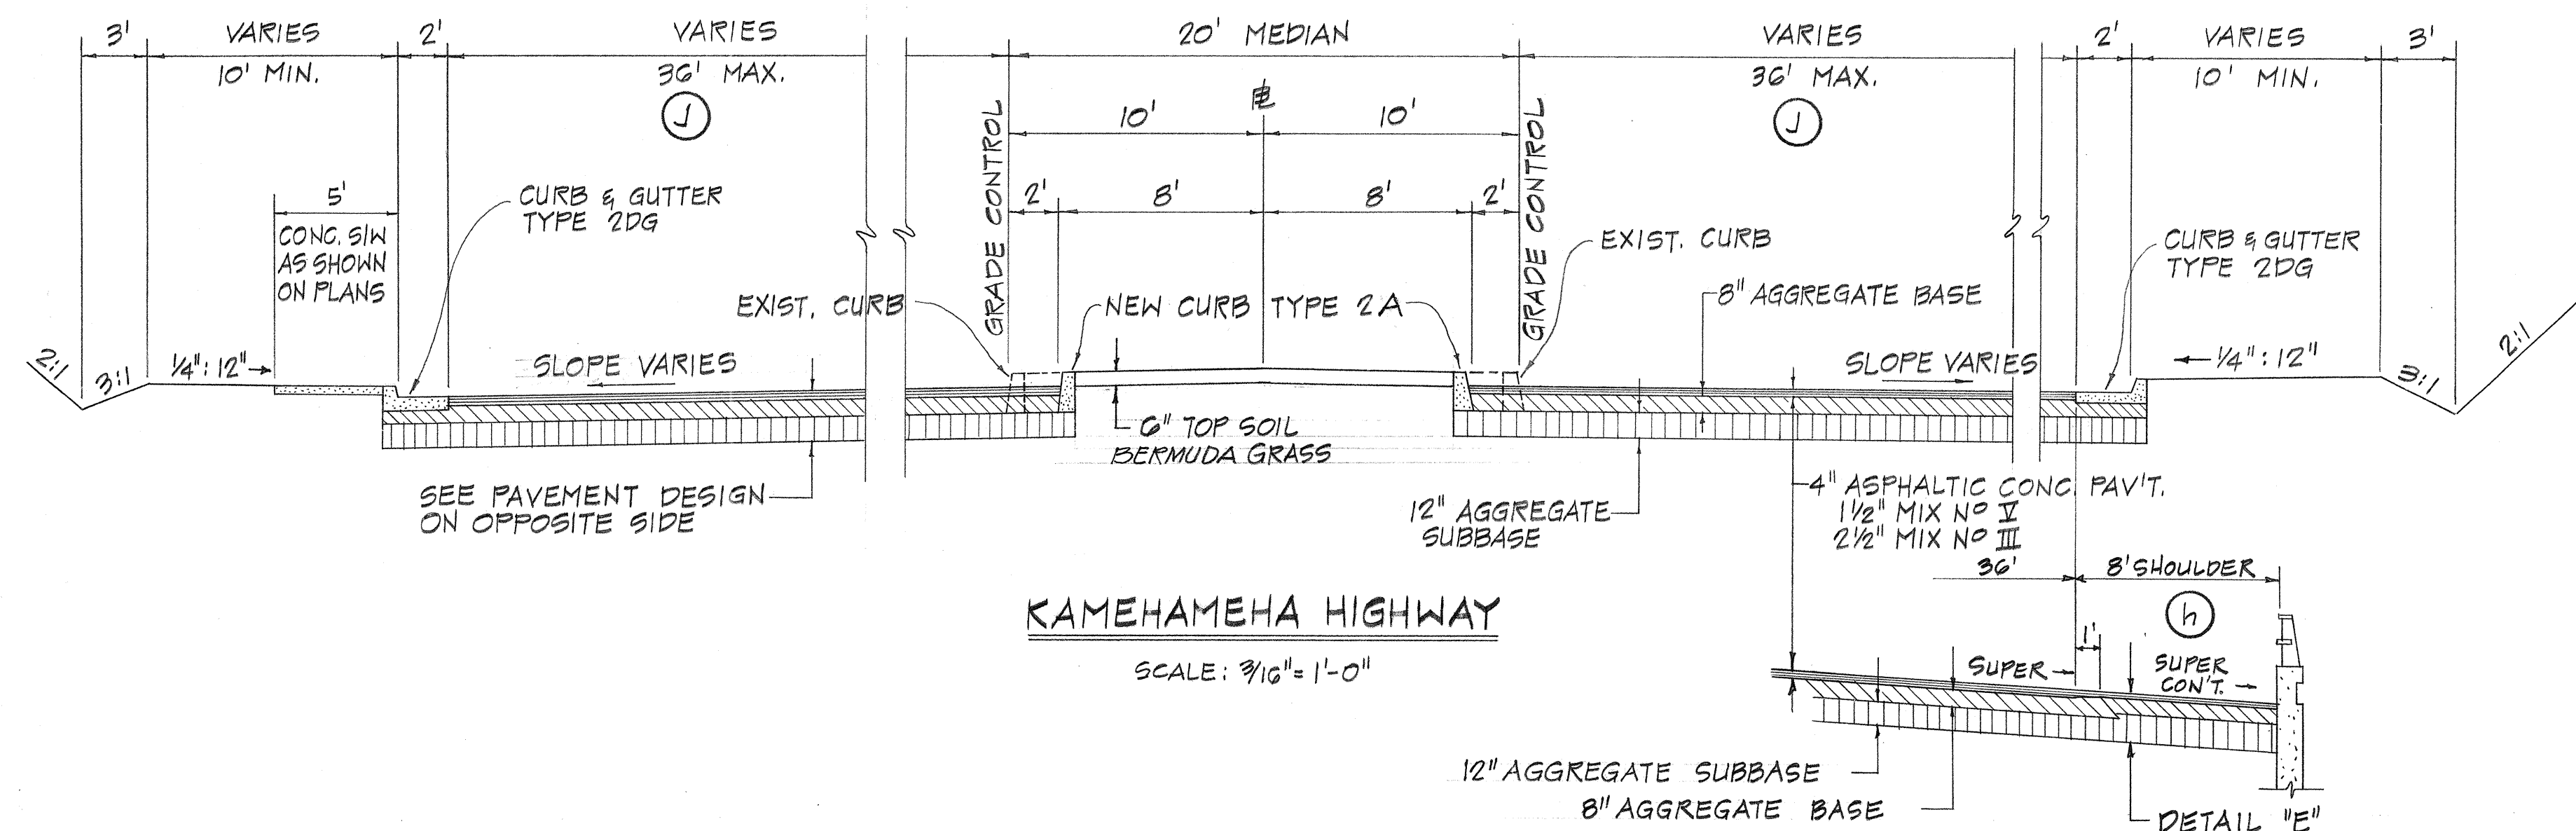

CLARENCE K. IANNONE
REGISTERED PROFESSIONAL ENGINEER
No. 1464-E
HAWAII, U.S.A.

AUSTIN, YEE & PARK
(A JOINT VENTURE)
745 FORT STREET, HONOLULU, HAWAII

DES. E.M. DR. B.M. CHK. J.T.

APPROVED FOR JOINT VENTURE

STATE OF HAWAII
DEPARTMENT OF TRANSPORTATION
HIGHWAYS DIVISION

TYPICAL ROADWAY SECTIONS

WAIHAWA INTERCHANGE



F.A.I. Project No. I-H2-1(11):7

Scale: As shown Date: 4-25-78

SHEET NO. 2 OF 3 SHEETS


DATE	_____
DESIGNED BY	_____
CHECKED BY	_____
NOTED BY	_____
ORIGINAL PLAN	_____
NO. BOOK	_____

FED. ROAD DIST. NO.	STATE	FED. AID PROJ. NO.	FISCAL YEAR	SHEET NO.	TOTAL SHEETS
HAWAII	HAW.	I-H2-(11)-7	1973	#	274

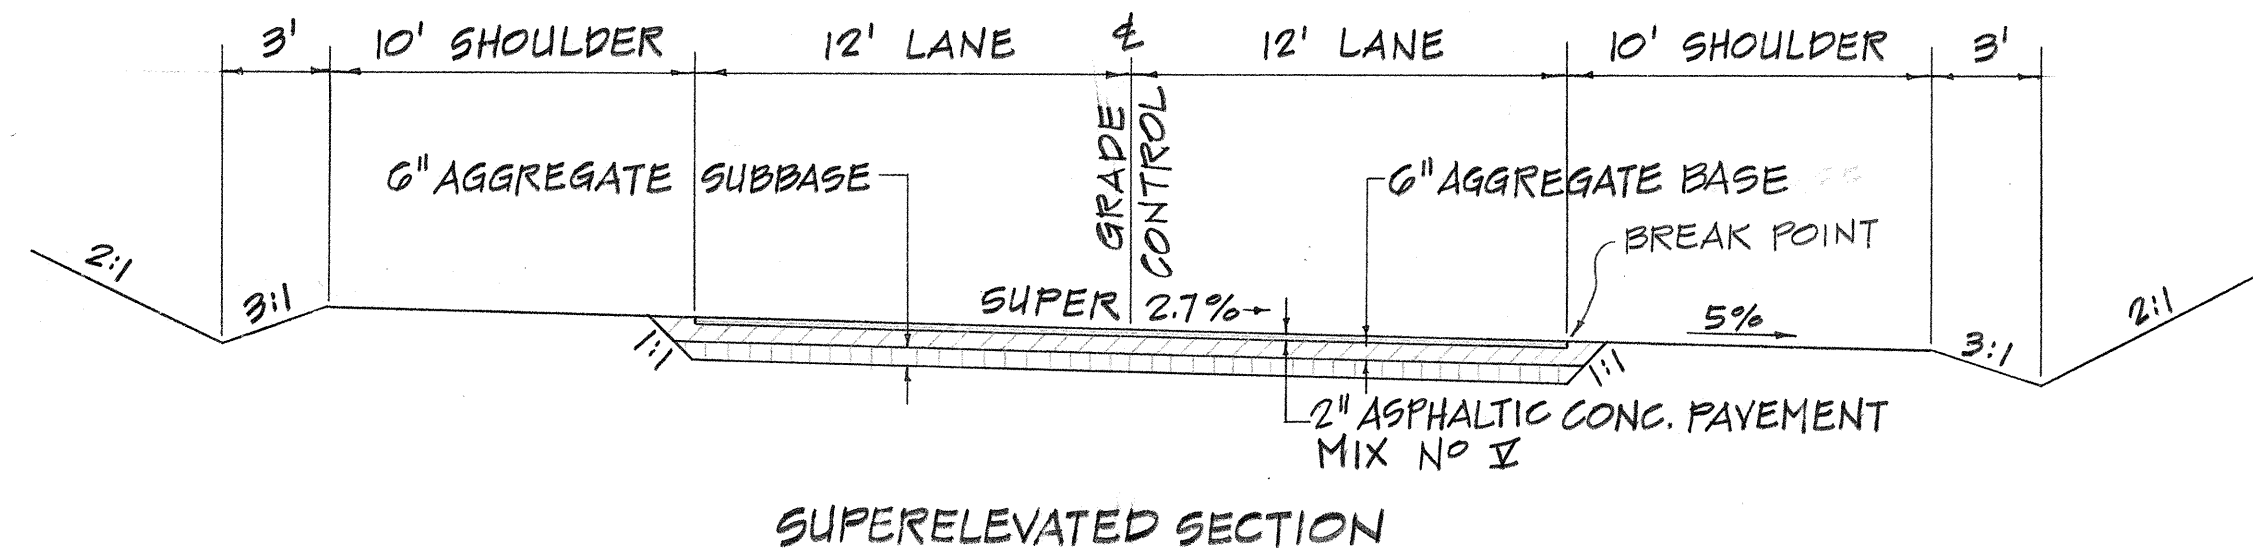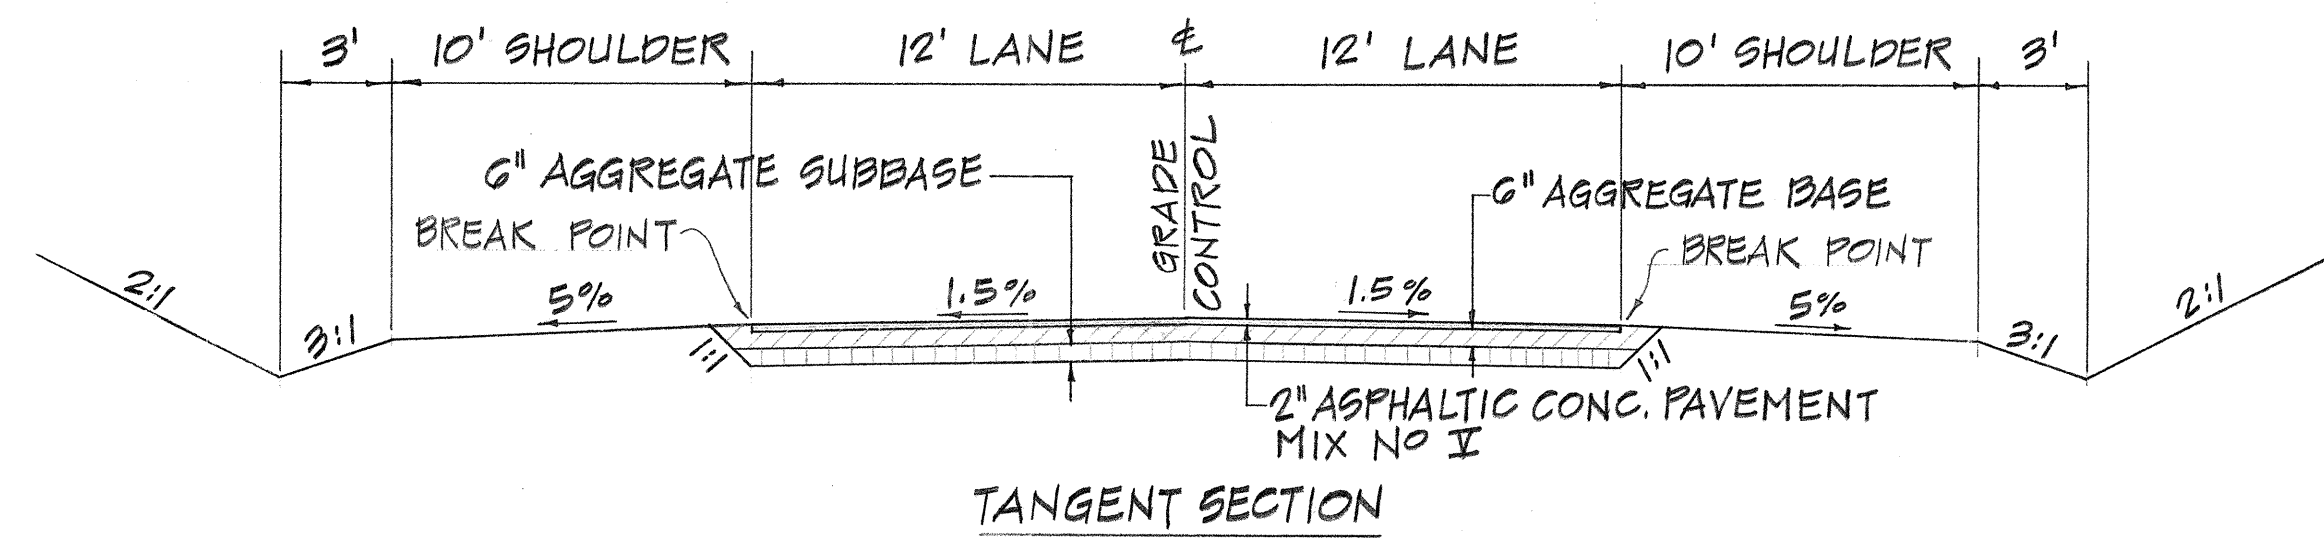


EAST RANGE ROAD


SCALE: 3/16" = 1'-0"

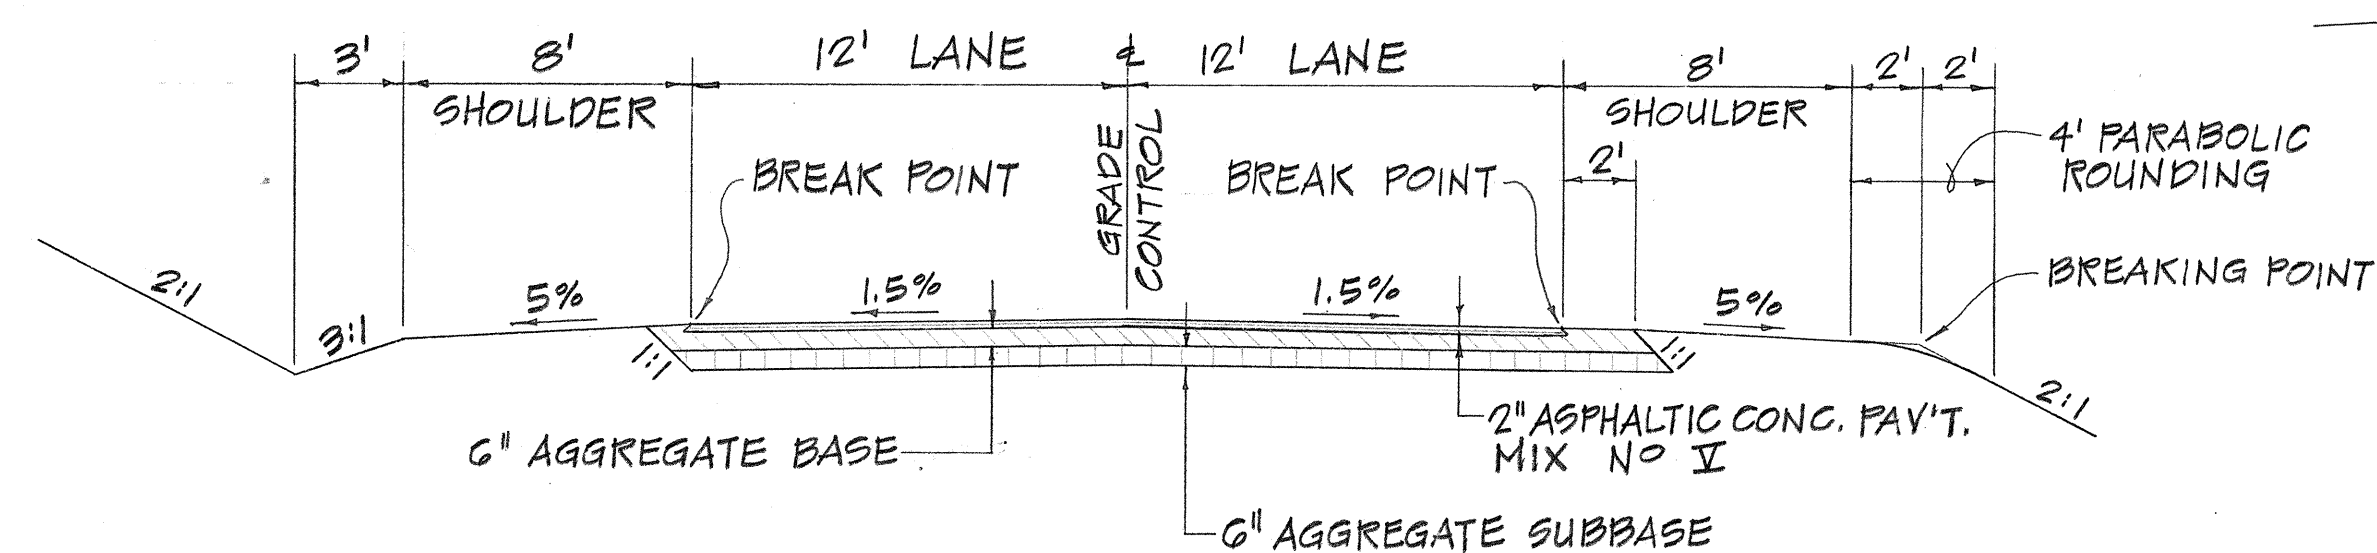


SCALE: 3/16" = 1'-0"

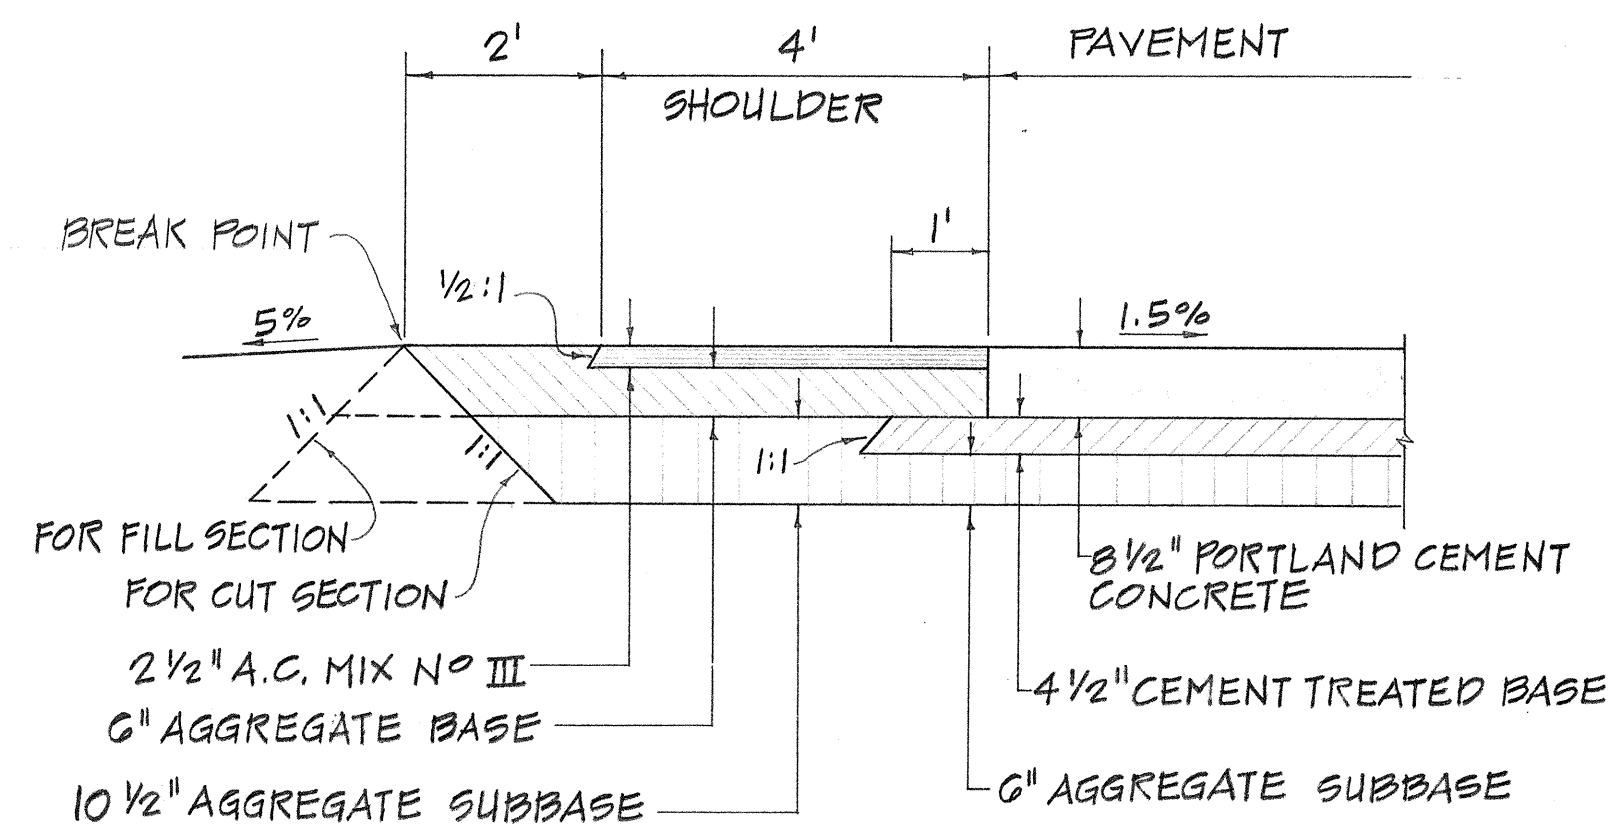


SCALE: 1/2" = 1'-0"

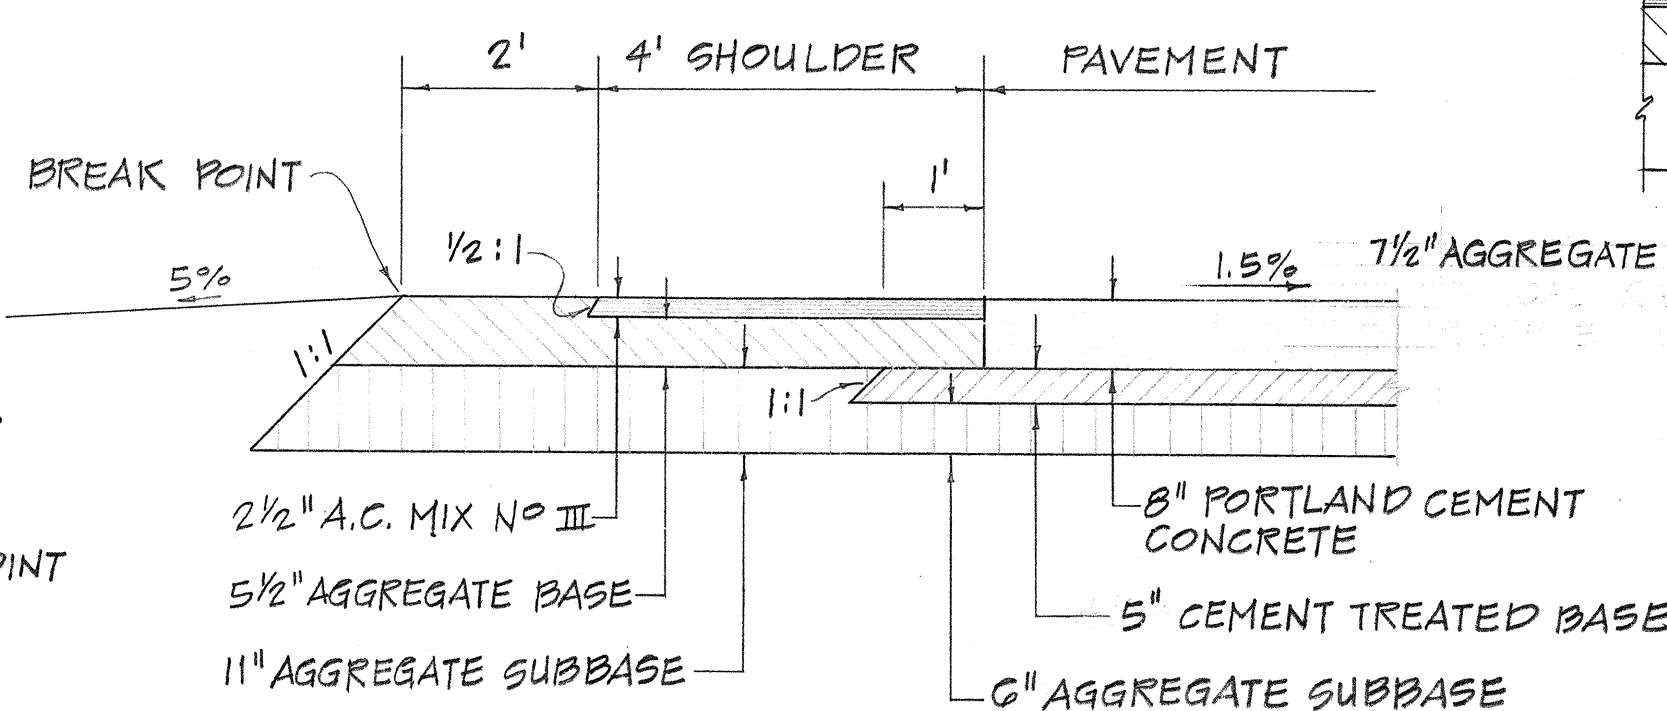


SCALE: 1/2" = 1'-0"

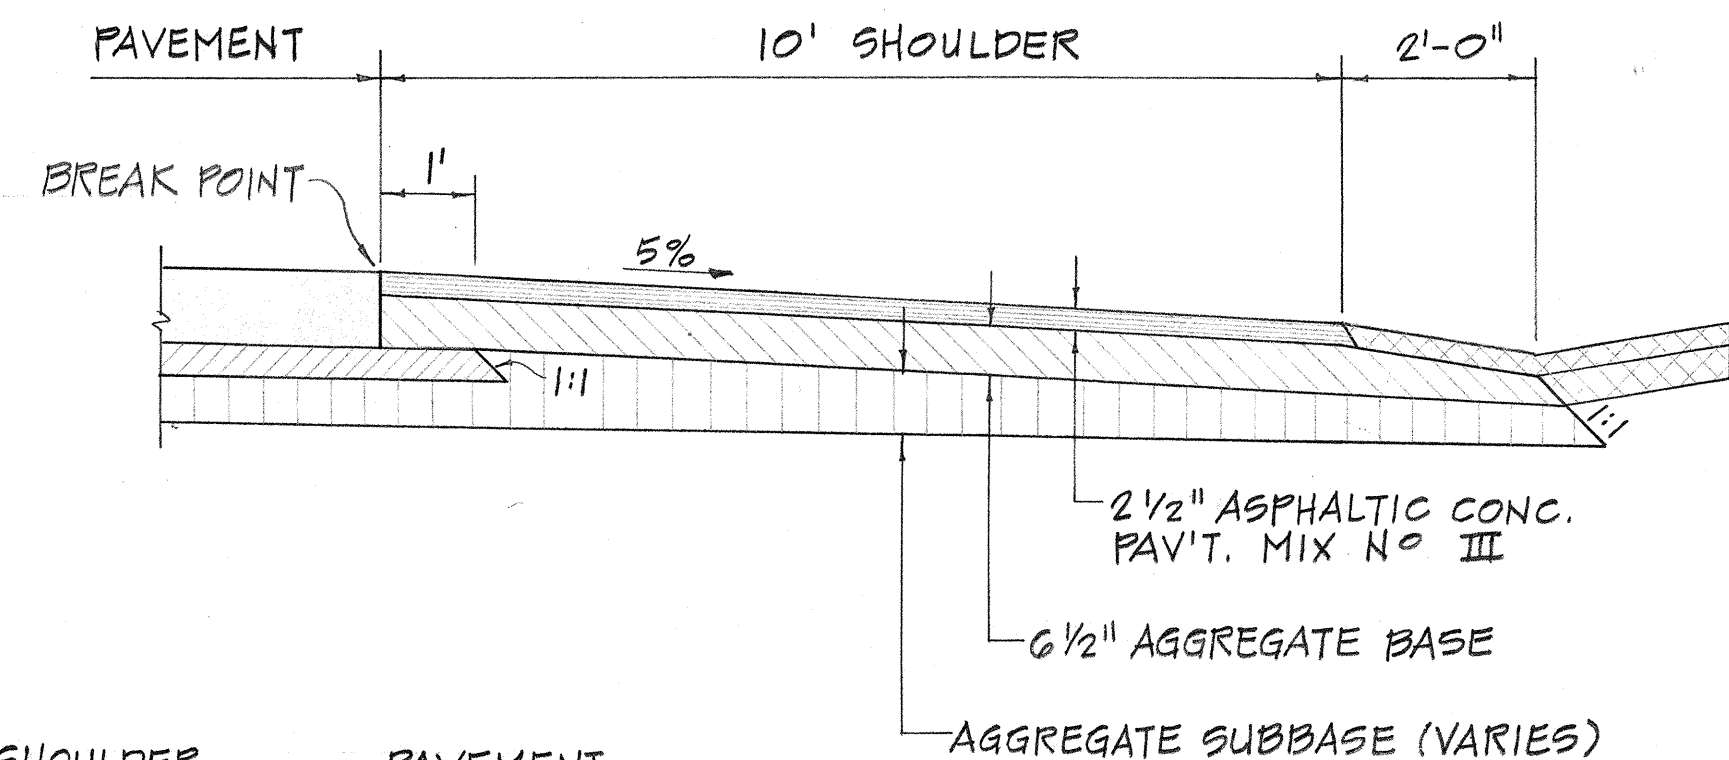


SCALE: 1/2" = 1'-0"

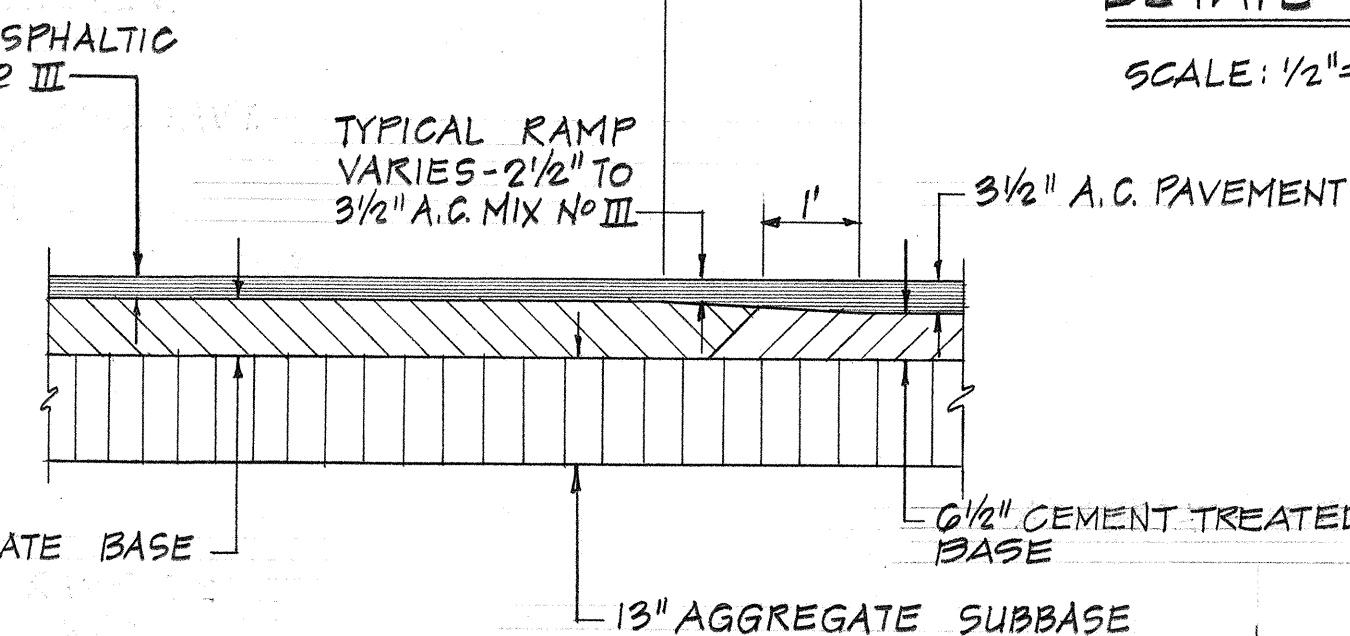

SCALE: 1/2" = 1'-0"

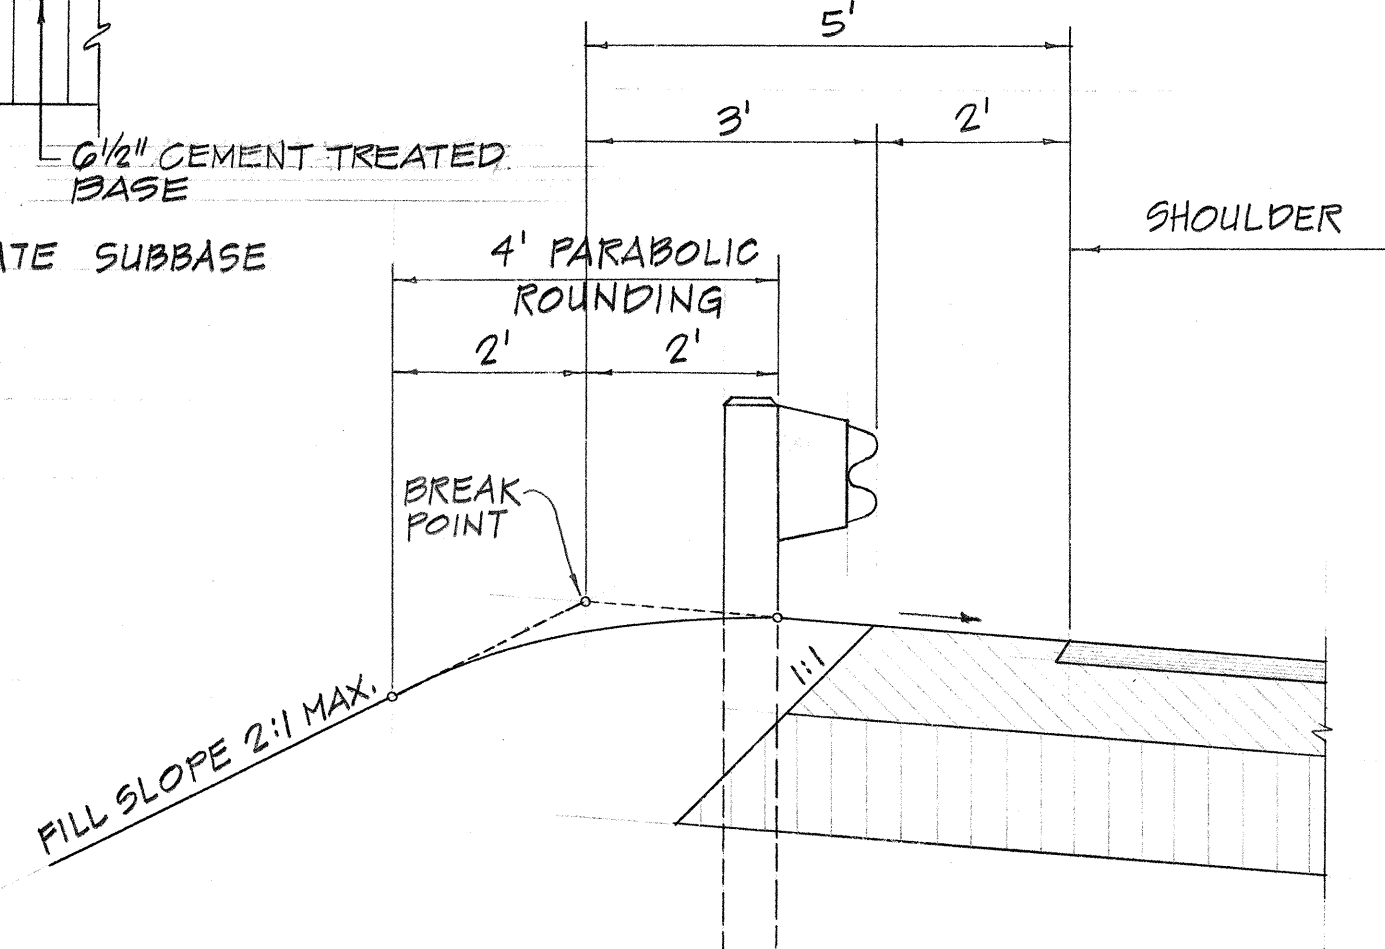


SCALE: 1/2" = 1'-0"

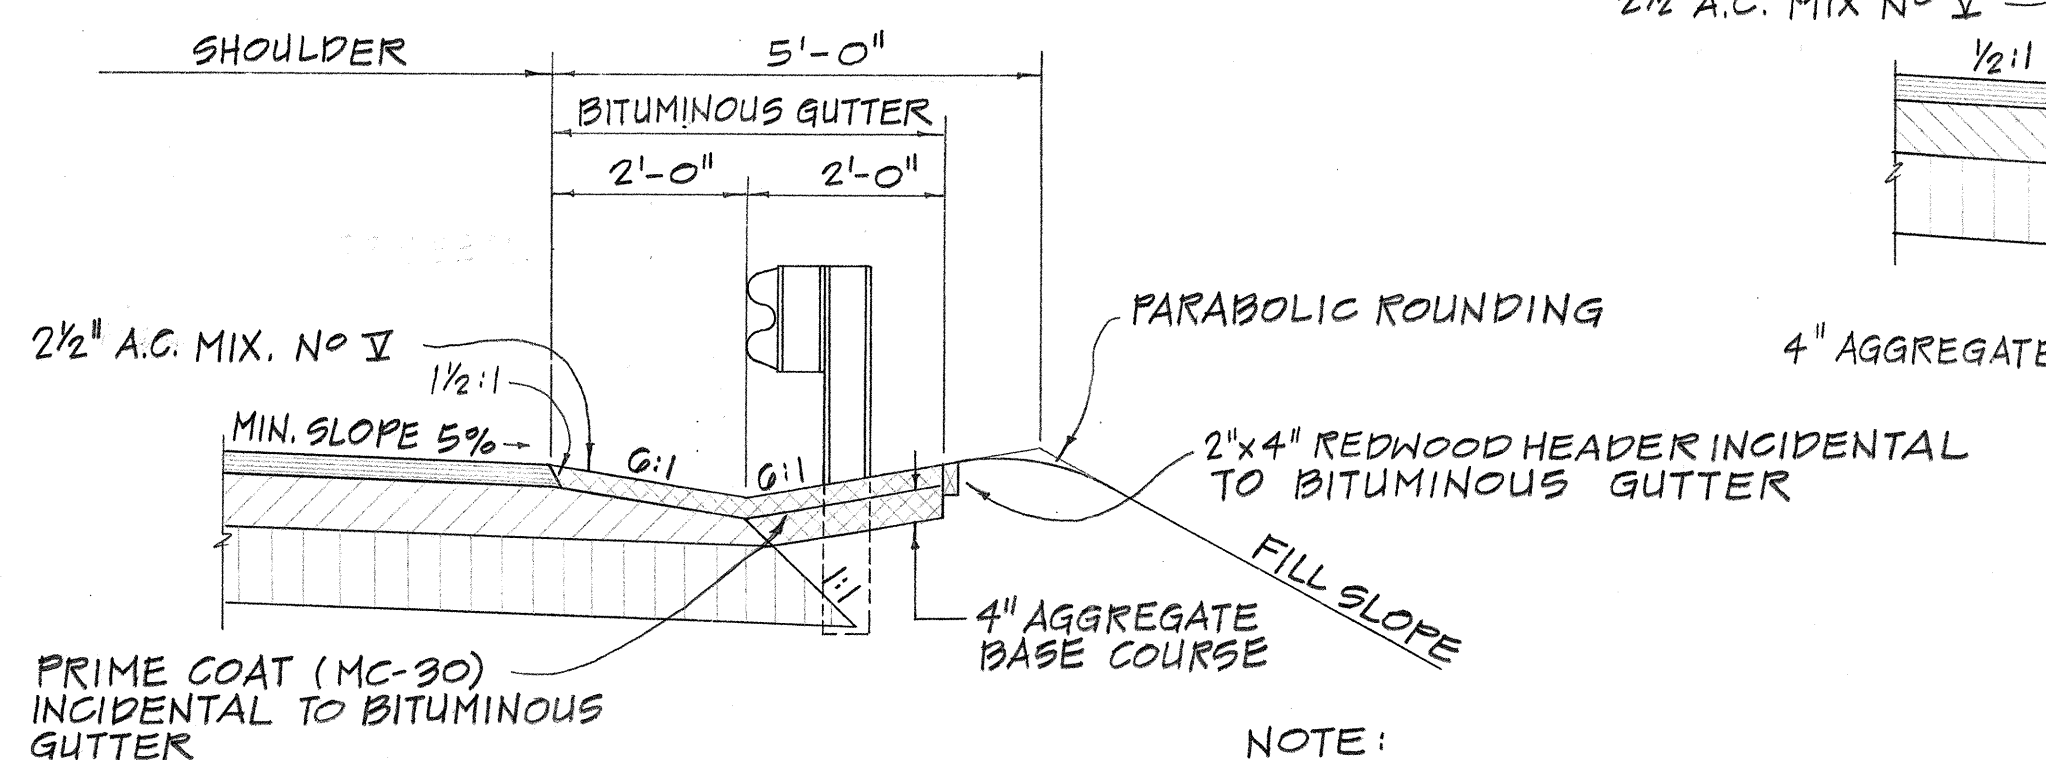


NOTE: A.C. MIX I FOR BITUMINOUS GUTTER SHALL CONFORM TO THE REQUIREMENTS OF GOOD CURB AND/OR GUTTER OF THE SPECIAL PROVISIONS.

DETAILS OF TYPE 7 BITUMINOUS GUTTER


SCALE: 1/2" = 1'-0"

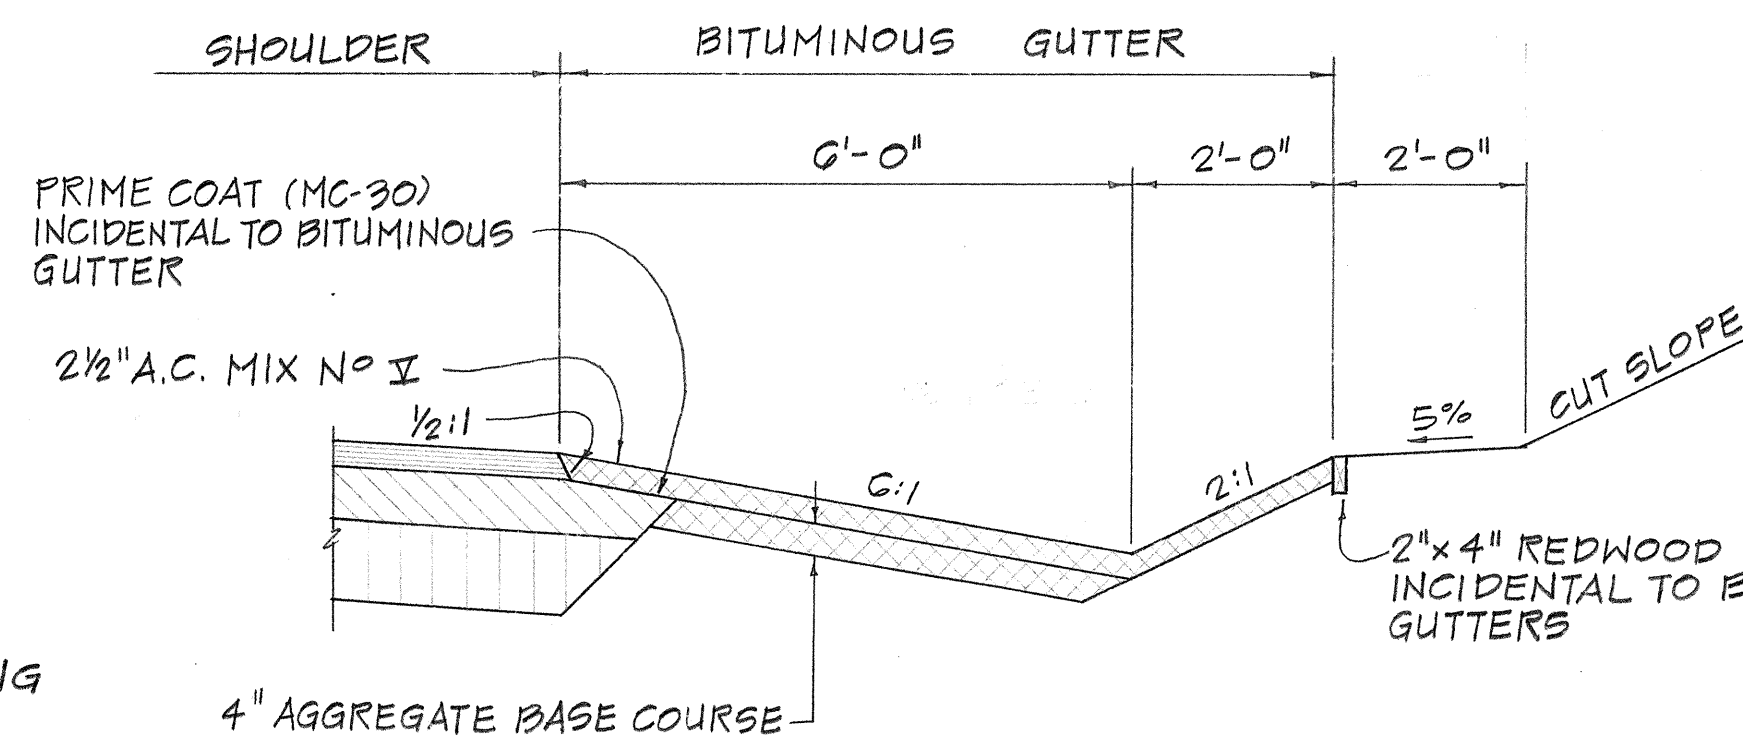

GUTTER TYPE 7(GIG18)

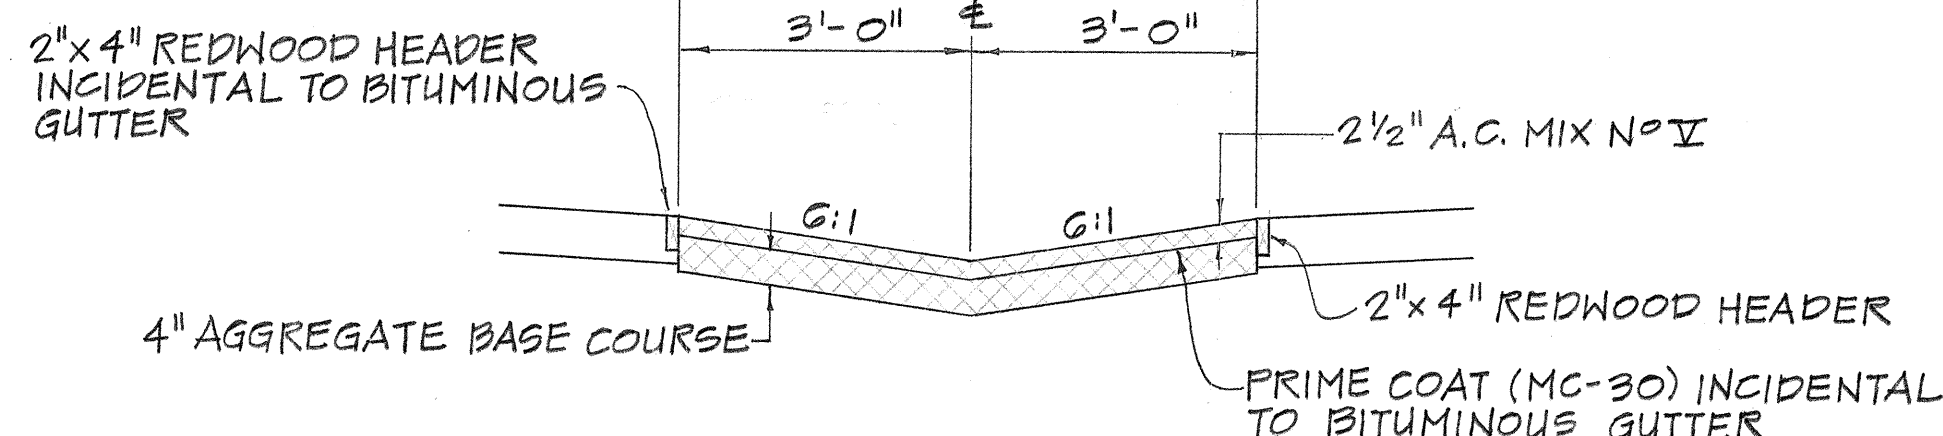

GUTTER TYPE 7(GIG16)

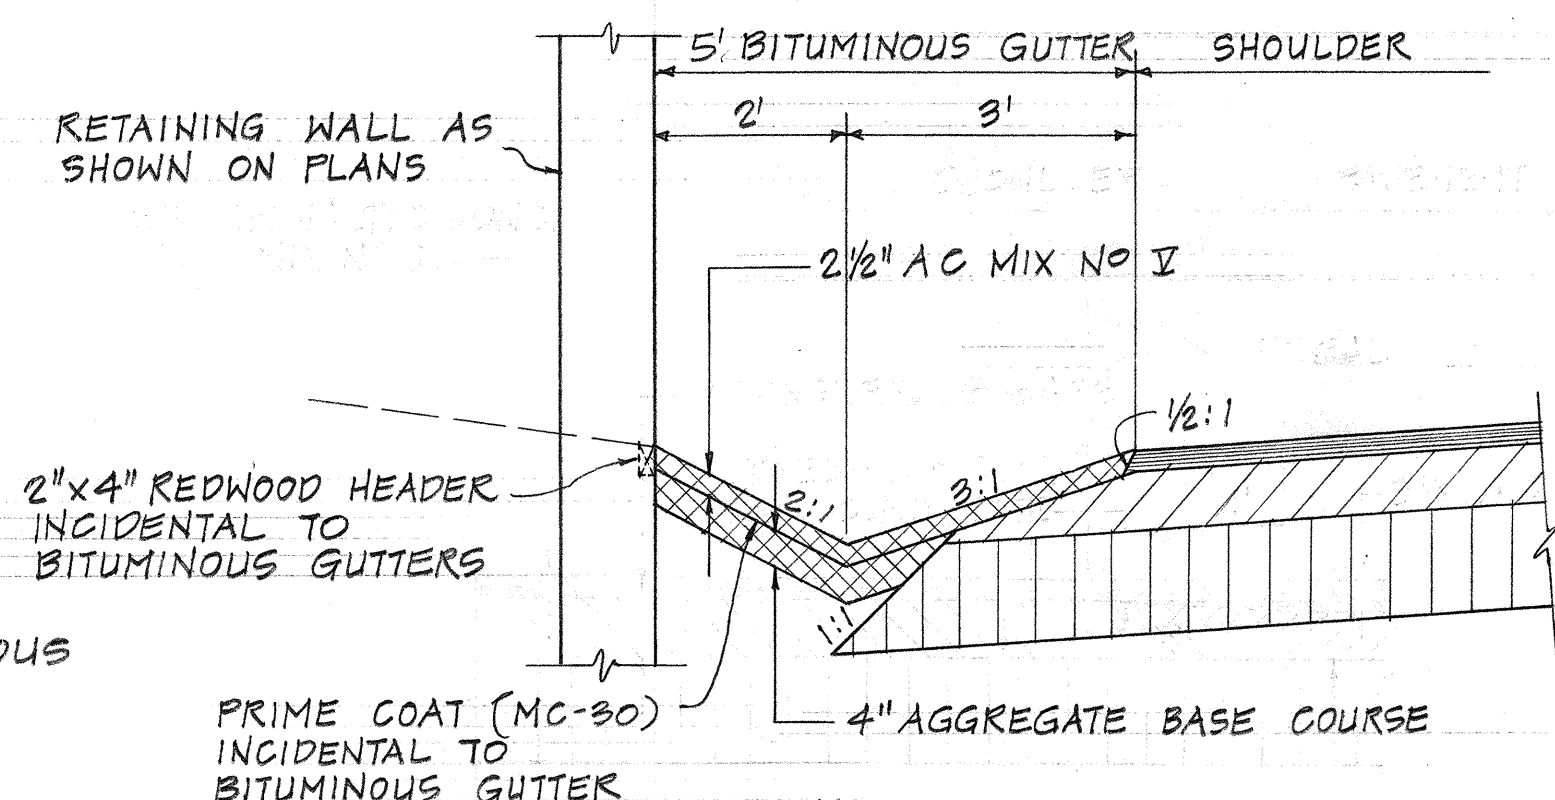

GUTTER TYPE 7(GIG15)

SCALE: 1/2" = 1'-0"

CLARENCE K. TANONAKA
REGISTERED PROFESSIONAL ENGINEER
No. 1464-E
STATE OF HAWAII

AUSTIN, YEE & PARK
(A JOINT VENTURE)
745 FORT STREET, HONOLULU, HAWAII

DES. E.A. DR. B.M. CHK. C.T.

Clarence K. Tanonaka
THIS WORK WAS PREPARED BY ME OR UNDER MY SUPERVISION

Donald W. Park
APPROVED FOR JOINT VENTURE

STATE OF HAWAII
DEPARTMENT OF TRANSPORTATION
HIGHWAYS DIVISION

TYPICAL ROADWAY SECTIONS AND MISCELLANEOUS DETAILS

WAIHAWA INTERCHANGE

F.A.I. Project No. I-H2-(11)-7

Scale: As shown Date: 4-25-73

SHEET No. 3 OF 3 SHEETS