



FED. ROAD DIST. NO.	STATE	FED. AID PROJ. NO.	FISCAL YEAR	SHEET NO.	TOTAL SHEETS
HAWAII	HAW.	I-H2-1(15):0	1974	28	54

- NOTES
1. All fill and cut slopes shall be hydromulched (with Bermuda Seeds).
 2. All eroded slopes shall be filled and dressed before hydromulching.
 3. All unpaved gutters shall be hydromulched (with Bermuda Seeds).
 4. For additional requirements, see Section 641- Hydromulch Seeding, of the Special Provisions.

EROSION CONTROL		
Legend	Description	Estimated Quantity (Sq. Ft.)
————	Fill Slope	95,788
-----	Cut Slope	105,608
	TOTAL	201,396

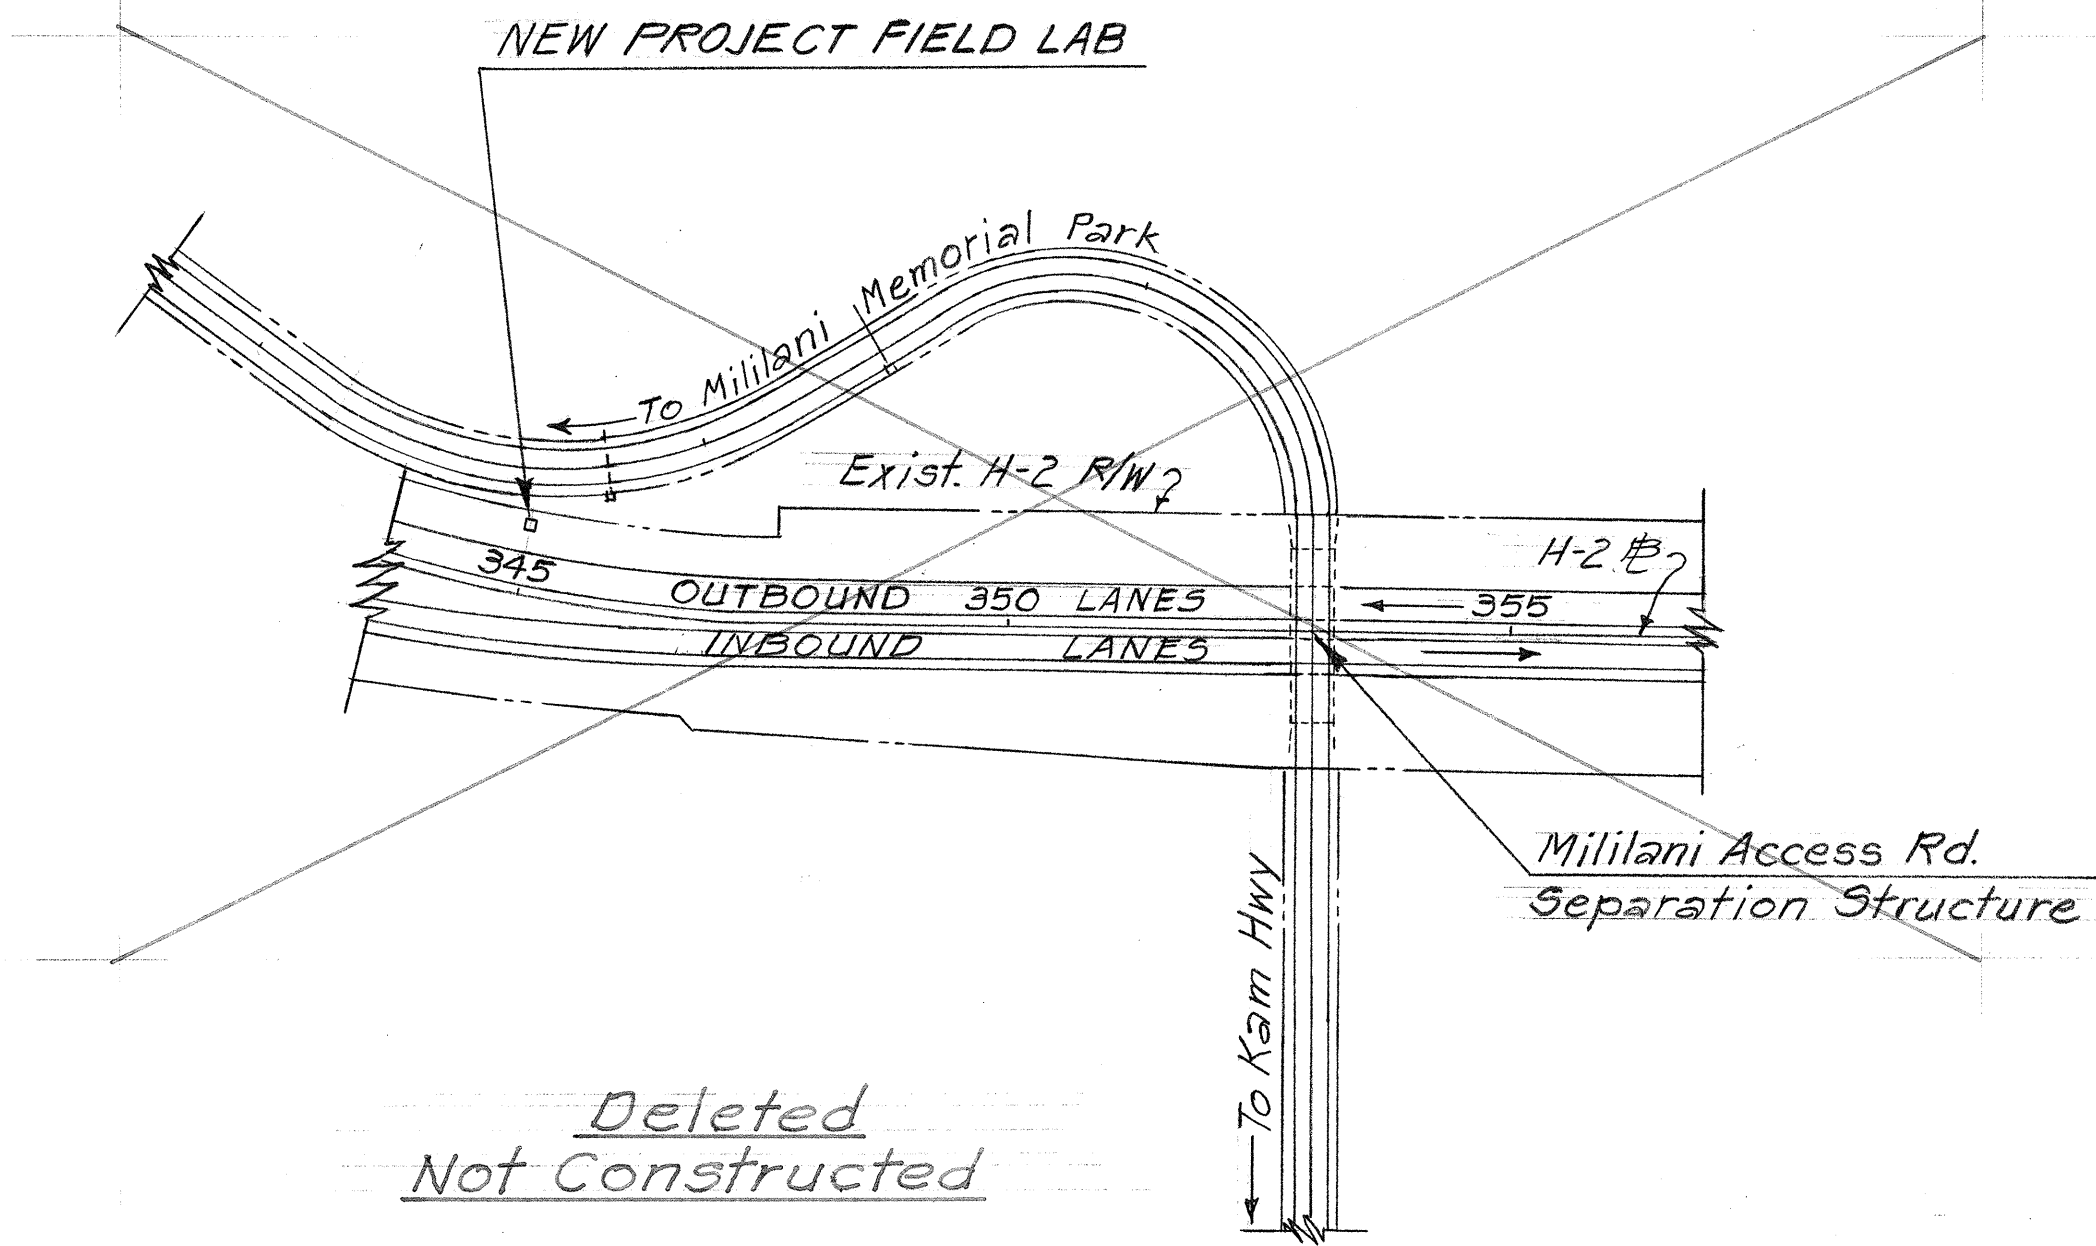

PROJECT FIELD LAB LOCATION
Scale: 1" = 200'

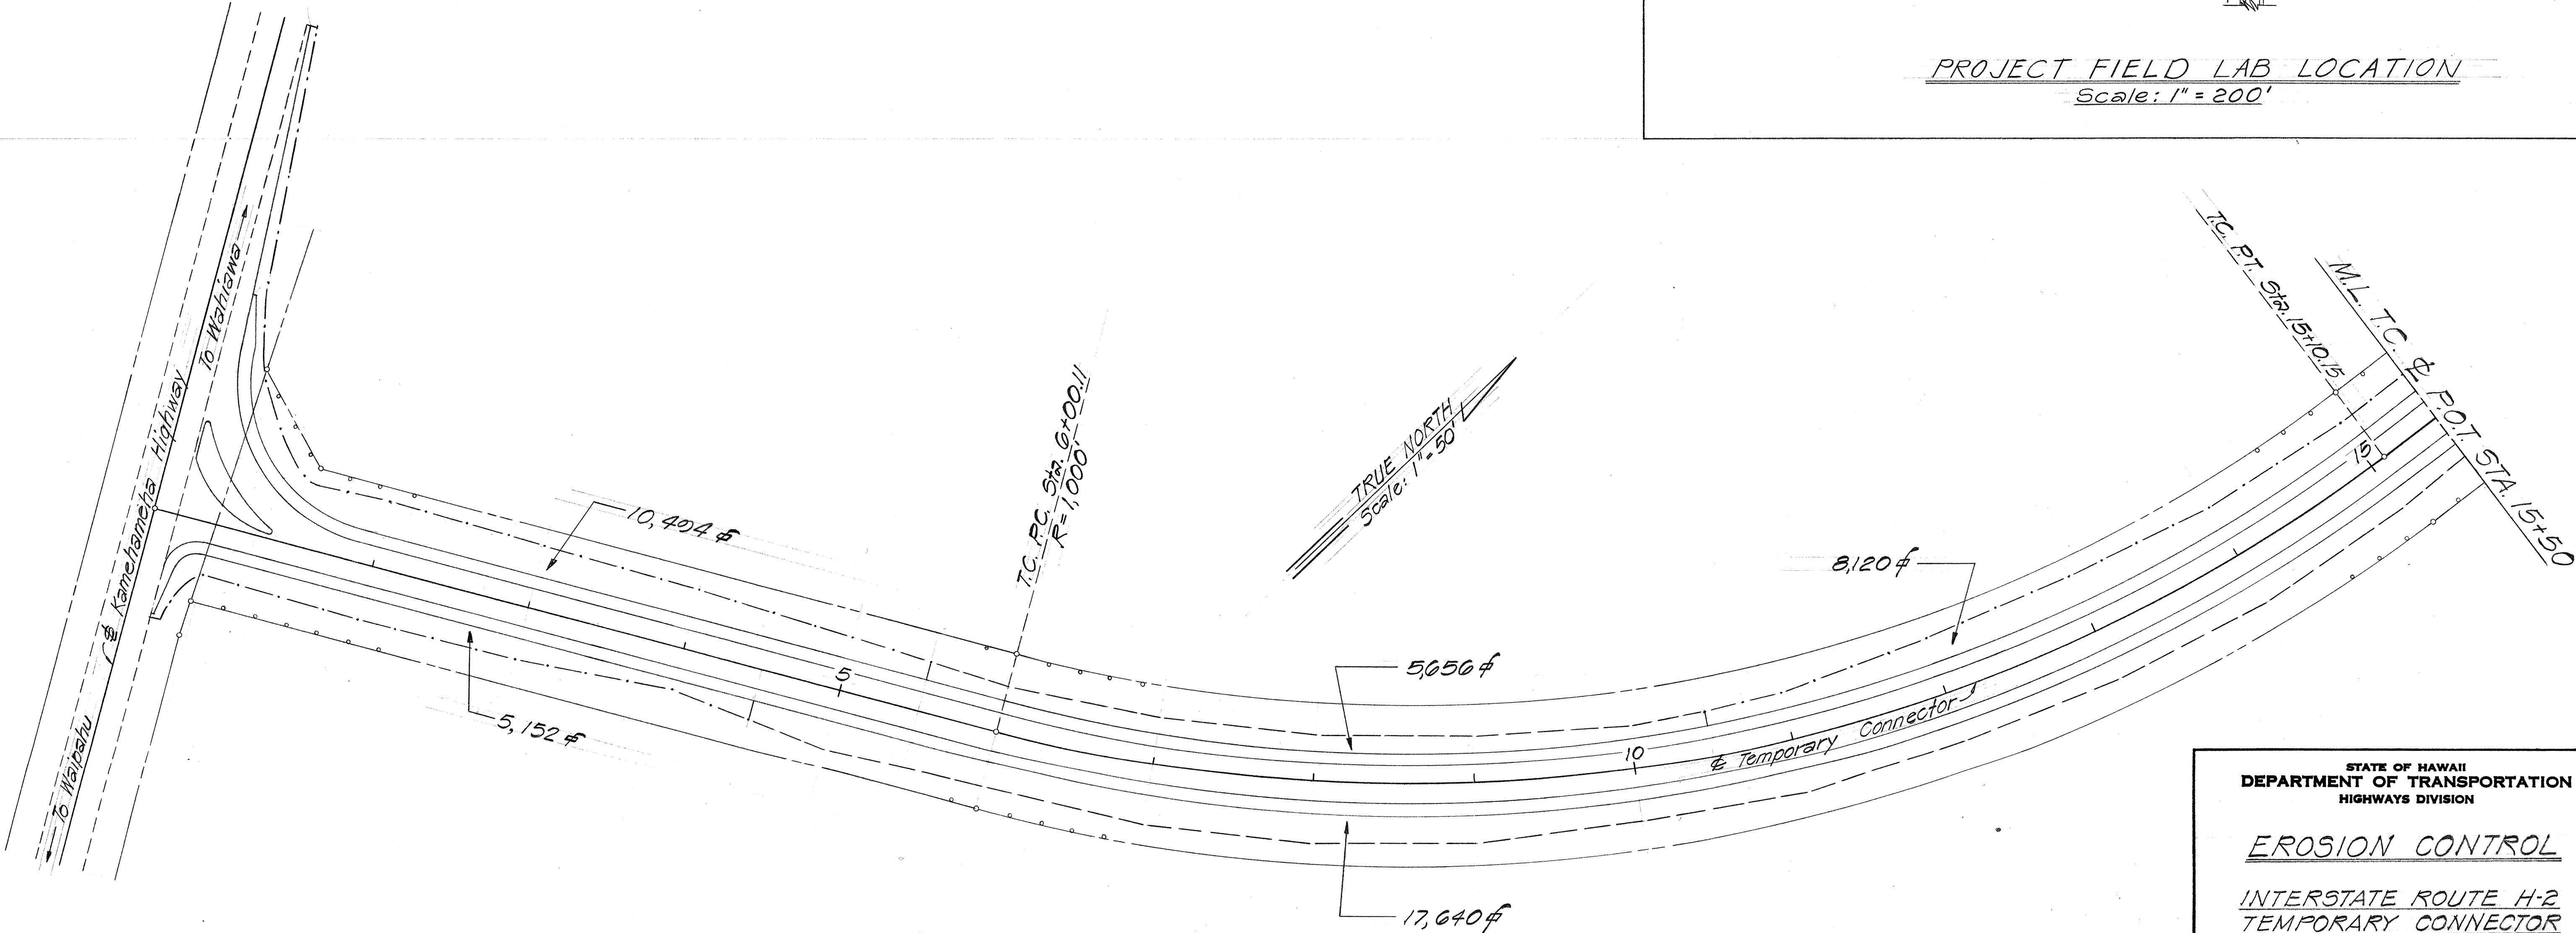


STATE OF HAWAII
DEPARTMENT OF TRANSPORTATION
HIGHWAYS DIVISION

EROSION CONTROL
INTERSTATE ROUTE H-2
TEMPORARY CONNECTOR
F.A.I. Proj. No. I-H2-1(15):0
Scale: 1"=50' Date: April, 1974
SHEET No. 1 OF 3 SHEETS


ORIGINAL PLAN	DATE
DESIGNED BY	
TRACED BY	
NOTE BOOK	
QUANTITIES BY	
CHECKED BY	
No.	

FED. ROAD DIST. NO.	STATE	FED. AID PROJ. NO.	FISCAL YEAR	SHEET NO.	TOTAL SHEETS
HAWAII	HAW.	I-H-2-1(15):0	1974	20	54

True North
Scale: 1"=50'

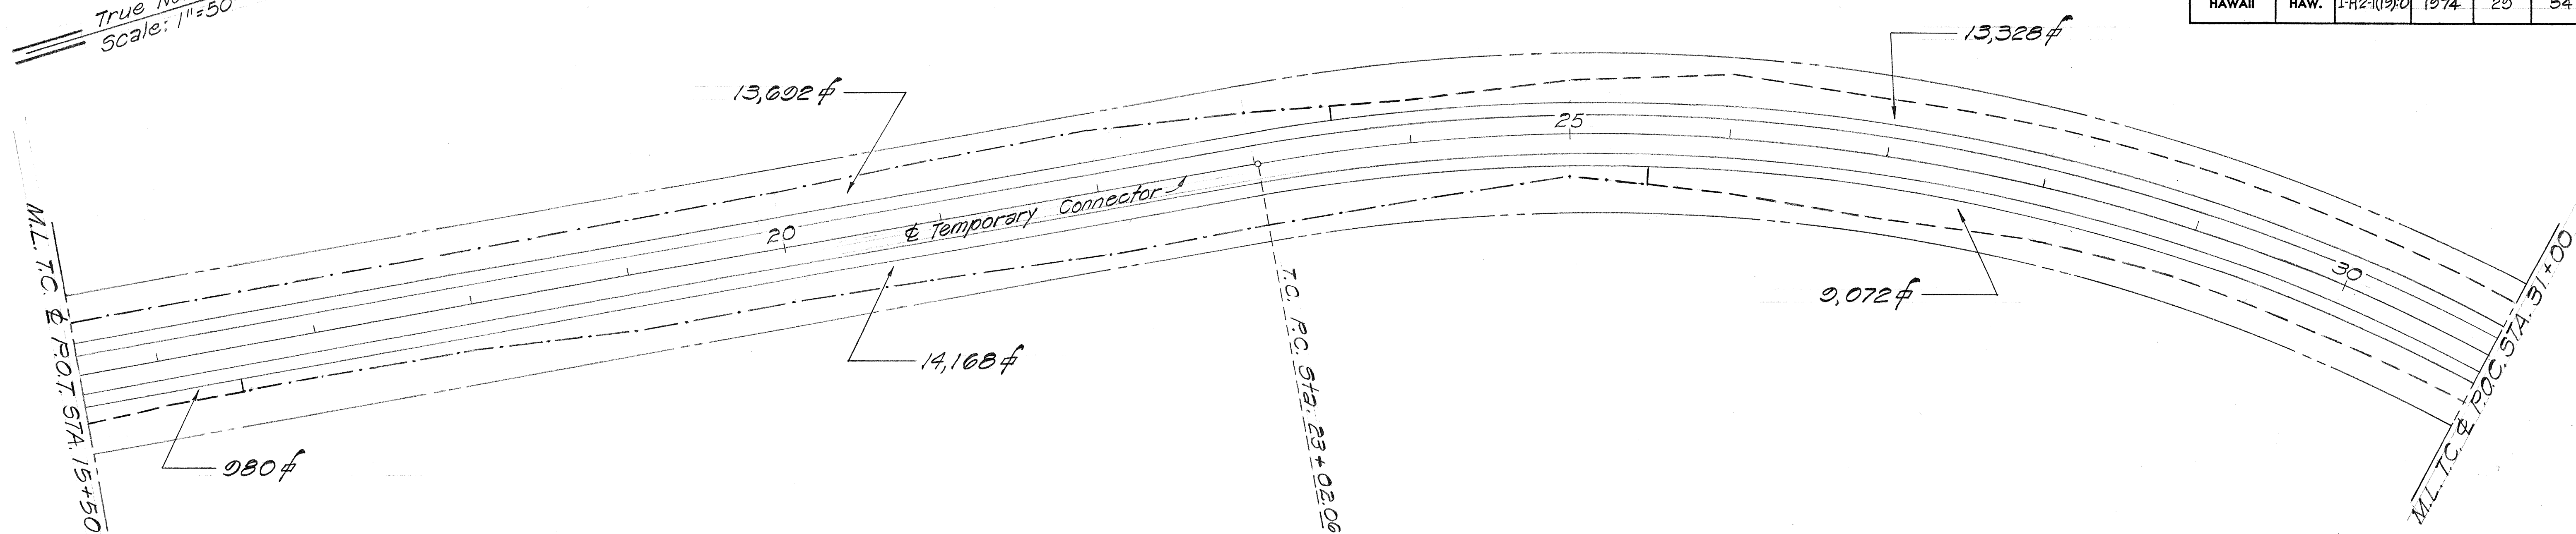

True North
Scale: 1"=50'

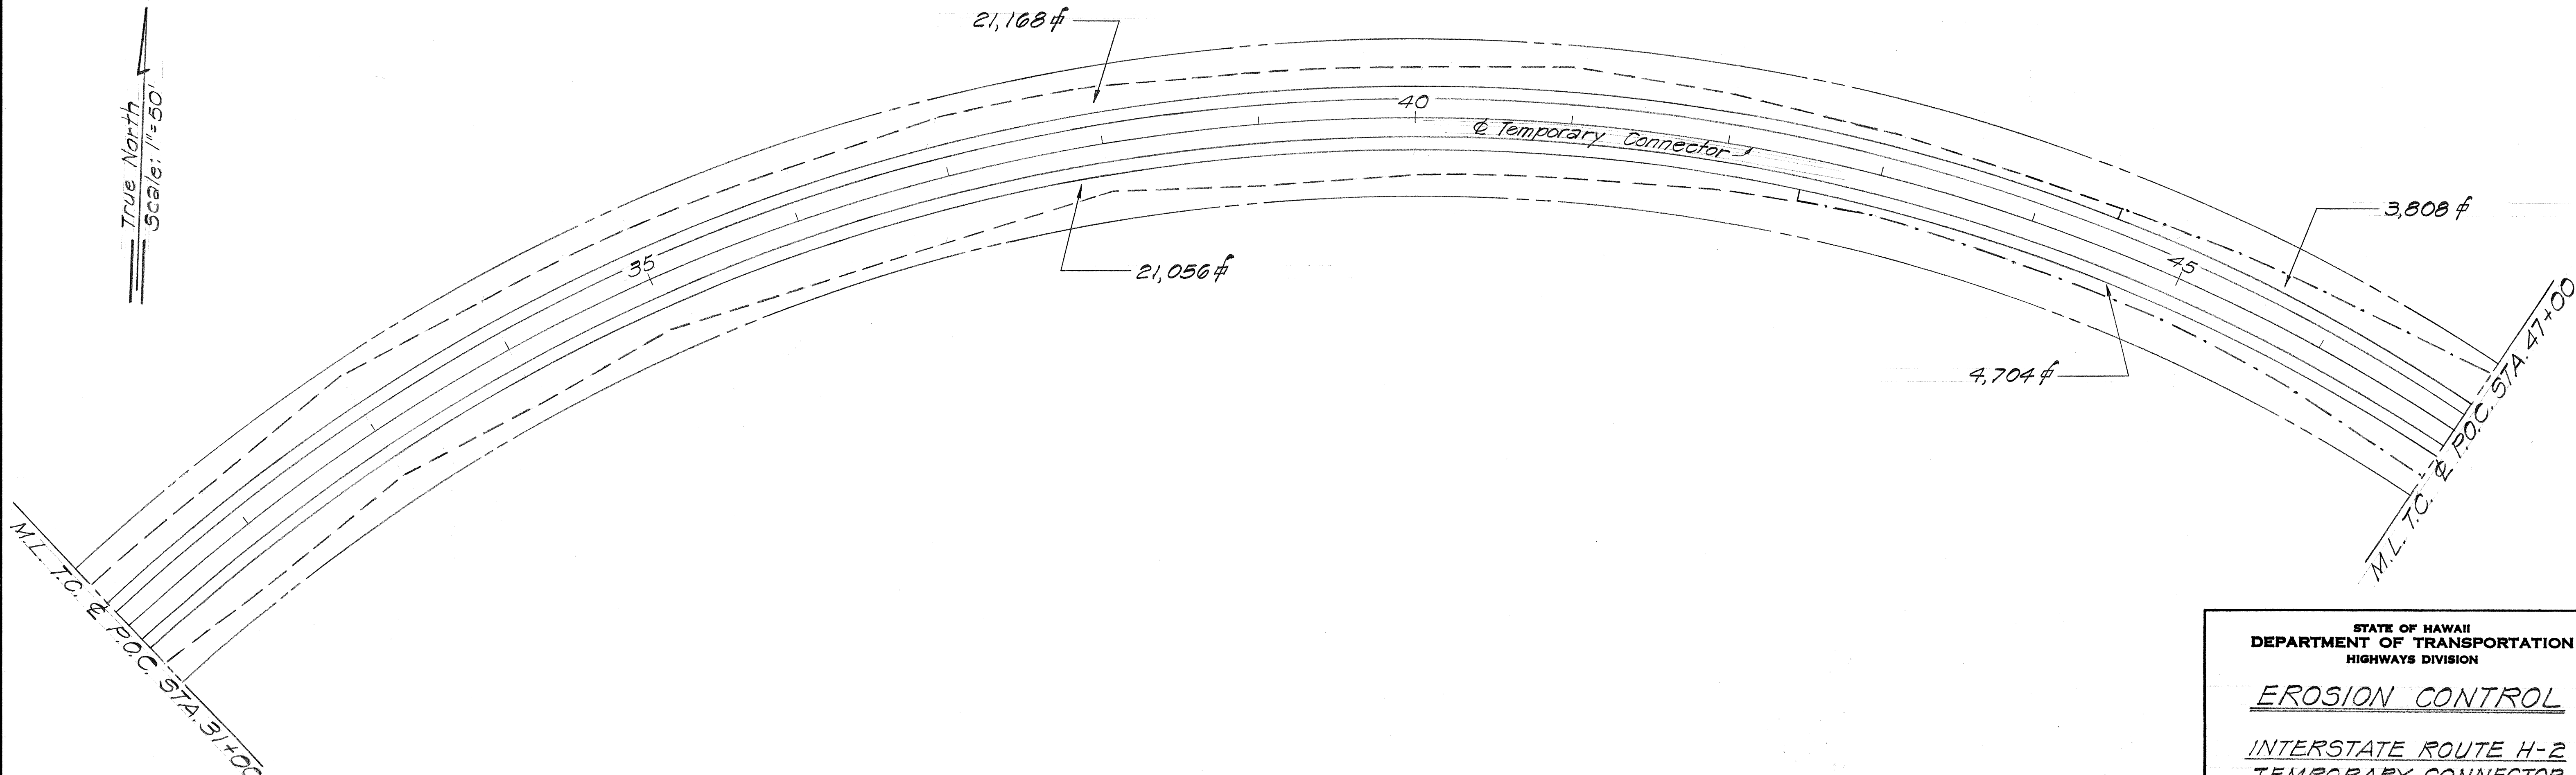

SURVEY PLOTTED BY	DATE
DESIGNED BY	
TRACED BY	
NOTED BY	
CHECKED BY	

STATE OF HAWAII
DEPARTMENT OF TRANSPORTATION
HIGHWAYS DIVISION
EROSION CONTROL
INTERSTATE ROUTE H-2
TEMPORARY CONNECTOR
F.A.I. Proj. No. I-H-2-1(15):0
Scale: 1"=50' Date: April, 1974
SHEET No. 2 OF 3 SHEETS

K&E CRYSTALIZED PAPER

