

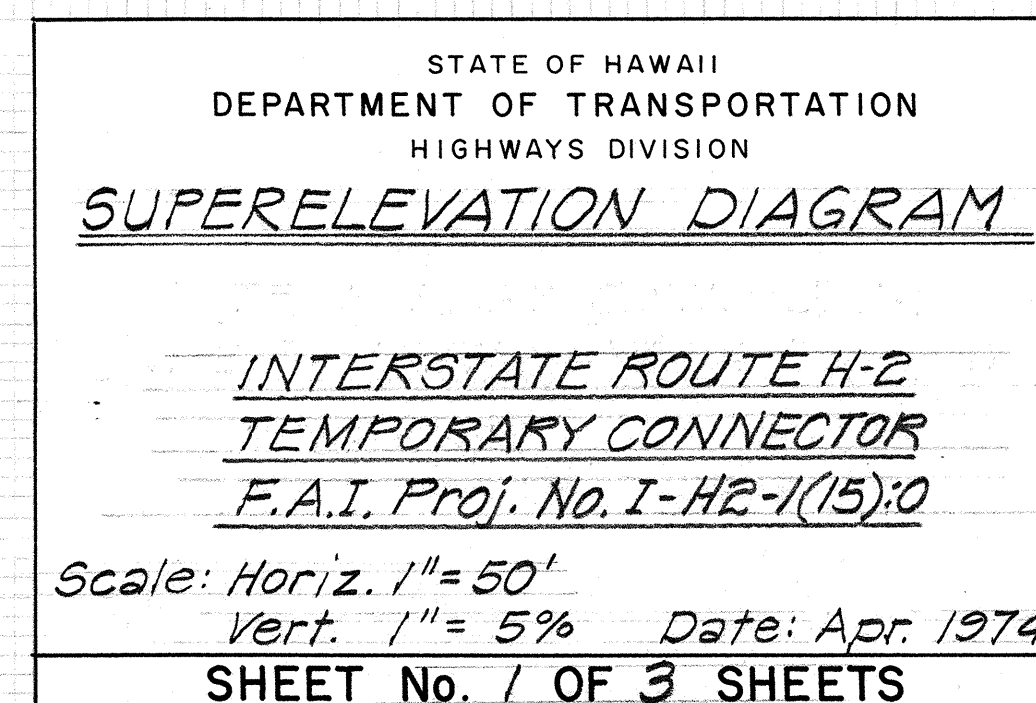
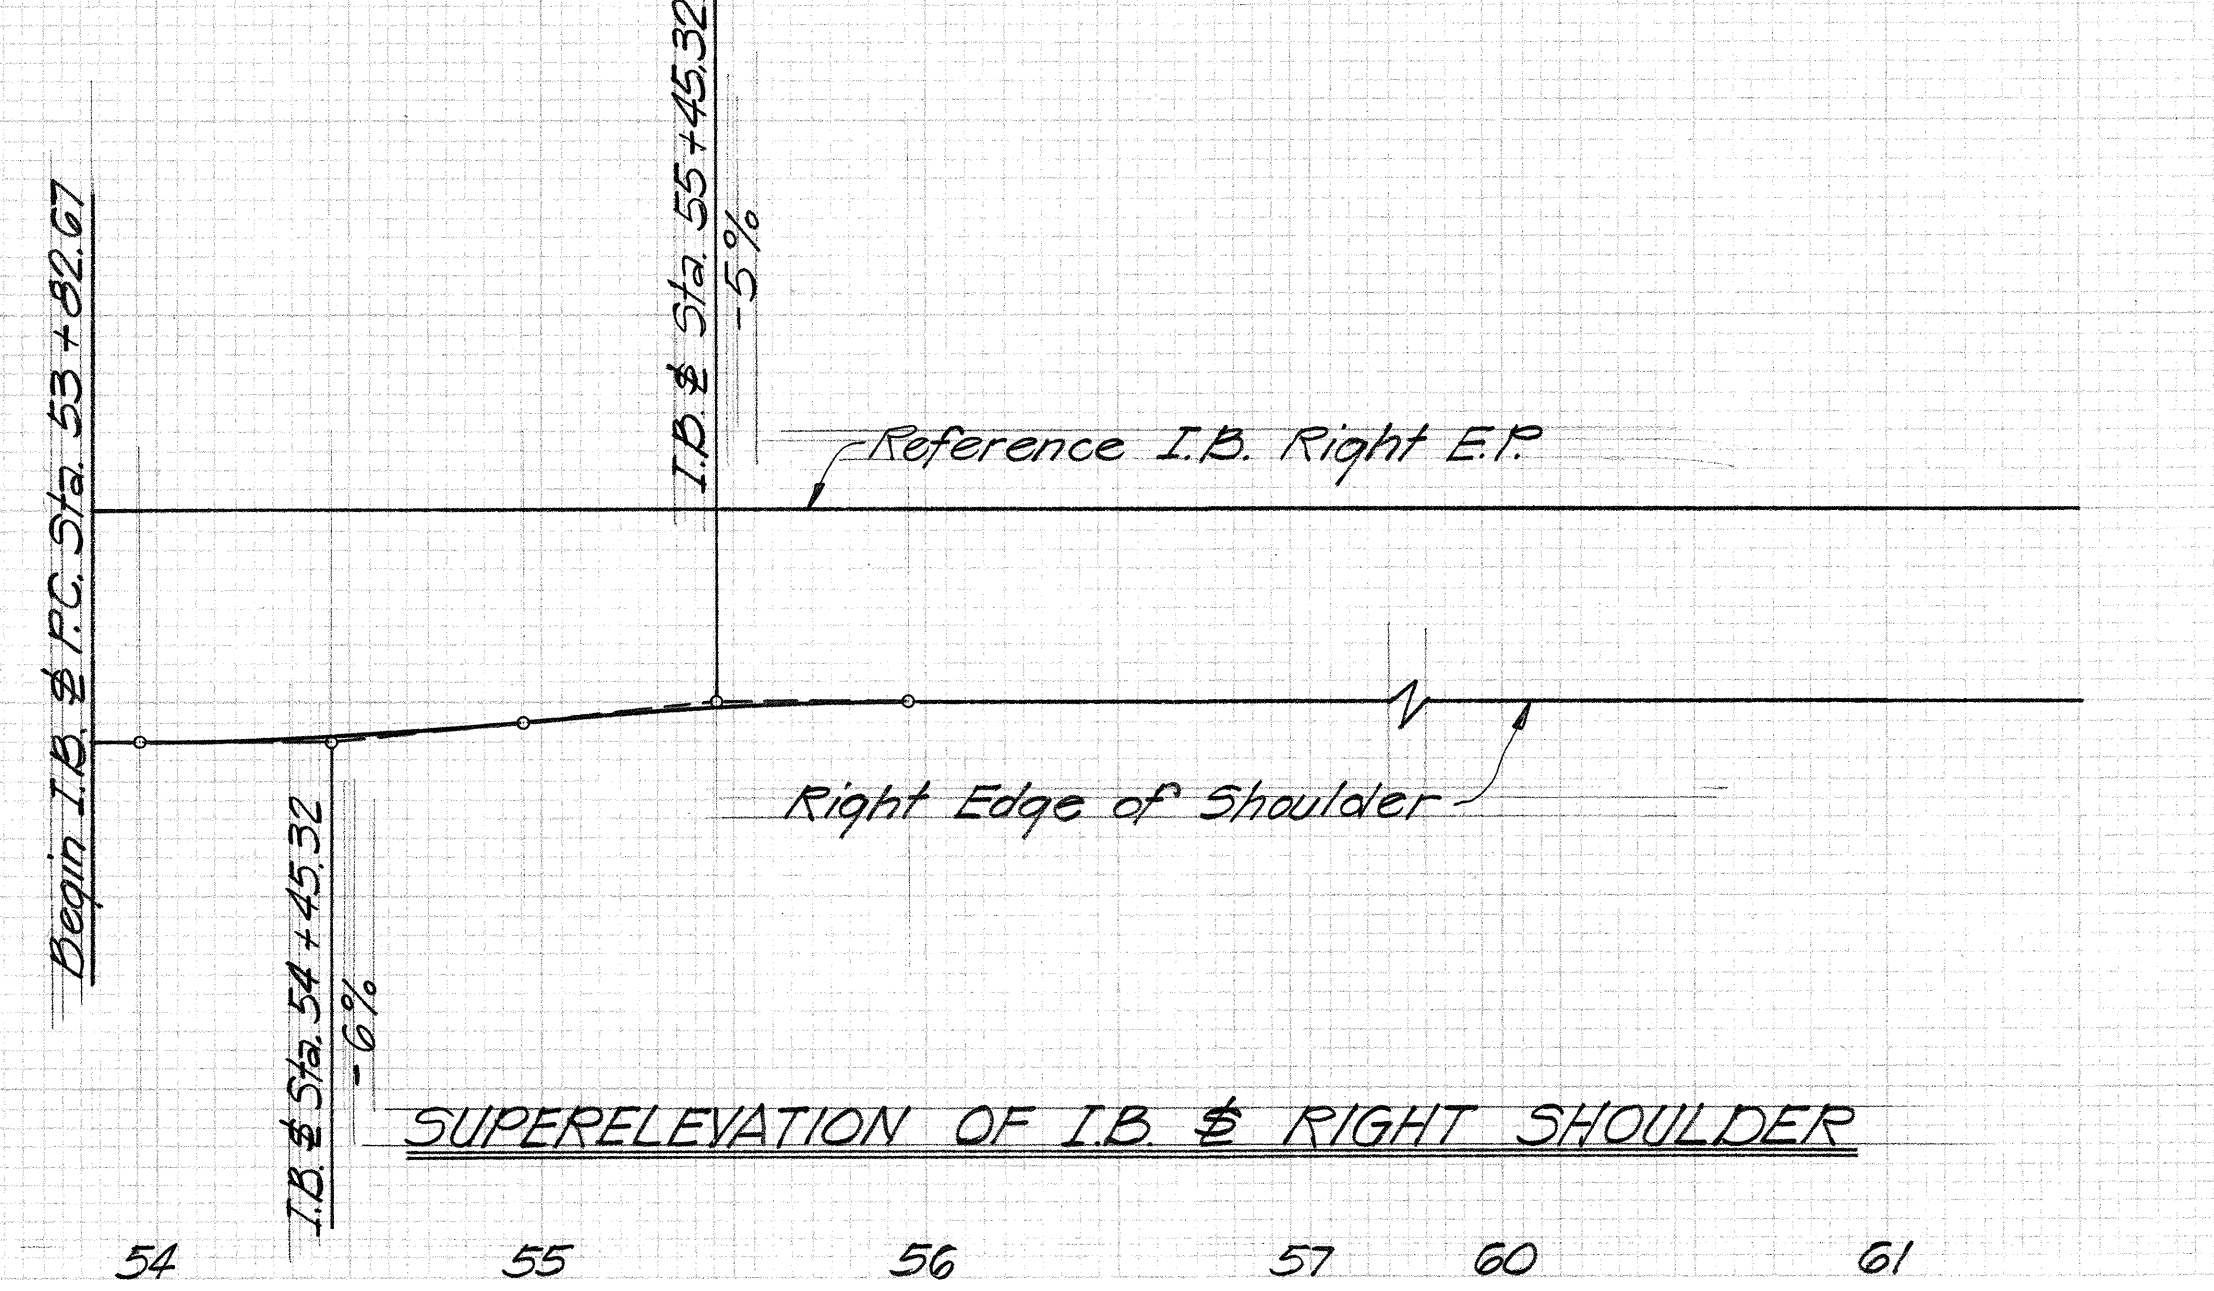
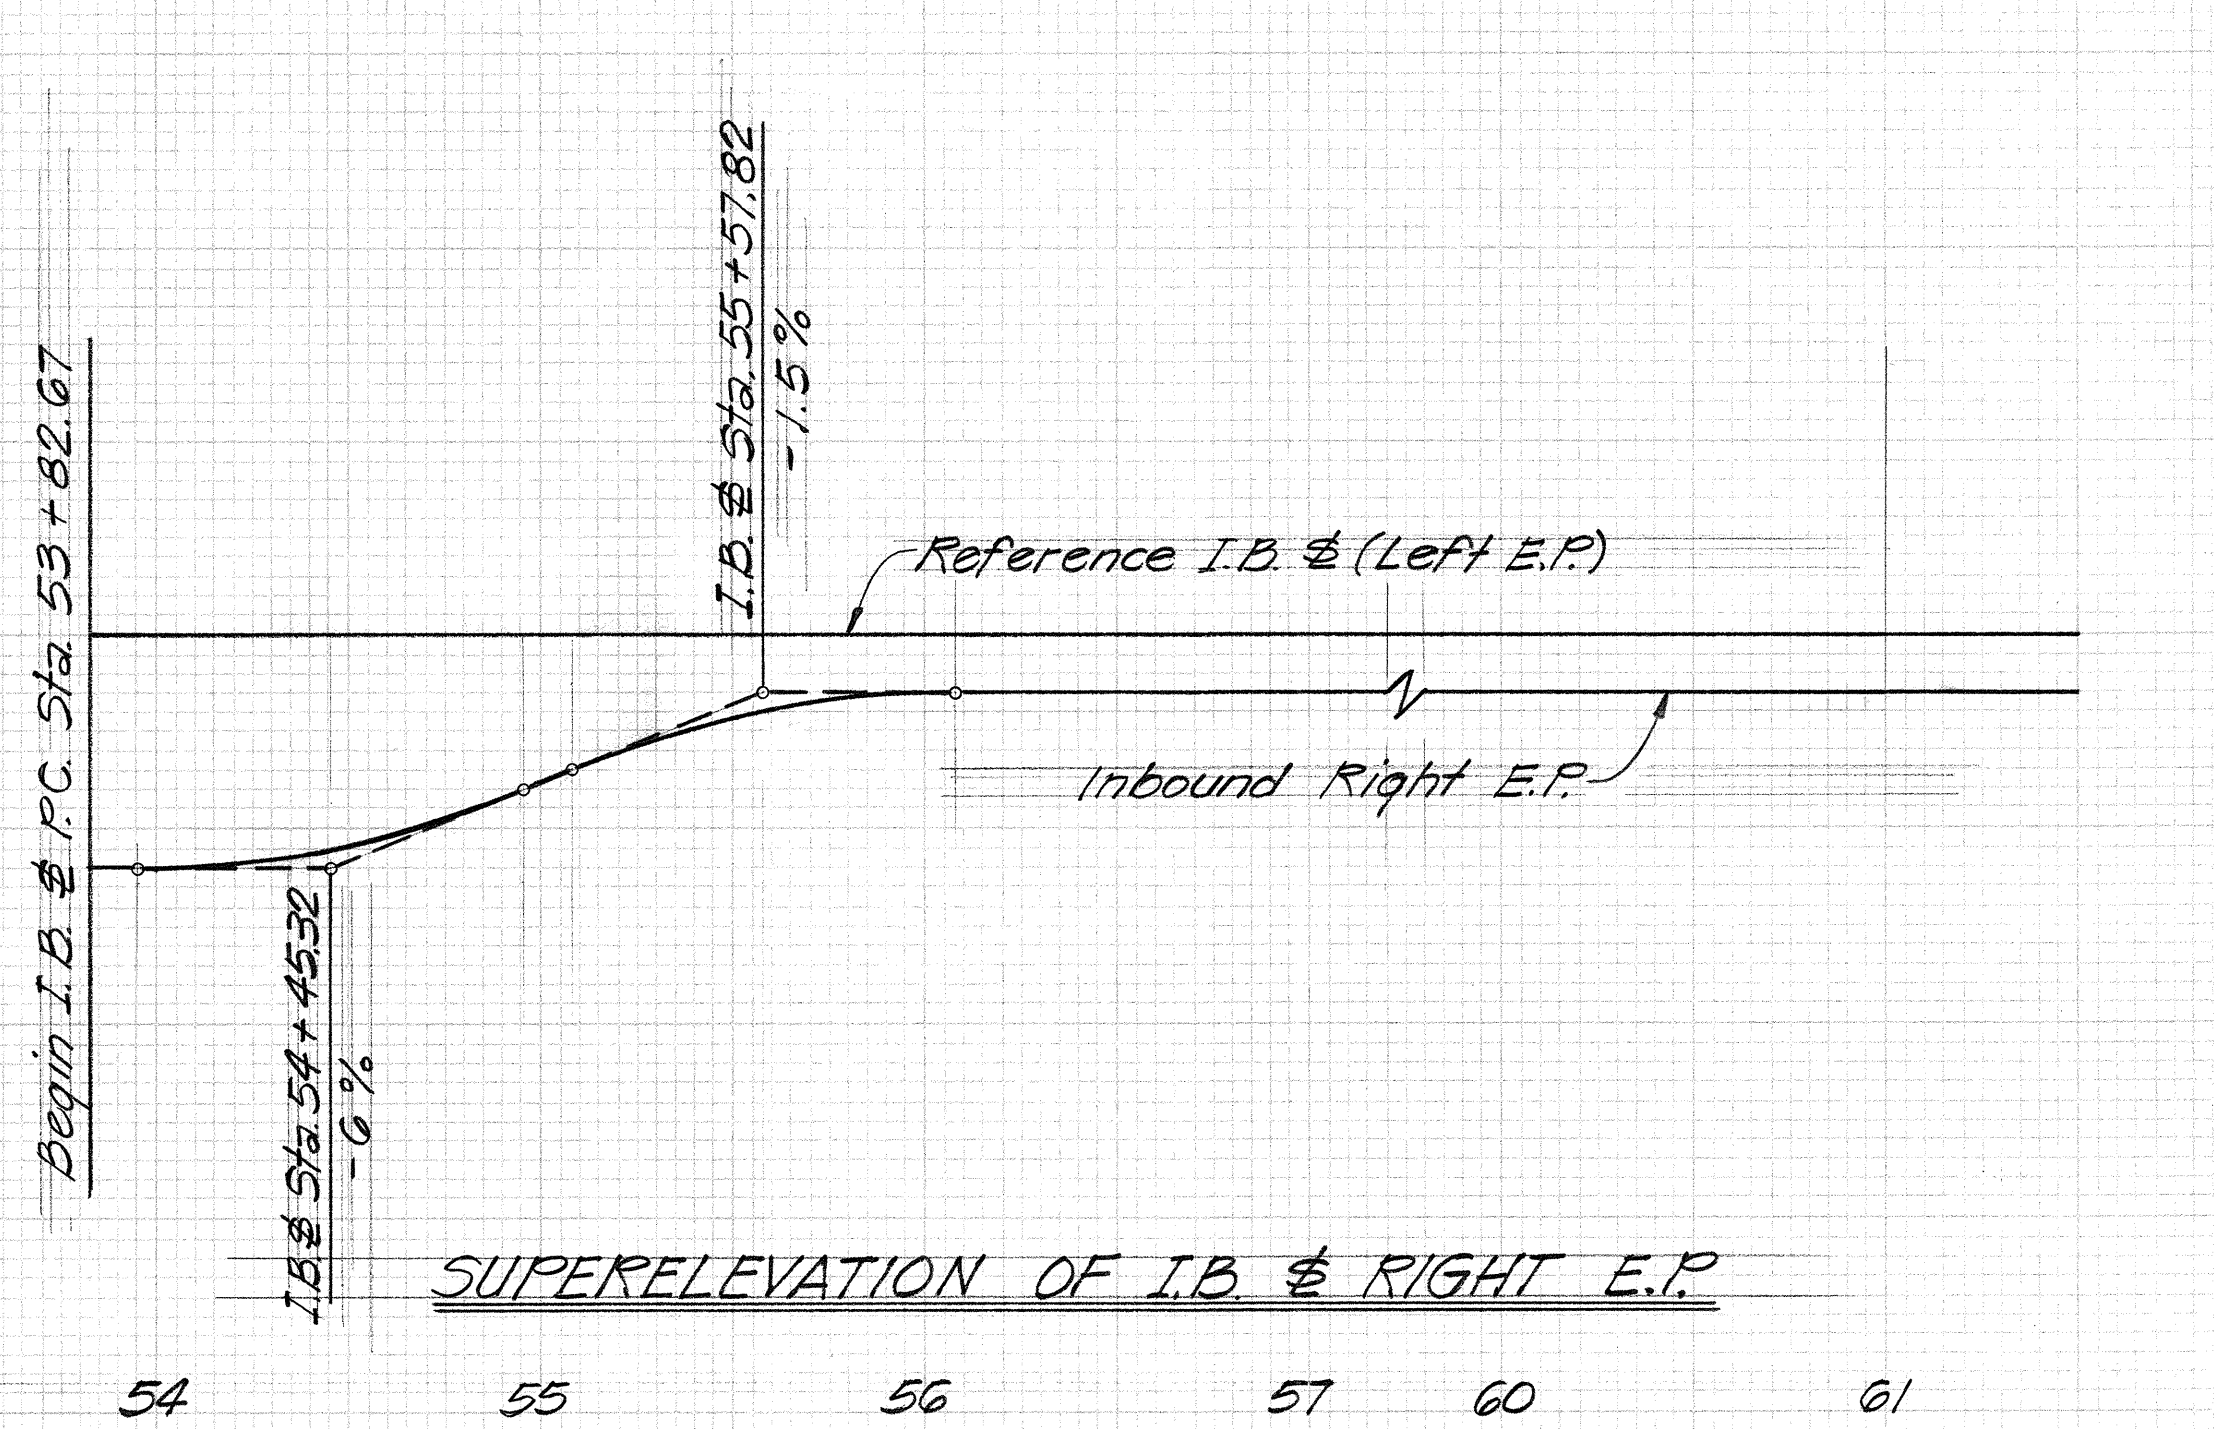
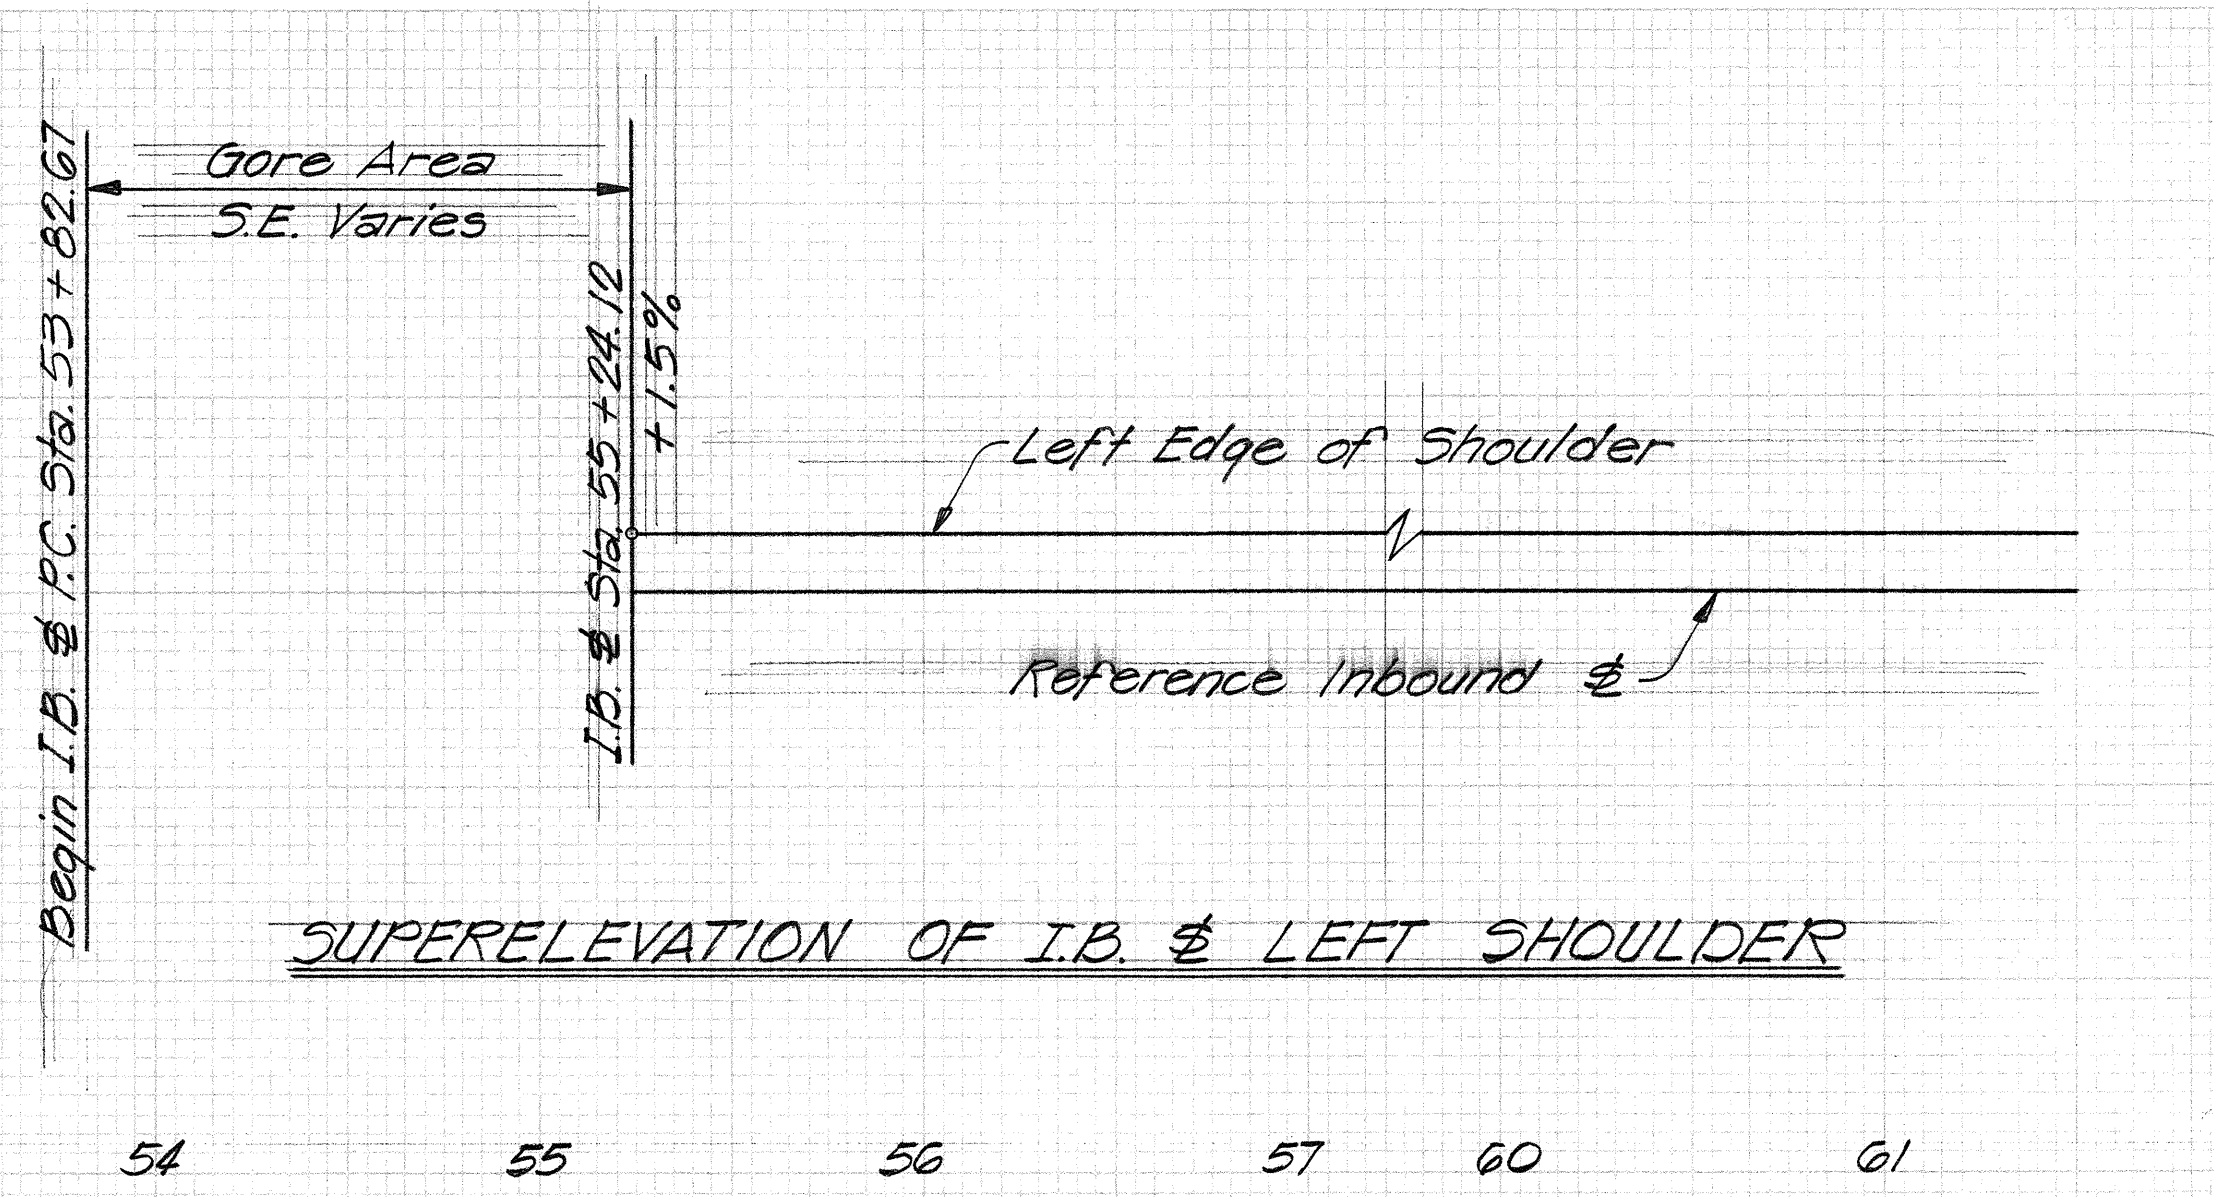
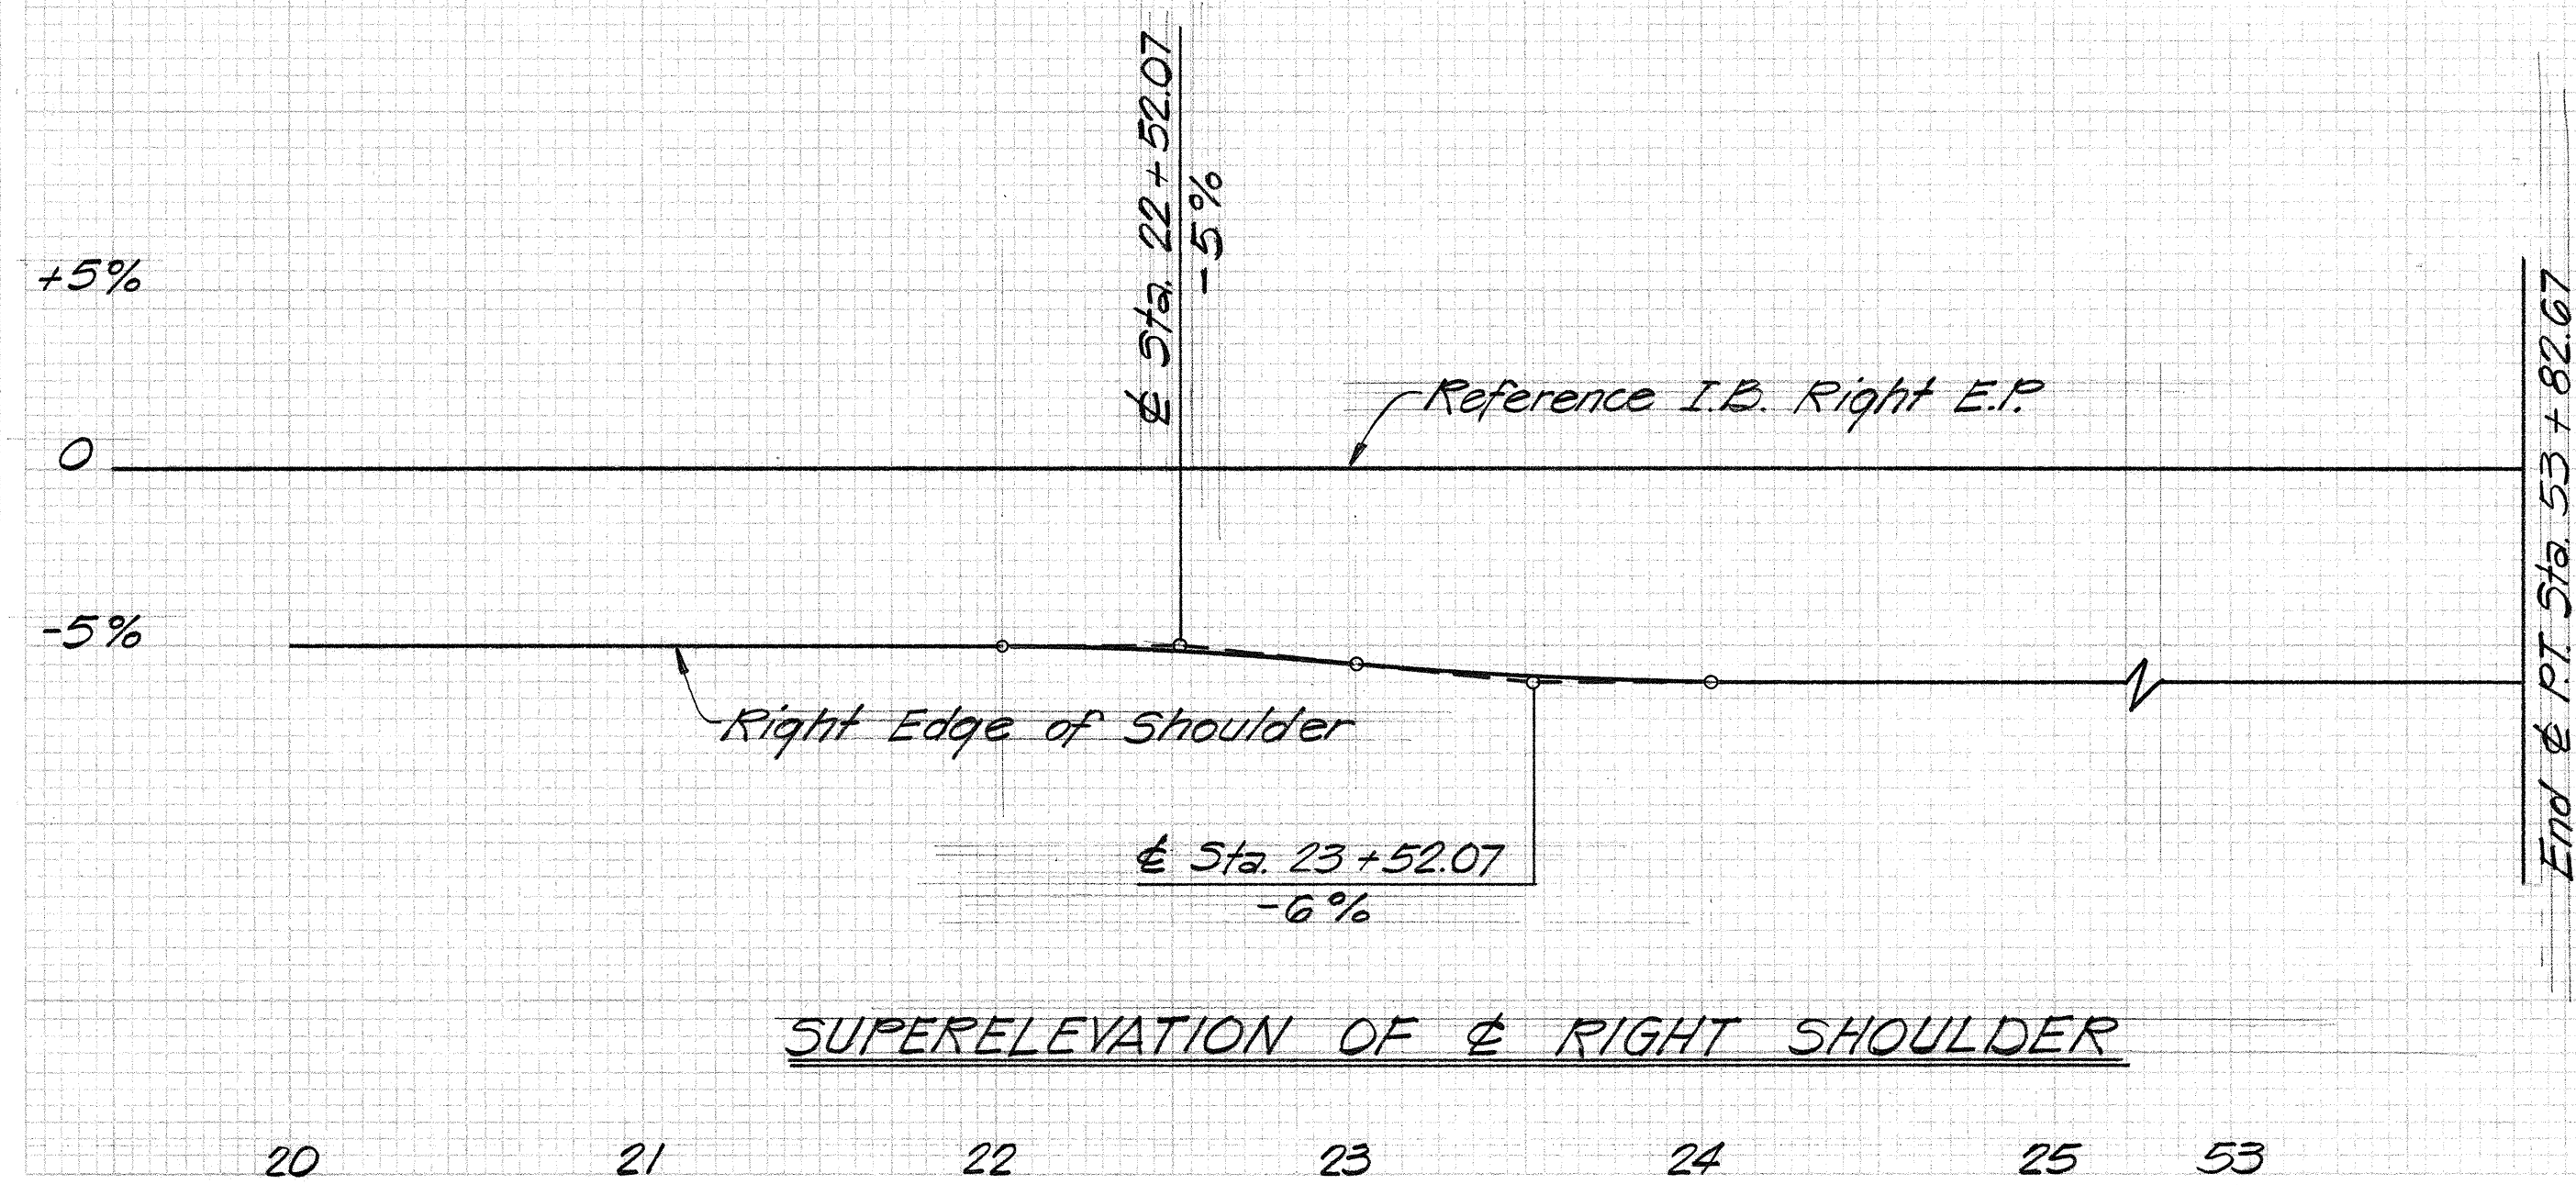


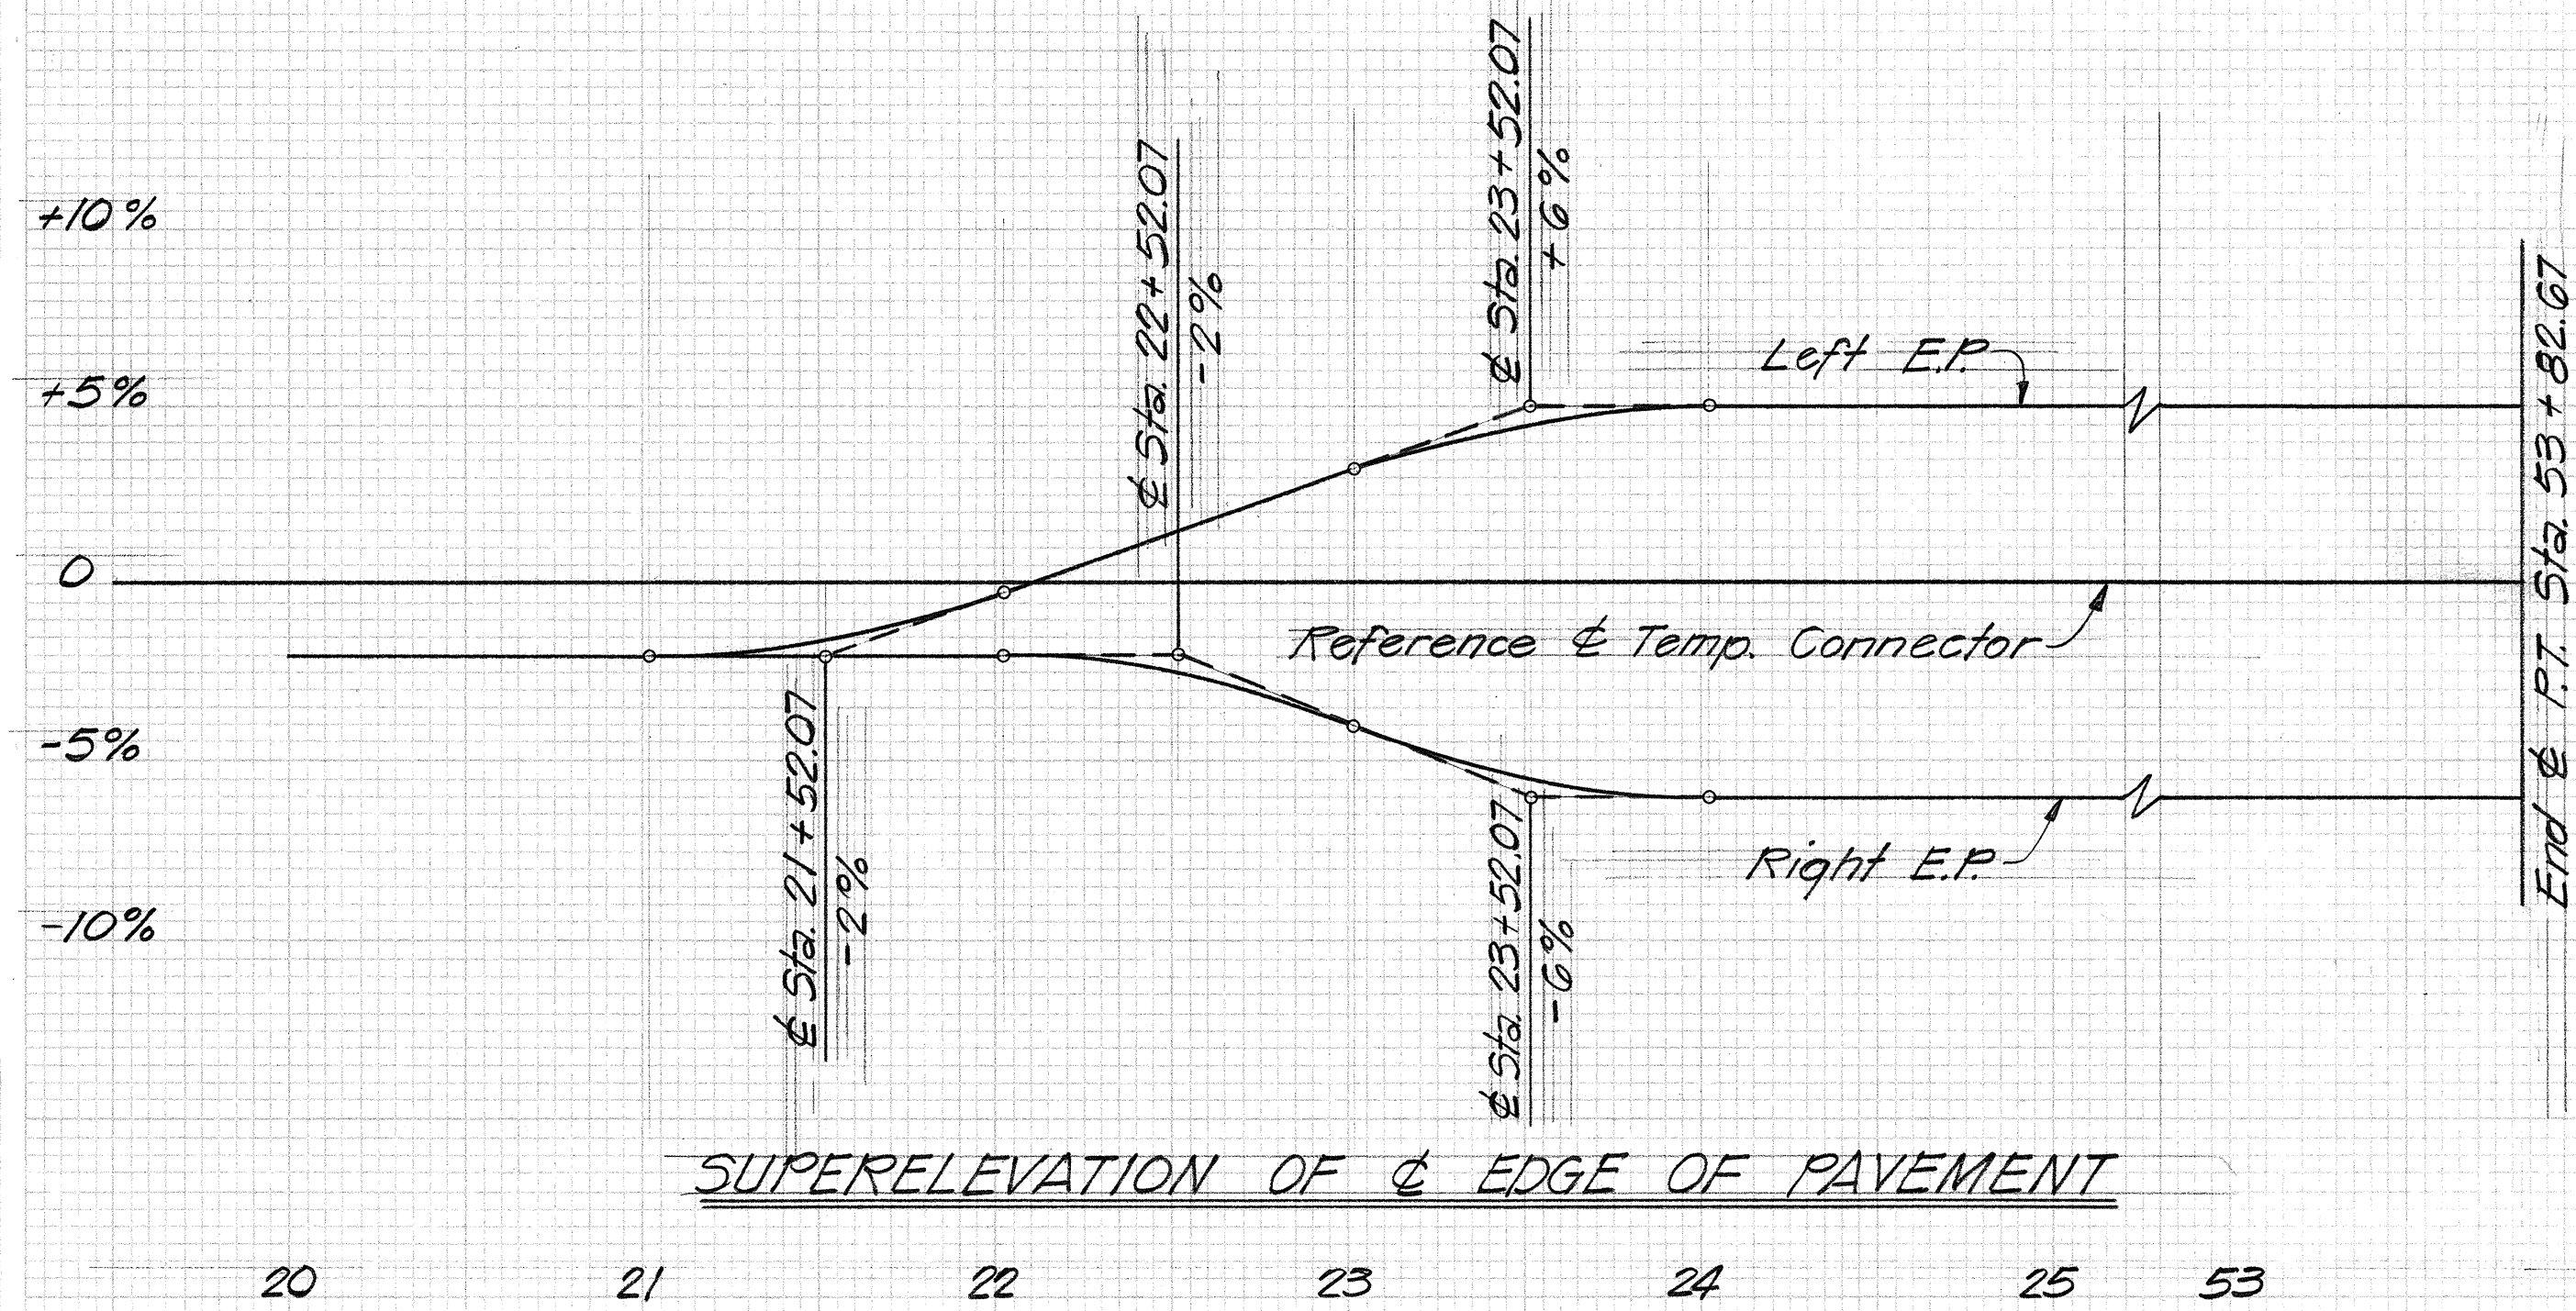

FED. ROAD DIST. NO.	STATE	FED. AID PROJ. NO.	FISCAL YEAR	SHEET NO.	TOTAL SHEETS
HAWAII	HAW.	I-H2-1(15)0	1974	10	54

ORIGINAL SURVEY	DATE
SURVEYED	
PLOTTED	
NOTE BOOK	
AREAS CHECKED	

ORIGINAL SURVEY	DATE
SURVEYED	
PLOTTED	
NOTE BOOK	
AREAS CHECKED	

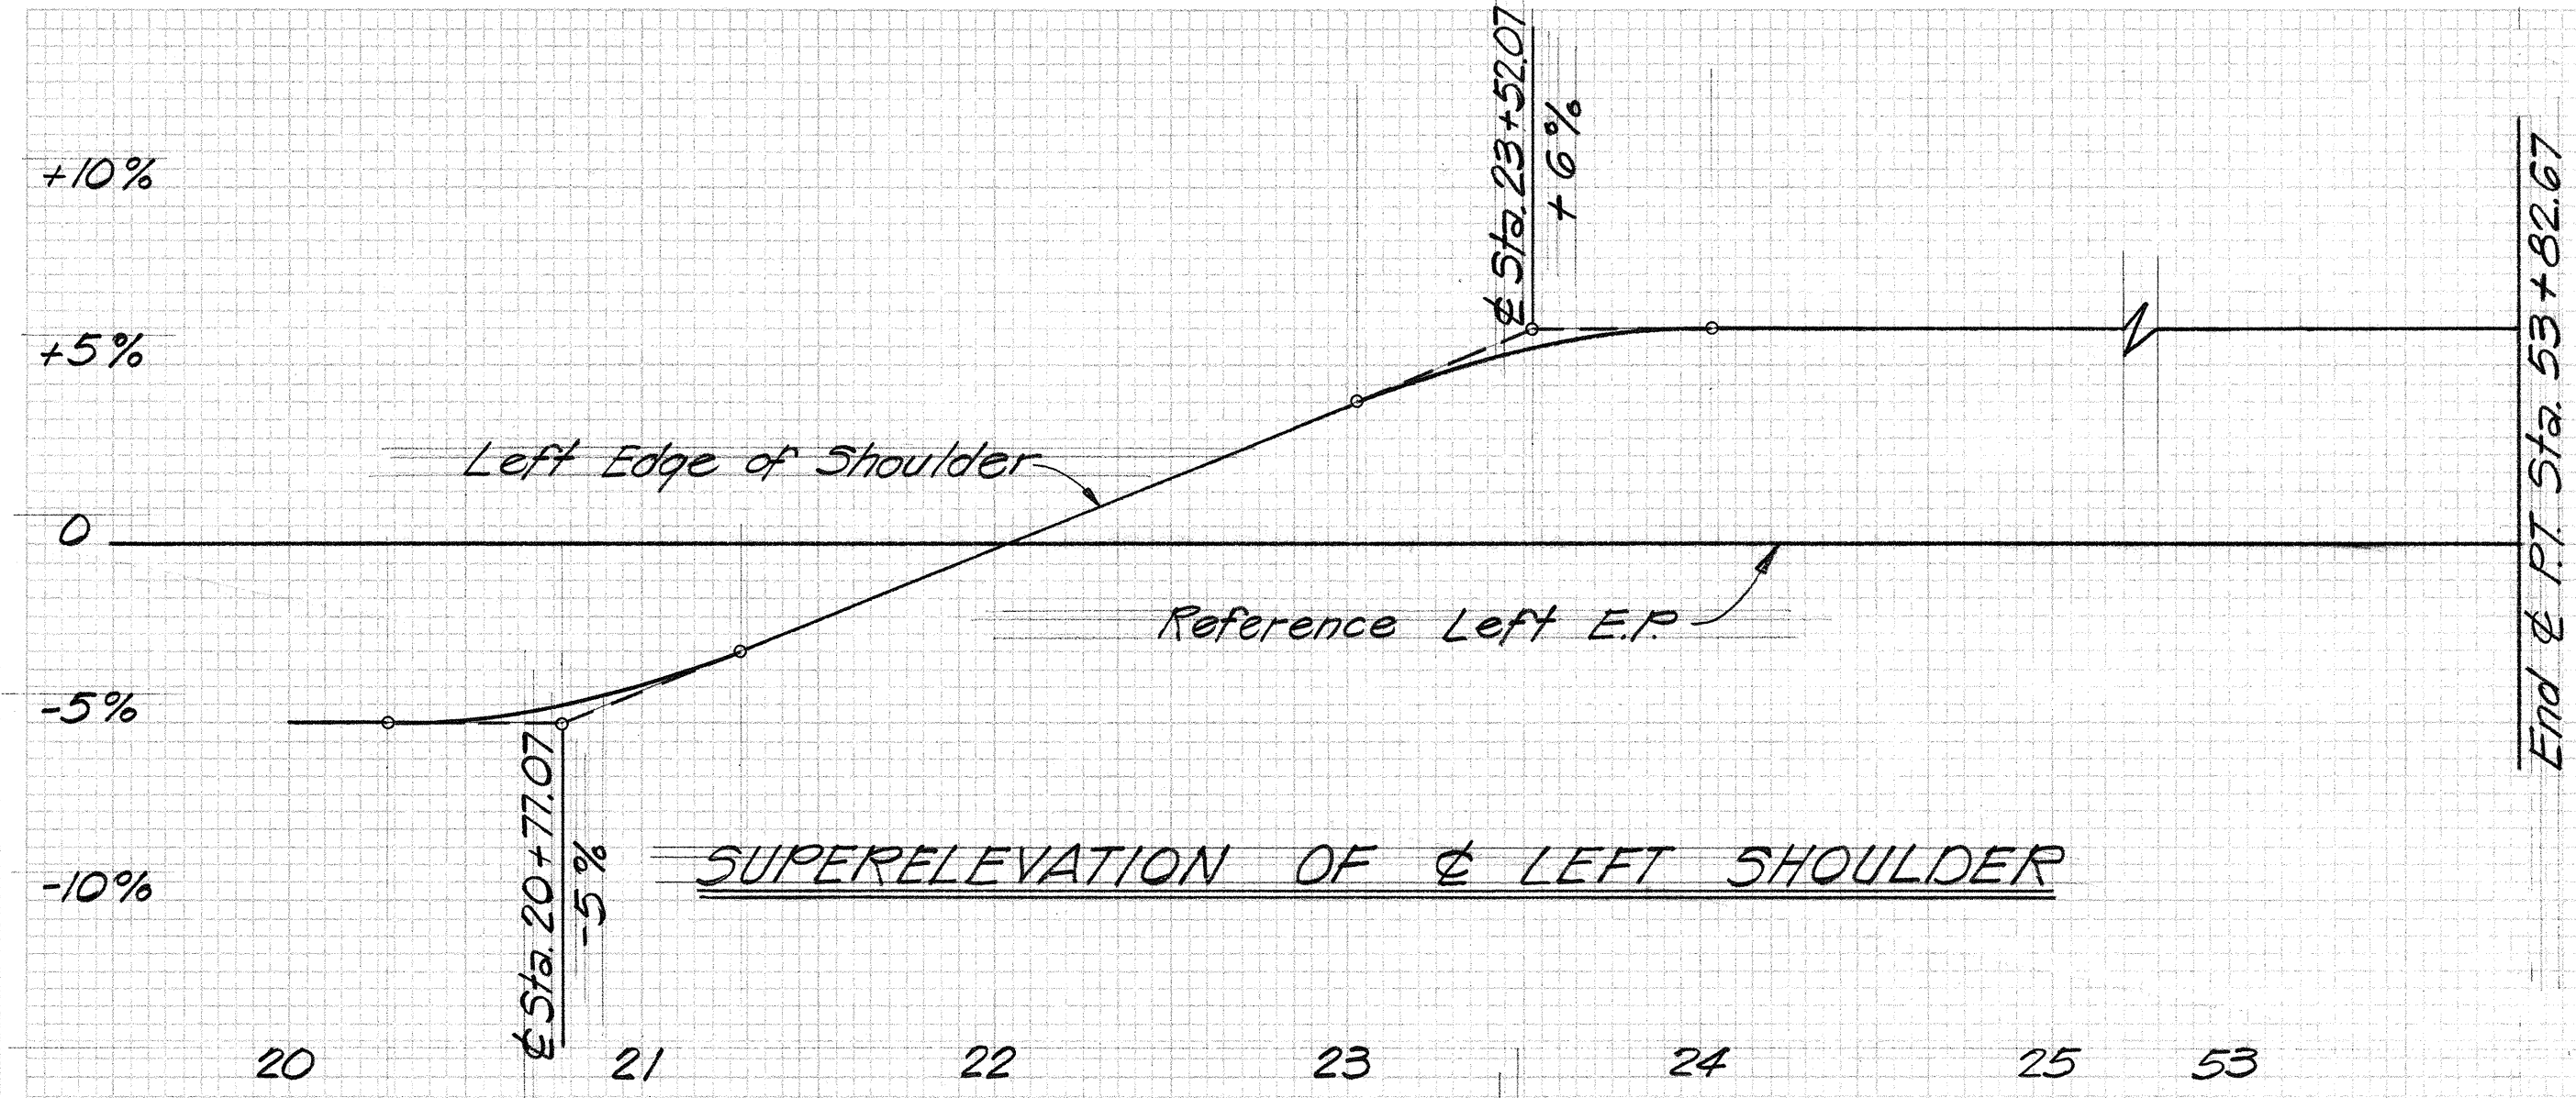

NOTE: S.E. Rounding = 100' V.C.


STATE OF HAWAII
DEPARTMENT OF TRANSPORTATION
HIGHWAYS DIVISION

SUPERELEVATION DIAGRAM
TEMPORARY CONNECTOR
H-2 TO KAMEHAMEHA HIGHWAY
INTERSTATE ROUTE H-2
F.A.I. PROJ. NO. I-H2-1(15)0


Scale: Horiz. 1"=50'
Vert. 1"=5% Date: Apr. 1974

SHEET No. 2 OF 3 SHEETS


FED. ROAD DIST. NO.	STATE	FED. AID PROJ. NO.	FISCAL YEAR	SHEET NO.	TOTAL SHEETS
HAWAII	HAW.	I-H2-1(15):0	1974	11	54

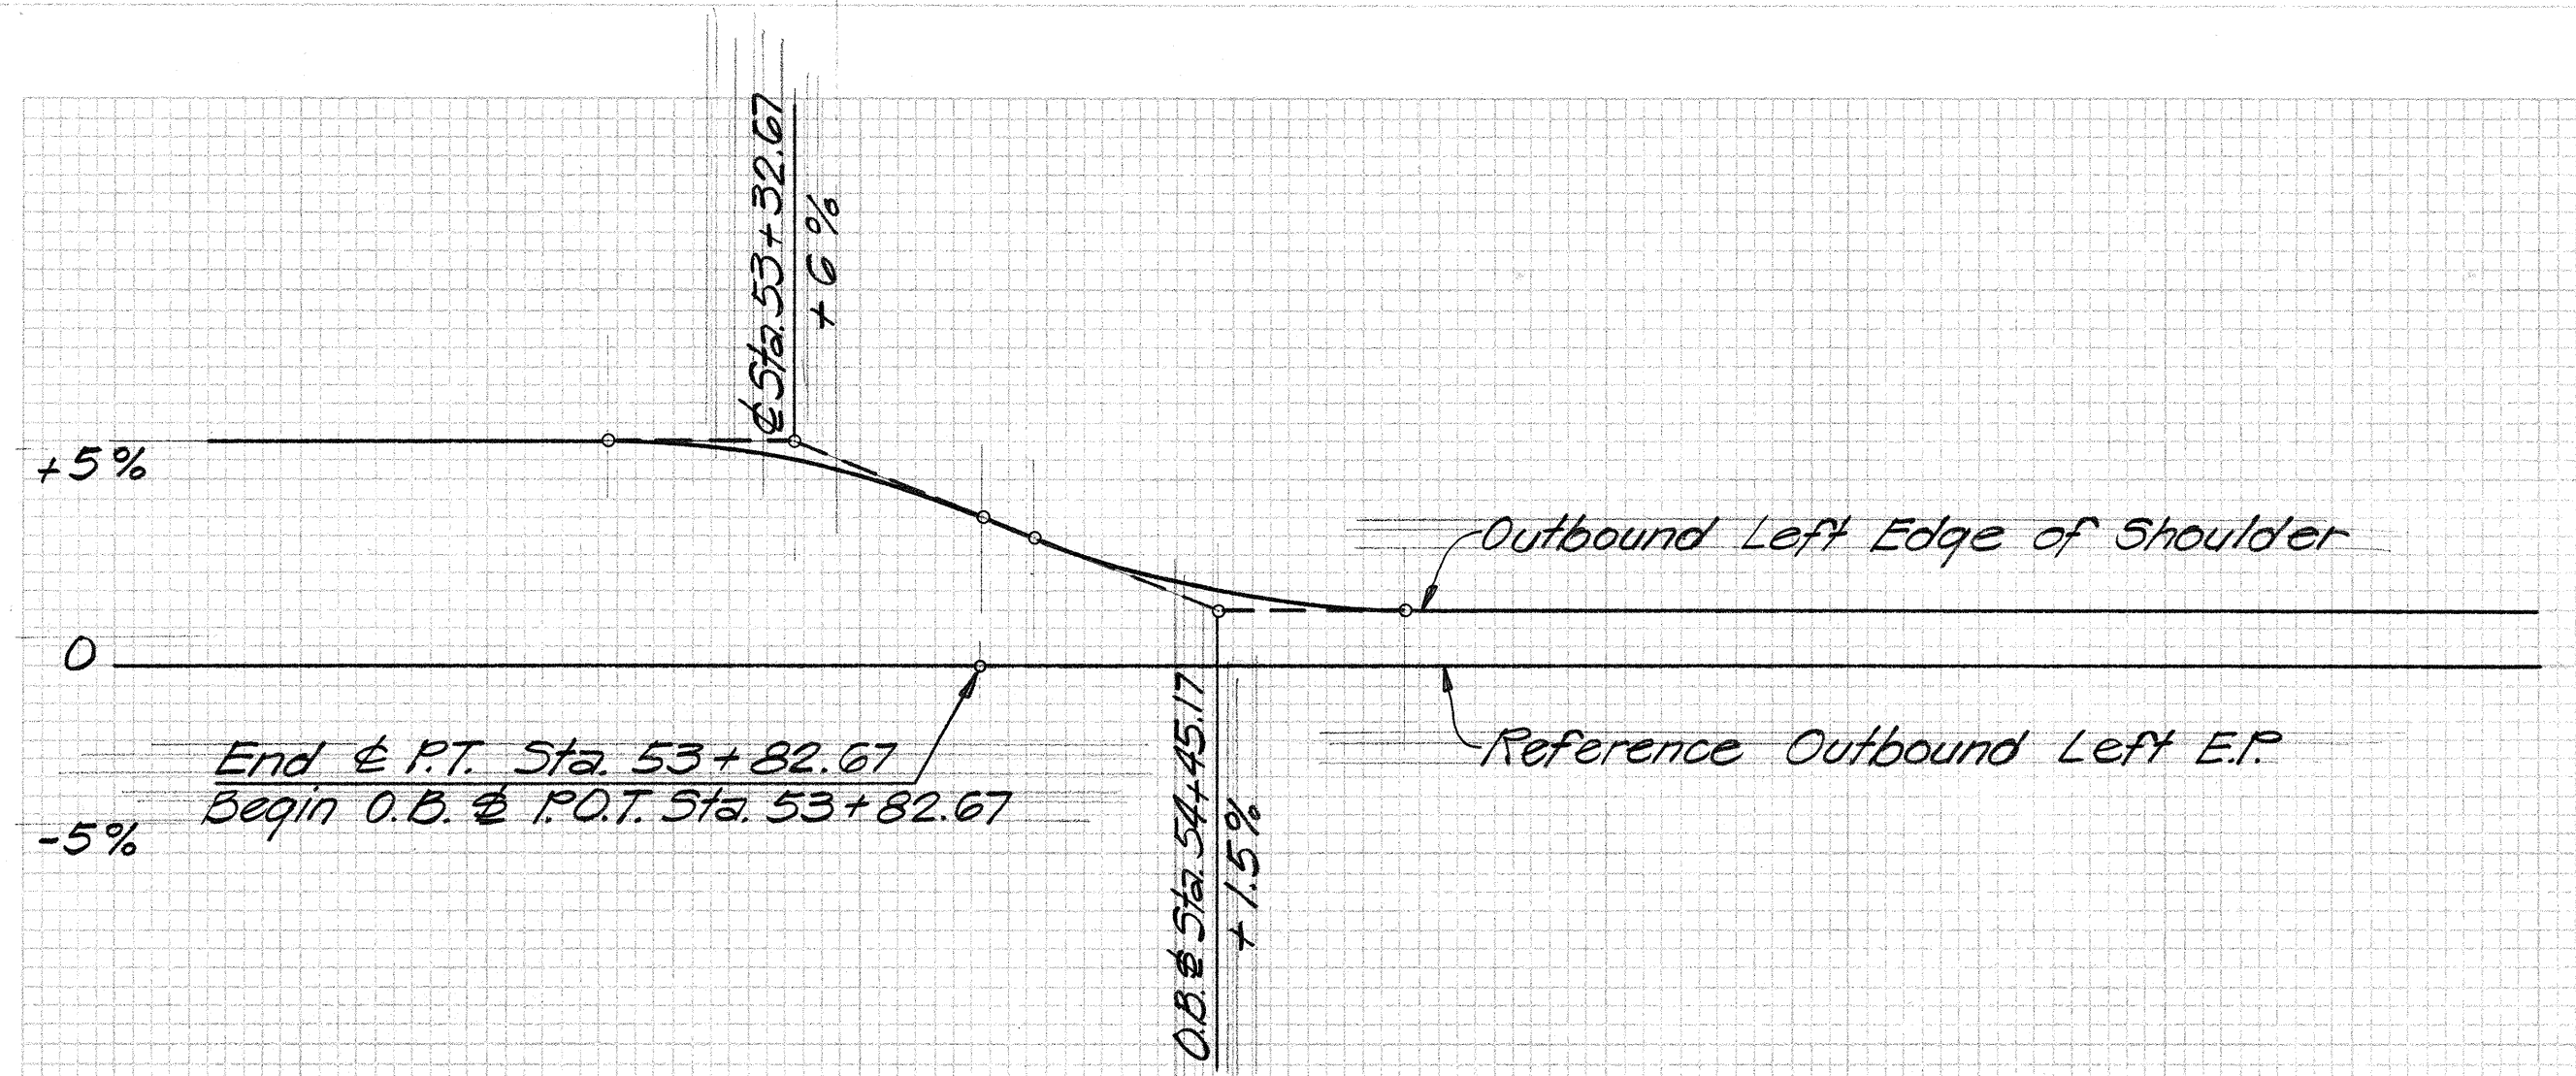

SUPERELEVATION OF O.B. & LEFT SHOULDER

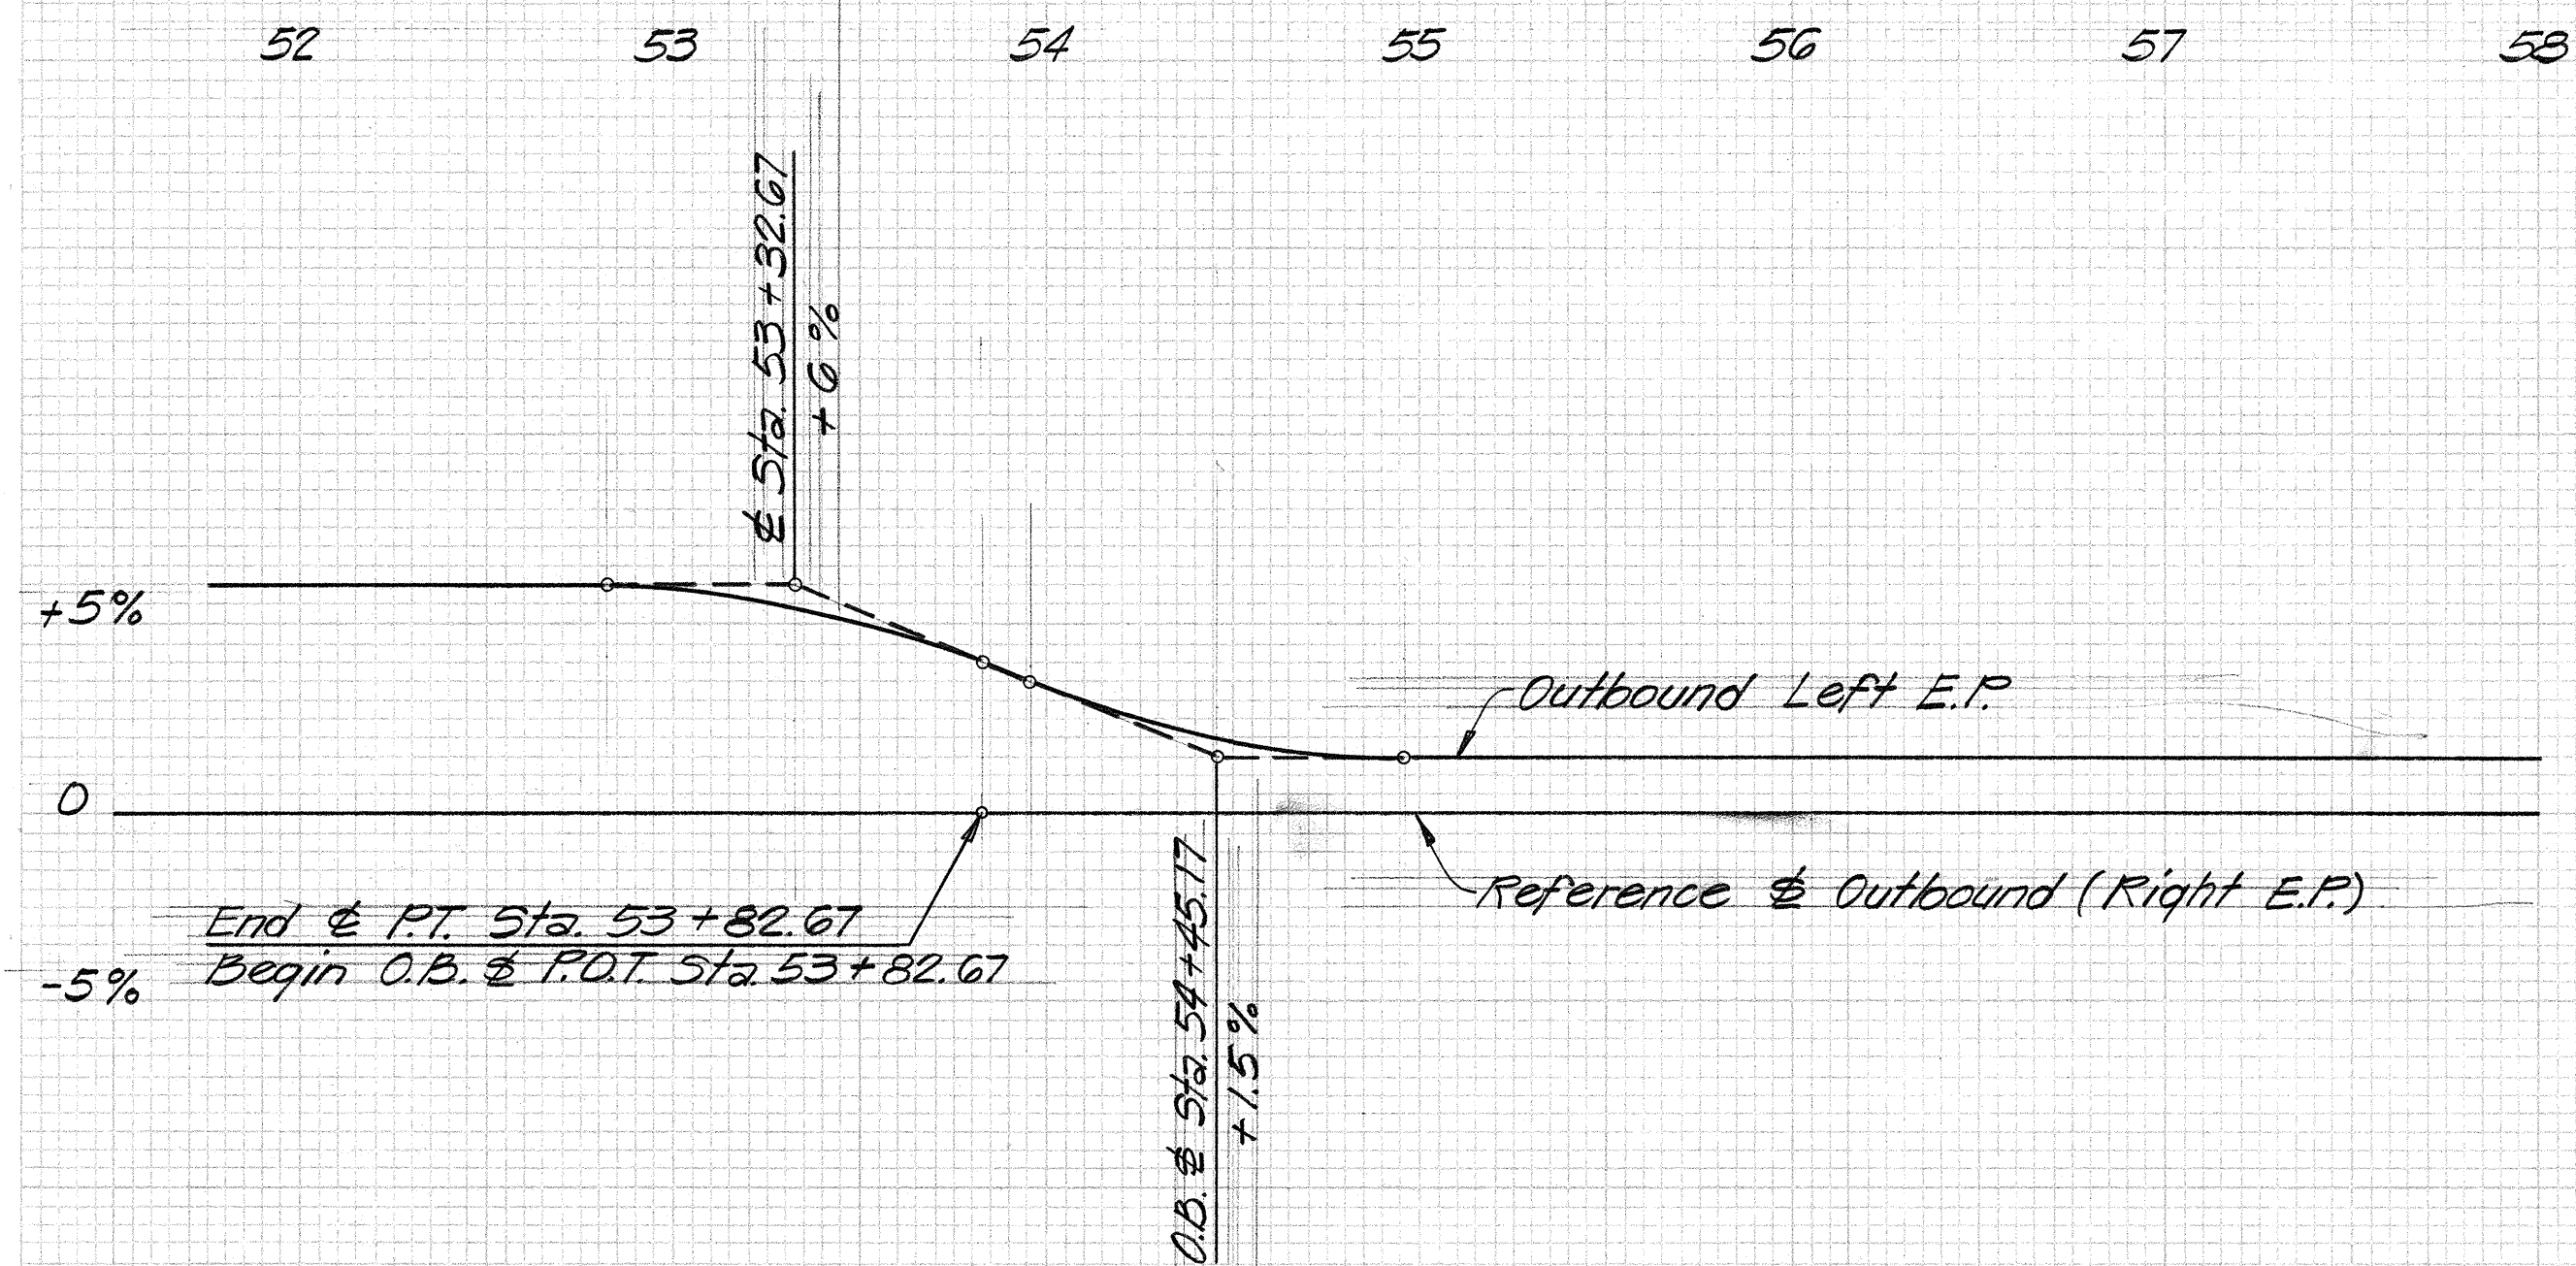

SUPERELEVATION OF O.B. & LEFT EDGE OF PAVEMENT

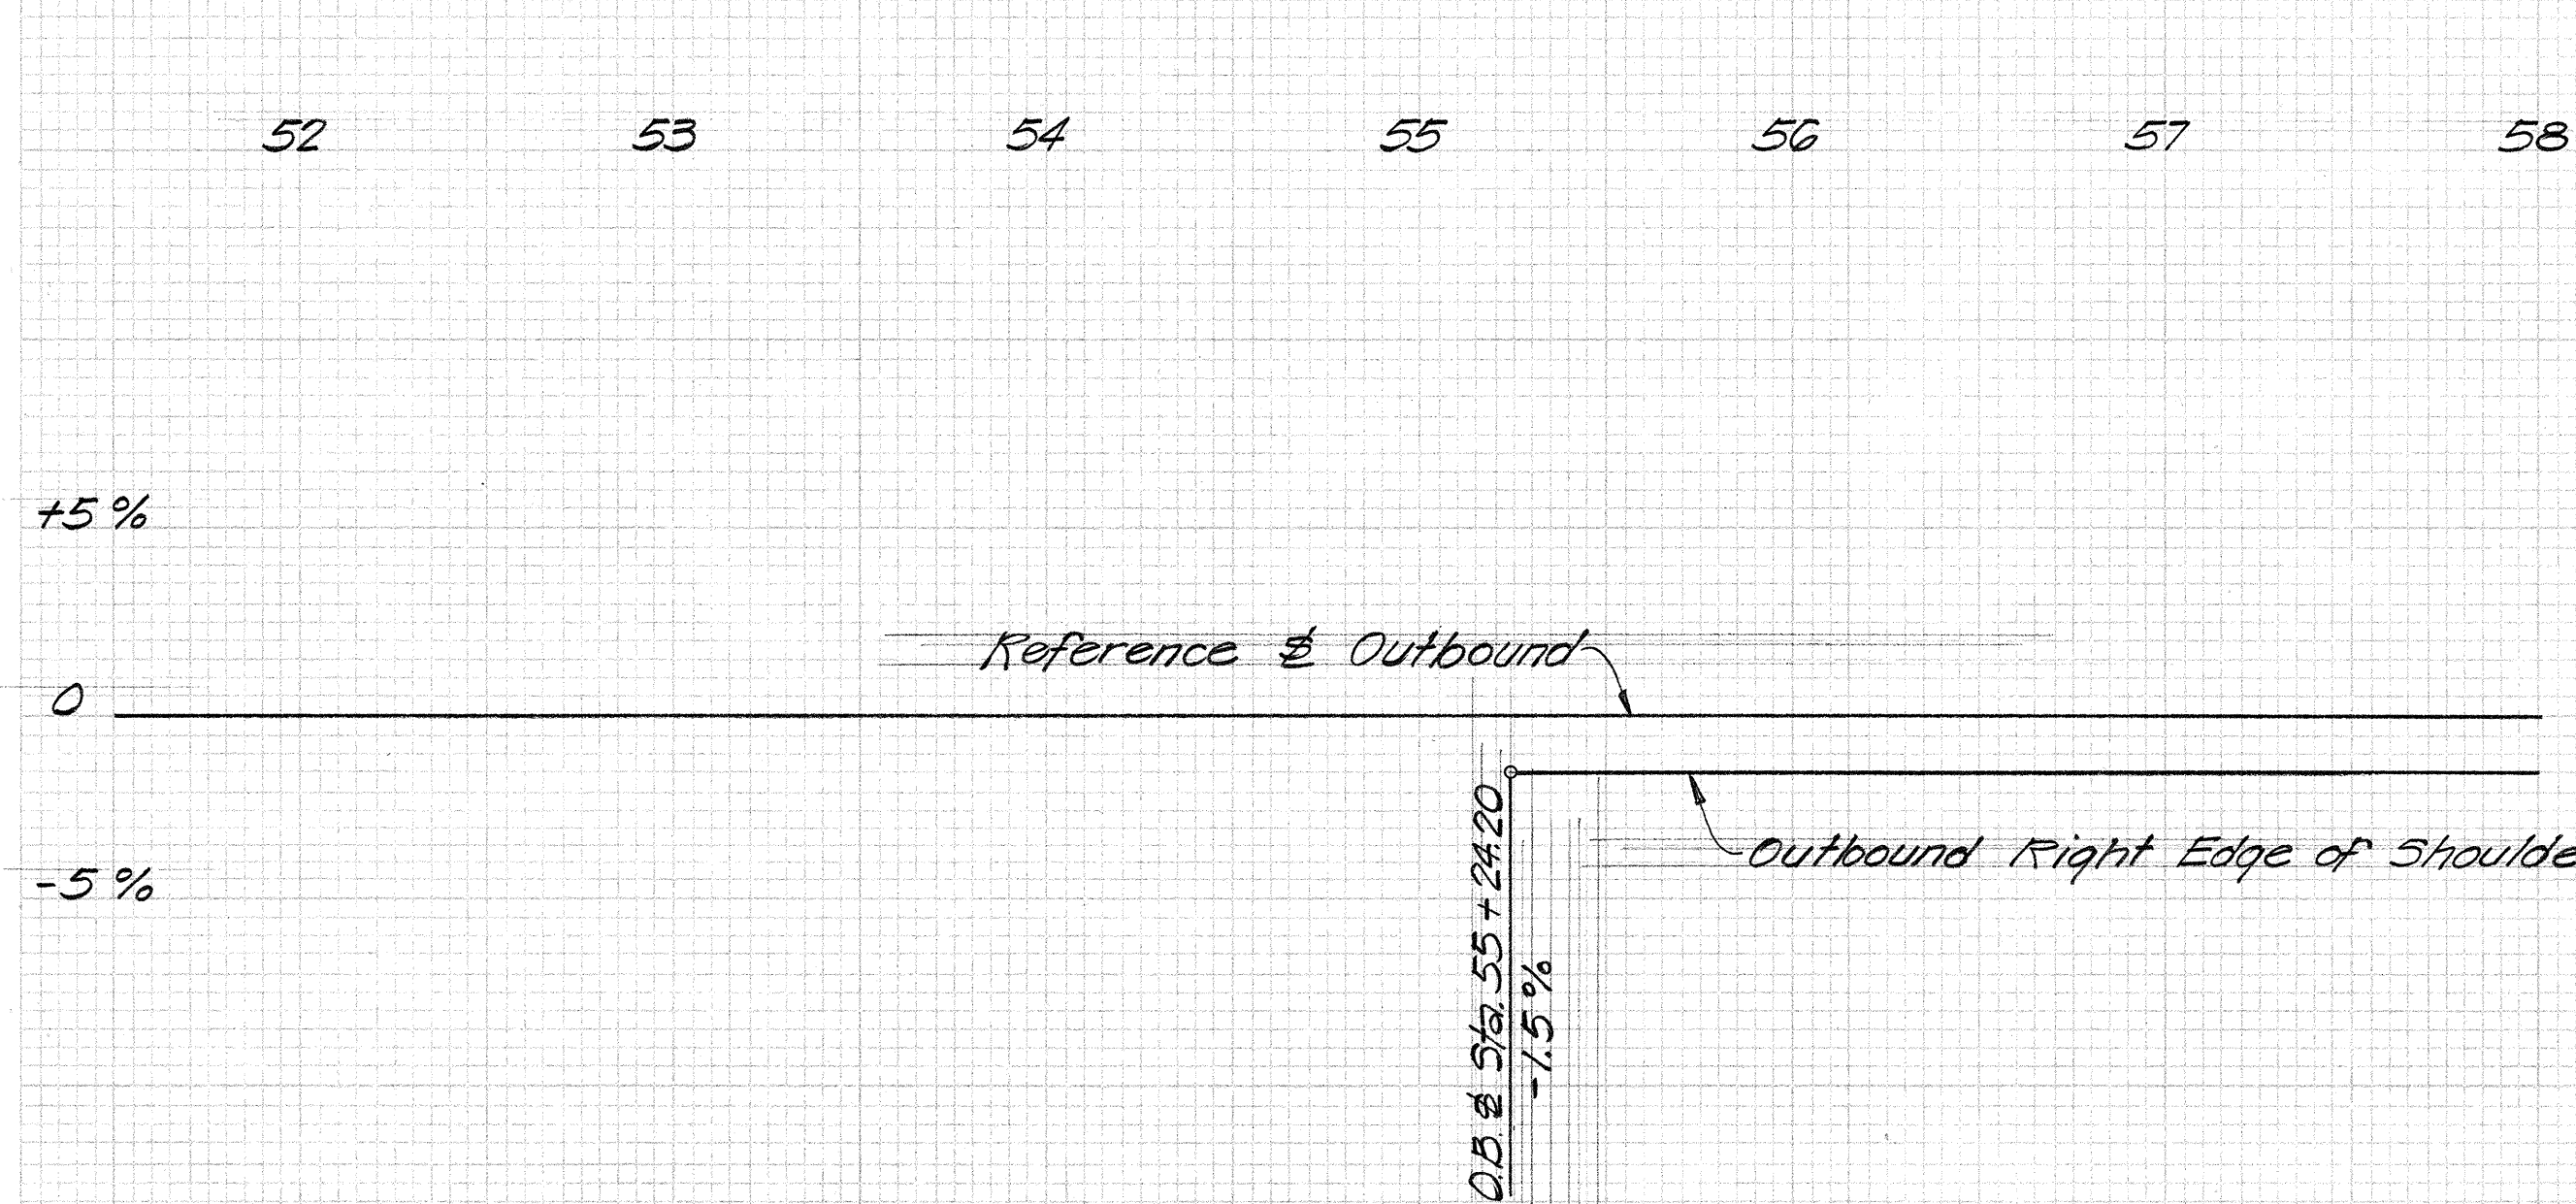

SUPERELEVATION OF O.B. & RIGHT SHOULDER

NOTE: S.E. Rounding = 100' V.C.

STATE OF HAWAII
DEPARTMENT OF TRANSPORTATION
HIGHWAYS DIVISION

SUPERELEVATION DIAGRAM
TEMPORARY CONNECTOR
H-2 TO KAMEHAMEHA HIGHWAY
INTERSTATE ROUTE H-2
F.A.I. PROJ. NO. I-H2-1(15):0

Scale: Horiz. 1" = 50'
Vert. 1" = 5% Date: Apr. 1974

SHEET No. 3 OF 3 SHEETS