



STATE OF HAWAII

DEPARTMENT OF TRANSPORTATION HIGHWAYS DIVISION


HONOLULU, HAWAII

"AS BUILT"

PLANS FOR CONSTRUCTION OF

INTERSTATE ROUTE H-2
TEMPORARY CONNECTOR
H-2 TO KAMEHAMEHA HIGHWAY
(Vicinity of Mililani Memorial Park Road)

FED. AID INTERSTATE PROJ. NO. I-H2-I(15):0

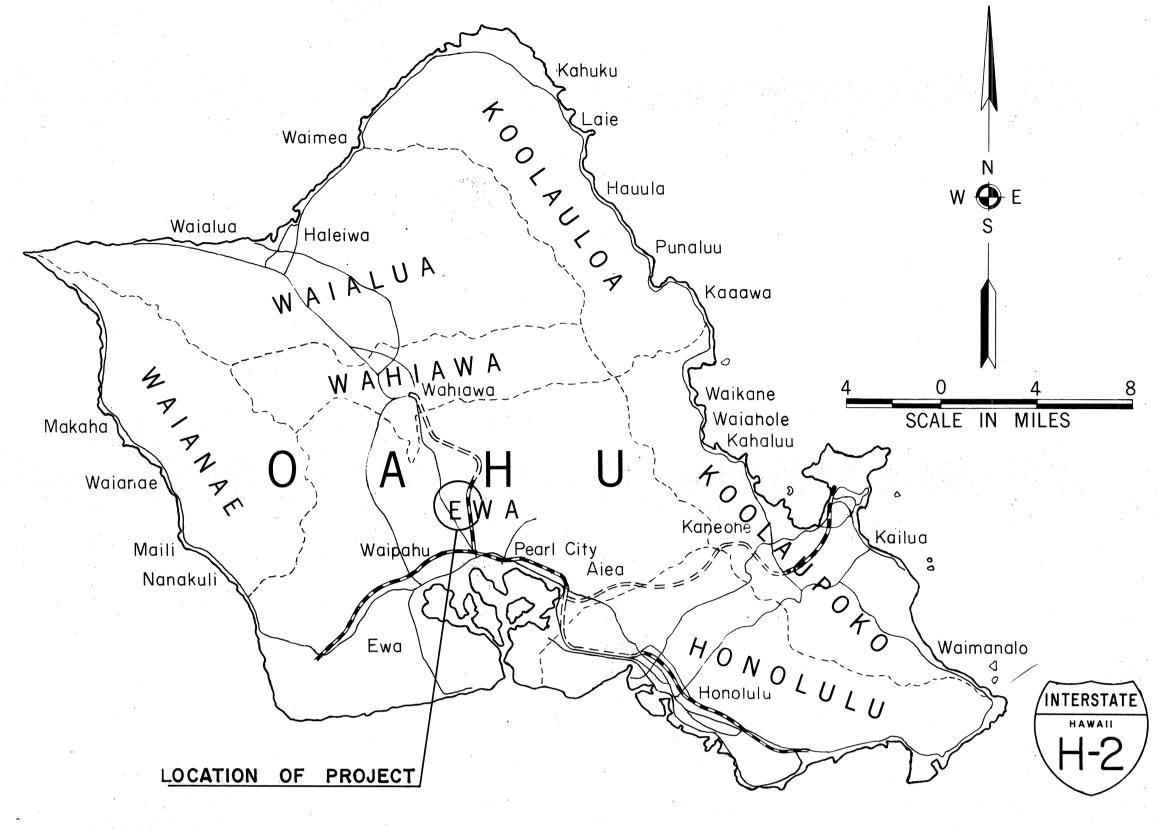

FED. AID FISCAL SHEET PROJ. NO. YEAR NO.

HAW. I-H2-1(15):0 1974

FED. ROAD DIST. NO.

