




FED. ROAD DIST. NO.	STATE	FED. AID PROJ. NO.	FISCAL YEAR	SHEET NO.	TOTAL SHEETS
HAWAII	HAW.	I-H2-1(15)0	1974	2	54

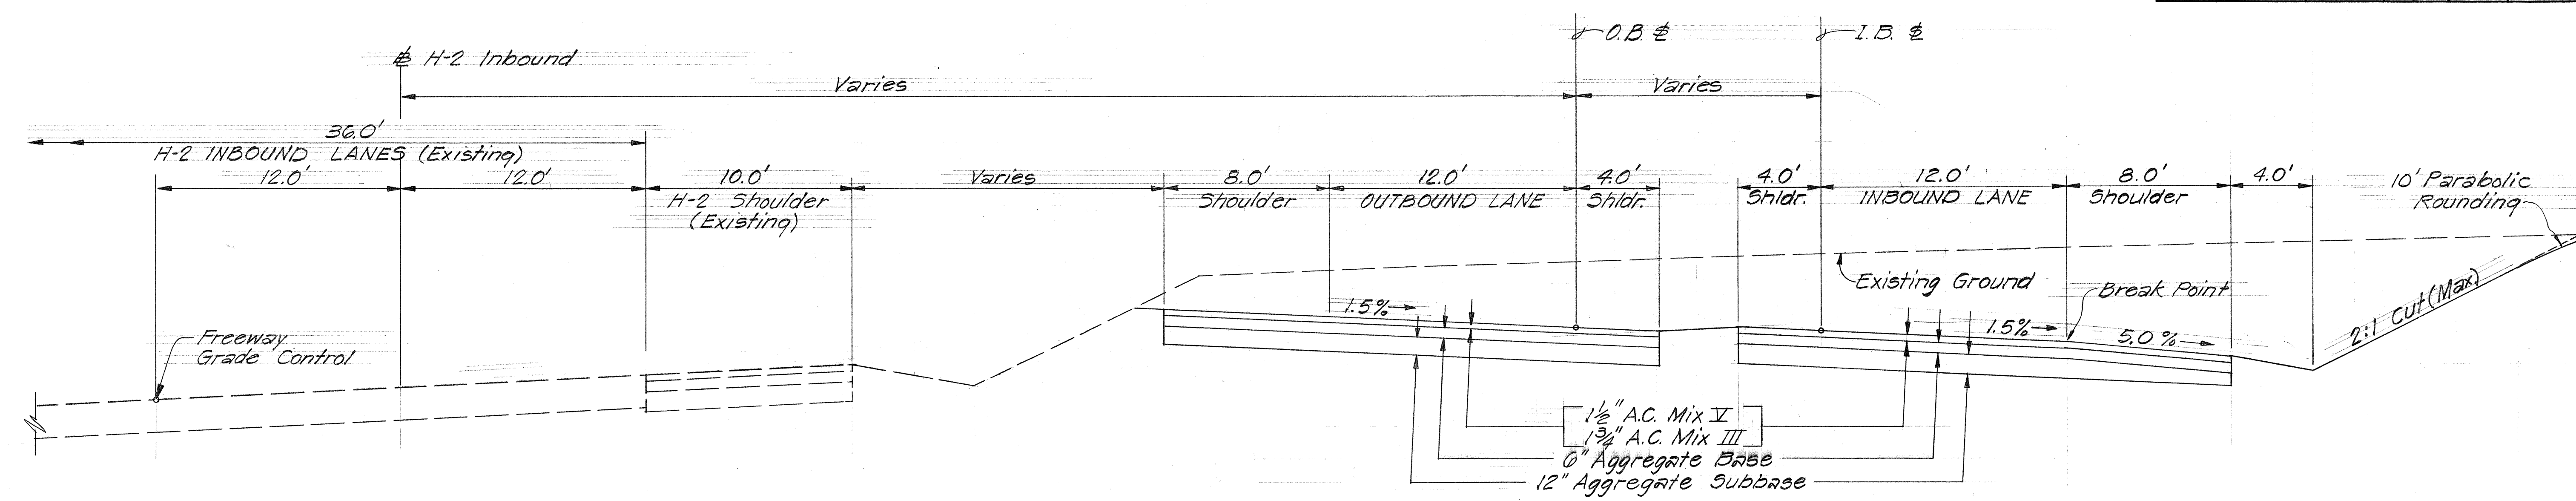

BI-FURCATED SECTION
Scale: 1/4" = 1'-0"

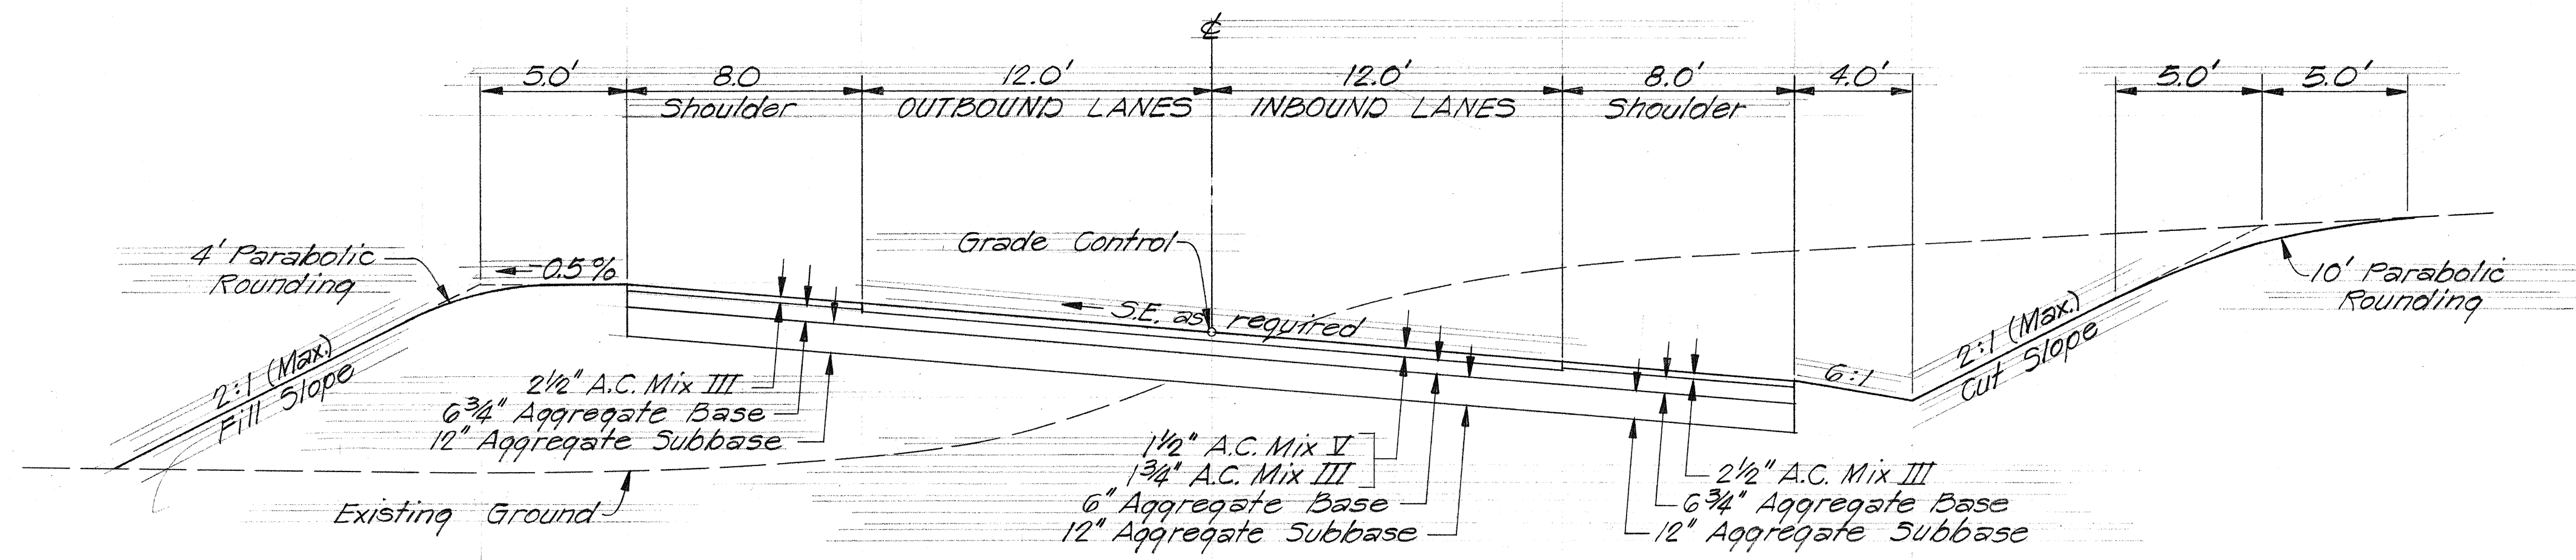

SUPERELEVATED SECTION
Scale: 1/4" = 1'-0"

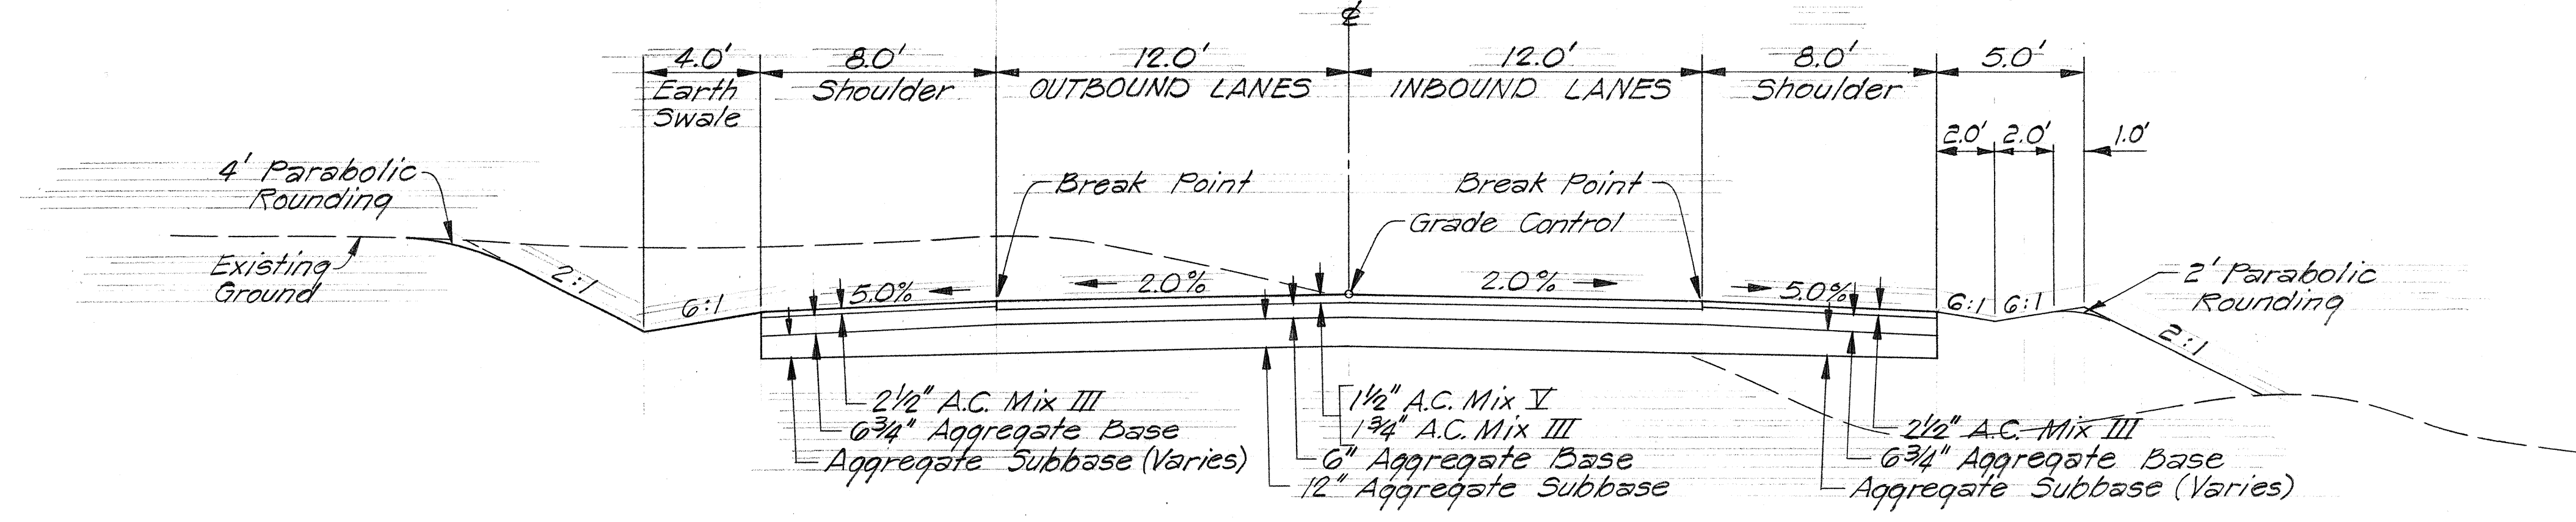

TANGENT SECTION
Scale: 1/4" = 1'-0"

STATE OF HAWAII
DEPARTMENT OF TRANSPORTATION
HIGHWAYS DIVISION

TYPICAL SECTION

INTERSTATE ROUTE H-2
TEMPORARY CONNECTOR
F.A.I. Proj. No. I-H2-1(15)0
Scale: As Shown Date: April, 1974
SHEET No. 1 OF 1 SHEETS

ORIGINAL PLAN
DATE
DRAWN BY
DESIGNED BY
CHECKED BY
NOTE BOOK
No.