


FED. ROAD DIST. NO.	STATE	PROJ. NO.	FISCAL YEAR	SHEET NO.	TOTAL SHEETS
HAWAII	HAW.	HWY-0-03-83M	1983	9	16

TRUE NORTH
Scale: 1"=50'

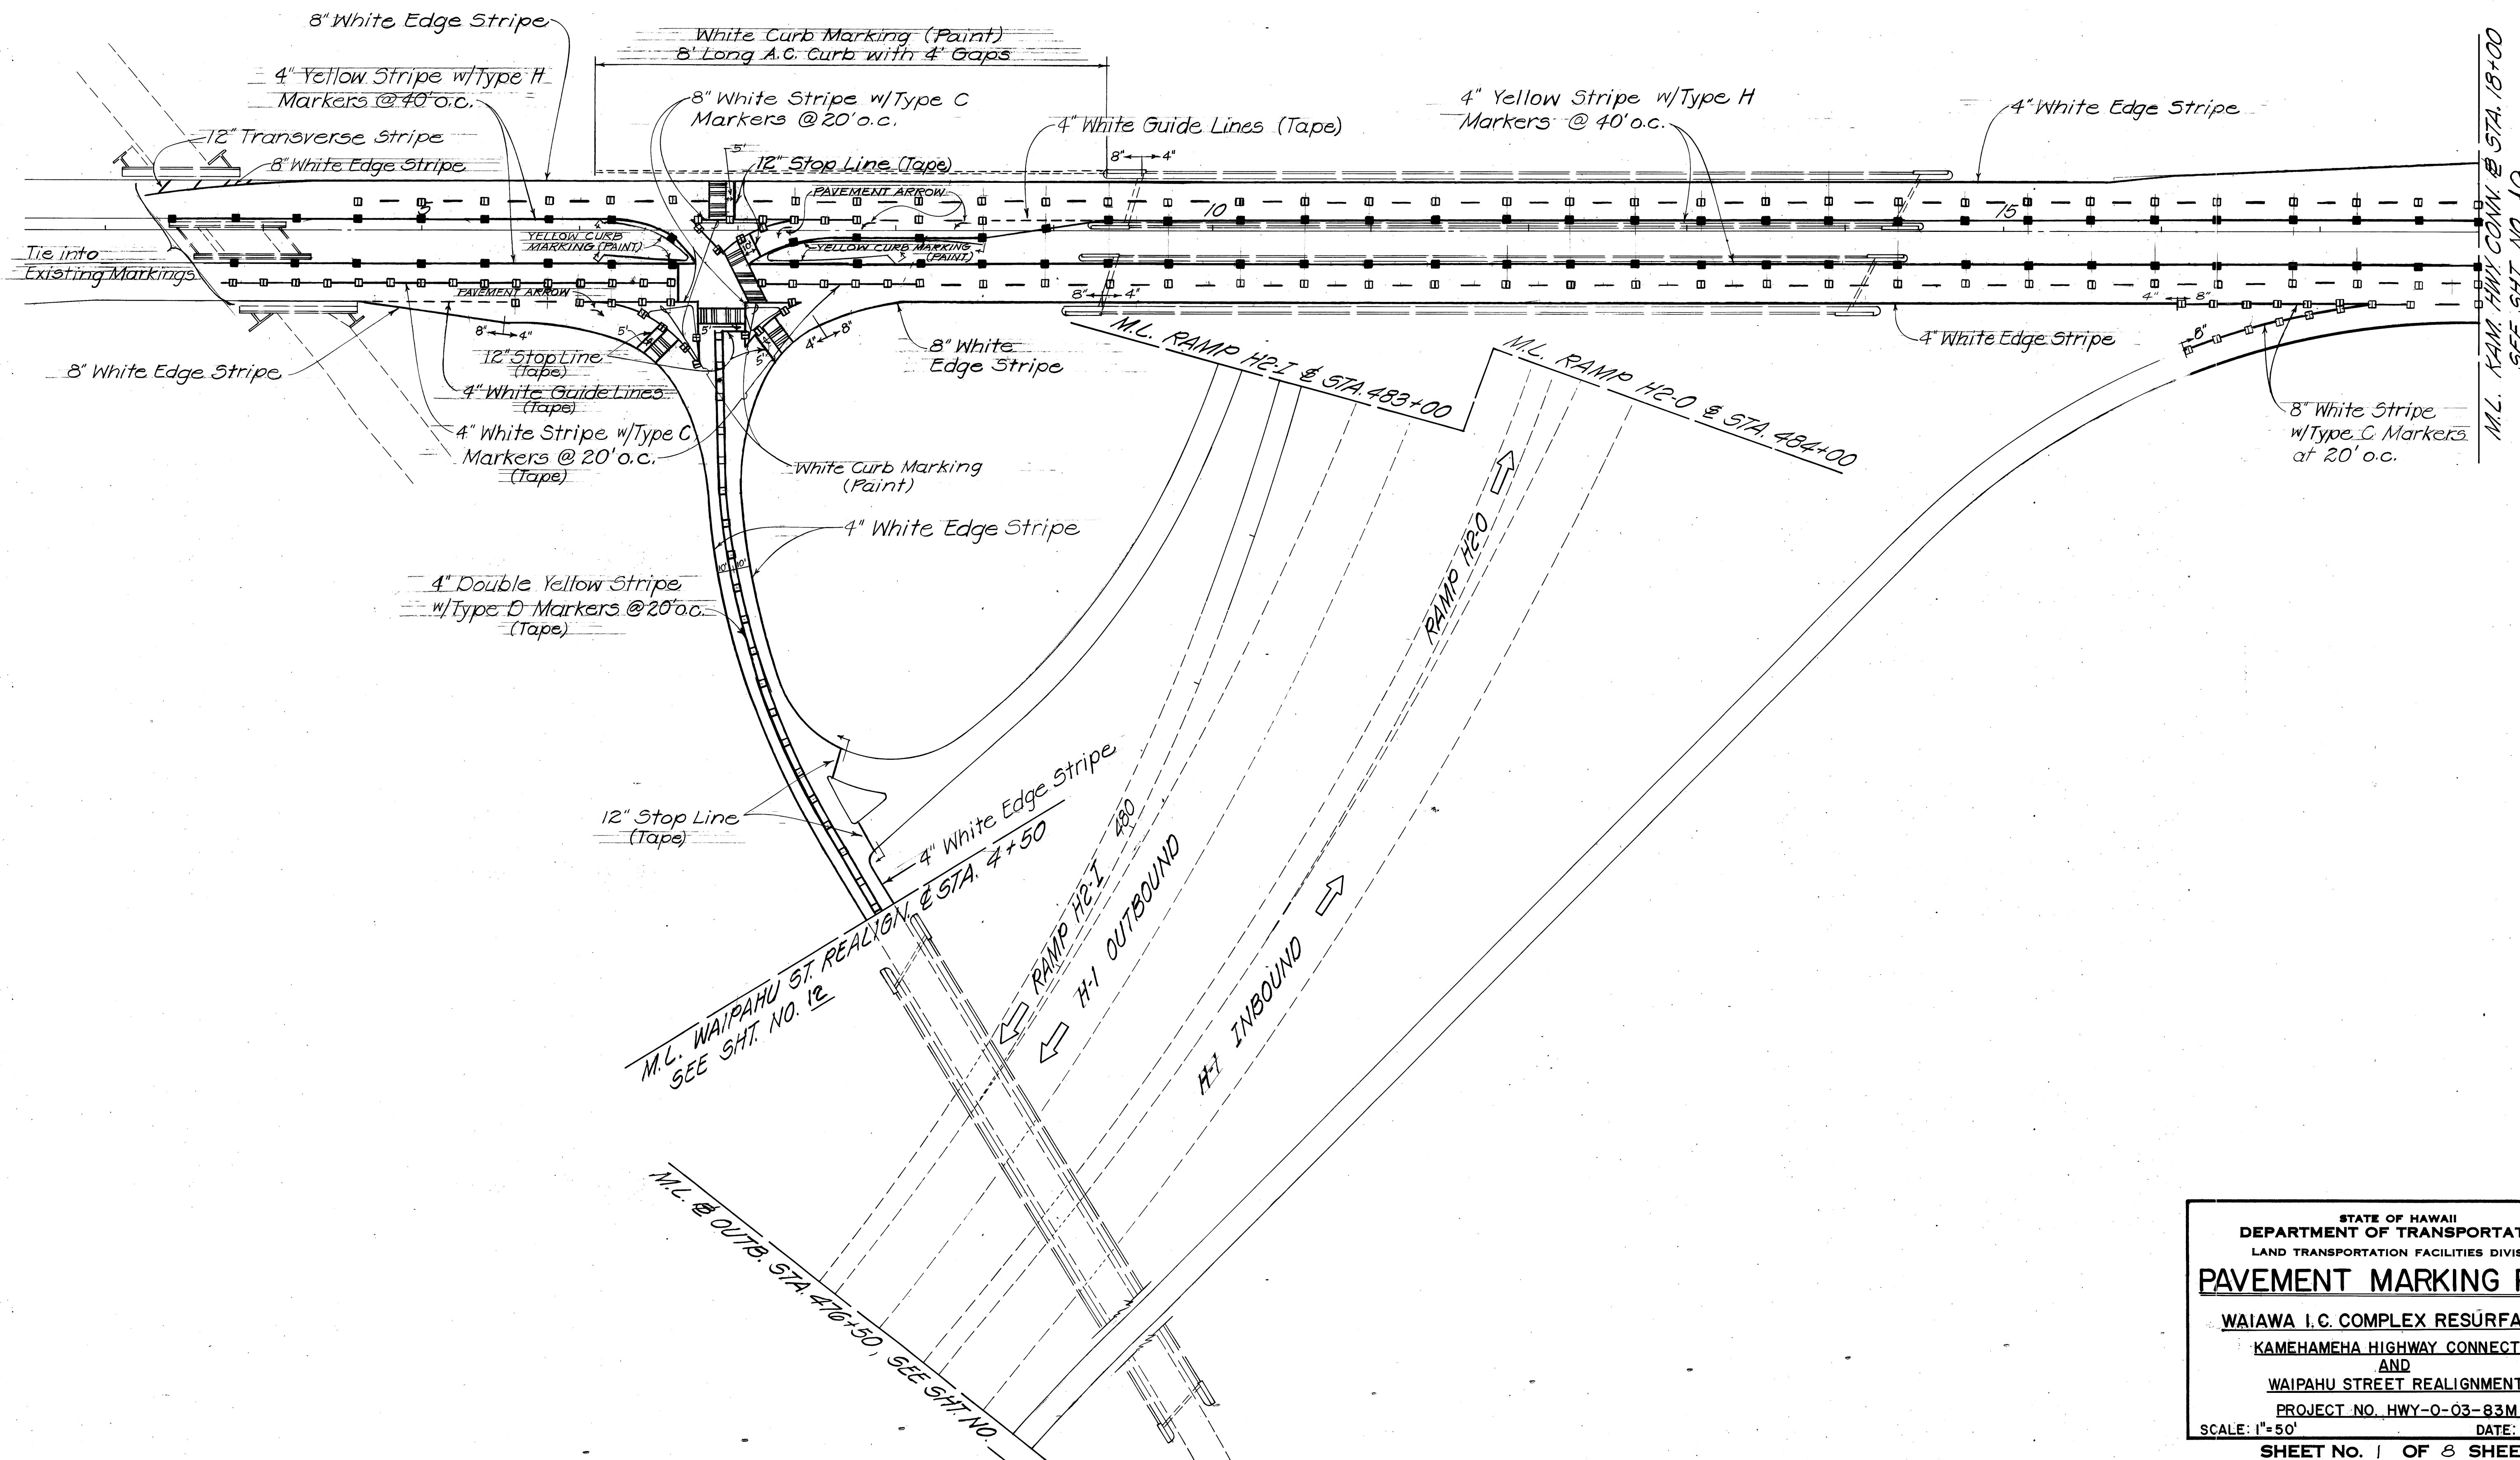


DATE	_____
SURVEY PLOTTED BY	_____
DRAWN BY	_____
DESIGNED BY	_____
CHECKED BY	_____
ORIGINAL PLAN	_____
NOTE BOOK	_____
No.	_____

STATE OF HAWAII
DEPARTMENT OF TRANSPORTATION
LAND TRANSPORTATION FACILITIES DIVISION

PAVEMENT MARKING PLAN

WAI'AWA I.C. COMPLEX RESURFACING
KAMEHAMEHA HIGHWAY CONNECTOR
AND
WAI'PAHU STREET REALIGNMENT
PROJECT NO. HWY-0-03-83M
SCALE: 1"=50' DATE: FEB. 1983
SHEET NO. 1 OF 8 SHEETS

FED. ROAD DIST. NO.	STATE	PROJ. NO.	FISCAL YEAR	SHEET NO.	TOTAL SHEETS
HAWAII	HAW.	HWY-0-03-83M	1983	10	16

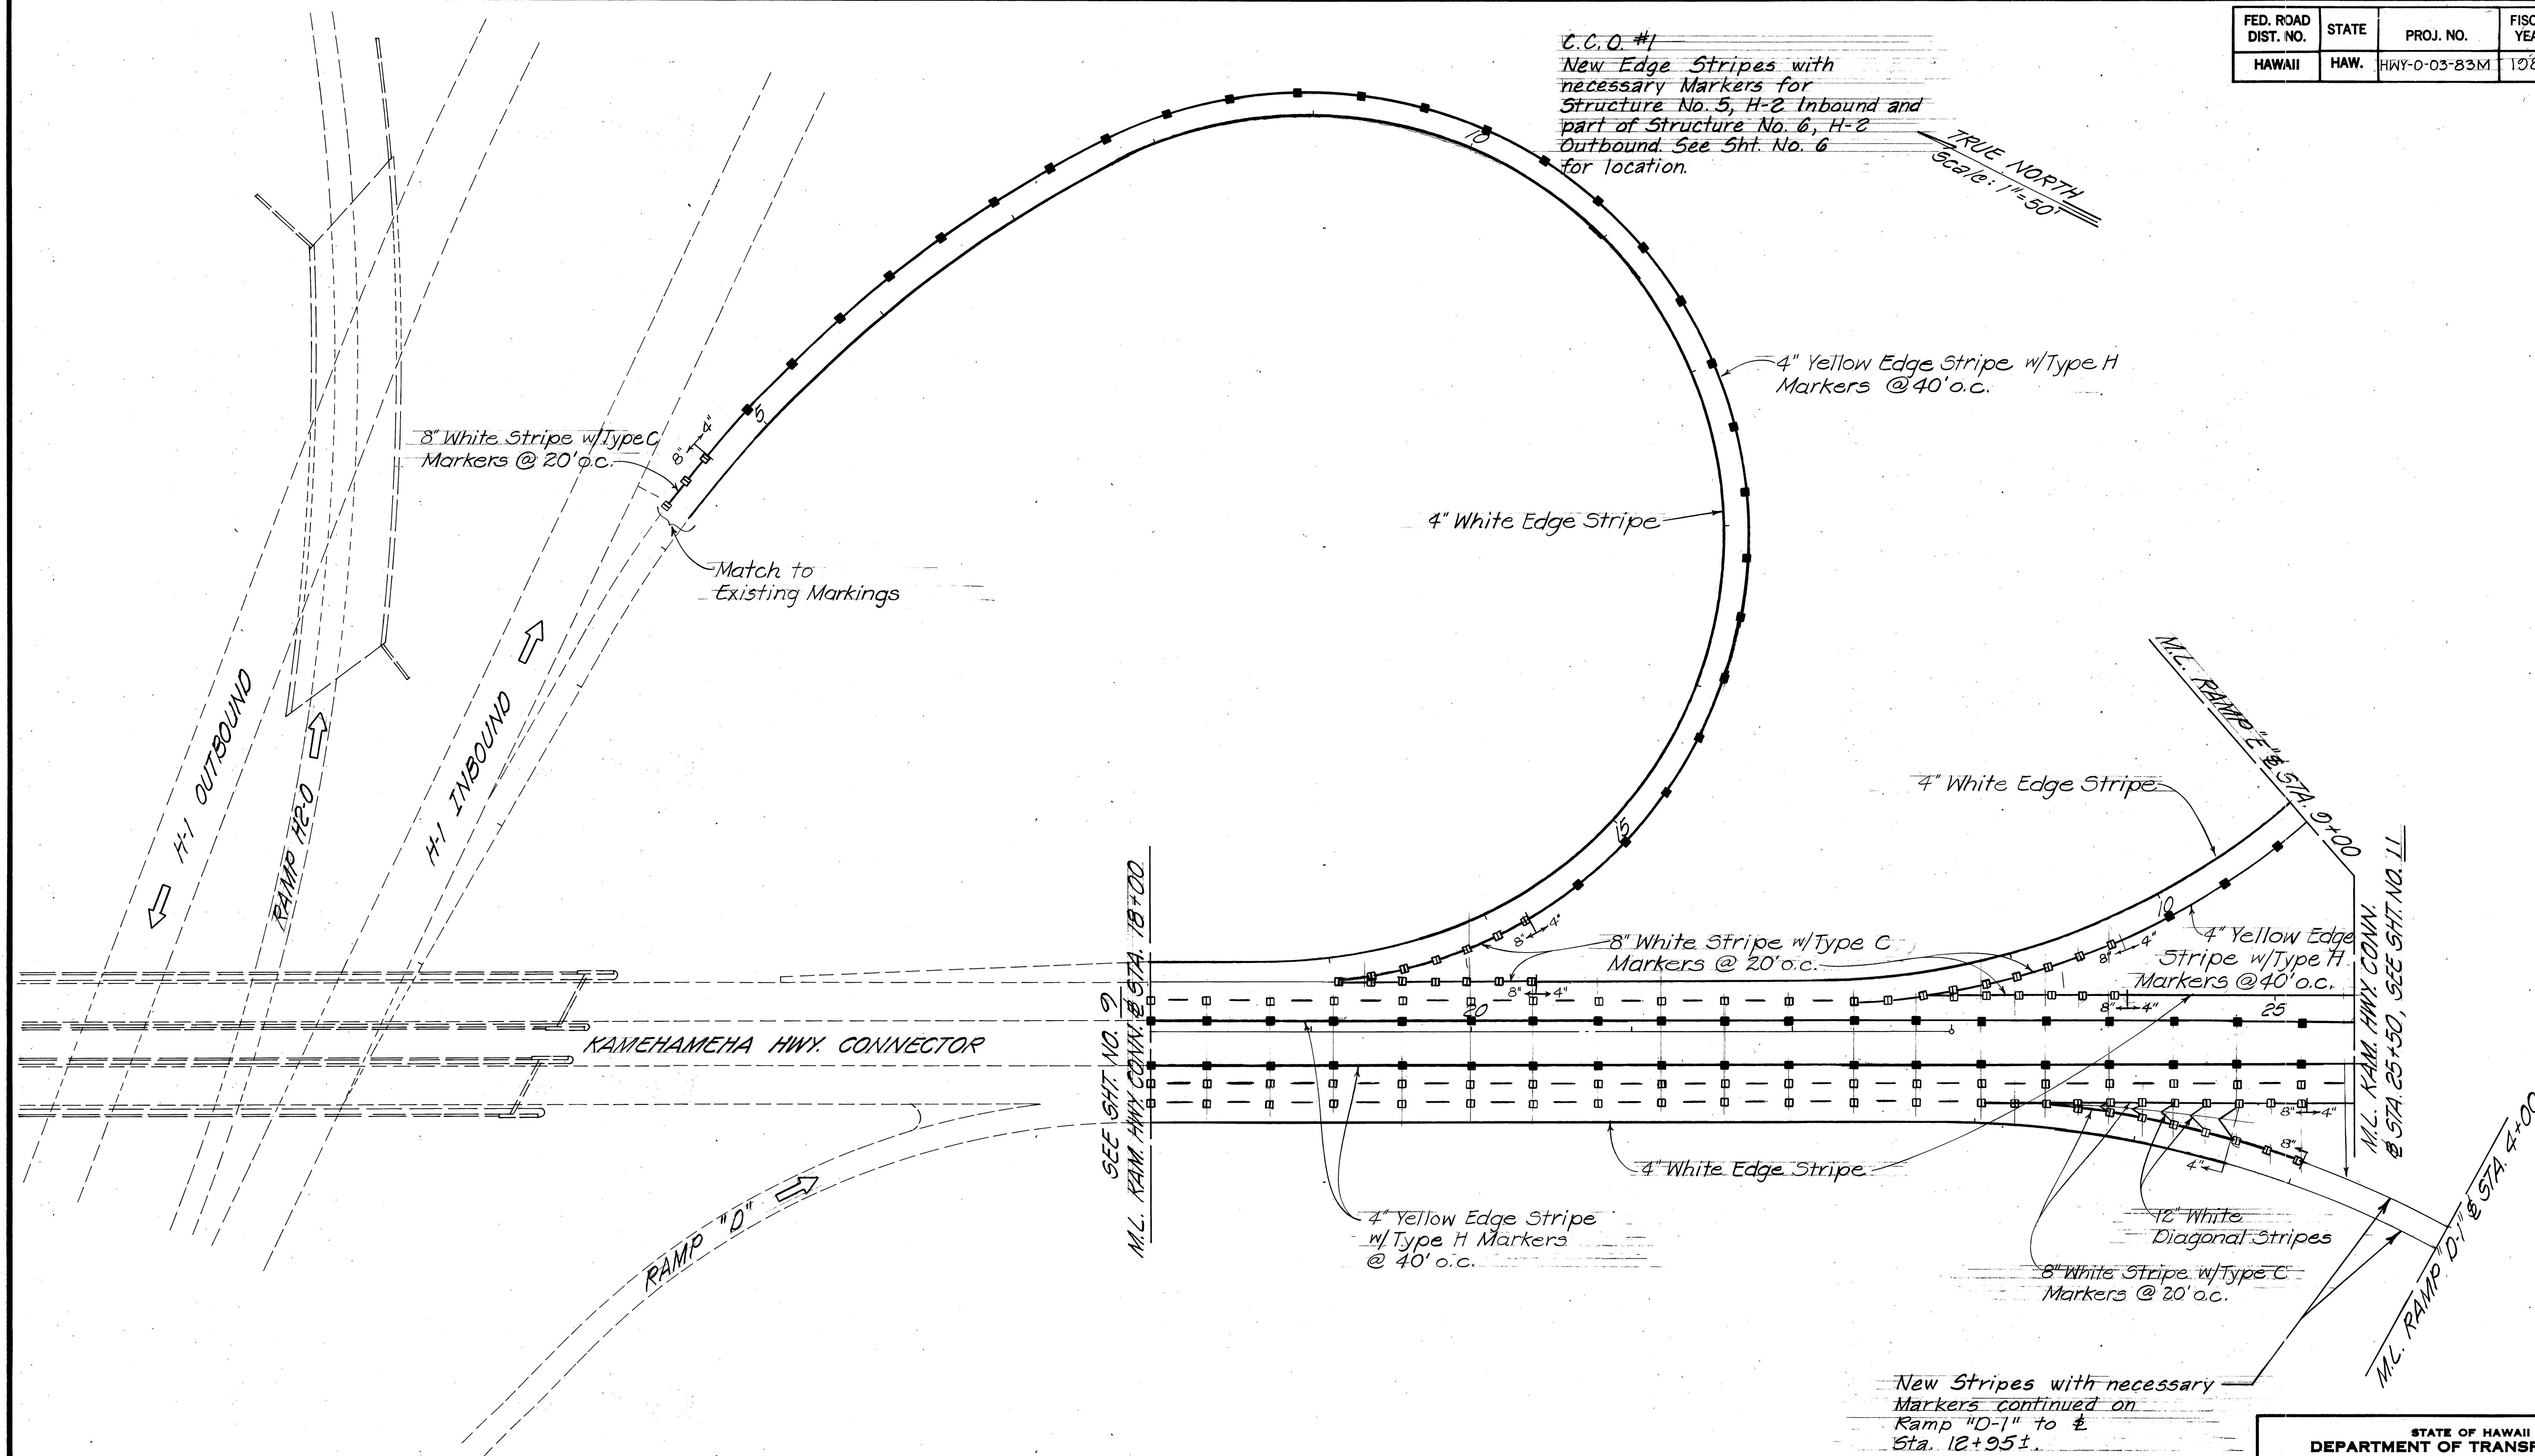


STATE OF HAWAII
DEPARTMENT OF TRANSPORTATION
LAND TRANSPORTATION FACILITIES DIVISION

PAVEMENT MARKING PLAN

WAIAWA I.C. COMPLEX RESURFACING
KAMEHAMEHA HIGHWAY CONNECTOR
AND
WAIPAHU STREET REALIGNMENT

PROJECT NO. HWY-0-03-83M
SCALE: 1"=50' DATE: FEB. 1983
SHEET NO. 2 OF 8 SHEETS

FED. ROAD DIST. NO.	STATE	PROJ. NO.	FISCAL YEAR	SHEET NO.	TOTAL SHEETS
HAWAII	HAW.	HWY-0-03-83M	1983	11	16

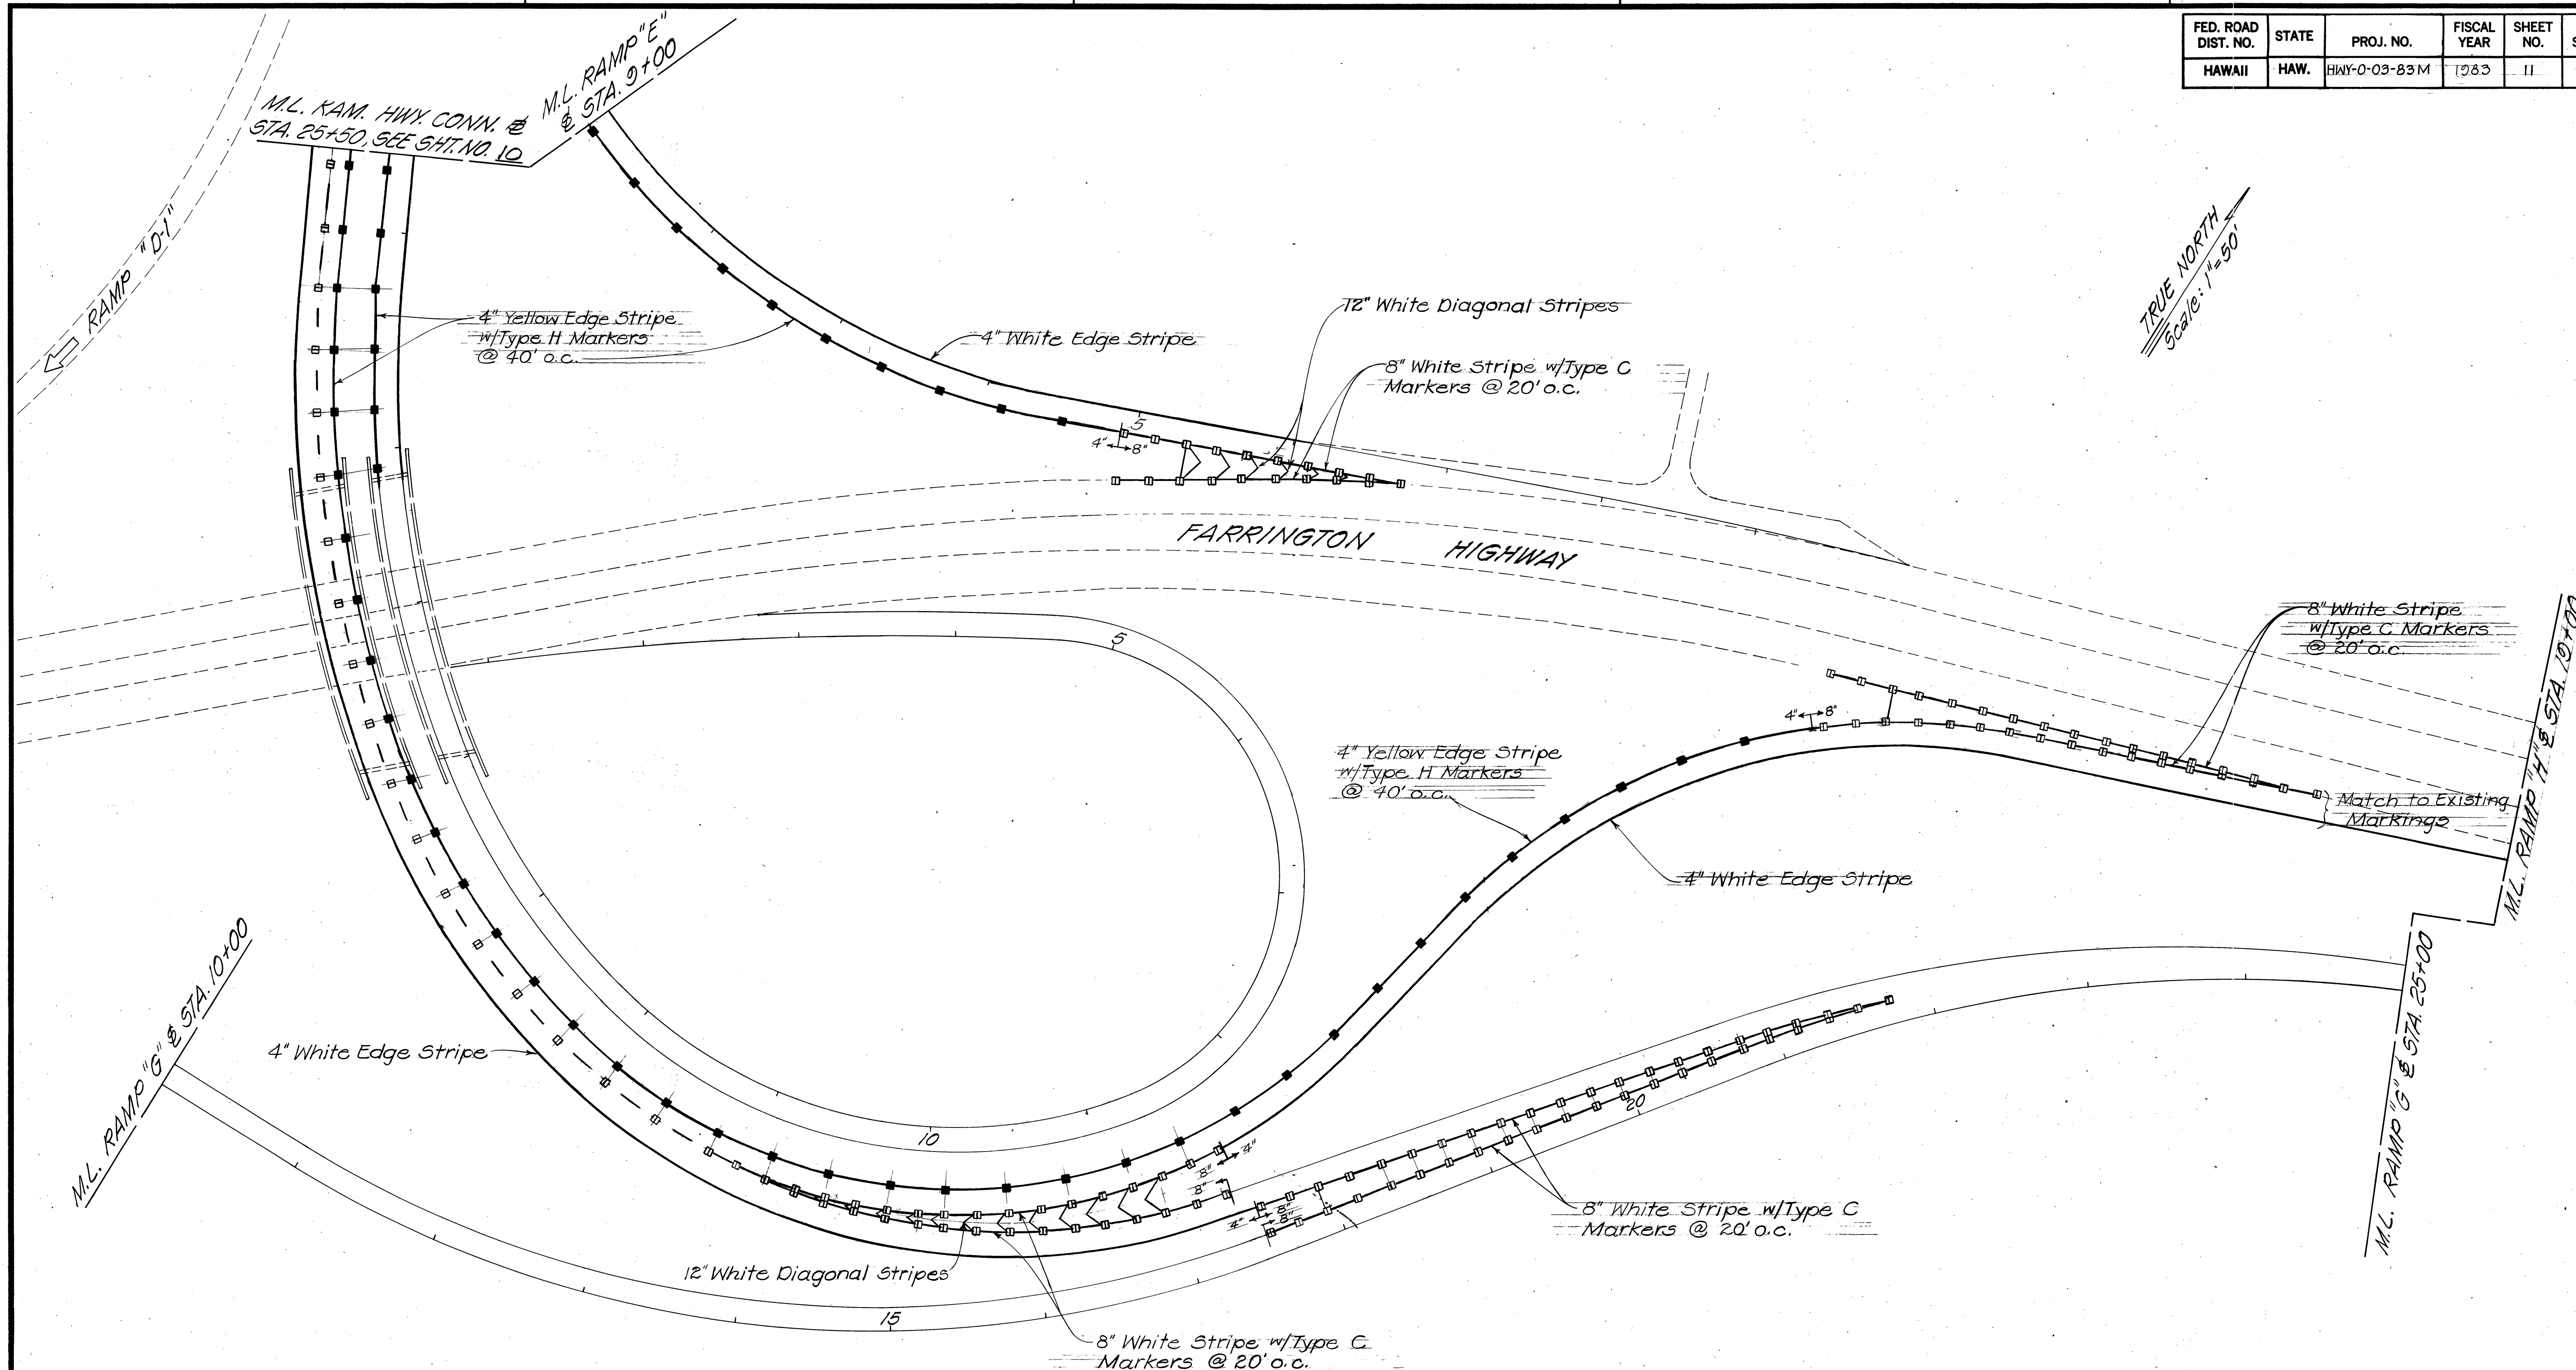

DATE	_____
SURVEY PLOTTED BY	_____
DESIGNED BY	_____
TRACED BY	_____
NOTE BOOK	_____
QUANTITIES BY	_____
CHECKED BY	_____
No.	_____


STATE OF HAWAII
DEPARTMENT OF TRANSPORTATION
LAND TRANSPORTATION FACILITIES DIVISION

PAVEMENT MARKING PLAN

WAI'AWA I.C. COMPLEX RESURFACING
KAMEHAMEHA HIGHWAY CONNECTOR
AND
WAI'AHU STREET REALIGNMENT

PROJECT NO. HWY-0-03-83M
SCALE: 1"=50' DATE: FEB. 1983
SHEET NO. 3 OF 8 SHEETS

FED. ROAD DIST. NO.	STATE	PROJ. NO.	FISCAL YEAR	SHEET NO.	TOTAL SHEETS
HAWAII	HAW.	HWY-0-03-83M	1983	12	16

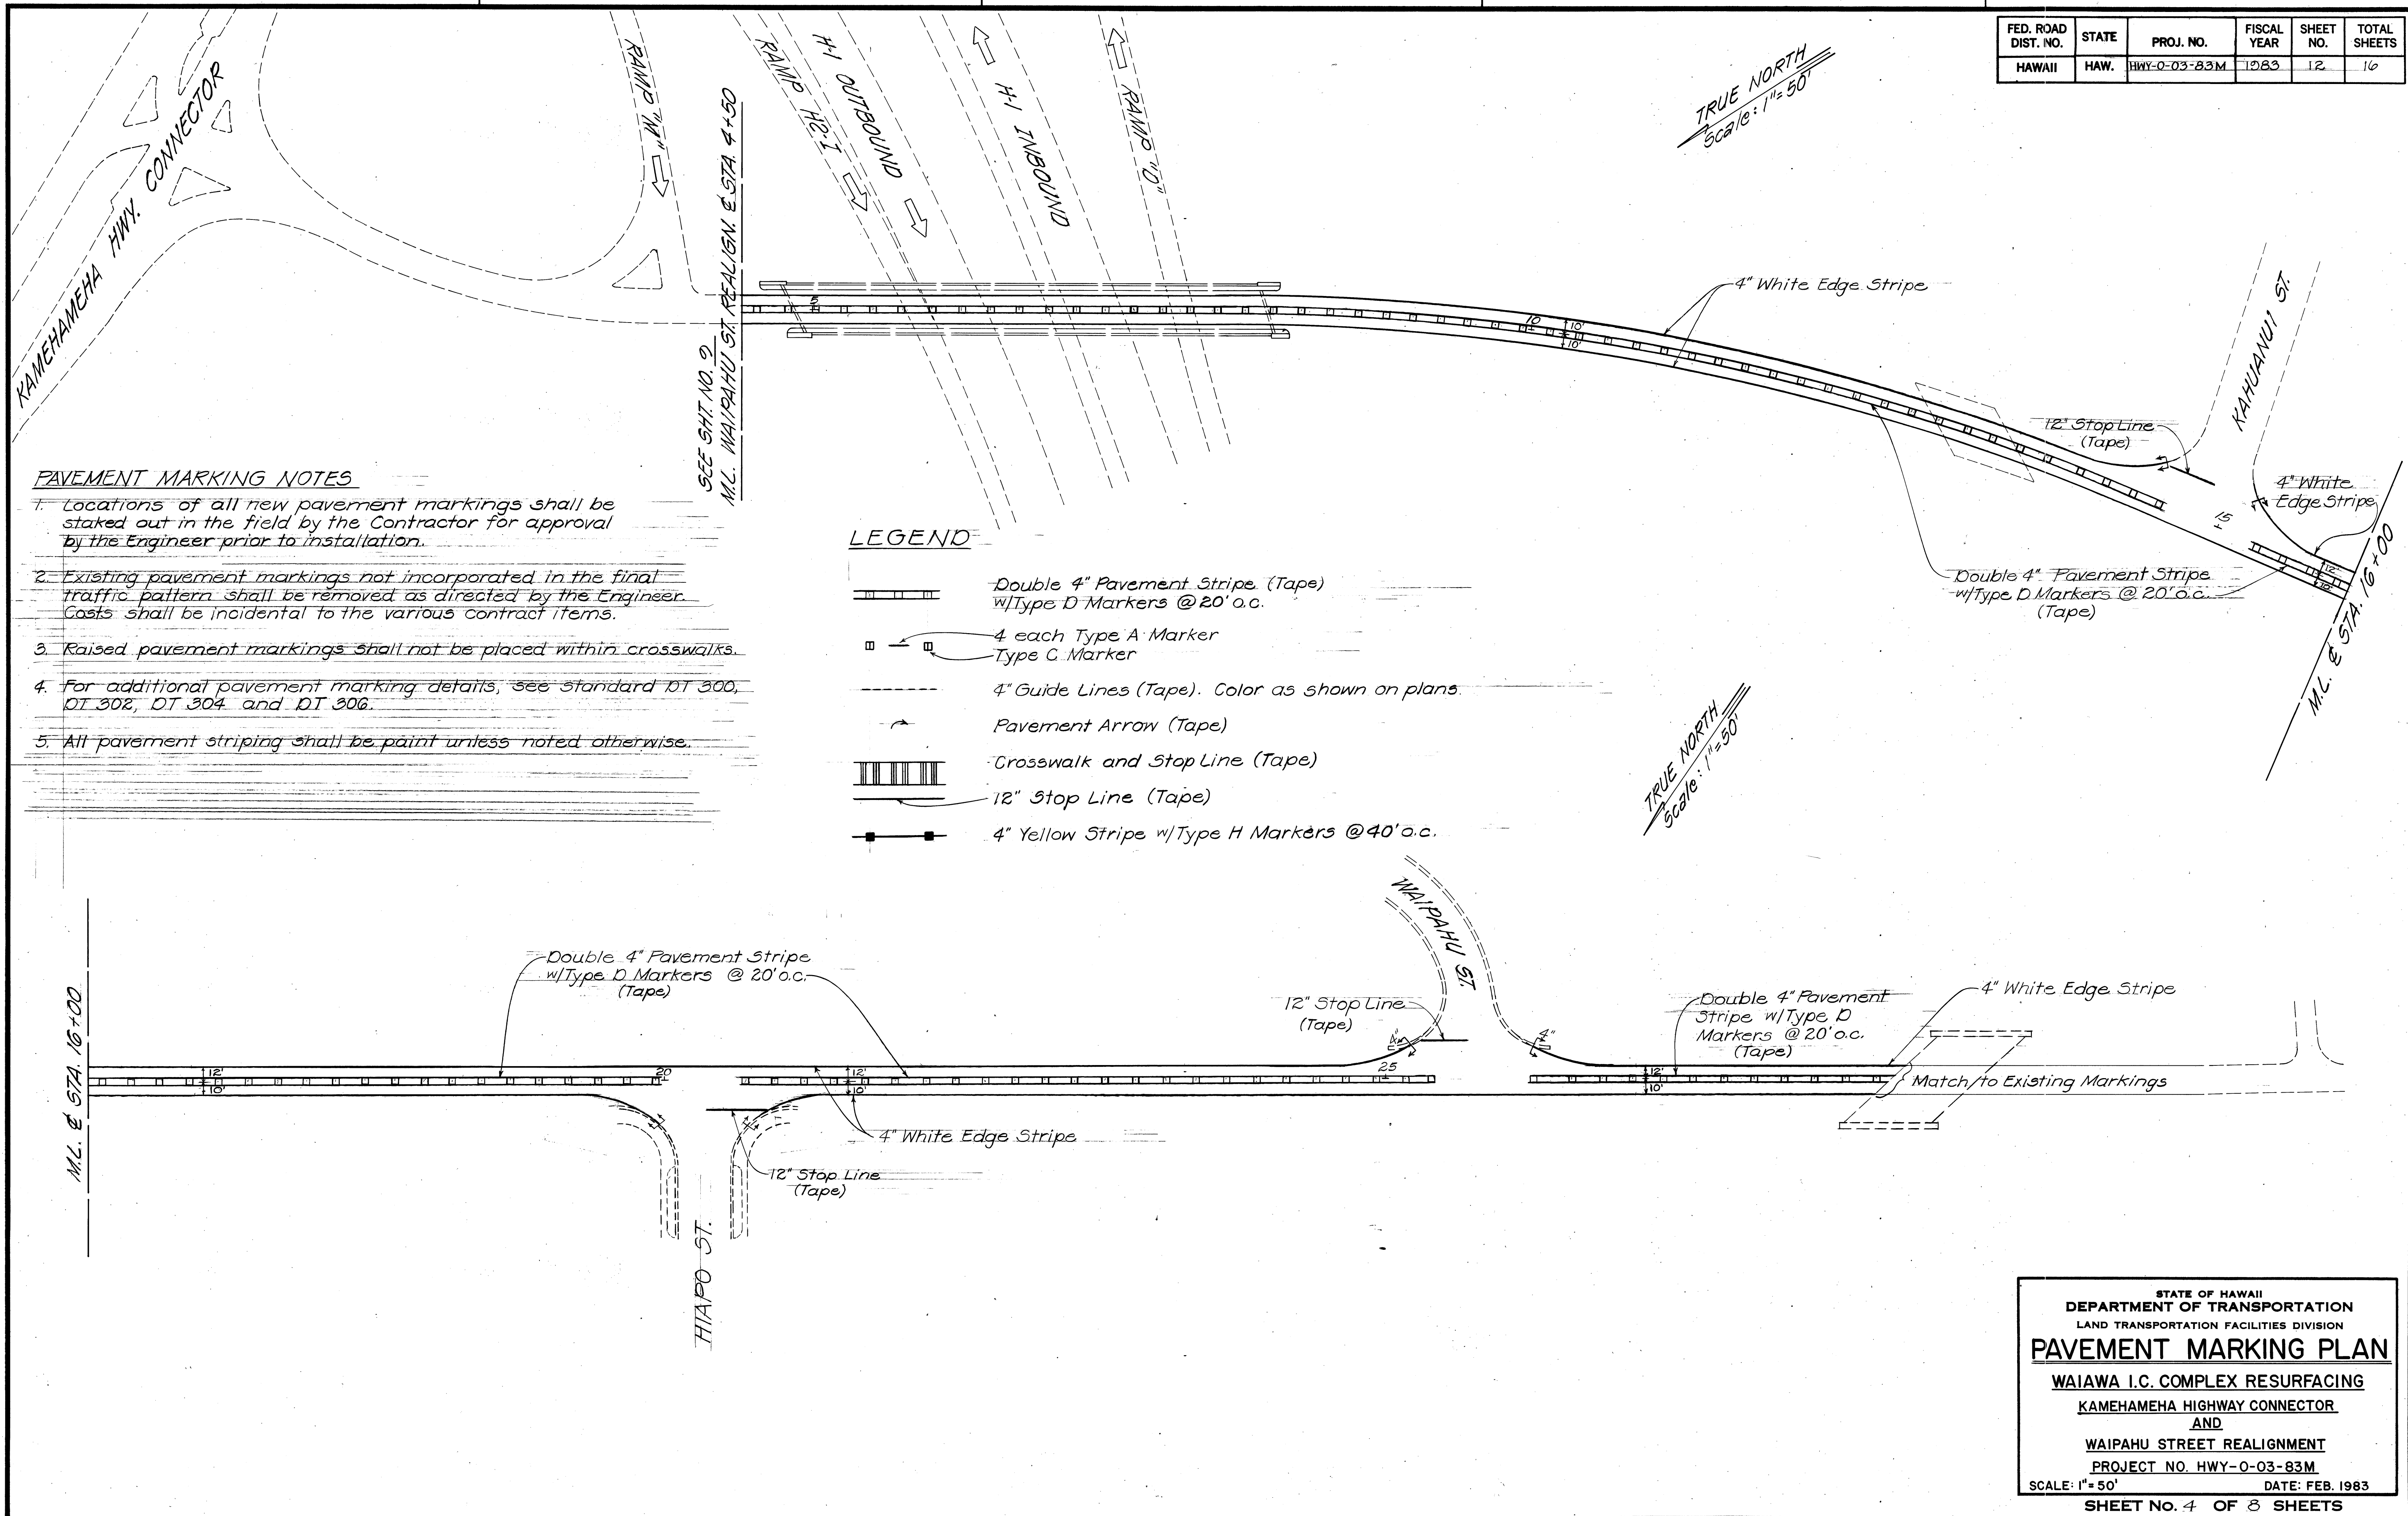

STATE OF HAWAII
DEPARTMENT OF TRANSPORTATION
LAND TRANSPORTATION FACILITIES DIVISION

PAVEMENT MARKING PLAN

WAIKALUA I.C. COMPLEX RESURFACING
KAMEHAMEHA HIGHWAY CONNECTOR
AND
WAIKALUA STREET REALIGNMENT
PROJECT NO. HWY-0-03-83M
SCALE: 1" = 50' DATE: FEB. 1983
SHEET No. 4 OF 8 SHEETS