	INDEX TO DRAWINGS
SHEET NO.	DESCRIPTION
	TITLE SHEET
2	LAYOUT SHEET
3	FOG SEAL SCHEDULE
4-5	GENERAL NOTES & TYPICAL SECTIONS
:	
· .	

STATE OF HAWAII

DEPARTMENT OF TRANSPORTATION
HIGHWAYS DIVISION
HONOLULU, HAWAII


"AS BUILT "

PLANS FOR

FOG SEAL
AT
VARIOUS LOCATIONS ON OAHU
ROUTE NOS. 63, 750, & H-2

PROJECT NO. HWY-0-04-90M

DISTRICTS OF HONOLULU, EWA & WAHIAWA ISLAND OF OAHU

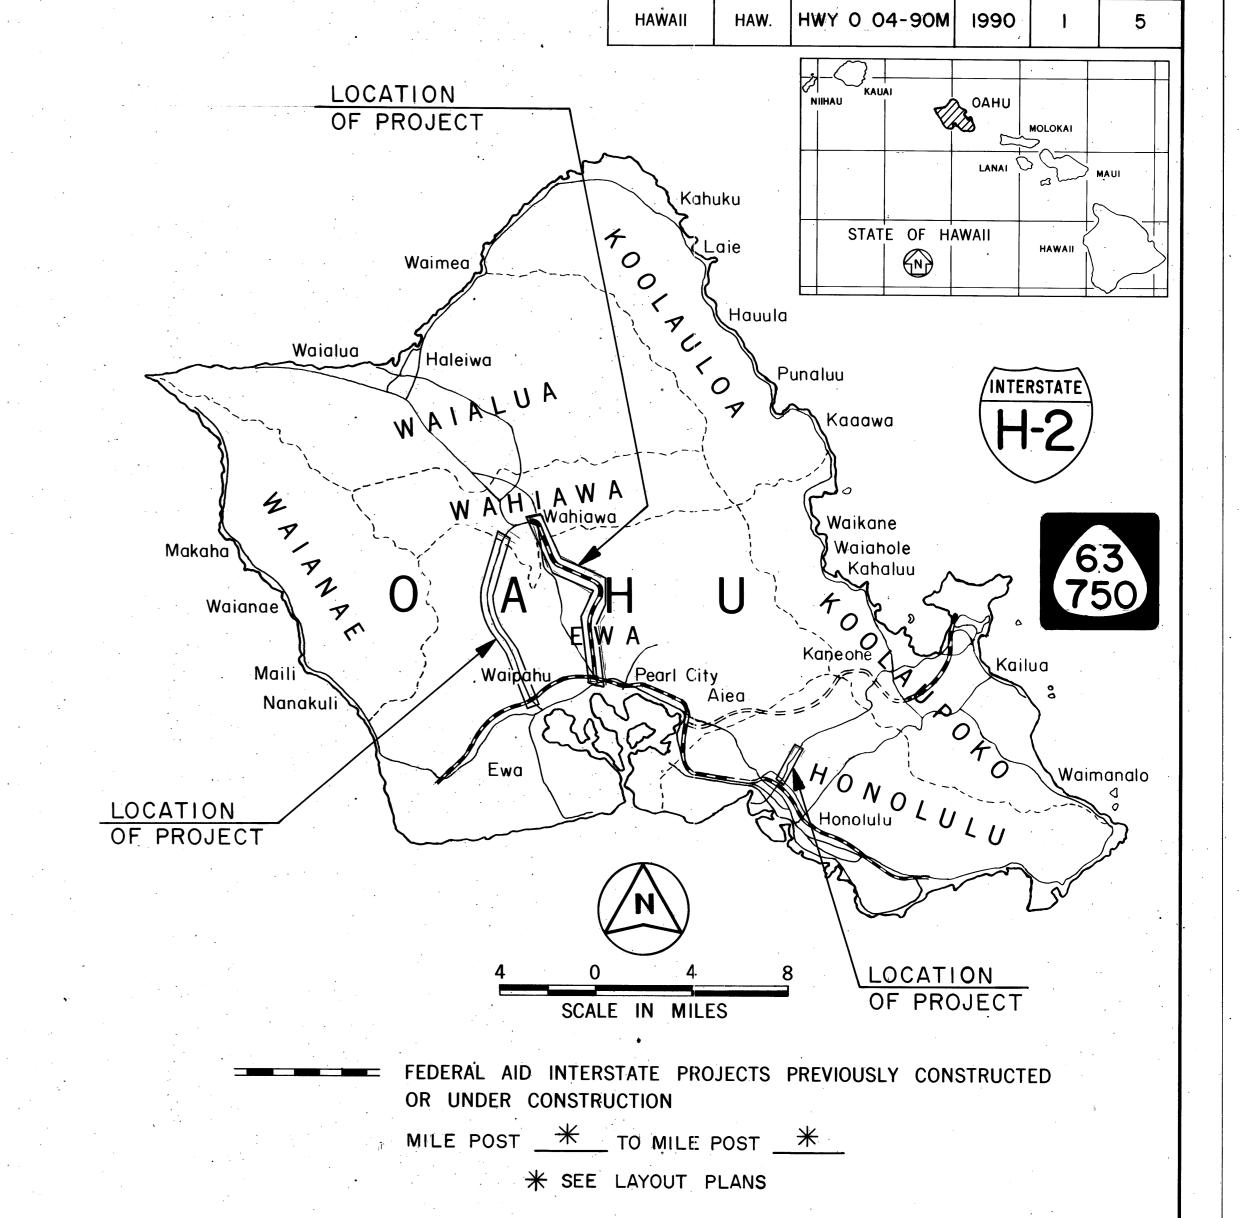

FED. ROAD DIST. NO.

NO SIGNIFICANT CHANGES WERE MADE DURING CONSTRUCTION ON THESE PLANS EXCEPT CHANGES IN THE ORIGINAL THEORETICAL QUANTITIES FOR ACTUAL QUANTITIES, REFER TO PROJECT LEDGER AND/OR COMPUTATION BOOK.

Muhael Daniega RESIDENT ENGINEER

1/9/97 DATE

DEPARTMENT OF TRANSPORTATION STATE OF HAWAII

APPROVED:

DIR. OF TRANSPORTATION

2/7/90 DATE

NISHIMURA ALLAN NISHIMURA 548-7490 JAN., 1990
IGNED BY P. S. & E. BY PHONE DATE

1