



- NOTE:
1. ALL WORK ON THIS PROJECT CONSISTS OF THE PLACEMENT OF ELEVEN (11) INSECTS, THE INSTALLATION OF TWO (2) 5' LONG 6" PIPES & CAPPING END OF THE 6" PIPES. ALL OTHER ITEMS SHOWN ARE FOR INFORMATIONAL PURPOSES ONLY.
 2. N.I.C. MEANS NOT IN CONTRACT.
 3. CAP LOCATIONS SHALL BE MARKED ON THE FINISHED PAVEMENT.
 4. CAPS, MARKERS, SLEEVES, HOLES IN BENTS AND PREMOLDED FILLER SHALL BE INCIDENTAL TO ITEM 025.5000.

FED. ROAD DIST. NO.	STATE	FED. AID PROJ. NO.	FISCAL YEAR	SHEET NO.	TOTAL SHEETS
HAWAII	HAW.	I-H3-1(24)-II	1983	169	328

PLAN	DATE	BY
SURVEYED		
NOTED		
ALIGNED		
CHECKED		
RT. OF WAY		
NO.		

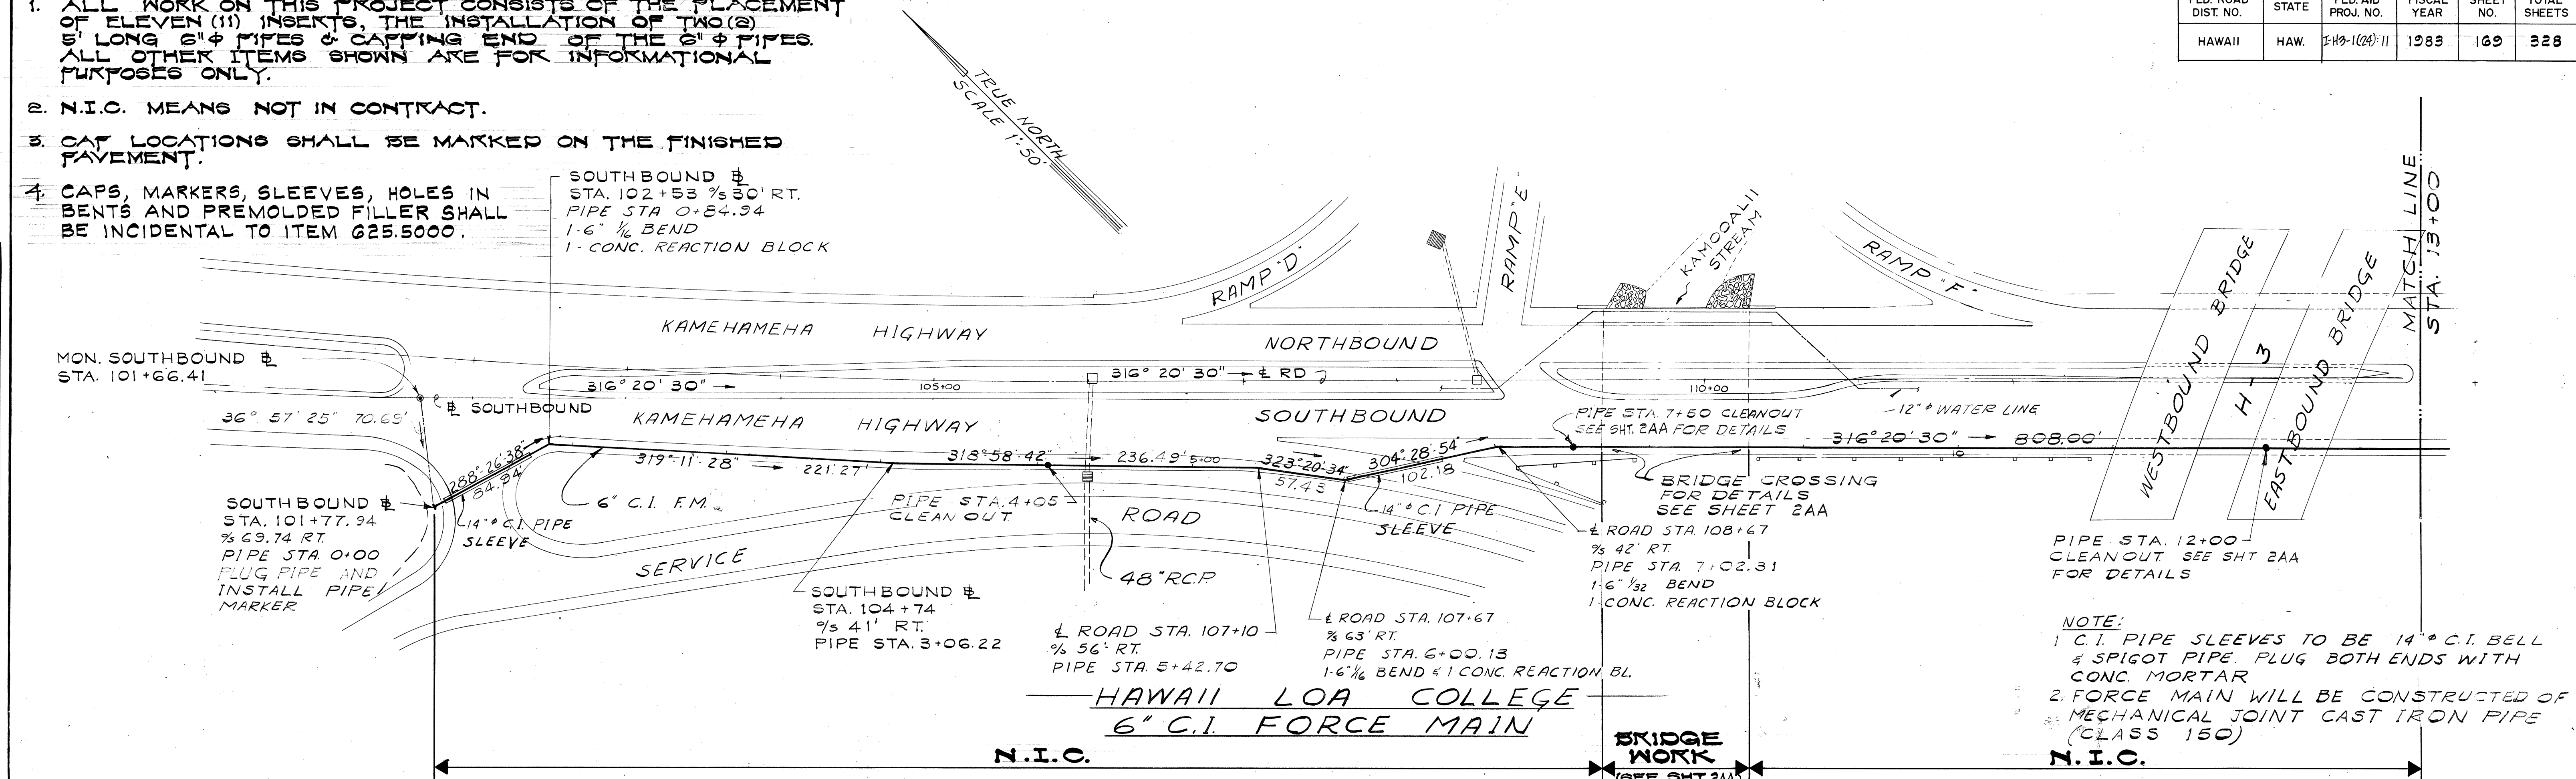

PROFILE	DATE	BY
SURVEYED		
NOTED		
GRADES CHECKED		
B.M.'S NOTED		
STRUCTURE NOTATIONS CHD.		
NO.		
















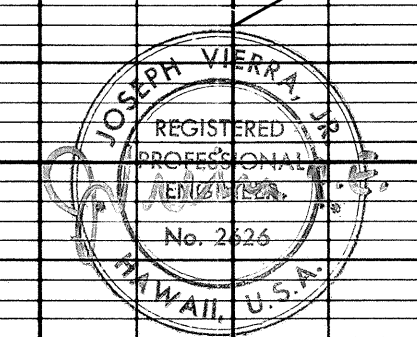


STATE OF HAWAII
DEPARTMENT OF TRANSPORTATION
HIGHWAYS DIVISION
HALEKOU INTERCHANGE
PROJ. NO. I-H3-1(24)-II

PLAN AND PROFILE

**HAWAII LOA COLLEGE
FORCE MAIN**

SCALE: AS SHOWN DATE: FEB. 1975
SHEET No. 169 OF 2 SHEETS

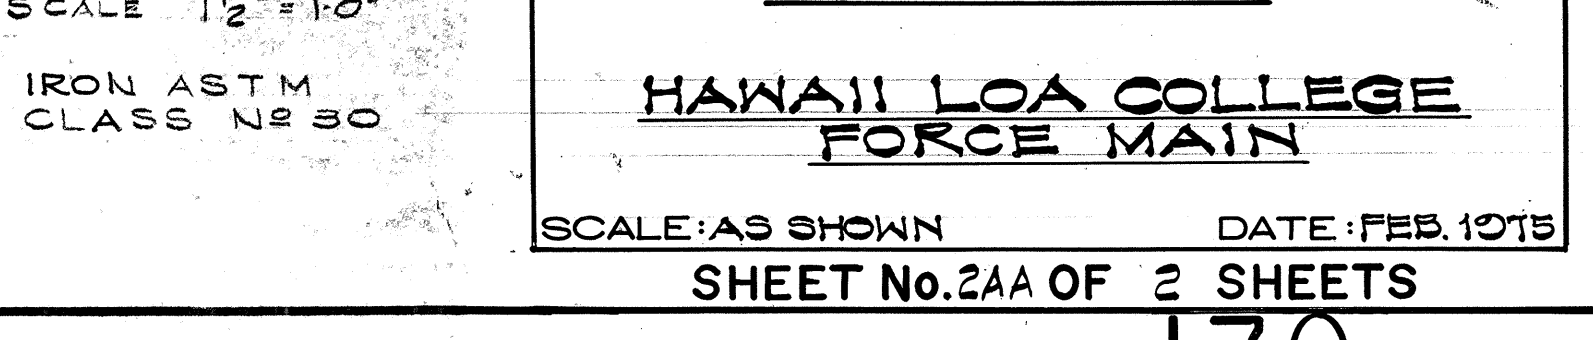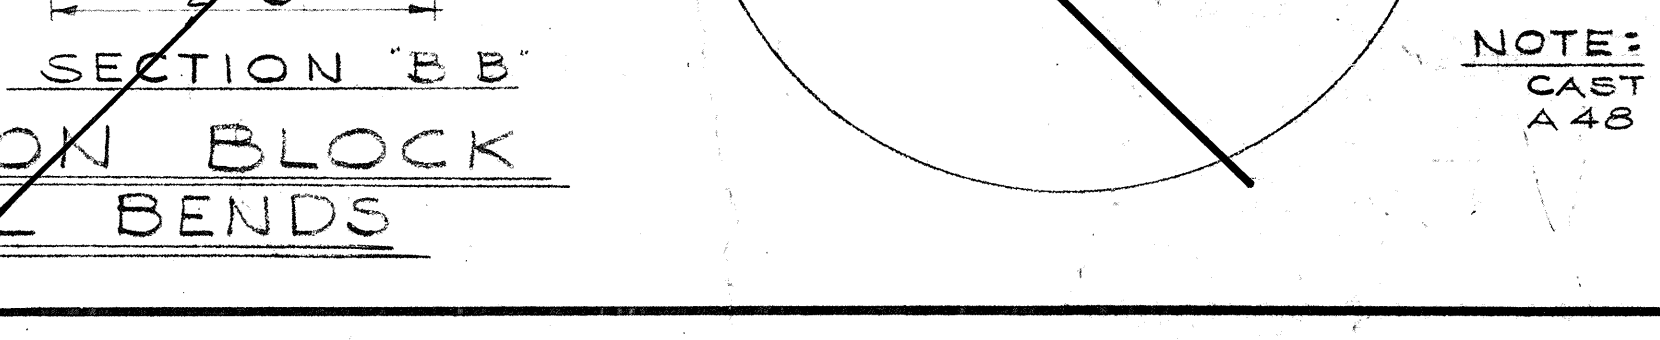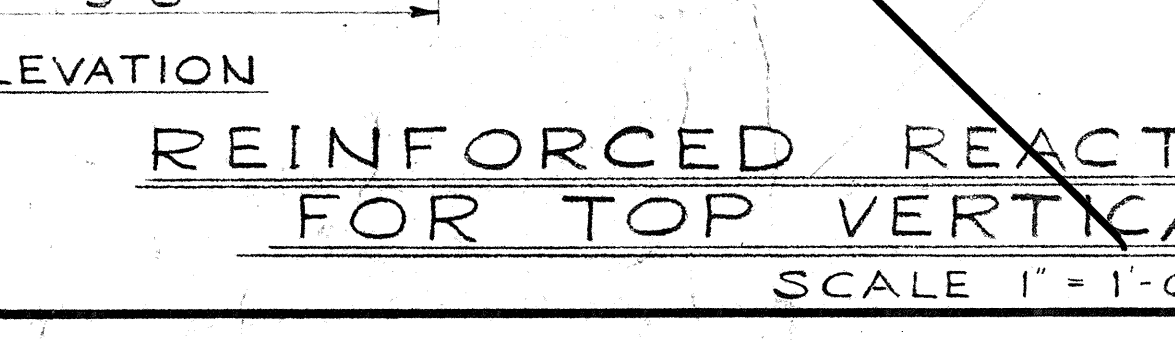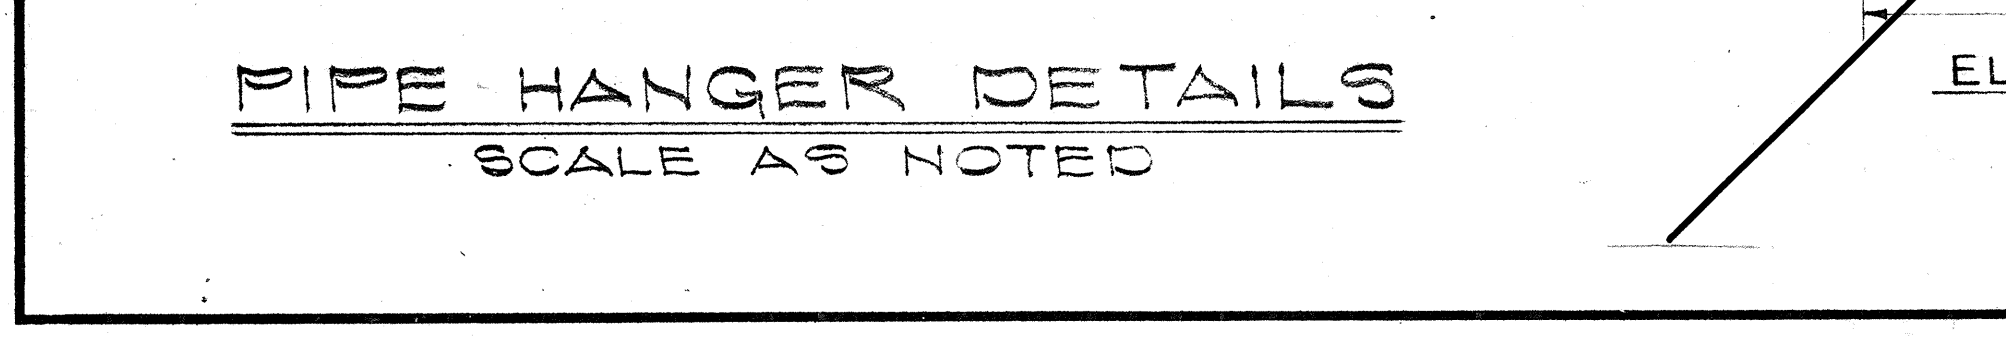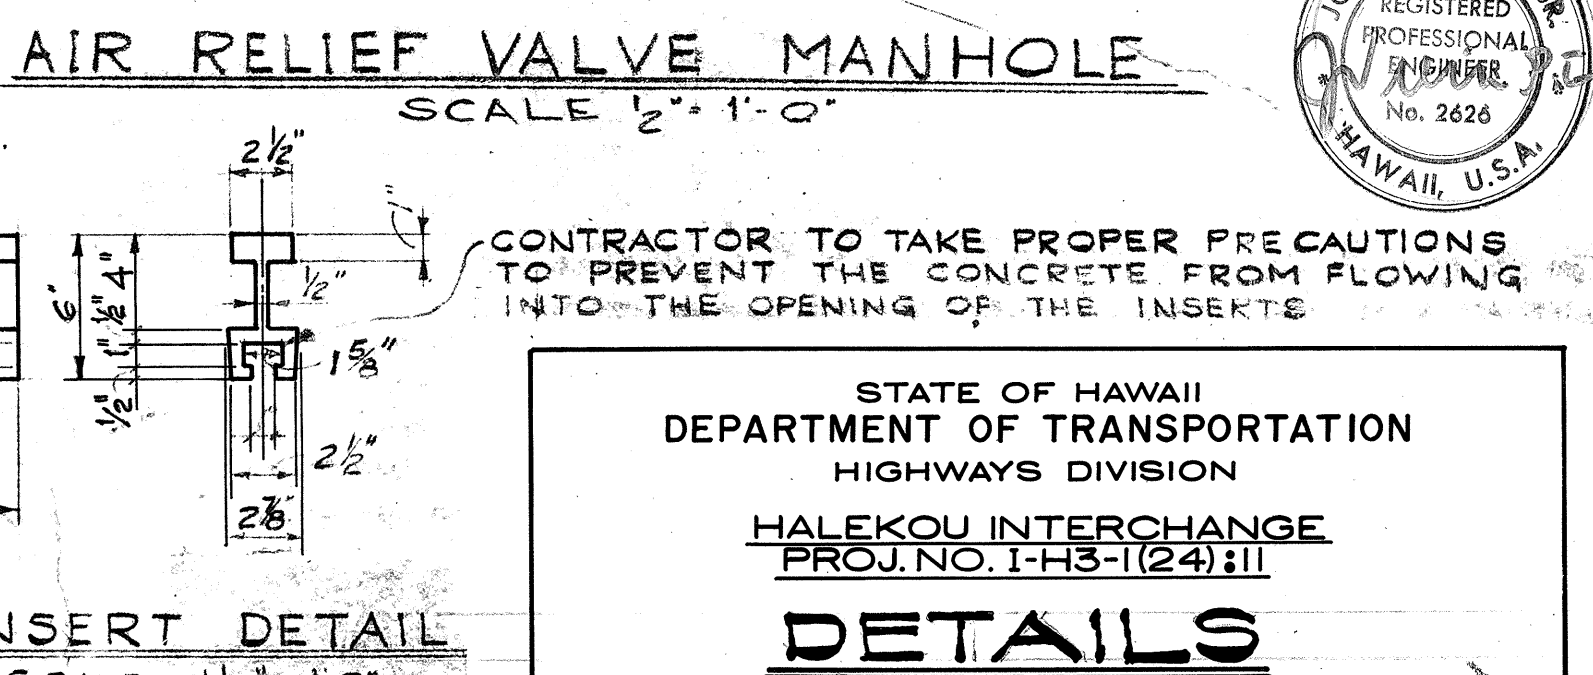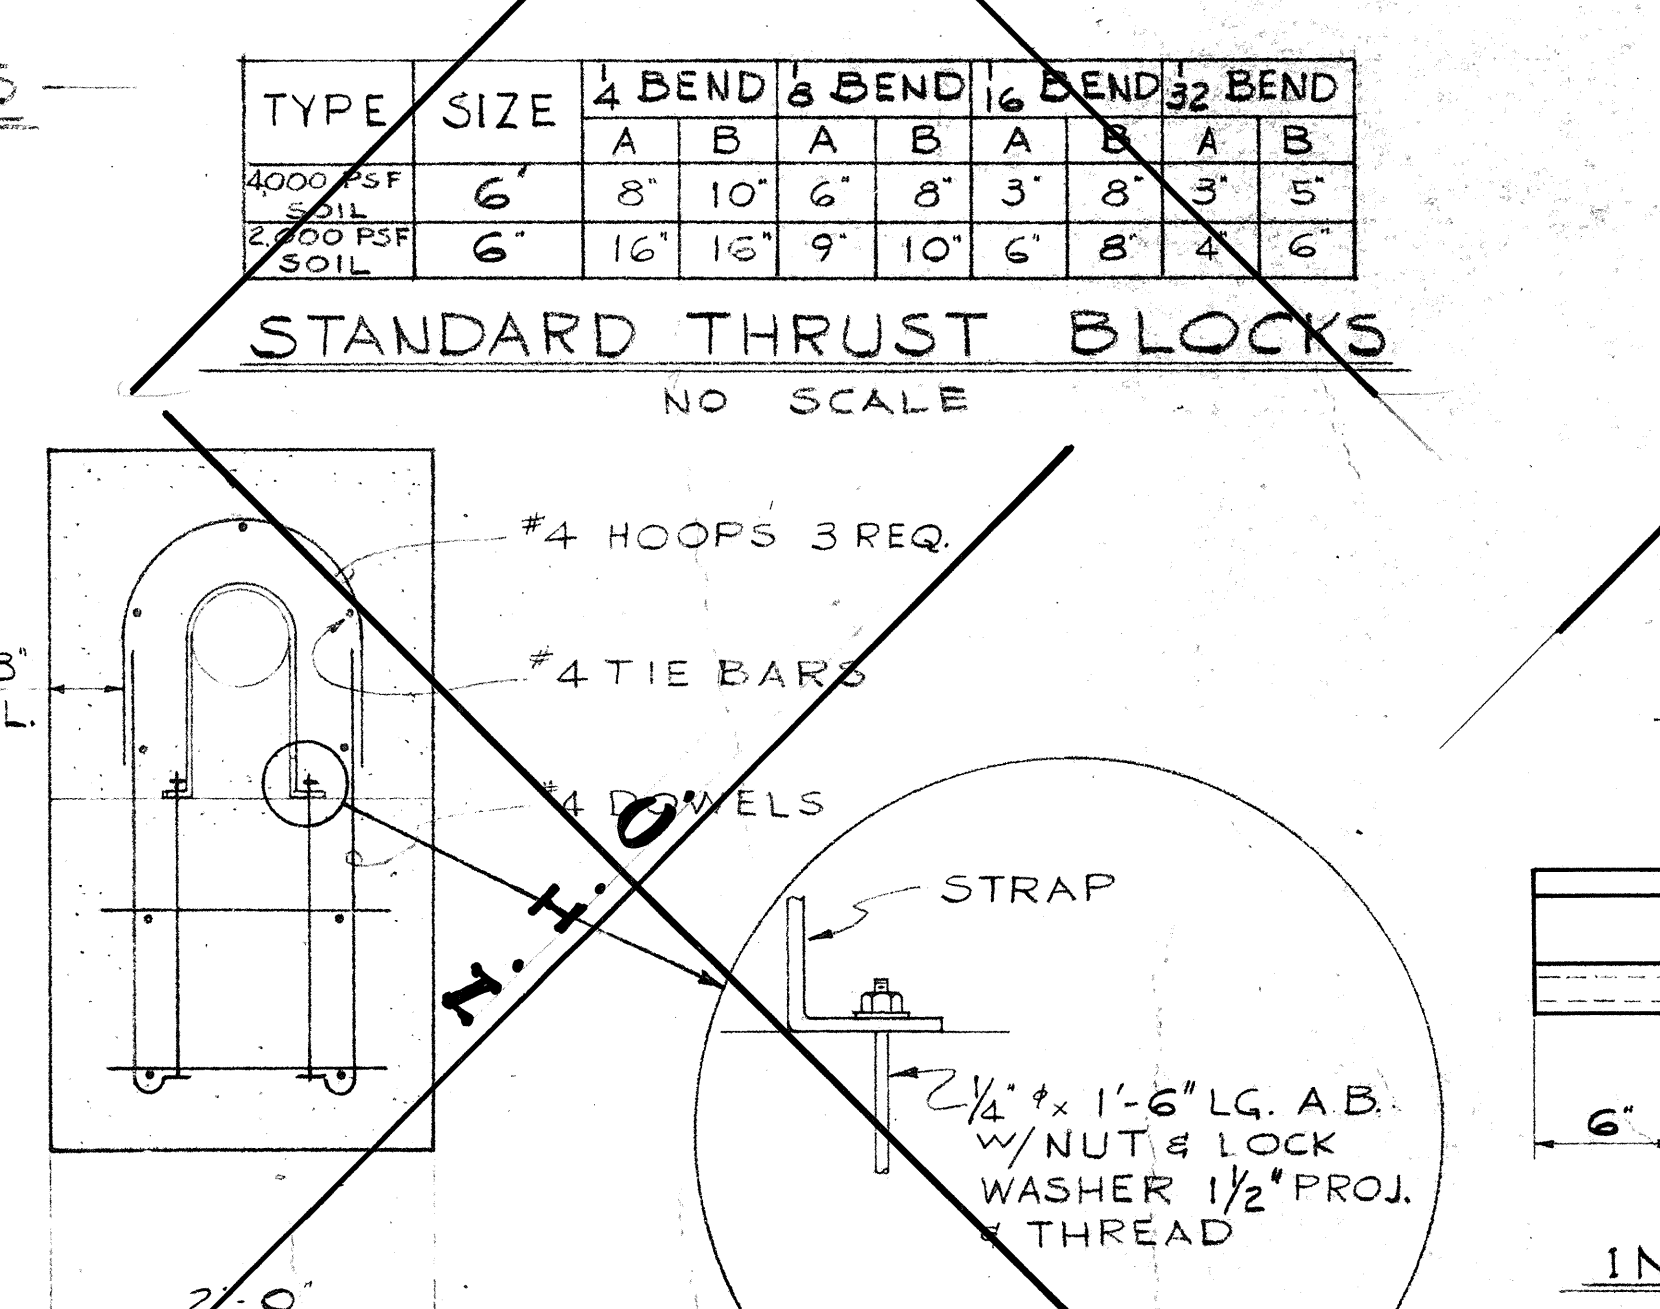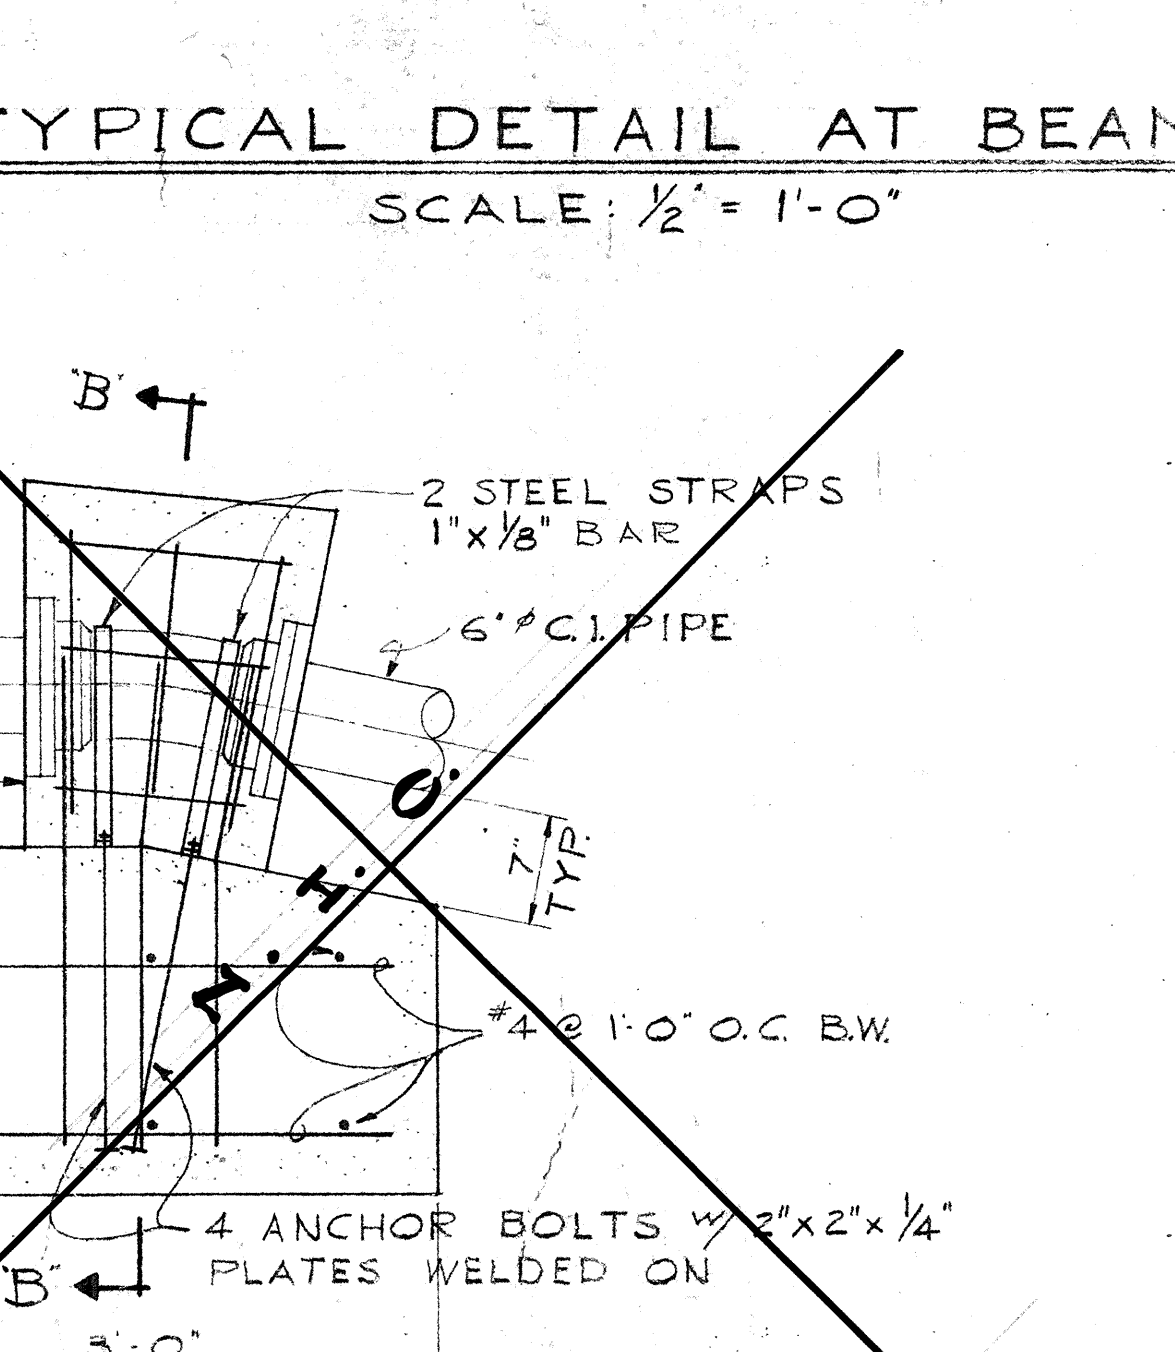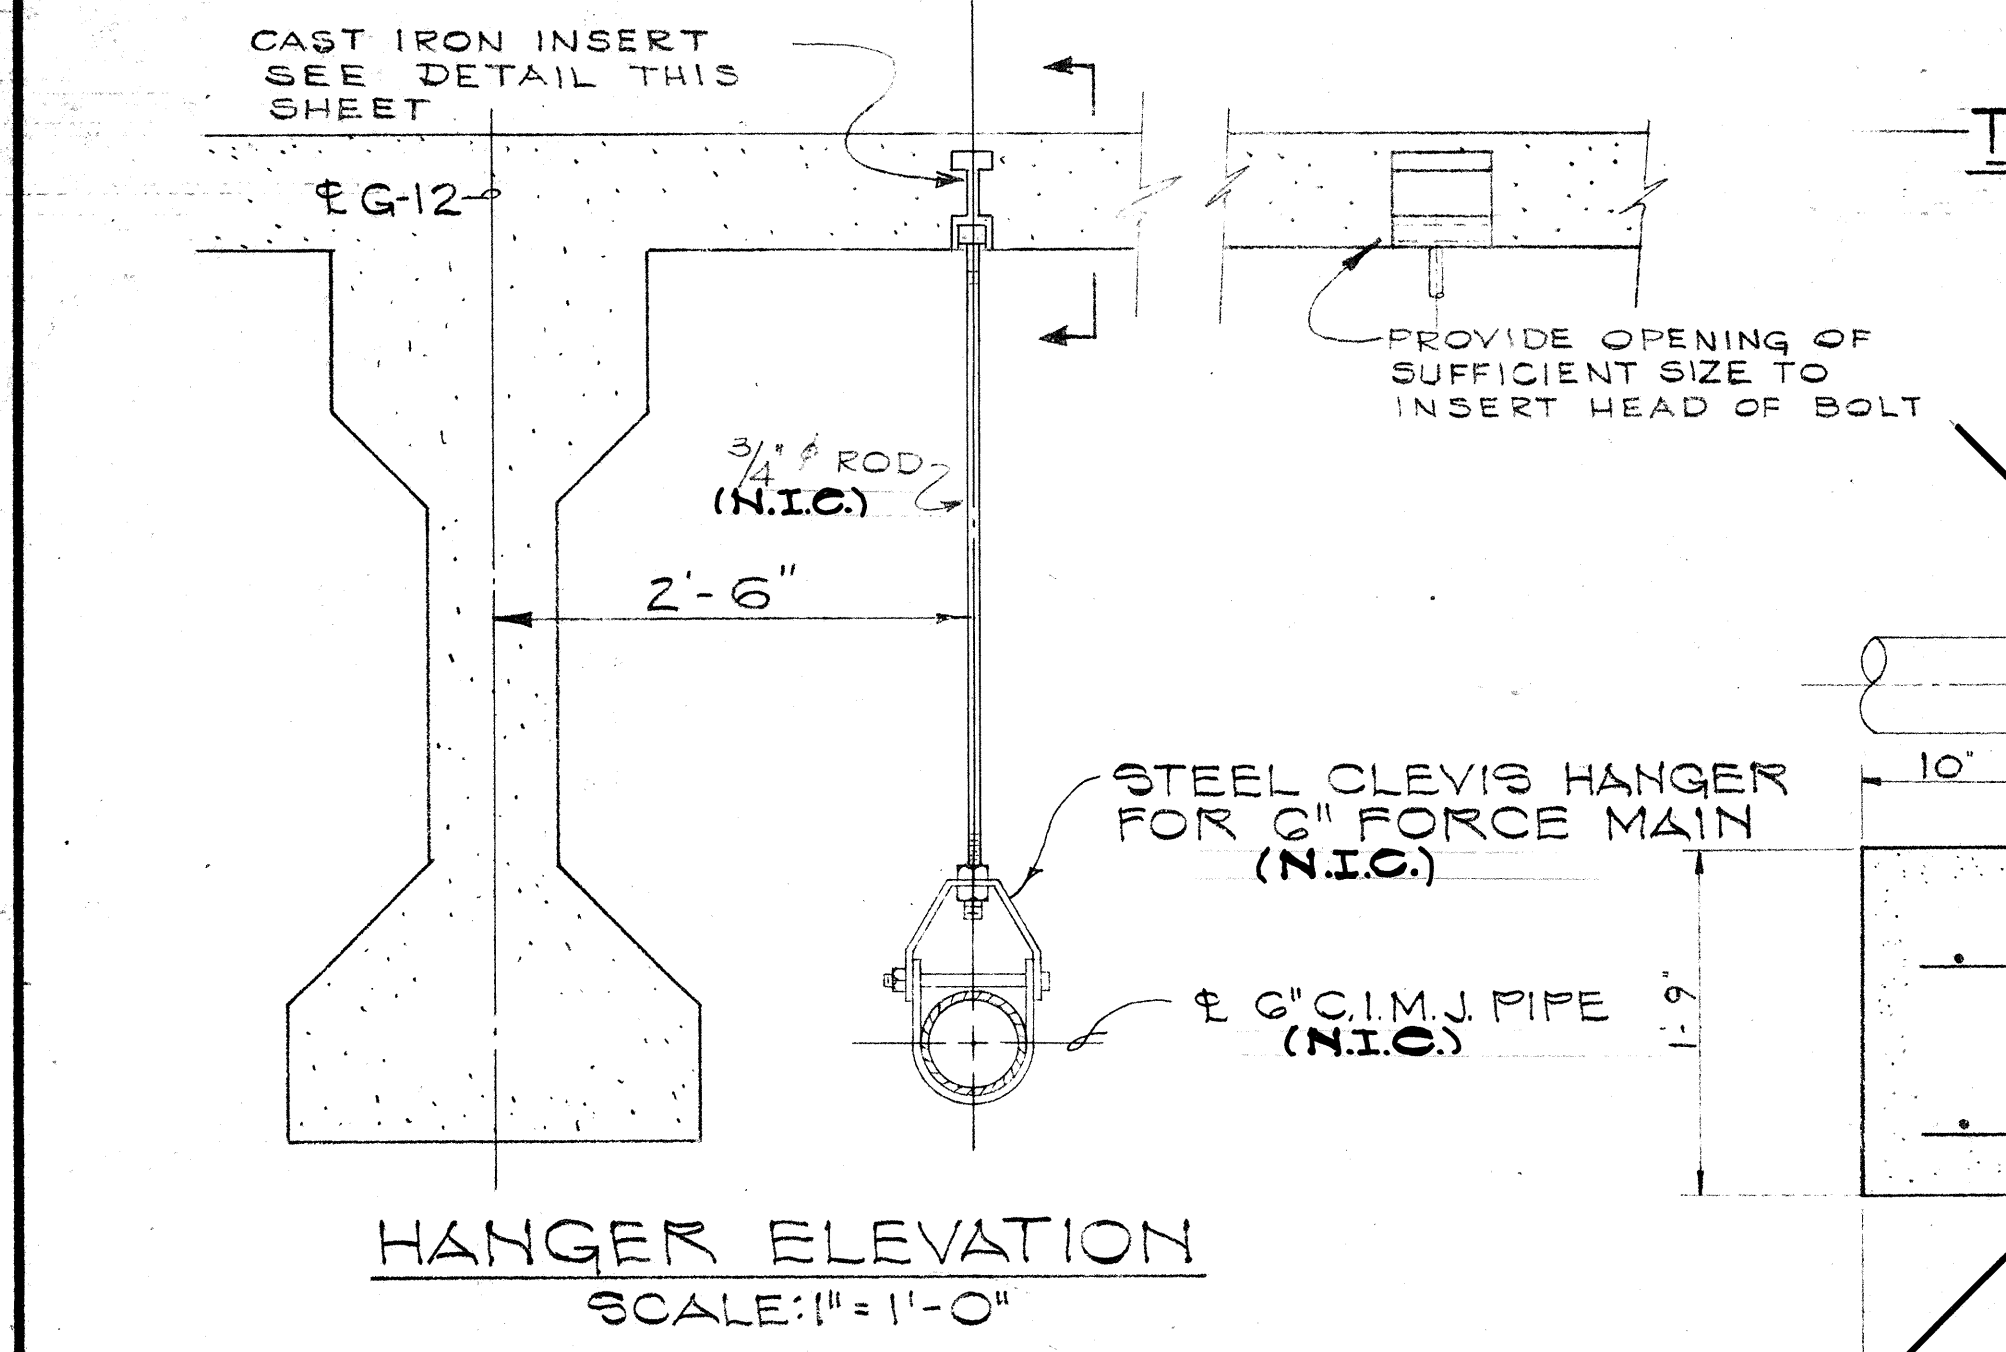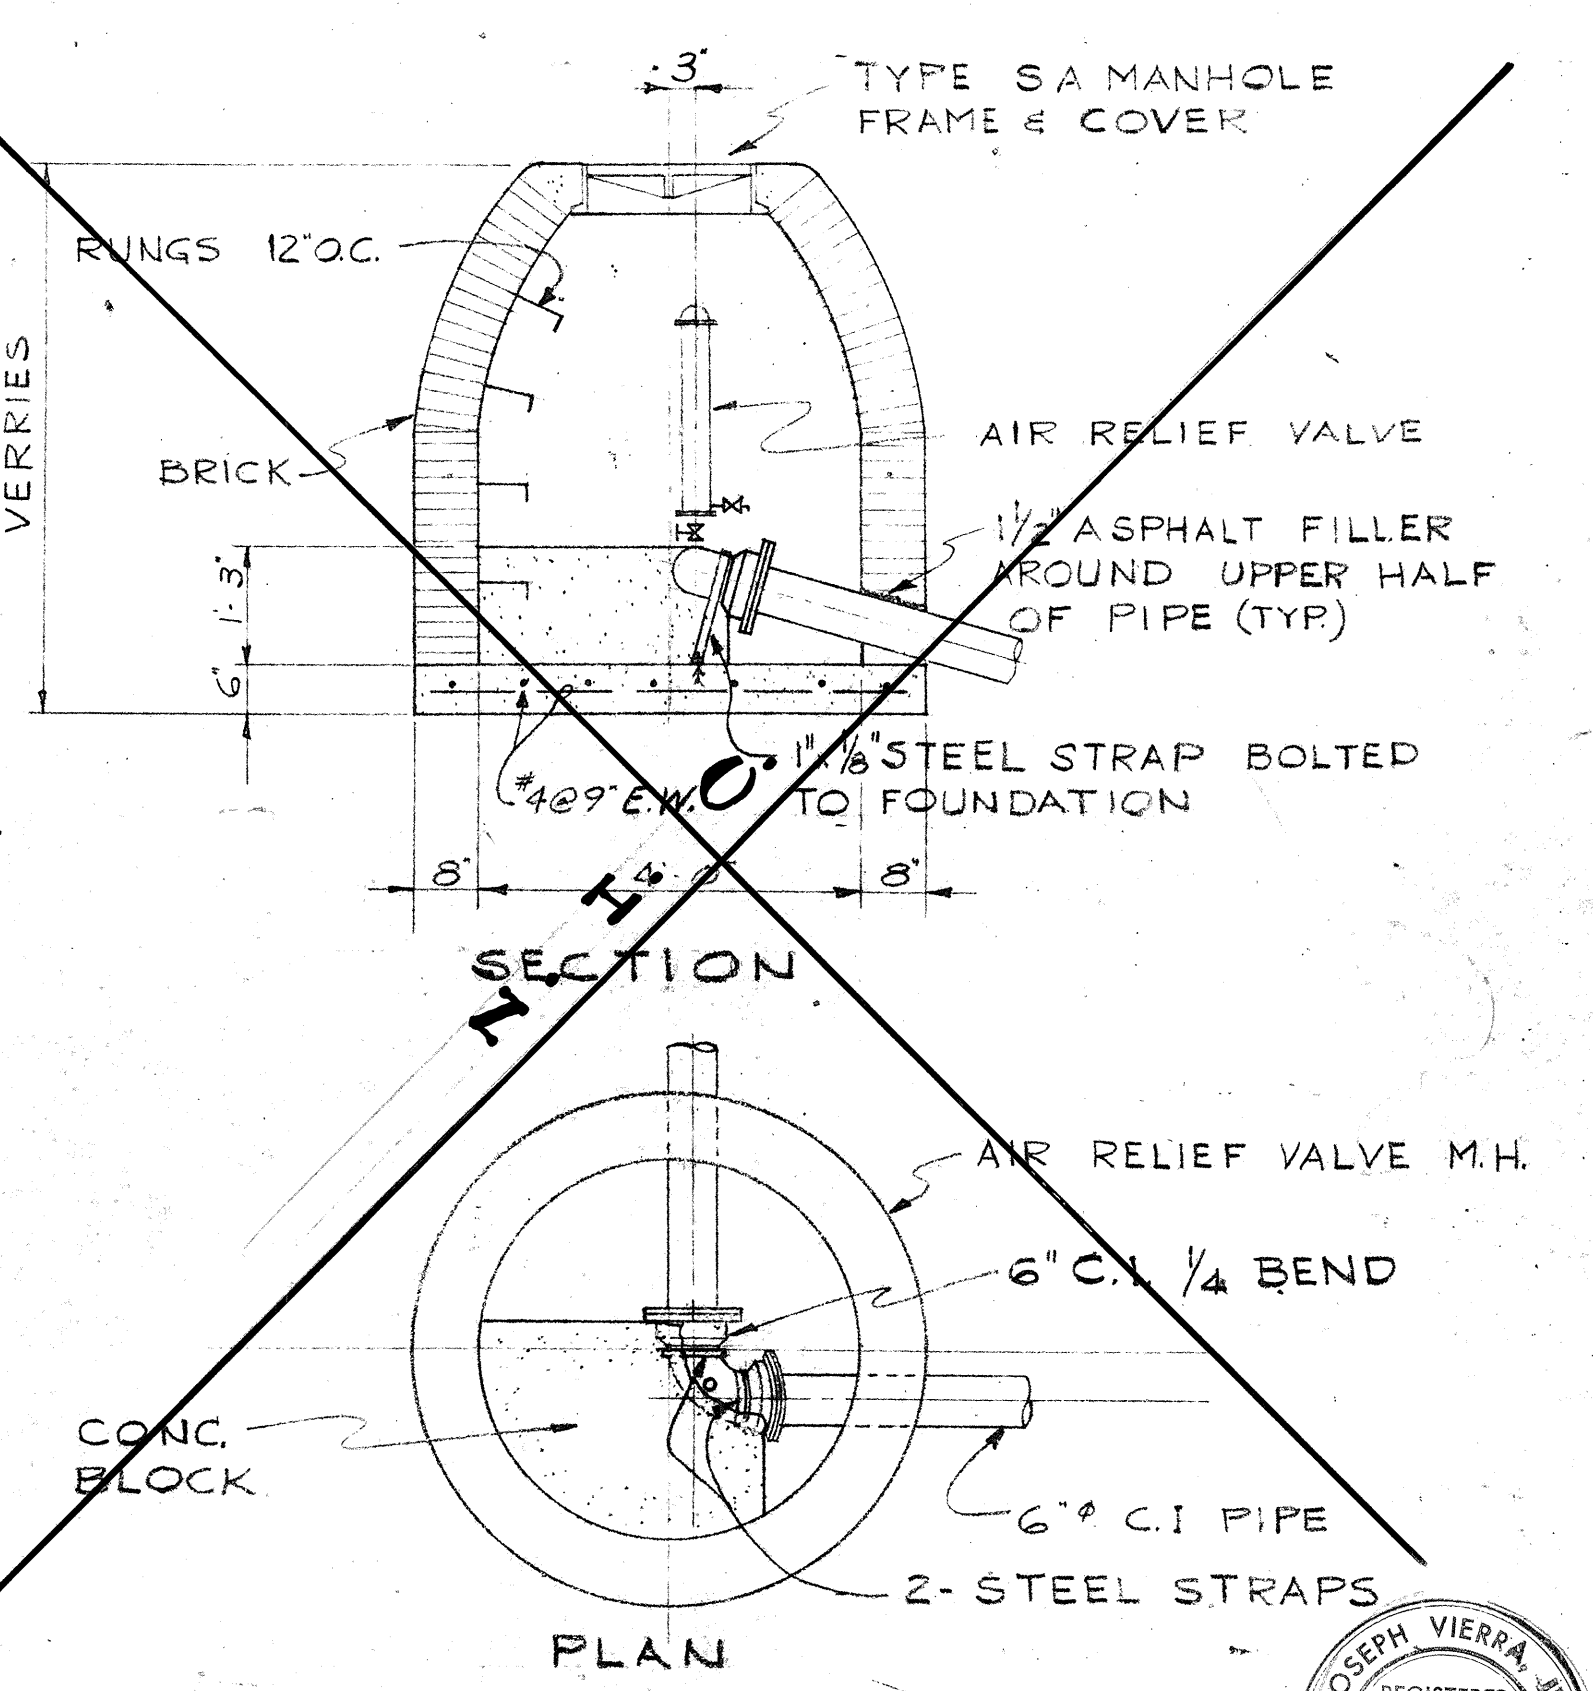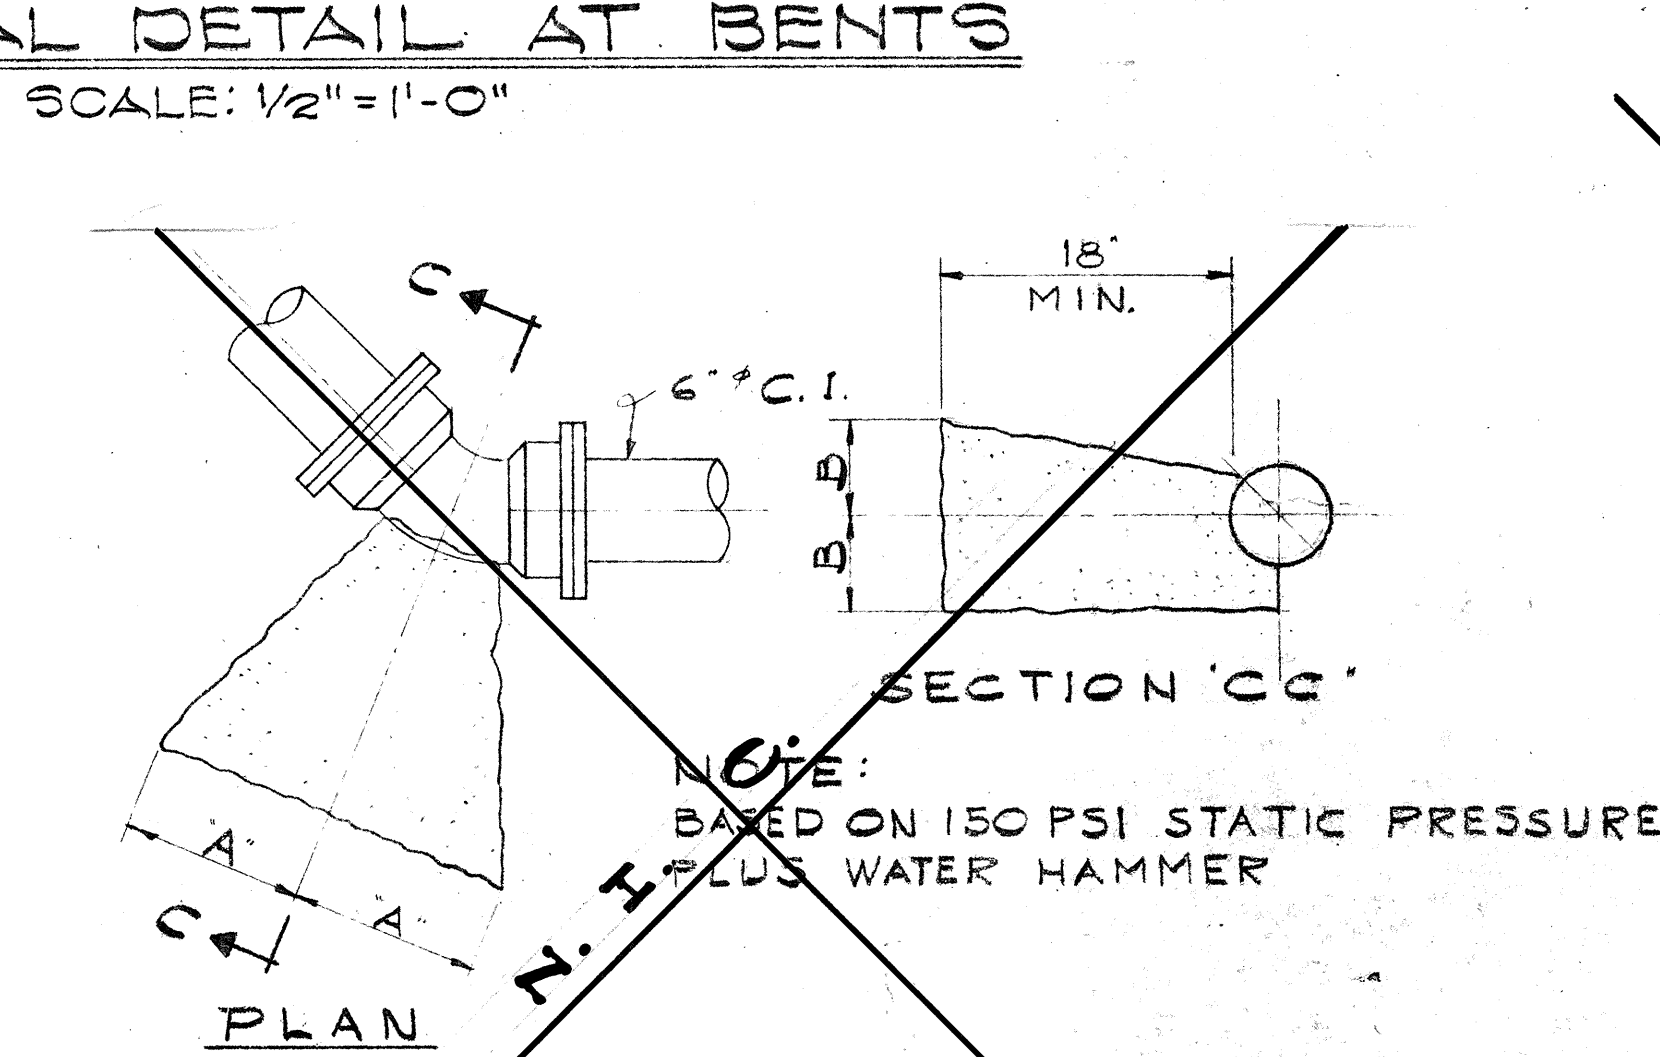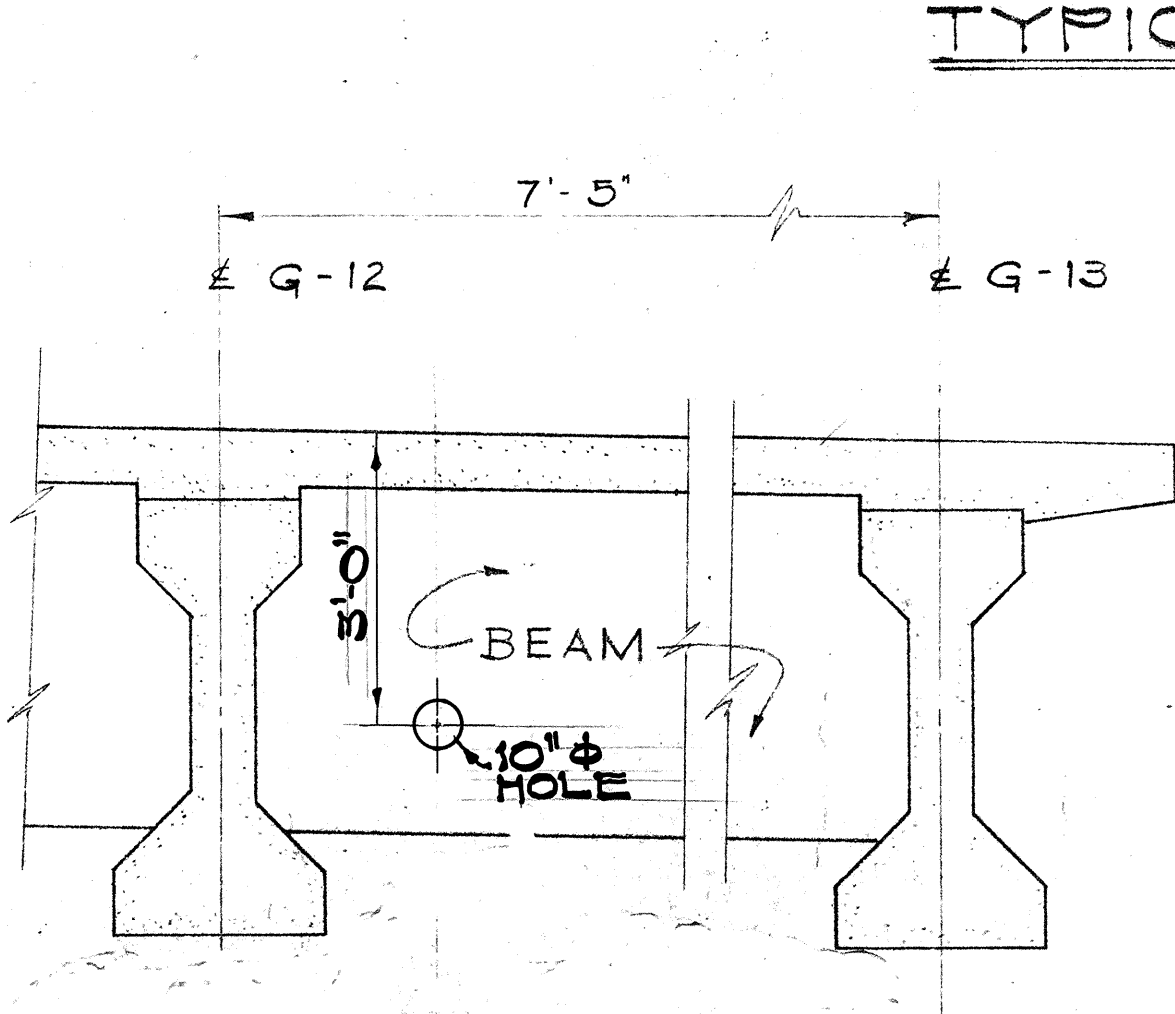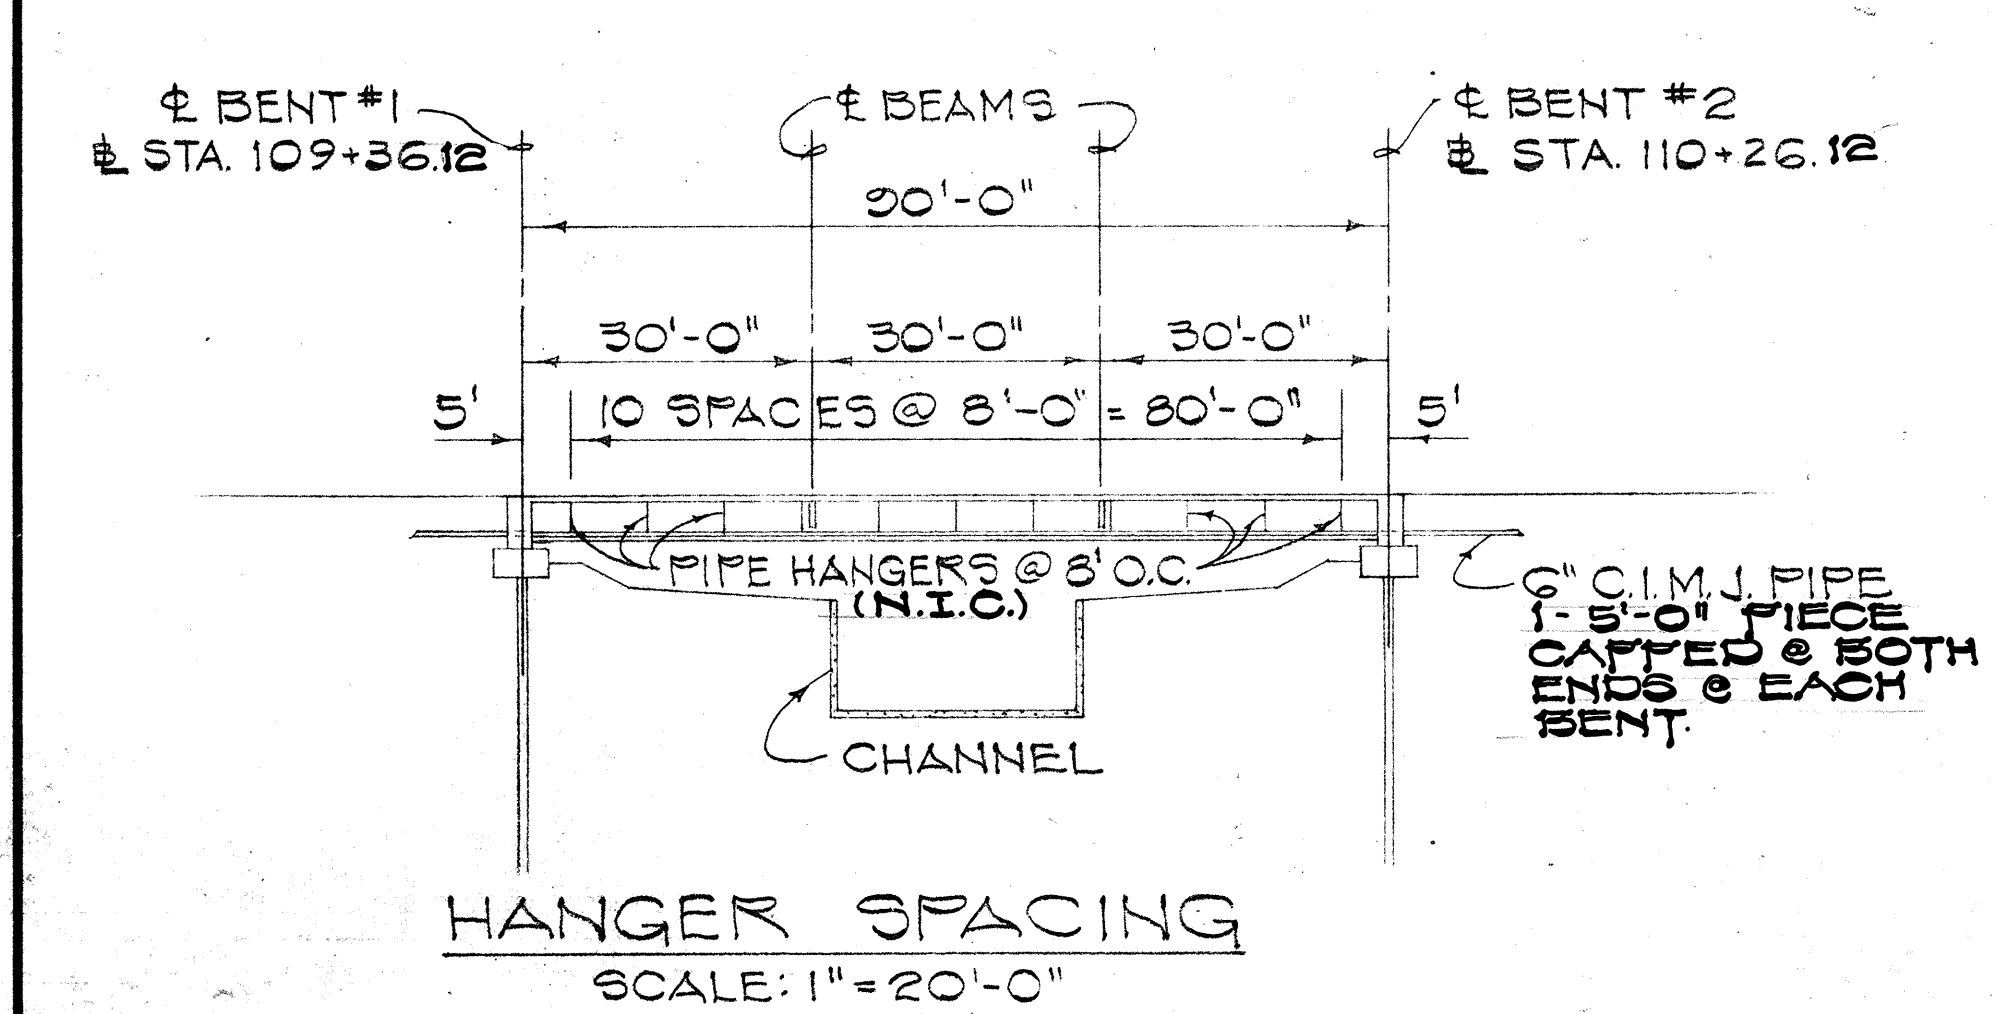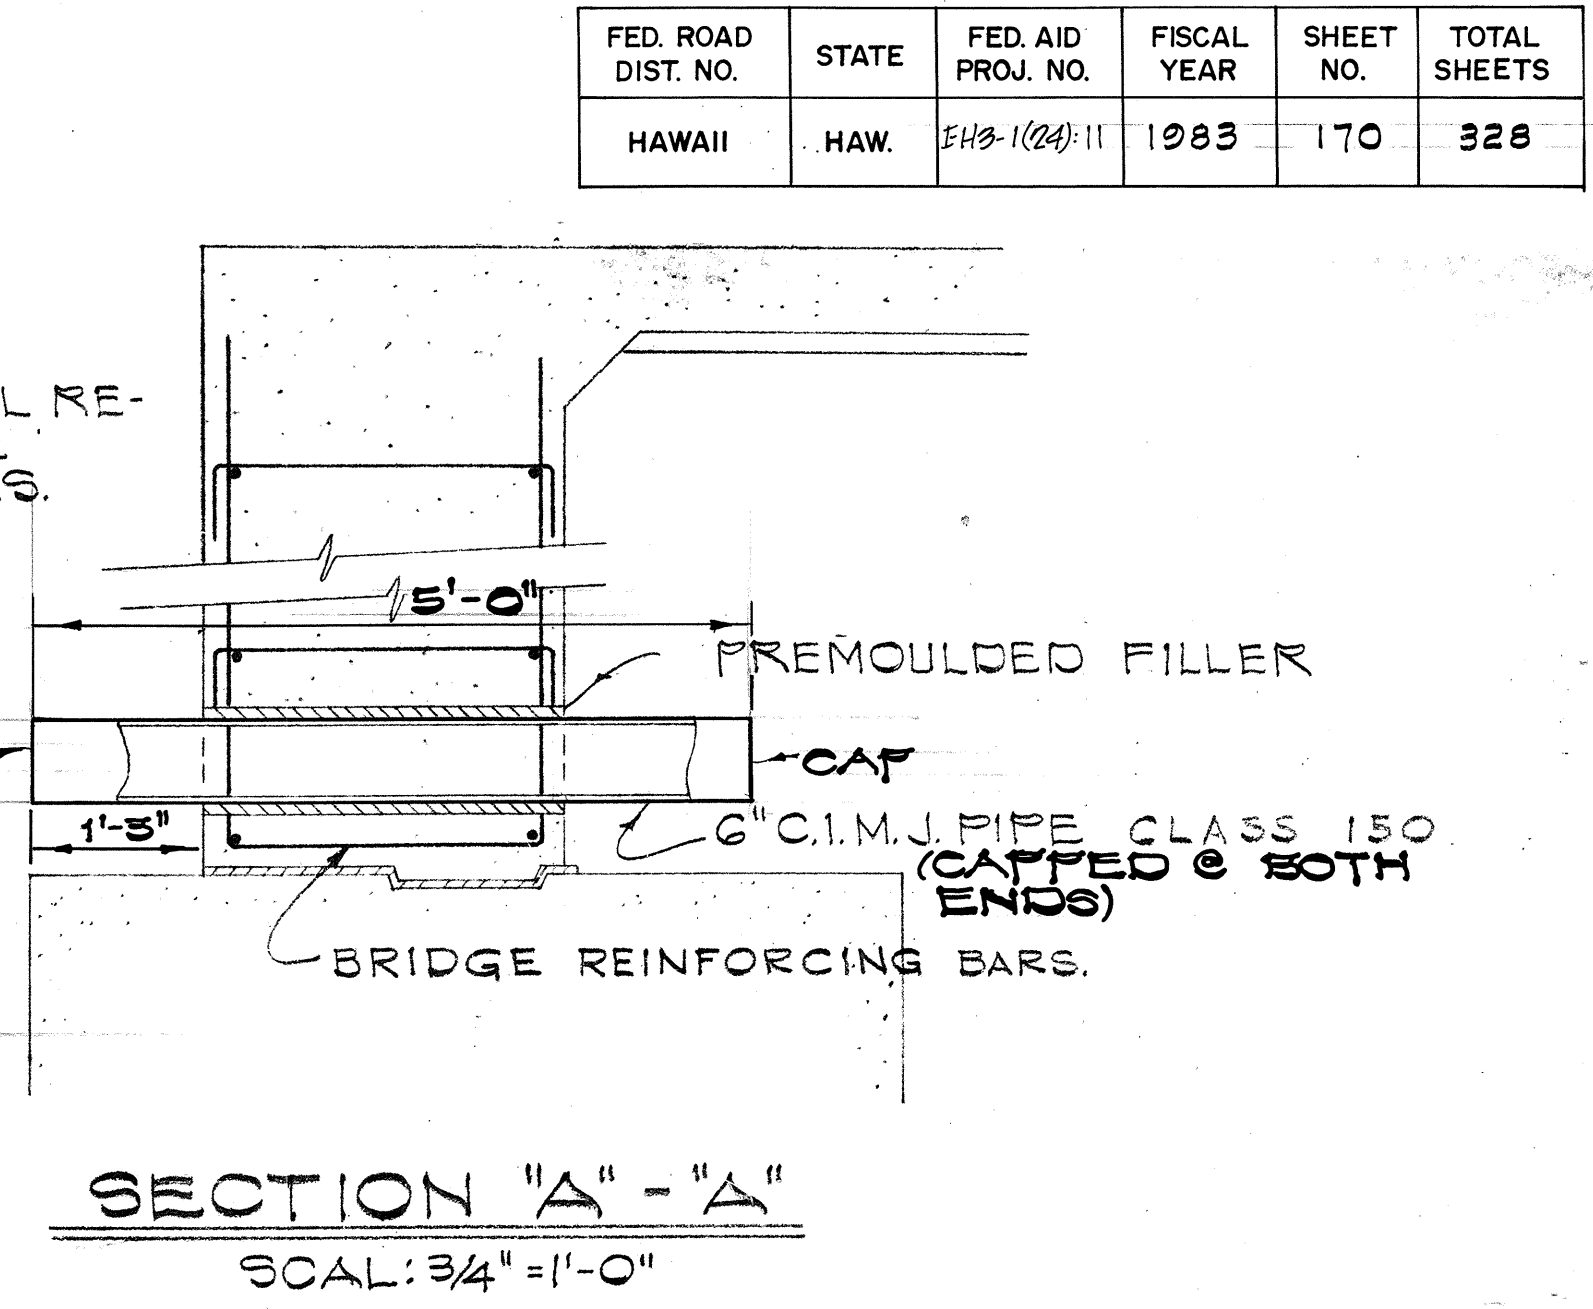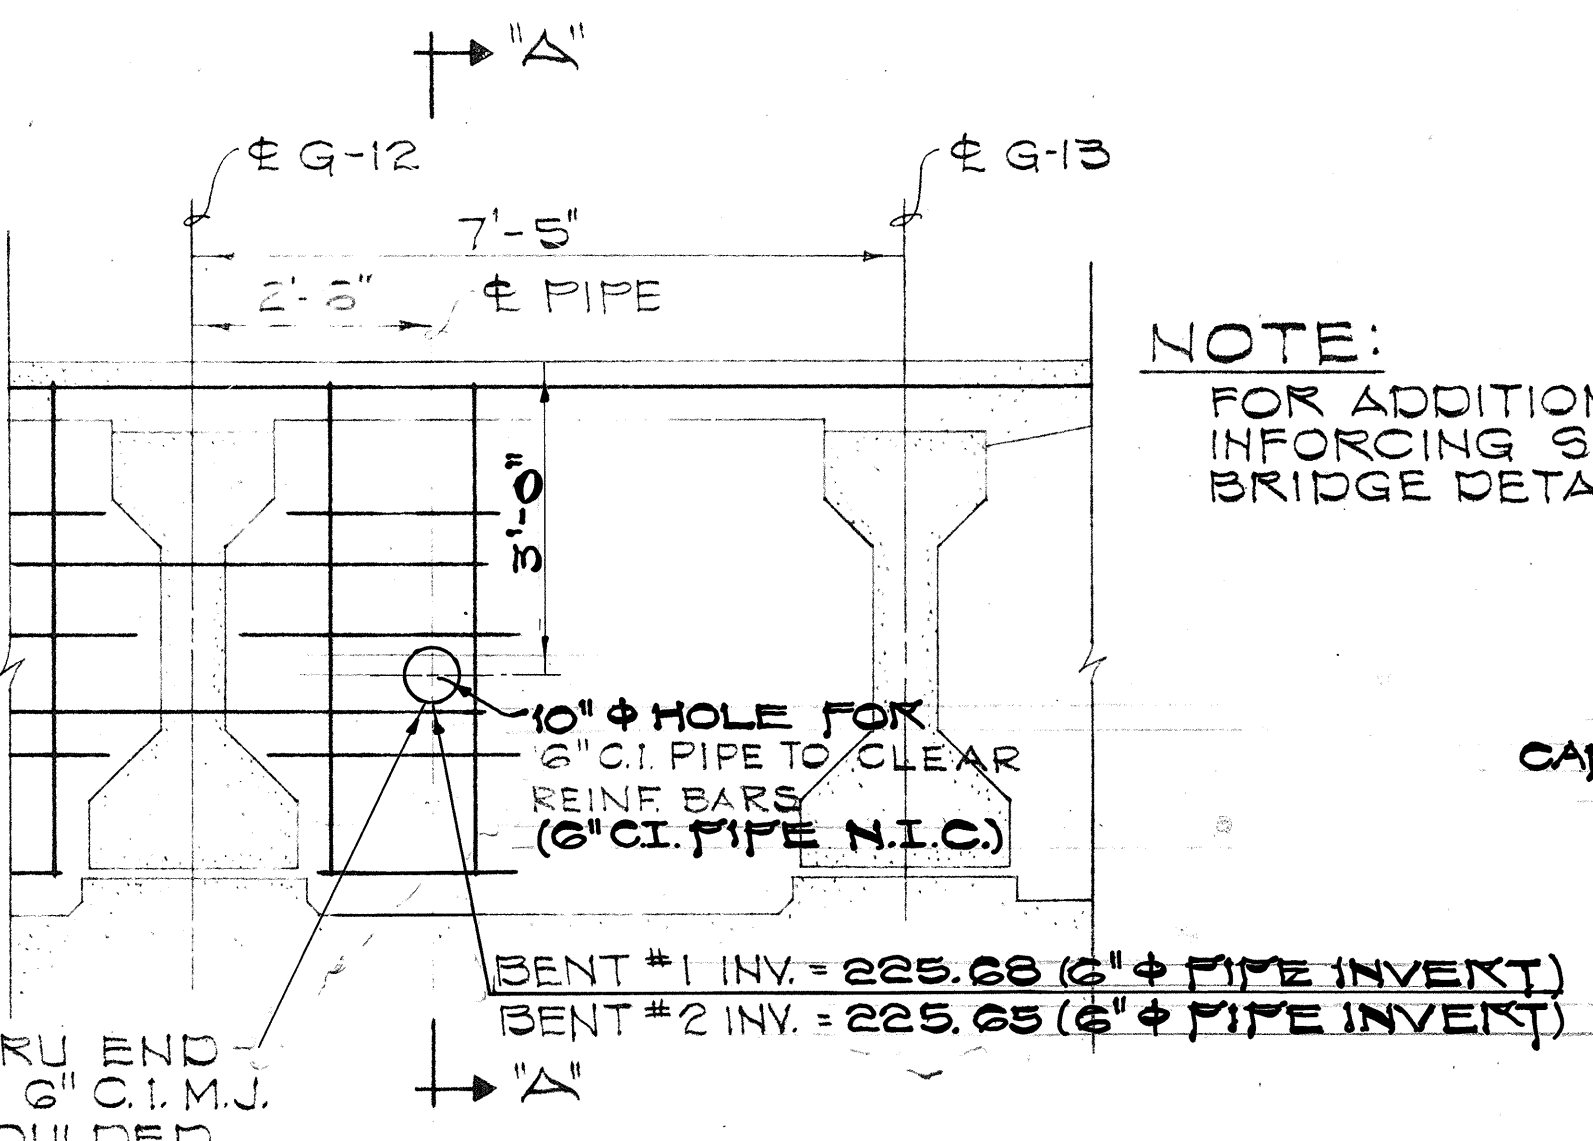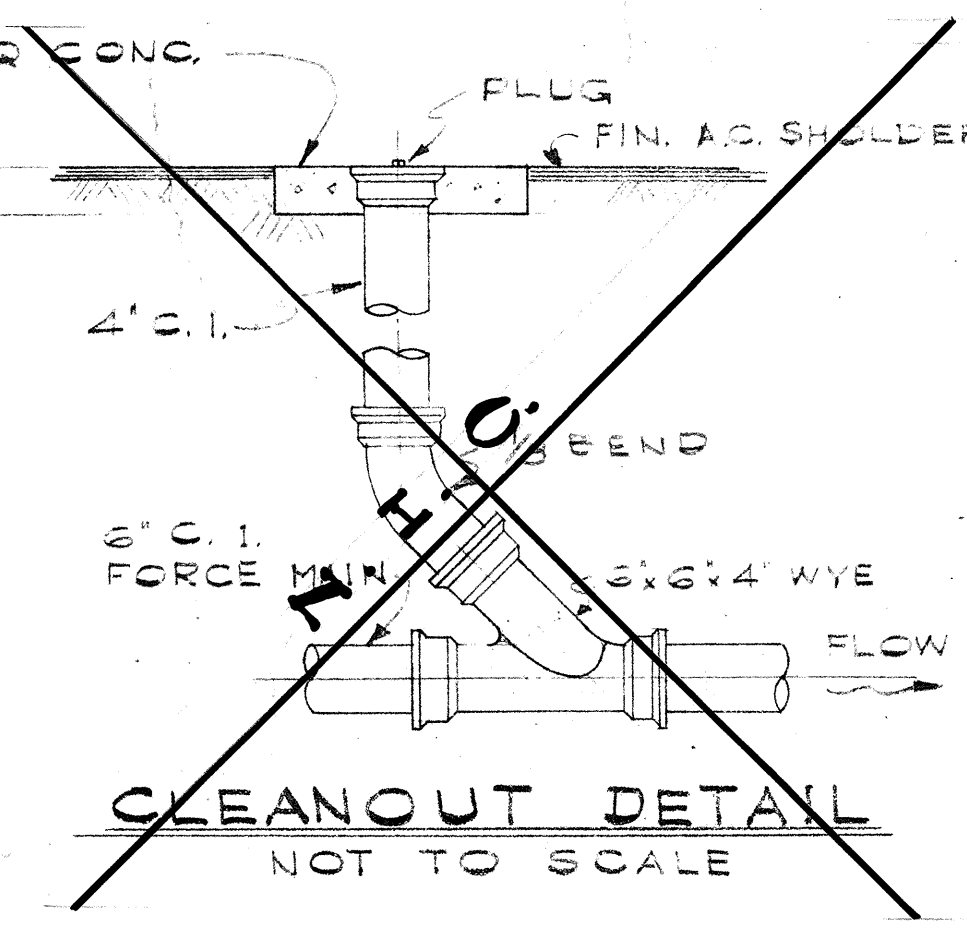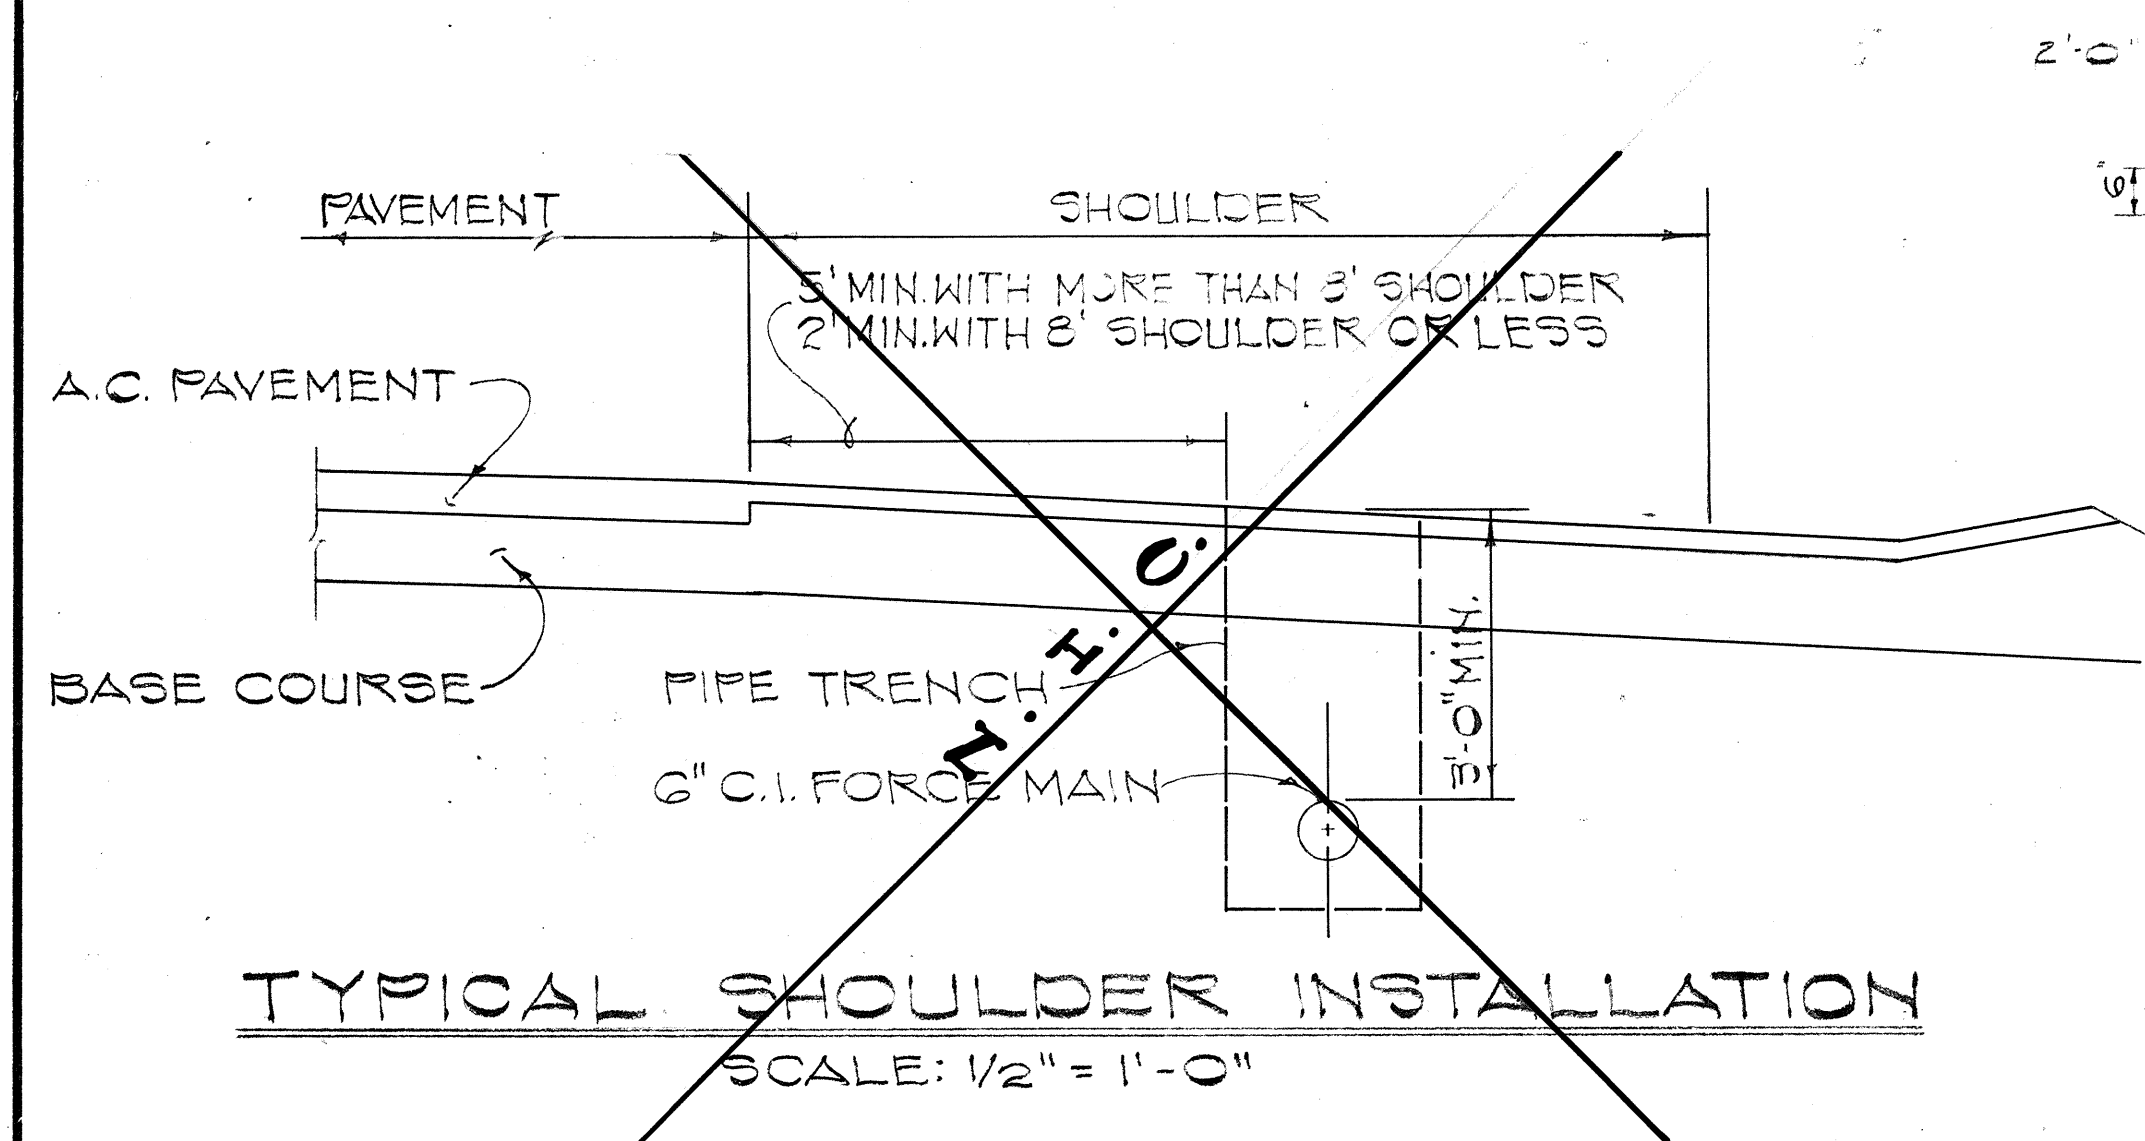

STATE OF HAWAII
DEPARTMENT OF TRANSPORTATION
HIGHWAYS DIVISION
HALEKOU INTERCHANGE
PROJ. NO. I-H3-1(24)-11
DETAILS
HAWAII LOA COLLEGE
FORCE MAIN
SCALE: AS SHOWN
DATE: FEB. 1975
SHEET No. 2AA OF 2 SHEETS

JOSEPH VIERRA
REGISTERED PROFESSIONAL ENGINEER
No. 2626
HAWAII, U.S.A.