


REHABILITATION
OF
WAIANAE ROAD
INCLUDING ALL OF
FEDERAL AID PROJECT NO. 4C.
FEDERAL AID GRADE CROSSING PROJ. NO. FAGH-4C.
EWA DISTRICT,
ISLAND OF OAHU.

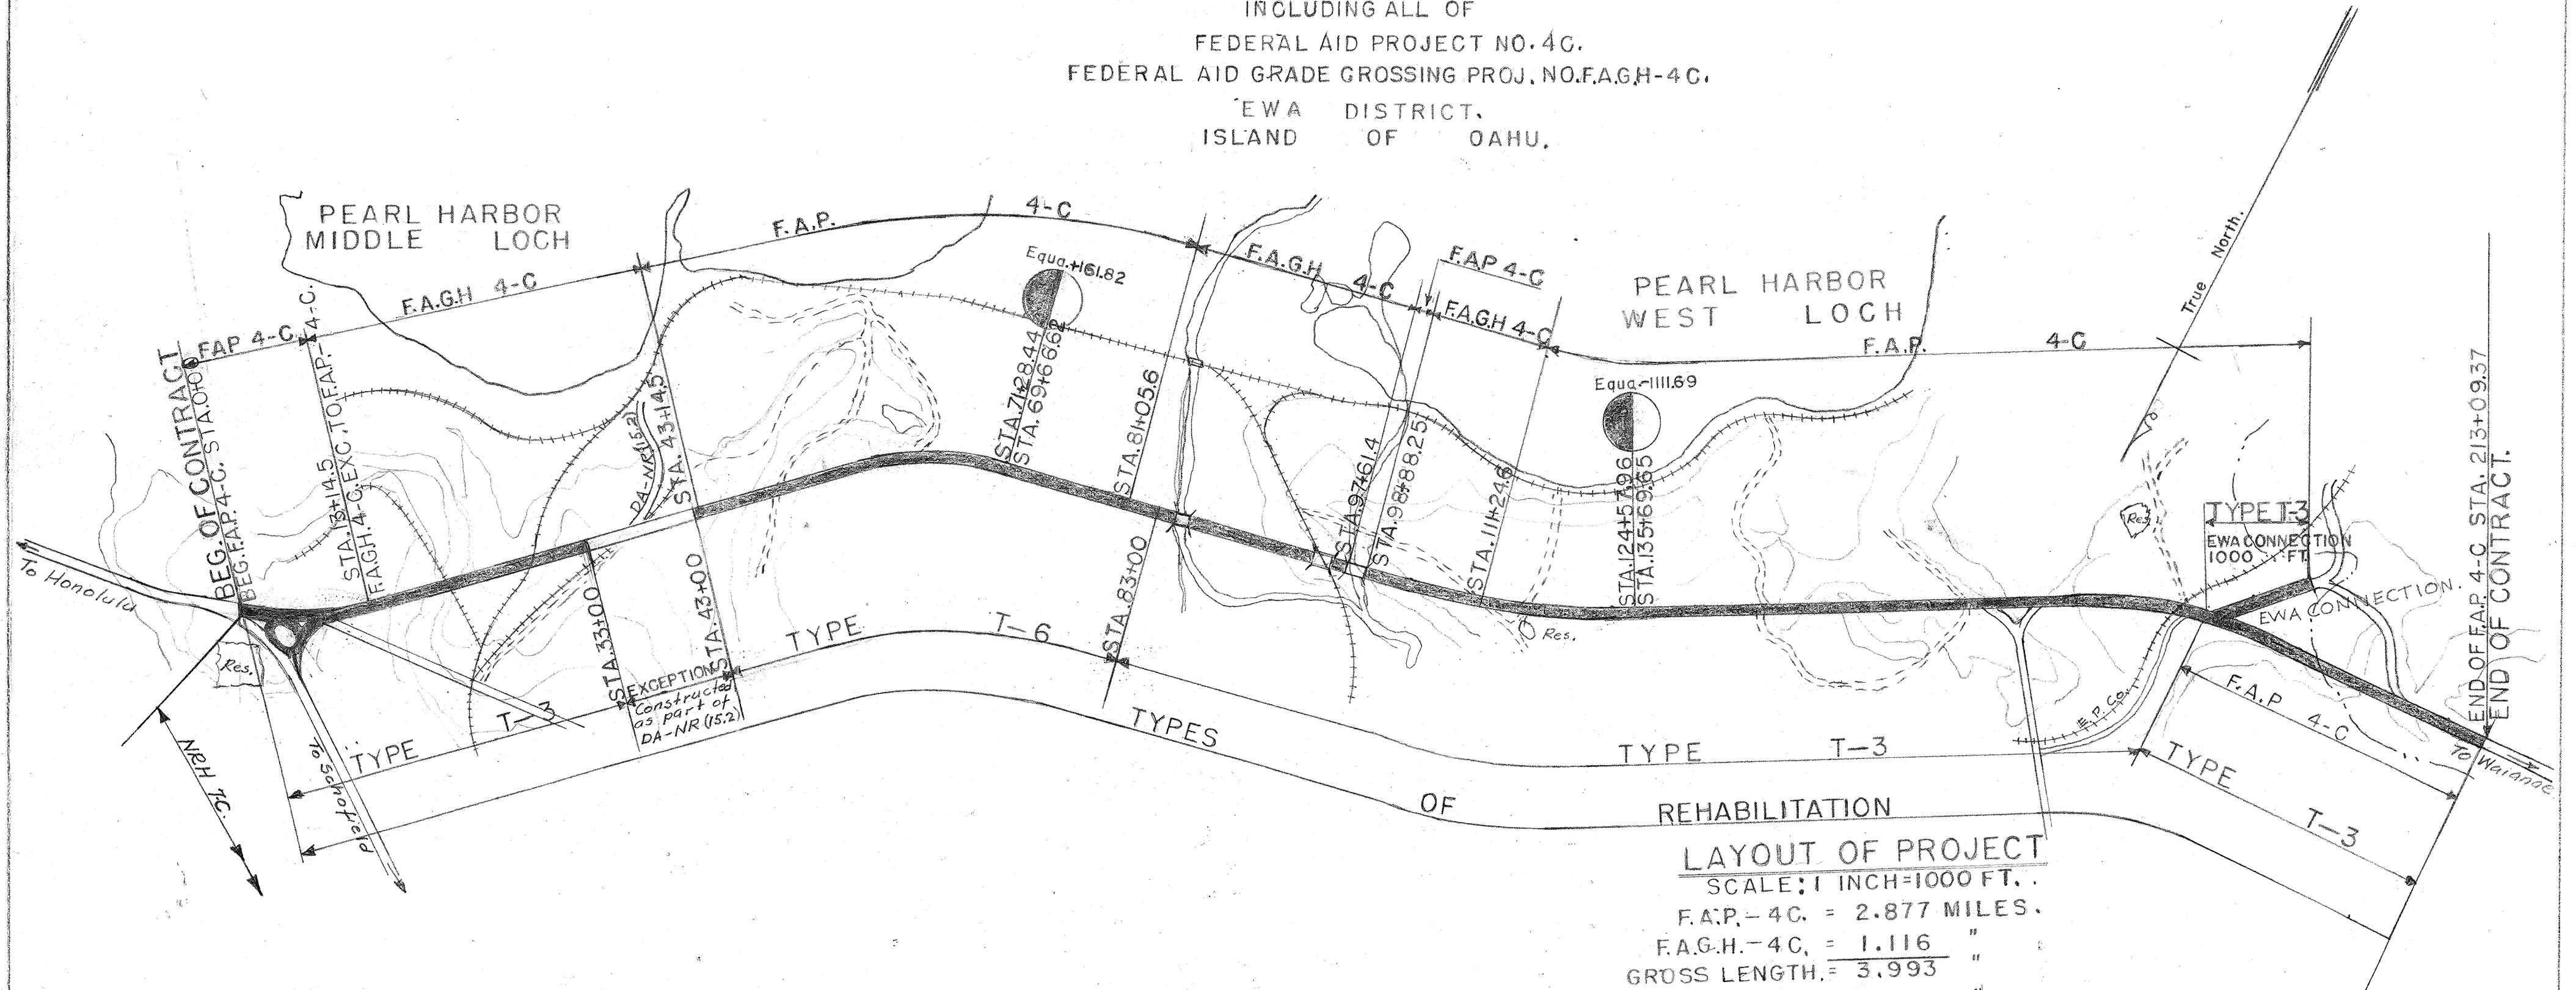

Note: Shaded area of Ewa-Schofield Junction shall be rehabilitated using Type T-3.

LAYOUT OF PROJECT
SCALE: 1 INCH=1000 FT.
F.A.P.-4C. = 2.877 MILES.
F.A.G.H.-4C. = 1.116 "
GROSS LENGTH = 3.993 "
EXCEPTION = 0.189 "
NET LENGTH = 3.804

5207.1

