

STATE OF HAWAII

DEPARTMENT OF TRANSPORTATION
HIGHWAYS DIVISION

HONOLULU, HAWAII

"AS BUILT"

PLANS FOR

INSTALLATION OF HIGHWAY LIGHTS

ON FARRINGTON HIGHWAY


PUPUPUHI STREET TO LEOKANE STREET


PROJECT No. A - 90 - 01 - 66

LEOKANE STREET TO FT. WEAVER ROAD

PROJECT No. 90A - 02 - 68

DISTRICT OF EWA
ISLAND OF OAHU

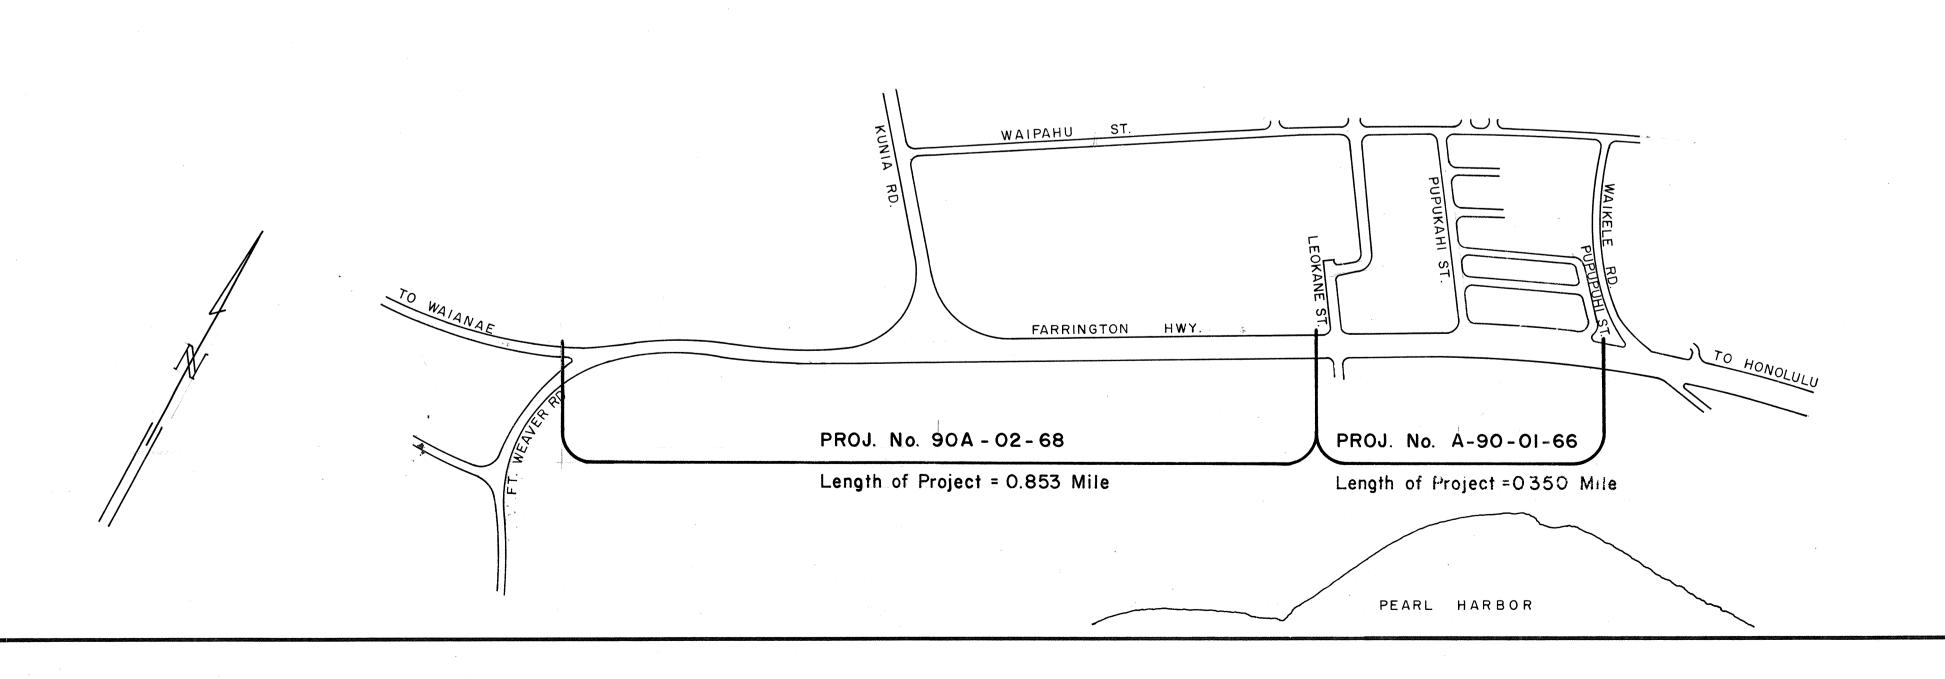

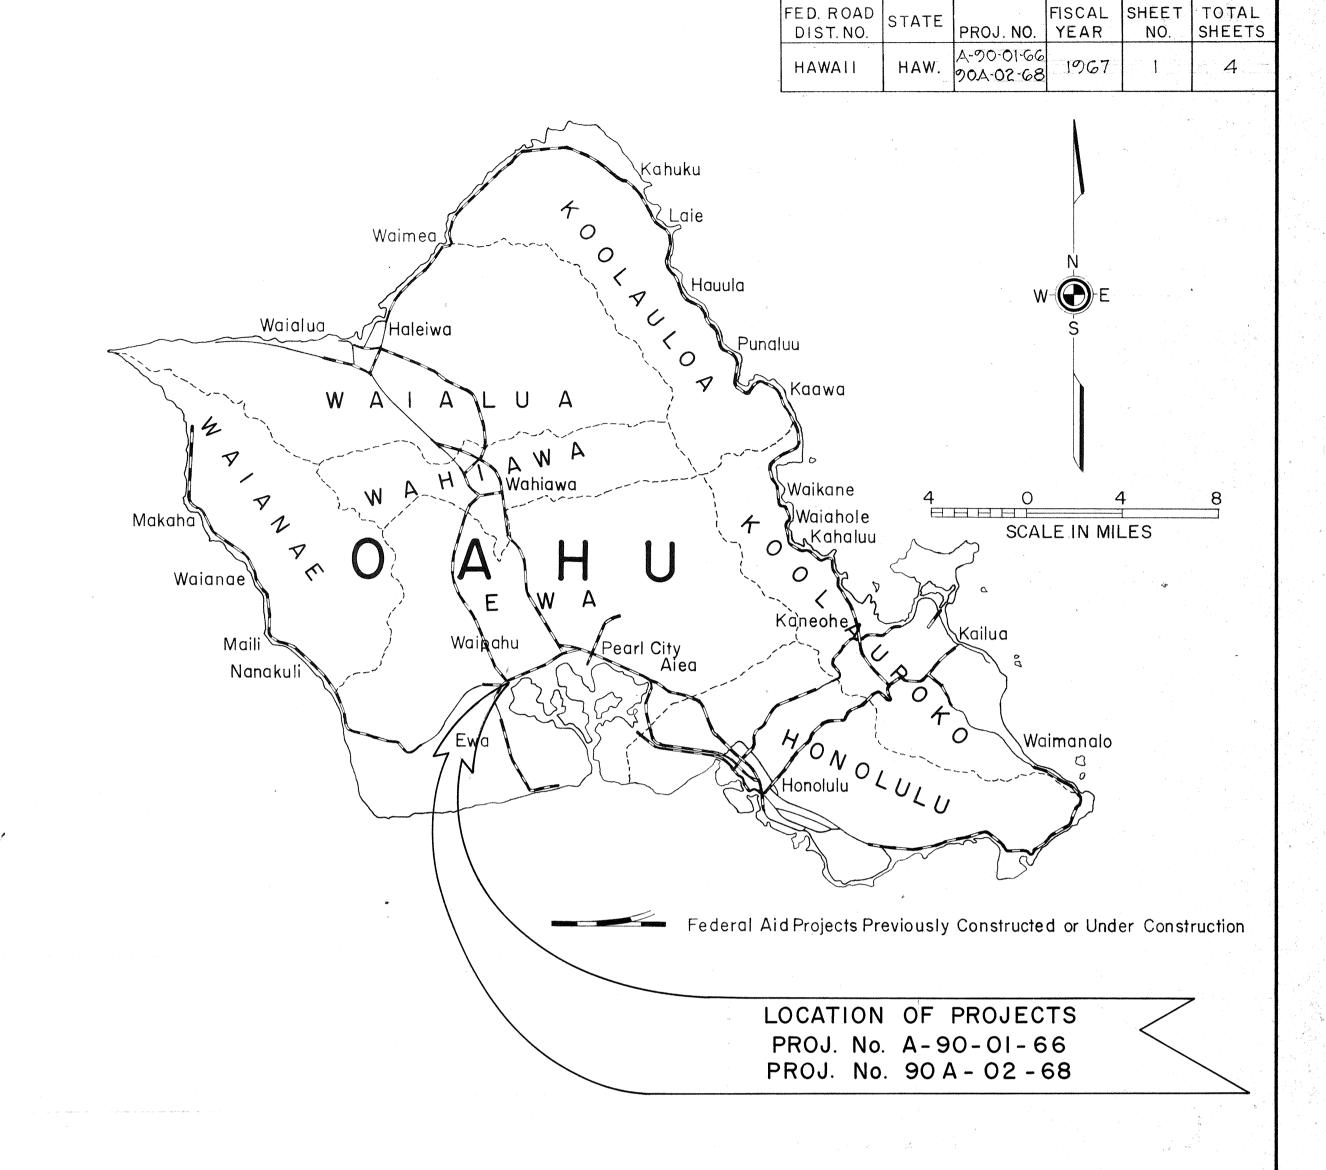

NOTE:

ALL CHANGES MADE DURING CONSTRUCTION HAVE BEEN NOTED IN RED ON THESE TRACINGS AND CHECKED BY

PROJECT ENGINEER DATE

DEPARTMENT OF TRANSPORTATION
STATE OF HAWAII

APPROVED:

John Mile Author 9/1/67
JOHN DIR. OF TRANSPORTATION

DATE