


FED. ROAD DIST. NO.	STATE	PROJ. NO.	FISCAL YEAR	SHEET NO.	TOTAL SHEETS
HAWAII	HAW.	9000A-01-80M	1980	2	12


GENERAL NOTES

- Only the hatched area shown on the plan sheets shall be resurfaced.
- Provide smooth transition at connections to existing pavement.
- Ruts on the existing roadway pavement shall be filled with a thin layer of leveling course Mix No. I prior to resurfacing. This leveling course will be considered as A.C. Pavement Mix No. I and paid for under Item No. 401.05.
- The exact limits of the reconstructed areas shall be determined in the field by the Engineer.
- The bidders attention is directed to Sub-section 104.09 Availability of funds of the Special Provisions.
- The A.C. overlay thickness shall be as shown on the plans, unless otherwise directed by the Engineer.
- Frame and cover of existing C & C Monuments shall be raised to new grade as shown on this sheet. This work shall be considered incidental to the various contract items and no separate payment shall be made thereof.
- Existing Centerline Monuments shall be adjusted as shown on this sheet.
- The Contractor shall be responsible for the layout of the pavement markings and striping. The Contractor shall check the layout of markers and striping with the Engineer prior to performing the work.

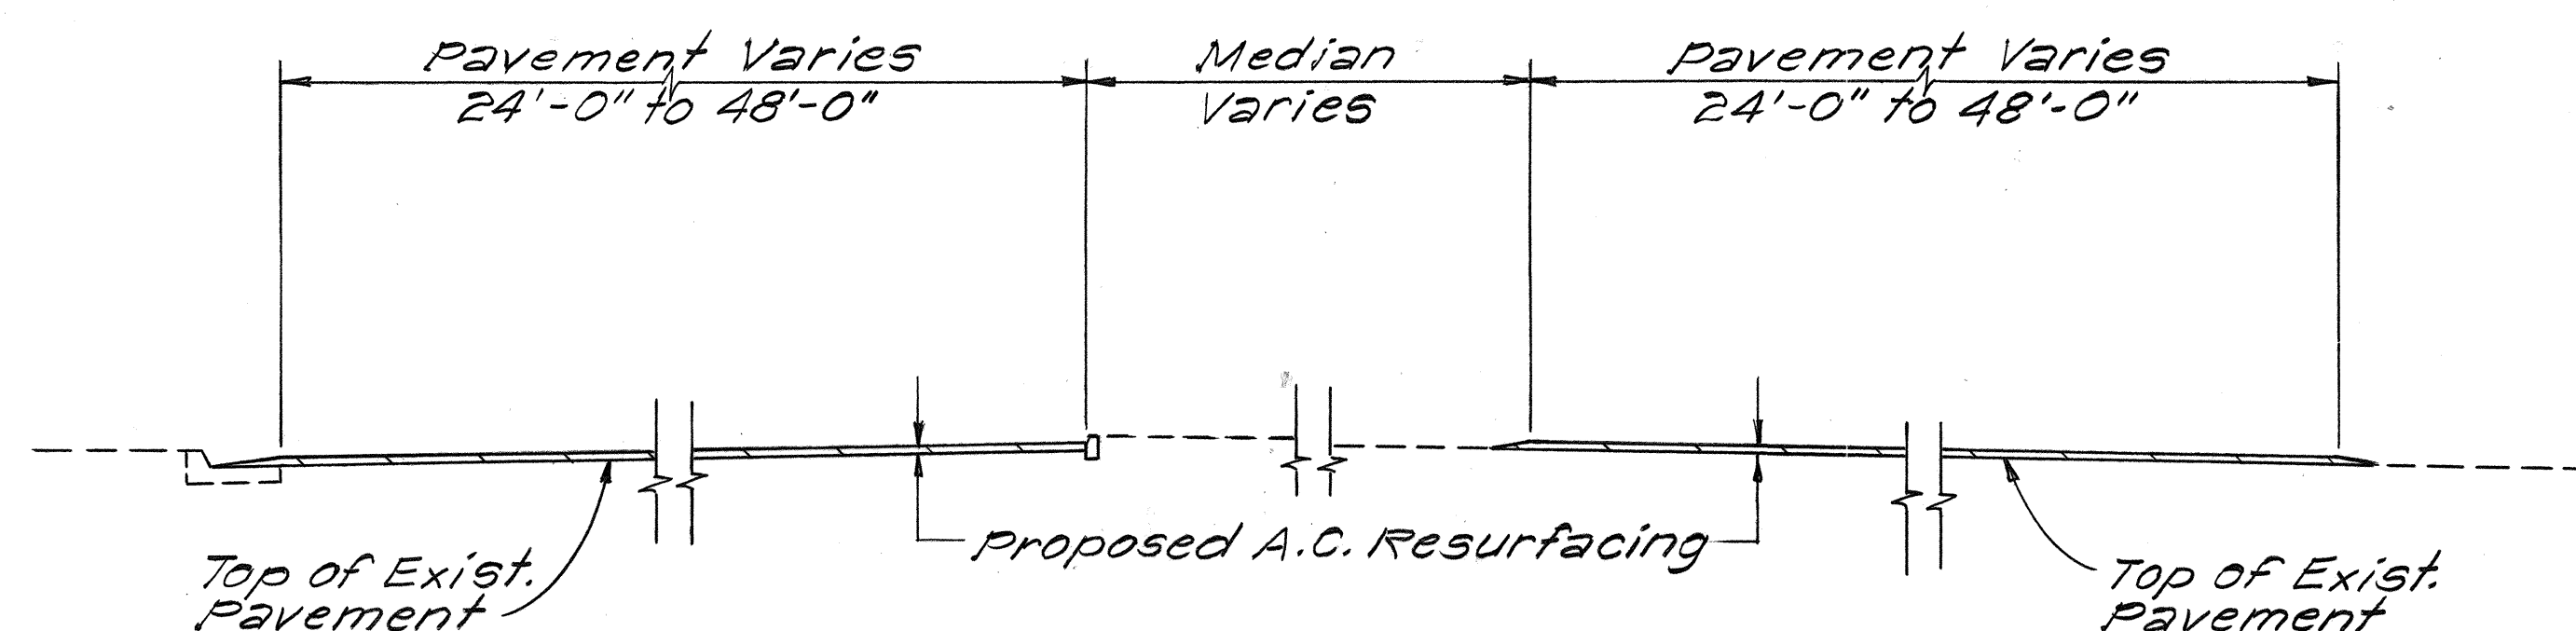


TYPICAL SECTION

Scale: 3/16" = 1'-0"

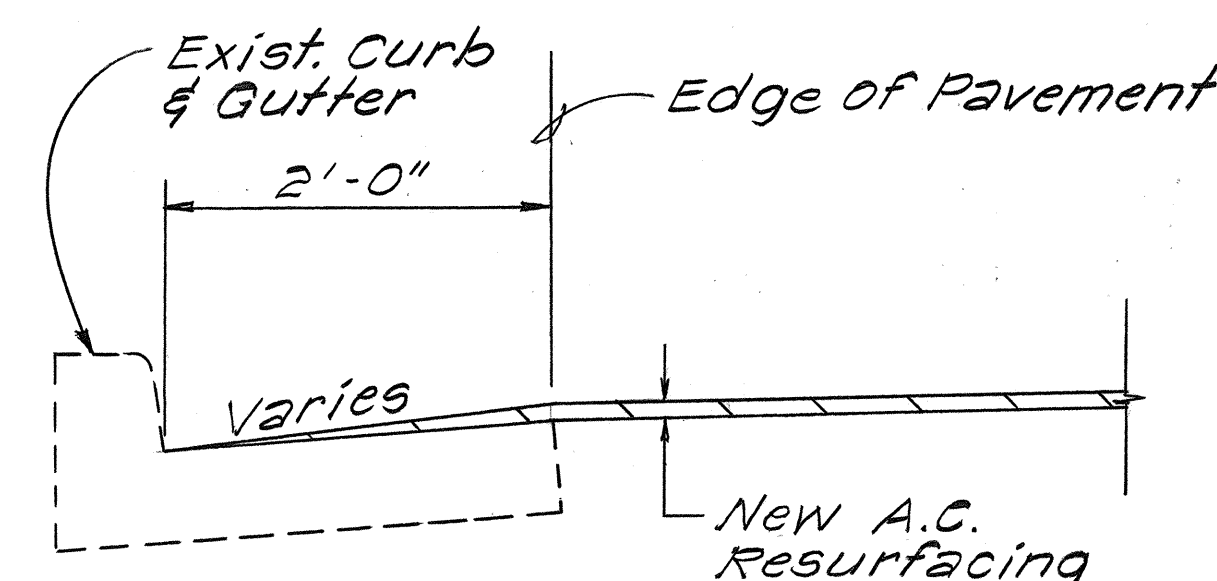


TYPICAL SECTION AT CURB AND GUTTER

Scale: 1" = 1'-0"

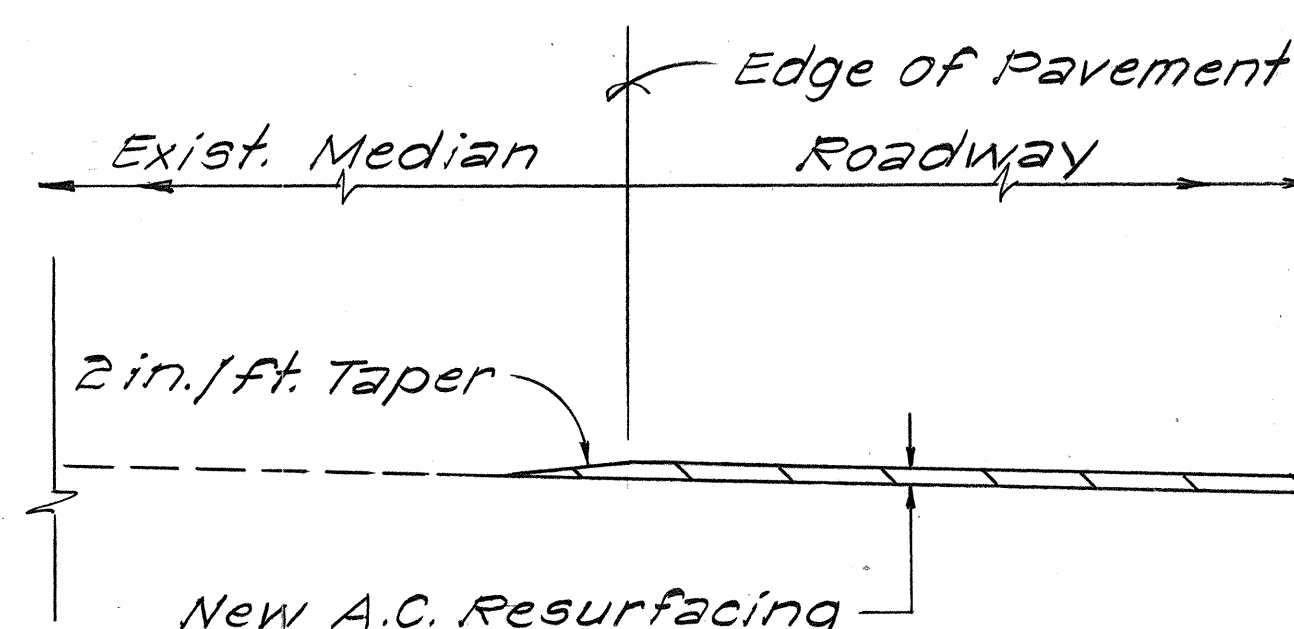


TYPICAL SECTION AT MEDIAN

Scale: 1" = 1'-0"

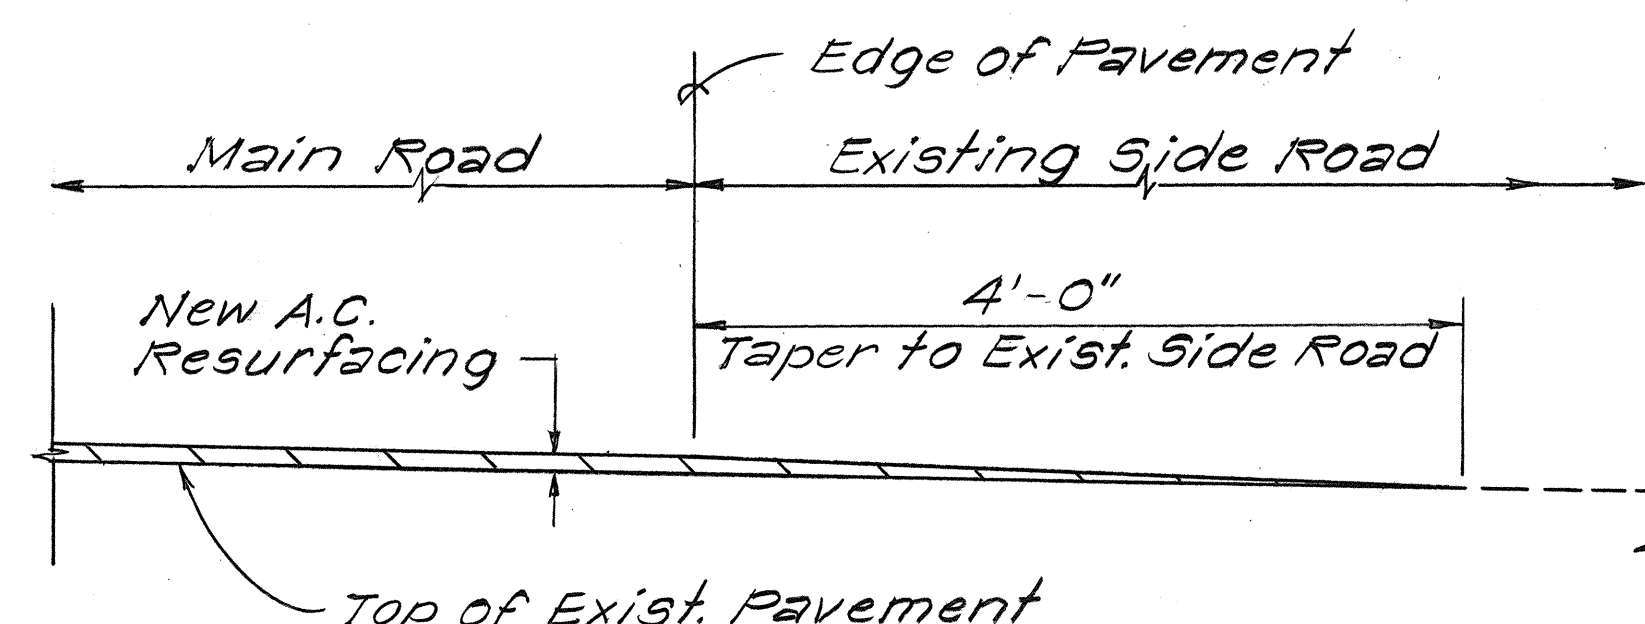


TYPICAL SECTION ~ SIDE ROAD CONNECTION

Scale: 1" = 1'-0"

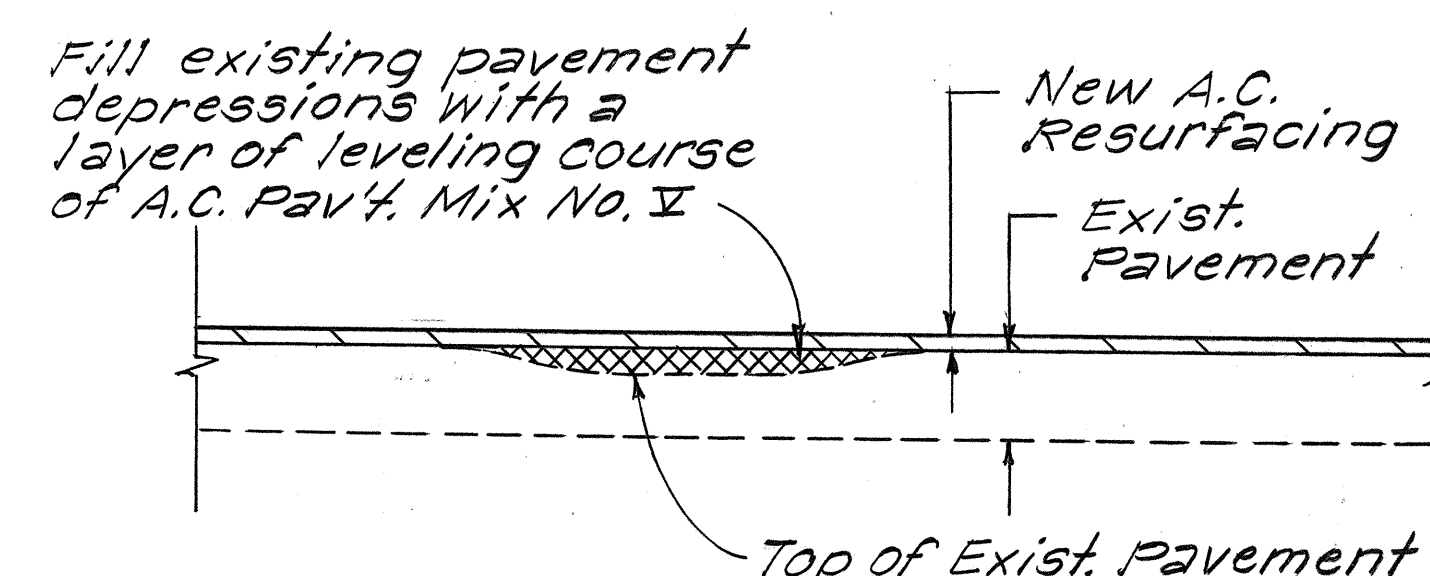


LEVELING COURSE DETAIL

Scale: 1" = 1'-0"

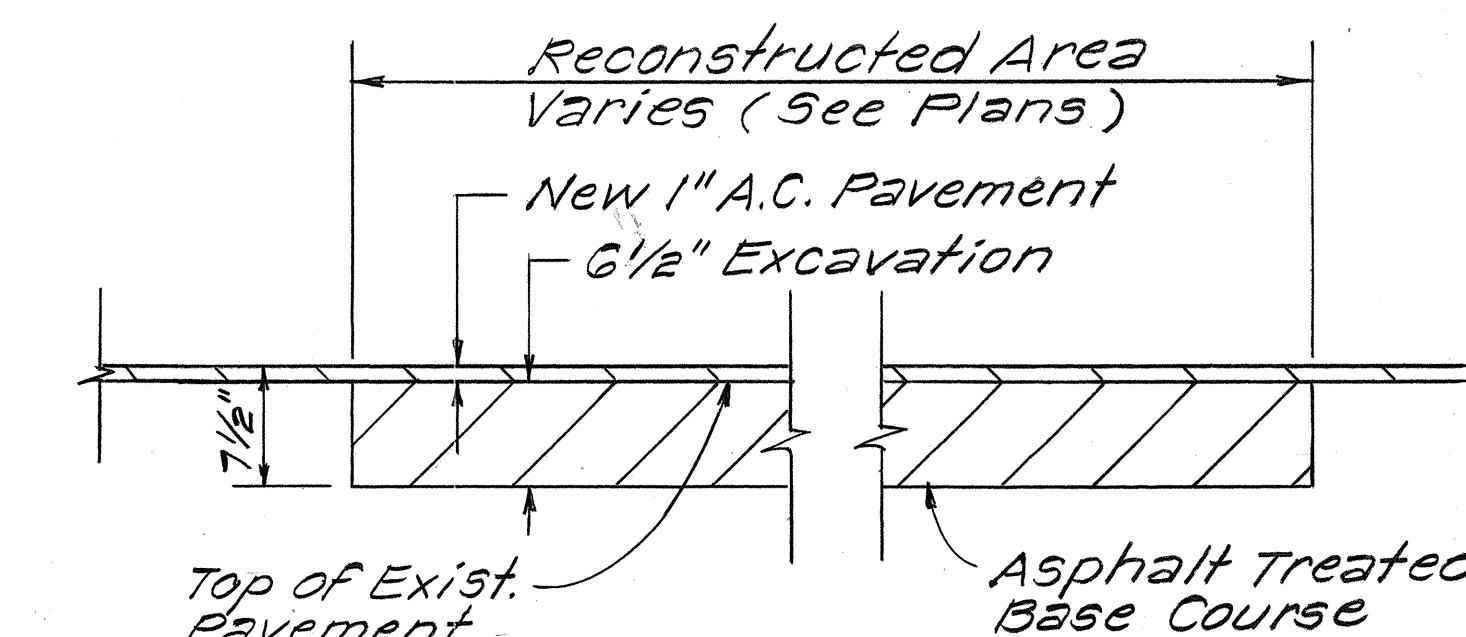

TYPICAL SECTION ~ RECONSTRUCTED AREA

Scale: 1" = 1'-0"

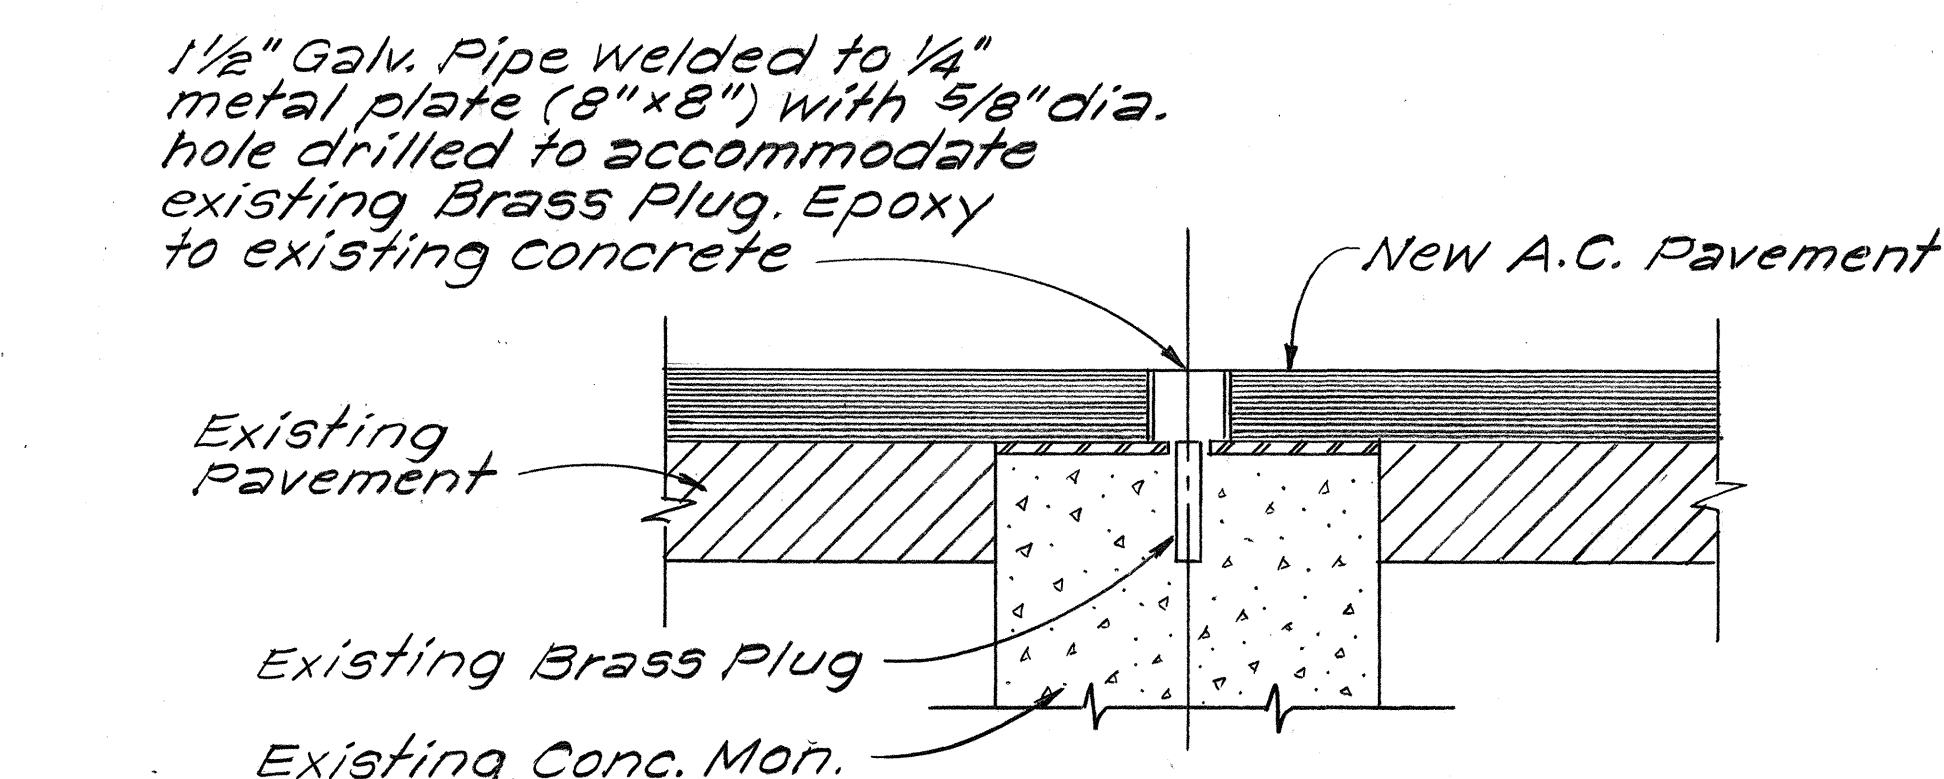


ADJUSTED & MONUMENT

Scale: 3" = 1'-0"

NOTE:

Adjustment of Centerline Monument shall not be paid for separately, but shall be considered incidental to the various contract items.

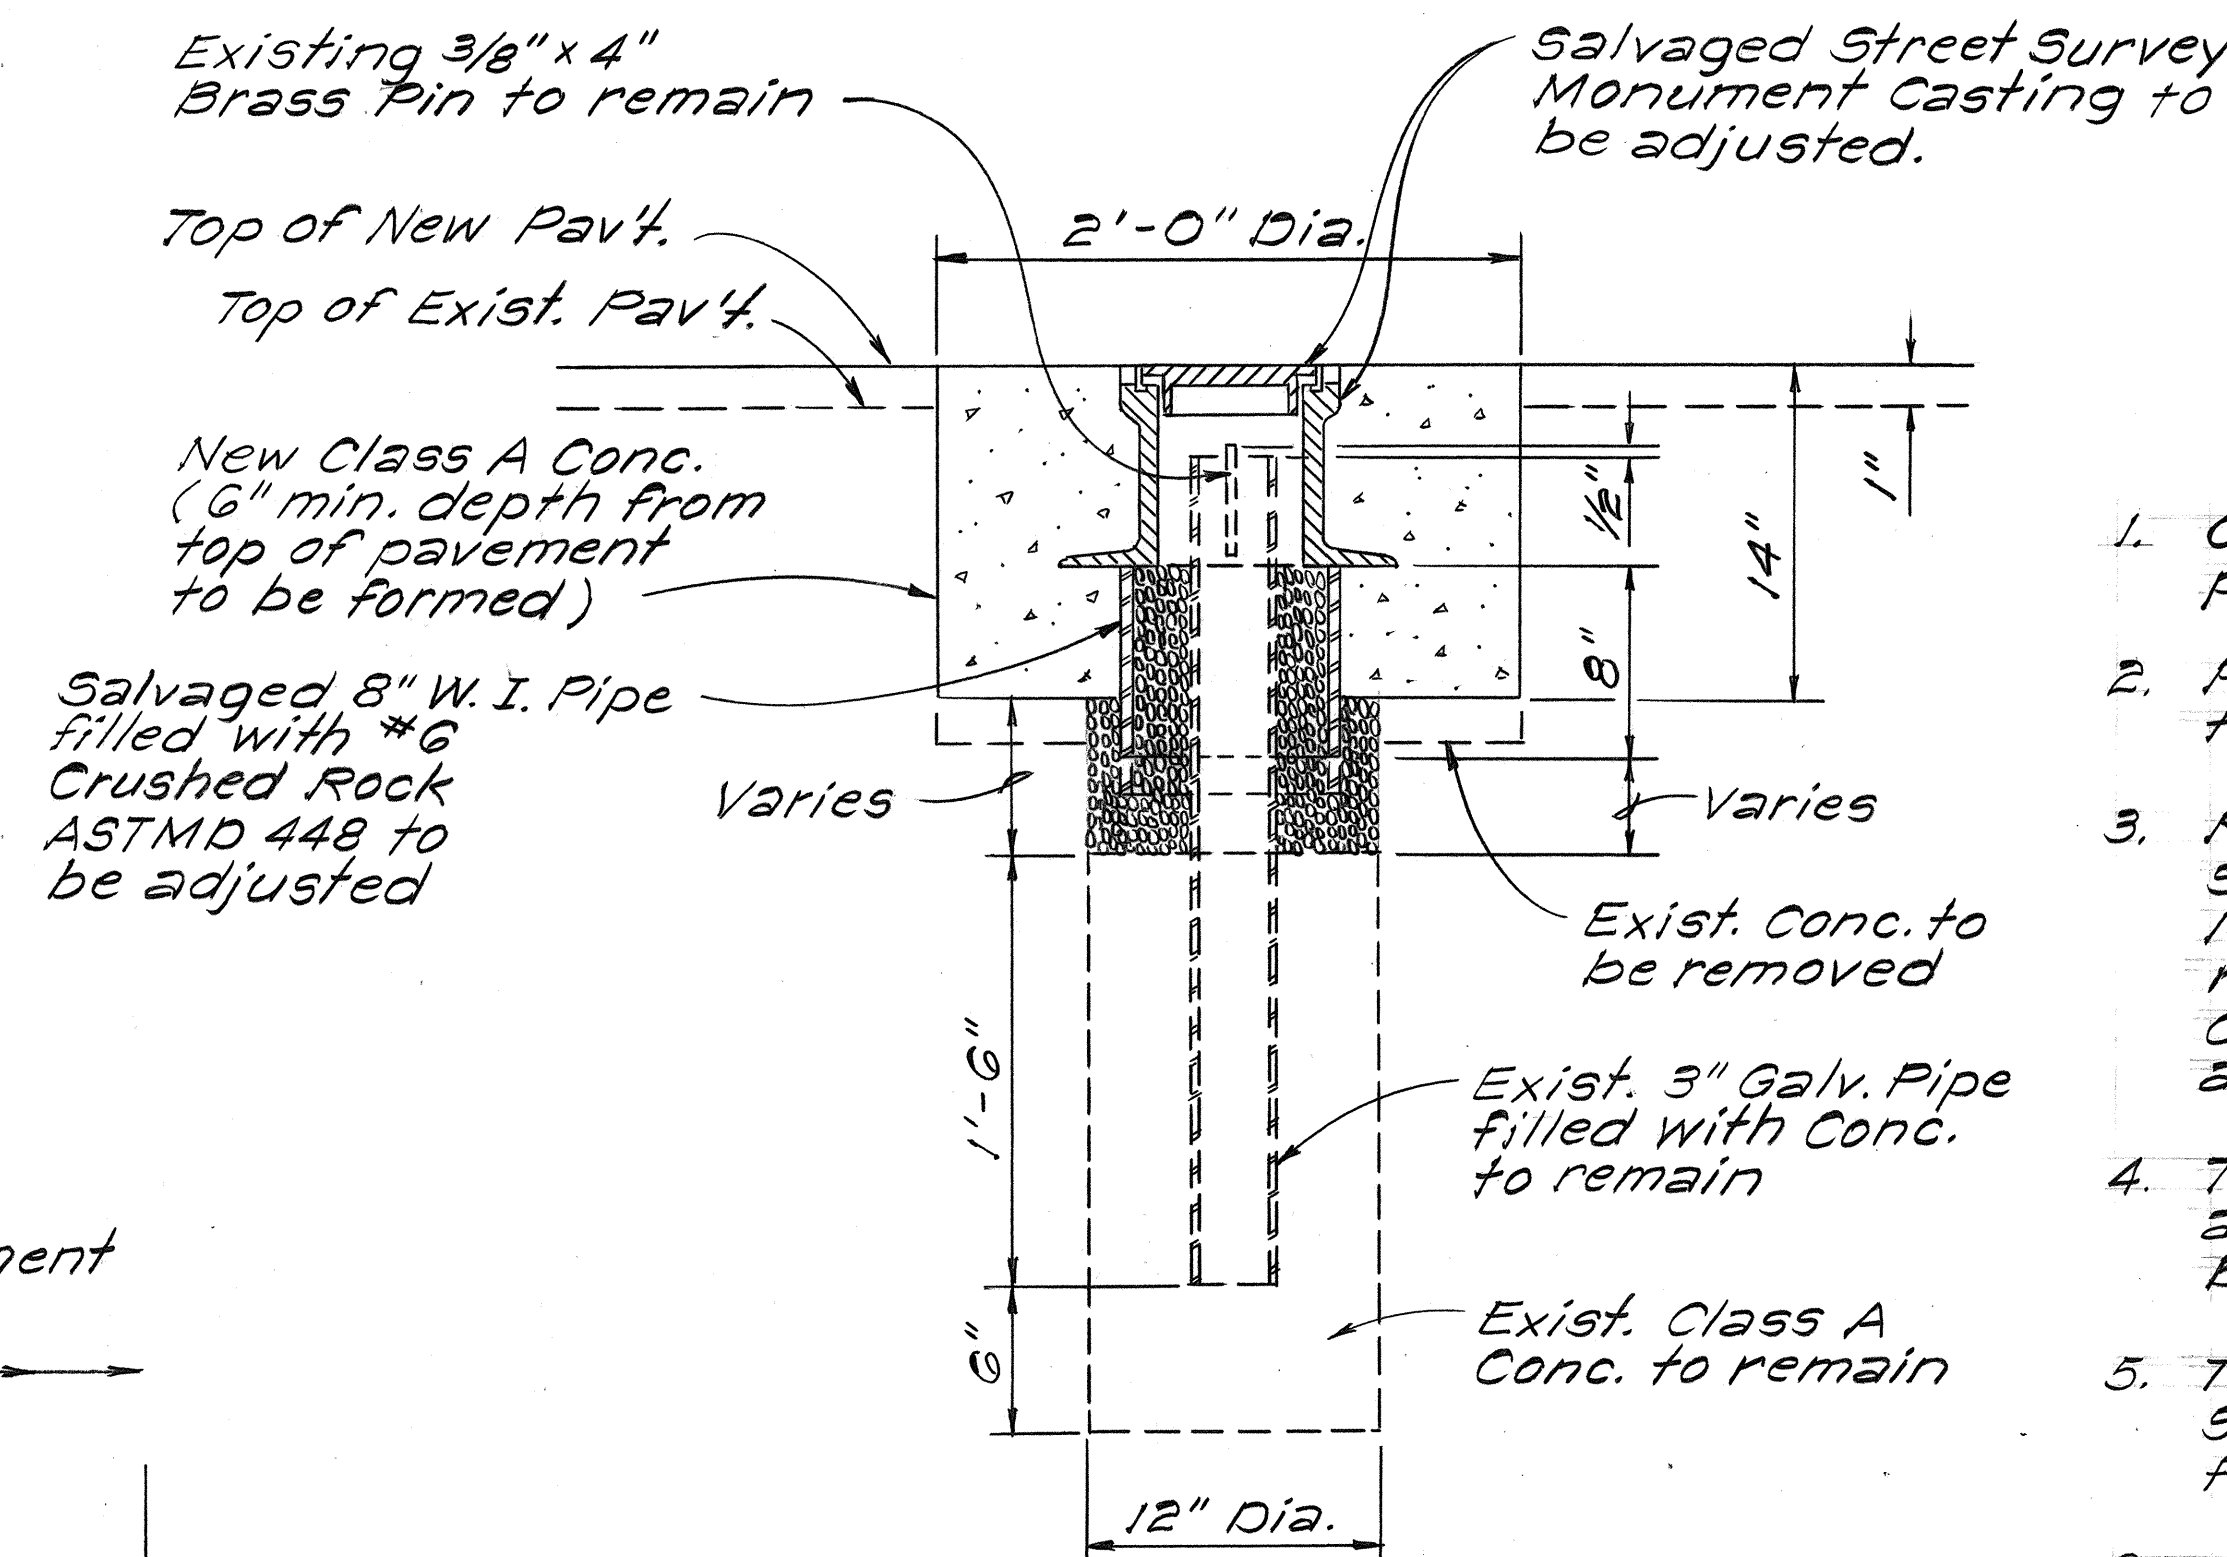

TYPICAL STREET SURVEY MONUMENT ADJUSTMENT

Scale: 1 1/2" = 1'-0"

STATE OF HAWAII DEPARTMENT OF TRANSPORTATION LAND TRANSPORTATION FACILITIES DIVISION					
TYPICAL SECTIONS AND GENERAL NOTES					
FARRINGTON HWY. RESURFACING PROJECT NO. 9000A-01-80M					
Scale: As Noted Date: Jan., 1980					
SHEET NO. 1 OF 1 SHEETS					