٠.		INDEX TO DRAWINGS
	SHEET NO.	DESCRIPTION
	ı	TITLE SHEET
	2	STANDARD PLAN SUMMARY
	3	GENERAL NOTES & LEGEND
	4 - 6	TYPICAL SECTIONS & MISCELLANEOUS DETAILS
,	7 - 8	PLANS
	9-12	TRAFFIC NOTES AND PAVEMENT MARKING & SIGNING PLANS
	,	
\r		
,		
	,	

548-4125 PHONE

STATE OF HAWAII

DEPARTMENT OF TRANSPORTATION


HIGHWAYS DIVISION HONOLULU, HAWAII


"AS BUILT "

PLANS FOR

FARRINGTON HIGHWAY RESURFACING OLD FORT WEAVER ROAD TO LEOKANE STREET PROJECT NO. HWY-0-01-90M

> DISTRICT OF EWA ISLAND OF OAHU

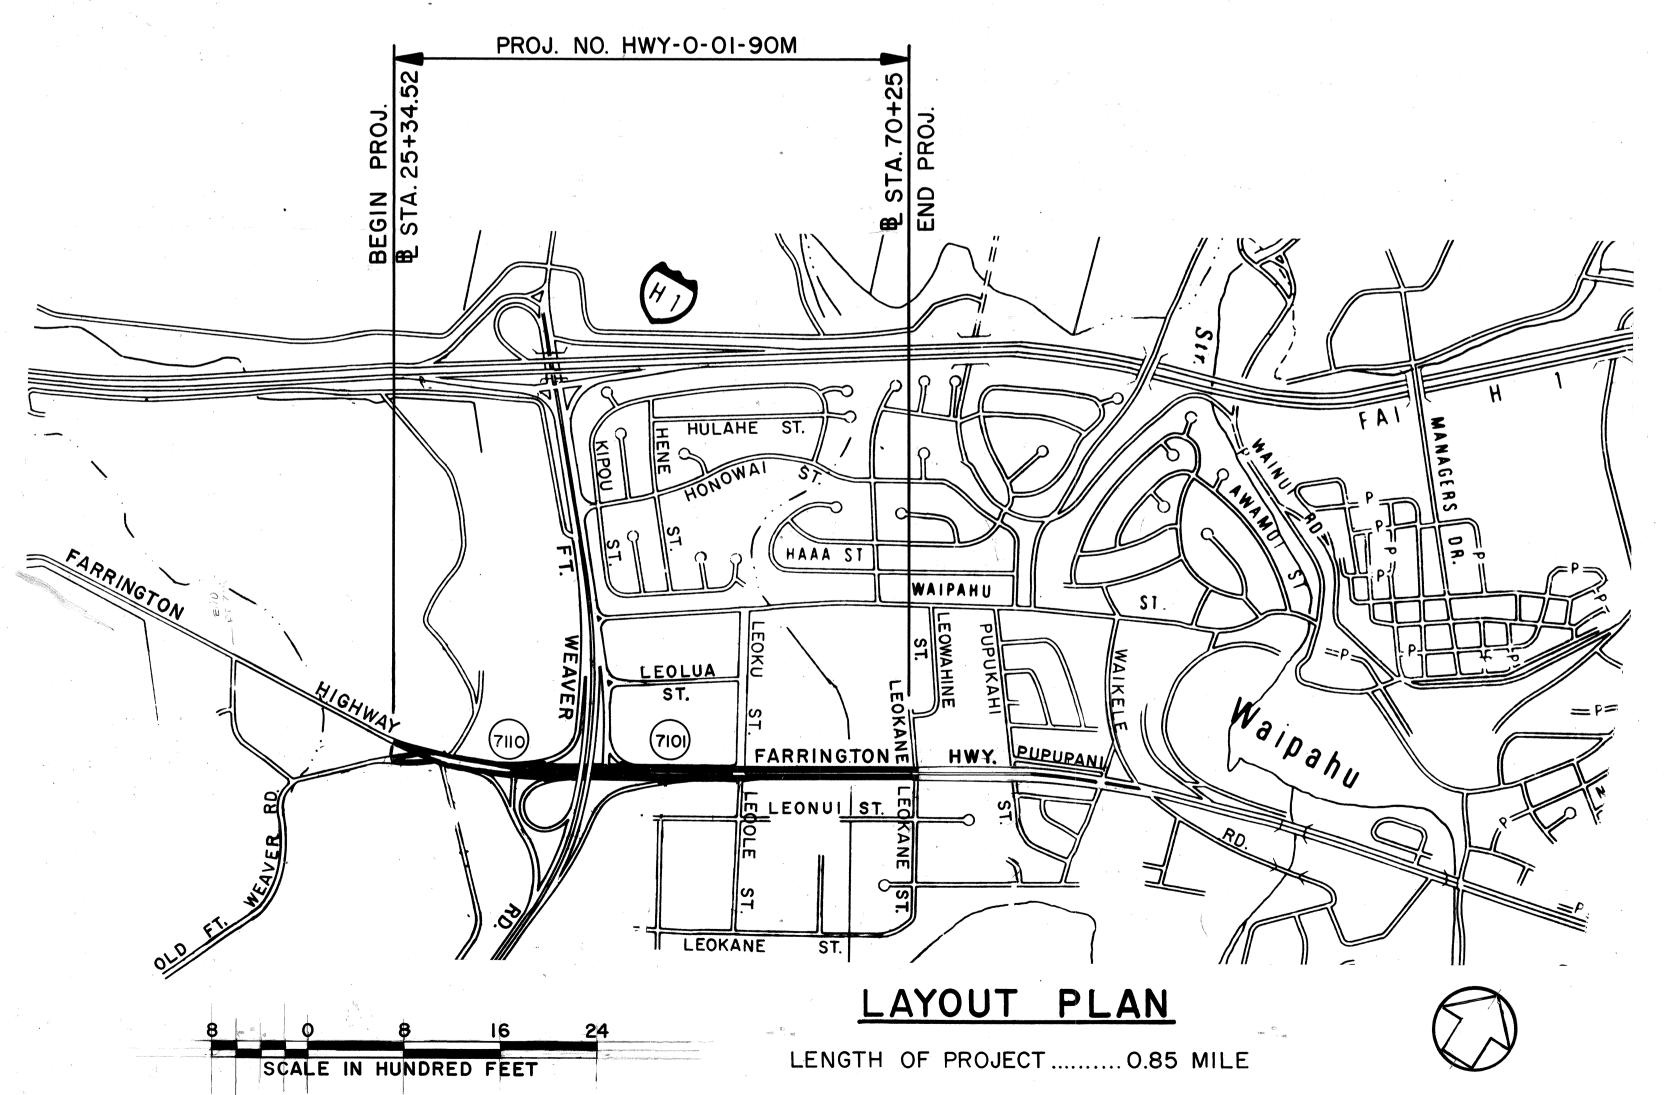

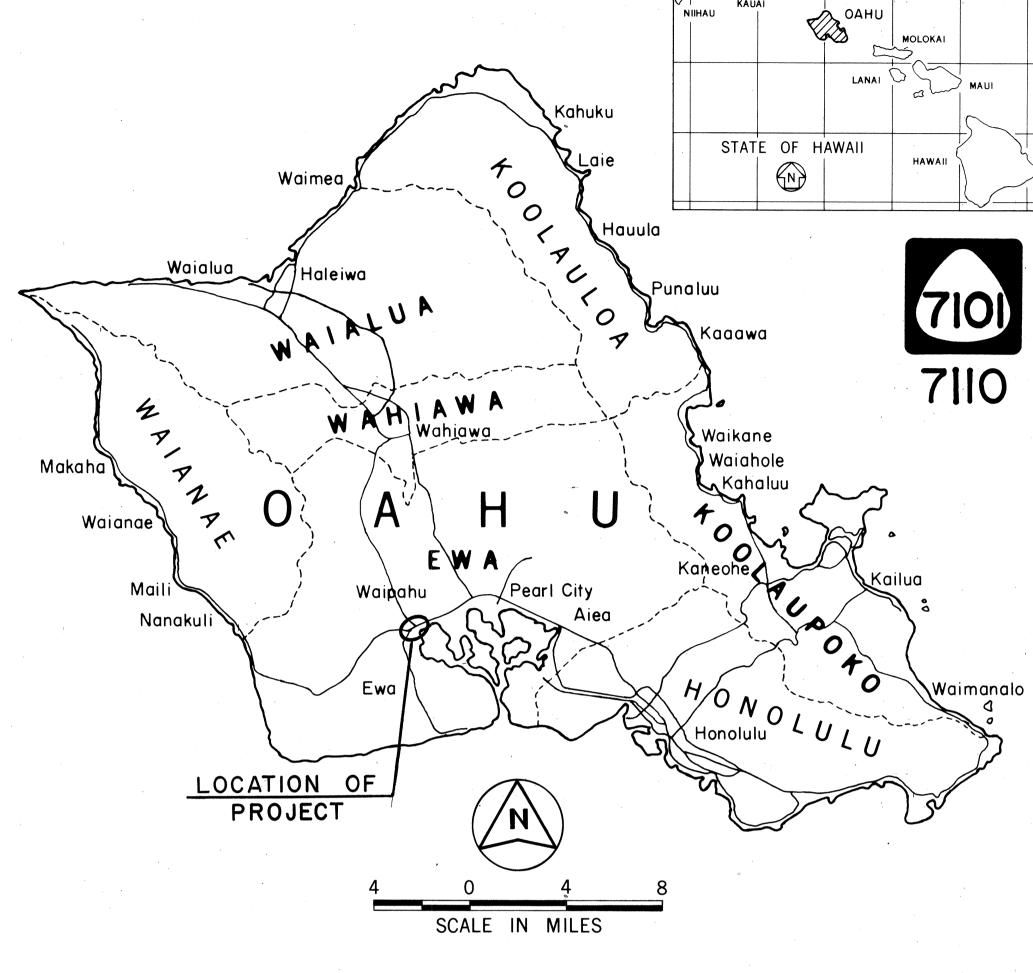

FED. ROAD DIST. NO.

FISCAL YEAR

PROJ. NO.

HAW. HWY-0-01-90M 1990

SHEETS

MILE POST 0.00 TO MILE POST 0.28 ROUTE 7110 MILE POST 0.00 TO MILE POST 0.60 ROUTE 7101

NO SIGNIFICANT CHANGES WERE MADE DURING CONSTRUCTION ON THESE PLANS EXCEPT CHANGES IN THE ORIGINAL THEORETICAL QUANTITIES. FOR ACTUAL QUANTITIES, REFER TO PROJECT LEDGER AND/OR COMPUTATION BOOK.

RESIDENT ENGINEER

DEPARTMENT OF TRANSPORTATION STATE OF HAWAII

APPROVED: