

PLAN	SURVEYED	DATE	BY
	PLOTTED		
	NOTED		
	RT. OF WAY CHECKED		

PROFILE	SURVEYED	DATE	BY
	PLOTTED		
	NOTED		
	STRUCTURE NOTING CHKD.		

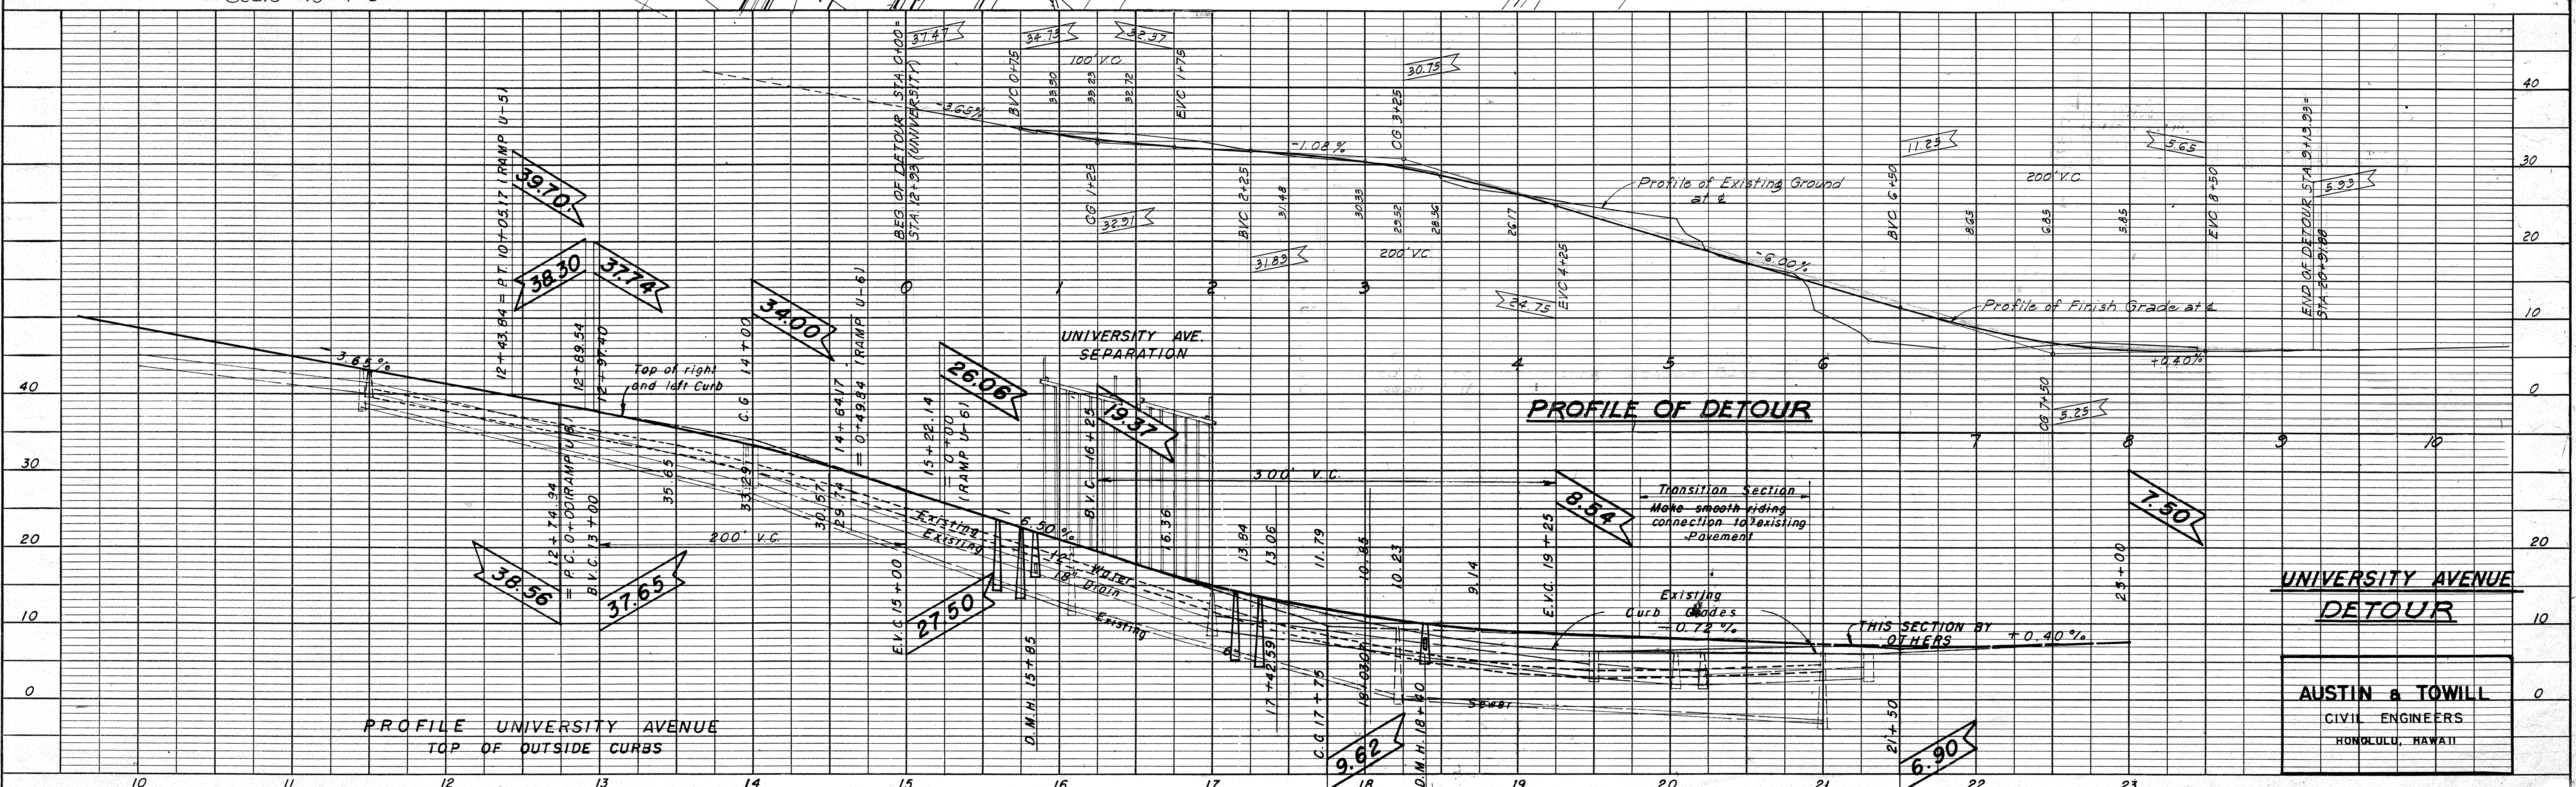
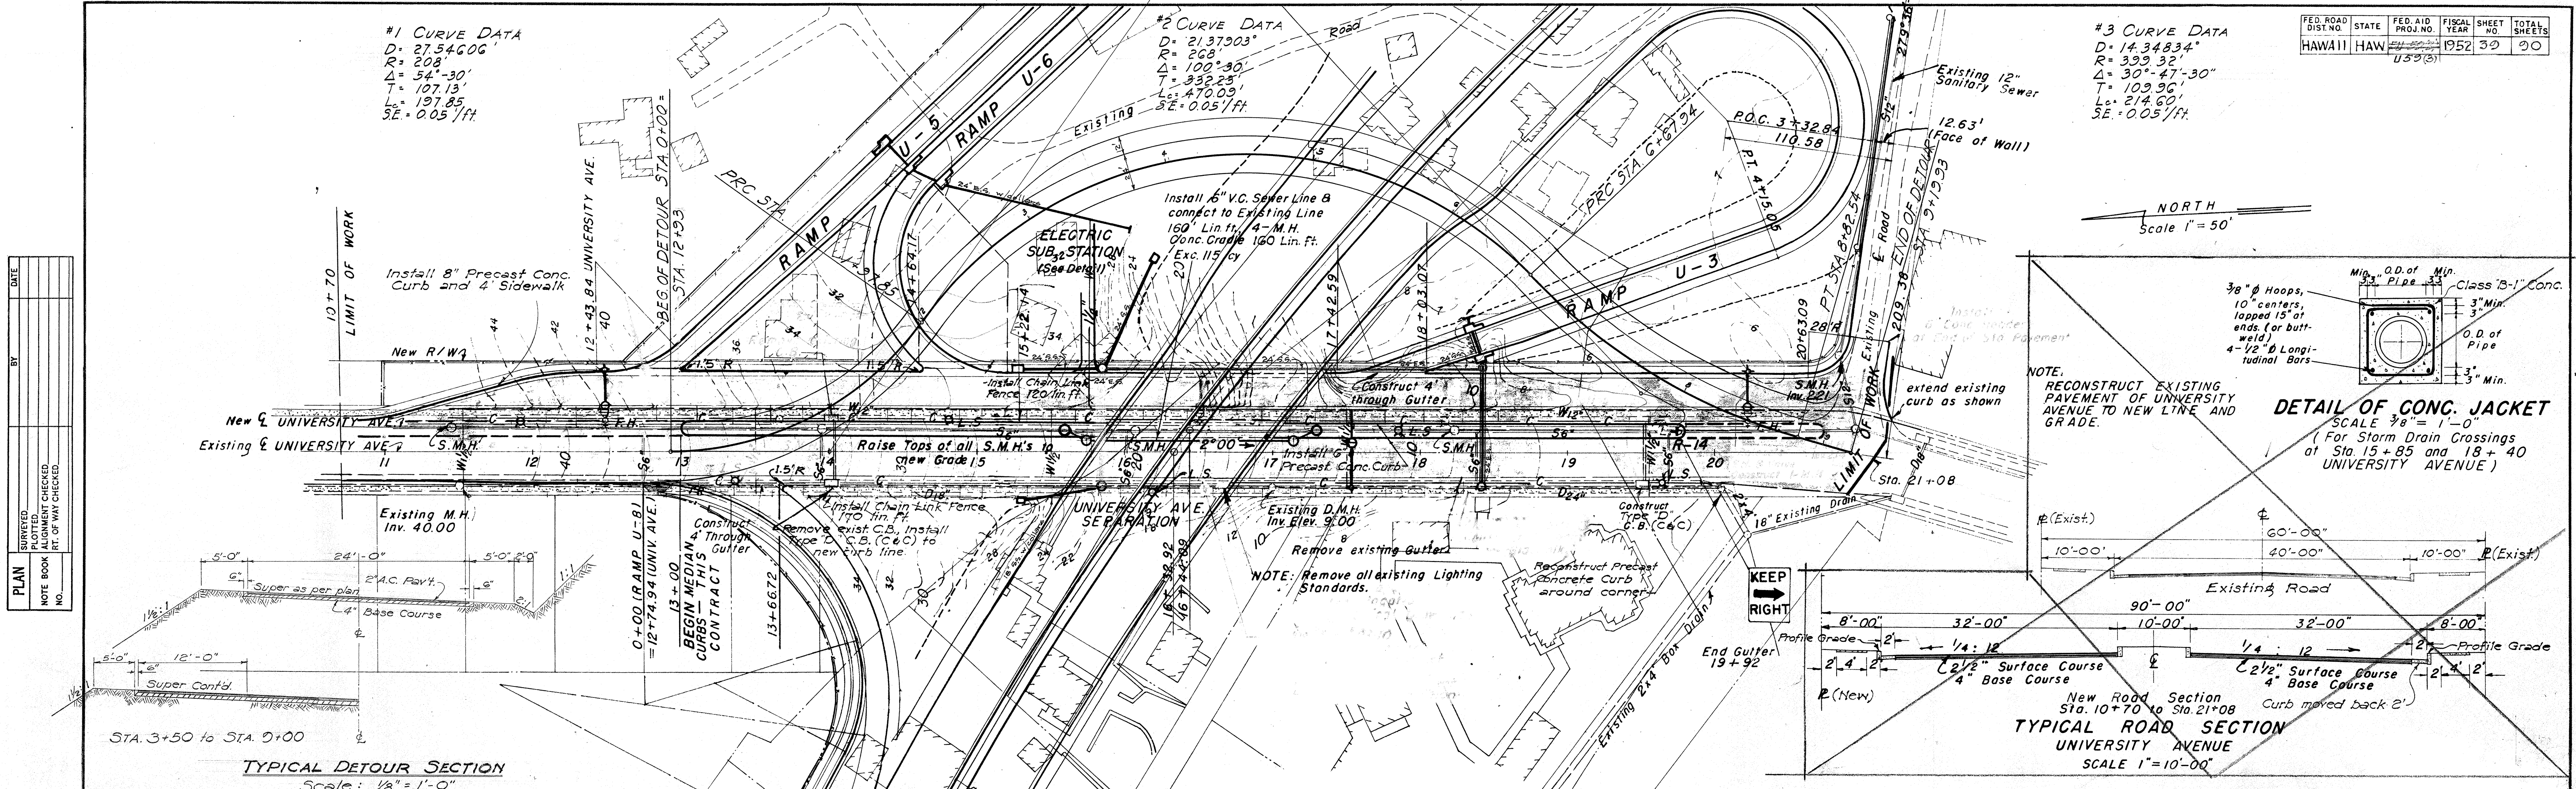


PLATE 1-PLAN-PROFILE O. P. R. & R. E. STANDARD
 KEUFFEL & ESSER CO. NEW YORK.

K & E Co. No. 346-1C

5508.39