


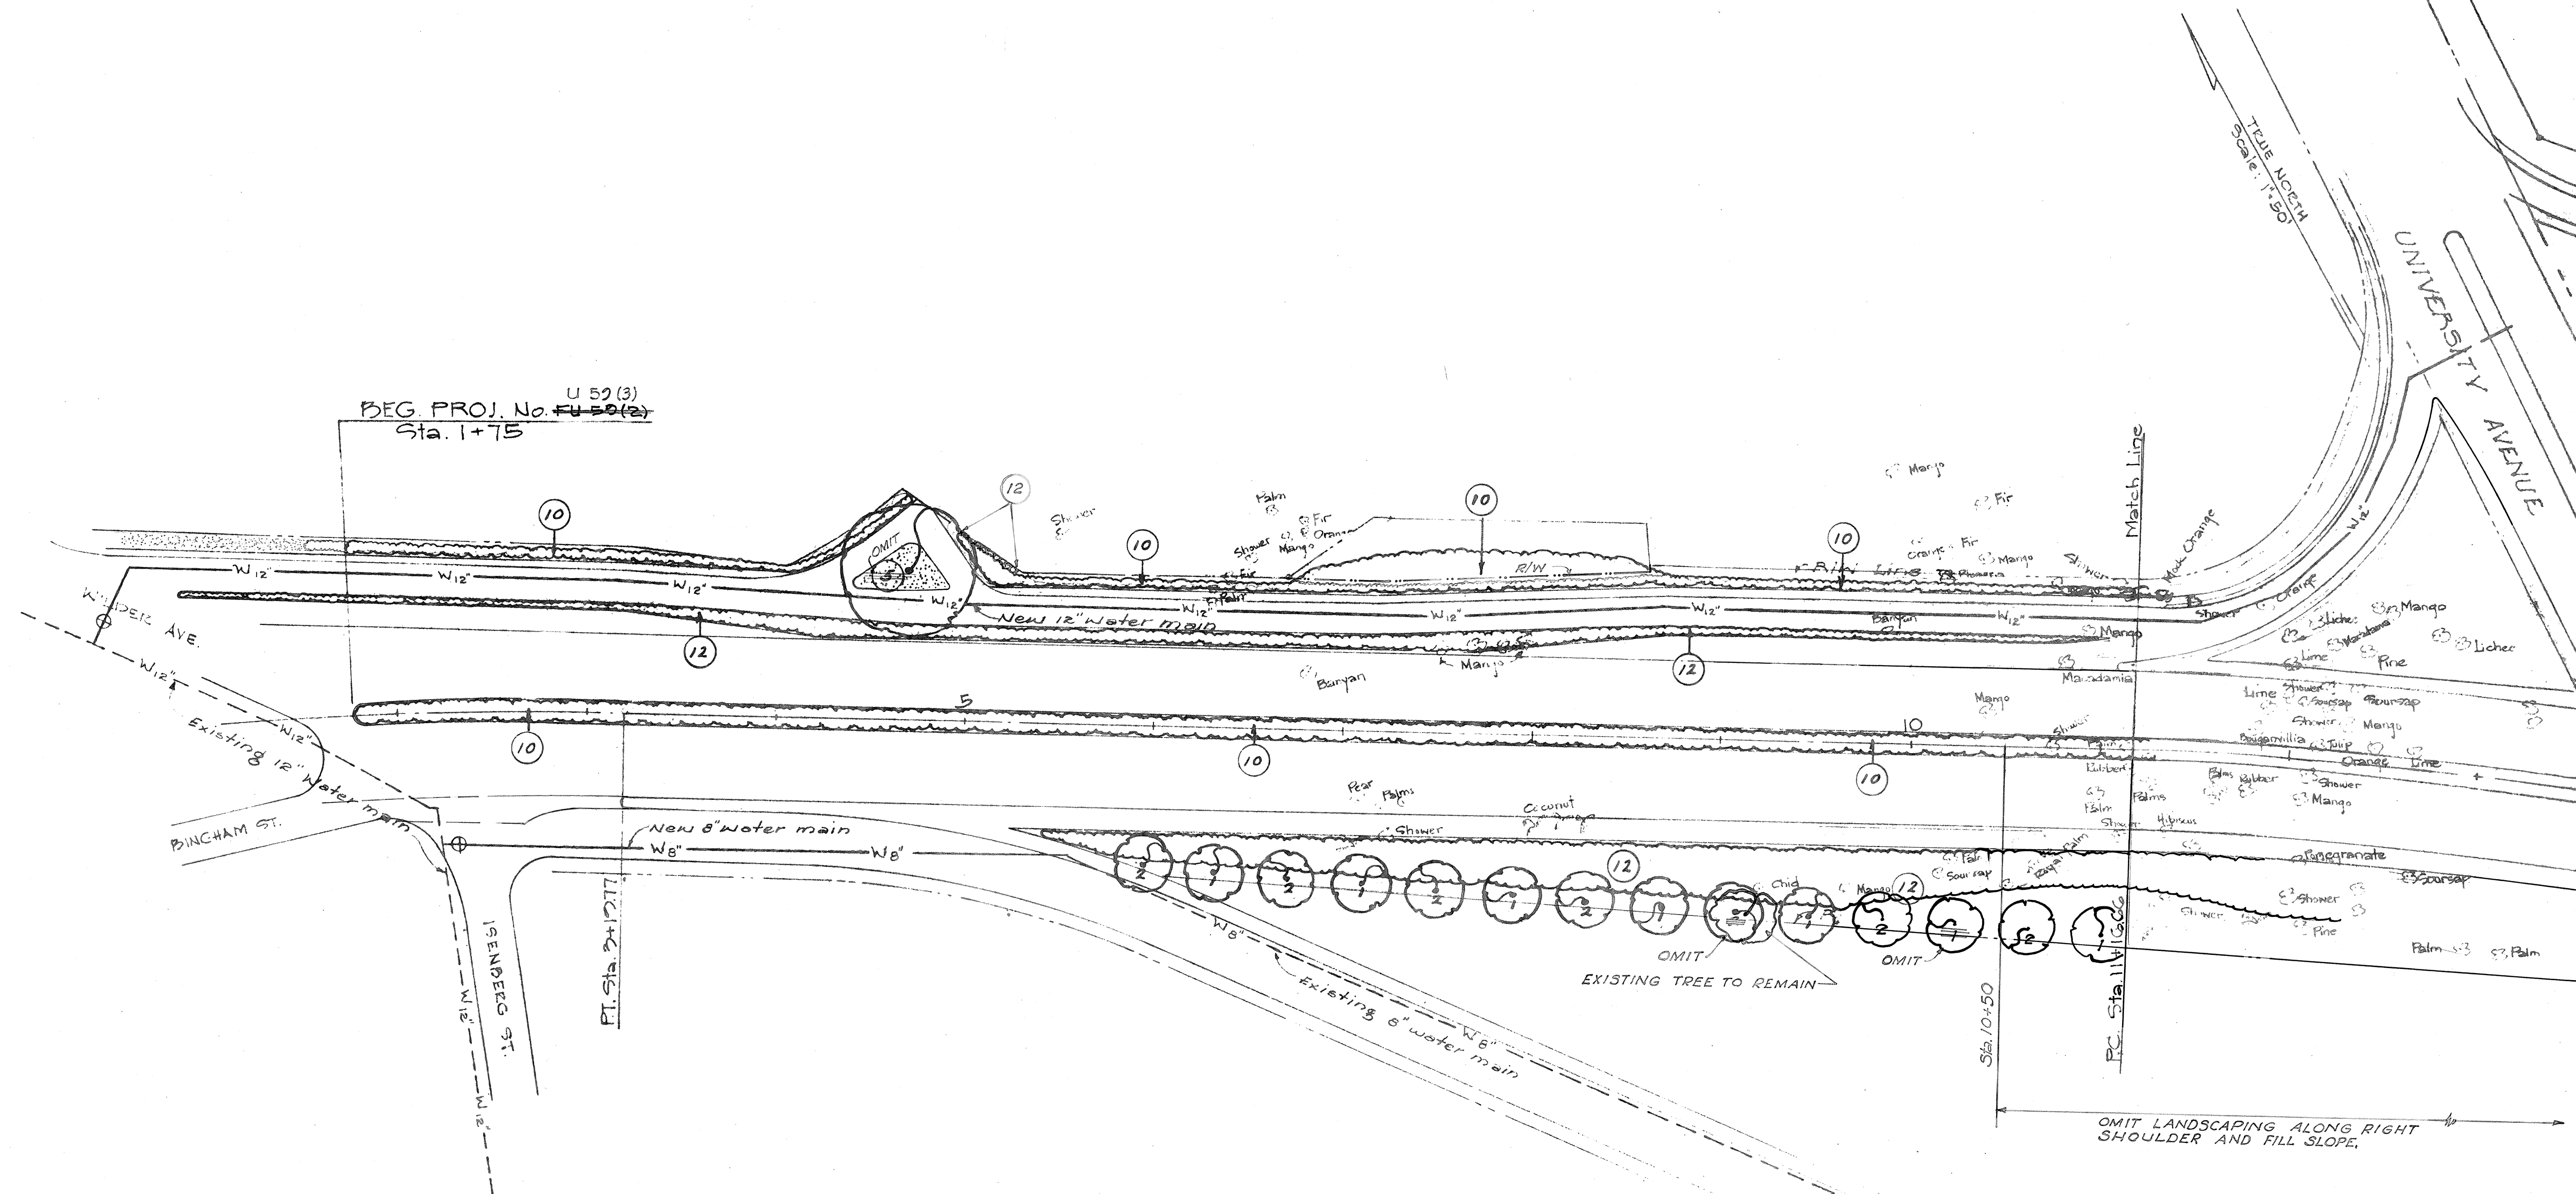

• P L A N T L I S T •

KEY	BOTANICAL NAME	COMMON NAME
1	CASSIA GRANDIS	PINK SHOWER
2	CASSIA JAVANICA	PINK & WHITE SHOWER
3	TABERUA DONNELL-SMITHII	GOLD TREE
5	JAPANESE SAMAN	MONKEYPOD TREE
6	HIBISCUS HYBRIDS (REDS)	HIBISCUS (MIXED REDS)
8	HIBISCUS HYBRIDS (YELLOW)	HIBISCUS (MIXED YELLOWS)
10	SOLANORA GUTTATA	CUP OF GOLD
12	BIGNONIA UNGUIS-CATI	CAT'S CLAW VINE
*	SEE SHEET NO. 3 FOR QUANTITIES & SPECIFICATIONS	

NOTE: GRASS (CYNODON DACTYLON) ON ALL ROAD SHOULDERS & IN AREA UNDER MONKEYPOD TREE (NO. 5)

DATE	
SURVEYED BY	
DESIGNED BY	
DRAWN BY	
CHECKED BY	
NOTE BOOK	
QUANTITIES CHECKED BY	
CHECKED BY	
NO.	

TERRITORIAL HIGHWAY DEPARTMENT
TERRITORY OF HAWAII

LANDSCAPE PLAN


MAUKA ARTERIAL
Ikenberg Street to Old Waialae Road
Fed. Aid Urban Proj. No. U 52(3)

June 1951

These plans were prepared by Thompson and Thompson, Landscape Architects.

TRUE NORTH
SCALE: 1" = 50' FT

END PROJ. No. U 52(3)
Sta. 33+00

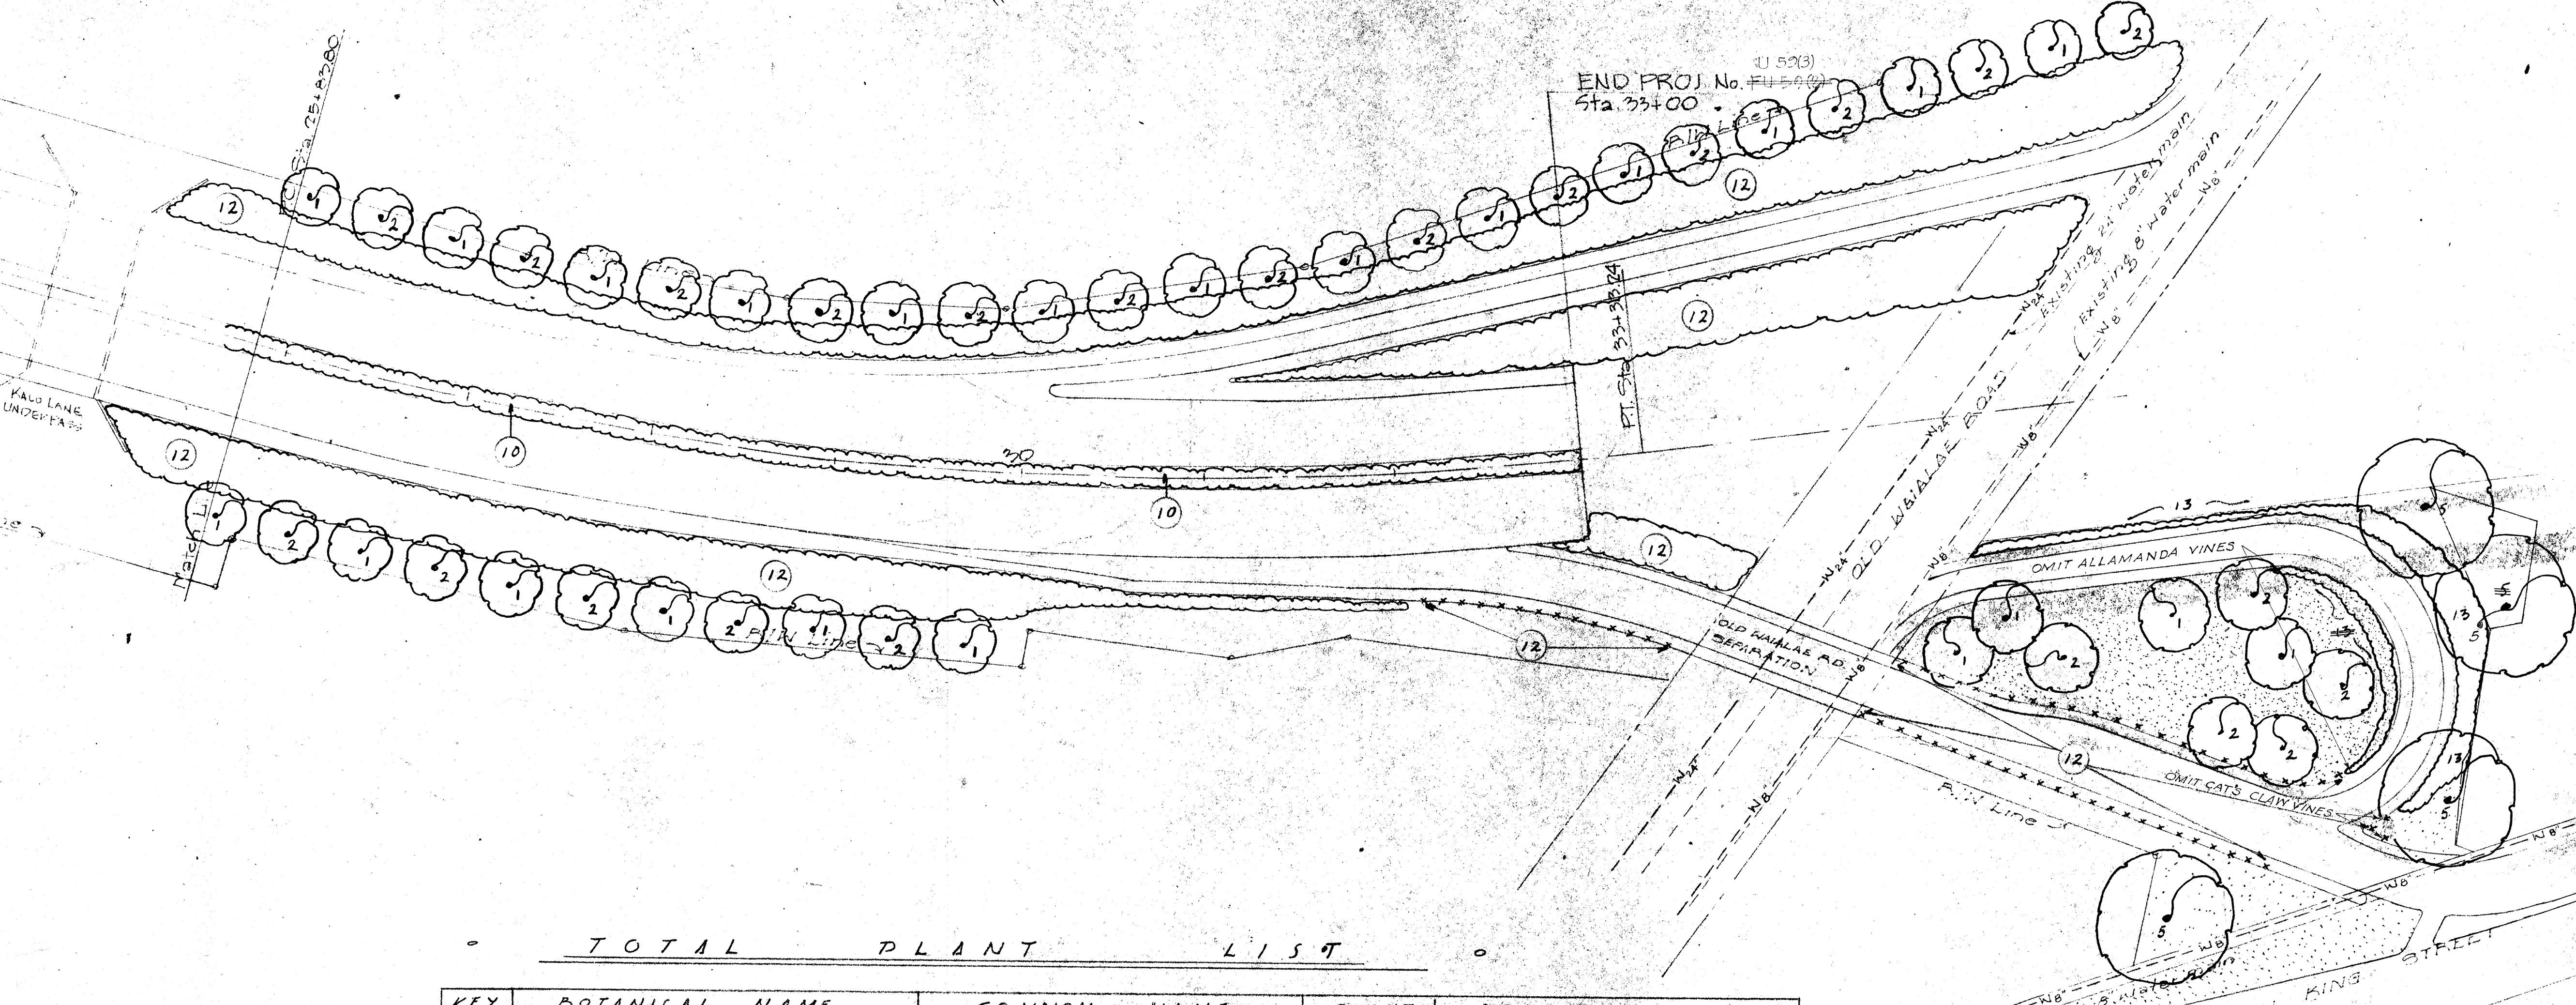

TOTAL PLANT LIST

KEY	BOTANICAL NAME	COMMON NAME	QUANT.	SPECIFICATIONS
1	CASSIA GRANDIS	PINK SHOWER	50	5 GAL. CAN-5'-8" TALL - 40' APART
2	CASSIA JAVANICA	PINK & WHITE SHOWER	52	5 GAL. CAN-5'-8" TALL - 40' APART
3	TABEBUIA DONNELL-SMITHII	GOLD TREE	17	5 GAL. CAN-5'-8" TALL - SEE PLAN
4	PTEROCARPUS INDICUS	NARRA	4	5 GAL. CAN-5'-8" TALL - SEE PLAN
5	SAMANEA SAMAN	MONKEYPOD TREE	4	5 GAL. CAN-5'-8" TALL - SEE PLAN
6	HIBISCUS HYBRIDS (RED)	HIBISCUS (MIXED RED)	257	1 GAL. CAN-2'-3" TALL - 6' APART
7	HIBISCUS HYBRIDS (PINKS)	HIBISCUS (MIXED PINKS)	200	1 GAL. CAN-2'-3" TALL - 6' APART
8	HIBISCUS HYBRIDS (YELLOW)	HIBISCUS (MIXED YELLOW)	102	1 GAL. CAN-2'-3" TALL - 6' APART
9	HIBISCUS HYBRIDS (ORANGES)	HIBISCUS (MIXED ORANGES)	102	1 GAL. CAN-2'-3" TALL - 6' APART
10	SOLANUM GUTTATA	CUP OF GOLD	102	1 GAL. CAN-2'-3" TALL - 6' APART
11	RYSTEGIA ICNEA	HORROR VINE	2,143	1 GAL. CAN-3' STAGGERED
12	BIGNONIA UNGUIS-CATI	CAT'S CLAW VINE	10,104	1 GAL. CAN-3' STAGGERED
13	ALLAMANDA CATNARTICA	ALLAMANDA	1,606	1 GAL. CAN-3' STAGGERED
14	CYDISTA AEGUINOCTIALIS	GARLIC VINE	205	1 GAL. CAN-3' STAGGERED
15	CRYPTOSTEGIA GRANDIFLORA	INDIA RUBBER VINE	206	1 GAL. CAN-3' STAGGERED

NOTE: GRASS (CYNODON DACTYLON) ON ALL ROAD SHOULDERS & IN AREAS INDICATED ON SHEETS NO. 1, 2, & 3

SURVEY PLOTTED BY
DESIGNED BY
PLAN
TRACED BY
NOTE BOOK
QUANTITIES BY
CHECKED BY
No.

TERRITORIAL HIGHWAY DEPARTMENT
TERRITORY OF HAWAII

LANDSCAPE PLAN
MAUNA ARTERIAL
BENBERG STREET TO OLD WAIALAE ROAD
FED. AID URBAN PROJ. No. U 52(3)
JUNE 1951

These plans were prepared
by Thompson and Thompson
Landscape Architects.

SHEET No. 3 OF 3 SHEETS

5508.32