

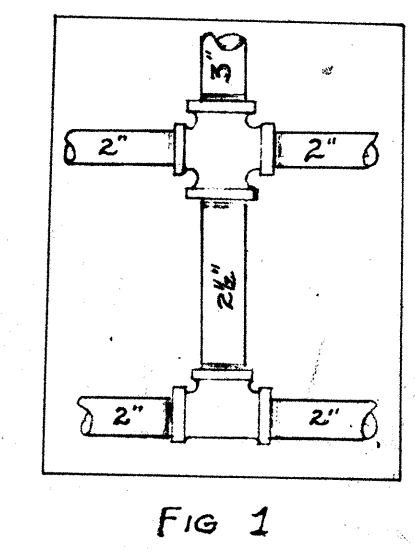
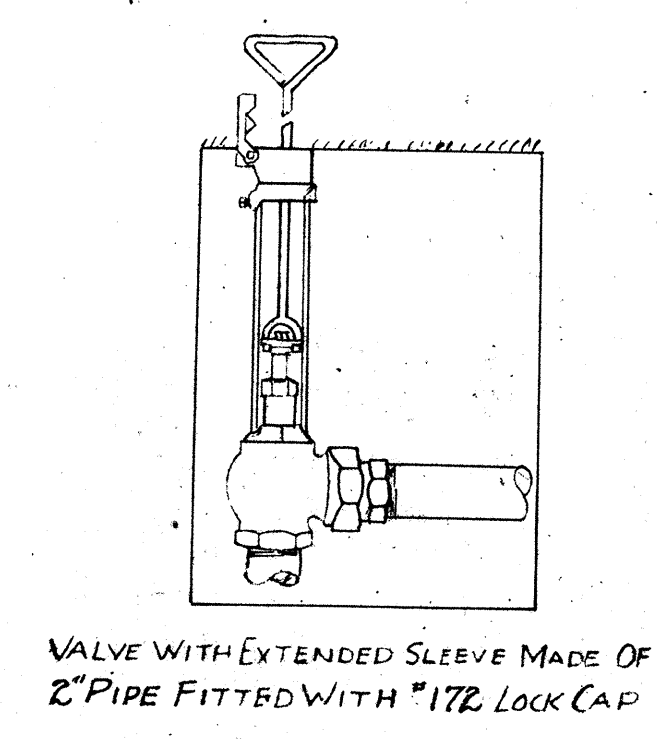
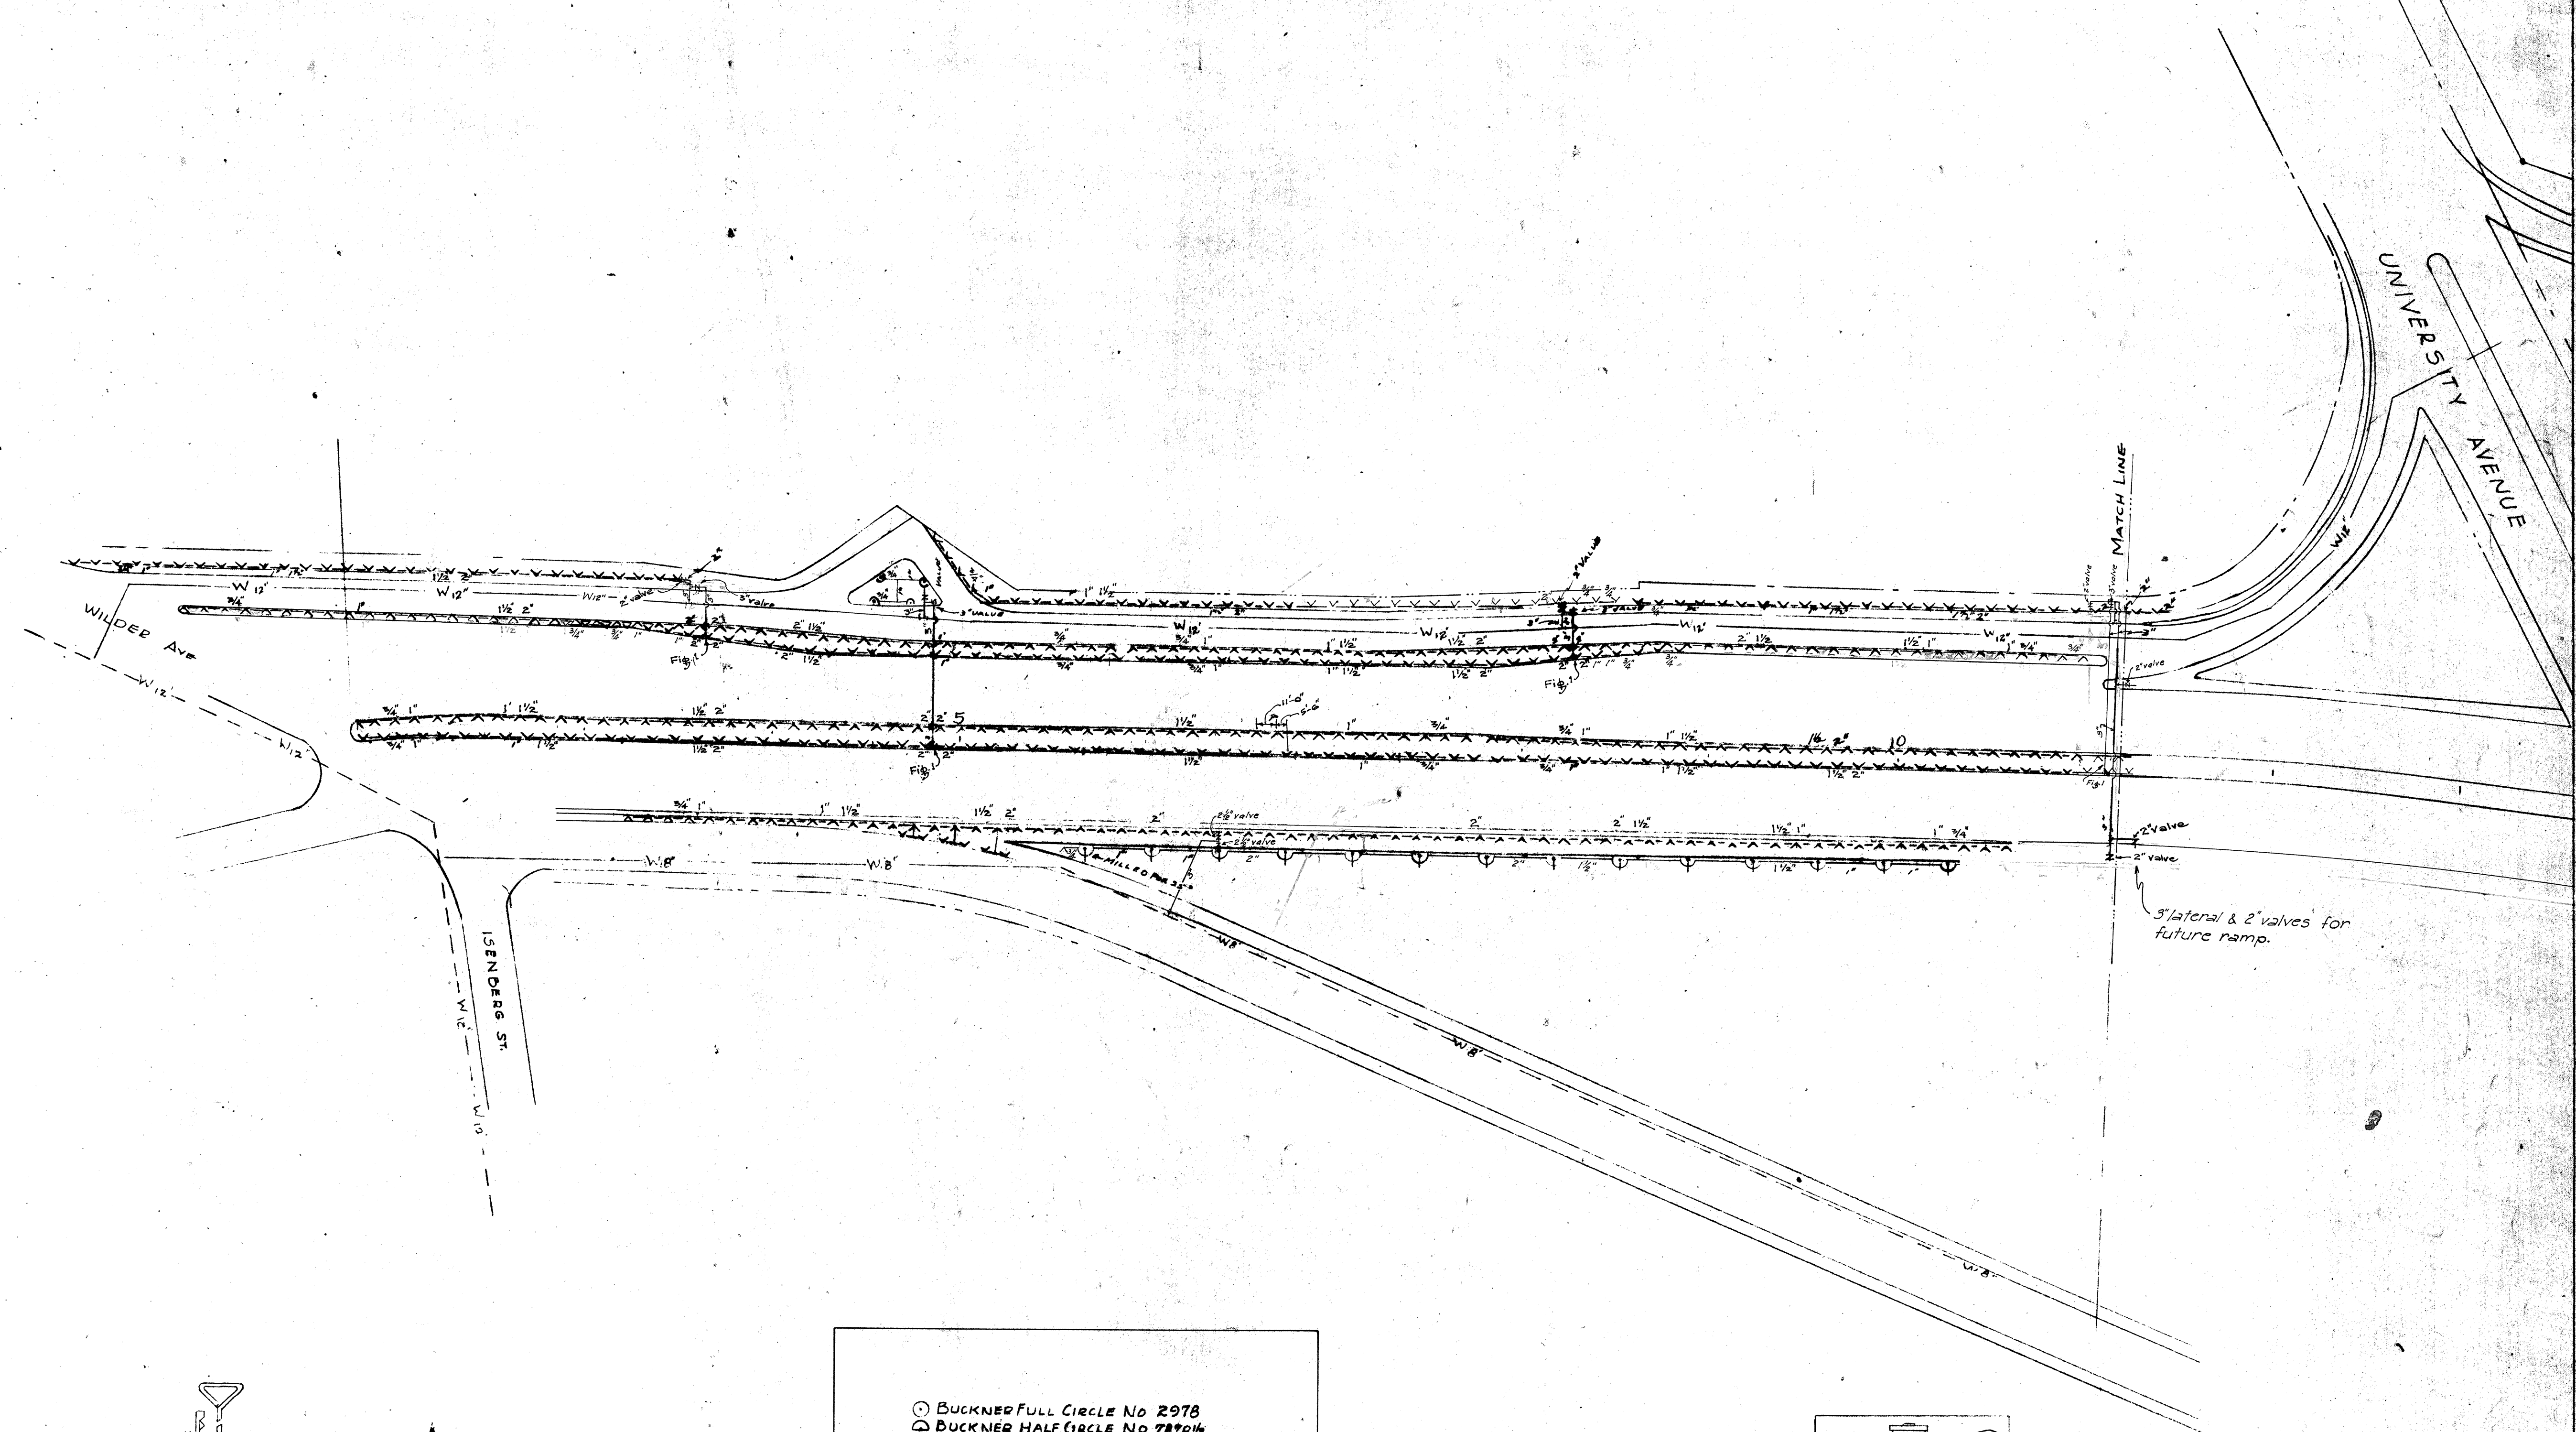


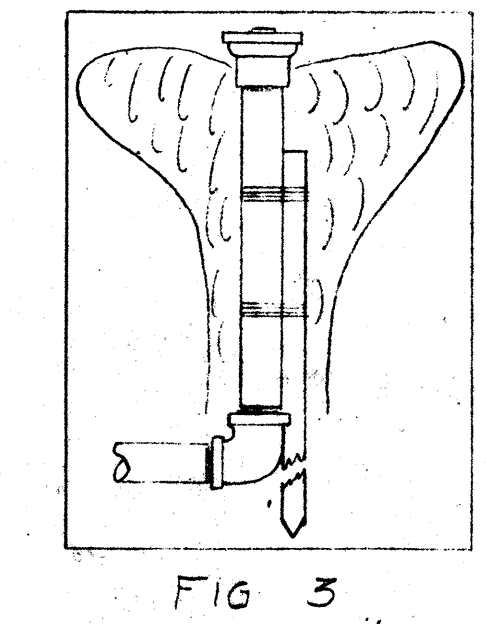

- ⊙ BUCKNER FULL CIRCLE NO 2978
- ⊙ BUCKNER HALF CIRCLE NO 7878 1/2
- ⊙ BUCKNER FULL CIRCLE NO 1290
- ⊙ BUCKNER HALF CIRCLE NO 1290 1/2
- ⊙ SLEEVE MILLED AS INDICATED
- ⊙ BUCKNER HALF CIRCLE NO 35H
- ⊙ BUCKNER HALF CIRCLE NO 400AH
- ⊙ SPACED AT 17 FT. INTERVALS
- ⊙ BUCKNER ANGLE CONTROL VALVE
- ⊙ SIZES AS INDICATED
- SEE MATERIAL LIST FOR QUANTITIES
- ALL HEADS IN SHRUBBERY TO BE
- EVEN WITH PLANT TOPS
- 60 LBS PRESSURE AT CONTROL VALVES
- SHEET 1 OF 3 SHEETS

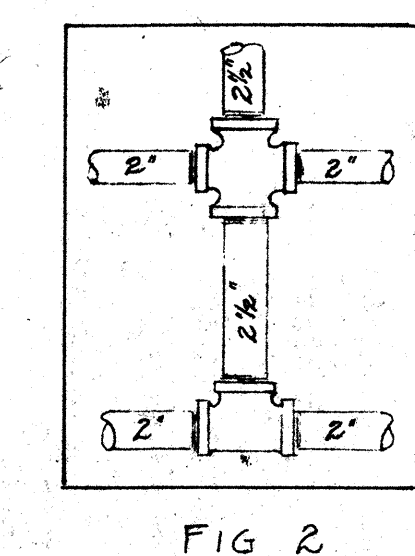

These plans were prepared by:
Hawaiian Sprinkler Service




THIS SHEET SUPERSEDES SHEET 5508.33

TERRITORIAL HIGHWAY DEPARTMENT
TERRITORY OF HAWAII
SPRINKLER SYSTEM
MAUKA ARTERIAL
Isenberg Street to Old Hialeac Road
Federal Aid Urban Project No. U590
Scale: 1"=50'
Nov. 11, 1951

5508.33A

STATE	FISCAL YEAR	SHEET NO.	TOTAL SHEETS
HAWAII	1952	34	90

RAMP U-3 REVISED
July 2, 1952.

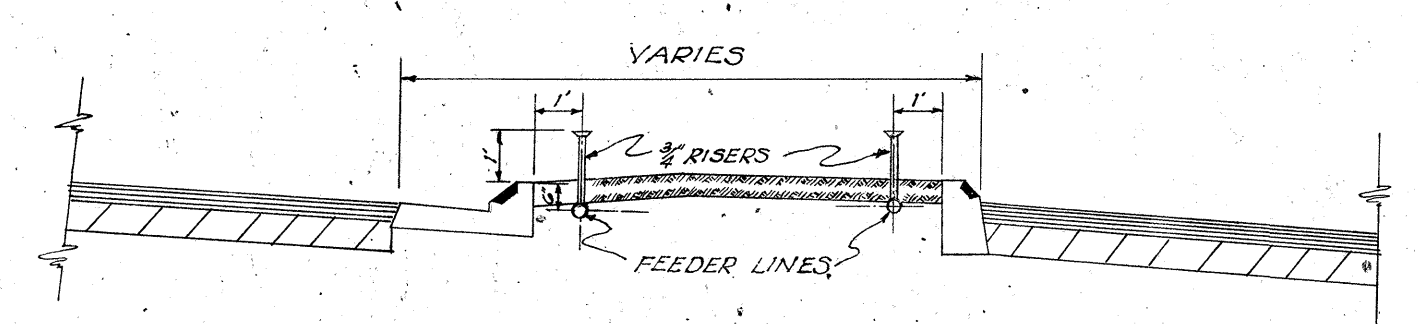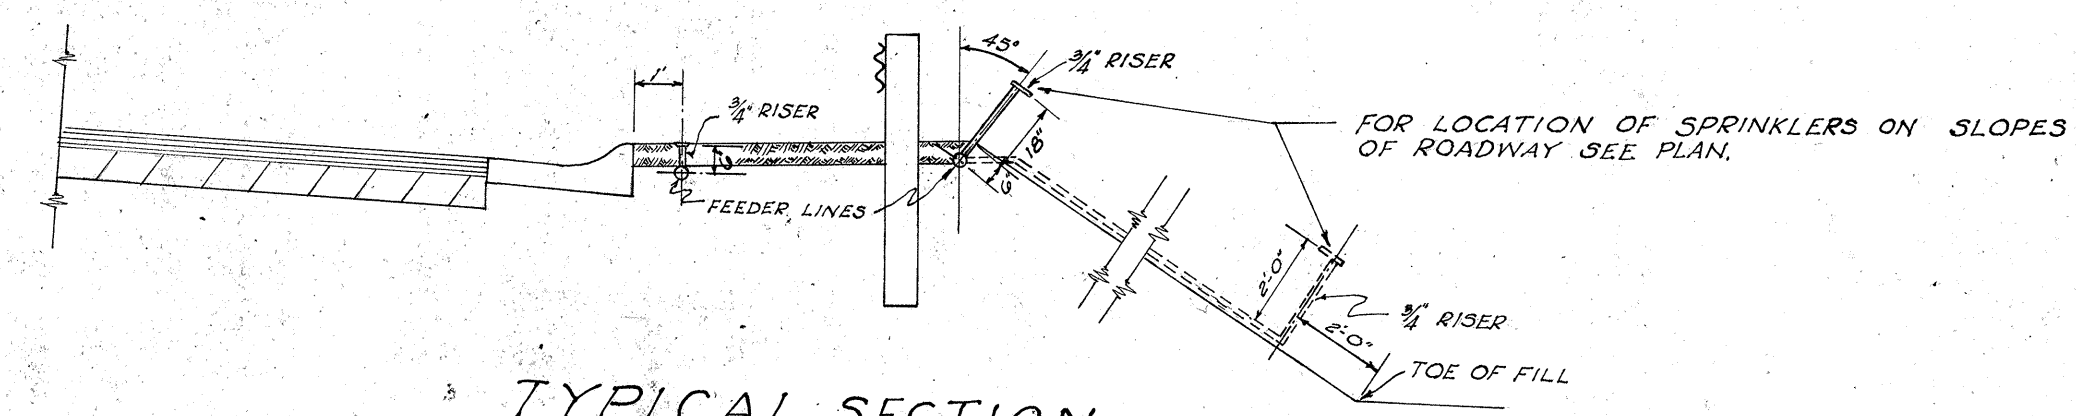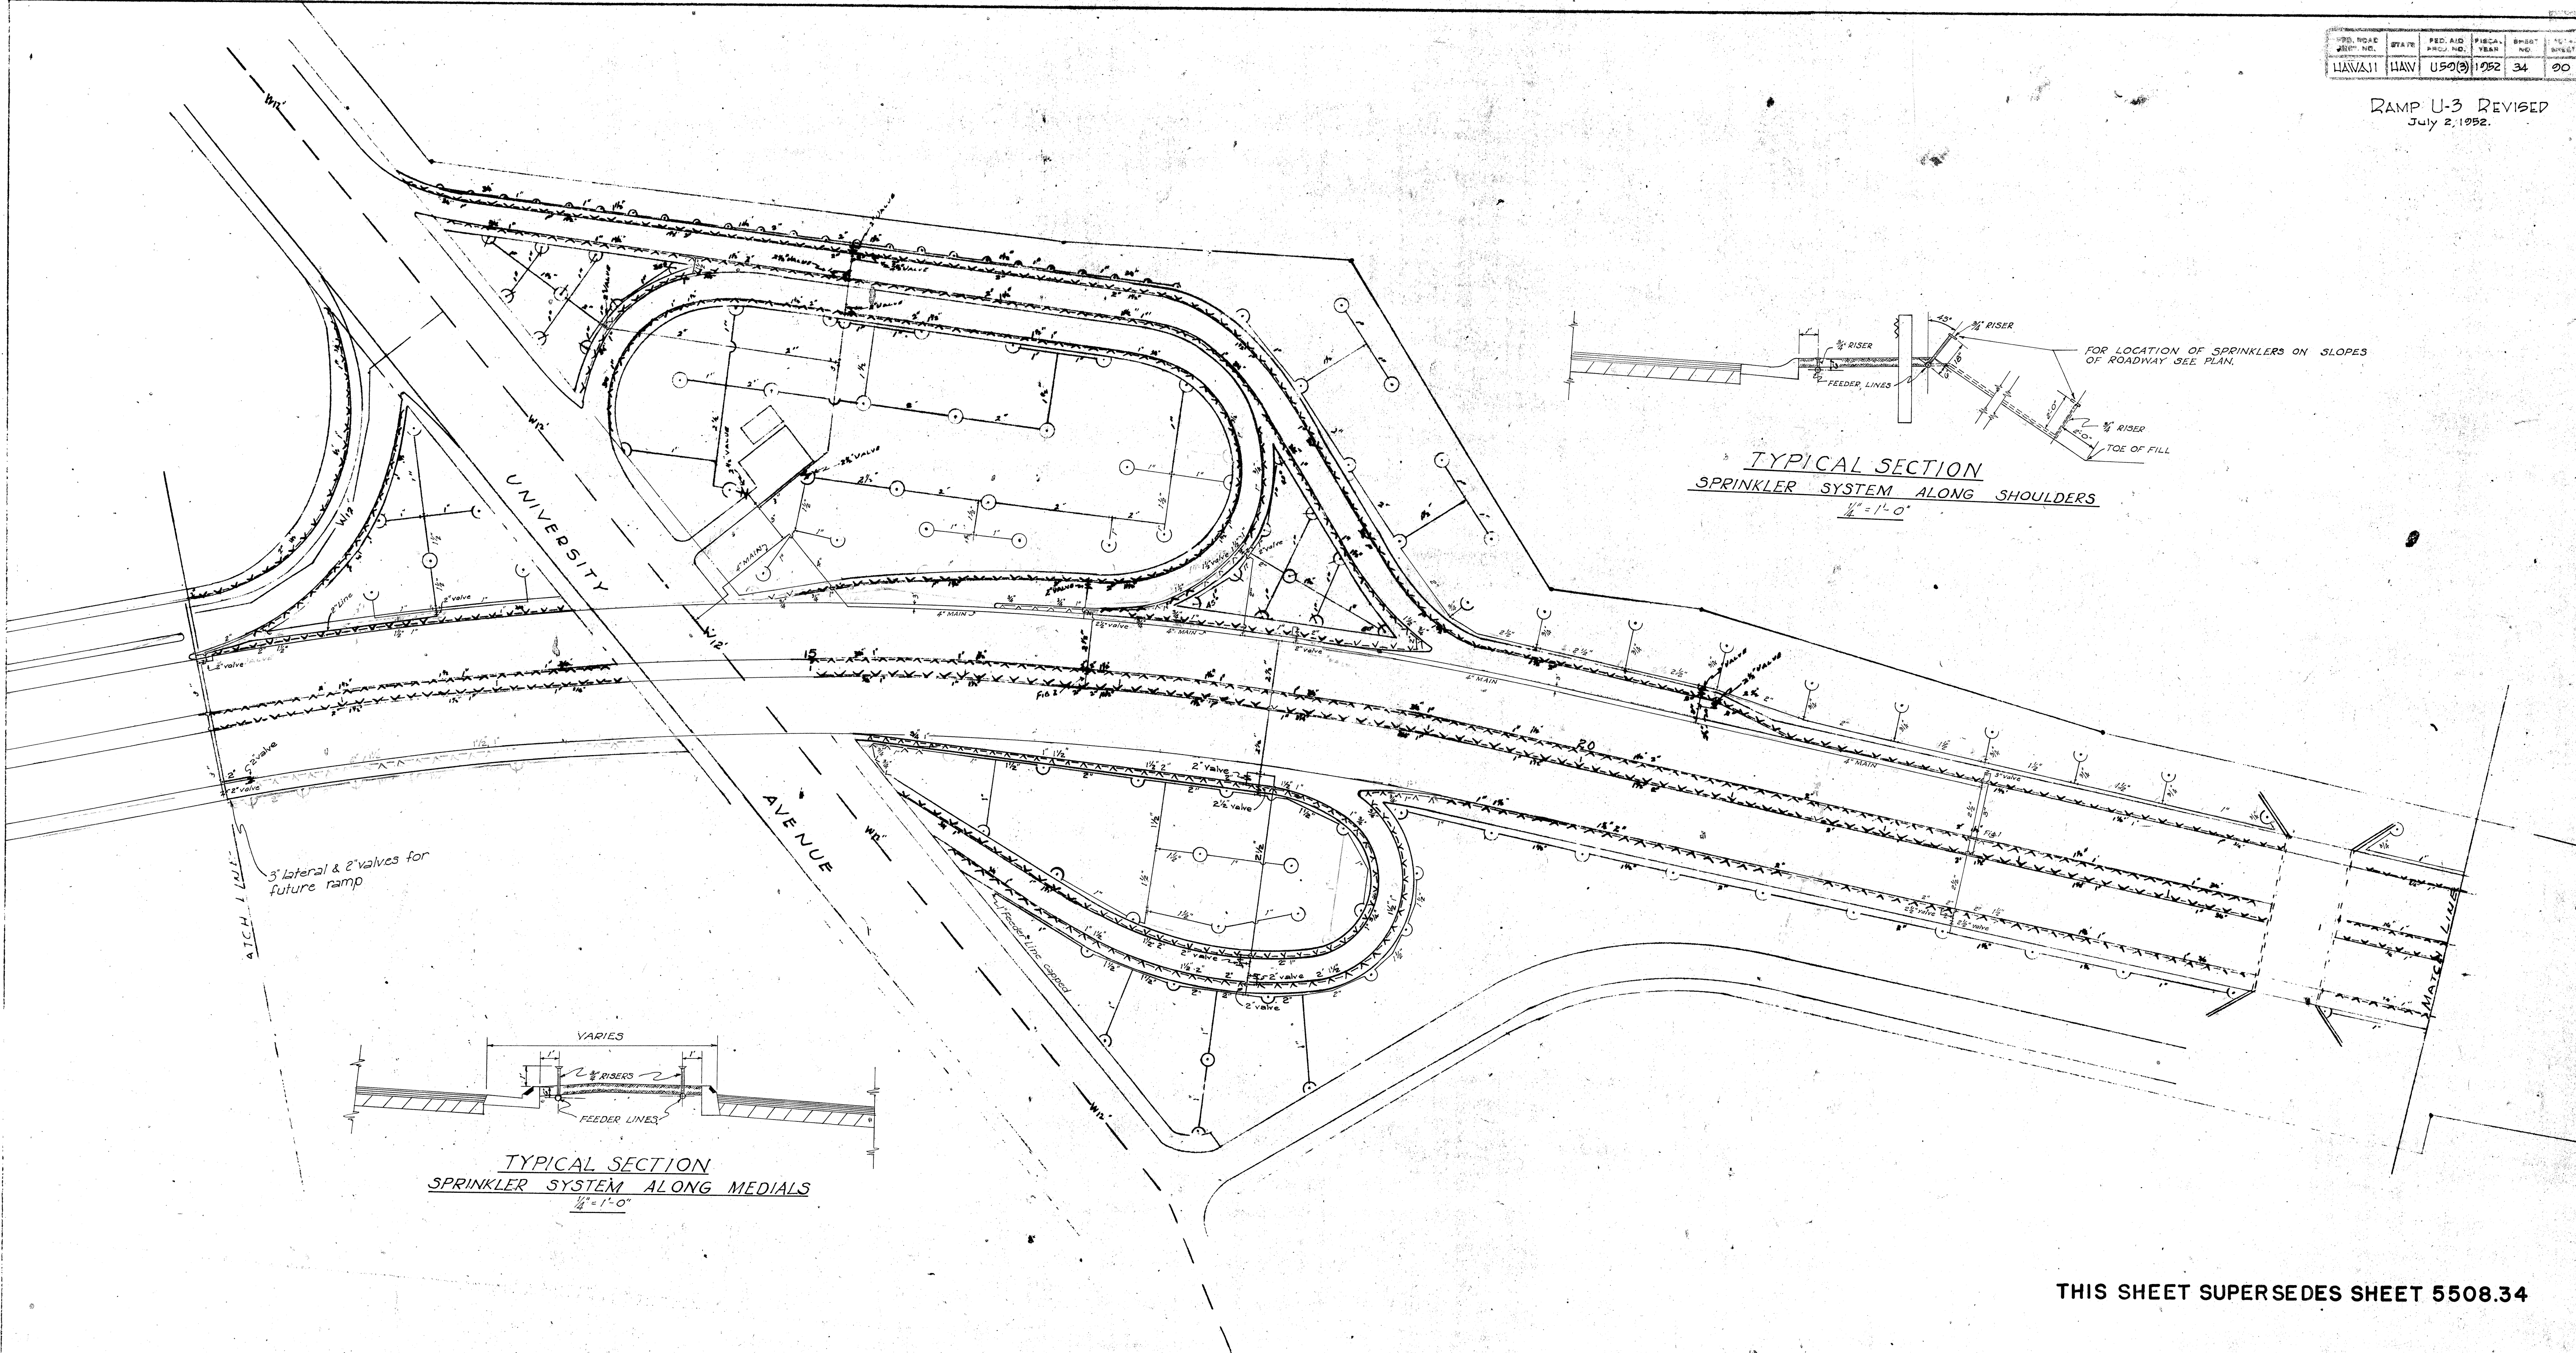

THIS SHEET SUPERSEDES SHEET 5508.34

SHEET 2 OF 3 SHEETS


These plans were prepared by:
Hawaiian Sprinkler Service

TERRITORIAL HIGHWAY DEPARTMENT
 TERRITORY OF HAWAII

SPRINKLER SYSTEM
MAUKA ARTERIAL
 Isenberg Street to Old Waiialea Road
 Federal Aid Urban Project No. U-596

Scale: 1"=50'
 Nov. 11, 1951

5508.34A

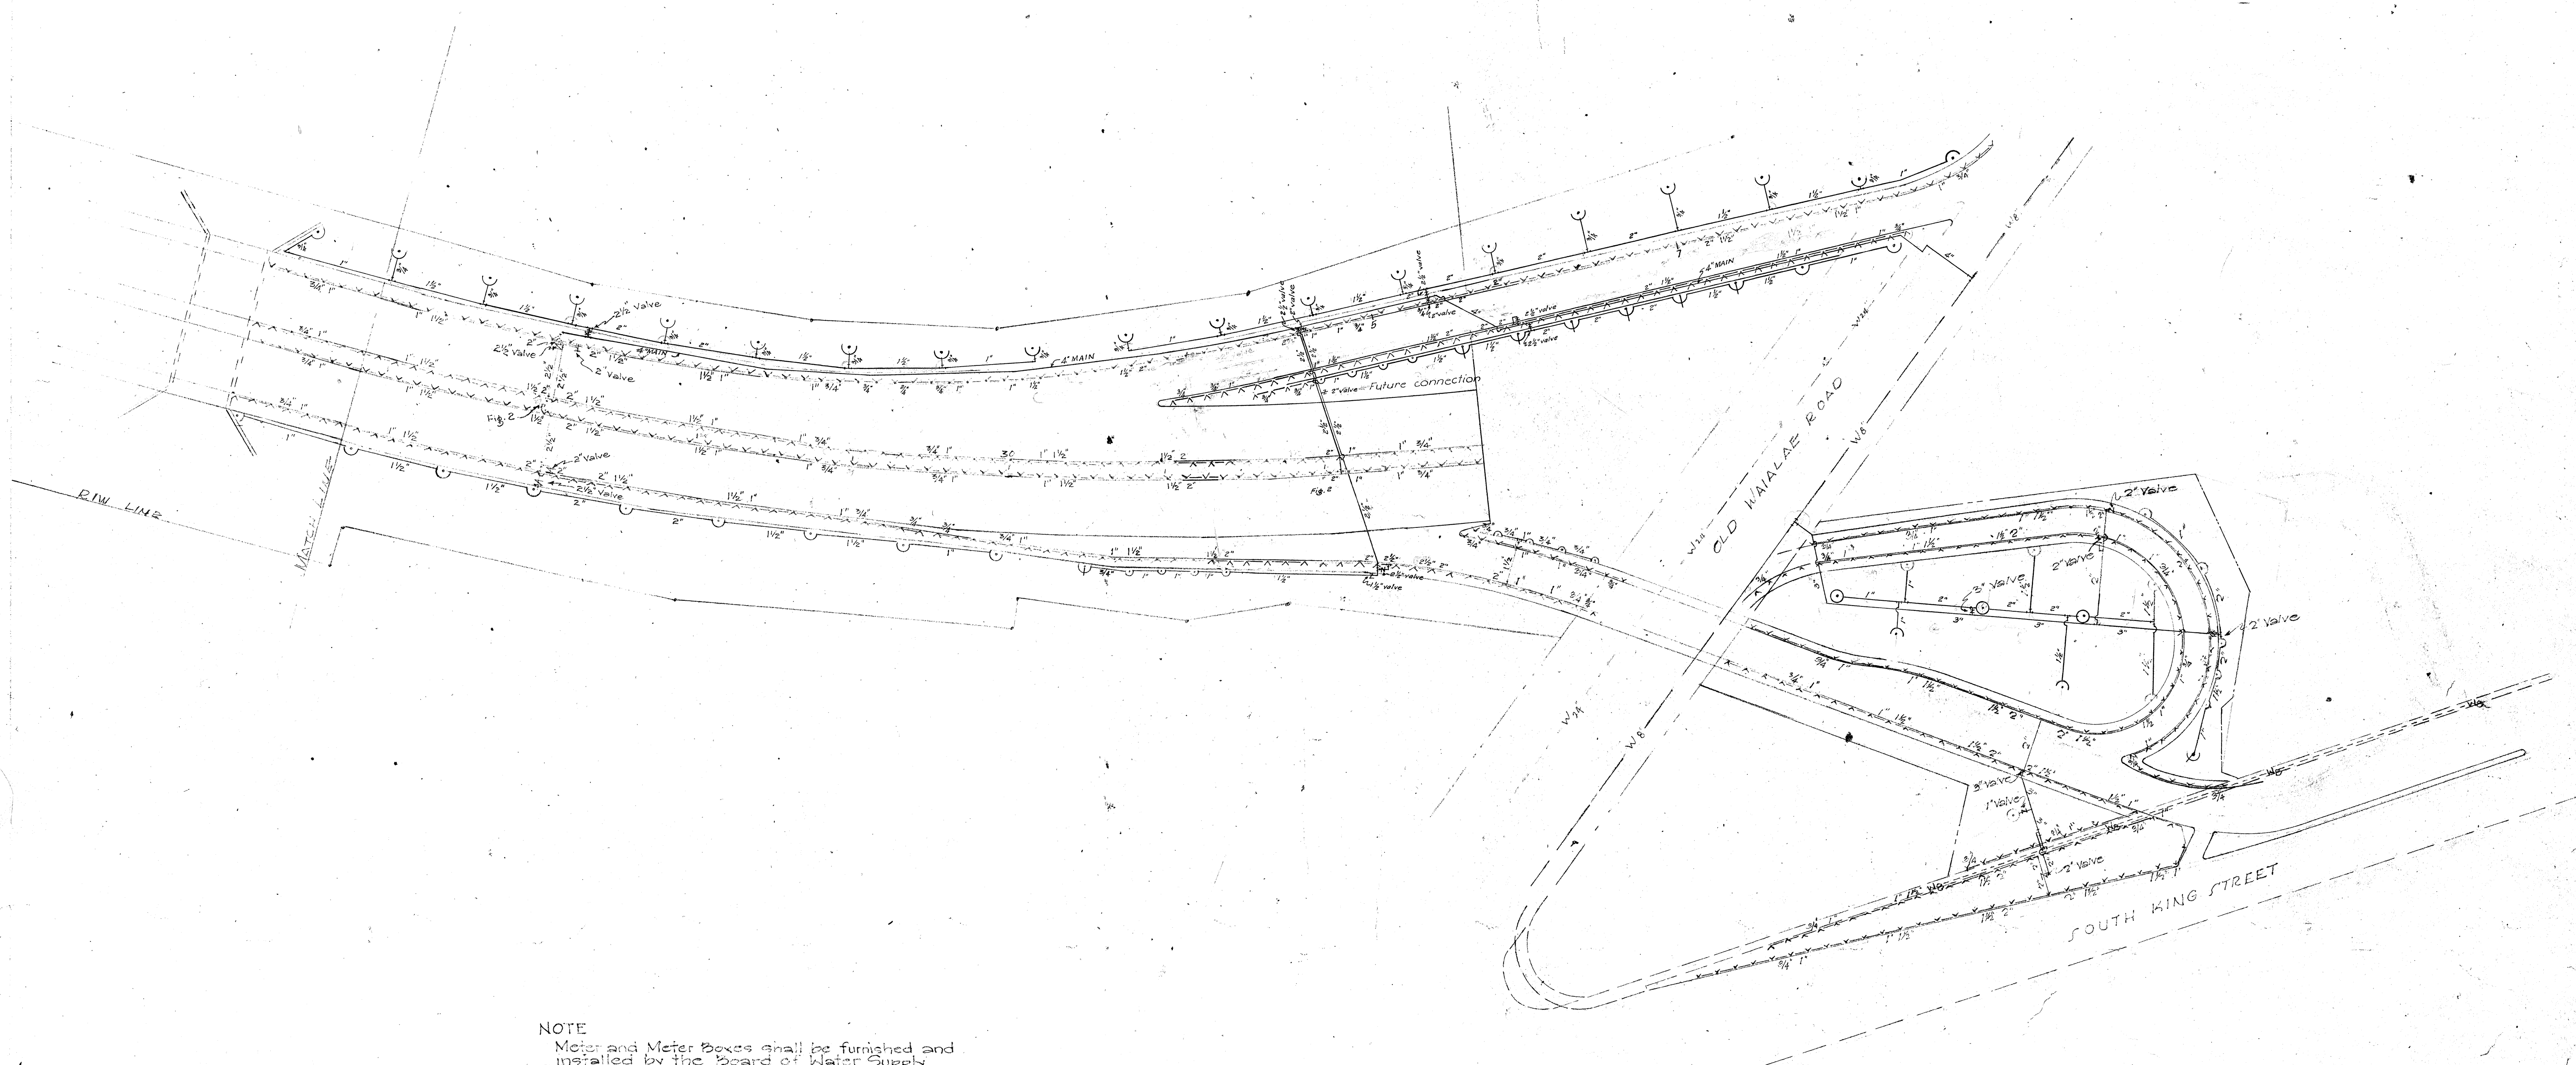

NOTE
 Meter and Meter Boxes shall be furnished and installed by the Board of Water Supply, City and County of Honolulu.
 All pipes in pavement area shall have 2'-0" cover below pavement grade.

THIS SHEET SUPERSEDES SHEET 5508.35

SHEET 3 OF 3 SHEETS

These plans were prepared by:
 Hawaiian Sprinkler Service

HAWAIIAN HIGHWAY & DEPARTMENT TERRITORY	
SPRINKLER SYSTEM MAUKA ARTERIAL Isenberg Street to Old Wai'alae Road Federal Aid Urban Project No. U 50(3)	
Scale: 1"=50'	Nov. 11, 1951
5508.35A	