

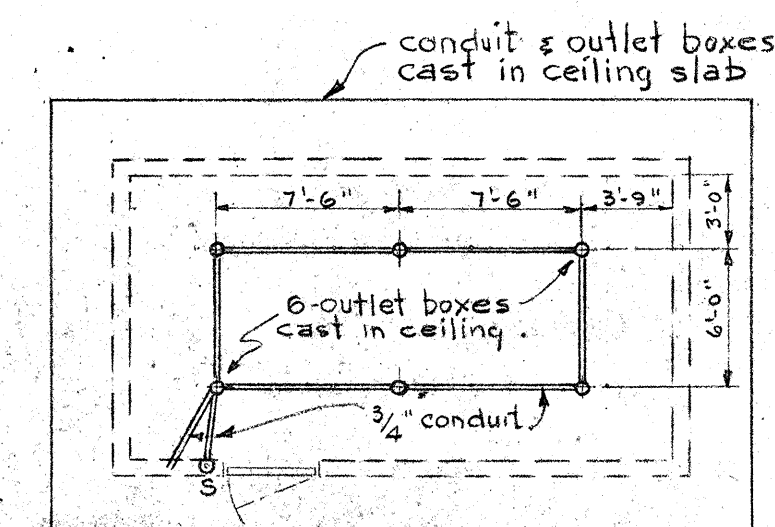
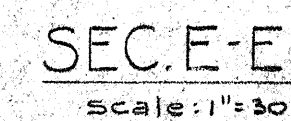
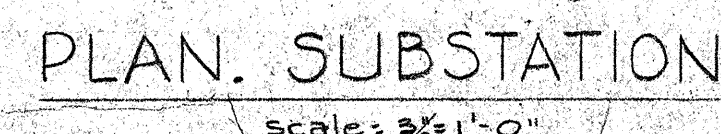


FRONT ELEVATION
scale: $\frac{3}{8}" = 1'-0"$

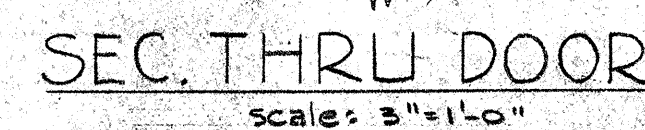

CONDUIT FOR 6
BENJAMIN 14"
RLM DOME LIGHTS

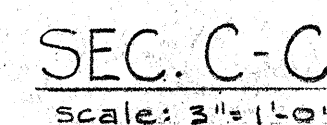

FRAME 20 GA. GALV. STEEL.
LOUVERS 26 GA. GALV. STEEL.
scale: 3"=1'-0"



Note: Line-in V.C.'s by eye

AUSTIN & TOWILL
CIVIL ENGINEERS
HONOLULU, HAWAII

TERRITORIAL HIGHWAY DEPARTMENT
TERRITORY OF HAWAII

SUBSTATION
STRUCTURAL DETAILS
MAUKA ARTERIAL

ISENBERG STREET TO OLD WAIALAE ROAD
FED. AID URBAN PROJ. No. U 52(3)
Scale: AS NOTED JANUARY 1951

SHEET No. | OF | SHEETS

