


CONVENTIONAL SIGNS

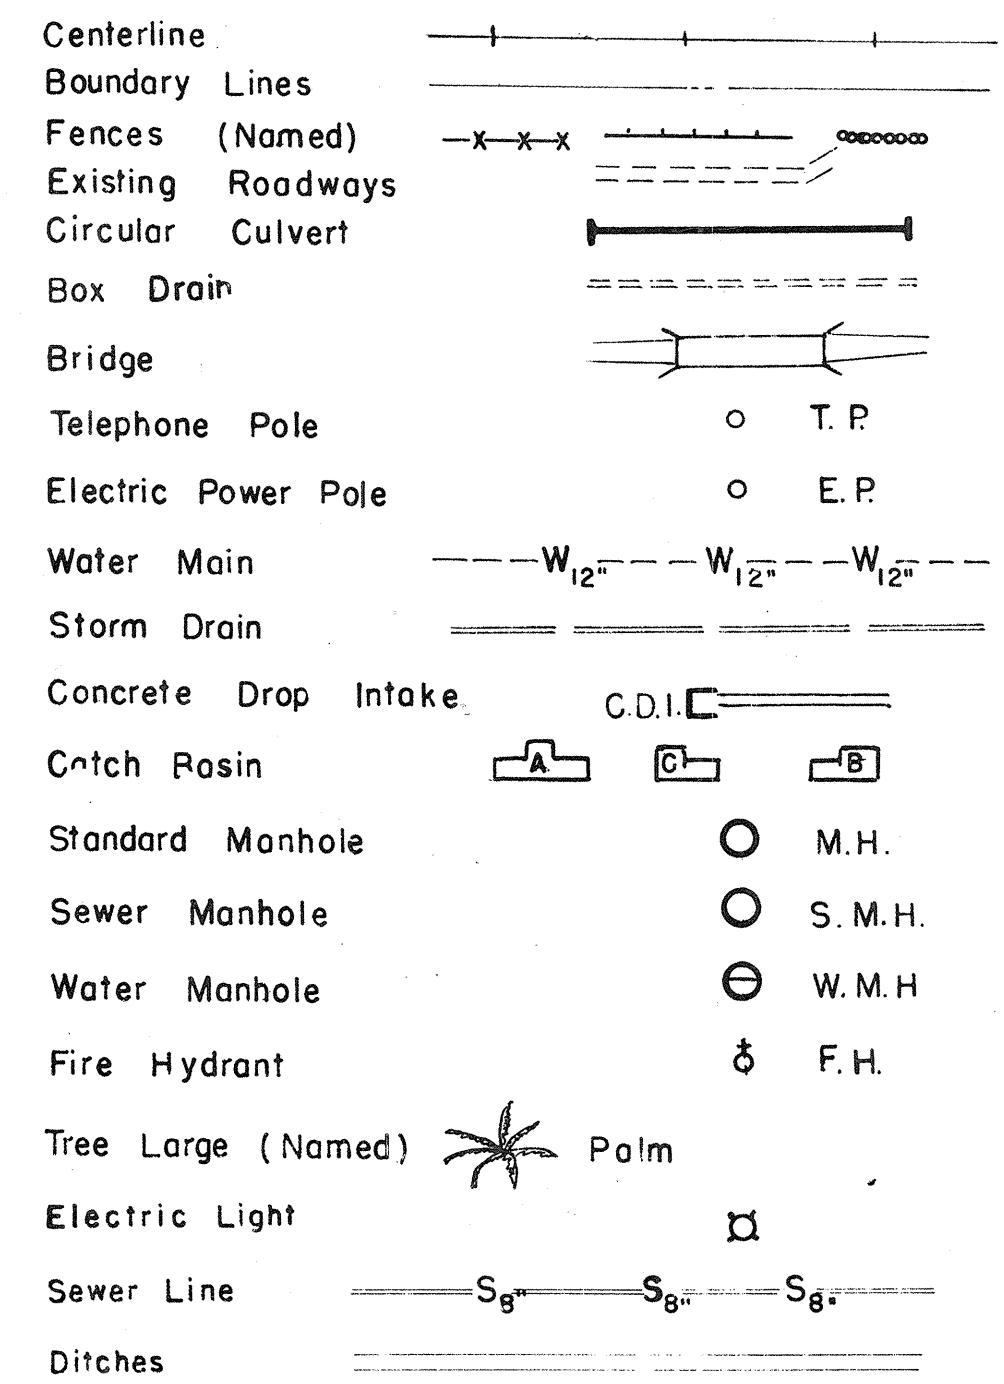



TERRITORY OF HAWAII
TERRITORIAL HIGHWAY DEPARTMENT
HONOLULU, OAHU, T. H.

PLANS OF MAUKA ARTERIAL

ISENBERG STREET TO OLD WAIALAE ROAD U 59 (3)
FEDERAL AID URBAN PROJECT NO. FU 59 (2)
DISTRICT OF HONOLULU
ISLAND OF OAHU

SCALES

PLAN 1 INCH = 50 FEET
PROFILE HOR. 1 INCH = 50 FEET
VERT. 1 INCH = 10 FEET
CROSS SECTION HOR. 1 INCH = 10 FEET
VERT. 1 INCH = 10 FEET

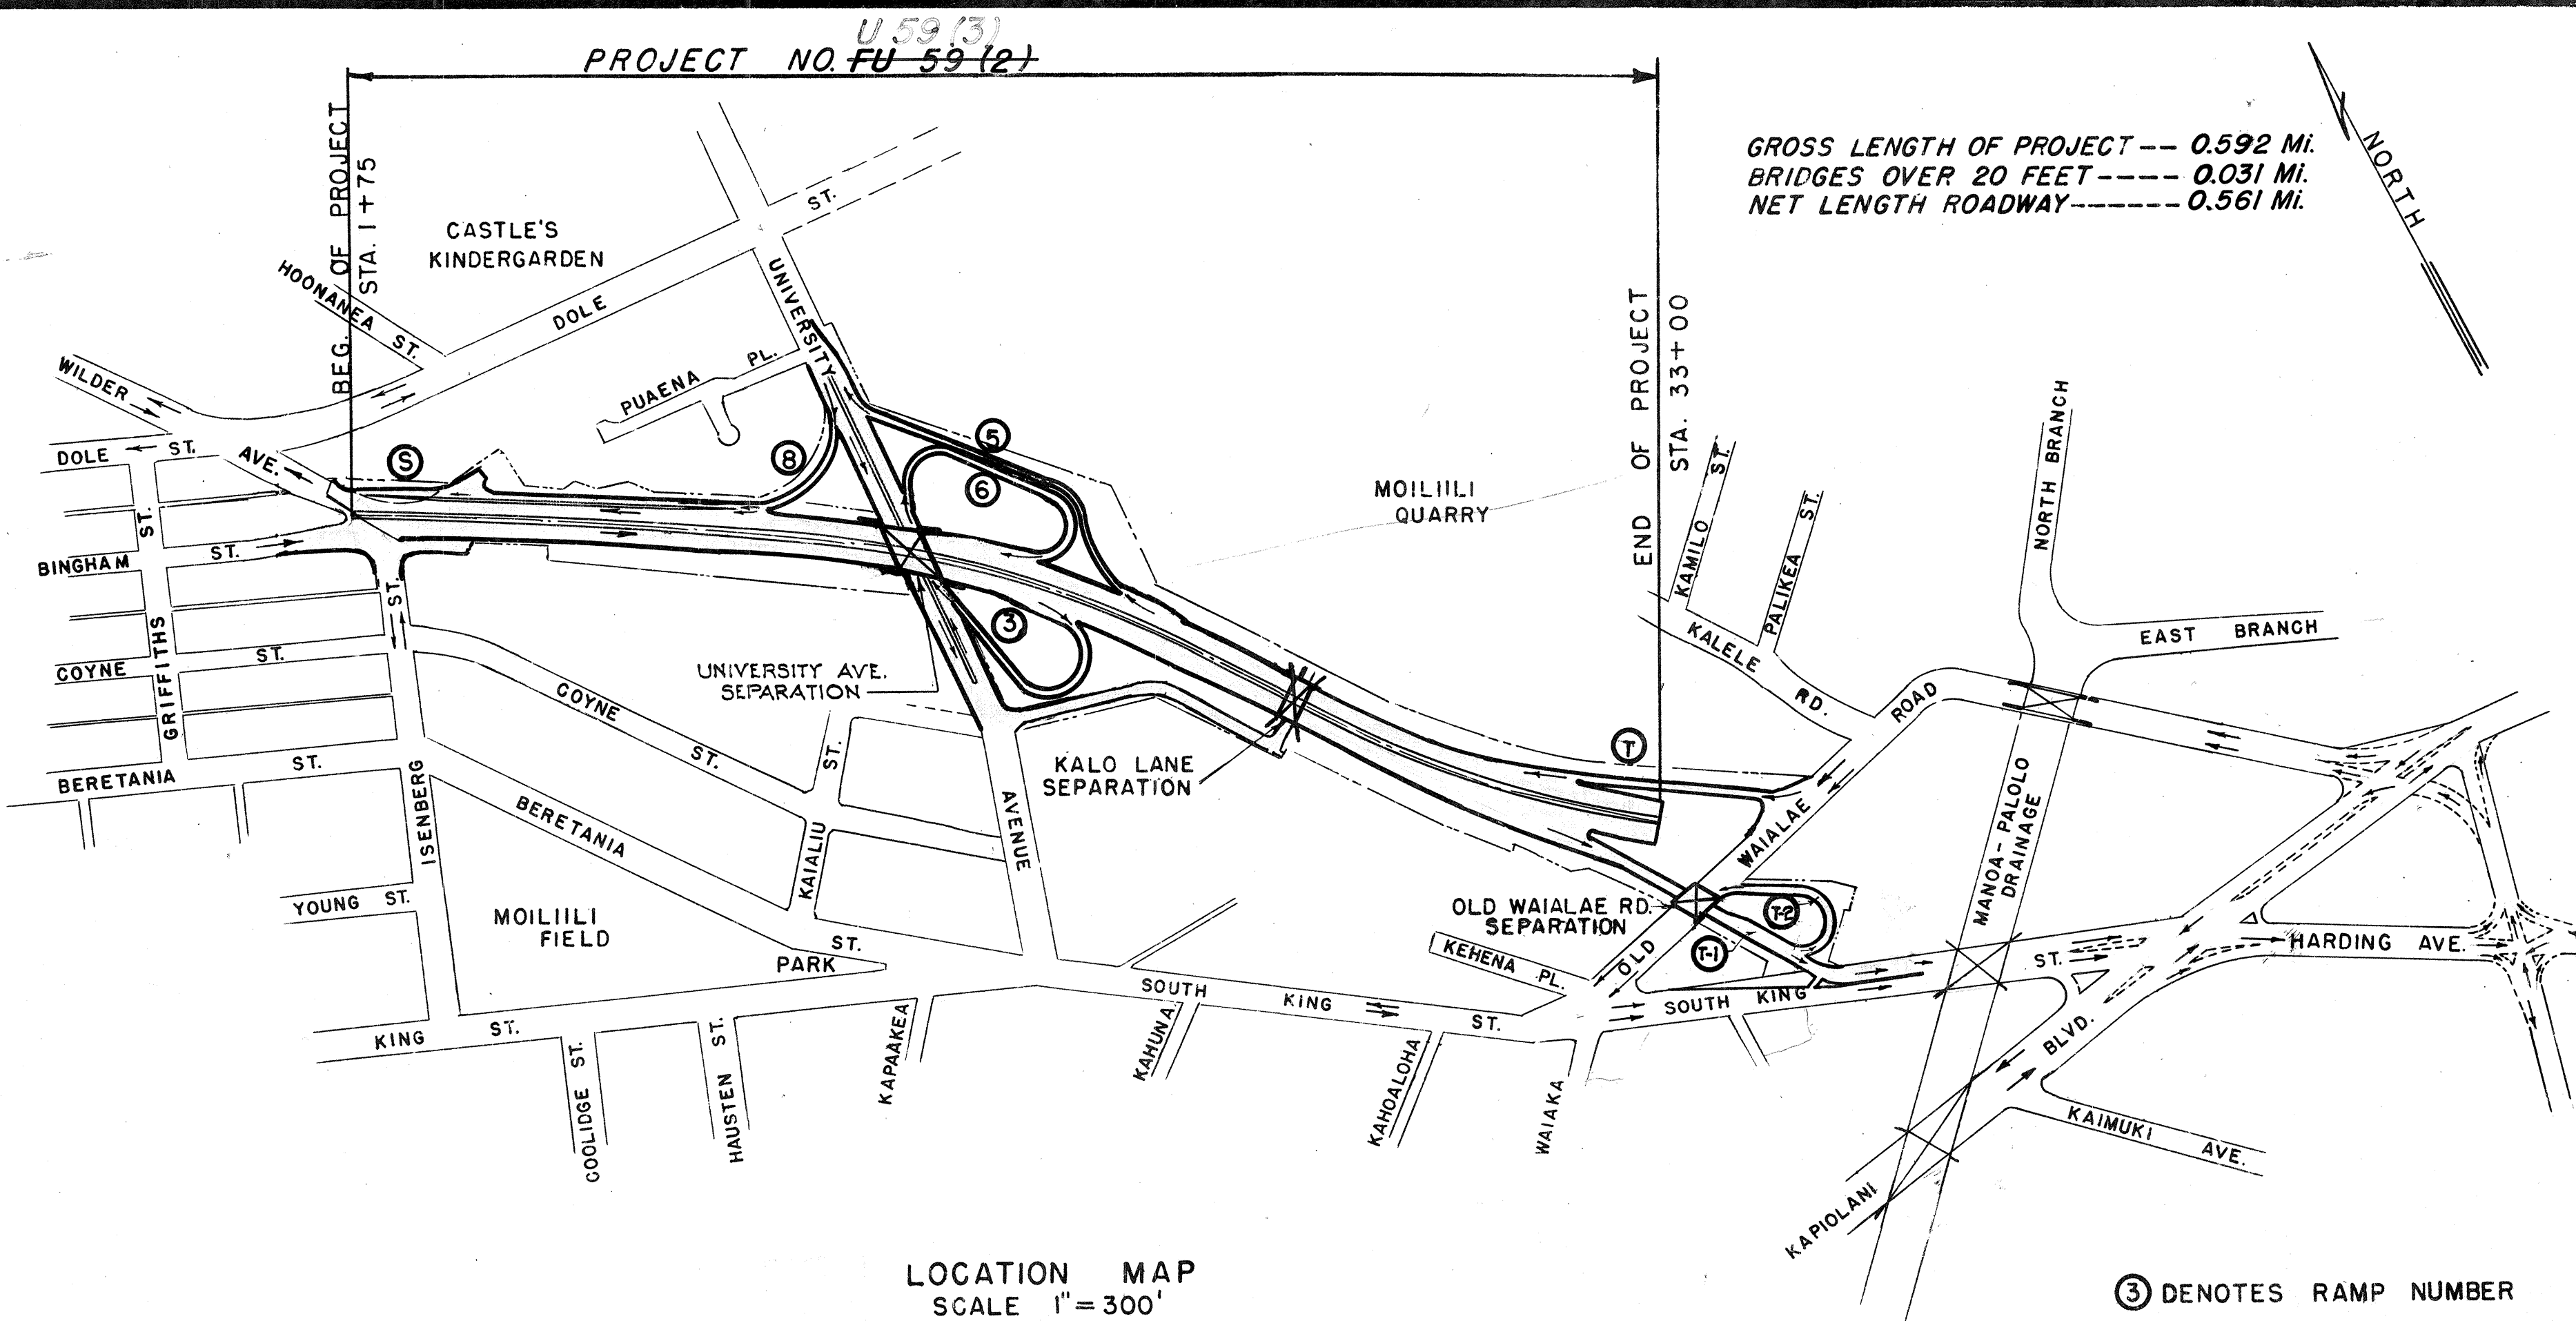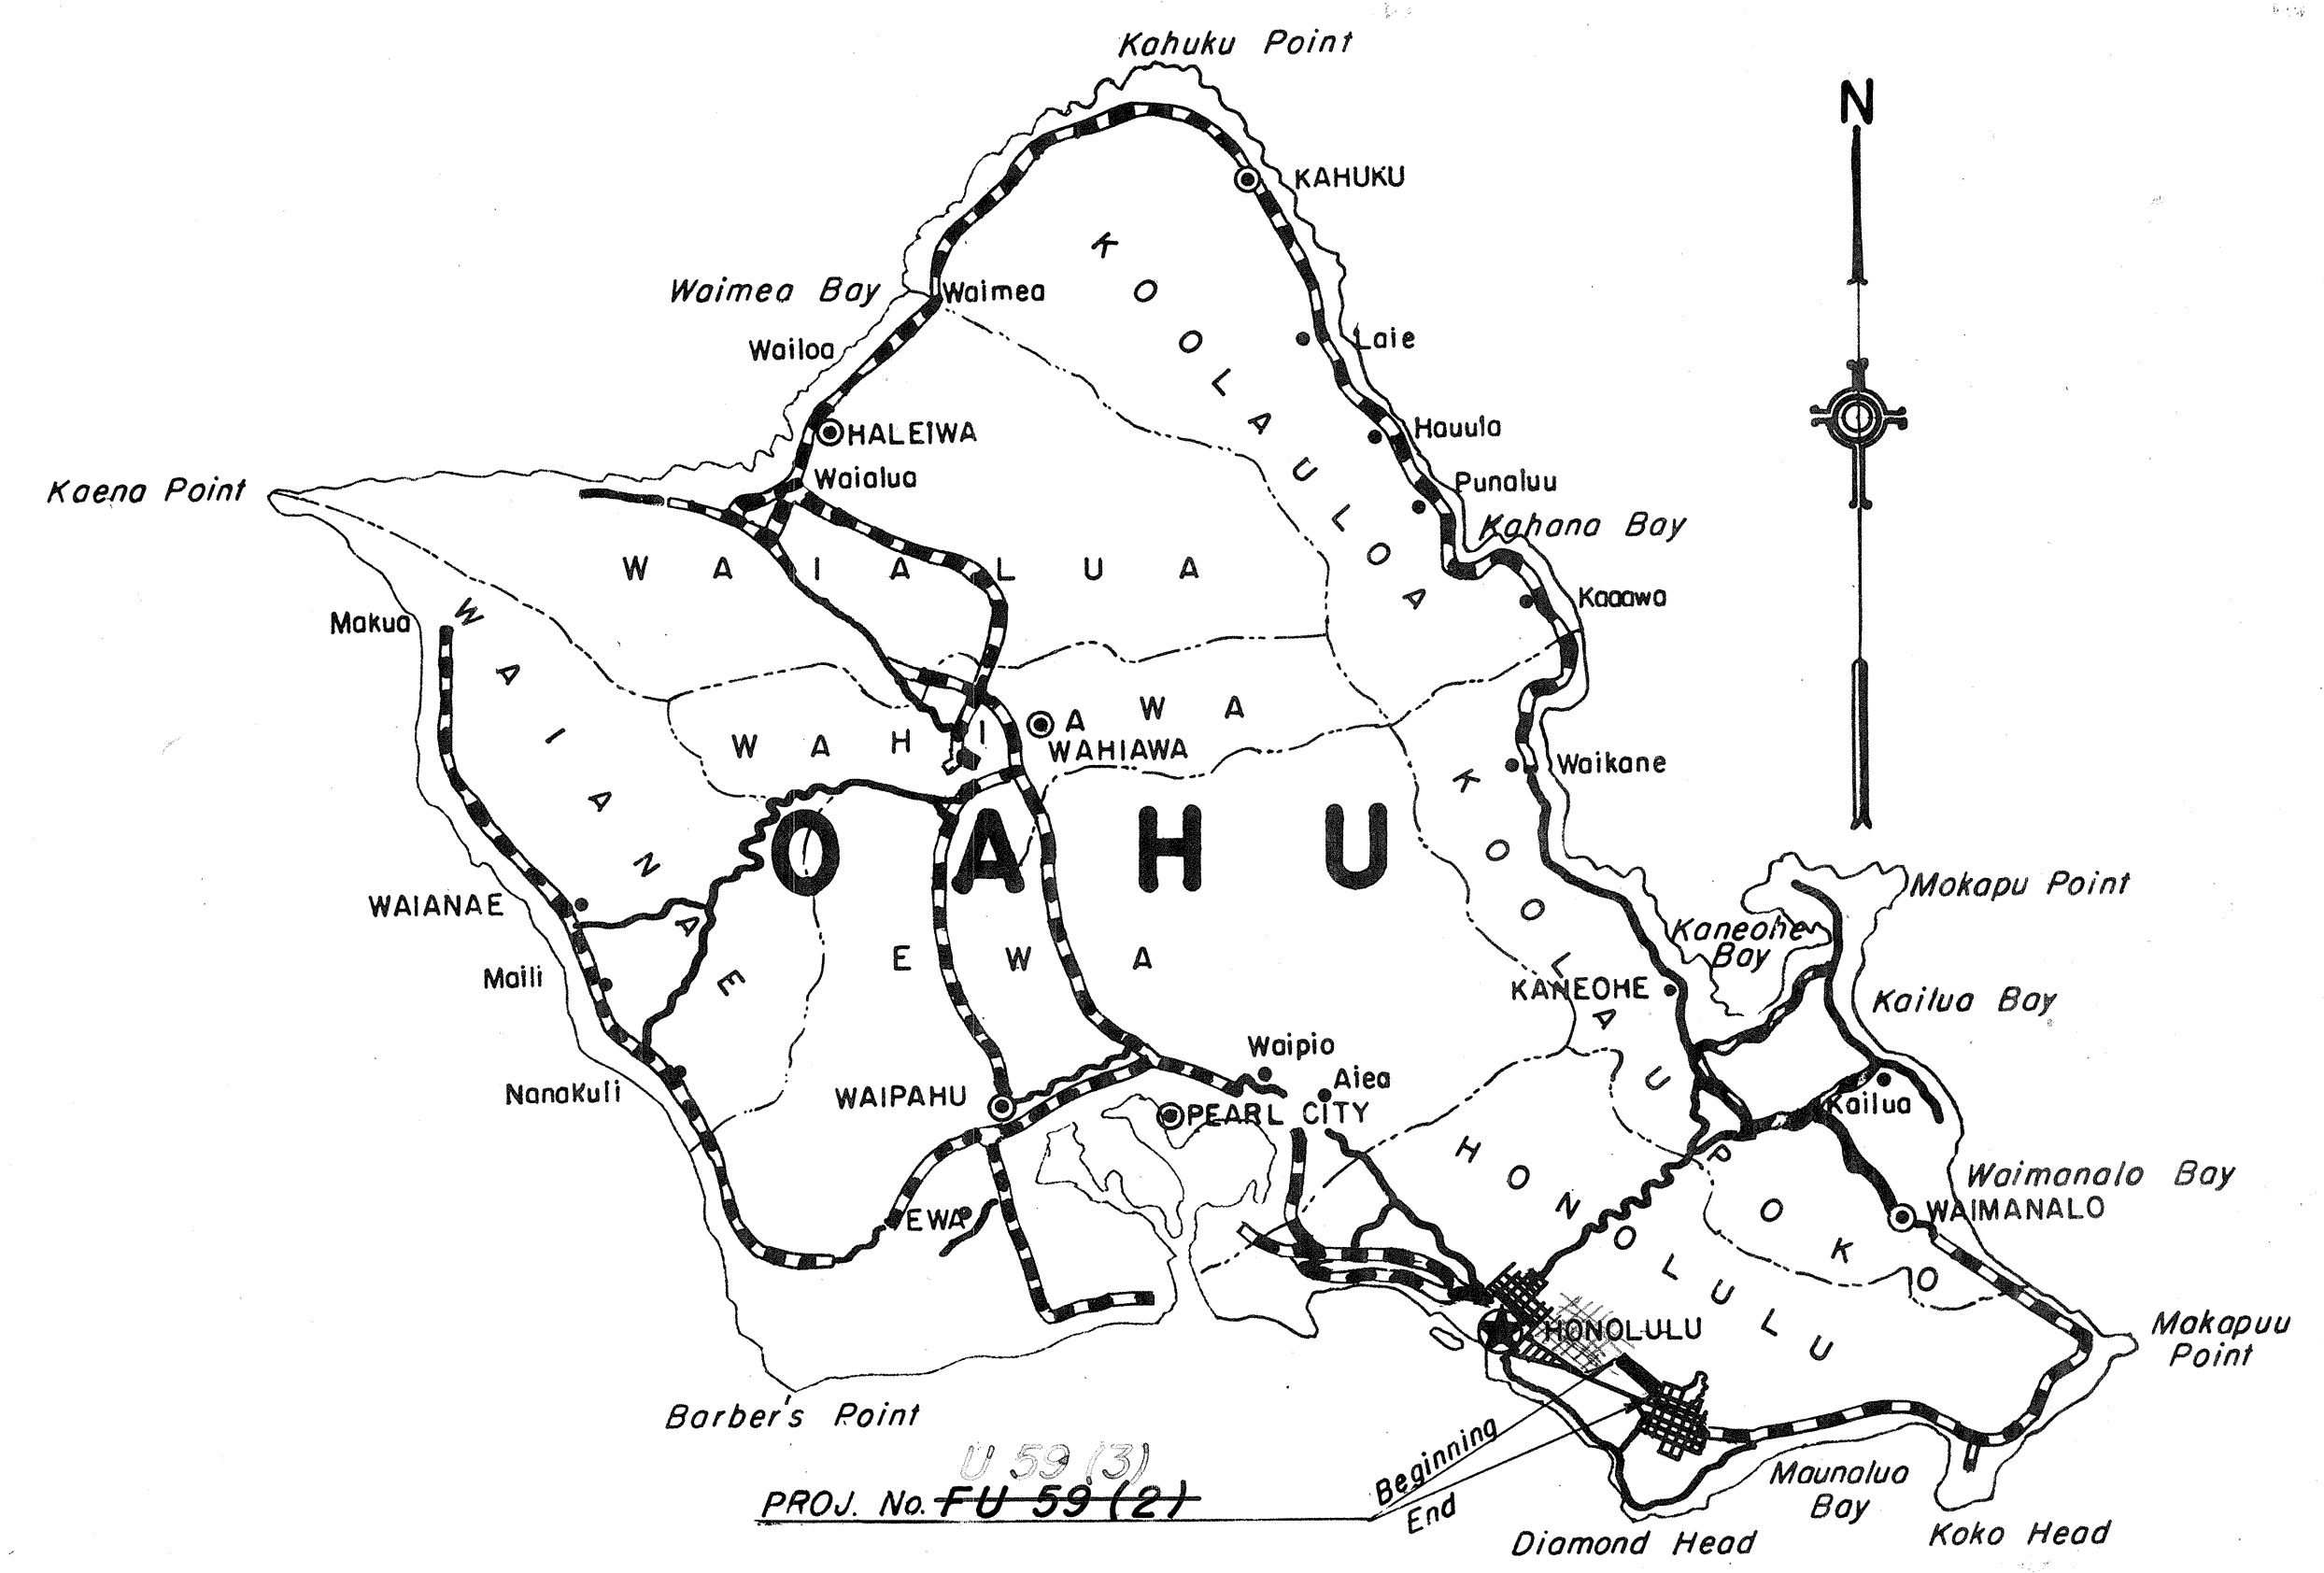

GROSS LENGTH OF PROJECT --- 0.592 MI.
BRIDGES OVER 20 FEET --- 0.031 MI.
NET LENGTH ROADWAY --- 0.561 MI.

LOCATION MAP
SCALE 1" = 300'

③ DENOTES RAMP NUMBER

Federal Aid Projects Previously Constructed Or Under Construction

INDEX TO DRAWINGS

SHEET	DESCRIPTION
1	Title Sheet
2-3	Typical Sections
4-8	Plan & Profile
9	Intersection Details
10	Drainage System
11-21	Standard Details
22-23	Water System
24-28	Street Lighting System
29	Sub-Station Structural Detail
30-32	Landscape Plan
33-35	Sprinkler System
36-38	Traffic Signs
39	Detour at University Avenue
40-41	Retaining Wall
42	Storm Drain Details
43	Boring Data For Drain Well
44	Rehabilitation of Improvement
45	Standard Bridge Details
46-65	University Avenue Separation
66-70	Kalo Lane Separation
71-74	Old Waialae Road Separation
75-90	Cross Sections

NOTE:
ALL CHANGES MADE DURING CONSTRUCTION
HAVE BEEN NOTED IN RED IN THESE TRACINGS
AND CHECKED BY:

John B. K. Sur
PROJECT ENGINEER
DATE 4-17-54

APPROVED DATE 3/10/52
[Signature]
TERRITORIAL HIGHWAY ENGINEER

DEPARTMENT OF COMMERCE
BUREAU OF PUBLIC ROADS
RECOMMENDED FOR APPROVAL
DISTRICT ENGINEER DATE
APPROVED
DIVISION ENGINEER DATE