



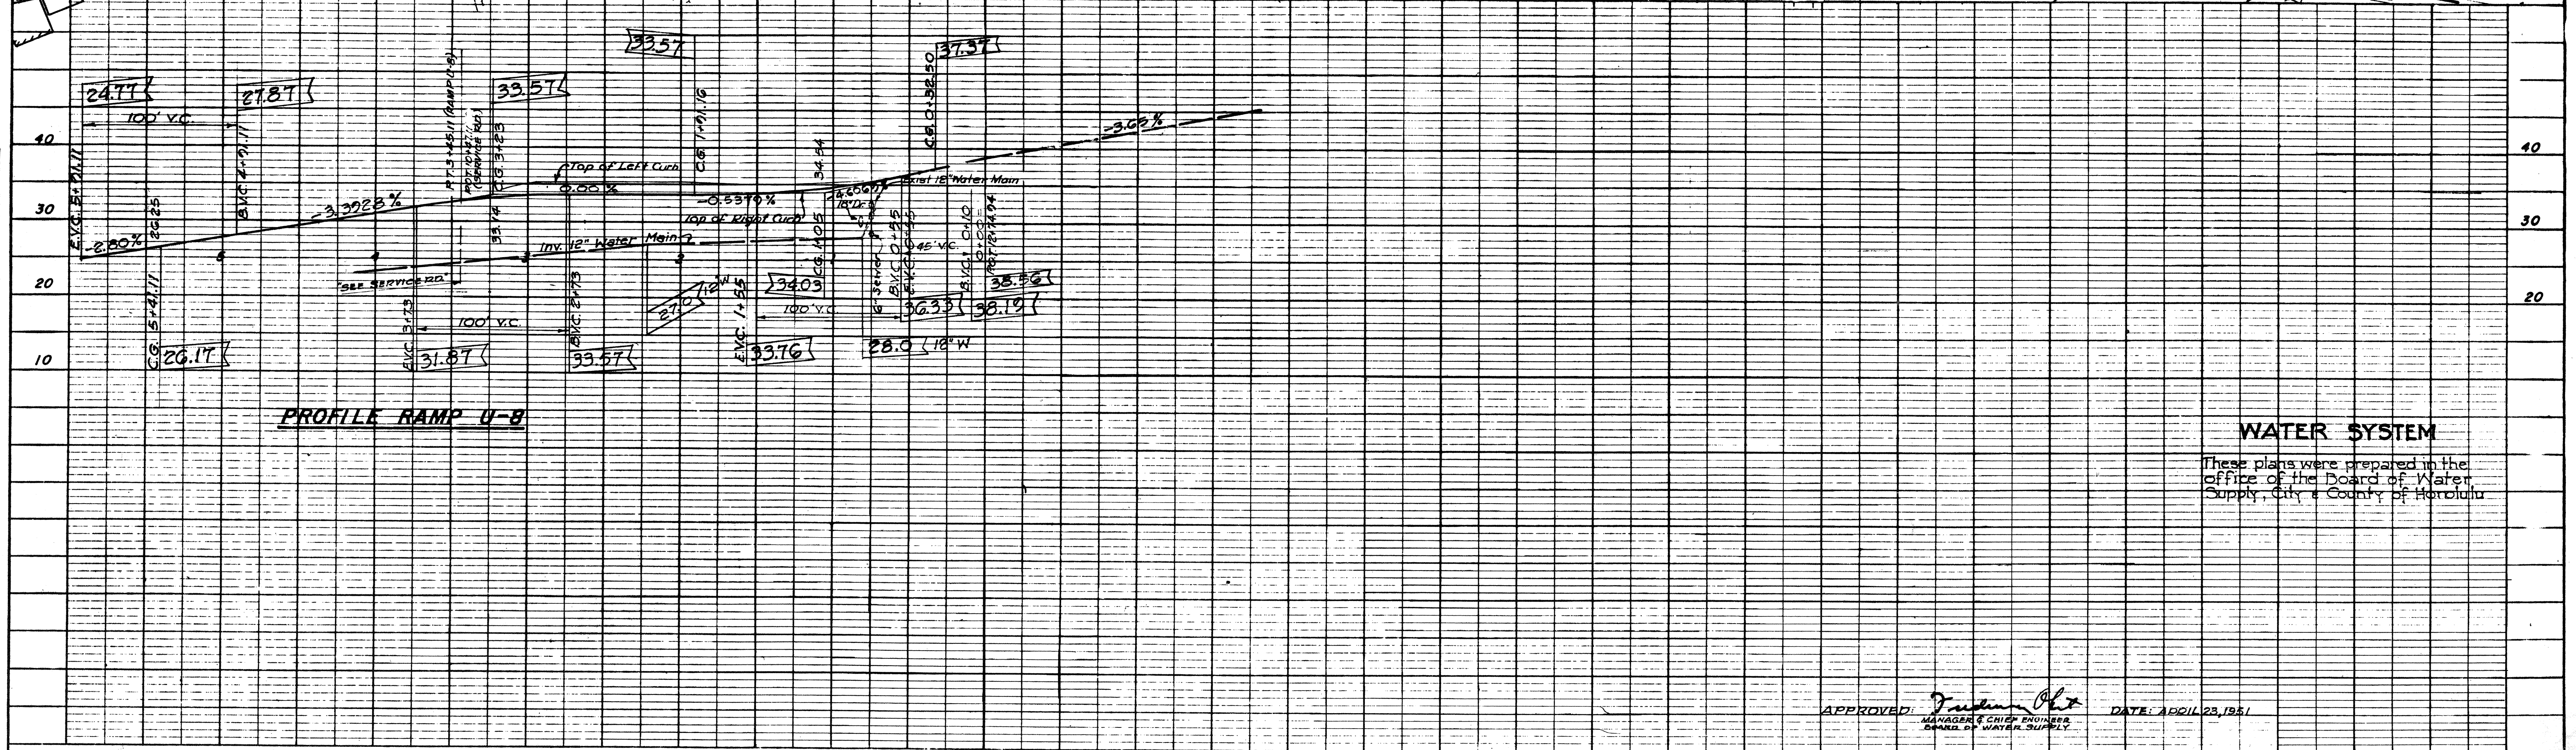

Ramp U-3 Revised - 7-2-52.

PLAN	SURVEYED	DATE
	BY	
	PLOTTED	
	NOTE BOOK	
	ALIGNMENT CHECKED	
	RT. OF WAY CHECKED	
	NO.	

PROFILE	SURVEYED	DATE
	BY	
	PLOTTED	
	NOTE BOOK	
	ALIGNMENT CHECKED	
	STRUCTURE NOTATION CHECKED	
	NO.	

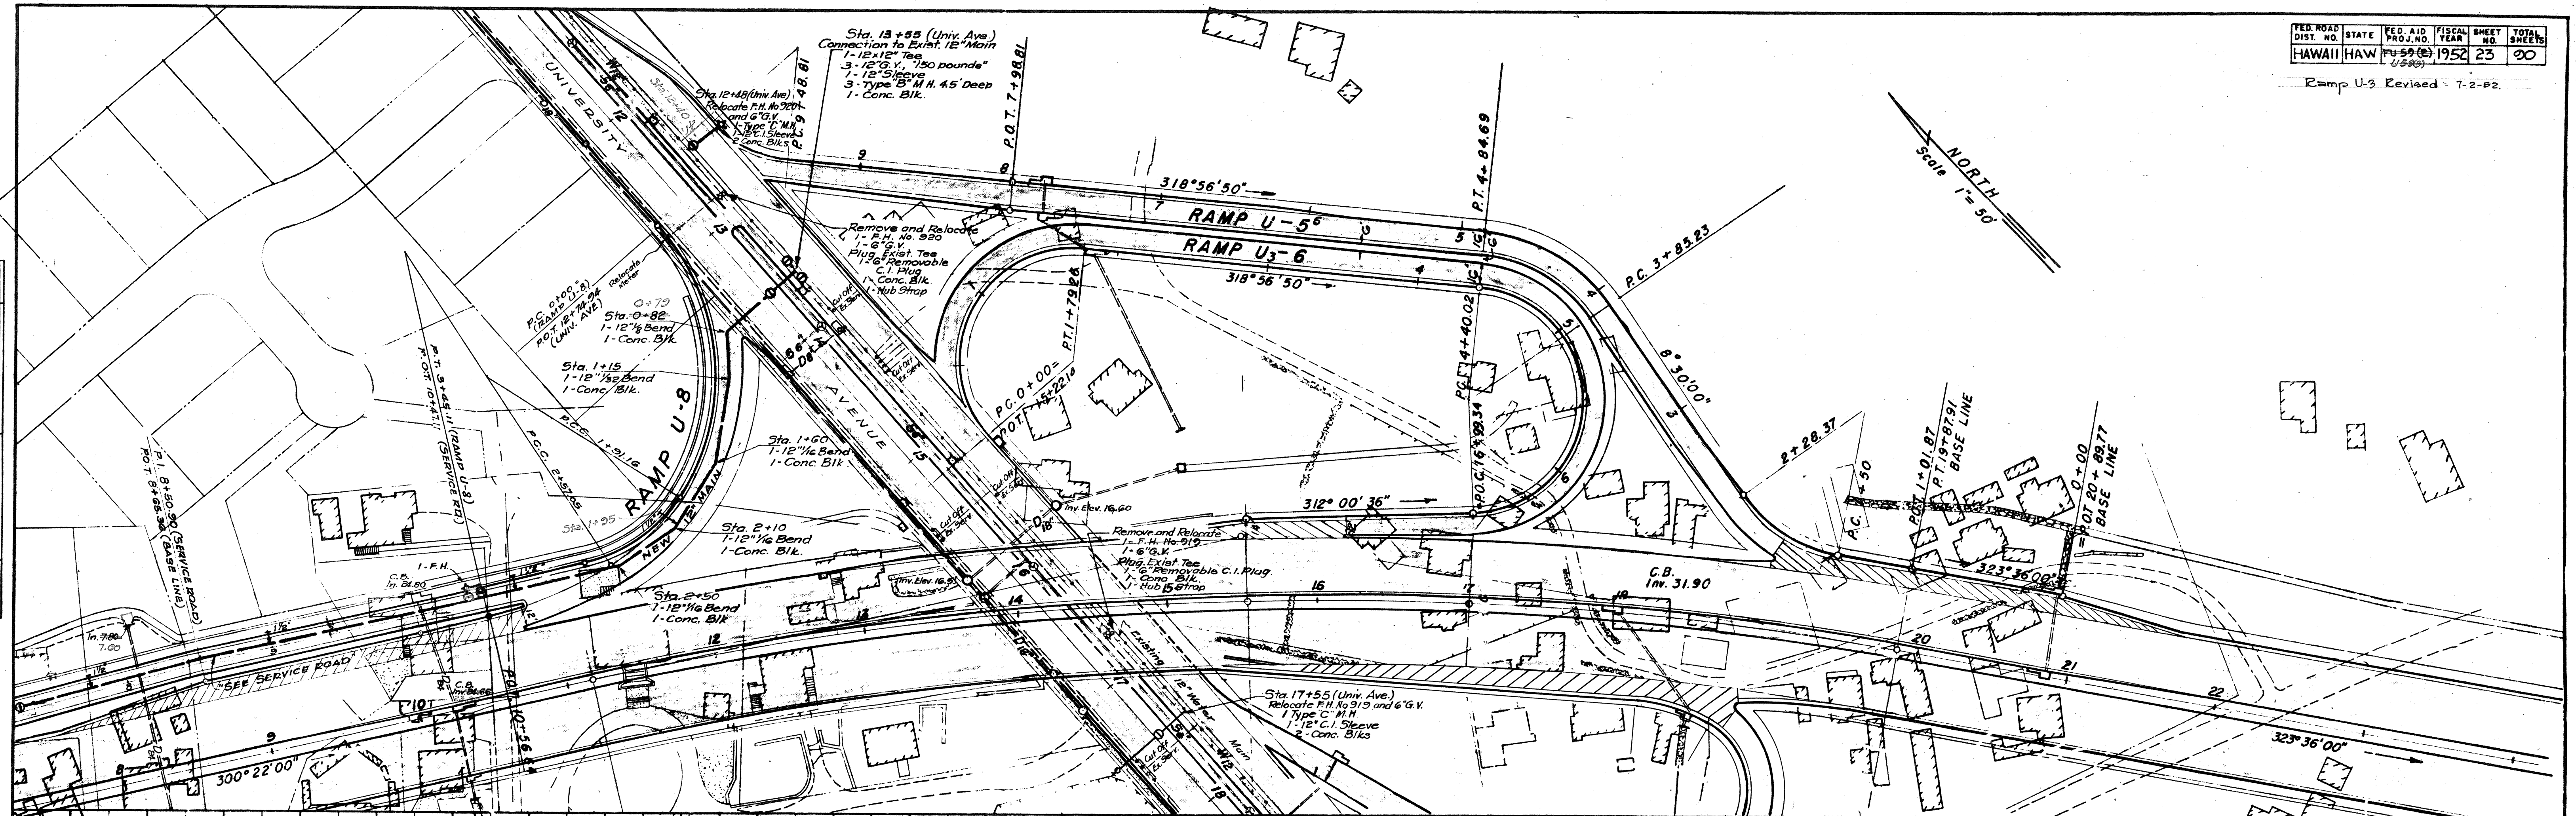

WATER SYSTEM

These plans were prepared in the office of the Board of Water Supply, City & County of Honolulu.

APPROVED: *[Signature]*
MANAGER & CHIEF ENGINEER
BOARD OF WATER SUPPLY

DATE: APRIL 23, 1951