




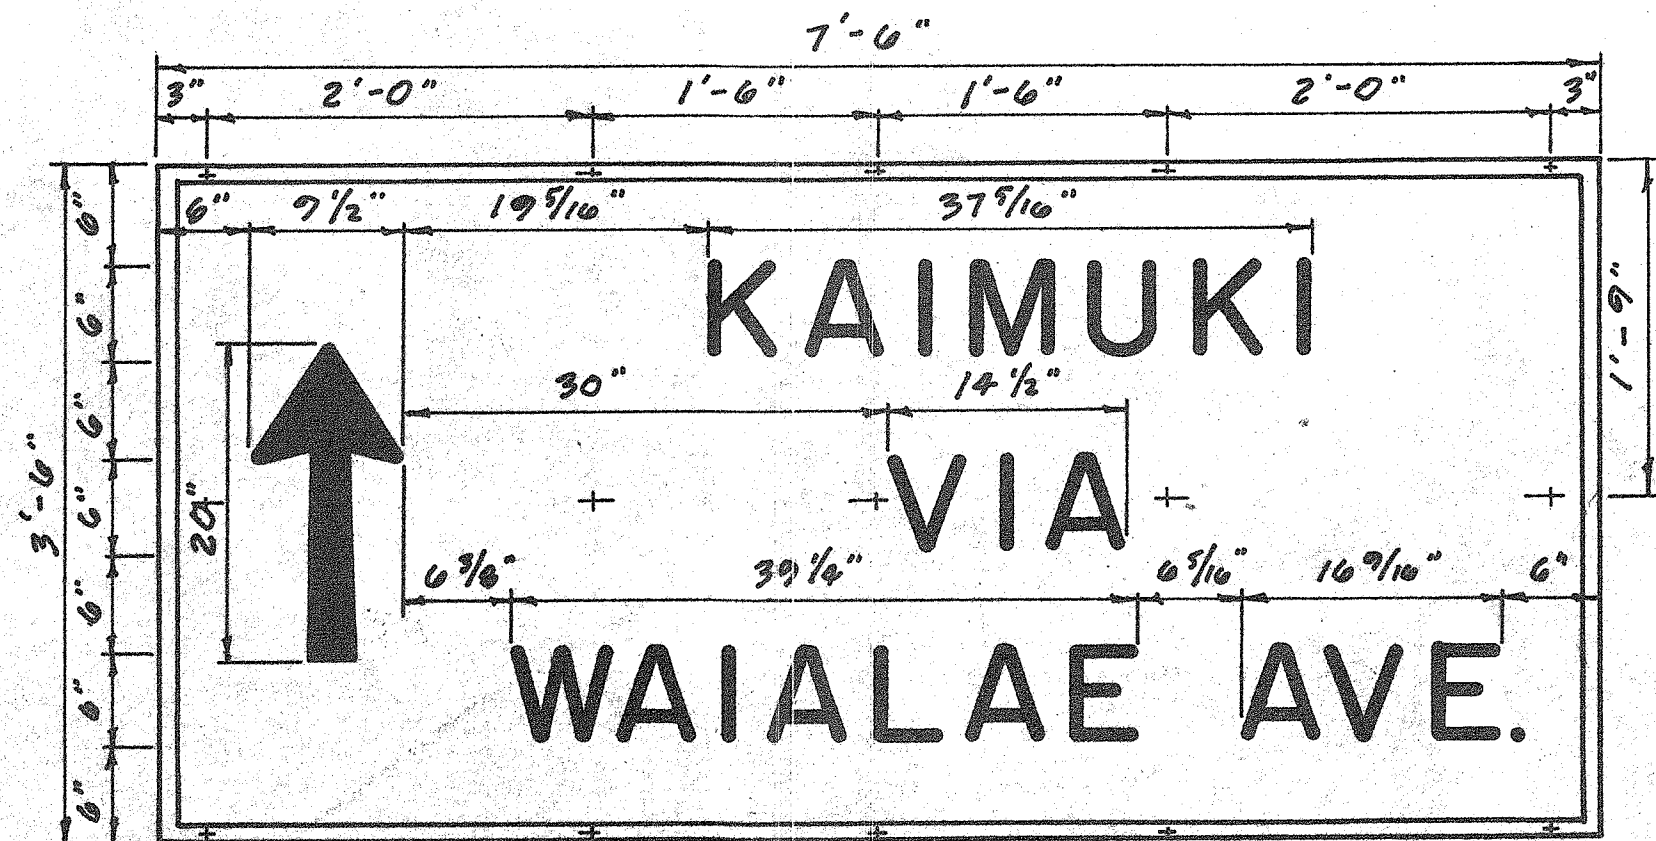


D-1

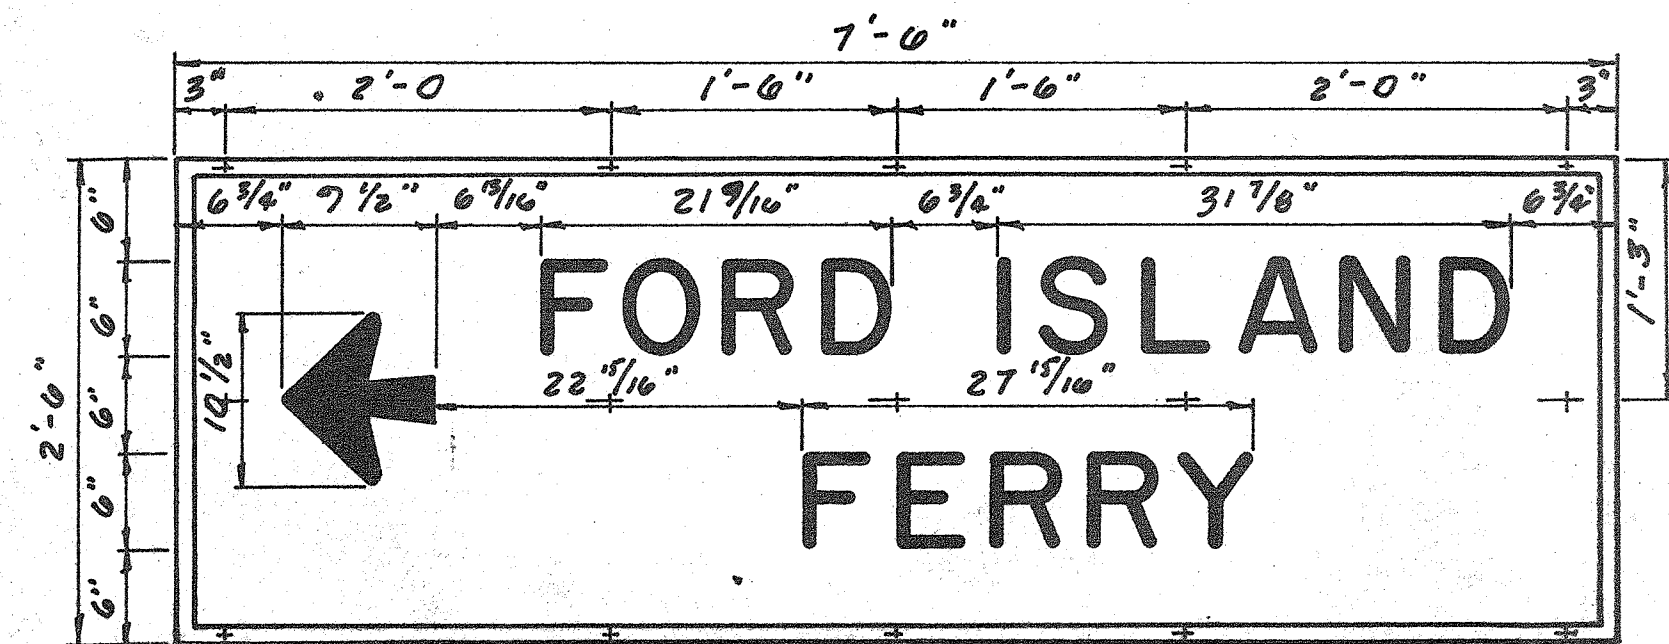


D-2

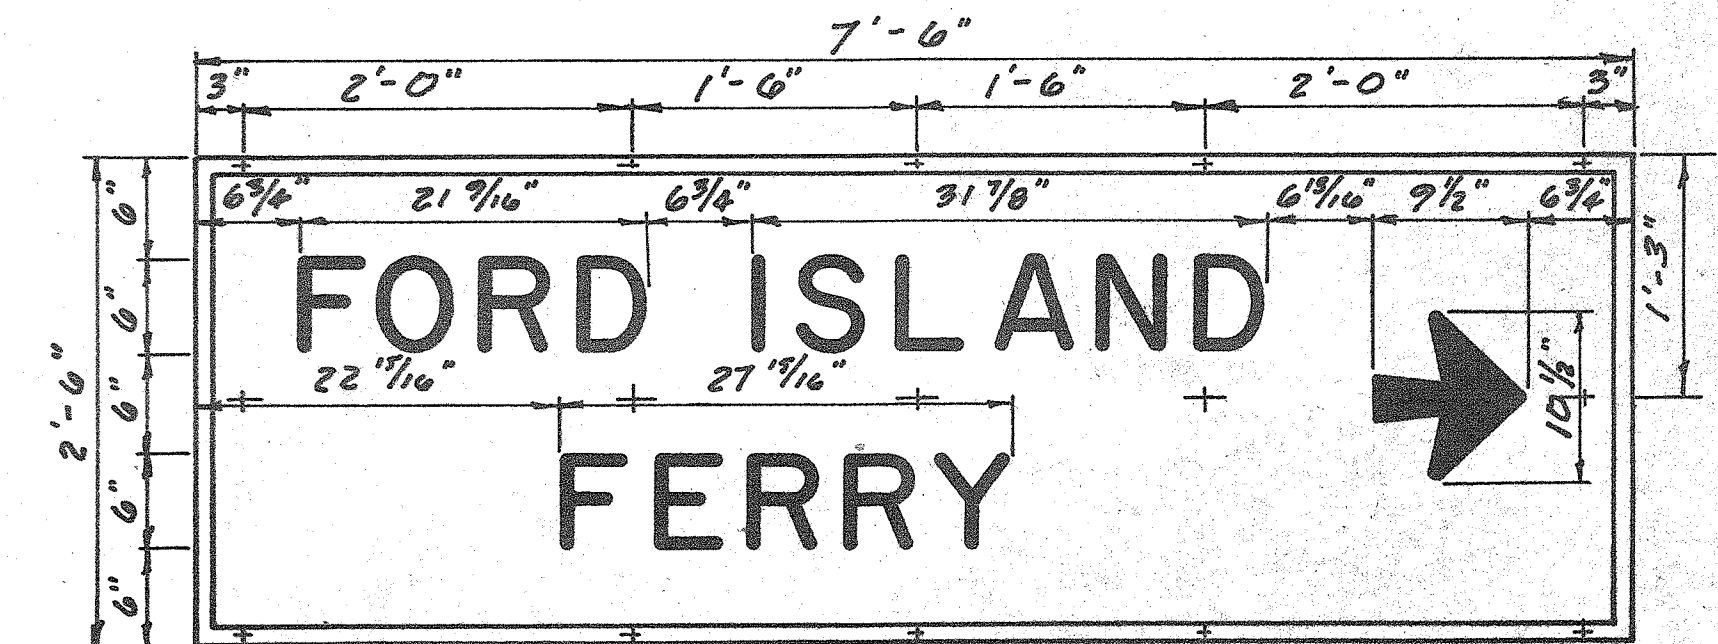


D-3

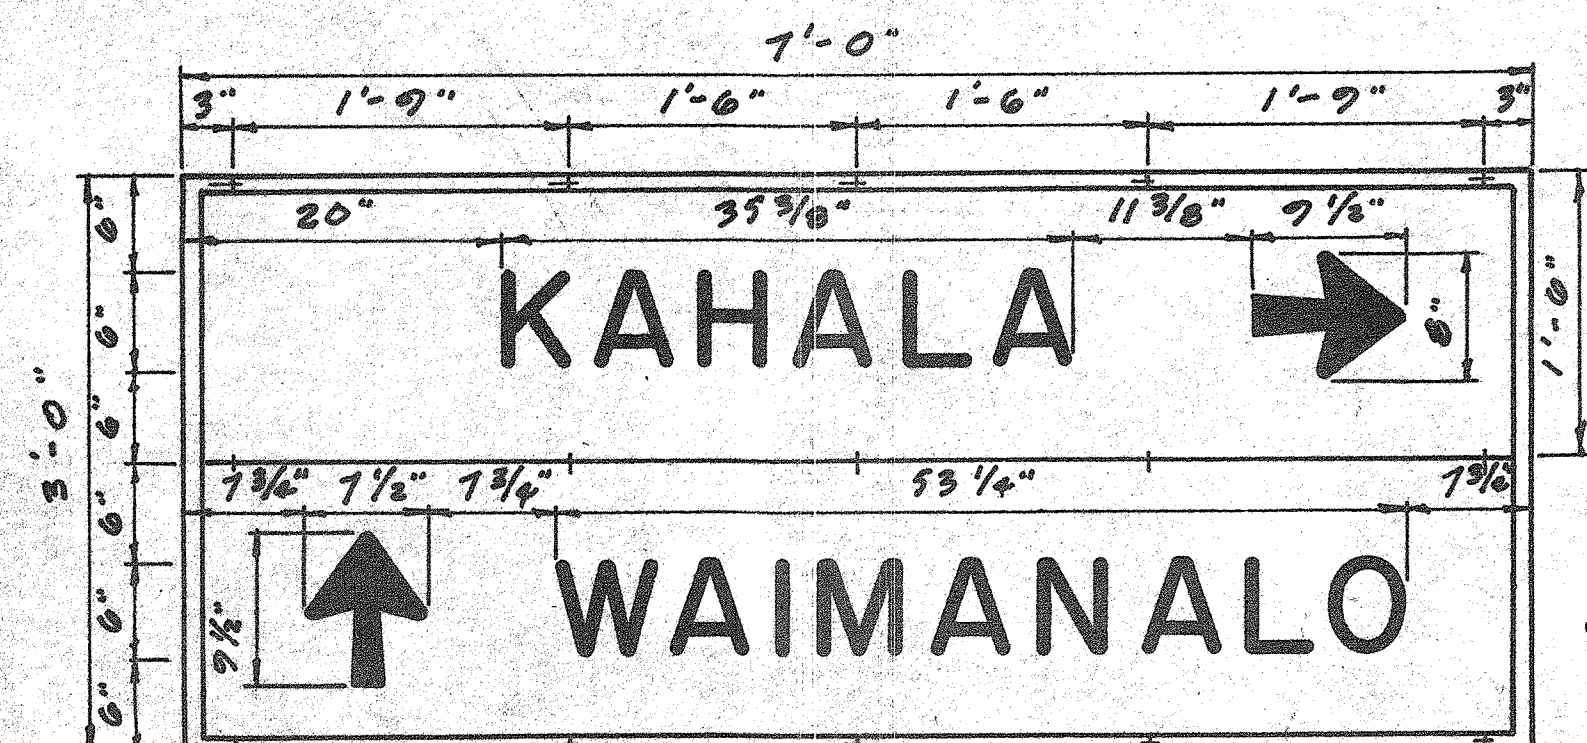


D-4

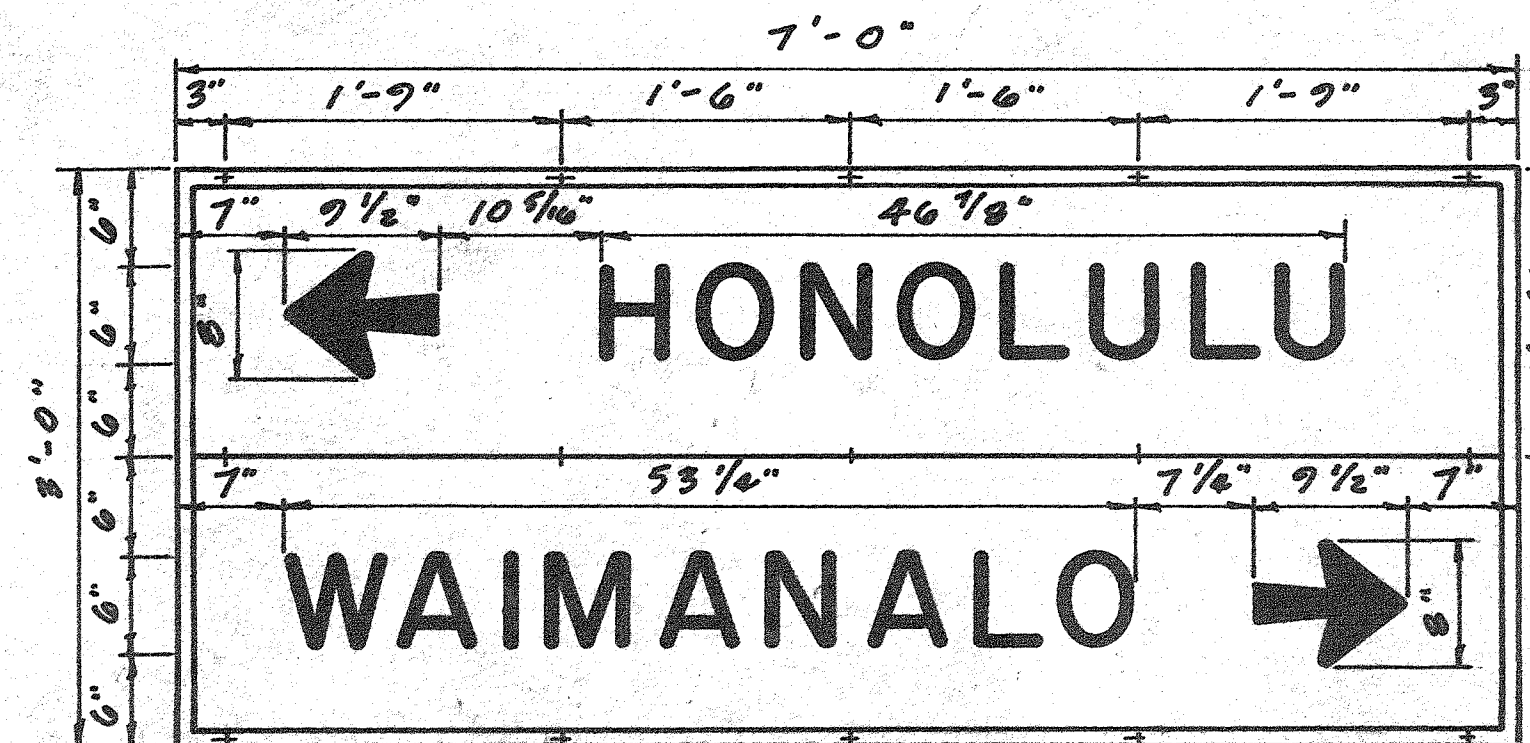


D-5

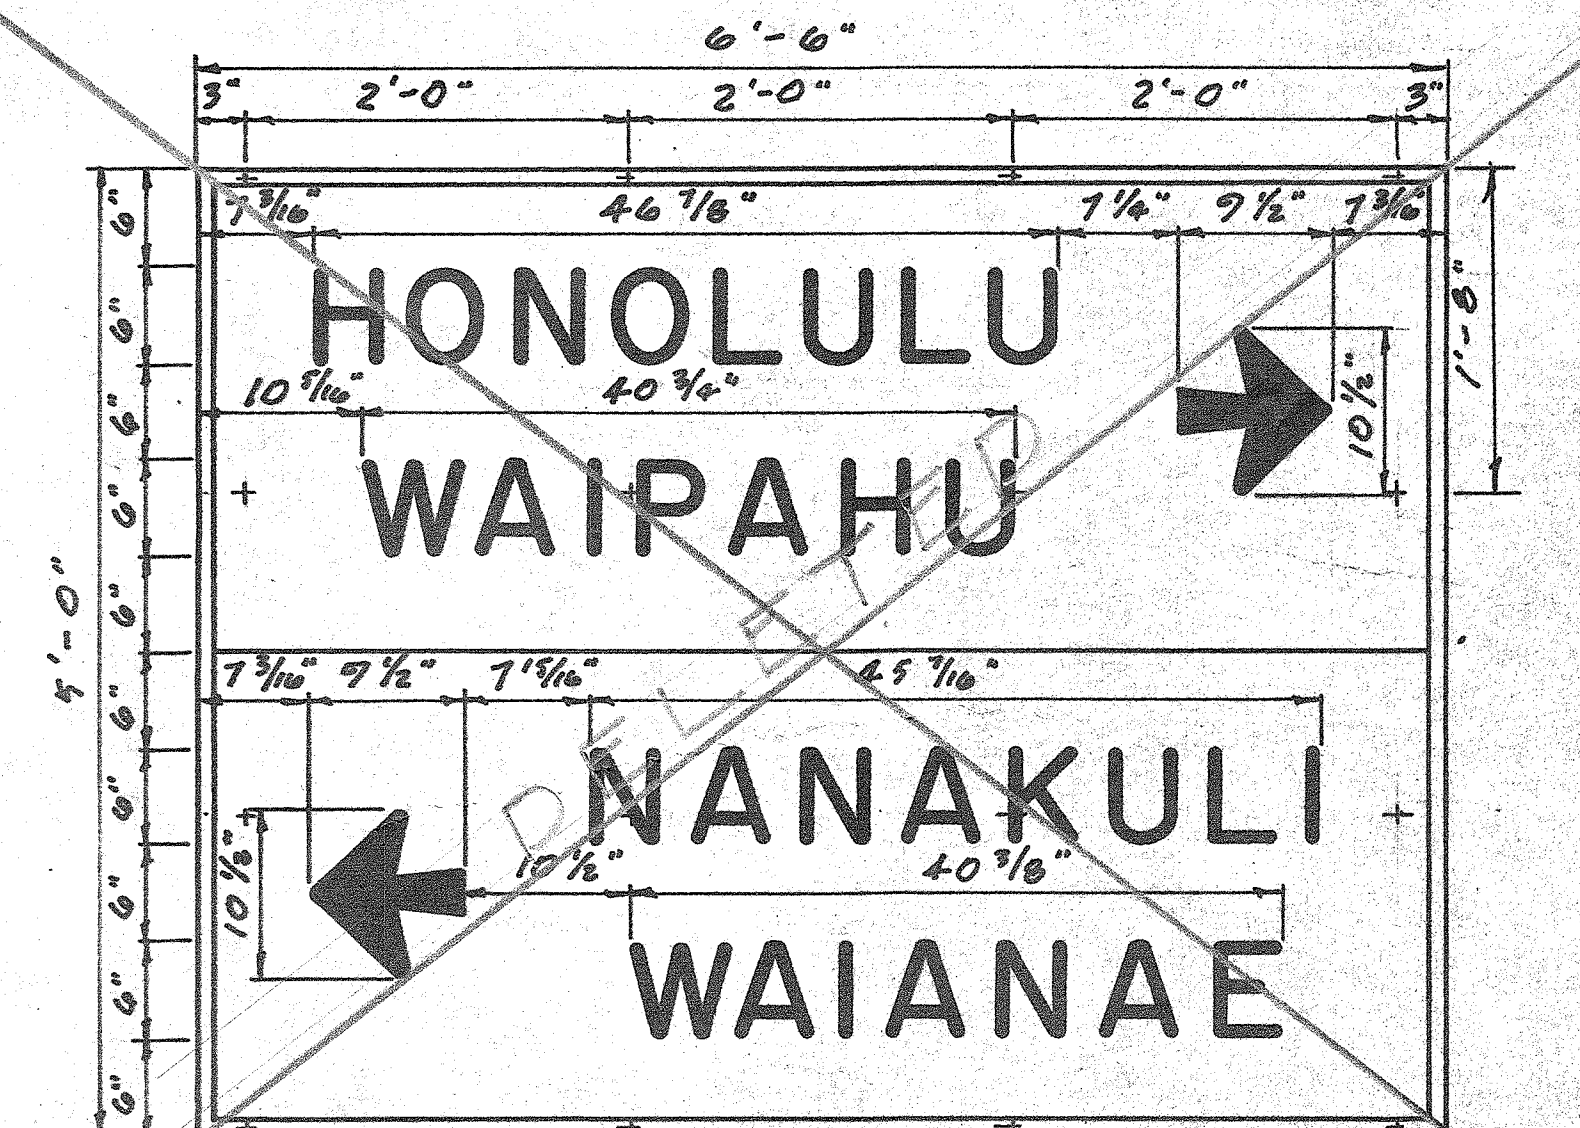


D-6

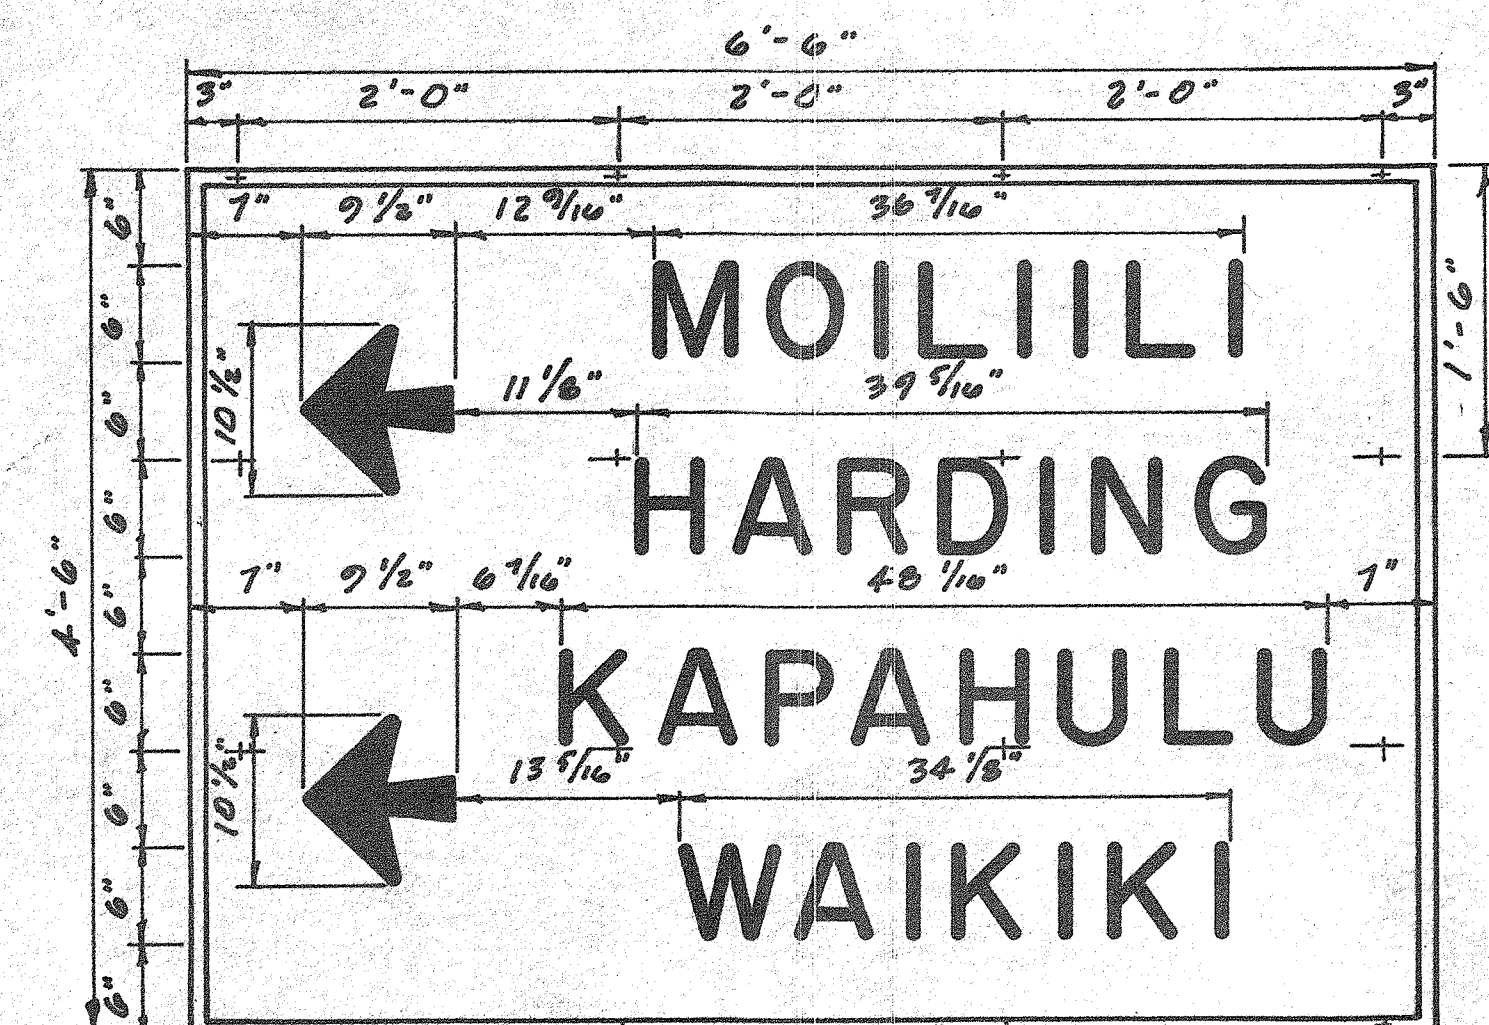

D-7

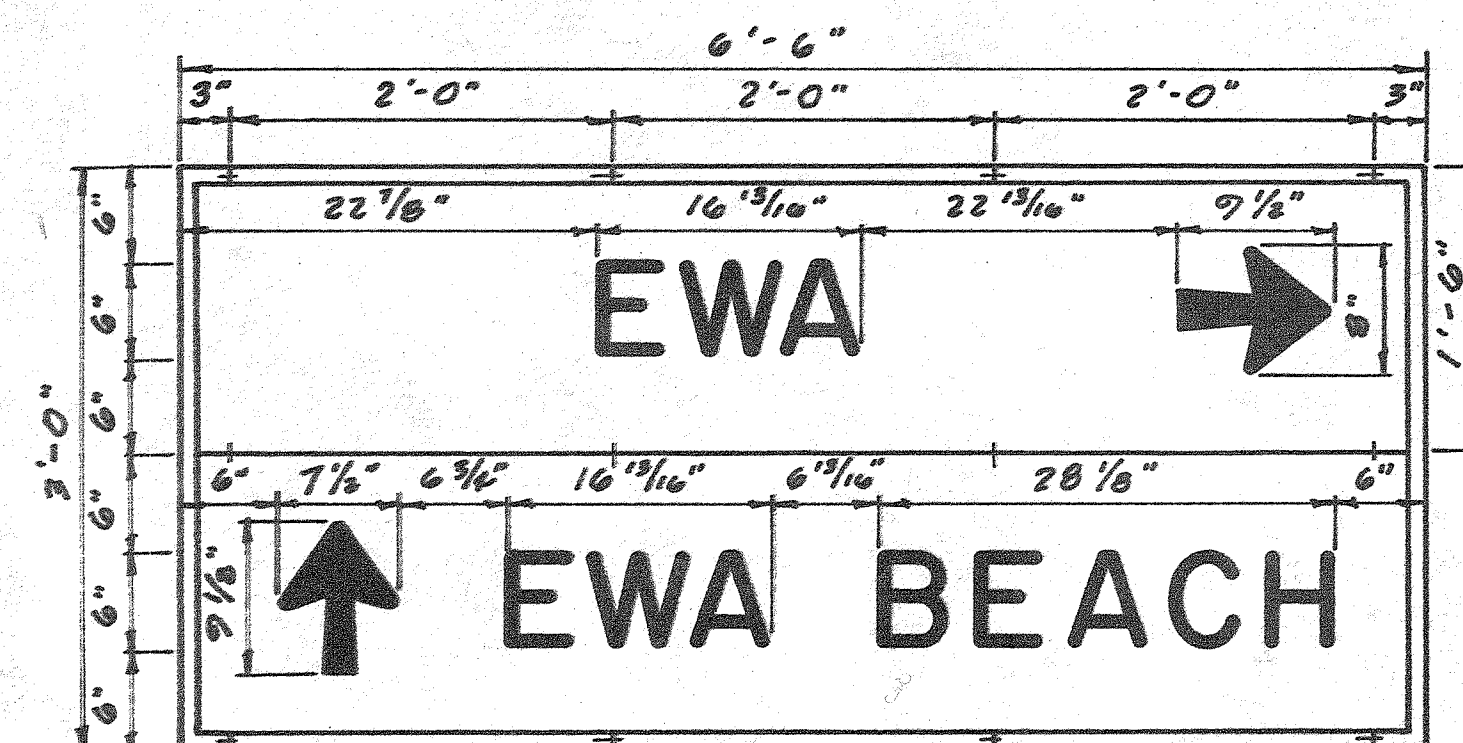

D-8

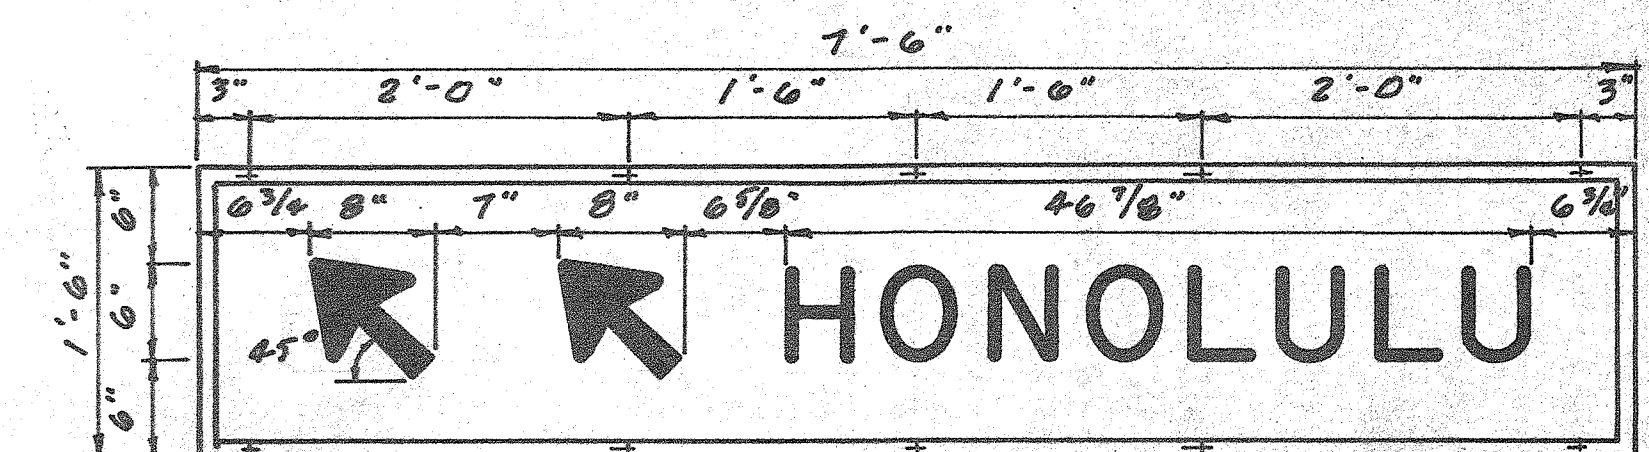


D-9

SURVEY PLOTTED BY	DATE
DRAWN BY	2/76
TRACED BY	
QUANTITIES CHECKED BY	
NOTE BOOK	
NO.	


STATE OF HAWAII
DEPARTMENT OF TRANSPORTATION
DIVISION OF HIGHWAYS

**DESTINATION SIGNS
ISLAND OF OAHU**


SCALE: 1" = 1'-0"

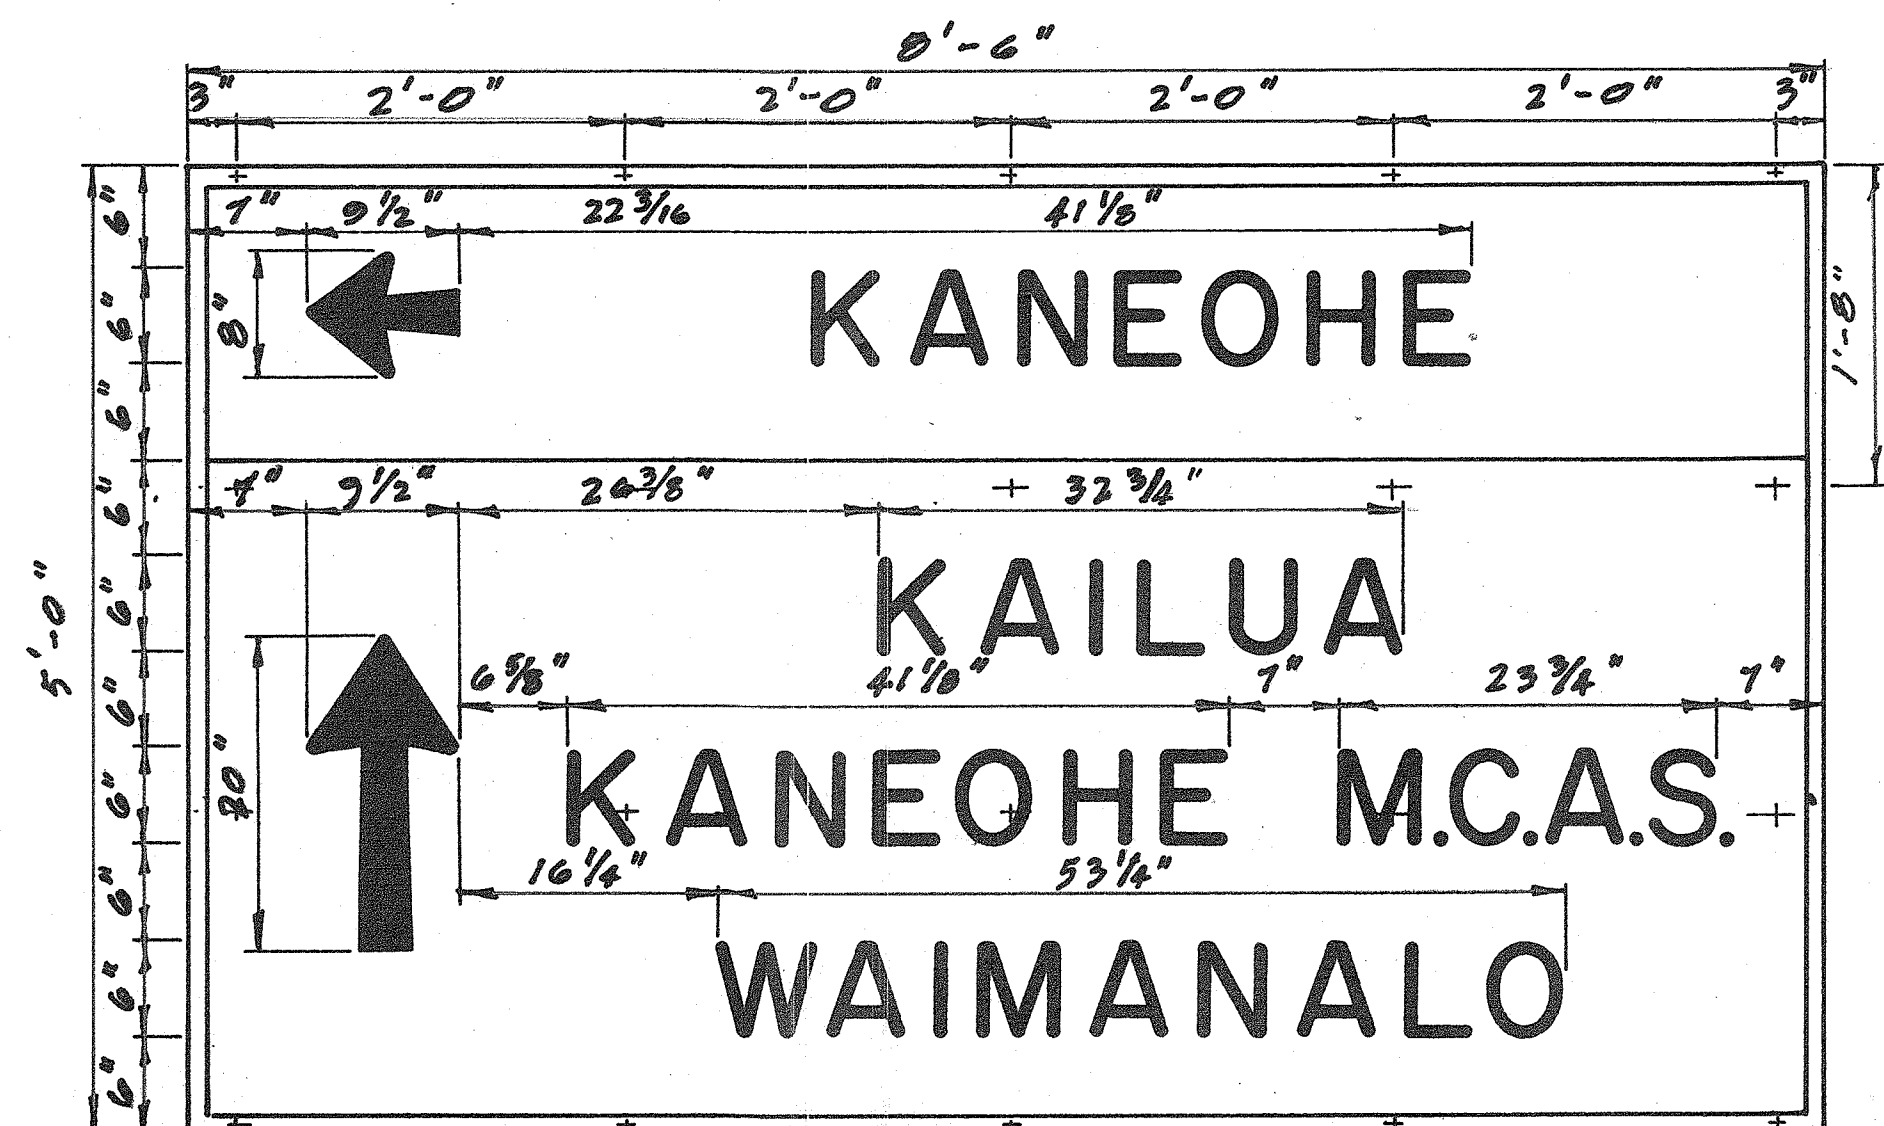


D-10

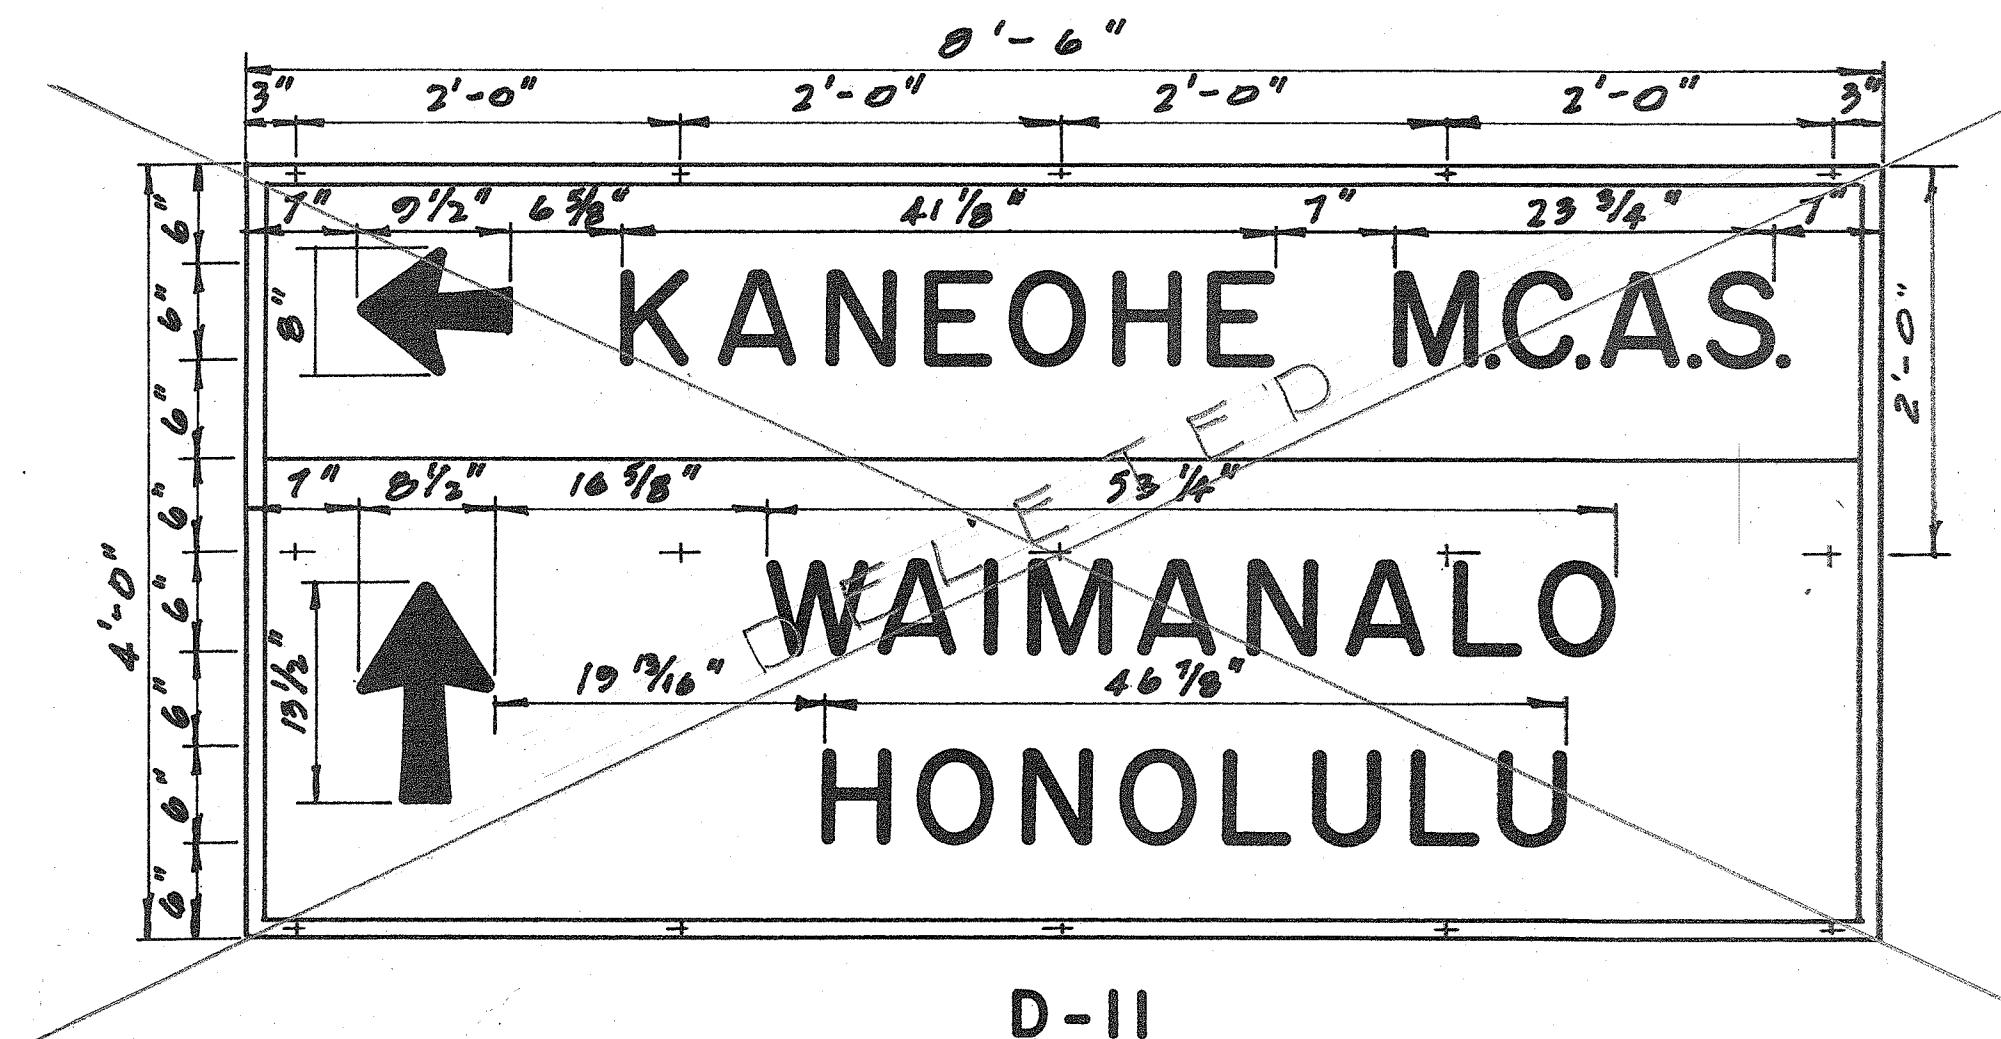

D-11

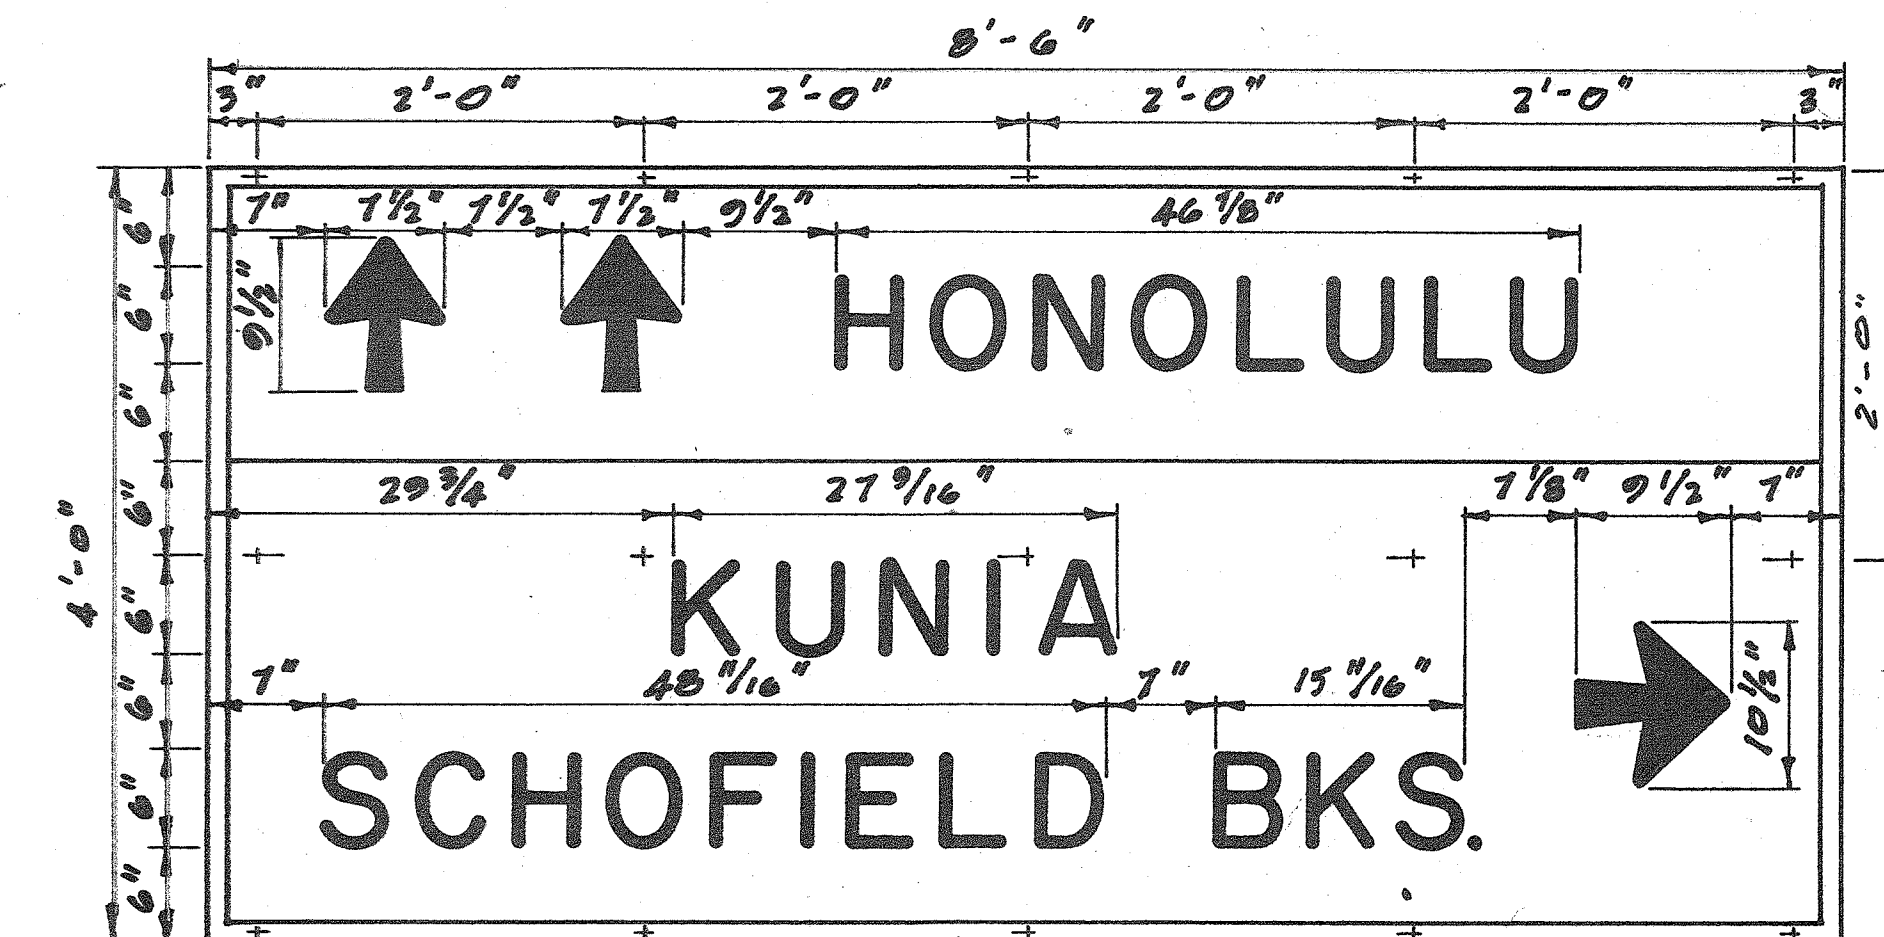


D-12

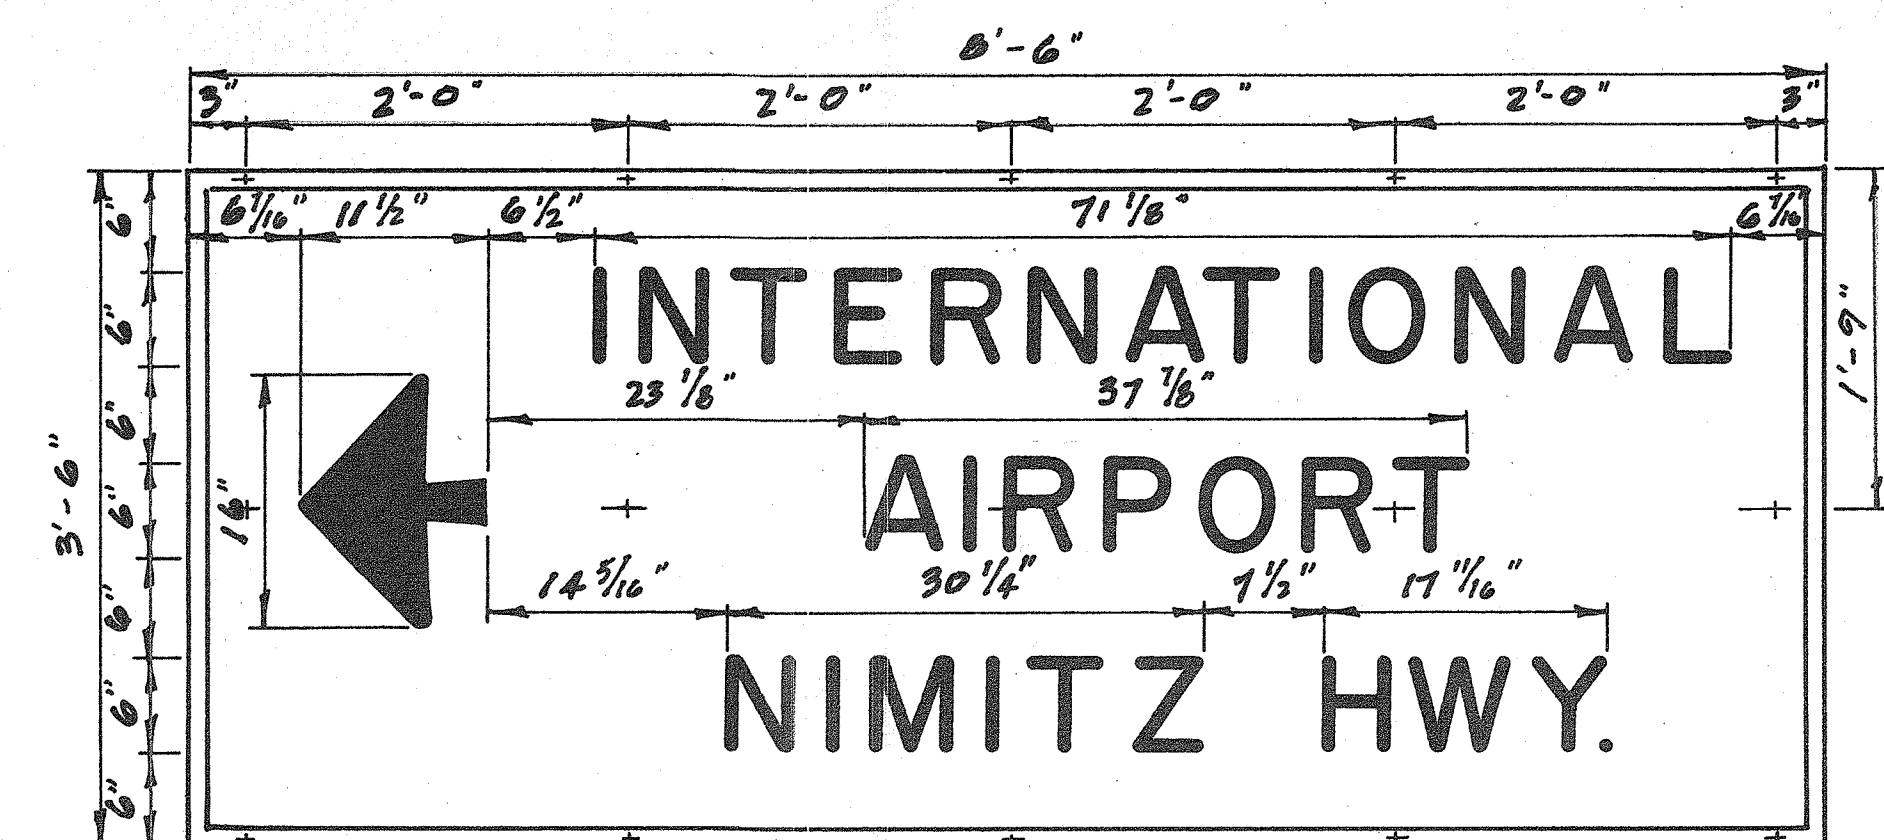


D-13




D-14

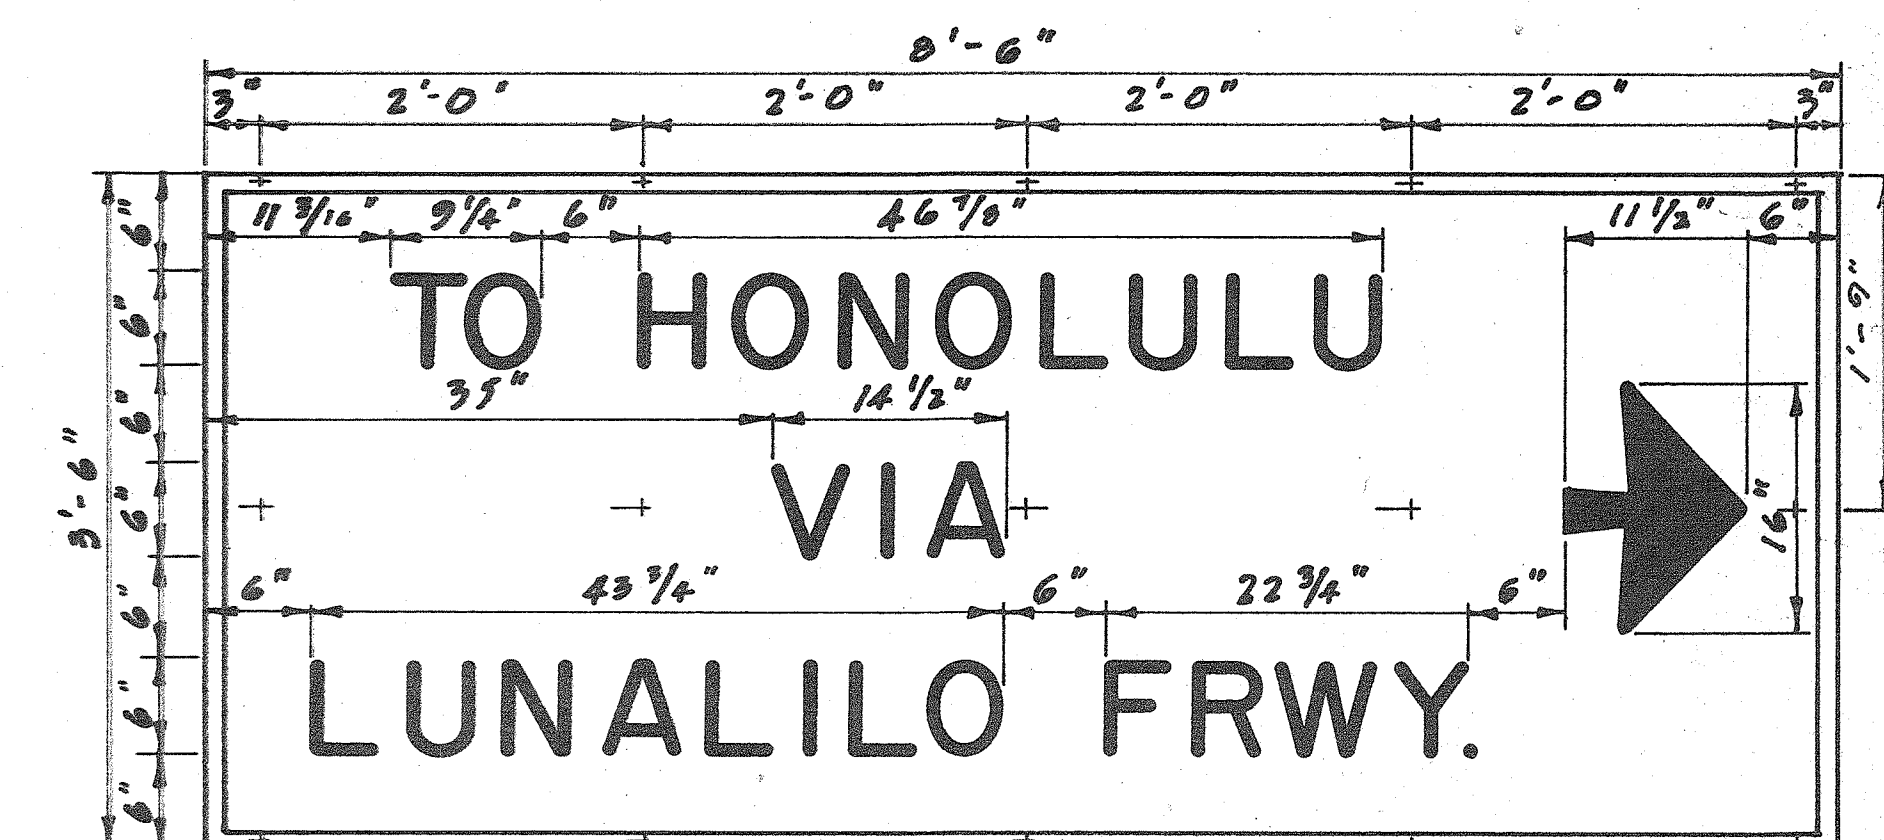


D-15

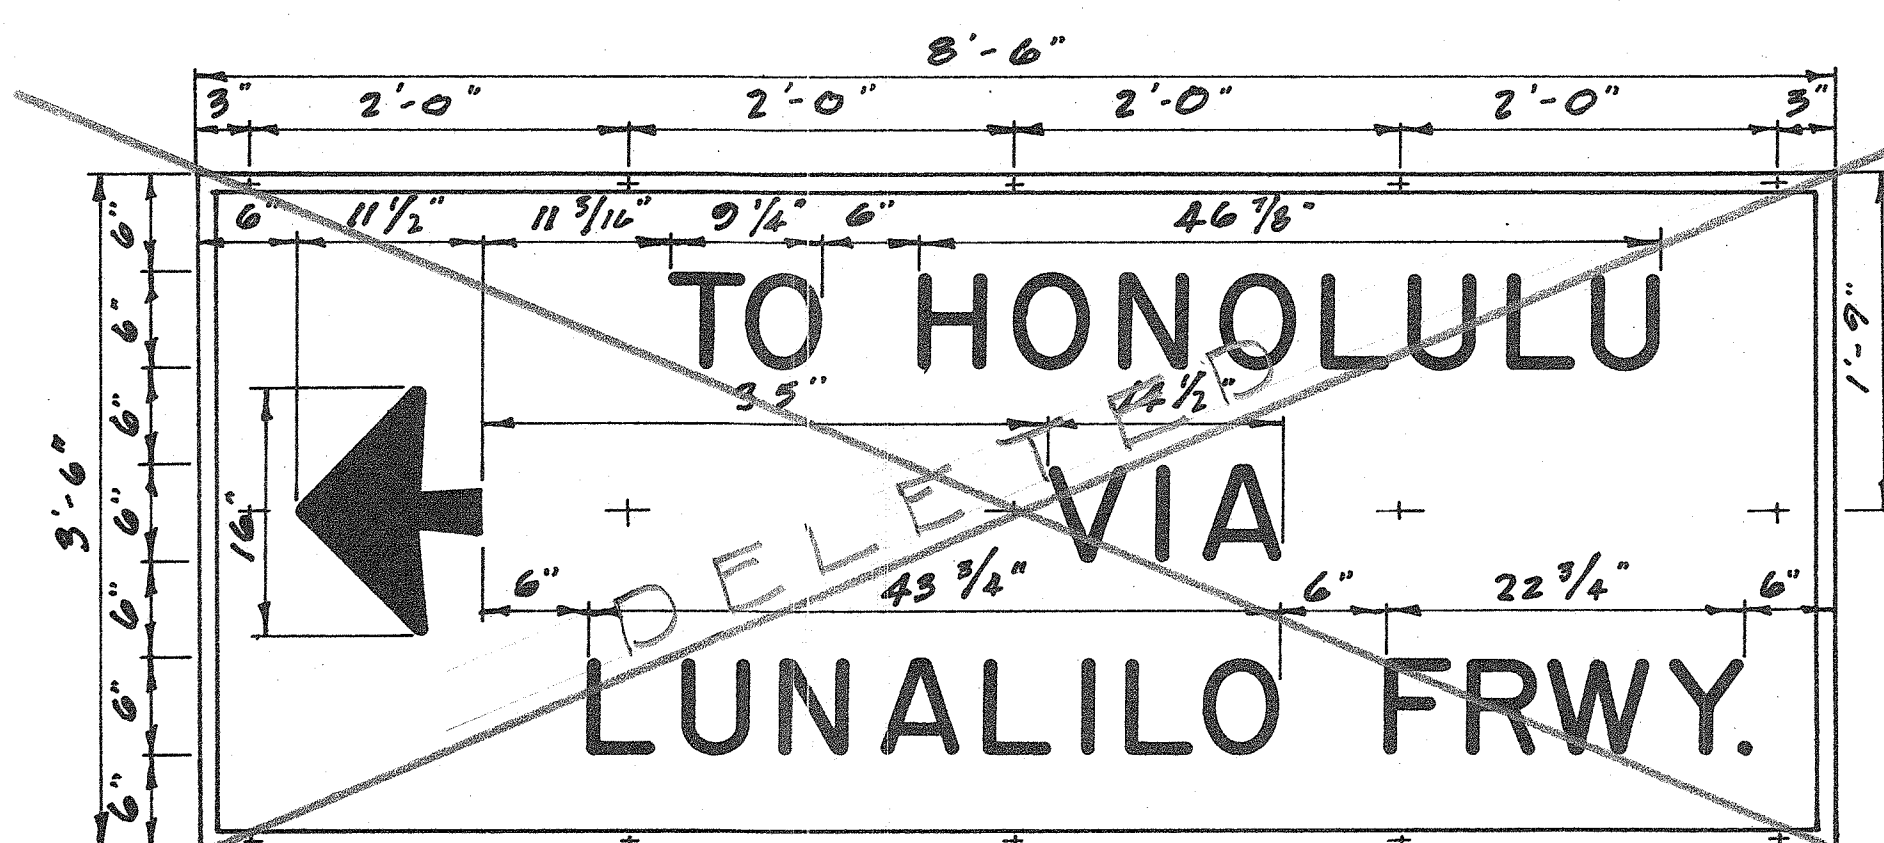

D-16

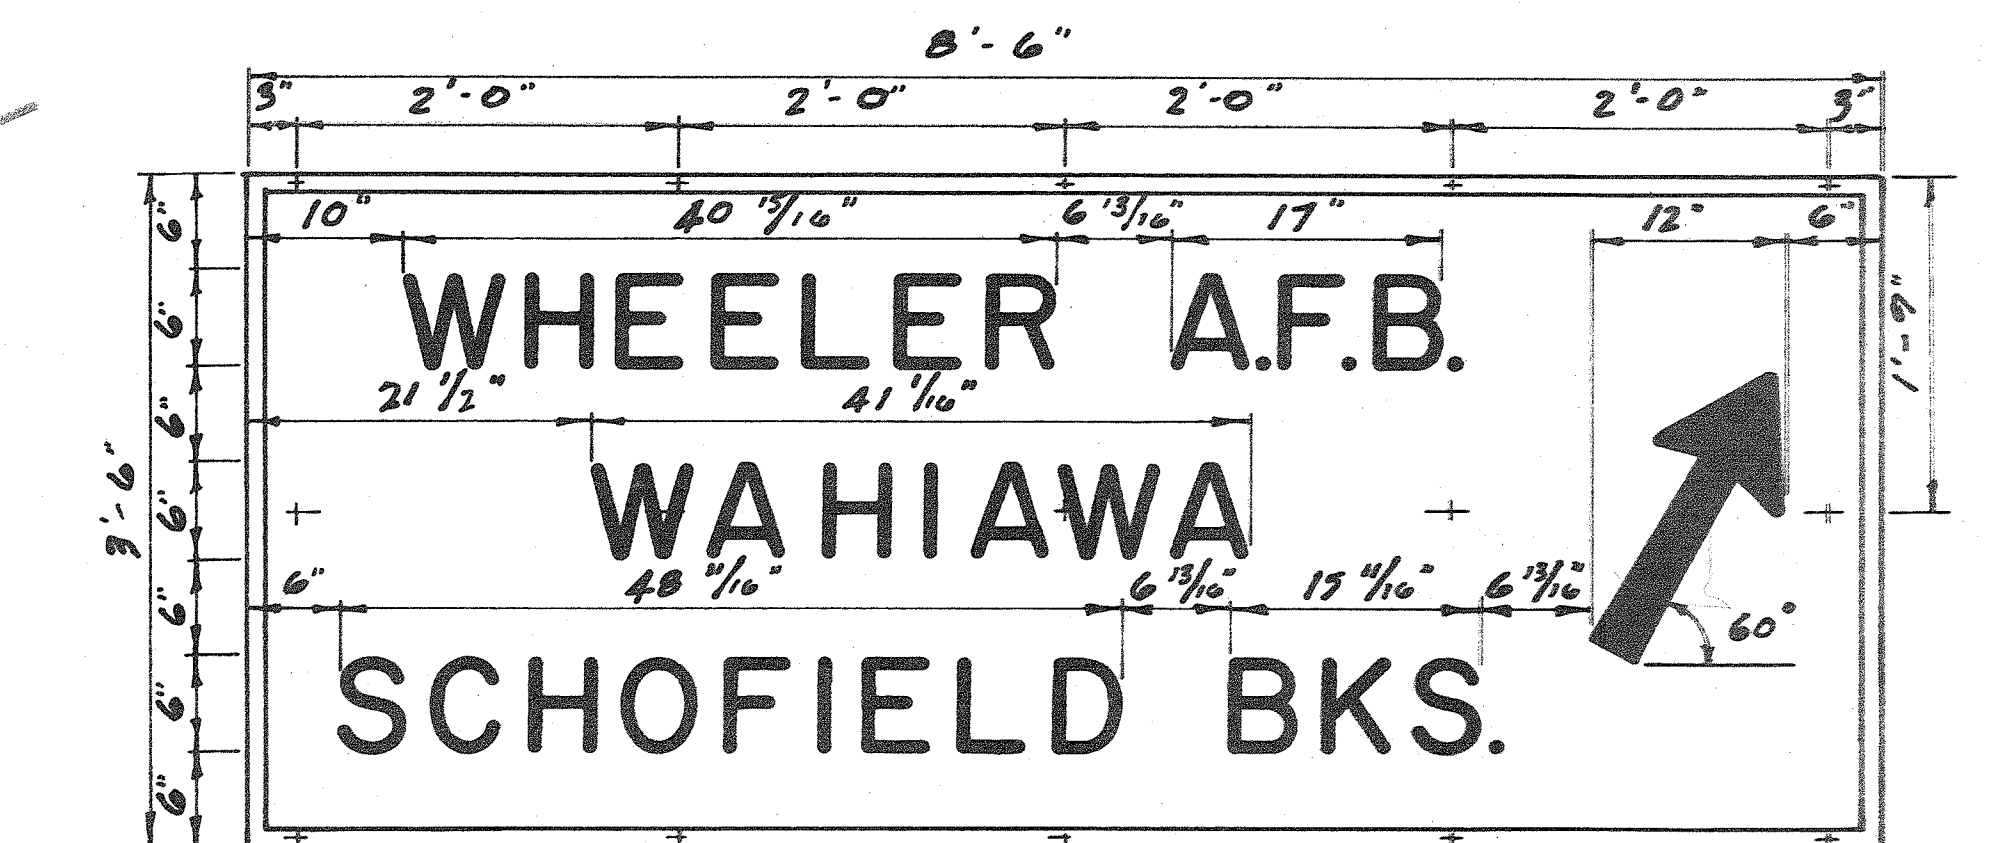

D-17

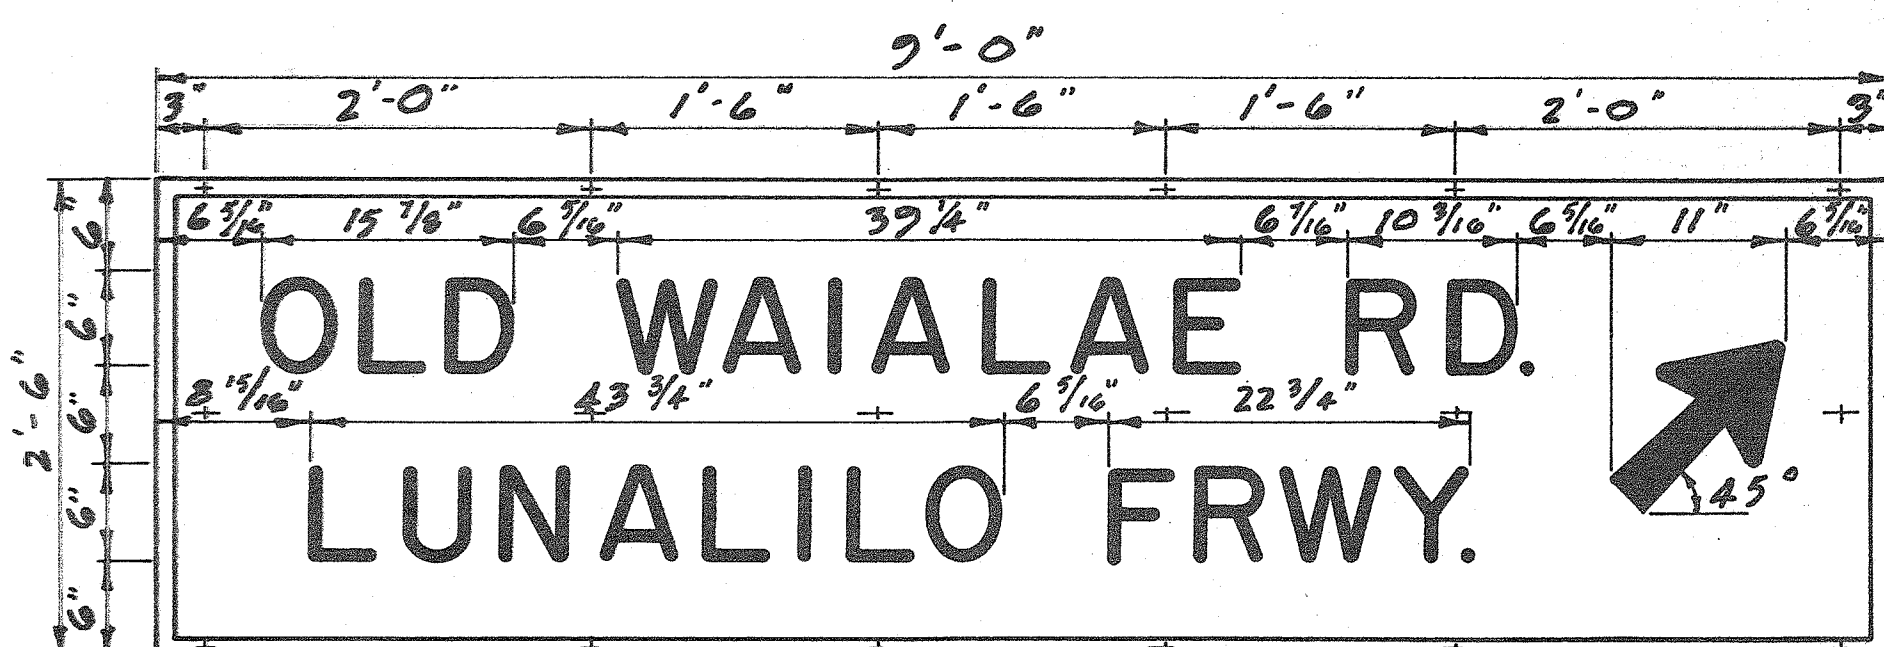


D-18

SURVEY PLOTTED BY: DATE: 3/69
 DESIGNED BY: 3/69
 TRACED BY: 3/69
 QUANTITIES BY: 3/69
 CHECKED BY: 3/69
 ORIGINAL PLAN No.


STATE OF HAWAII
 DEPARTMENT OF TRANSPORTATION
 DIVISION OF HIGHWAYS
DESTINATION SIGNS
ISLAND OF OAHU
 SCALE: 1" = 1'-0"

SHEET No. 5 OF 11 SHEETS


A-0001-08-60 (5)

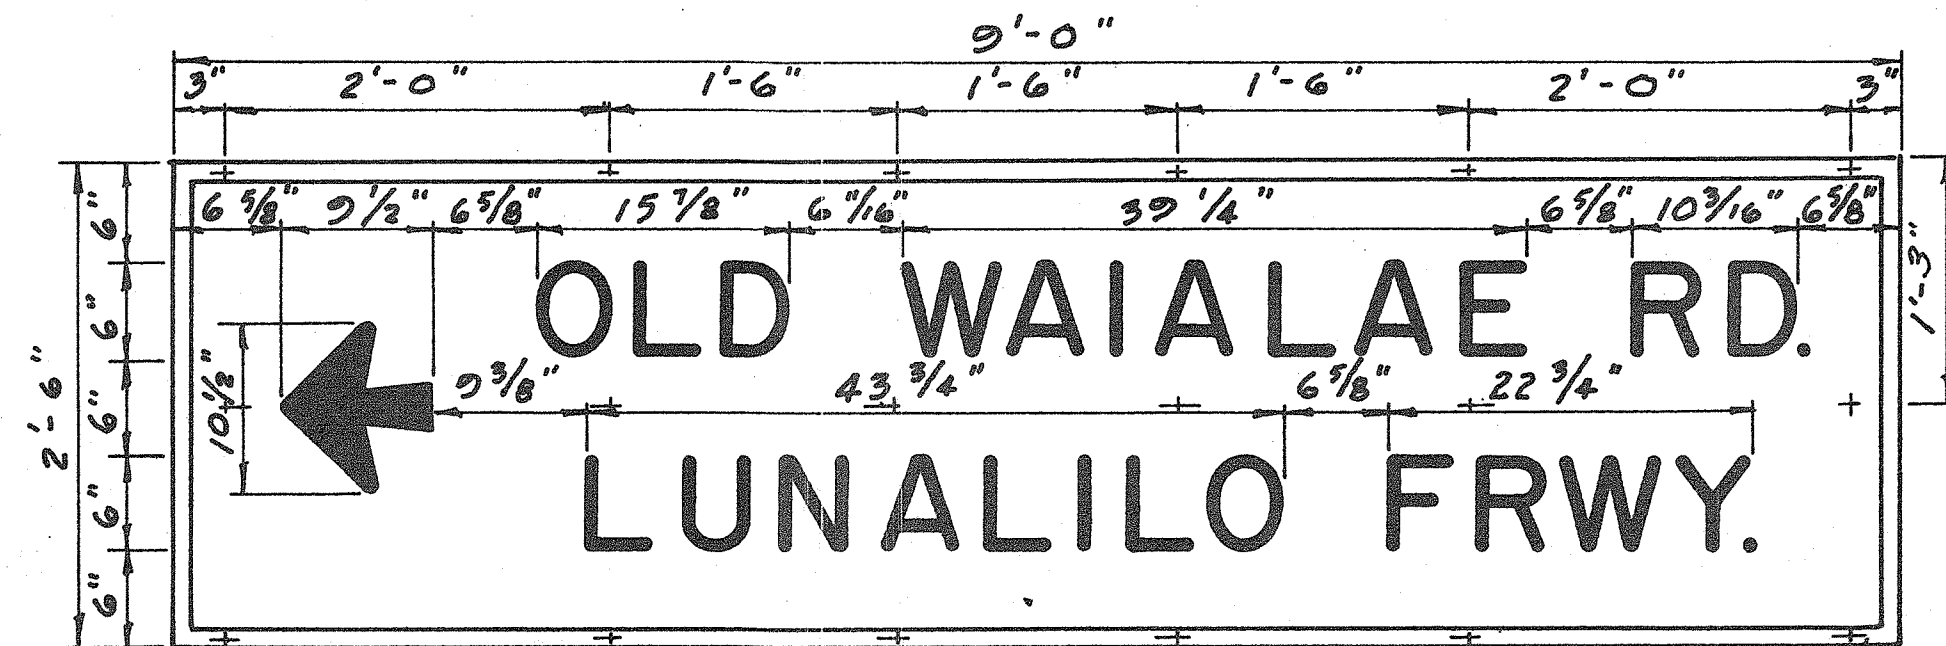


D-19

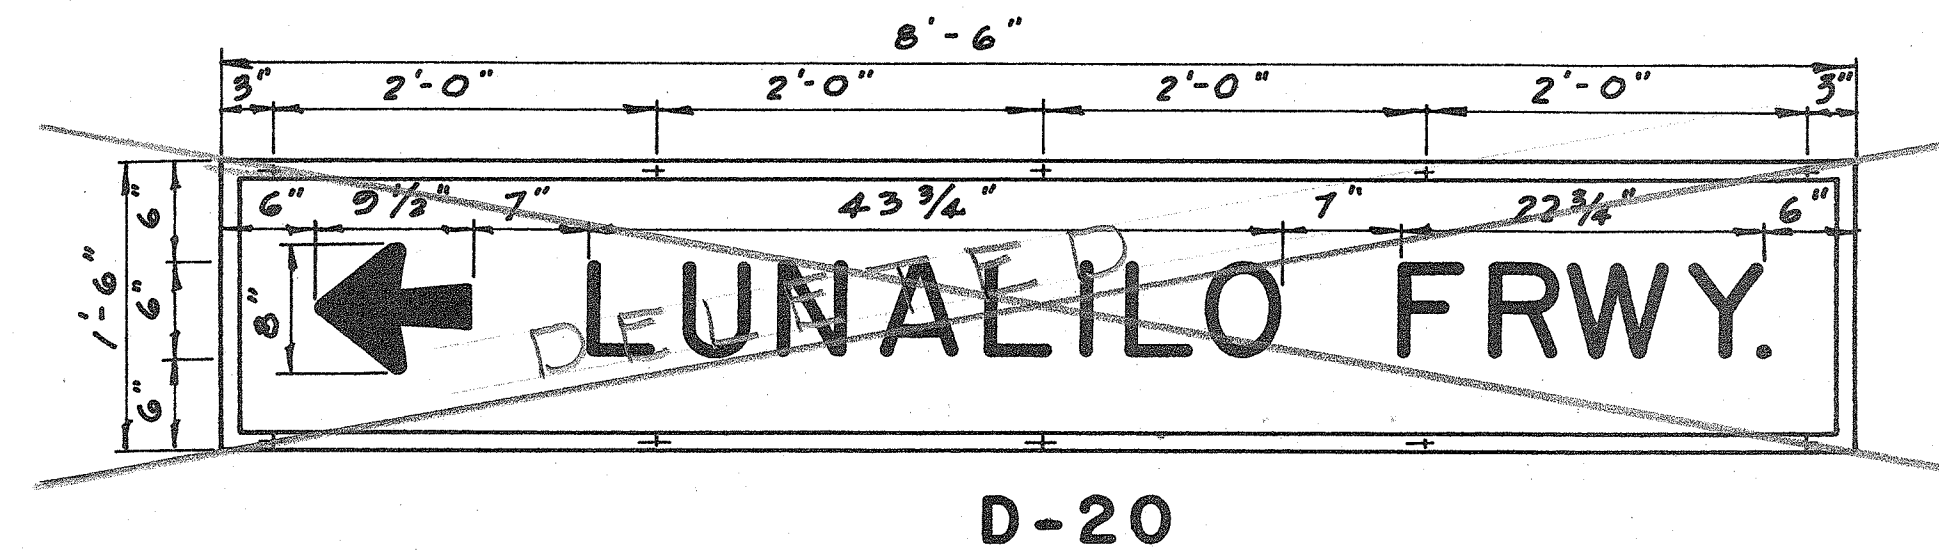


D-20

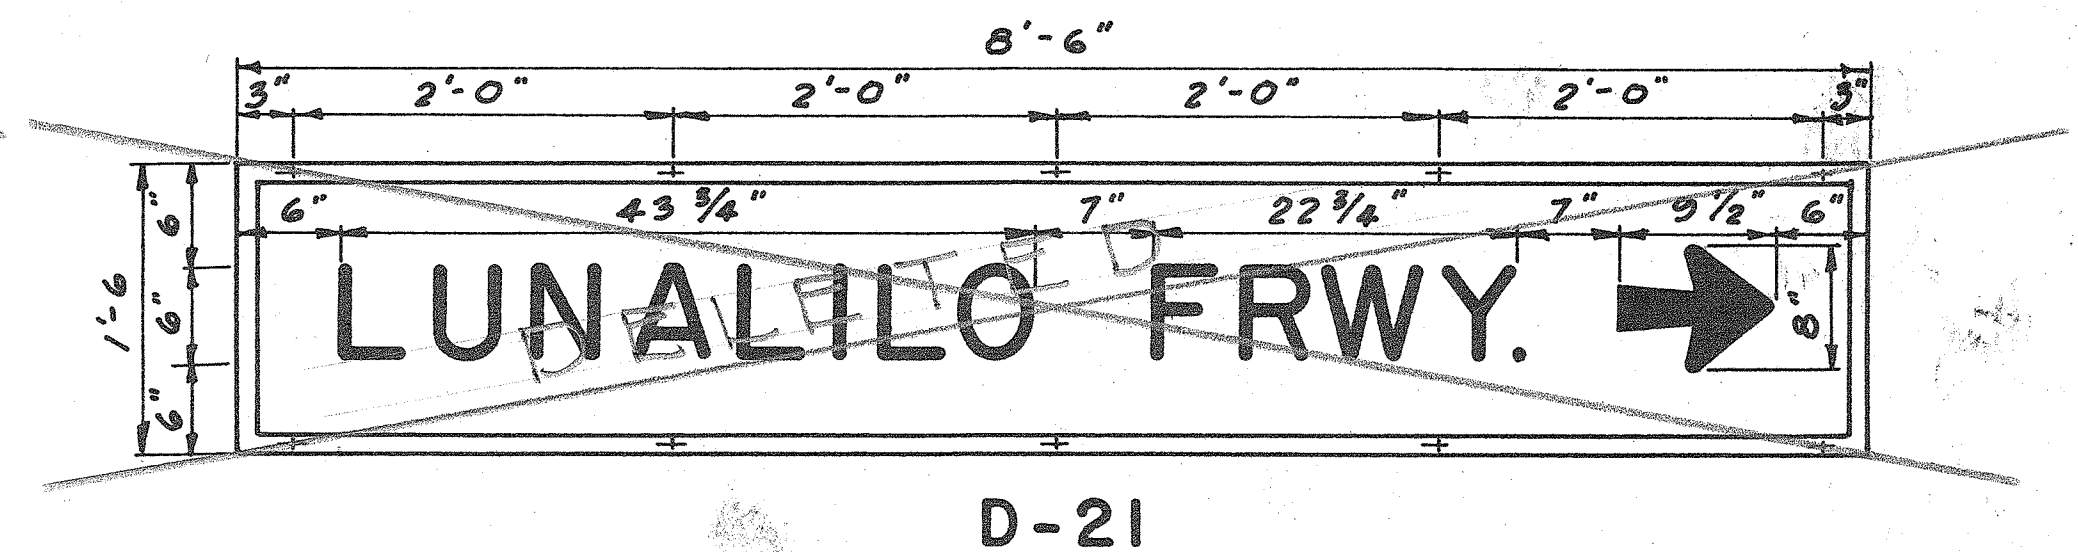

D-21

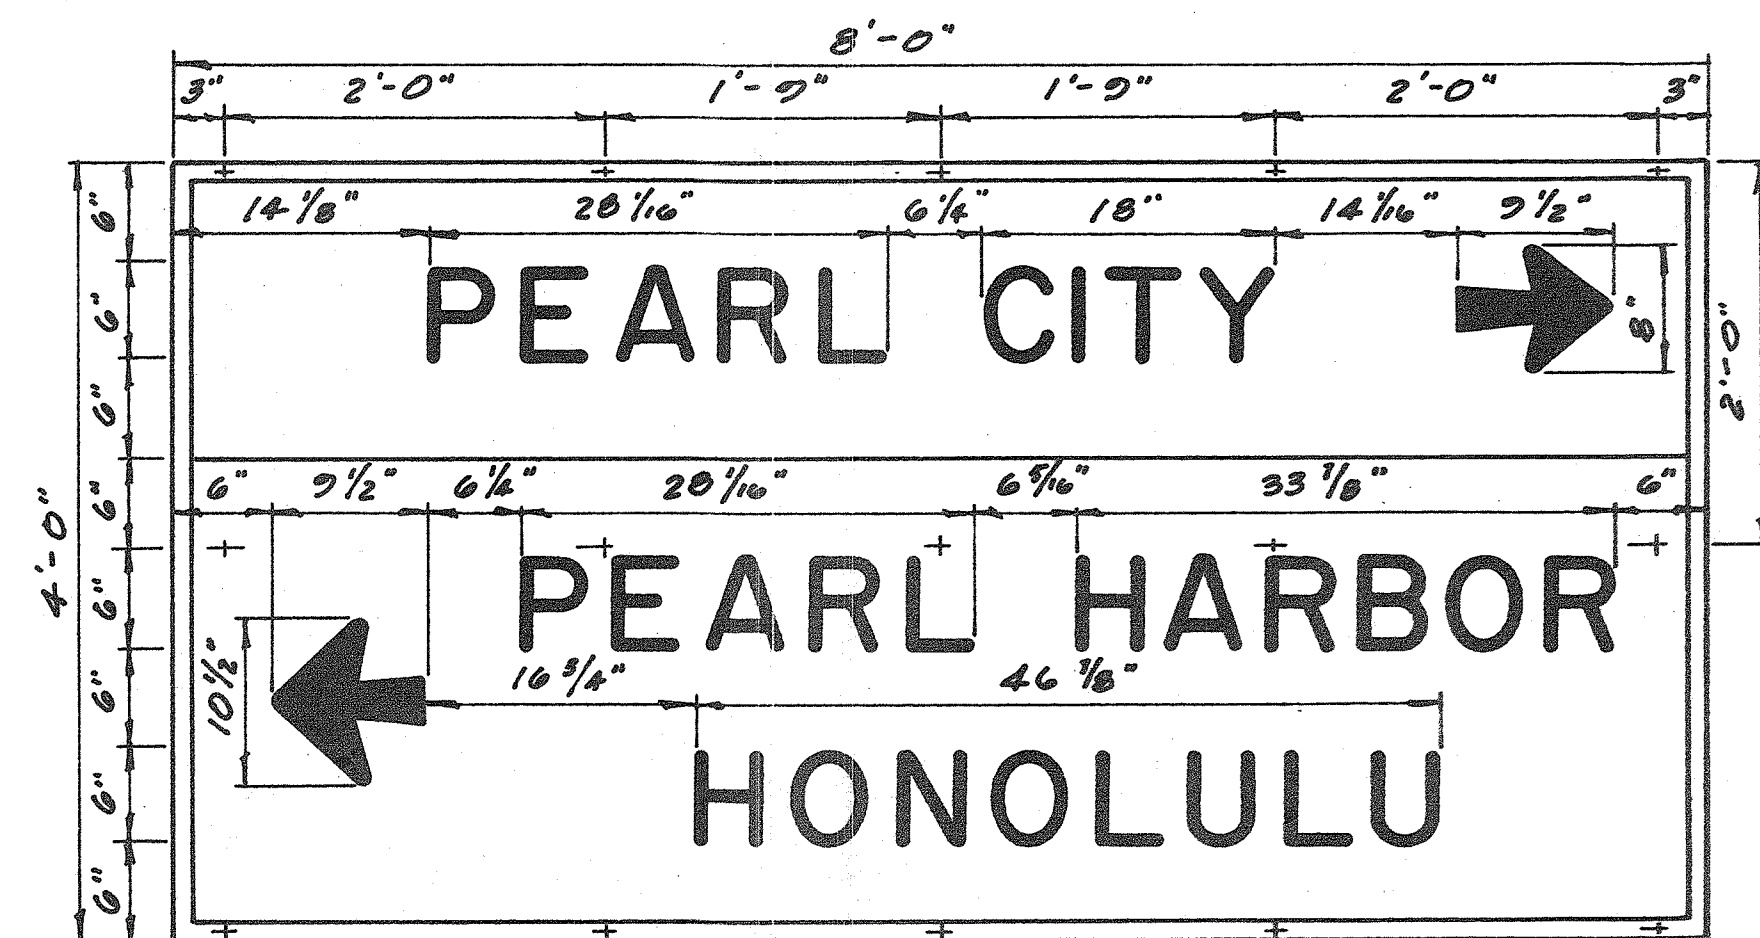


D-22

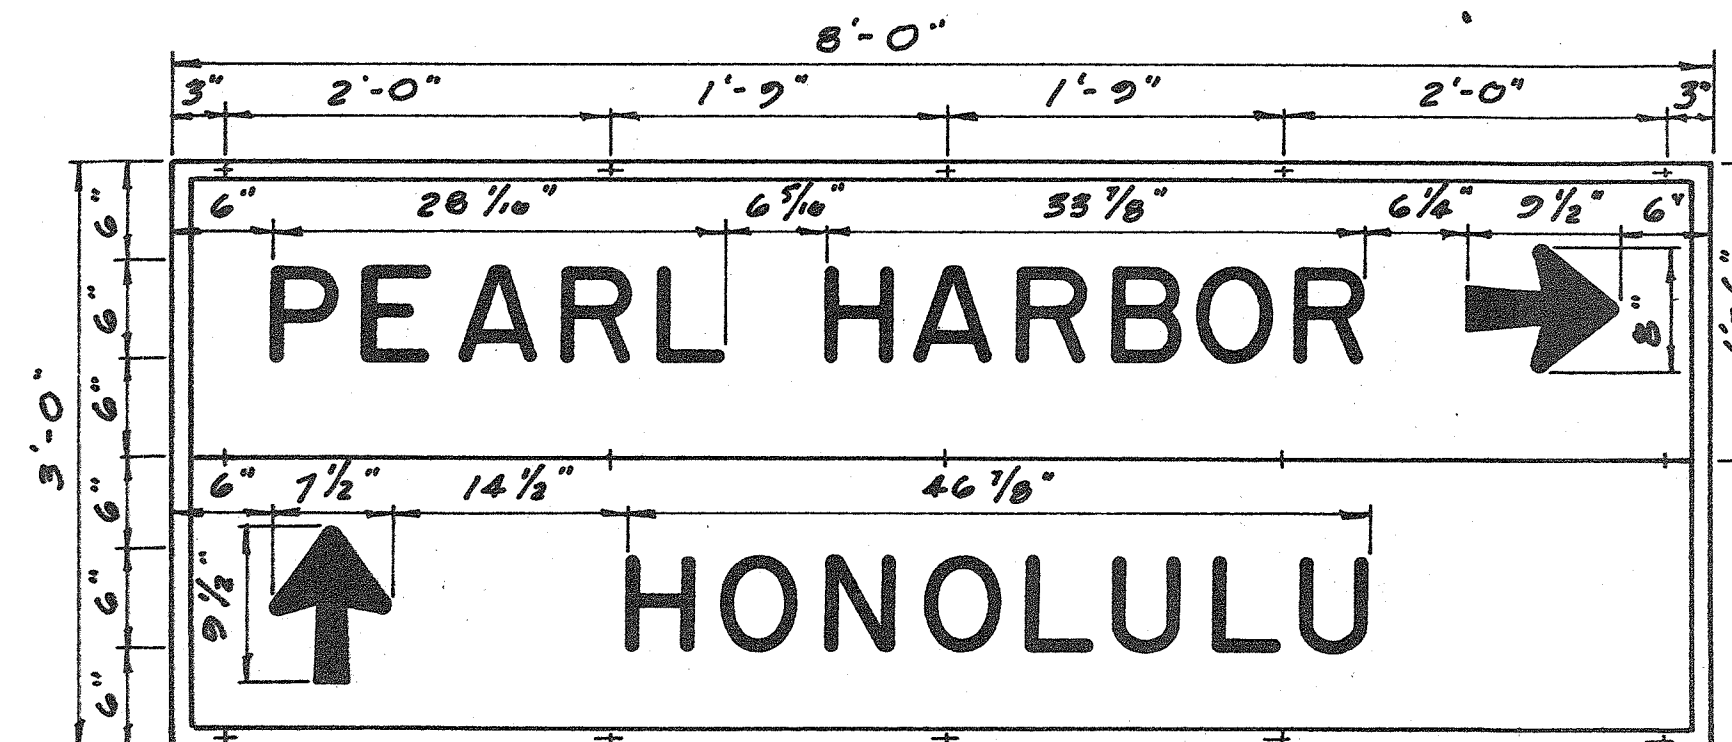


D-23




D-24

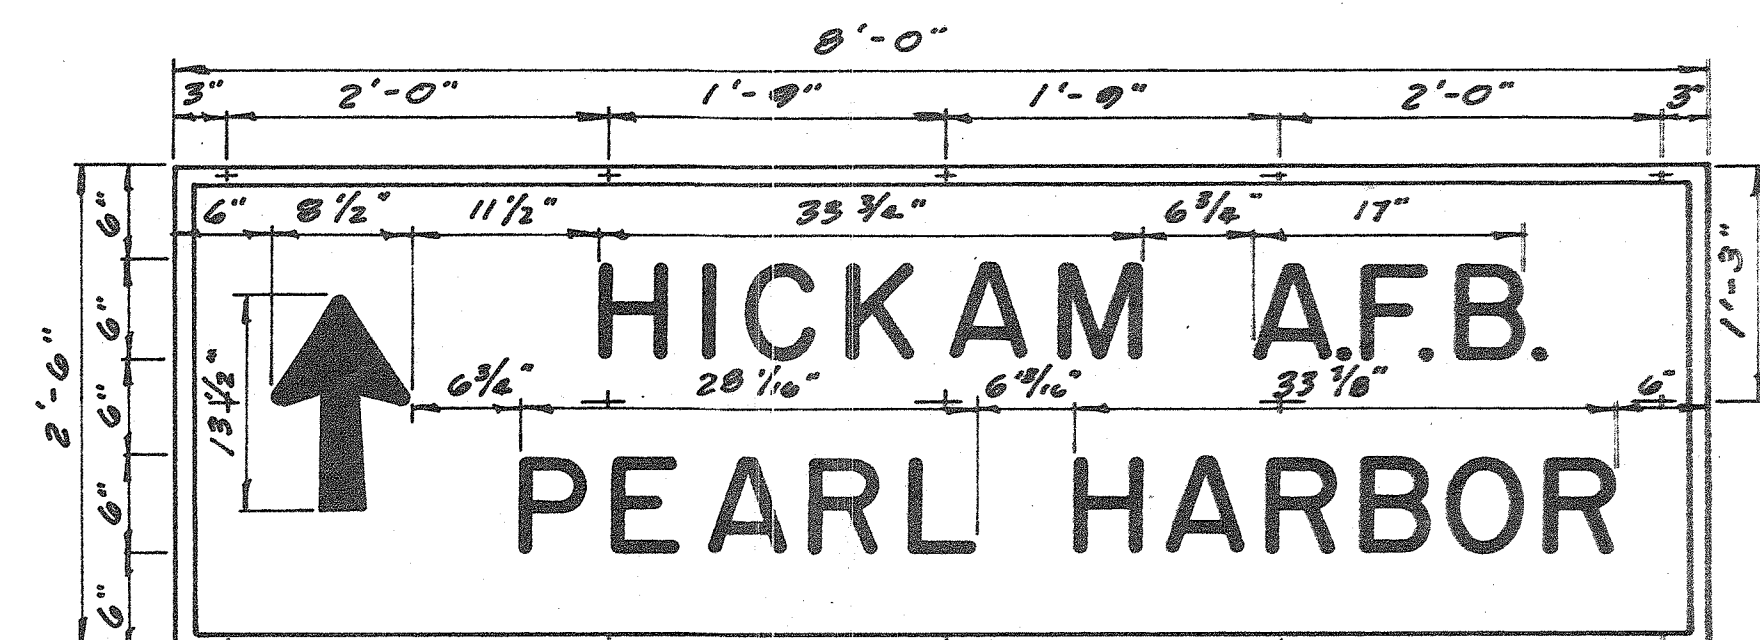

D-25

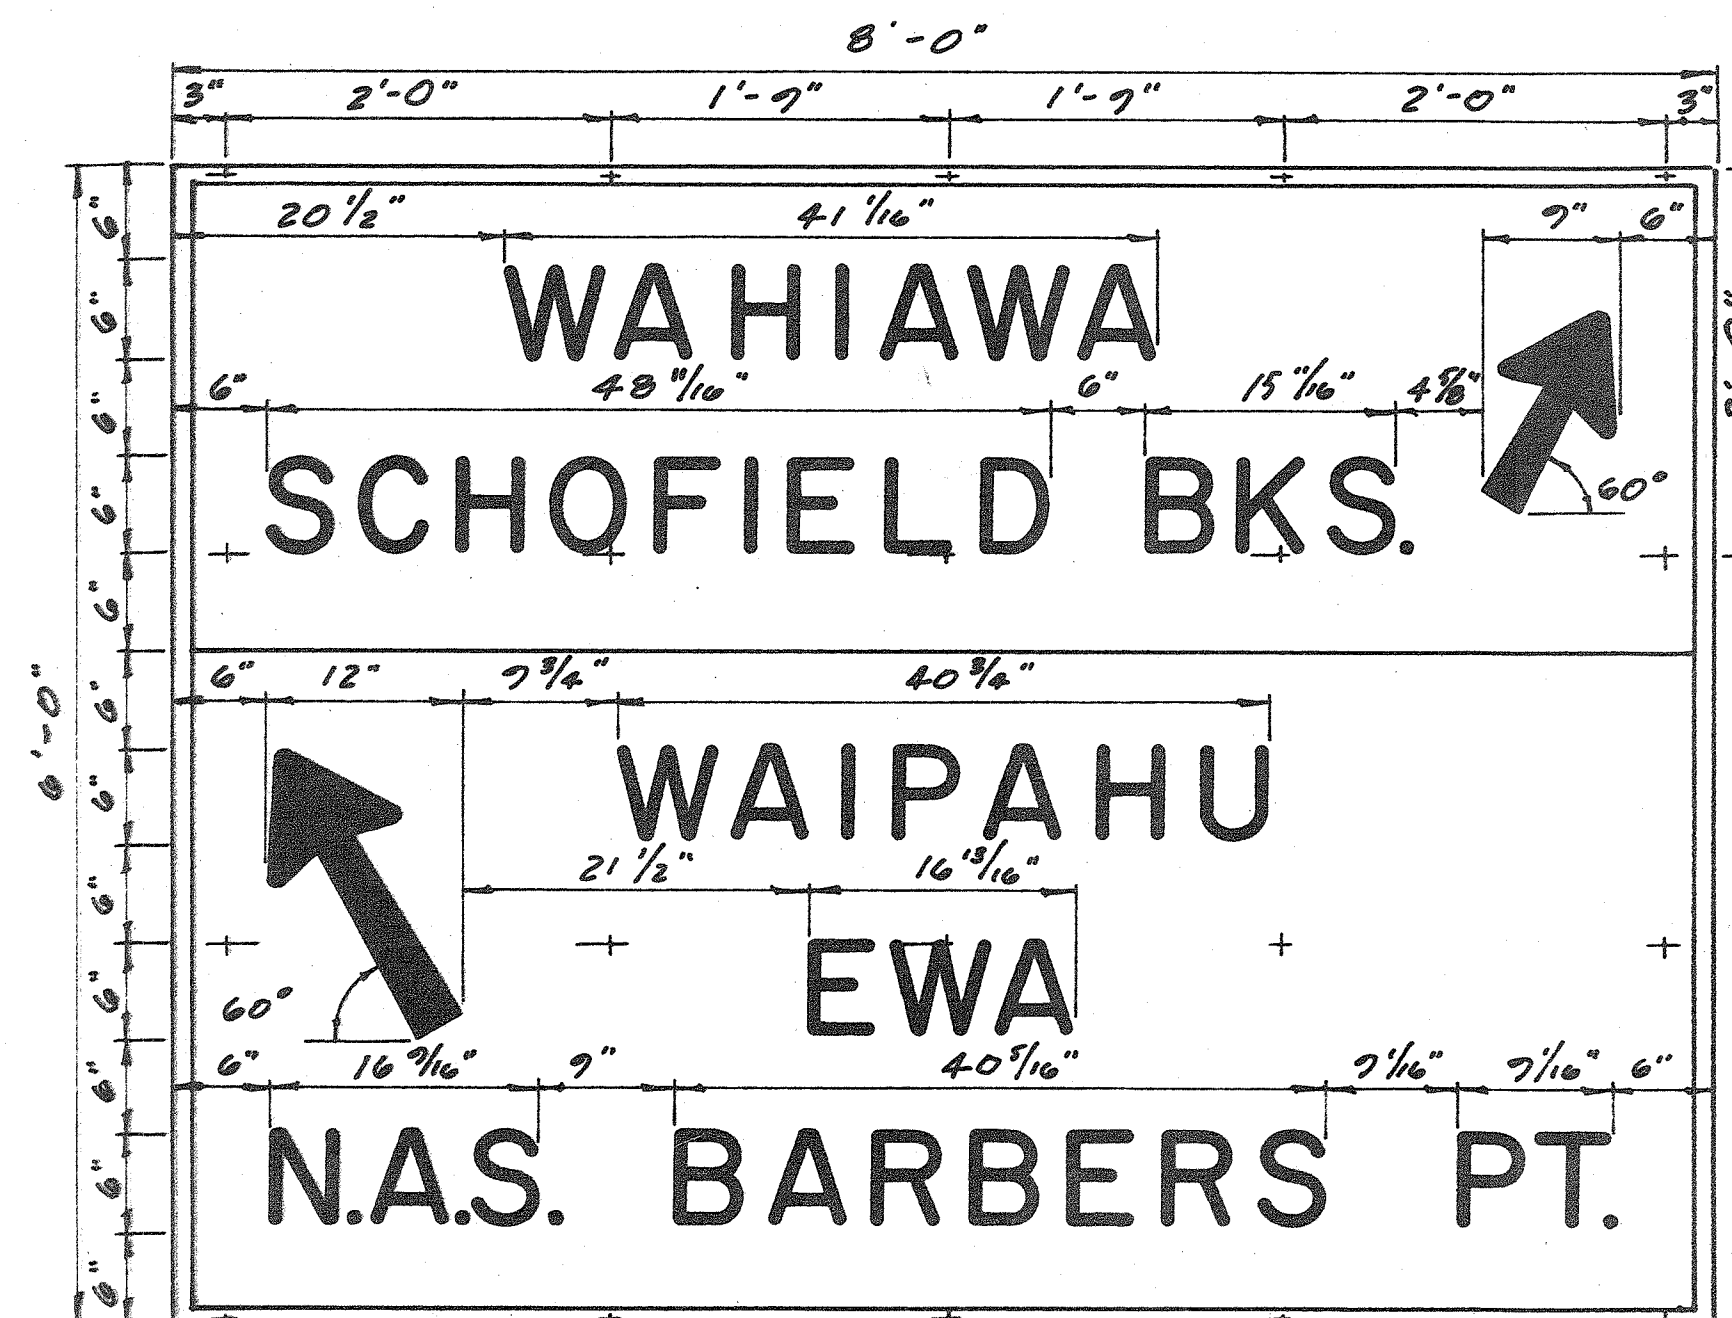

D-26

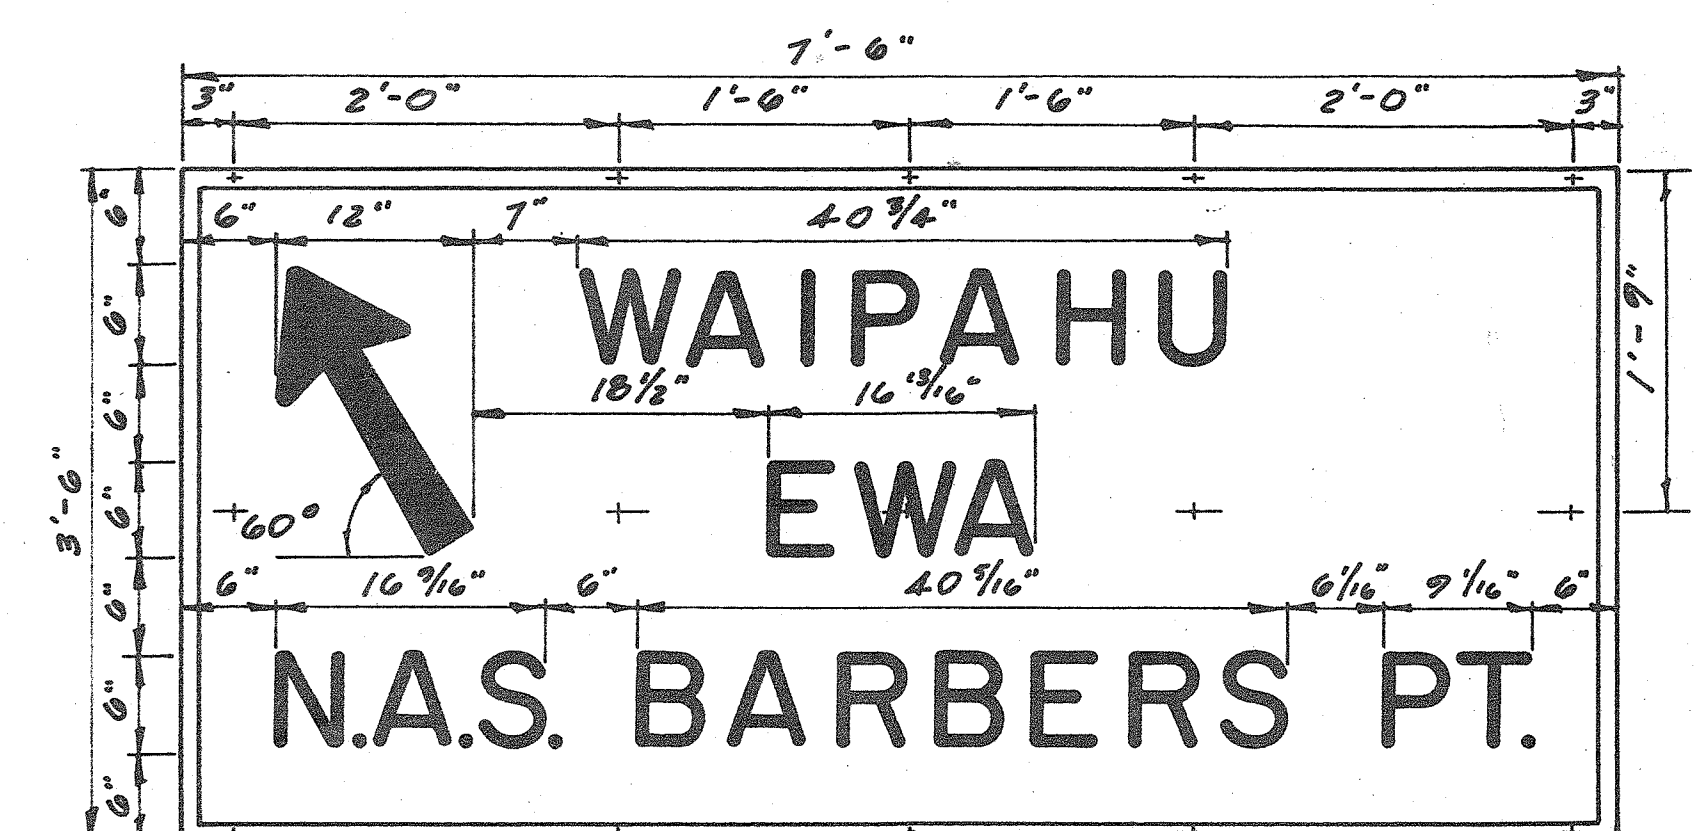

D-27

SURVEY PLANNED BY: _____
 DESIGNED BY: _____
 DRAWN BY: _____
 CHECKED BY: _____
 NOTE BOOK: _____
 NO. _____

STATE OF HAWAII
DEPARTMENT OF TRANSPORTATION
DIVISION OF HIGHWAYS


DESTINATION SIGNS
ISLAND OF OAHU

SCALE: 1" = 1'-0"


SHEET NO. 6 OF 11 SHEETS

A-0001-08-60 (6)


FED. ROAD DIST. NO.	STATE	FED. AID PROJ. NO.	FISCAL YEAR	SHEET NO.	TOTAL SHEETS
ORHU	HI	1111	1961	7	11

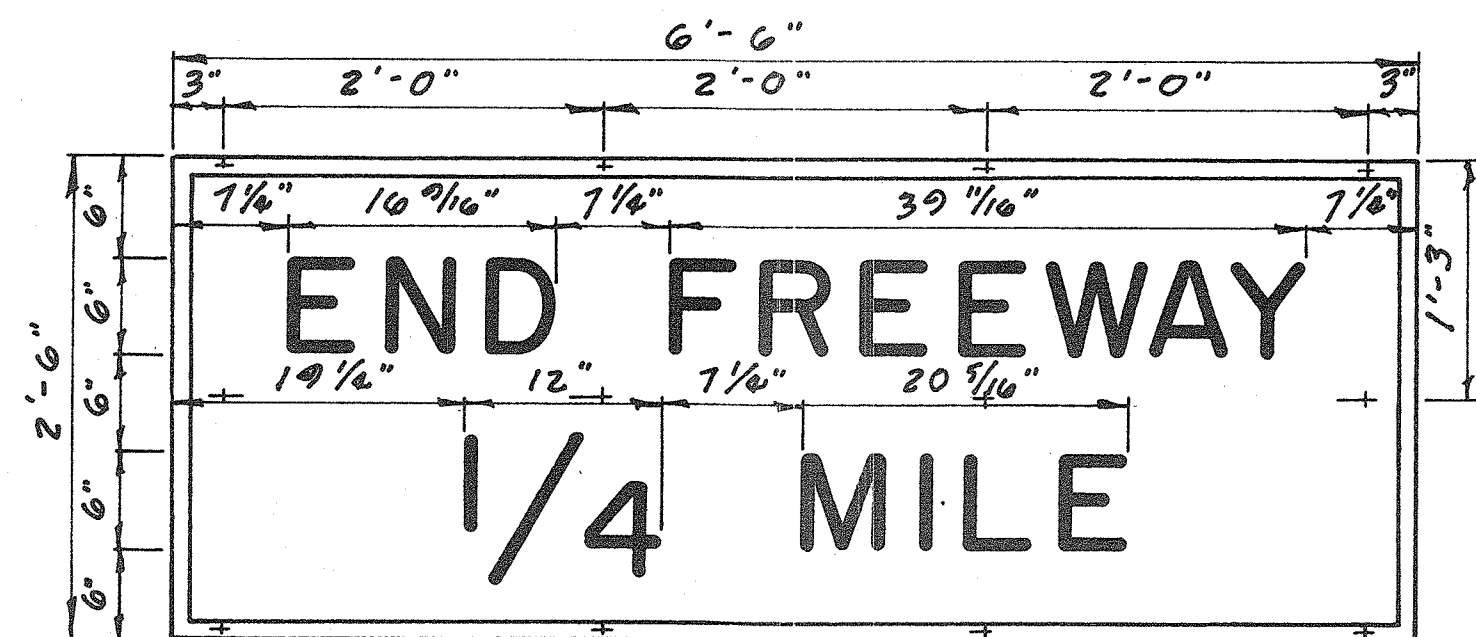


D-28,29

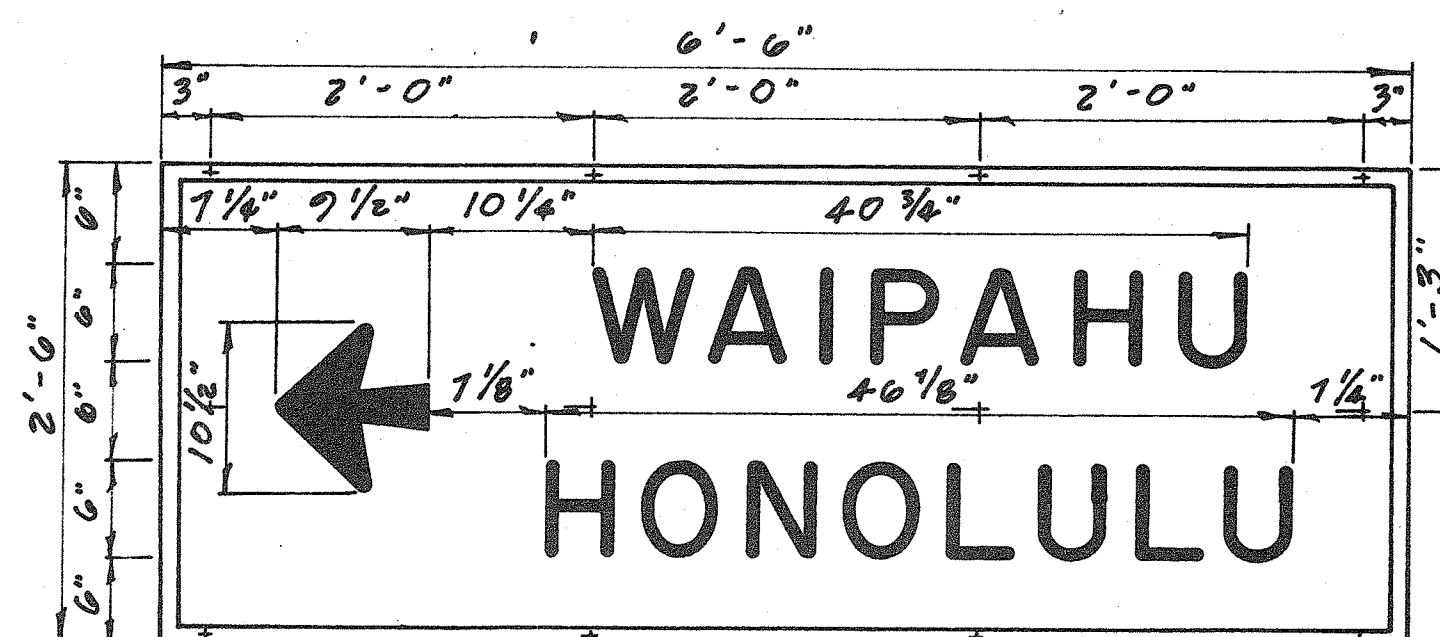


D-32

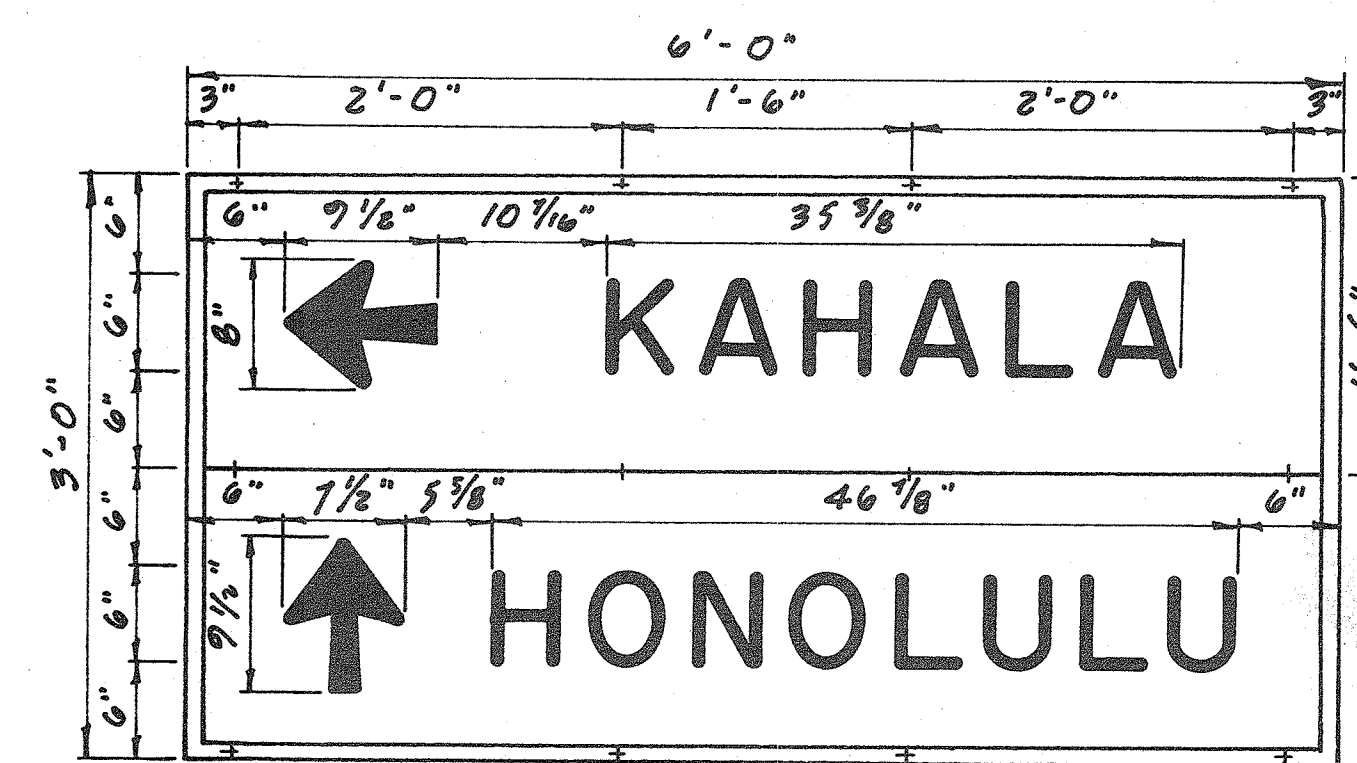


D-33

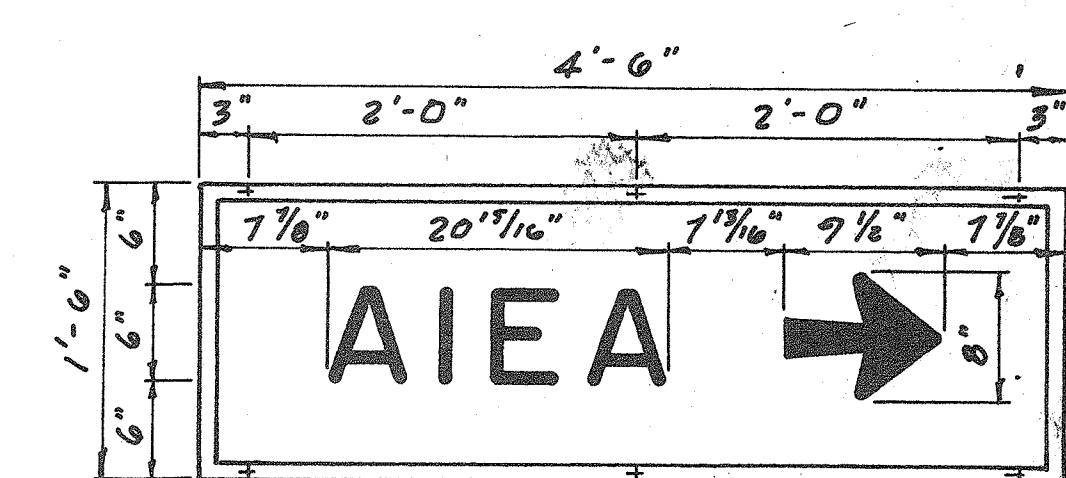


D-34

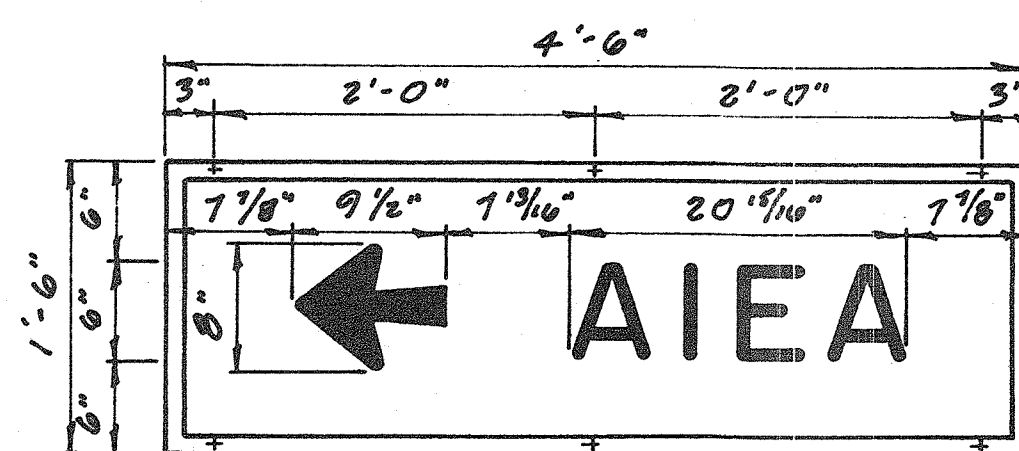


D-35

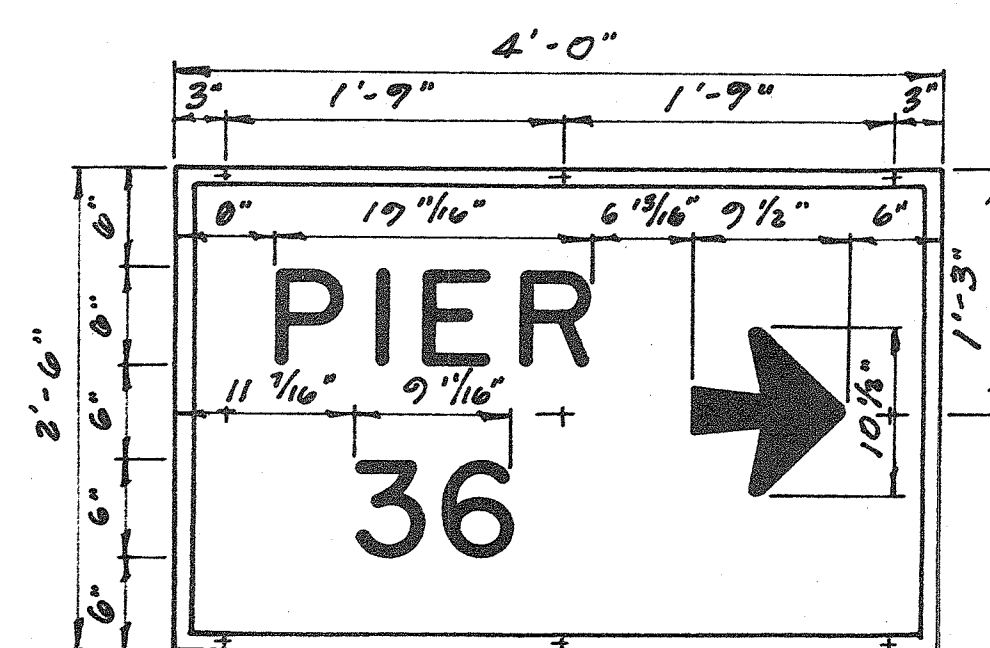


D-36

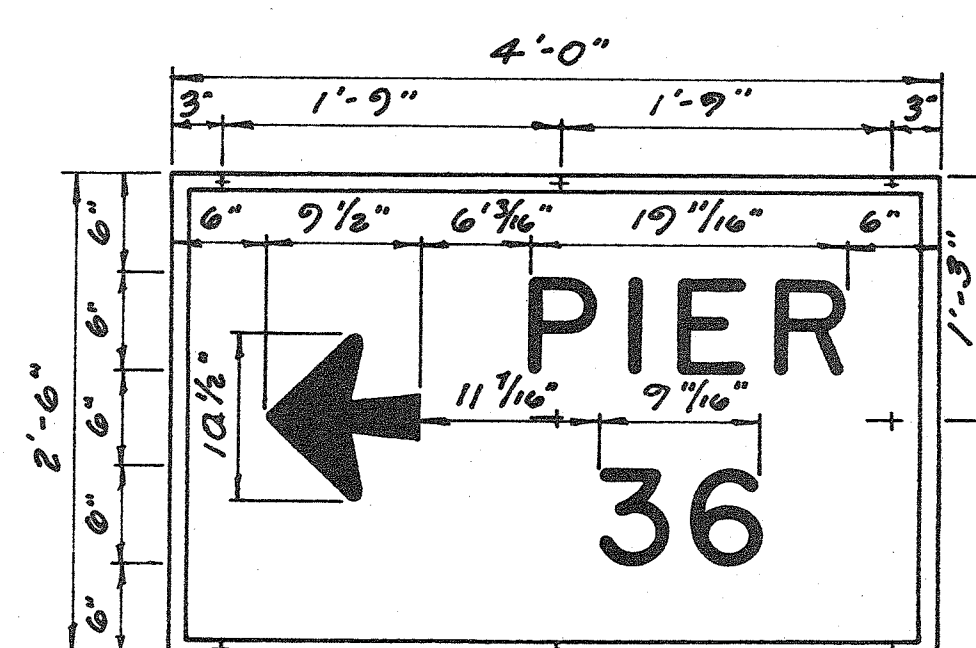


D-37

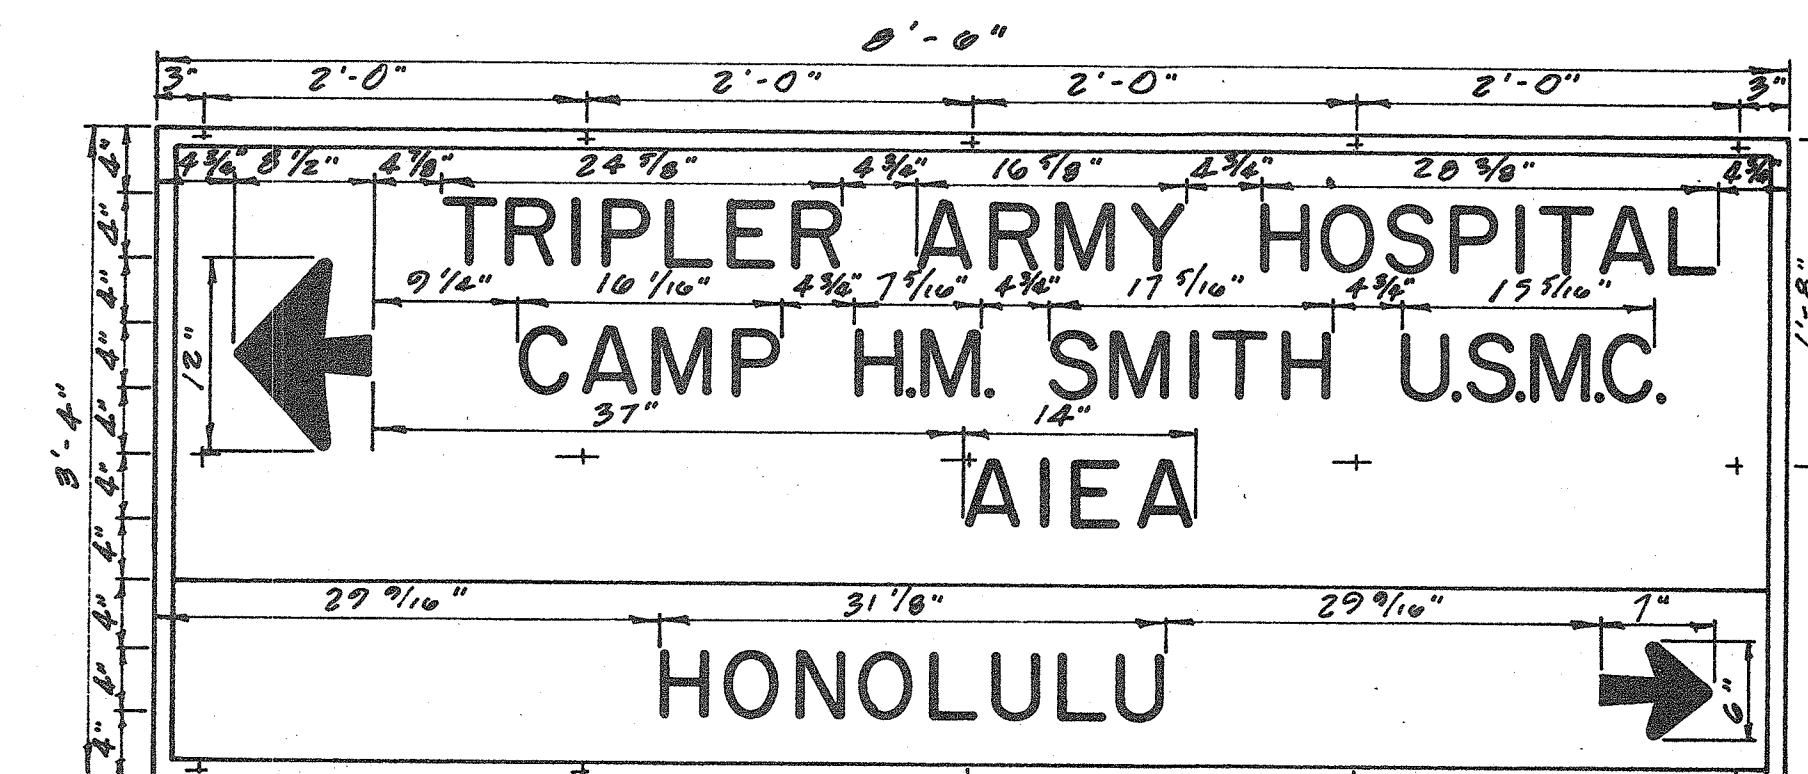


D-38

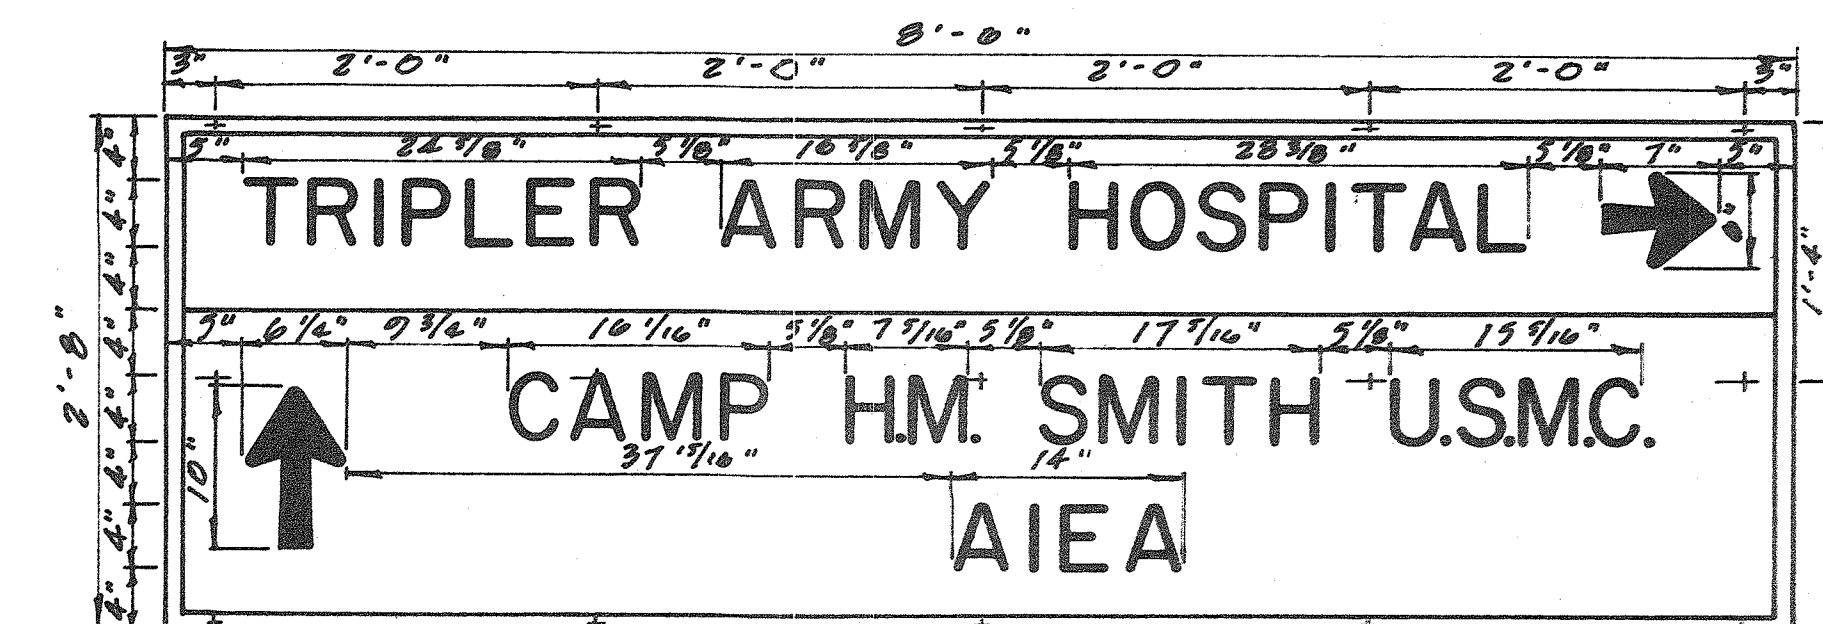


D-39

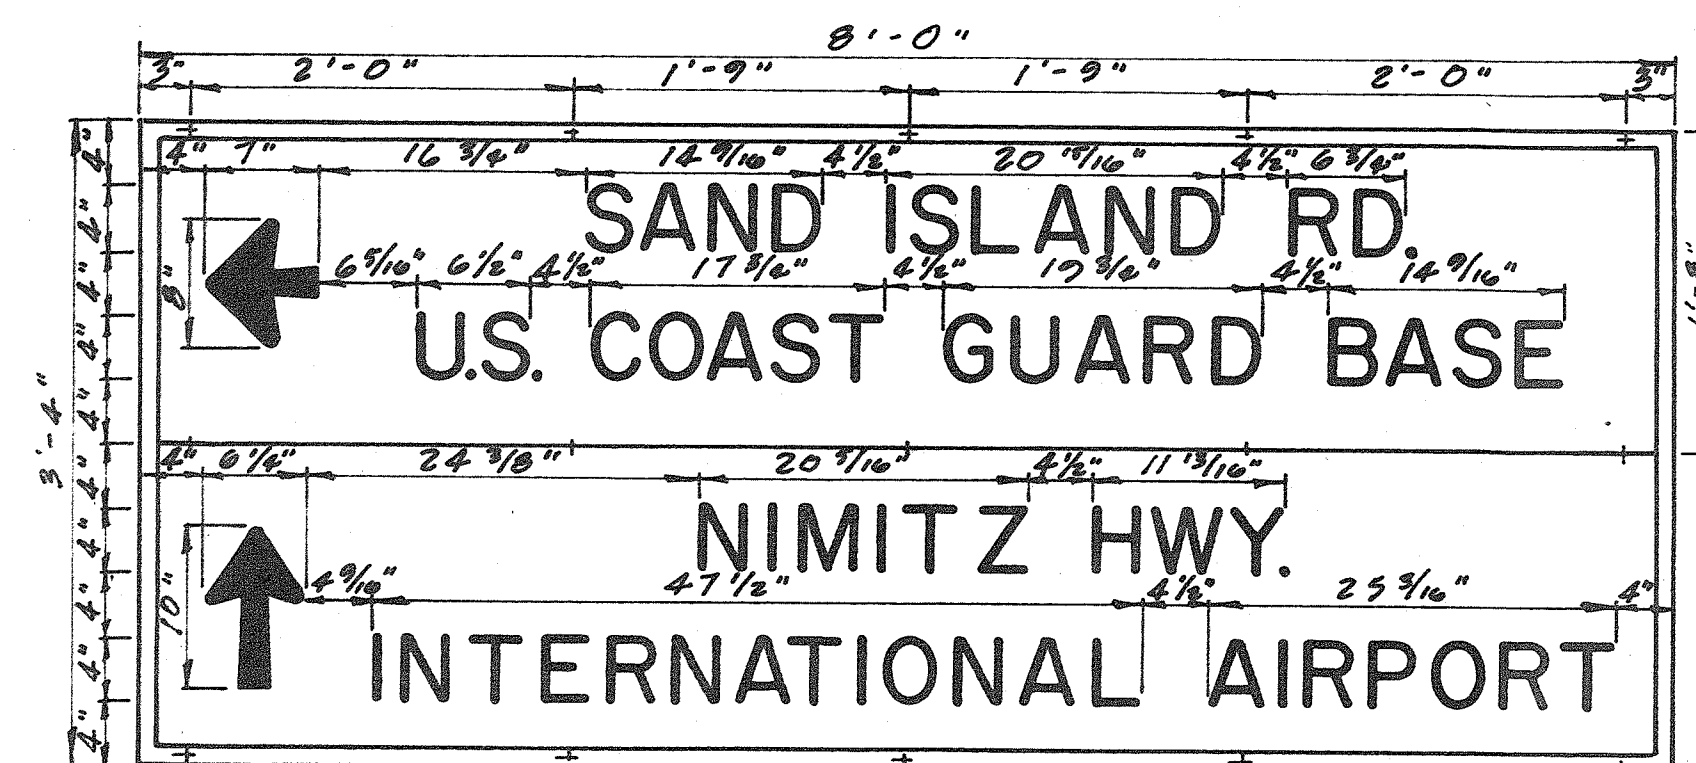


D-40

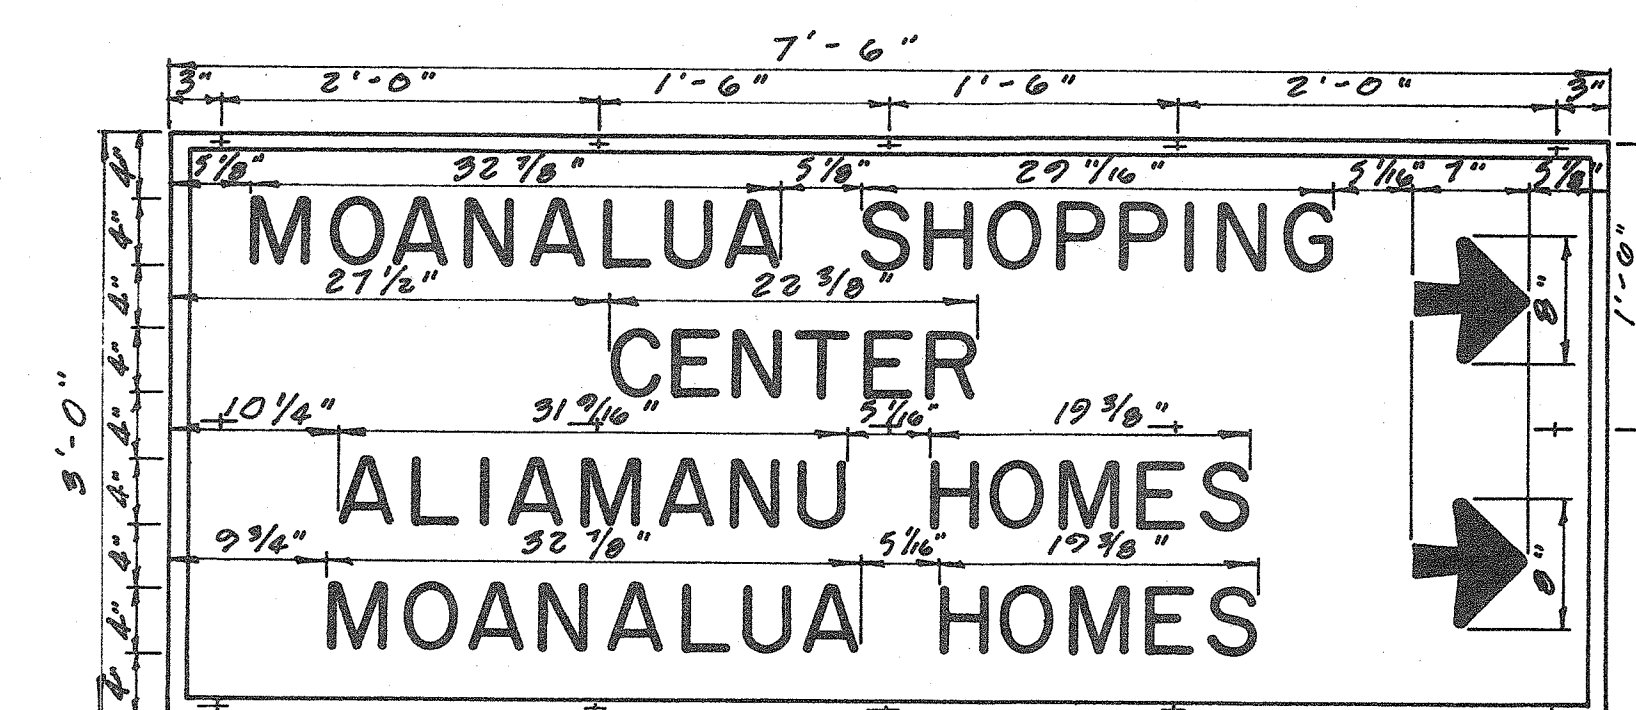

D-41

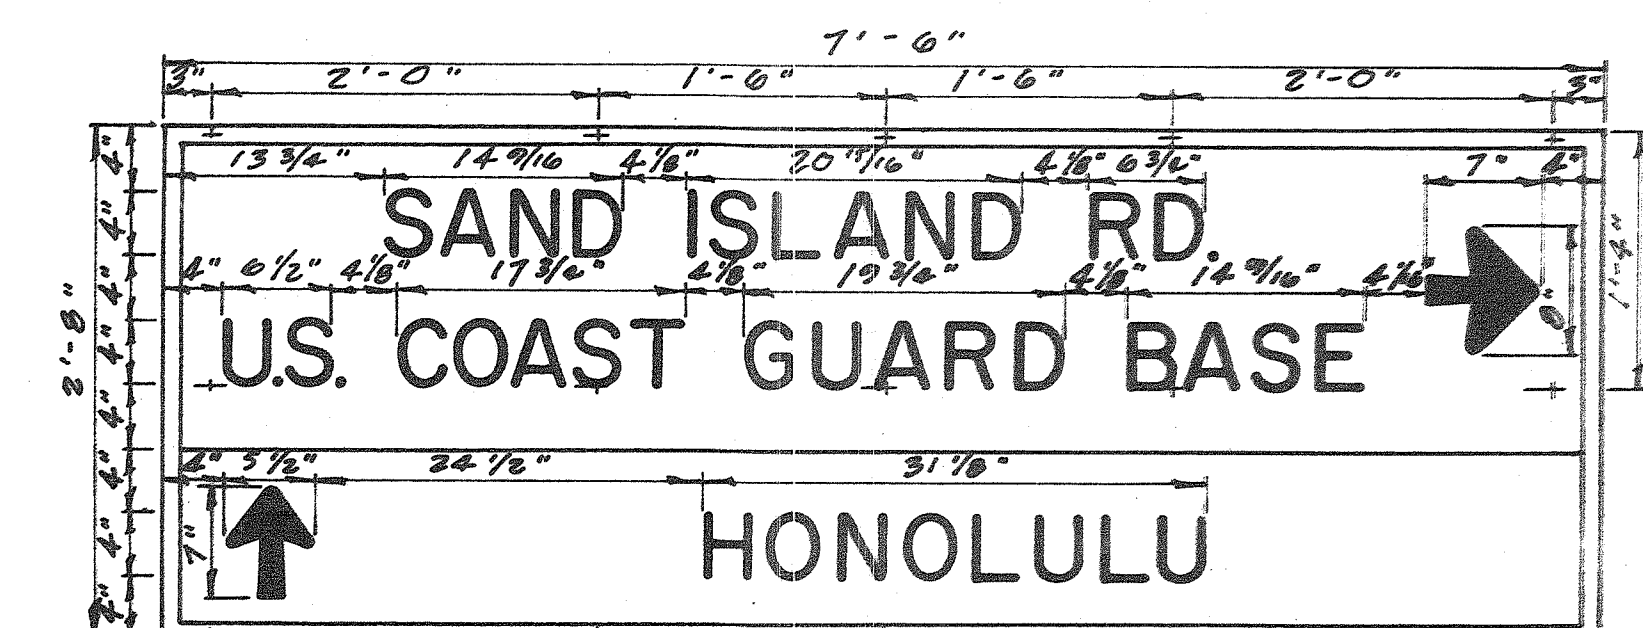

D-42

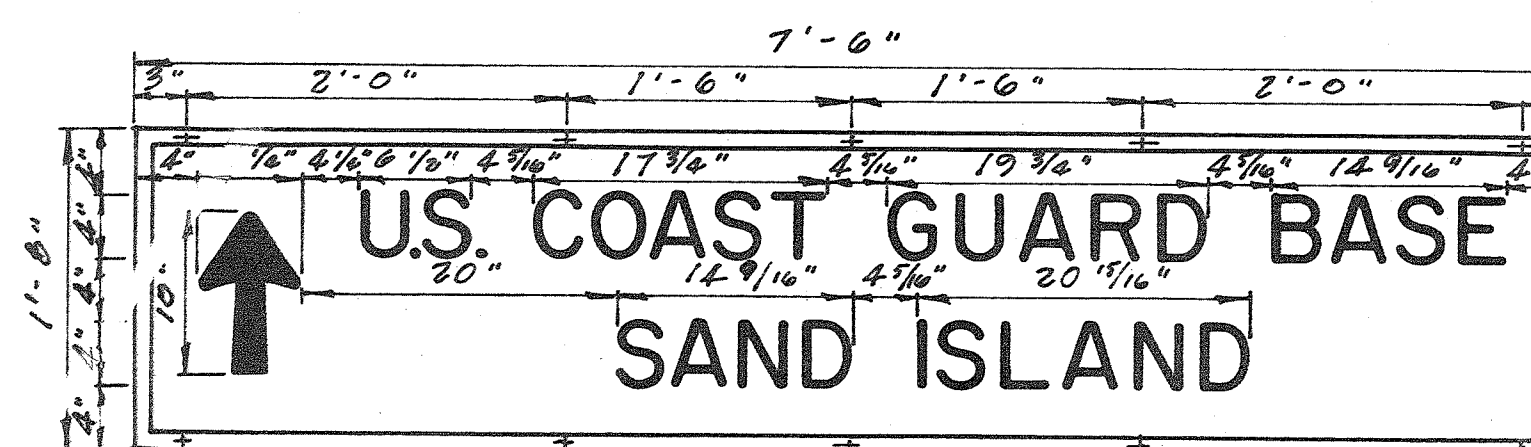

D-43

STATE OF HAWAII
DEPARTMENT OF TRANSPORTATION
DIVISION OF HIGHWAYS


DESTINATION SIGNS
ISLAND OF OAHU

SCALE: 1" = 1'-0"


SHEET NO. 7 OF 11 SHEETS

1-0001-08-60 (7)


SURVEY PLOTTED BY: DATE: 3/62
DESIGNED BY: 3/62
DRAWN BY: 3/62
CHECKED BY: 3/62
ORIGINAL PLAN NO. 1
NOTE BOOK NO. 1

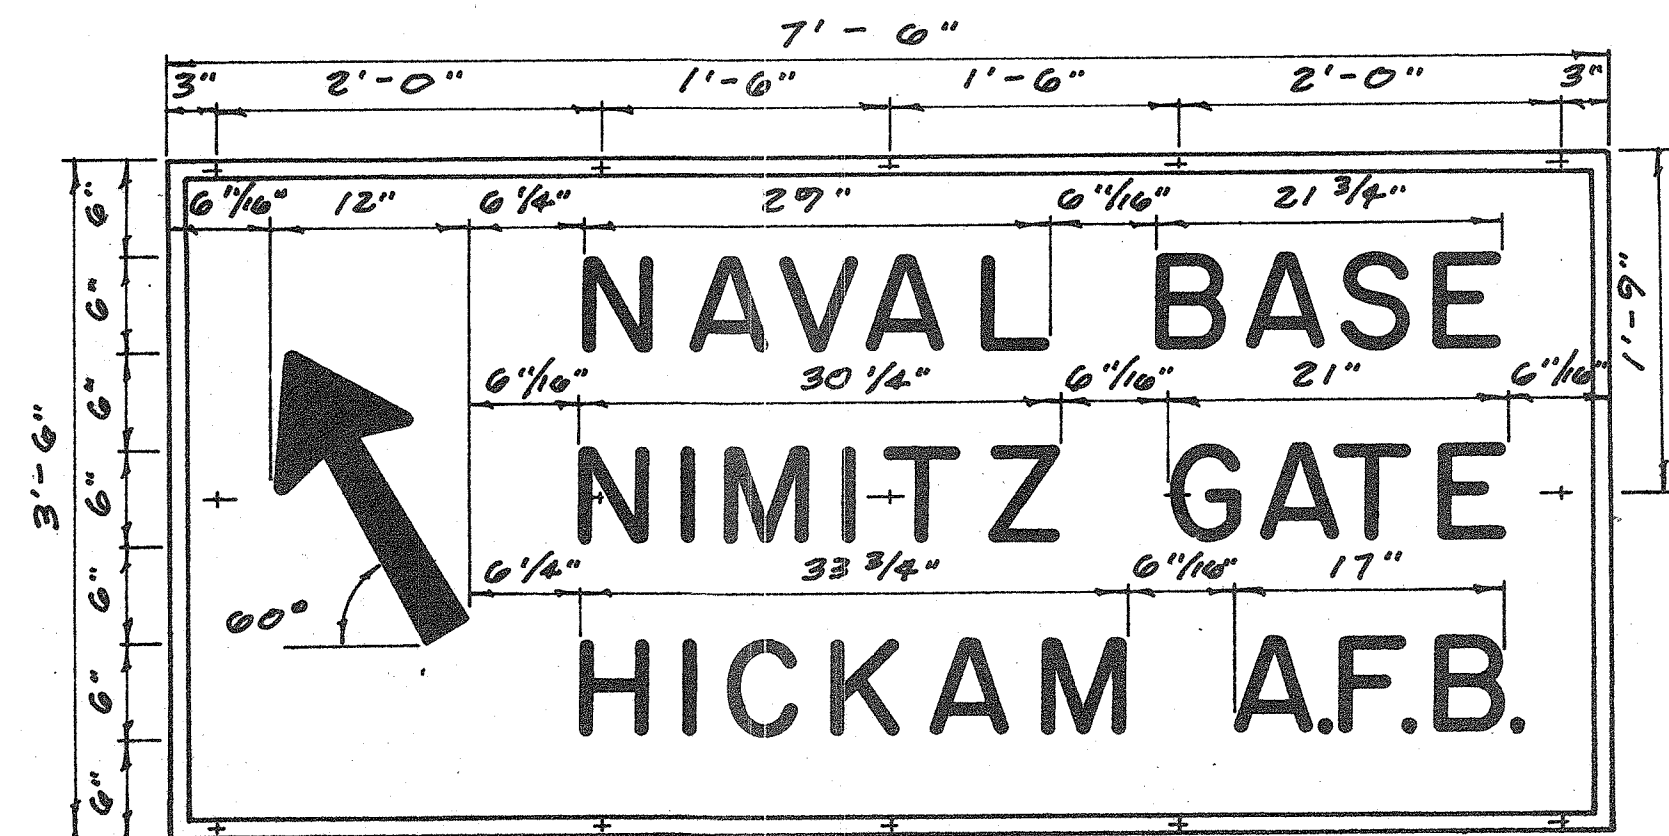


D-44

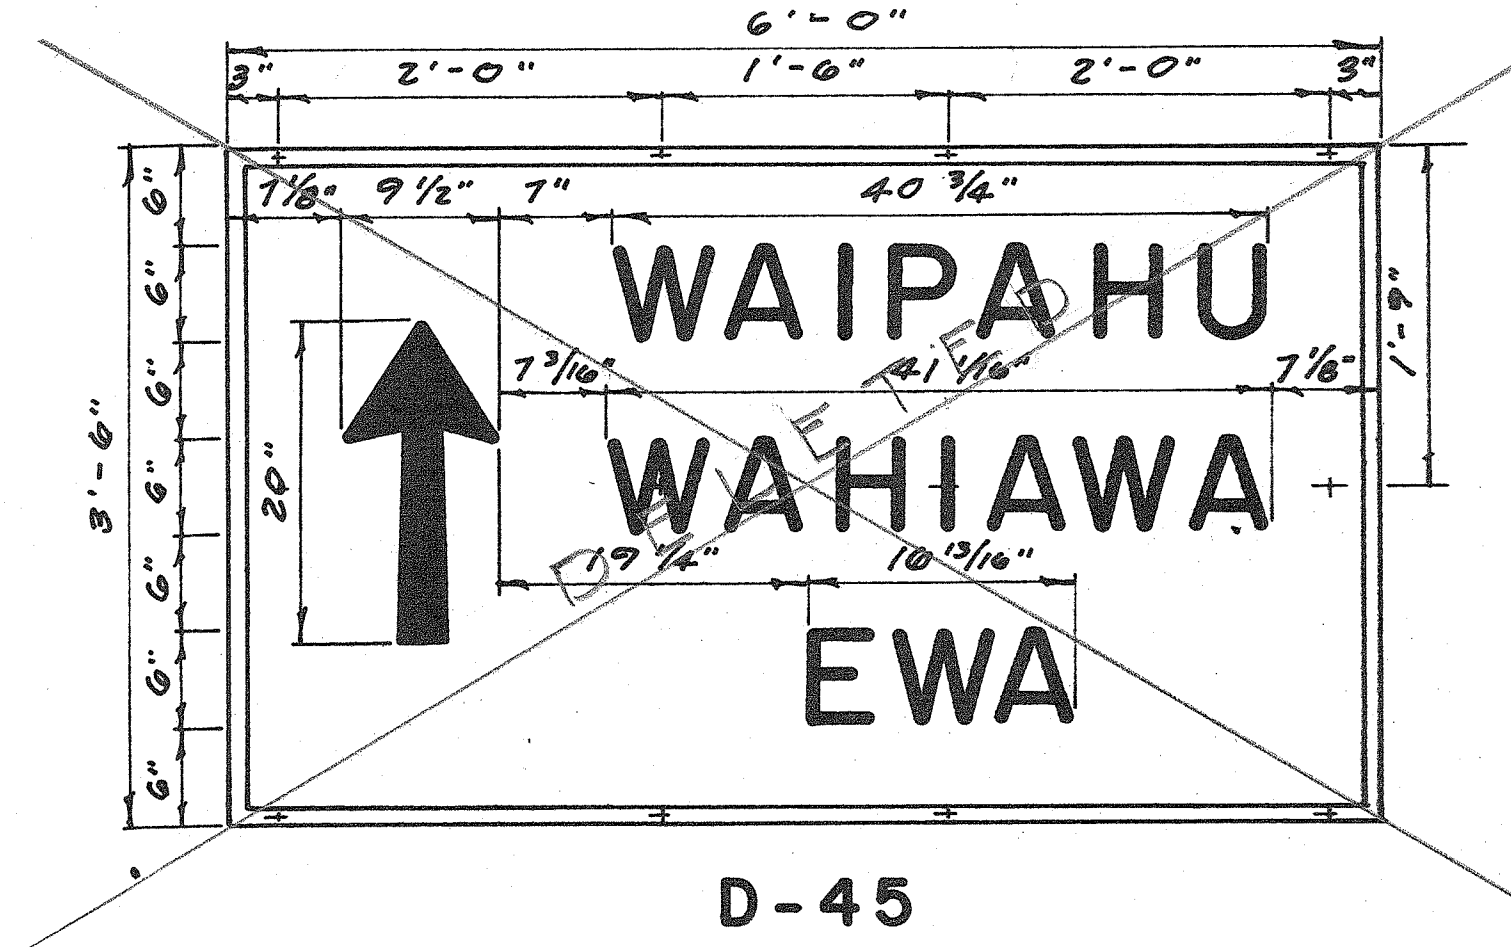


D-45

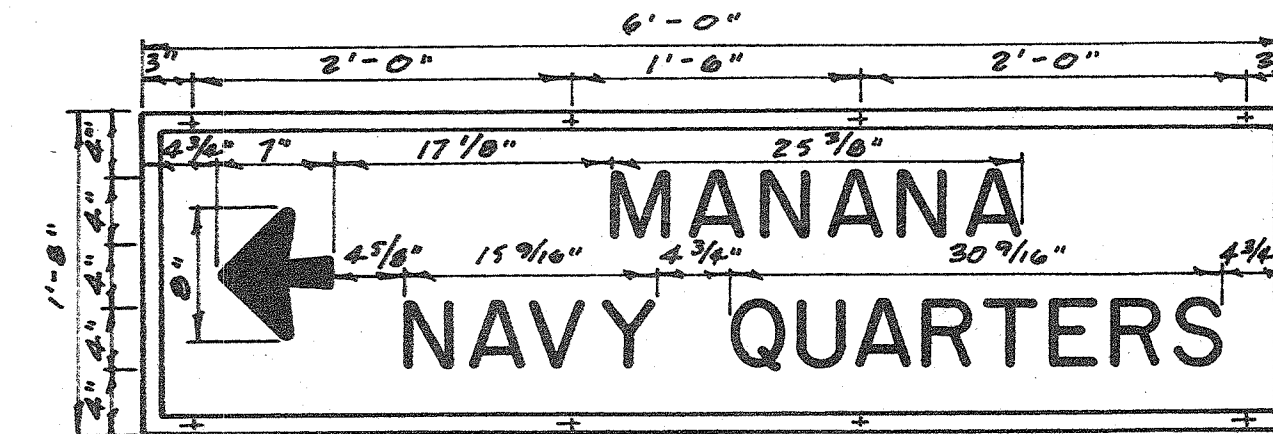


D-46

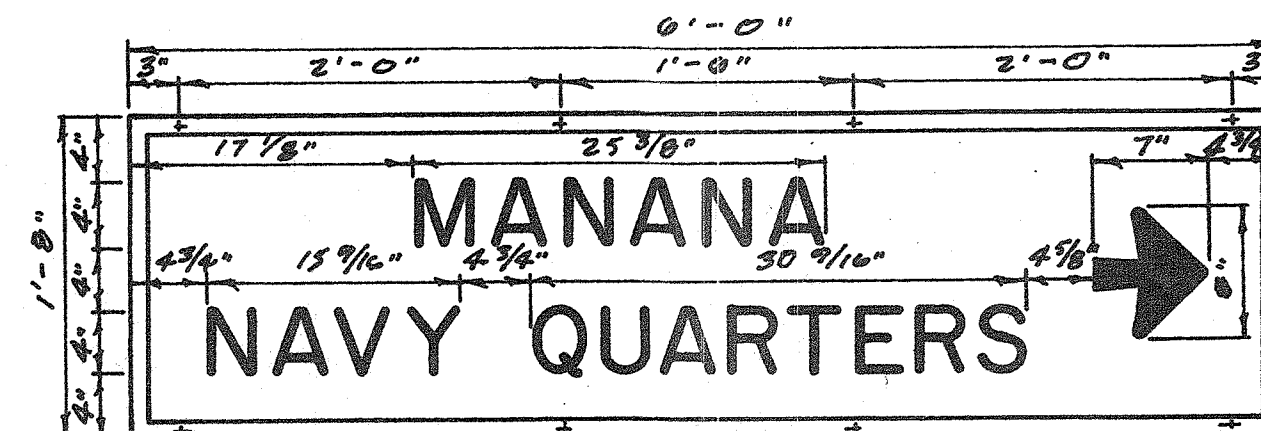


D-47

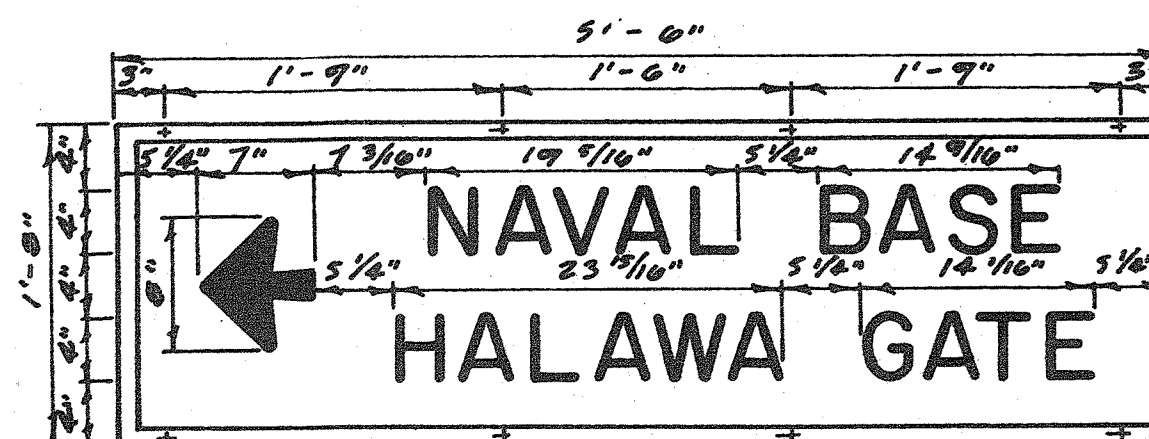


D-48

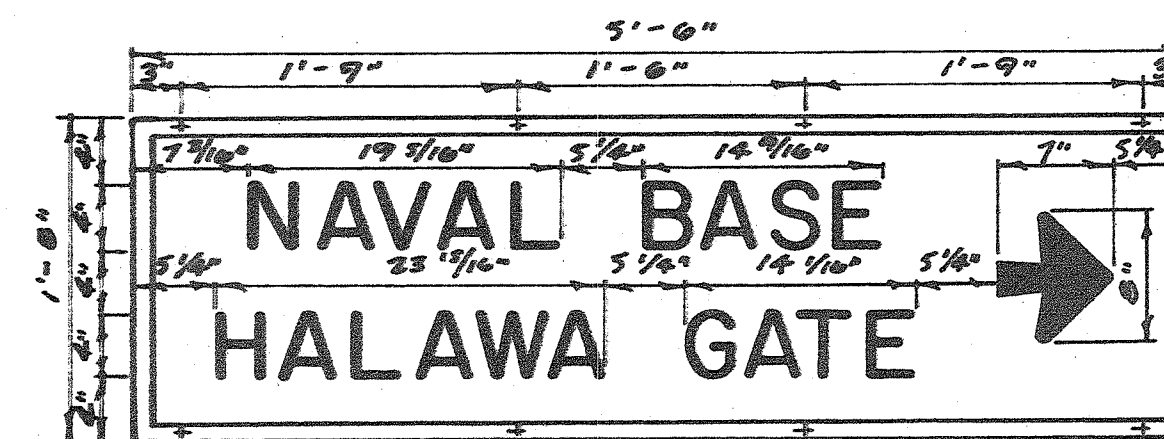


D-49

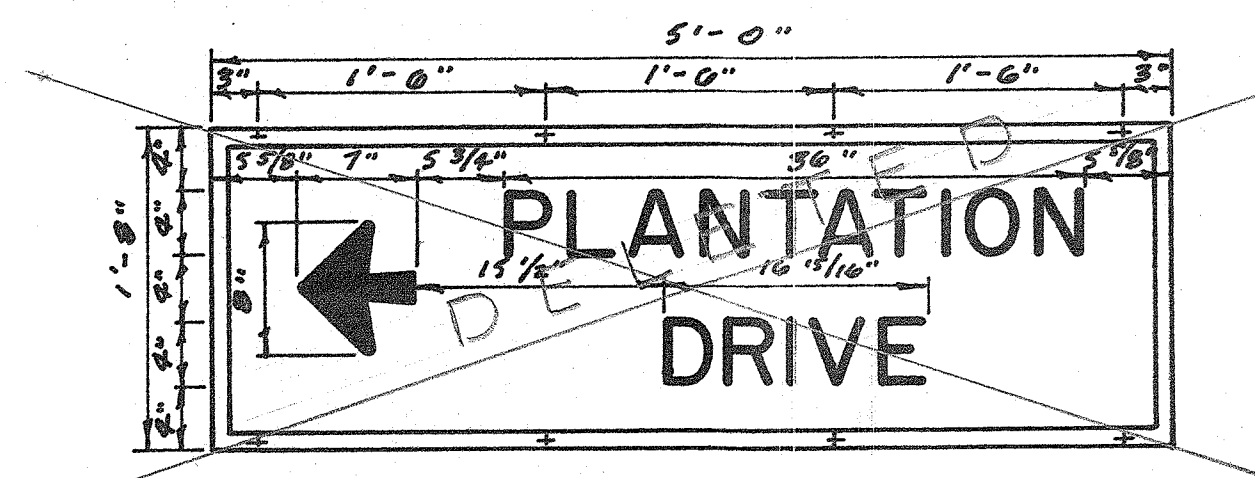


D-50

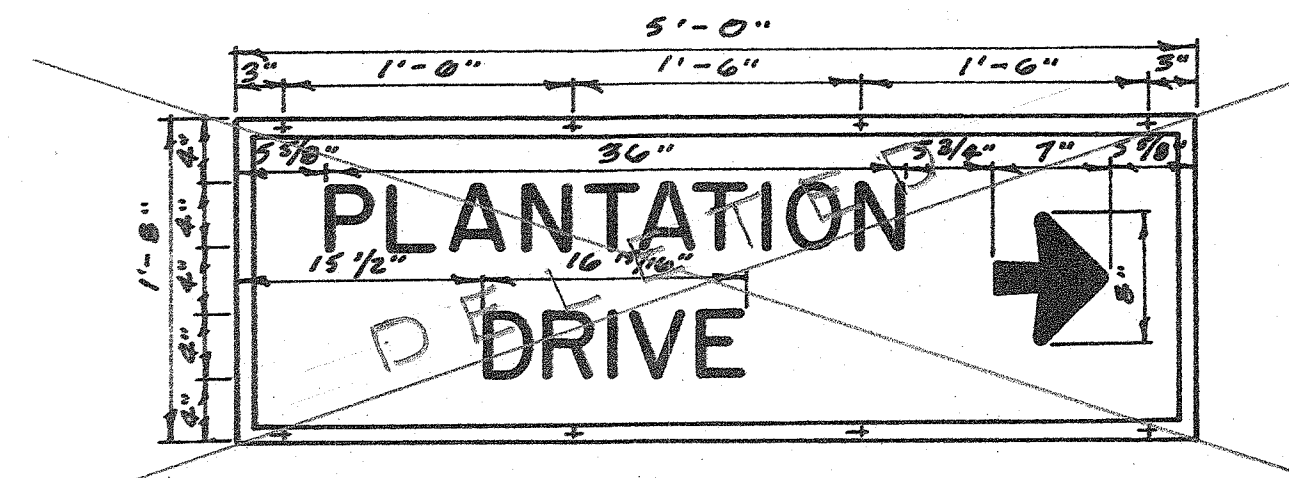

D-51

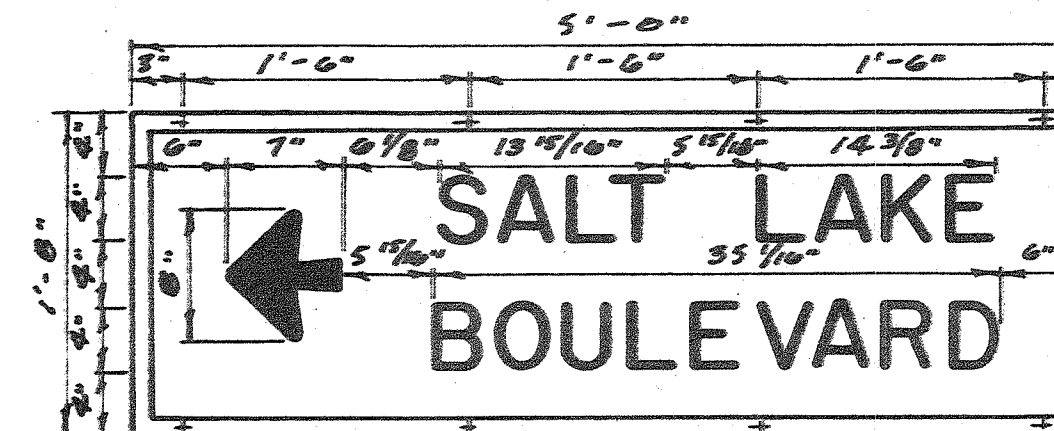

D-52

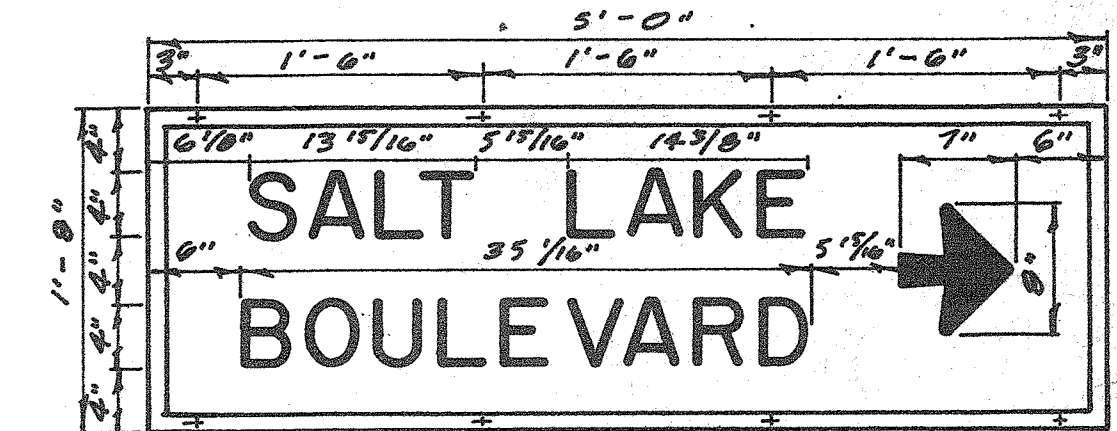

D-53

SURVEY PLOTTED BY	DATE
DRAWN BY	5/10/61
TRACED BY	
QUANTITIES CHECKED BY	
NOTE BOOK No.	


STATE OF HAWAII
DEPARTMENT OF TRANSPORTATION
DIVISION OF HIGHWAYS

DESTINATION SIGNS
ISLAND OF OAHU


SCALE: 1" = 1'-0"

SHEET No. 8 OF 11 SHEETS


A-0001-08-60 (8)

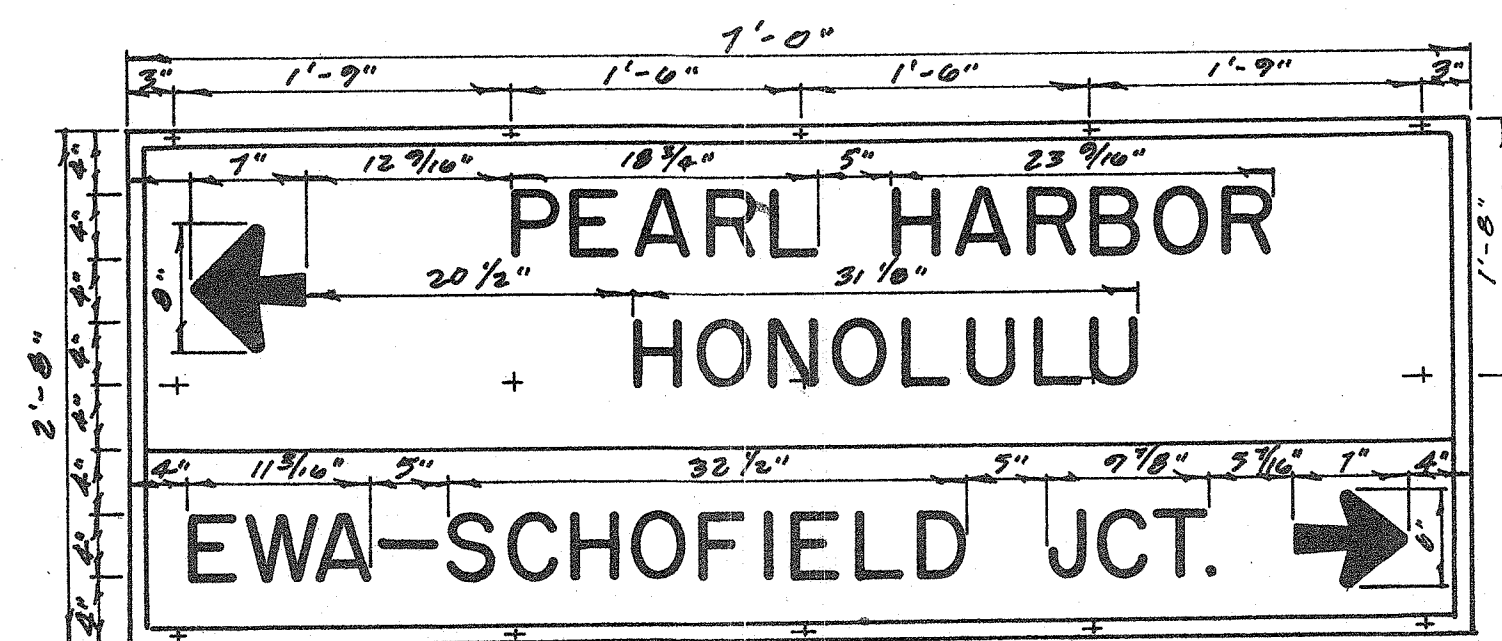


D-54

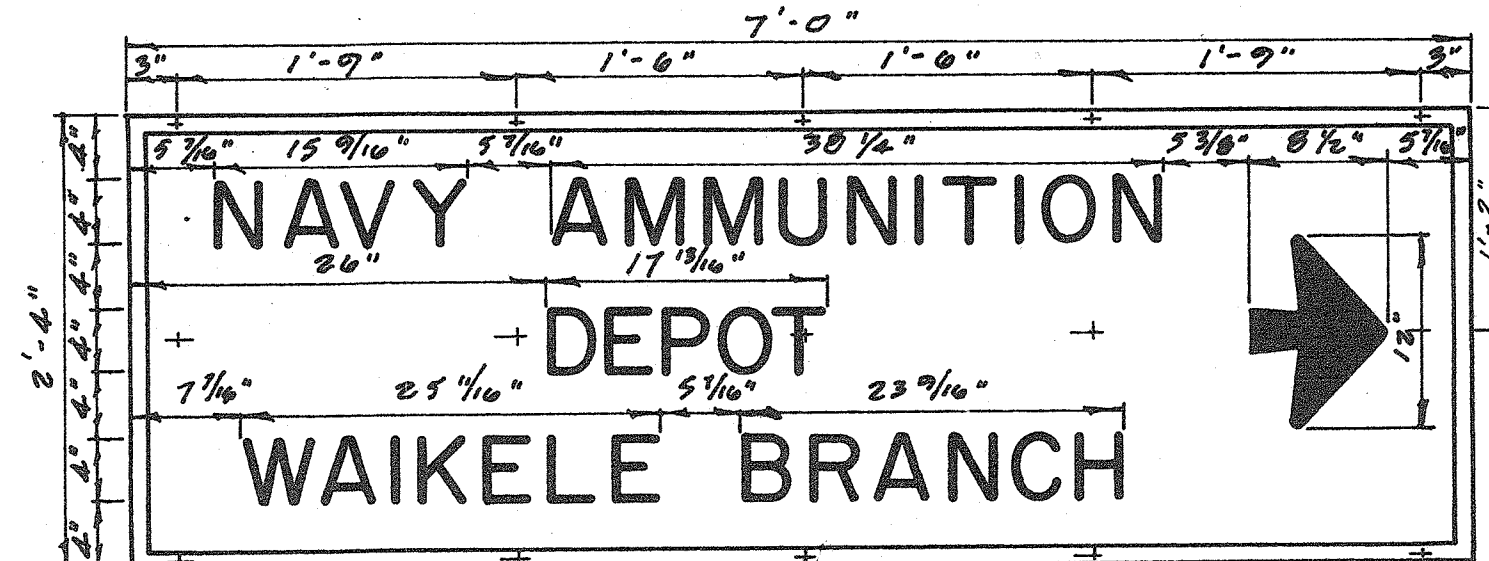


D-55

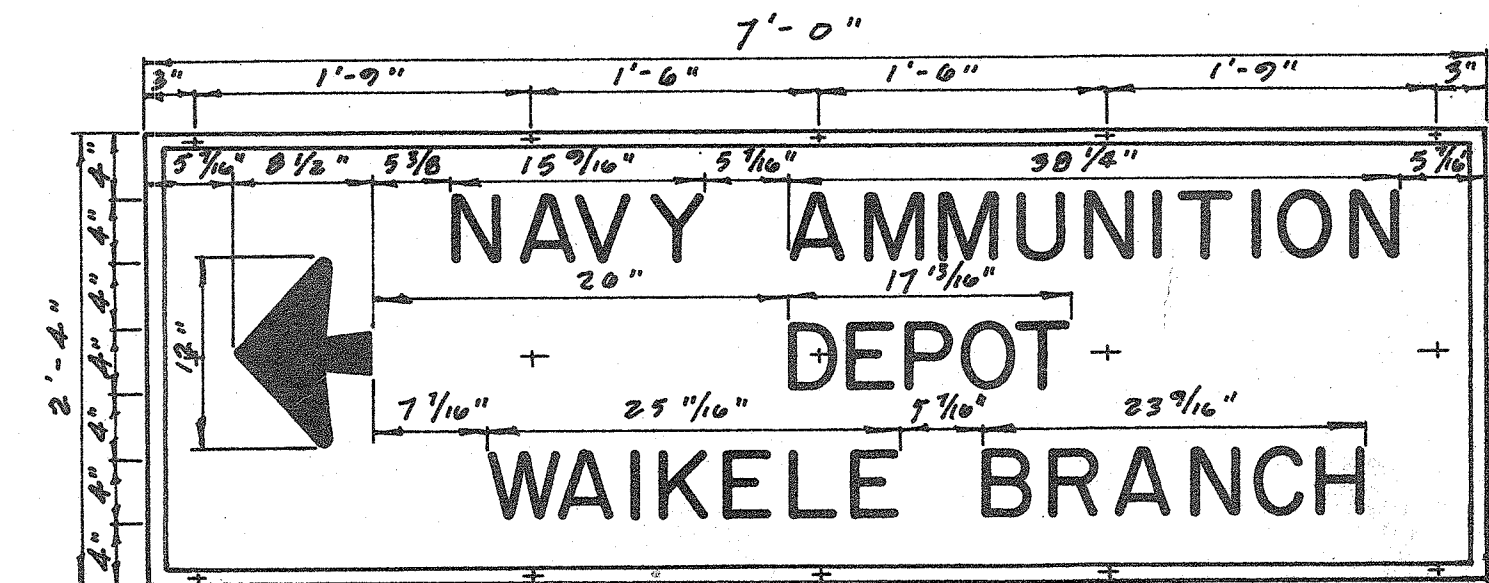


D-56

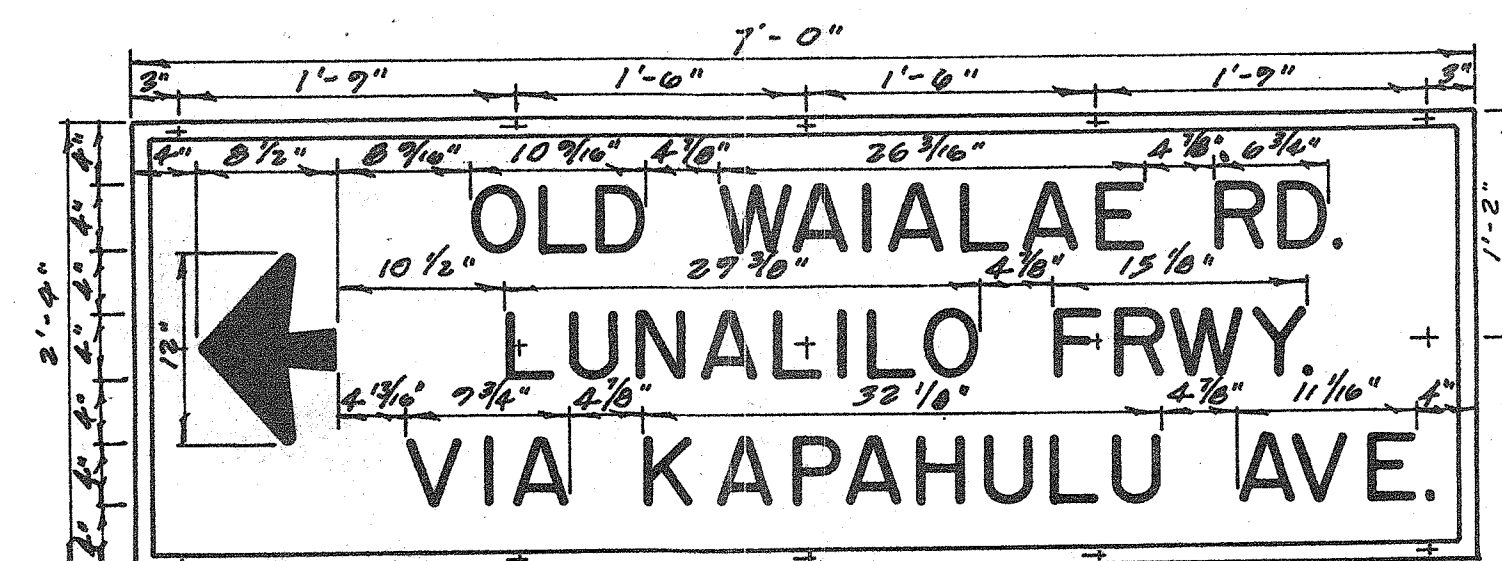


D-57

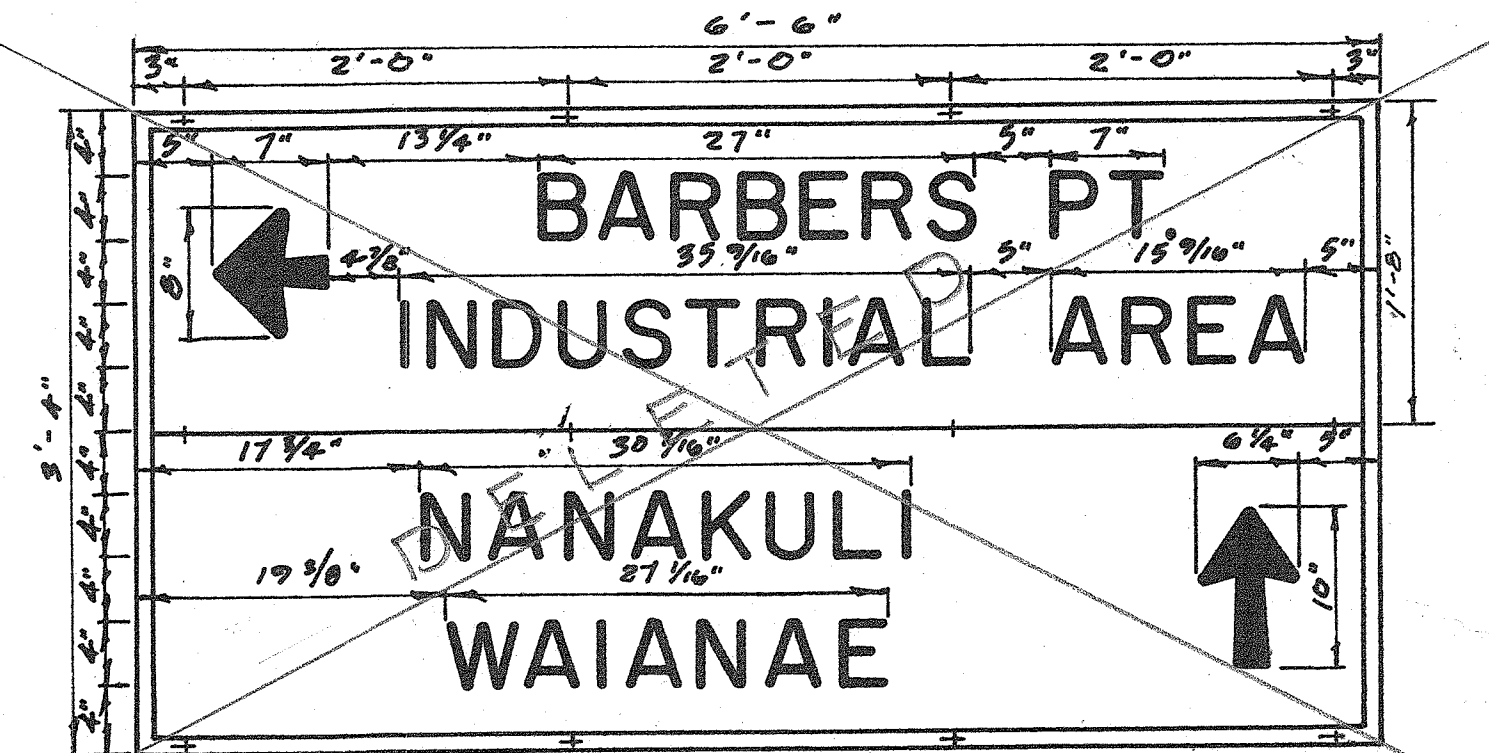


D-58

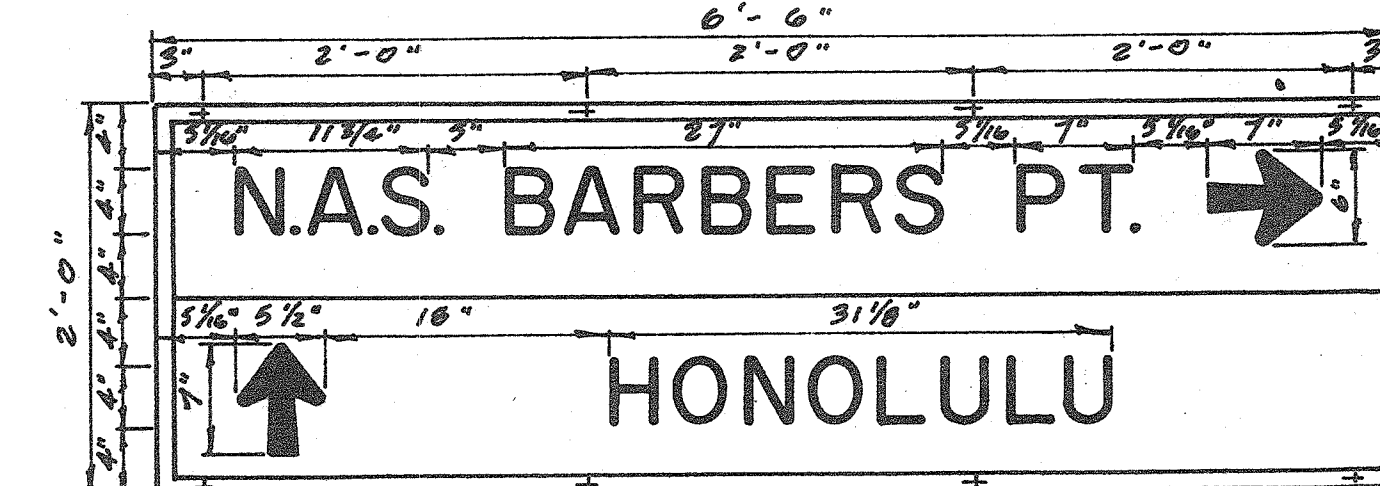


D-59

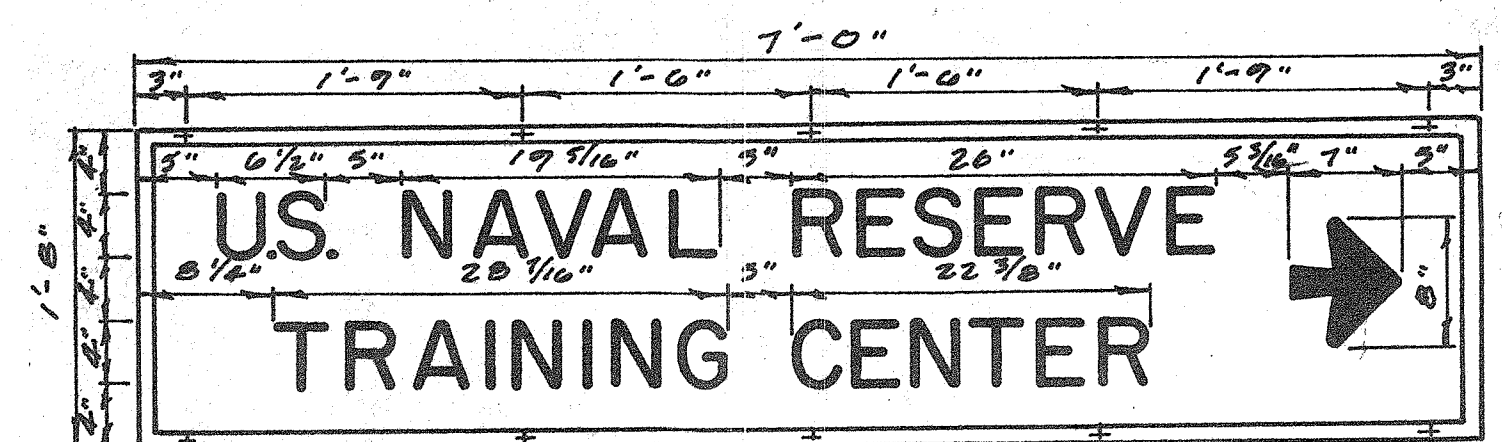


D-60

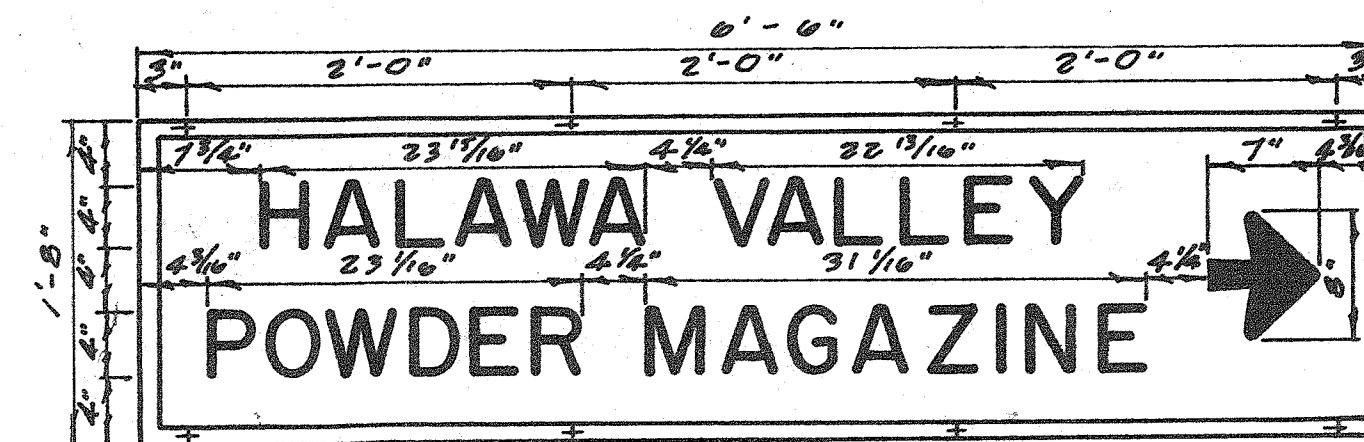


D-61

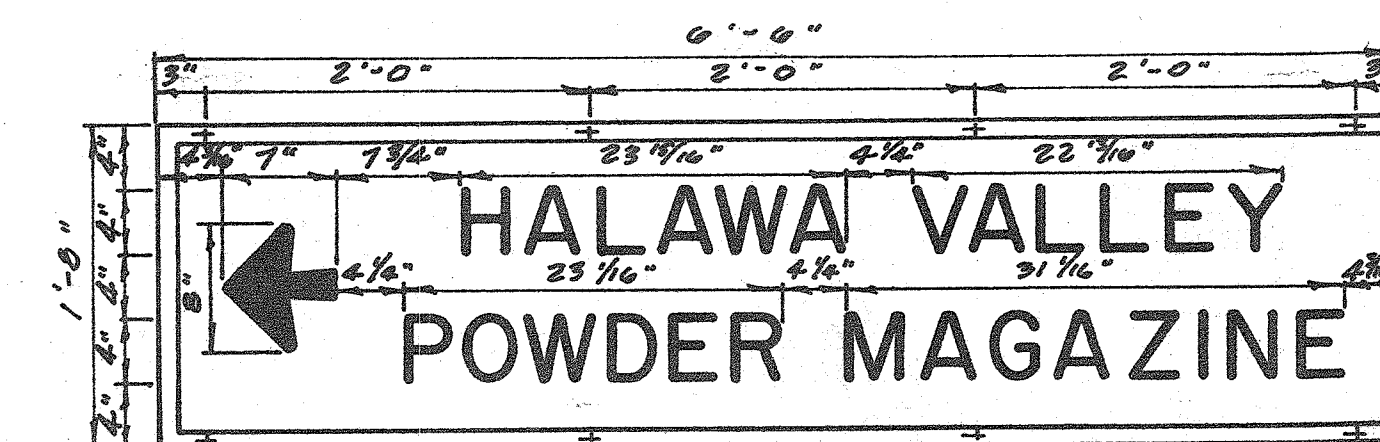


D-62

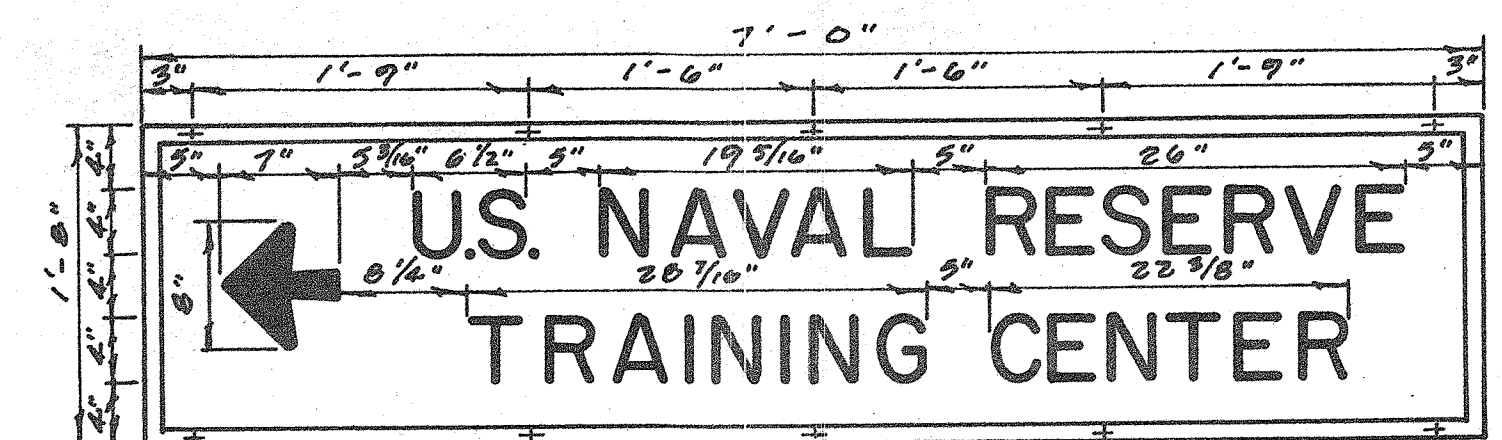


D-63

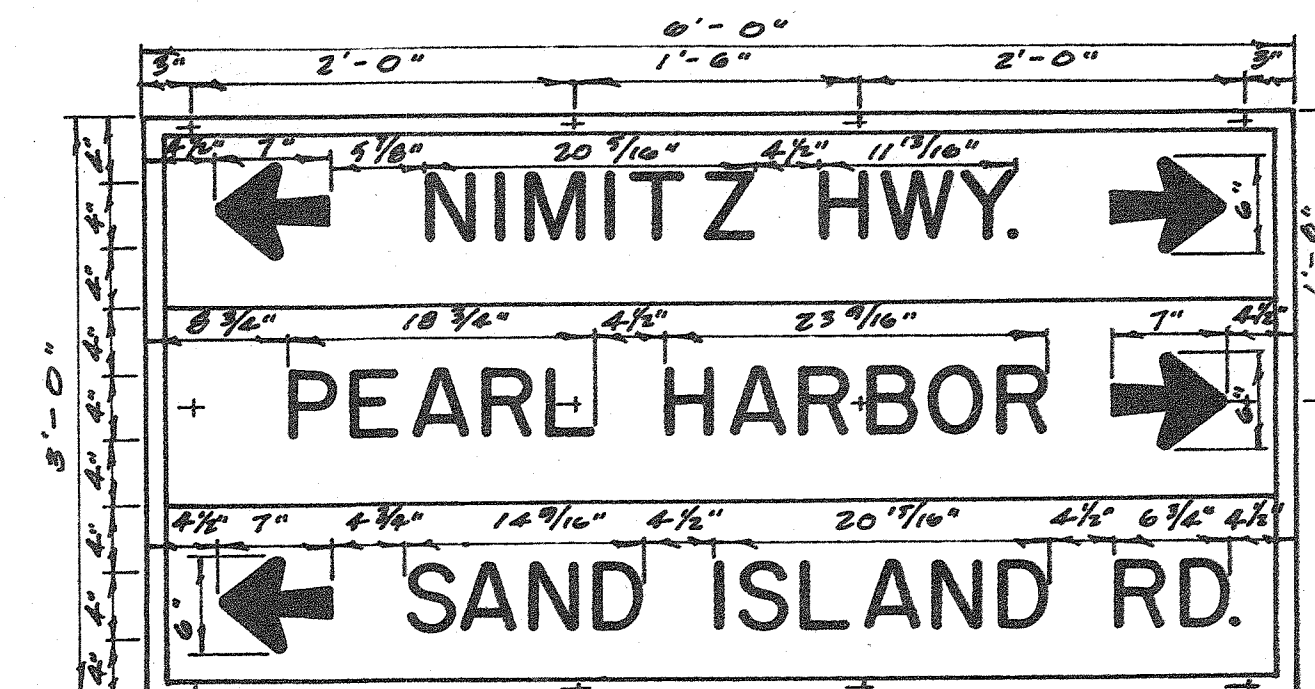

D-64

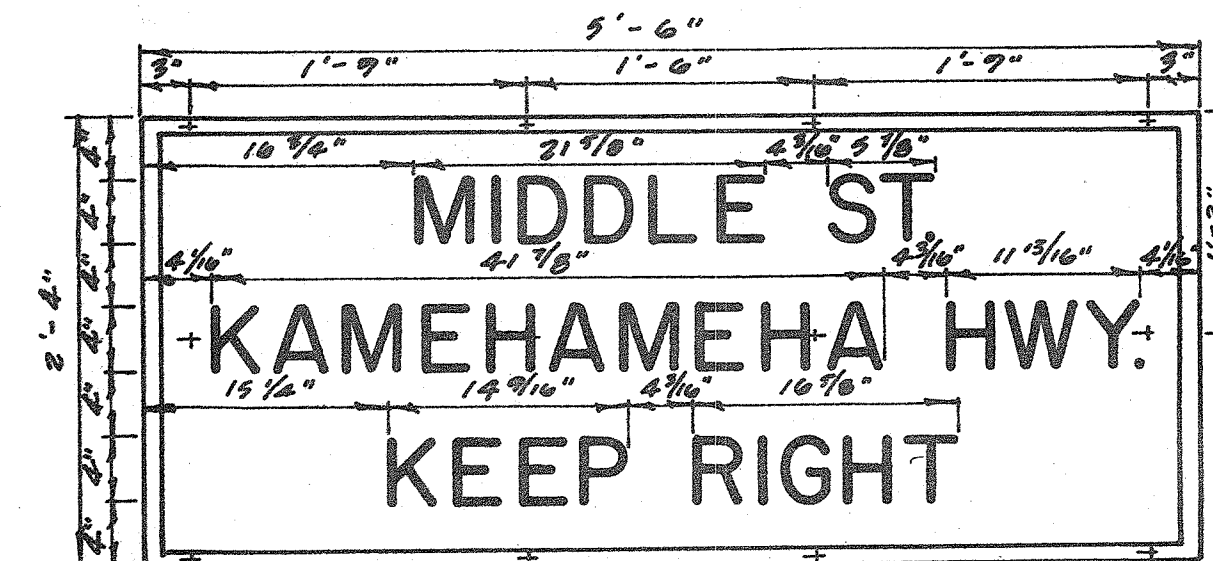

D-65

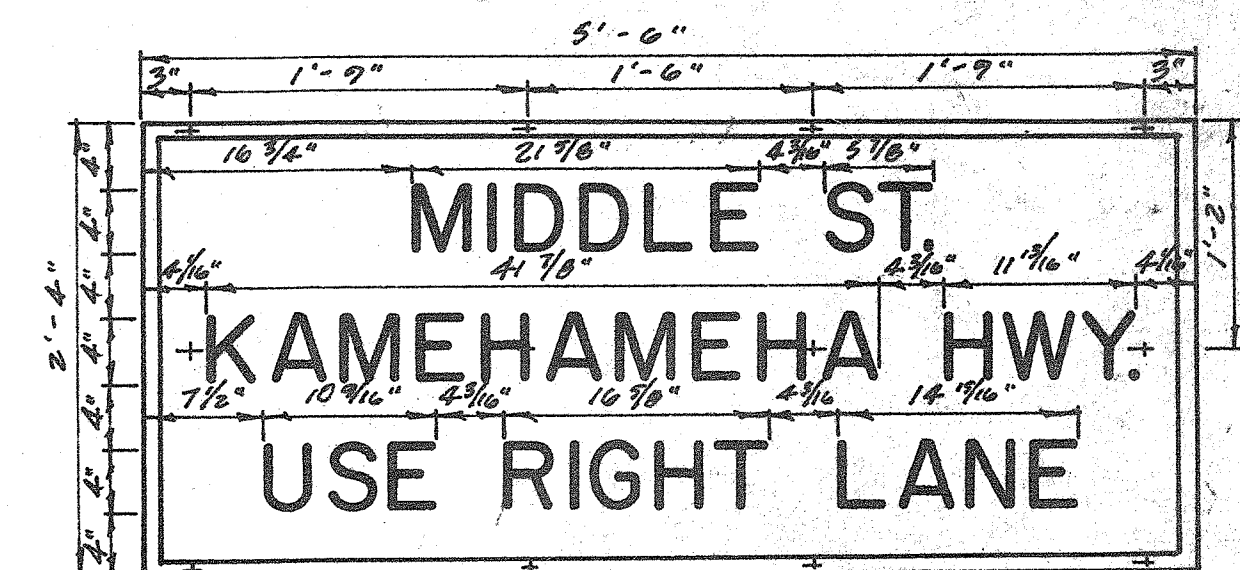

D-66


STATE OF HAWAII
DEPARTMENT OF TRANSPORTATION
DIVISION OF HIGHWAYS

DESTINATION SIGNS
ISLAND OF OAHU


SCALE: 1" = 1'-0"

SHEET NO. 9 OF 11 SHEETS


A-0001-08-60 (9)

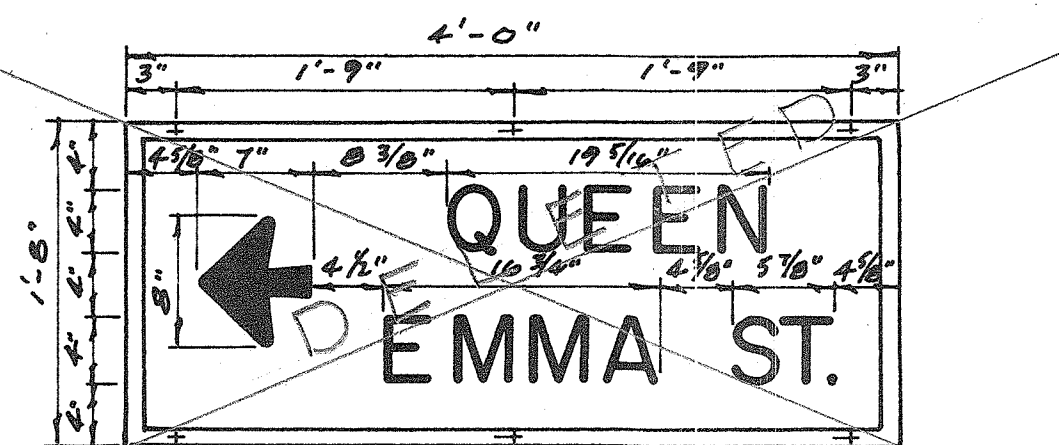


D-67

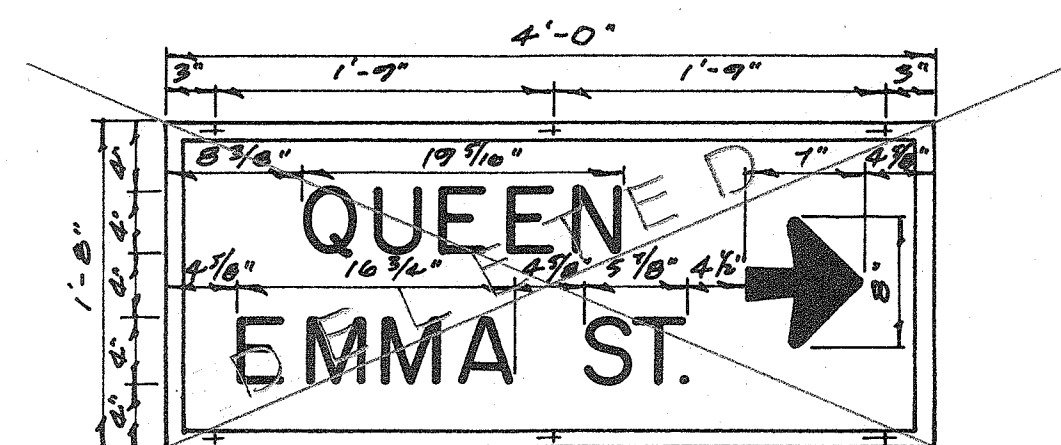


D-68

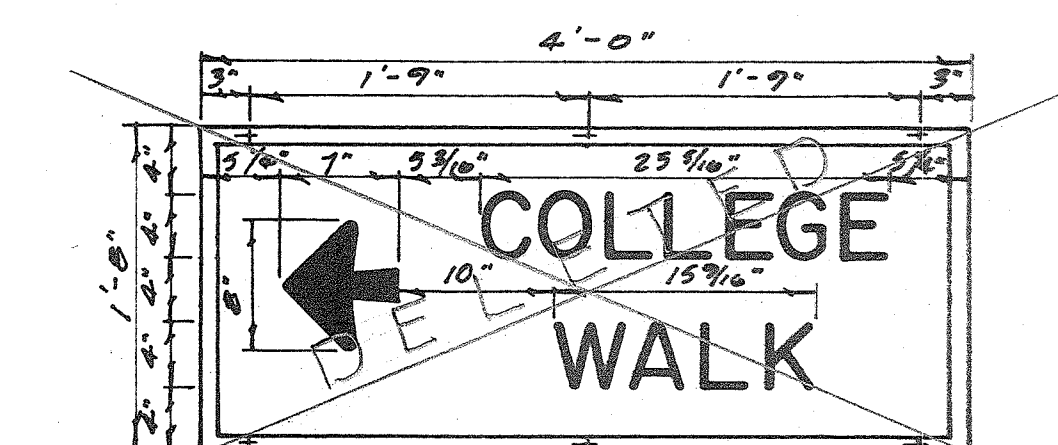


D-69

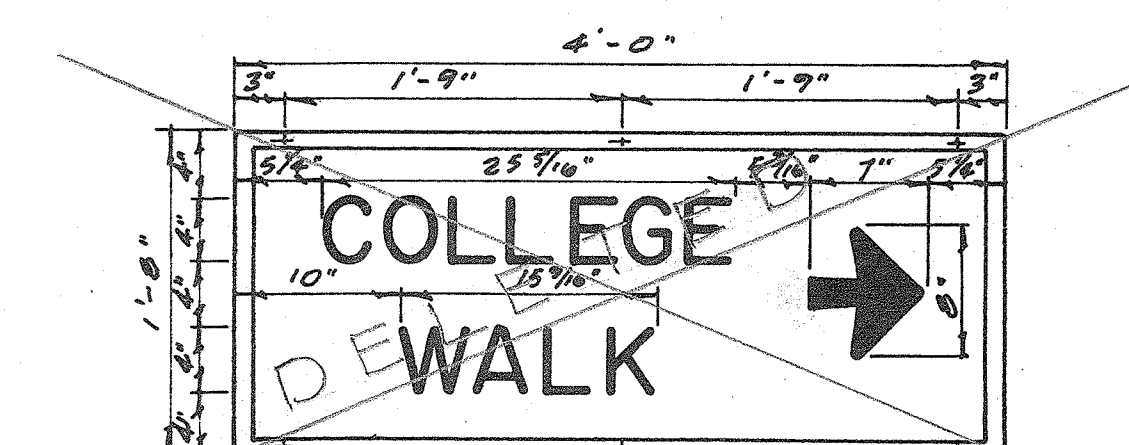


D-70

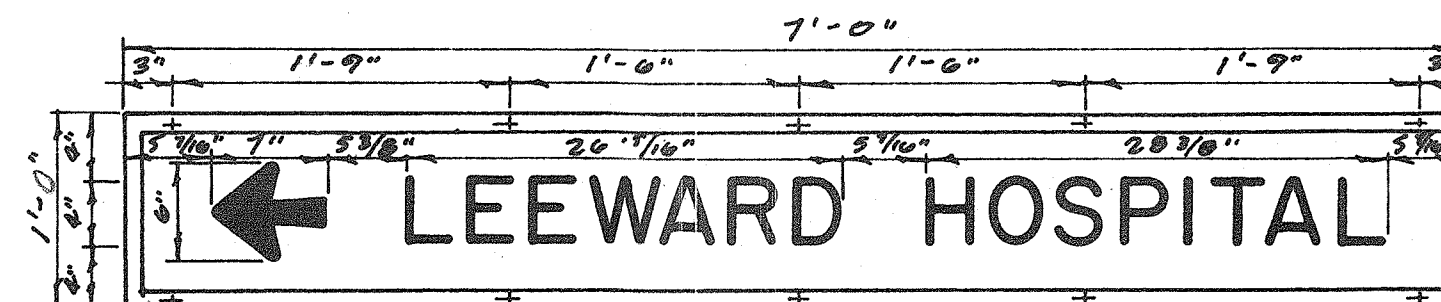


D-71

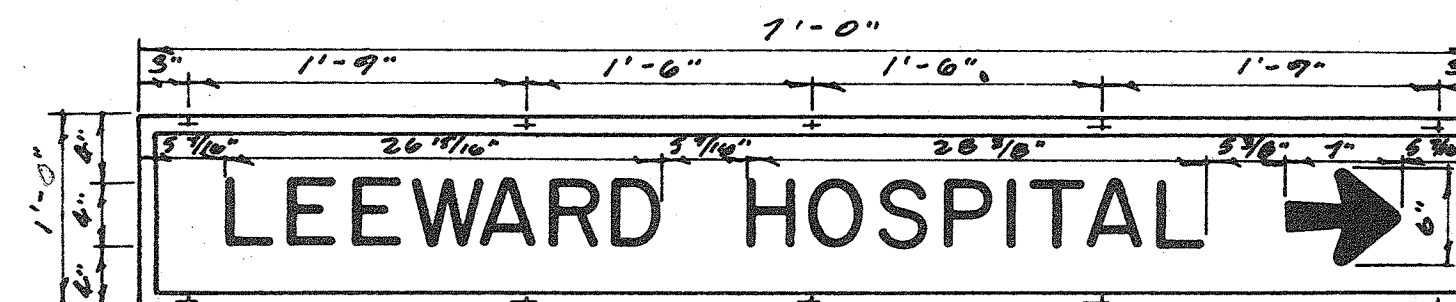


D-72

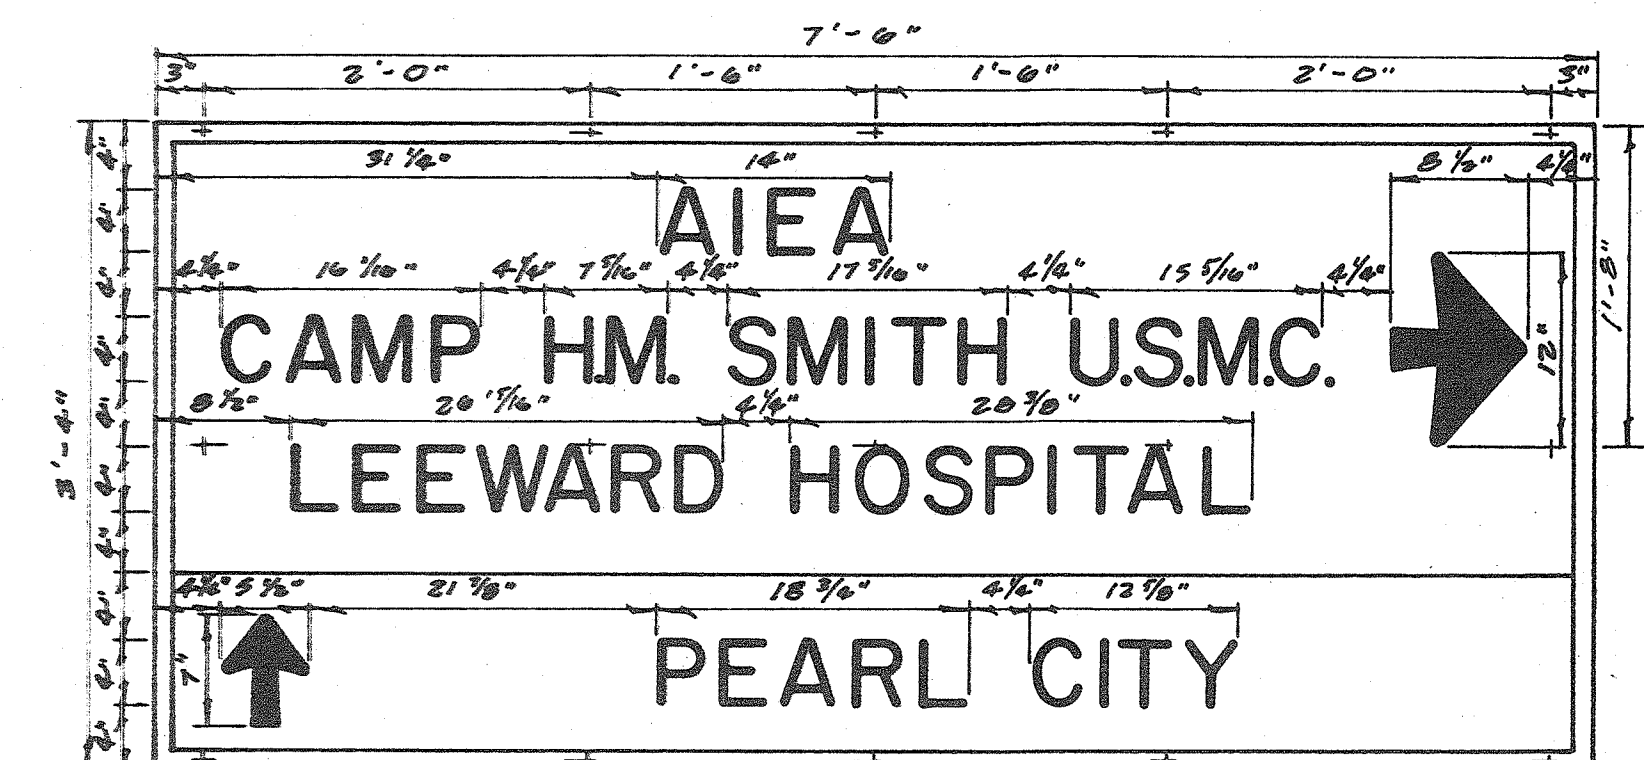


D-73

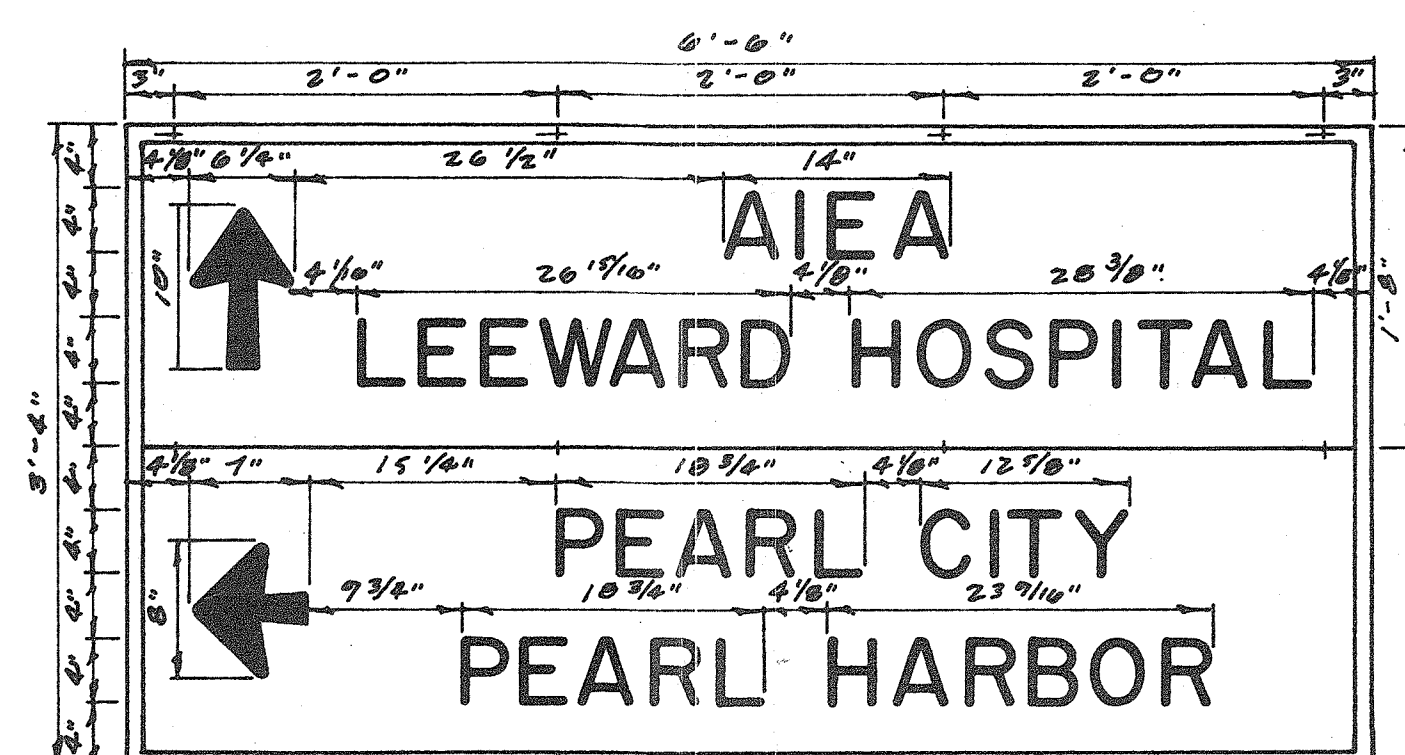


D-74

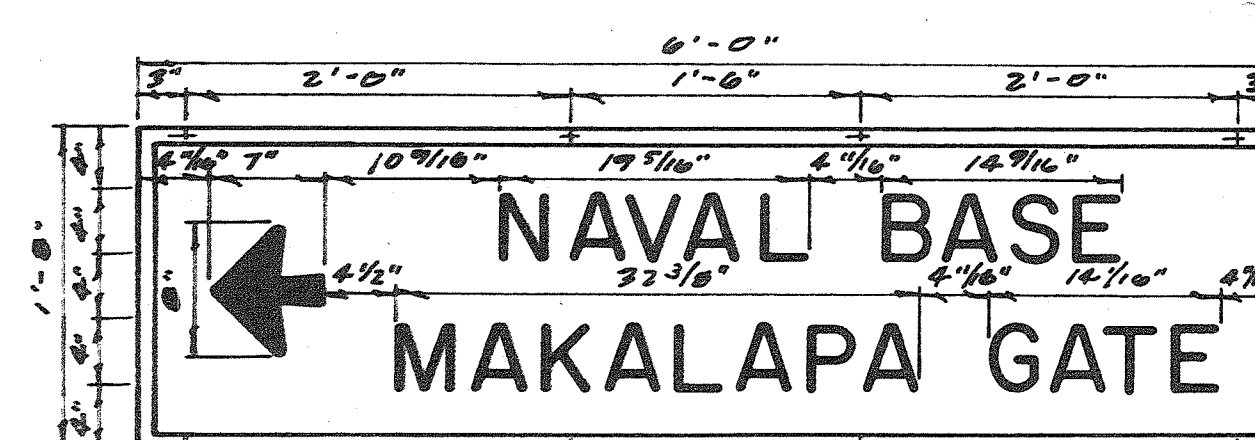


D-75

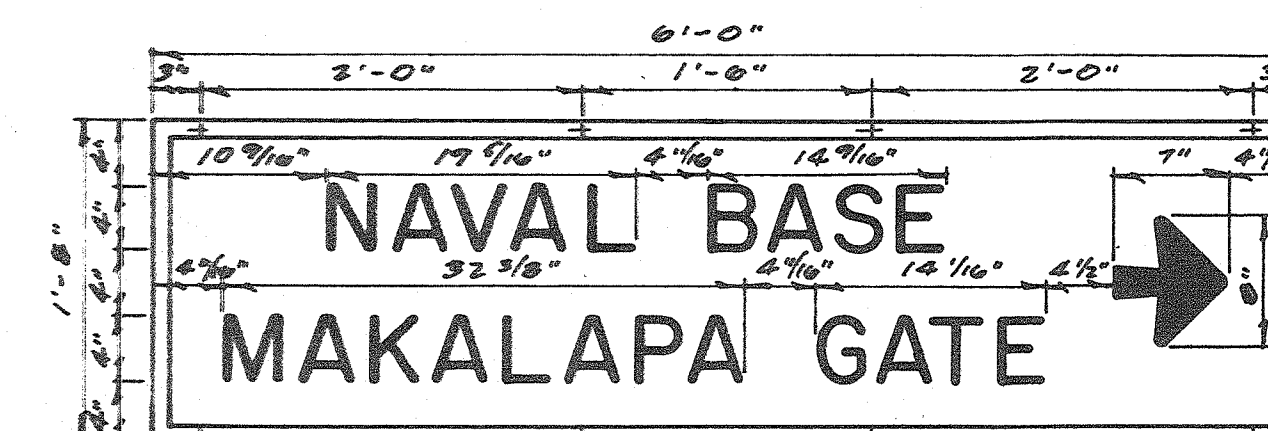


D-76

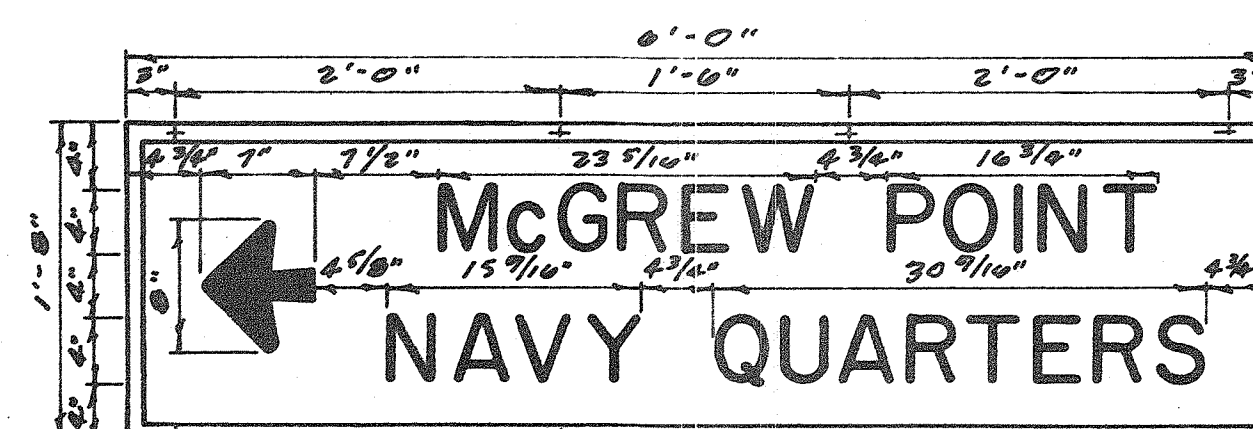

D-77

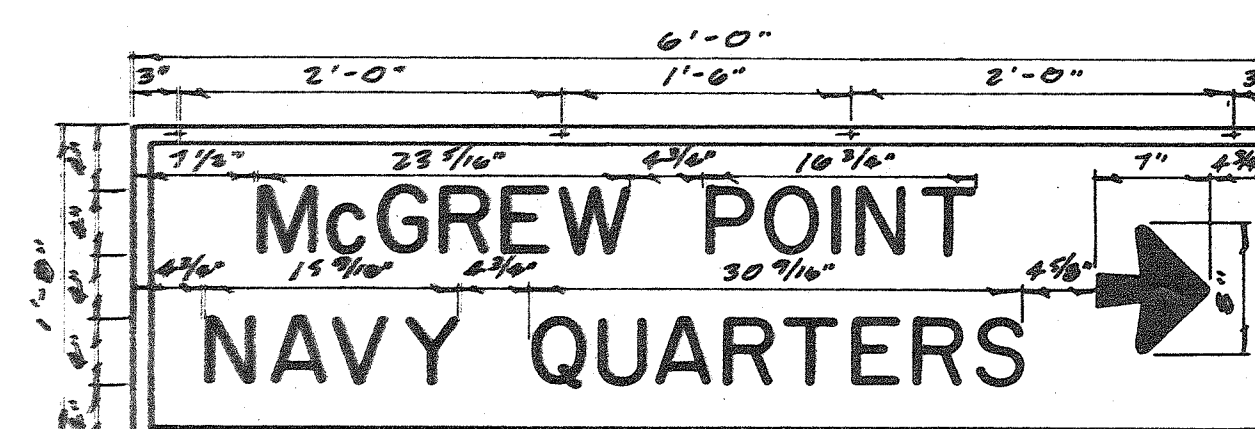

D-78

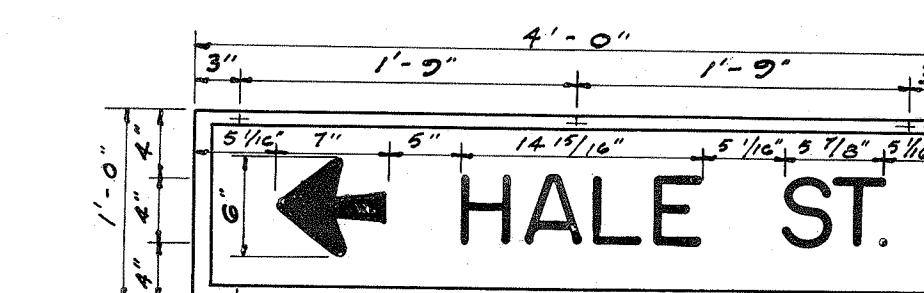

D-97

STATE OF HAWAII
DEPARTMENT OF TRANSPORTATION
DIVISION OF HIGHWAYS

DESTINATION SIGNS
ISLAND OF OAHU


SCALE: 1" = 1'-0"

SHEET NO. 10 OF 11 SHEETS


A-0001-08-60 (10)

ORIGINAL PLAN	DATE
DESIGNED BY	2/68
TRACED BY	
QUANTITIES BY	
CHECKED BY	
NOTE BOOK NO.	


FED. ROAD DIST. NO.	STATE	FED. AID PROJ. NO.	FISCAL YEAR	SHEET NO.	TOTAL SHEETS
0444	HAW.	1000000	1961	11	11

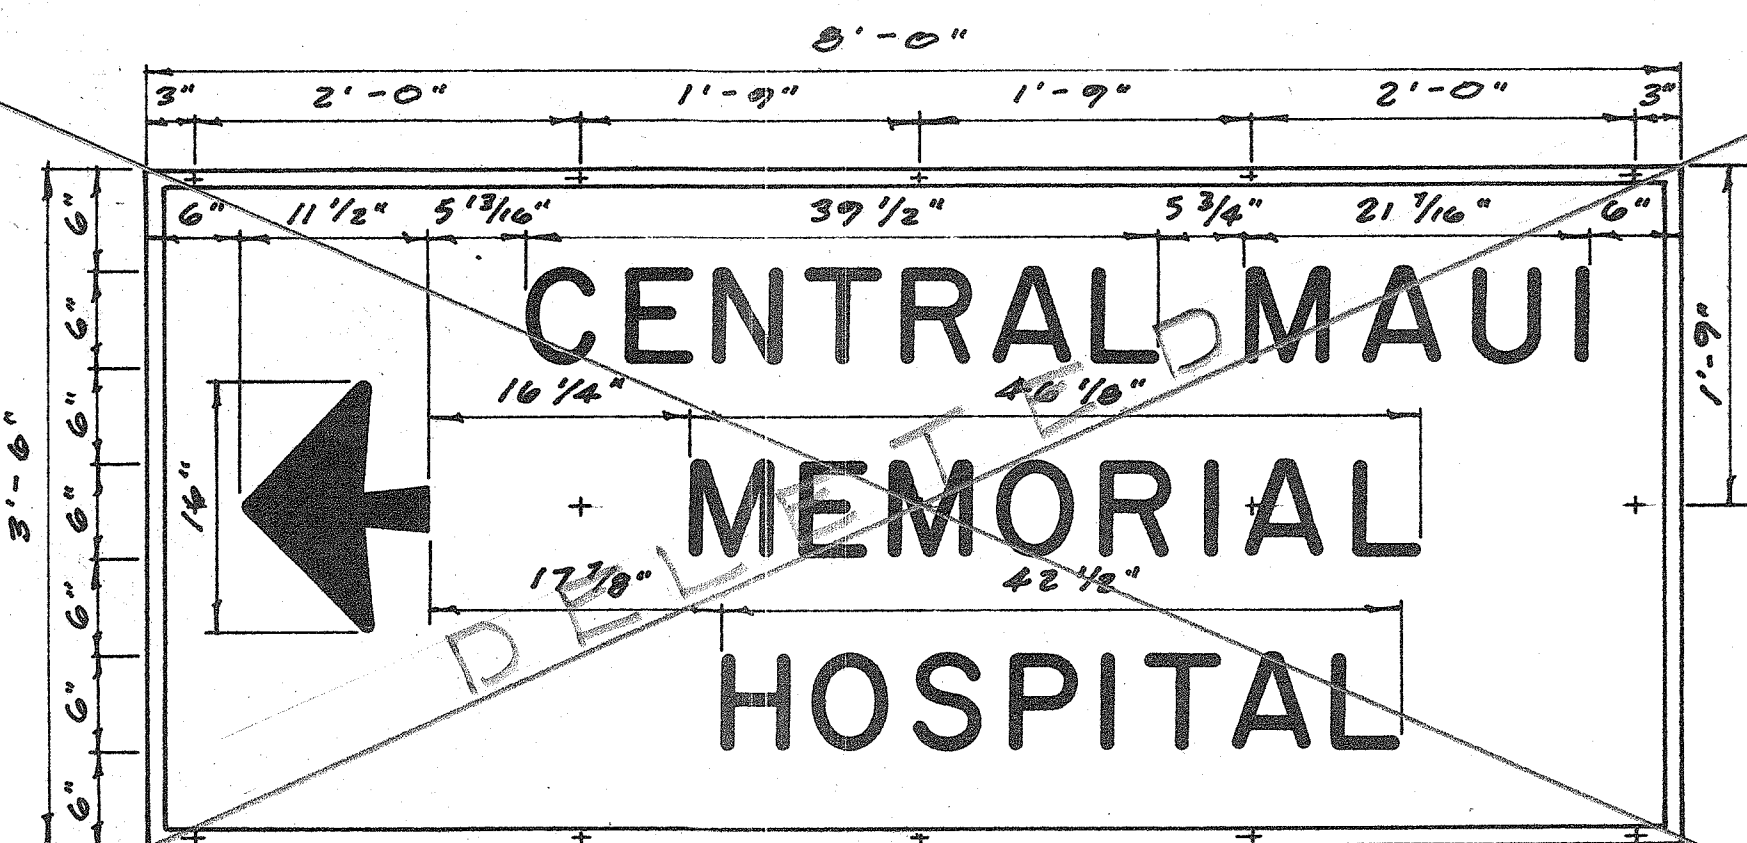


DM-1

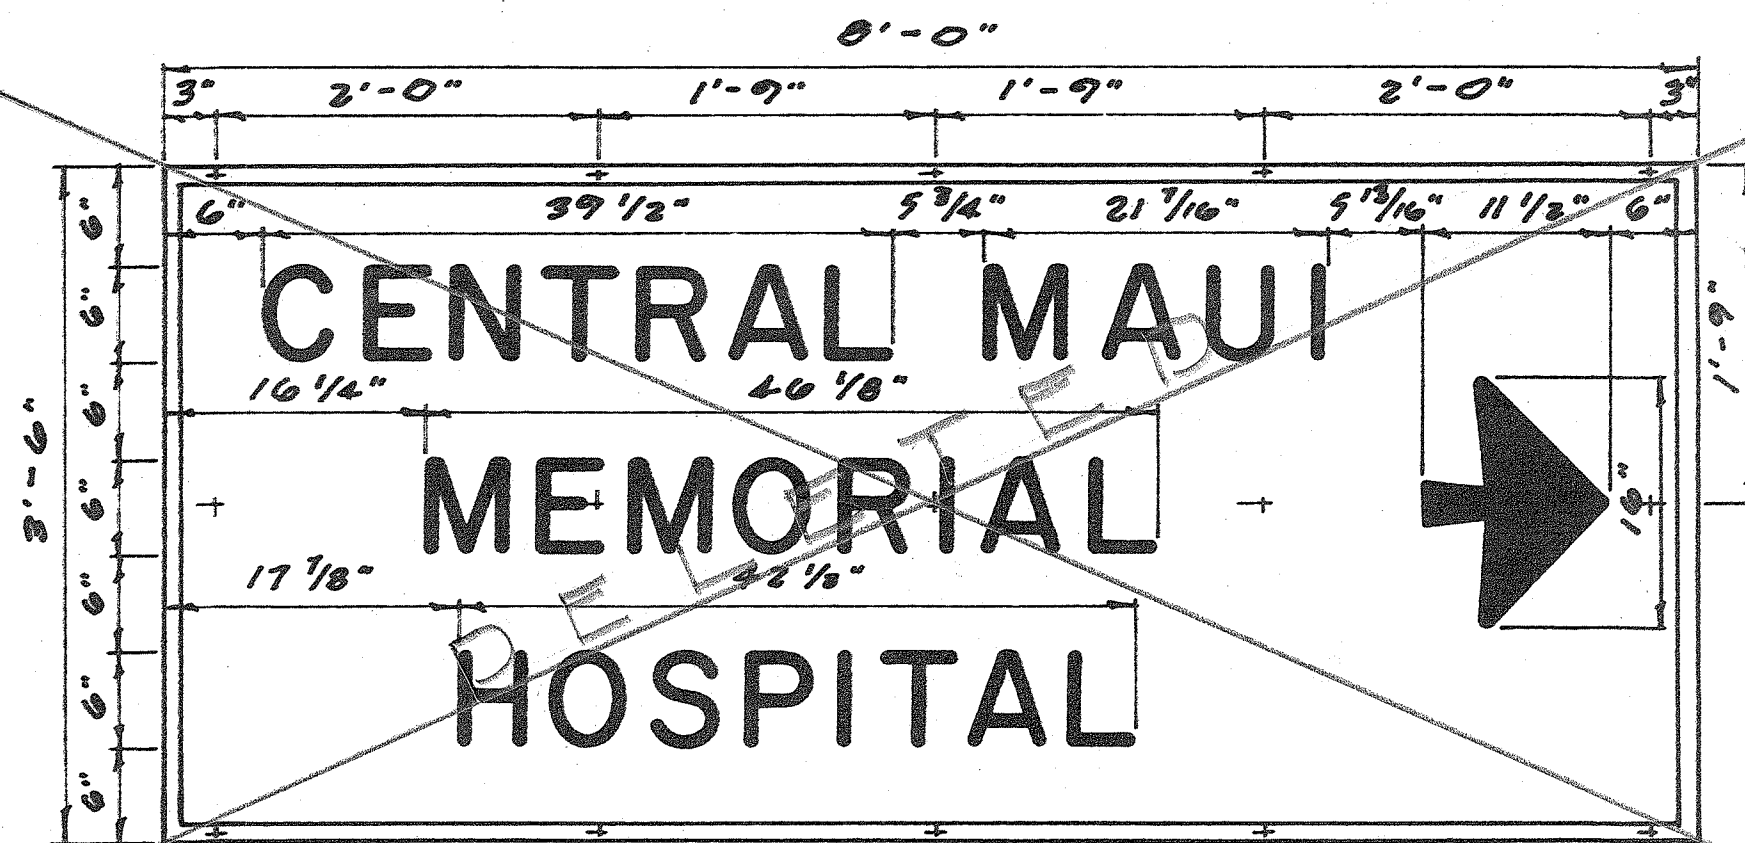


DM-2

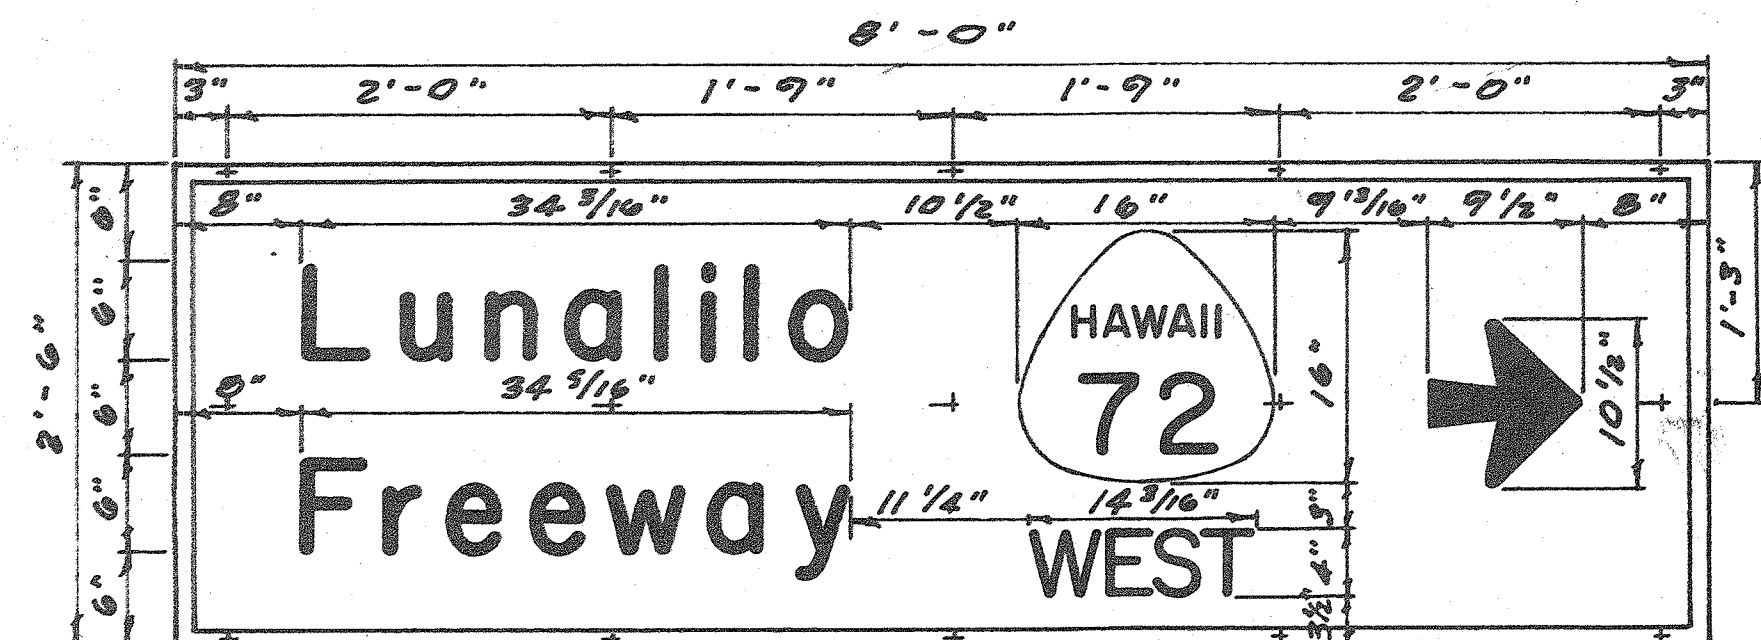


D-98,99,100,101,102
103,104, & 105

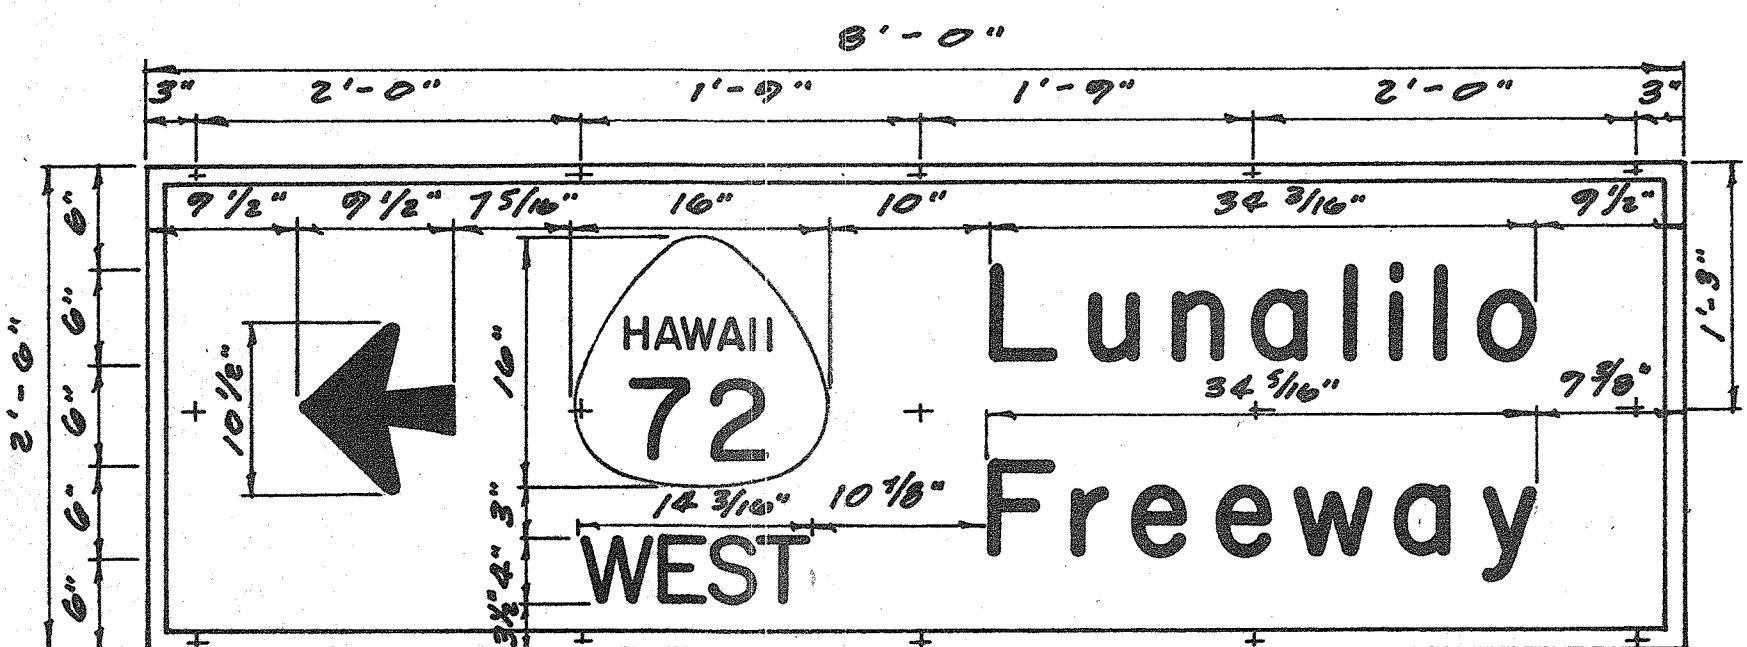


D-106

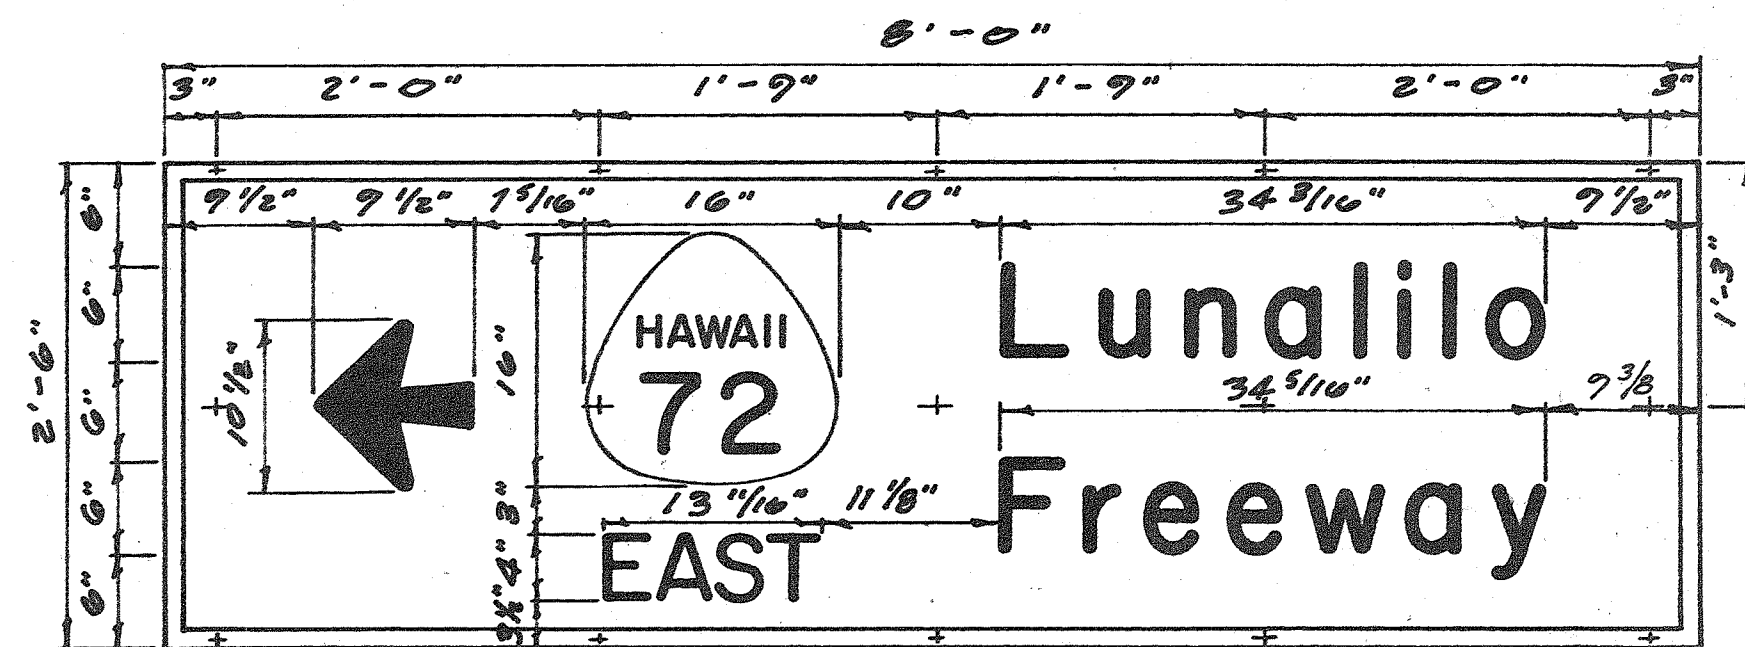


D-109, & 110

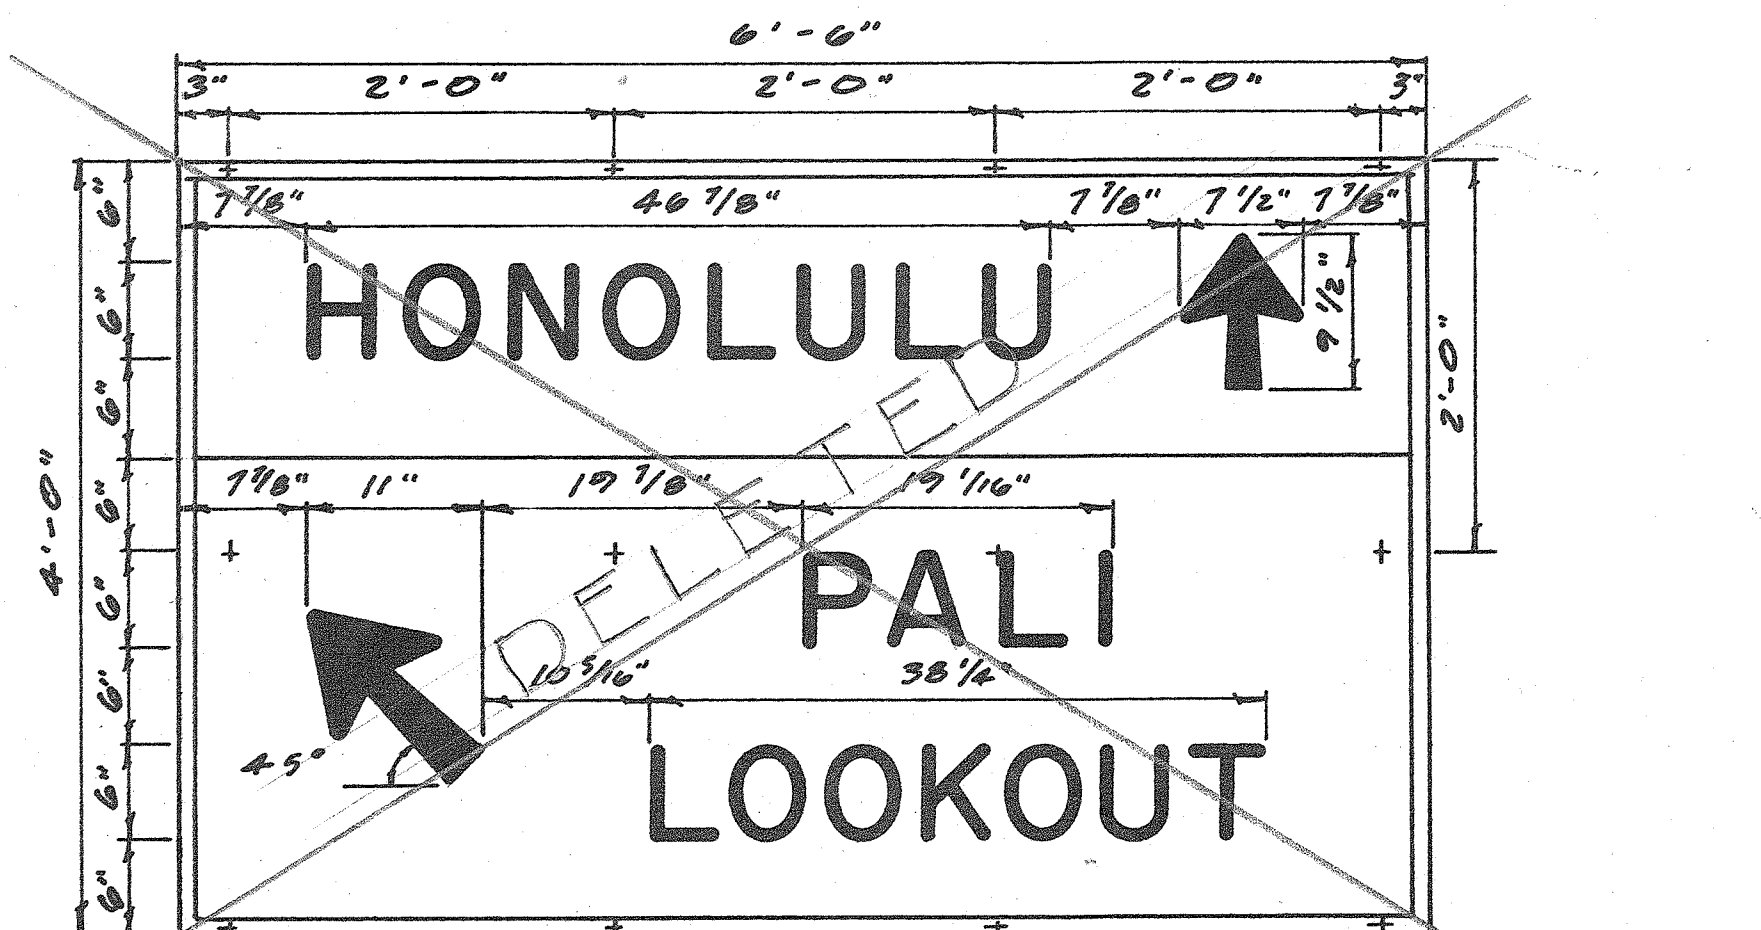


D-III

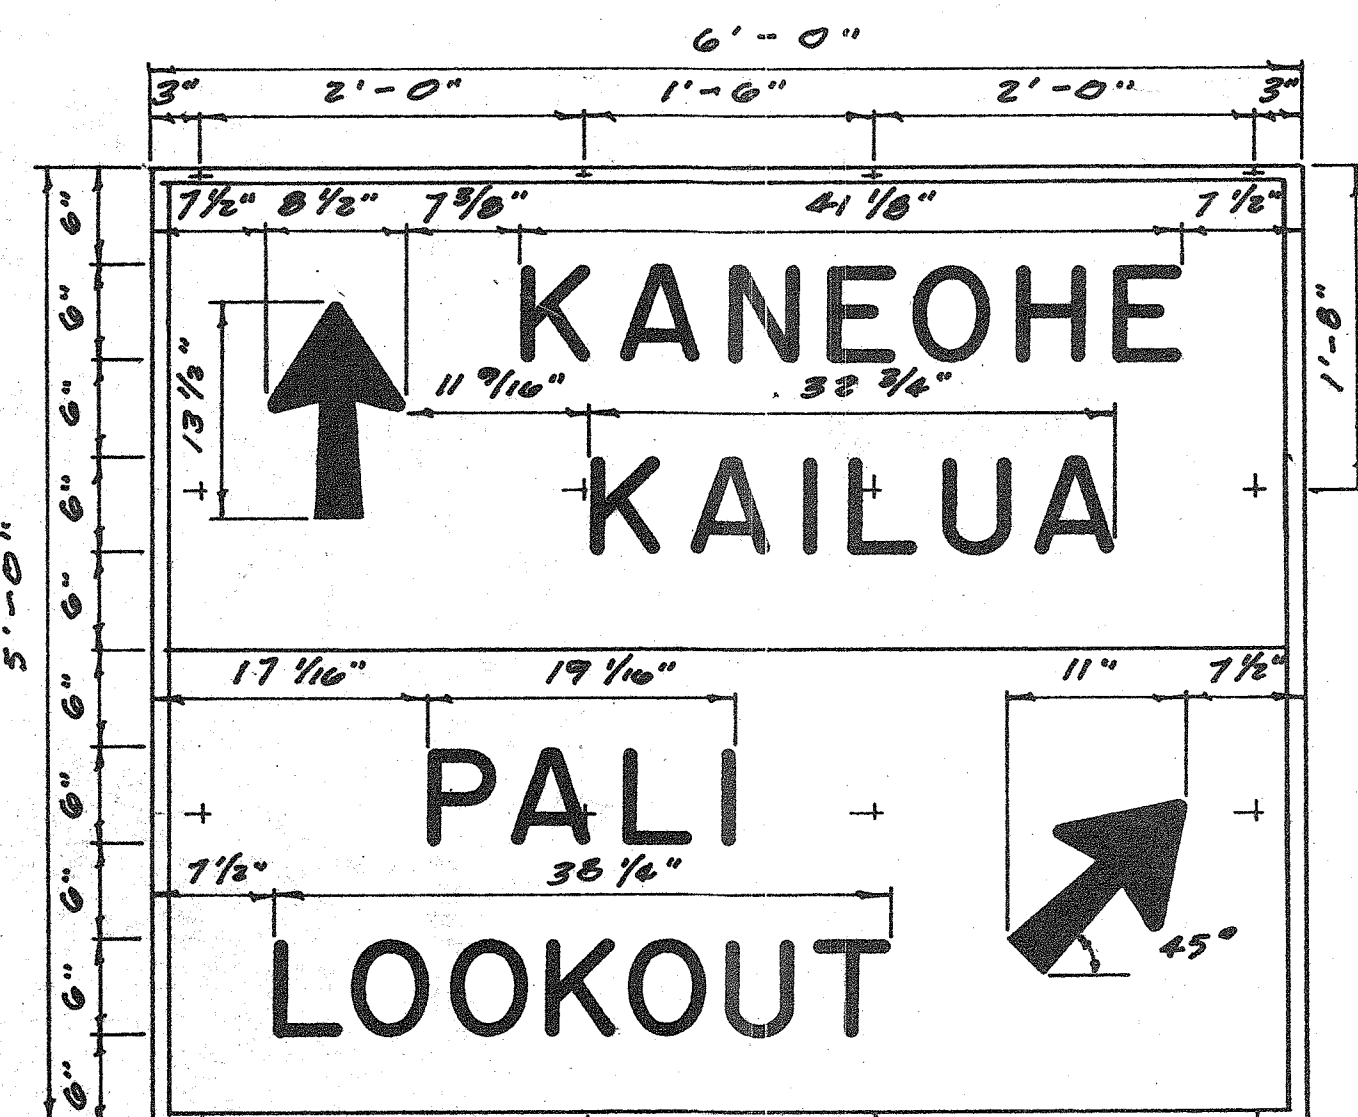


D-112

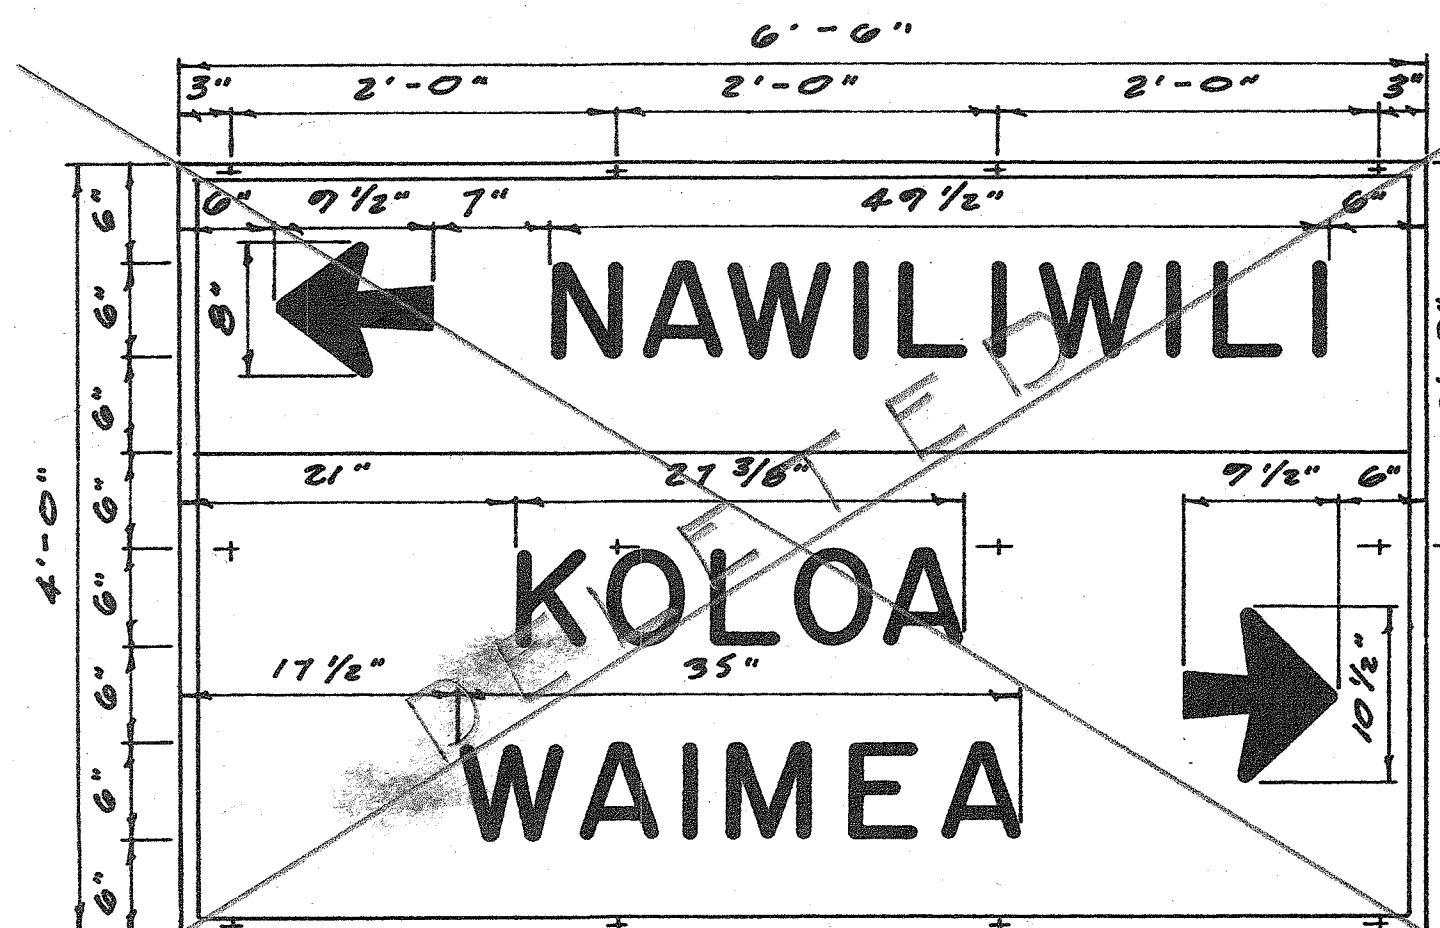

DK-1

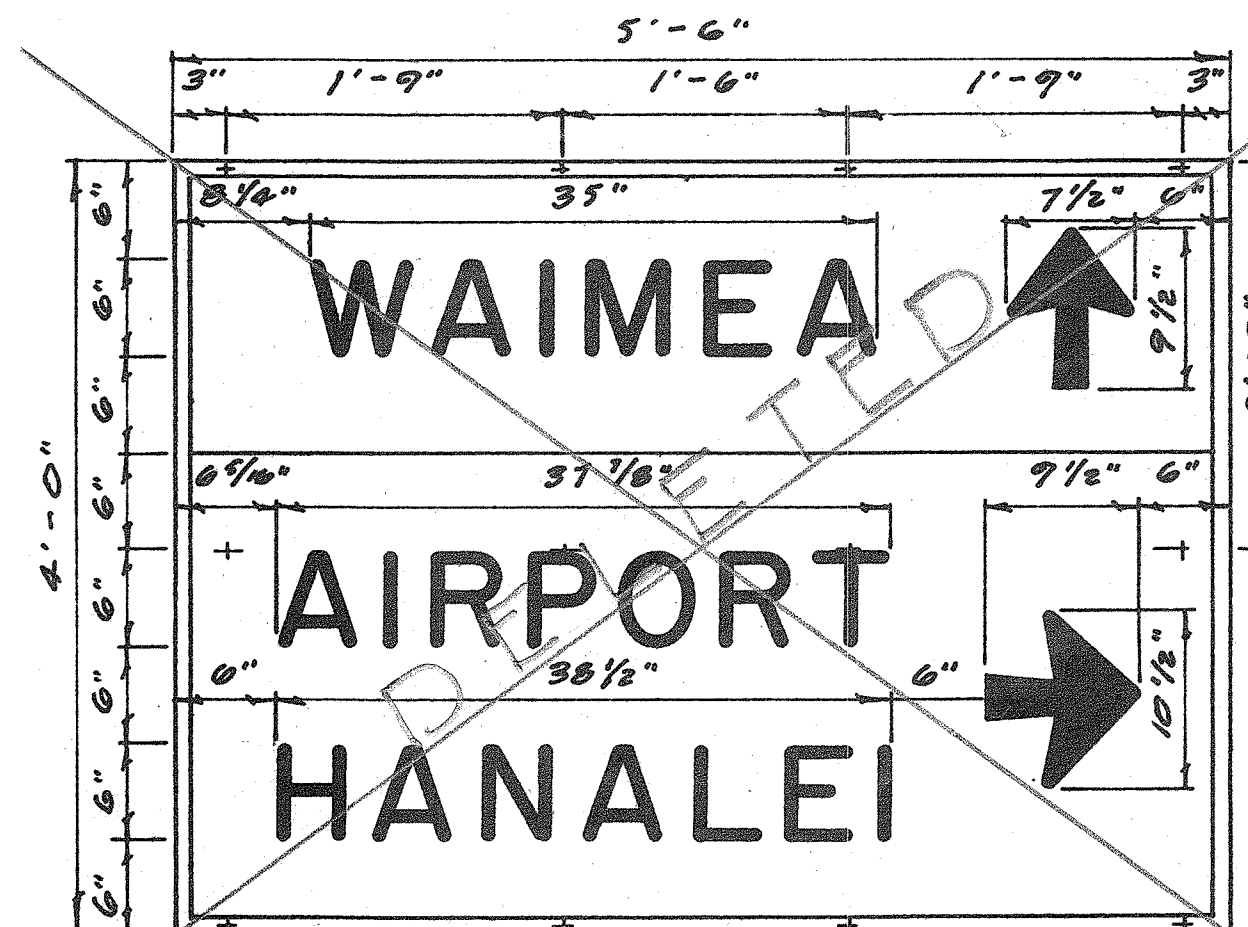

DK-2

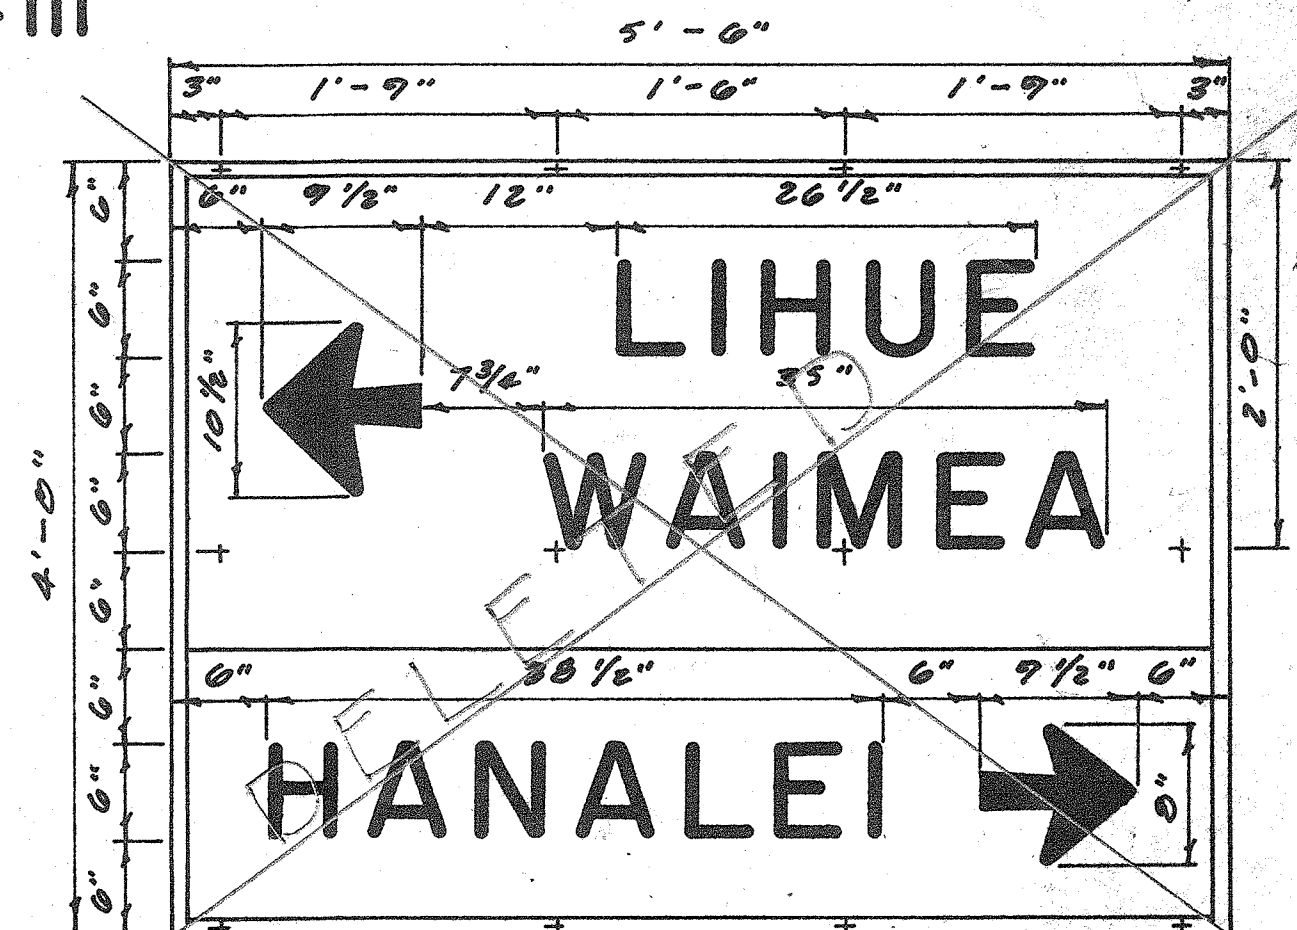

DK-3

STATE OF HAWAII
DEPARTMENT OF TRANSPORTATION
DIVISION OF HIGHWAYS
DESTINATION SIGNS
ISLAND OF OAHU
MAUI, AND KAUAI
SCALE: 1" = 1'-0"

SHEET No. 11 OF 11 SHEETS

A-0001-08-60 (11)

SURVEY PLOTTED BY	DATE
DRAWN BY	5/60
TRACED BY	
QUANTITIES CHECKED BY	
NOTE BOOK	
NO.	