

INDEX TO DRAWINGS	
SHEET NO.	DESCRIPTION
1	TITLE SHEET
2	TYPICAL SECTIONS AND MISC. DETAILS
3-4	PLAN AND PROFILE
5	DETAILS OF DETOURS
6-7	MAINT. ROAD AND NAVY UTILITY TUNNEL EXTENSION
8	RELOCATION OF CATHODIC PROTECTION
9-14	STANDARD DETAILS
15	HONOLULU GAS COMPANY
16-17	SEWER SYSTEM
18-19	EXISTING UTILITIES
20-34	AIEA INTERCHANGE STRUCTURE NO. 2
35-38	STANDARD BRIDGE DETAILS
39-41	TRAFFIC SIGNS, LANDSCAPING, AND SPRINKLER SYSTEM
42-50	DESTINATION AND EXPRESSWAY SIGNS DETAIL
51-55	HIGHWAY LIGHTING SYSTEM
56-58	CROSS SECTIONS


STATE OF HAWAII
DEPARTMENT OF TRANSPORTATION
HIGHWAYS DIVISION

"AS BUILT" PLANS OF
KAMEHAMEHA HIGHWAY
AIEA INTERCHANGE
FEDERAL AID PROJECT NO. F-090-1(10)

DISTRICT OF EWA
ISLAND OF OAHU

SCALES

PLAN ----- 1 INCH = 50 FT.
 PROFILE ----- HOR. 1 INCH = 50 FT.
 VER. 1 INCH = 5 FT.
 CROSS SECTION ----- HOR. 1 INCH = 10 FT.
 VER. 1 INCH = 10 FT.

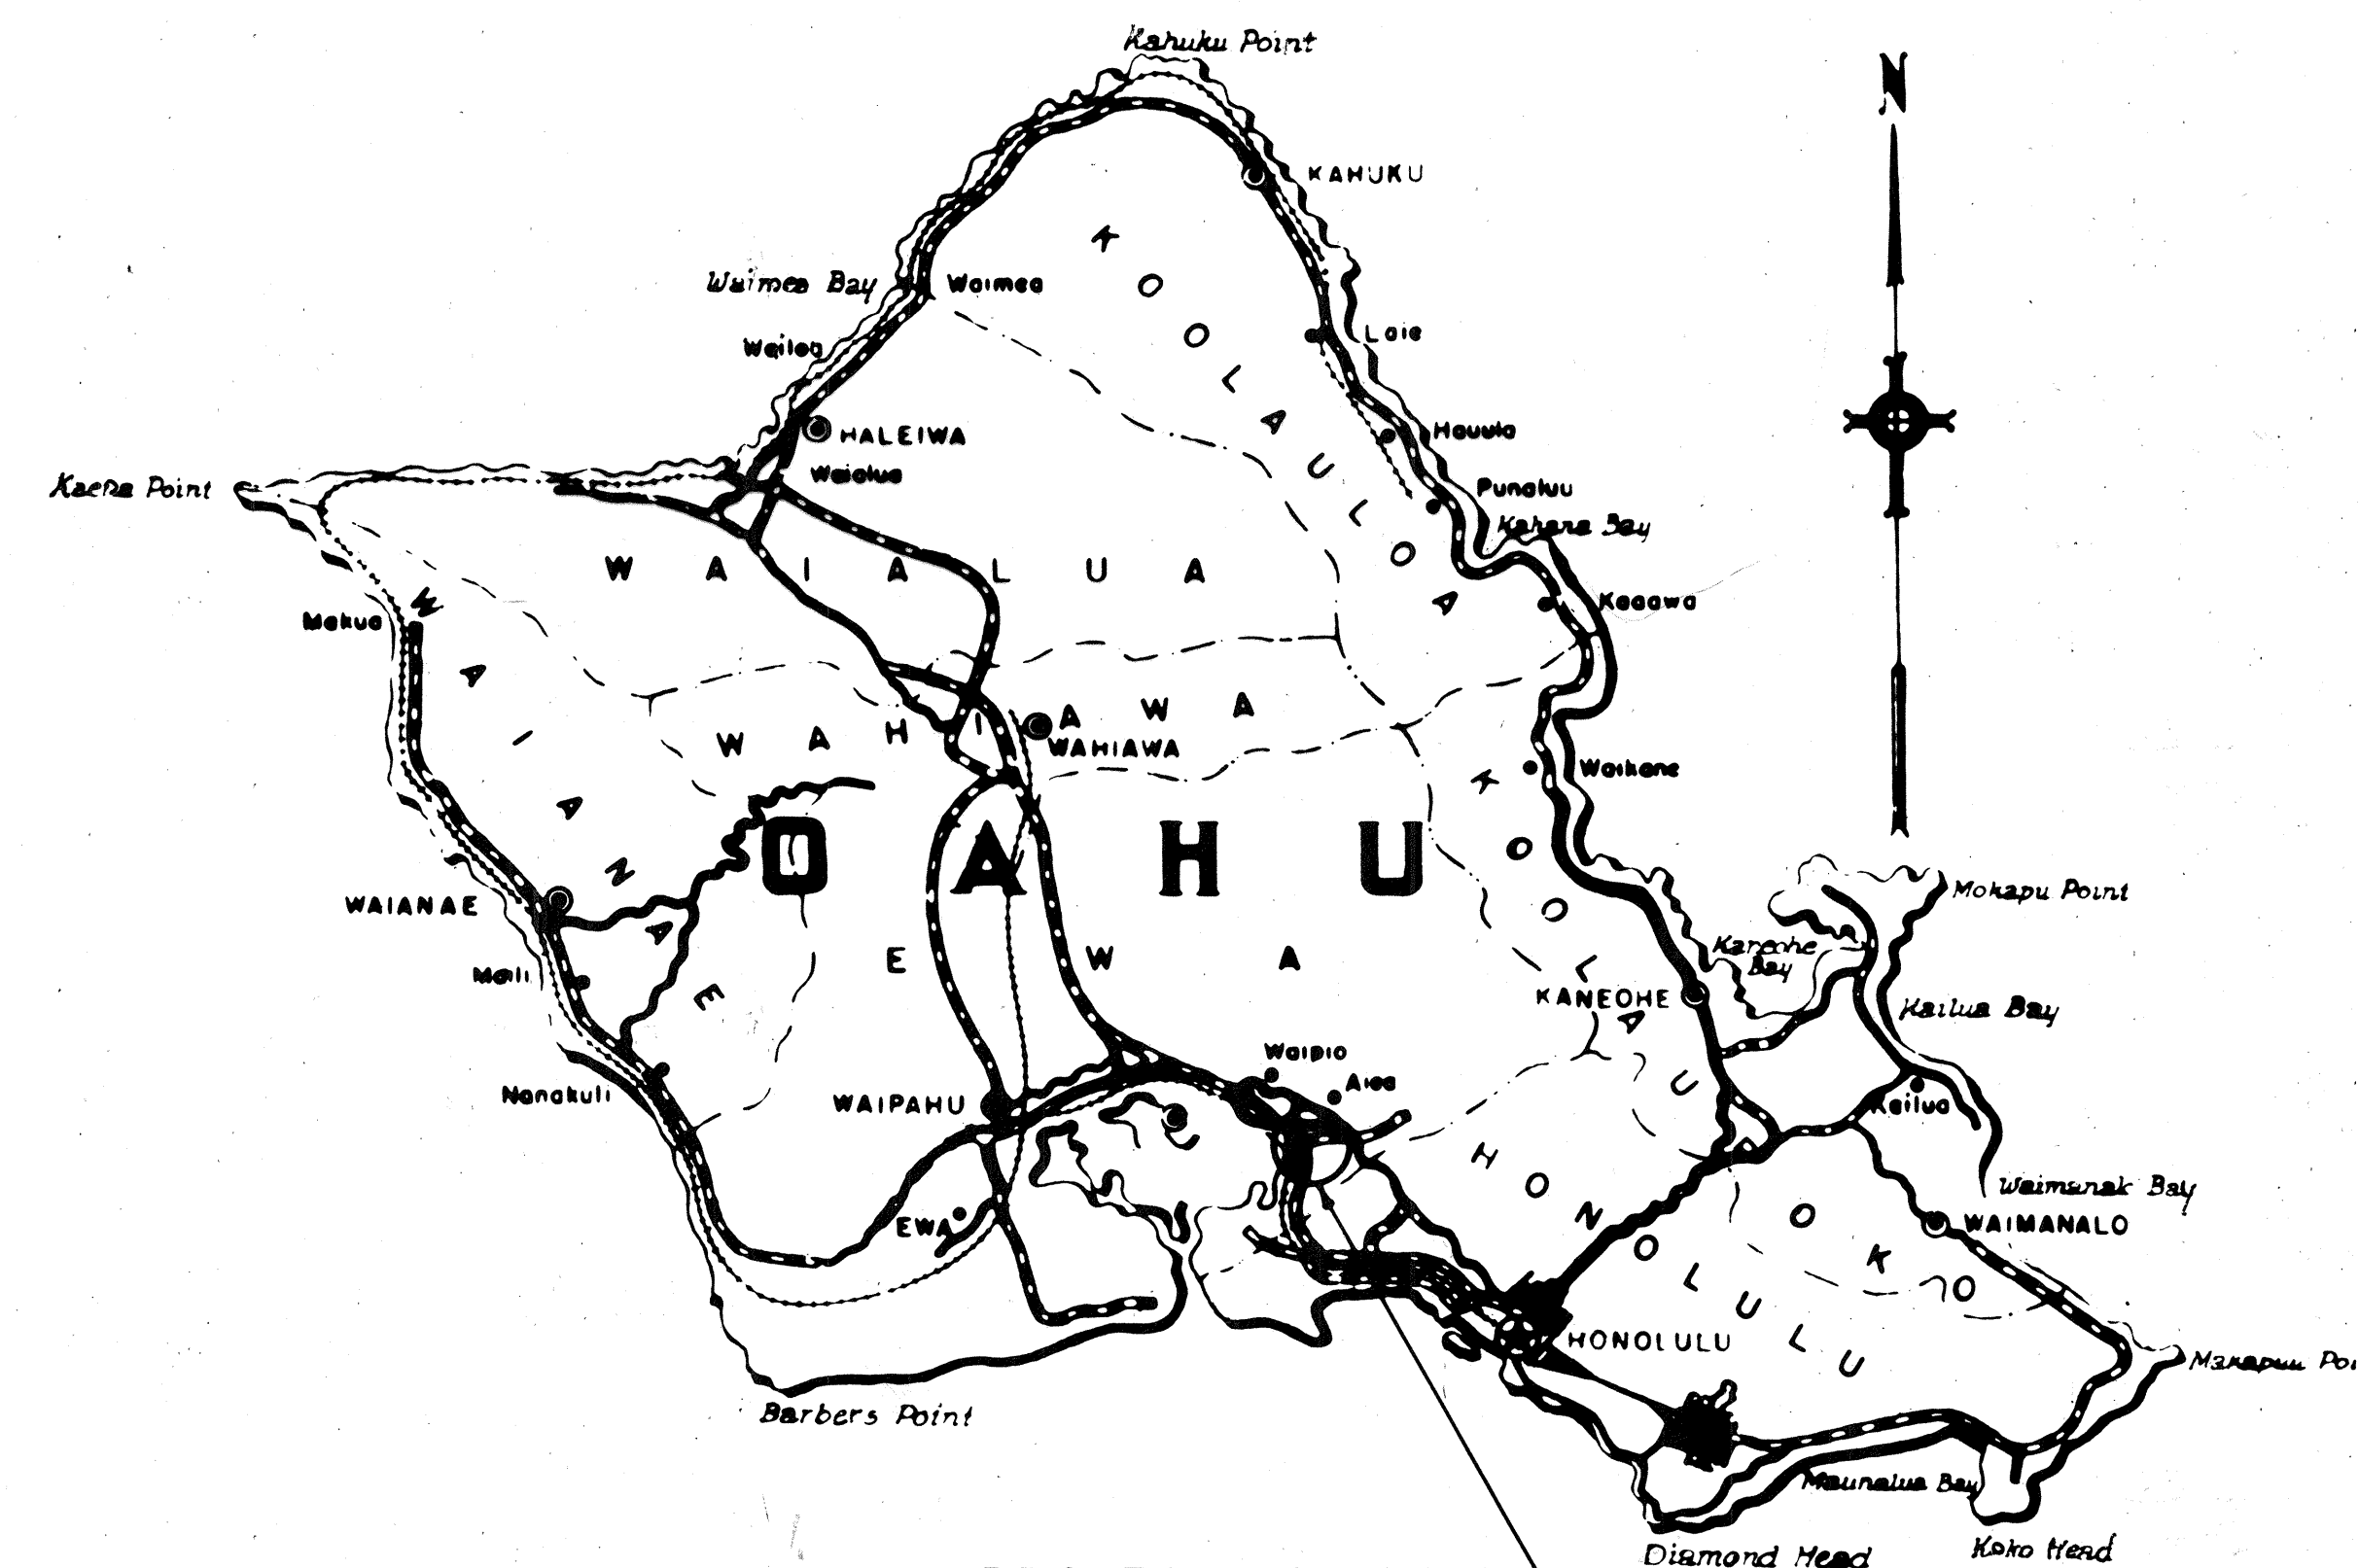

PROJECT LOCATION

Federal Aid Projects Previously Constructed Or Under Construction

NOTE:

ALL CHANGES MADE DURING CONSTRUCTION
HAVE BEEN NOTED IN RED ON THESE TRACINGS
AND CHECKED BY:

James C. Hughes
PROJECT ENGINEER
6/5/67
DATE

DESIGN CLASSIFICATION


ADT (1962) ----- 23,542
 DESIGN ADT (1980) ----- 32,950
 DHV ----- 11 %
 D ----- 65 / 35
 T ----- 2 %
 V ----- 50 M.P.H.

GROSS LENGTH OF PROJECT 0.341 MI.
 BRIDGE OVER 20'-0" LENGTH ... 0.195 MI.
 NET LENGTH OF ROADWAY 0.146 MI.

APPROVED *James C. Hughes* DATE 6/5/67
 DIRECTOR OF TRANSPORTATION

DEPARTMENT OF COMMERCE
BUREAU OF PUBLIC ROADS
APPROVED: *James C. Hughes*
 DIVISION ENGINEER DATE

LAYOUT PLAN

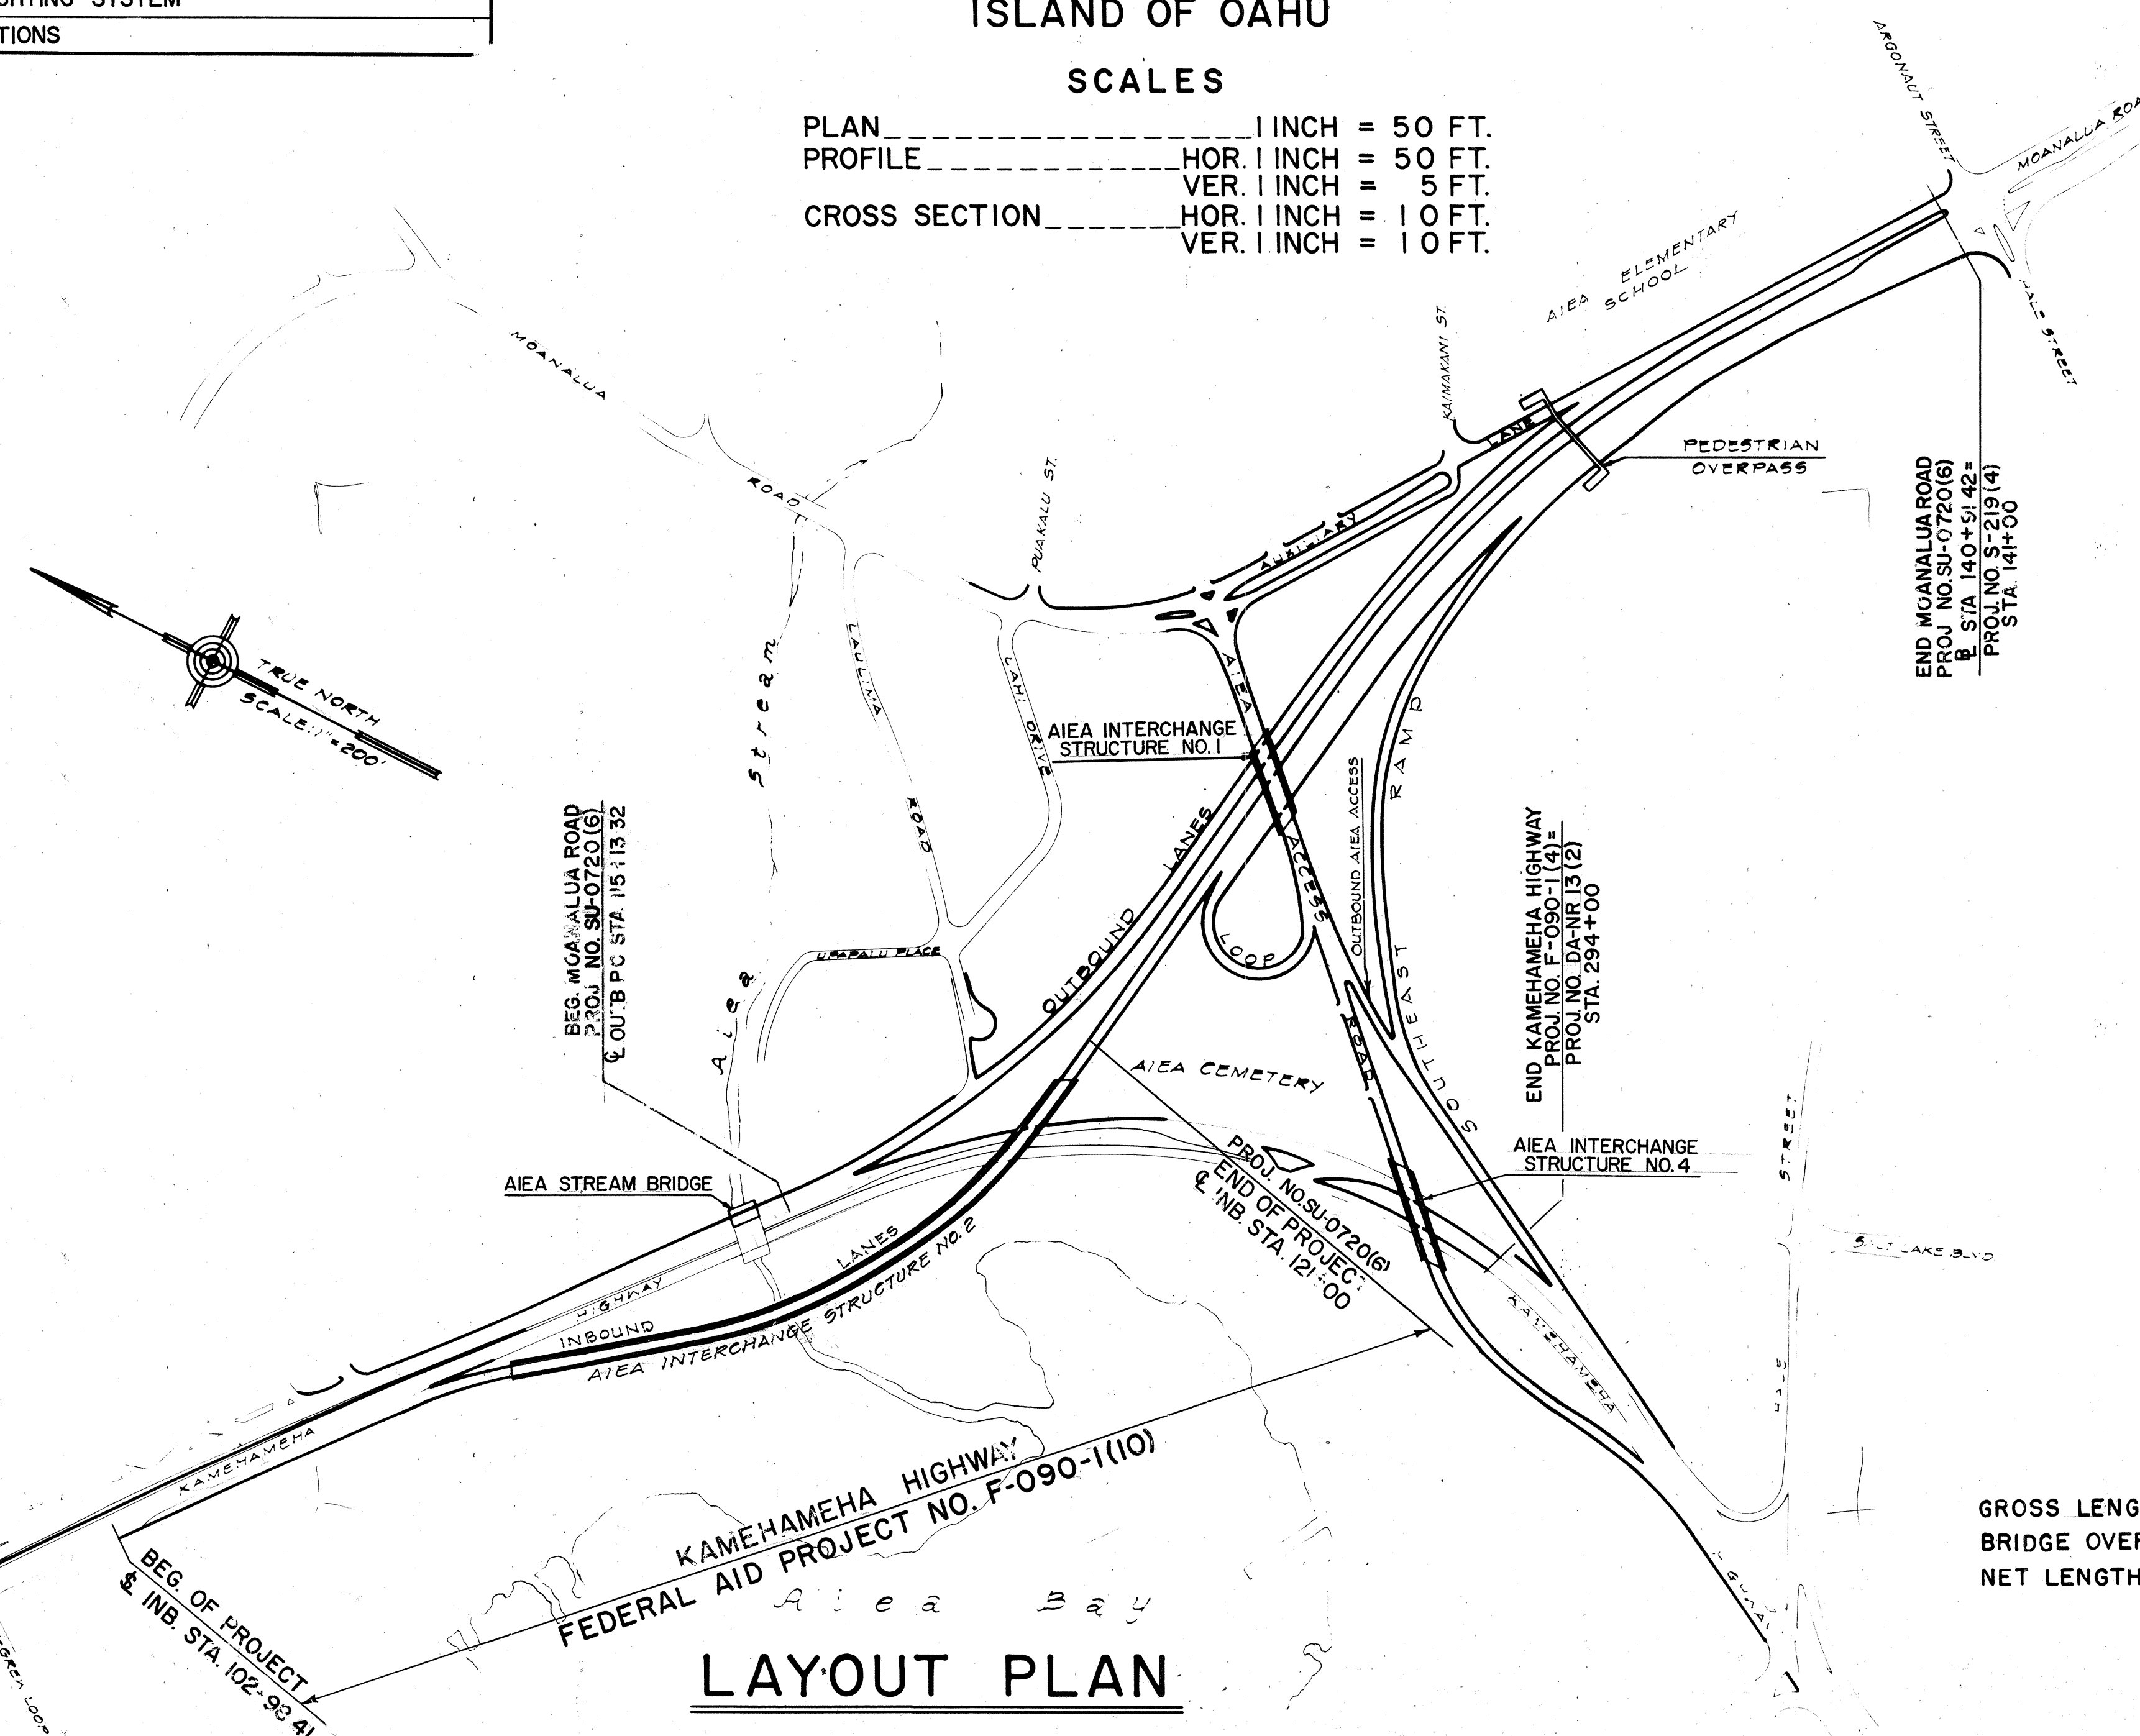

DD-1-6
 DATE
 DESIGNED BY
 DRAWN BY
 CHECKED BY
 NOTE BOOK
 UN-ANTITIES CHECKED BY
 CHECKED BY