

DDA-1-45

MAY 1971
DATE

548-2456
PHONE


RONALD TSUZUKI
PS & E BY

DANIEL, MANN, JOHNSON & MENDENHALL
DESIGN BY

INDEX TO DRAWINGS	
SHEET NO.	DESCRIPTION
1	TITLE SHEET
2 - 9	TYPICAL SECTIONS
10 - 11	GEOMETRIC PLAN
12 - 21	PROFILES & SE DIAGRAMS
22 - 27	DETAIL PLAN OF ROADWAY
28 - 30	INTERSECTION DIAGRAMS
31 - 34	TEMPORARY CONNECTIONS
35 - 37	SITE GRADING
38 - 45	CONST. PHASING & DETOURS
46 - 63	MISC. & STD. RDWY. DETAILS
64 - 65	SAND DRAINS PLANS
66 - 77	DRAINAGE PLANS & PROFILES
78 - 100	DRAINAGE DET. & SUMMARY
101 - 132	TRAFFIC SNG. & PVT. MARKING
133 - 137	LANDSCAPING PLANS
138 - 146	SPRINKLER SYSTEM PLAN
147 - 153	HIGHWAY LIGHTING SYSTEM
154 - 161	TRAFFIC SIGNAL SYSTEM
162 - 225	UTILITY PLANS
226 - 368	STRUCTURES
369 - 372	RETAINING WALLS
373 - 374	BORING LOGS
375 - 409	CROSS-SECTIONS

- (a) INCL. SHEET 23A
(b) INCL. SHEETS 49A, 49B & 54A
(c) INCL. SHEETS 172A, 172B, 177A, 177B & 182A
(b) C.O. 47S-1 to C.O. 47S-4 Inclusive
(c) C.O. 167S-1, C.O. 172BS-1, C.O. 172BS-2, C.O. 225S-1, C.O. 225S-2 & C.O. 225S-3

See right side of this sht. for additional listing

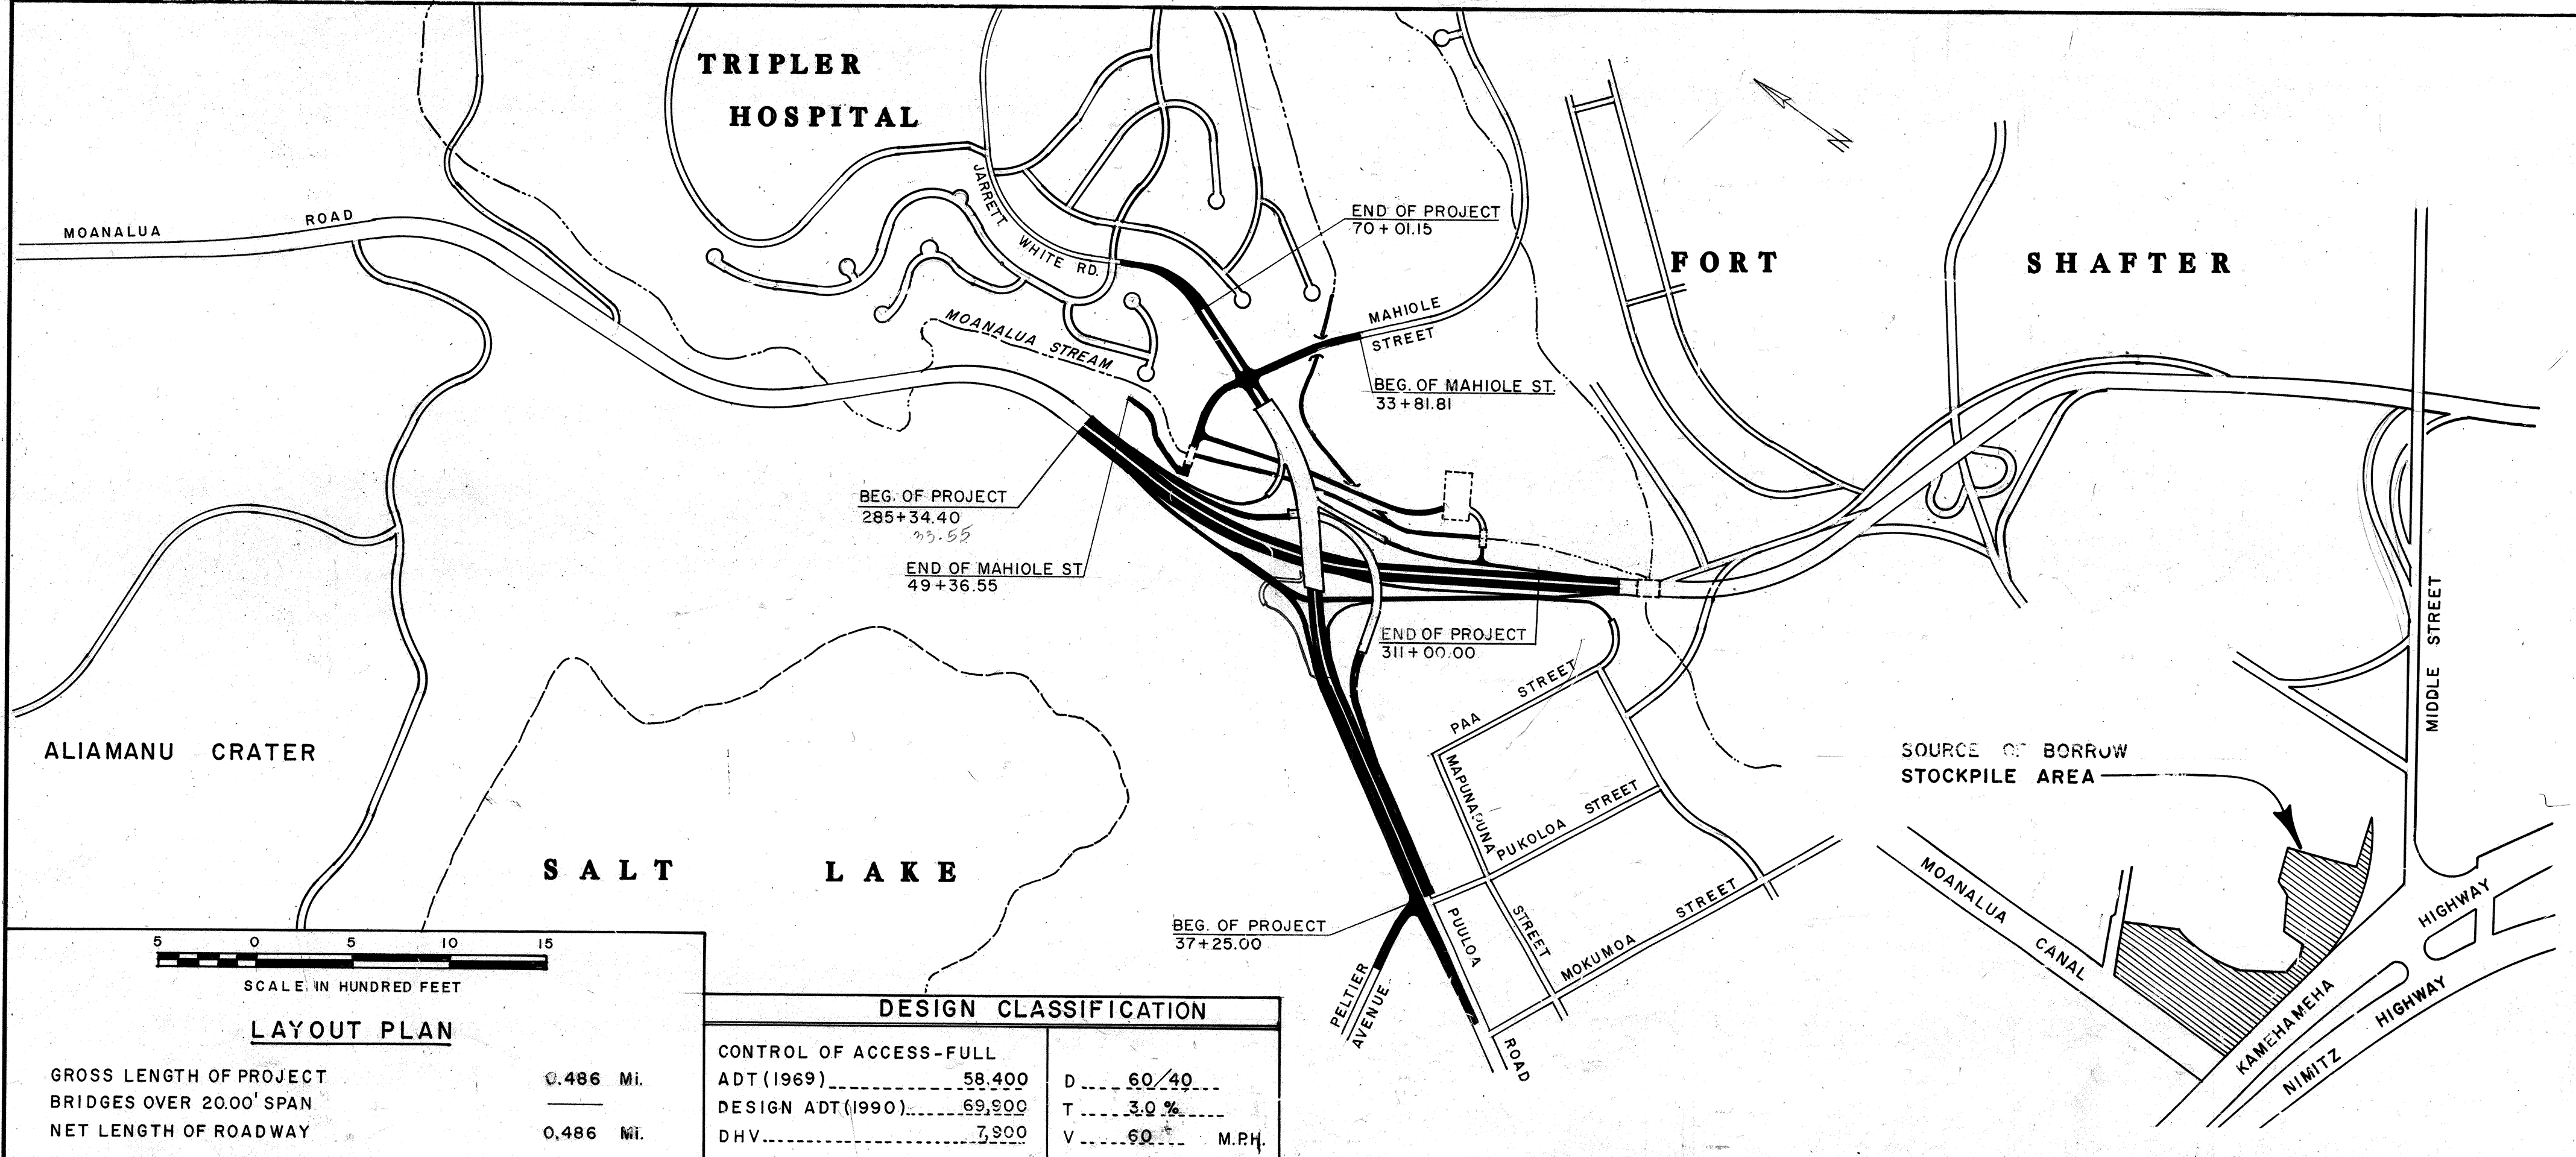

DESIGN CLASSIFICATION			
CONTROL OF ACCESS-FULL			
ADT (1969)	58,400	D	60/40
DESIGN ADT (1990)	69,900	T	3.0 %
DHV	7,900	V	60 M.P.H.

DESIGN CLASSIFICATION			
CONTROL OF ACCESS-FULL			
ADT (1969)	58,400	D	60/40
DESIGN ADT (1990)	69,900	T	3.0 %
DHV	7,900	V	60 M.P.H.

|--|