




FED. ROAD DIST. NO.	STATE	FED. AID PROJ. NO.	FISCAL YEAR	SHEET NO.	TOTAL SHEETS
HAWAII	HAW.	ROS-0300(1)	1977	19	29

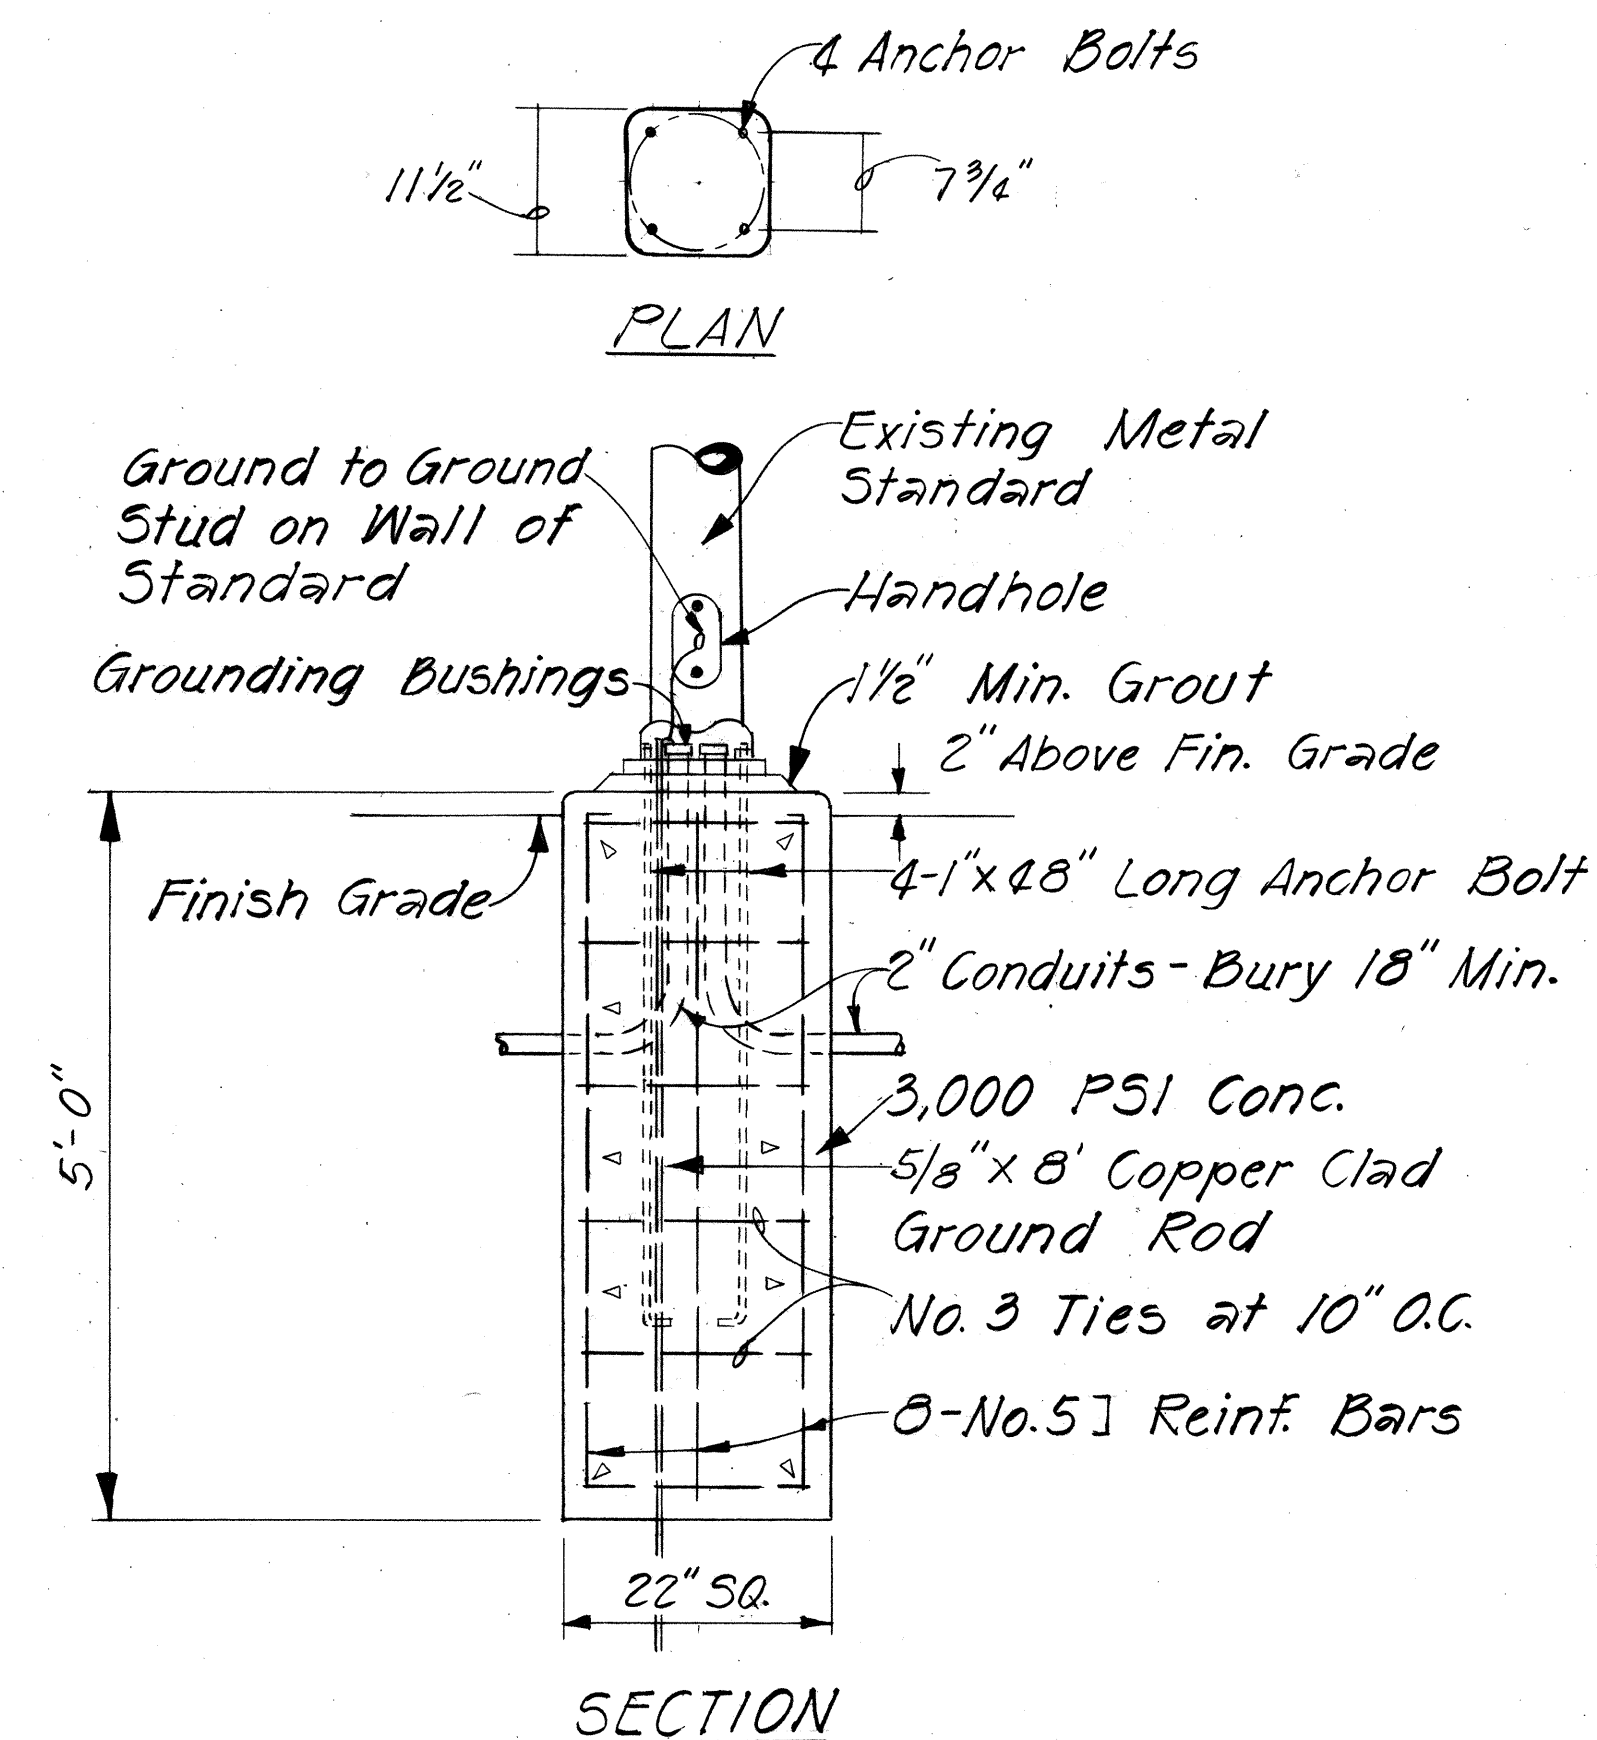

CONCRETE POLE BASE FOR
LIGHT STANDARD WITH ANCHOR BASE
SCALE: Not to Scale

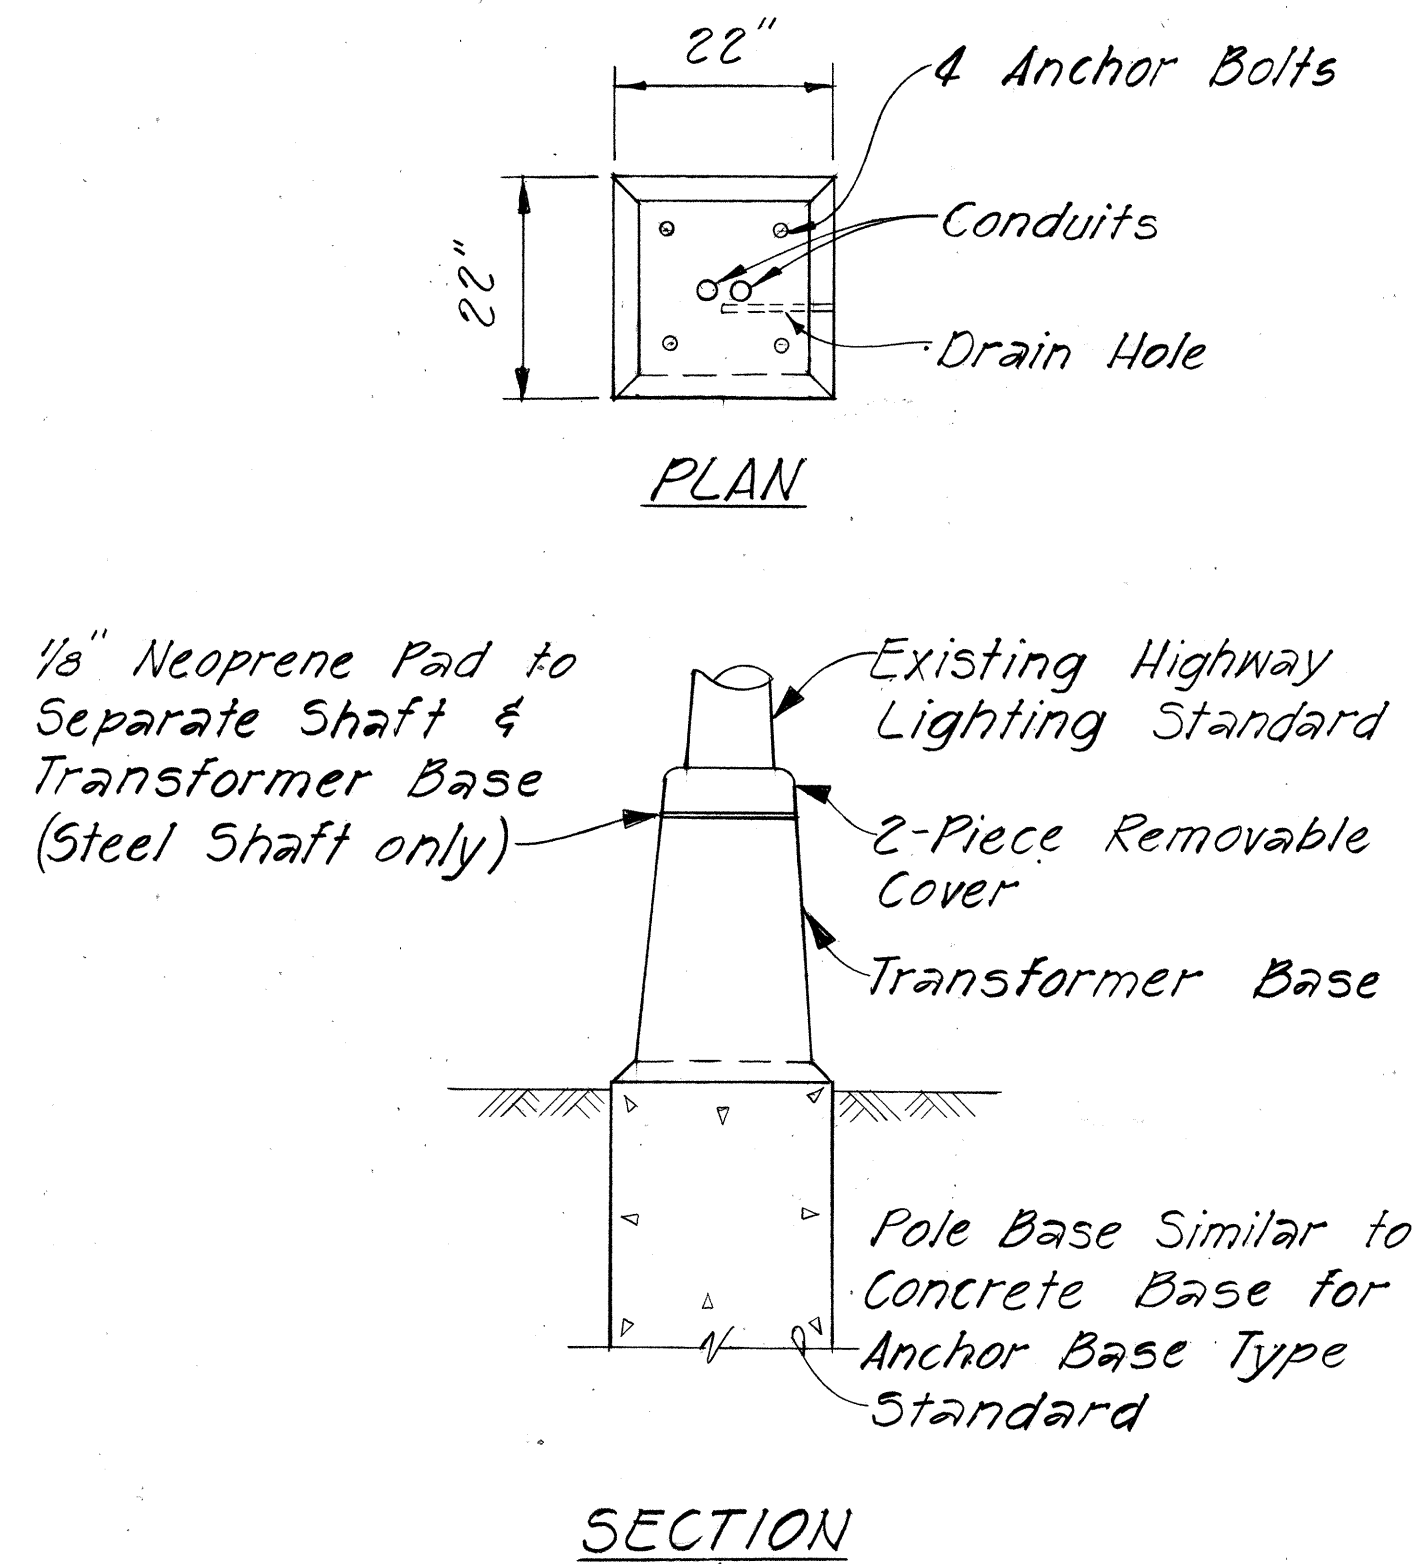

TRANSFORMER BASE DETAIL
SCALE: Not to Scale

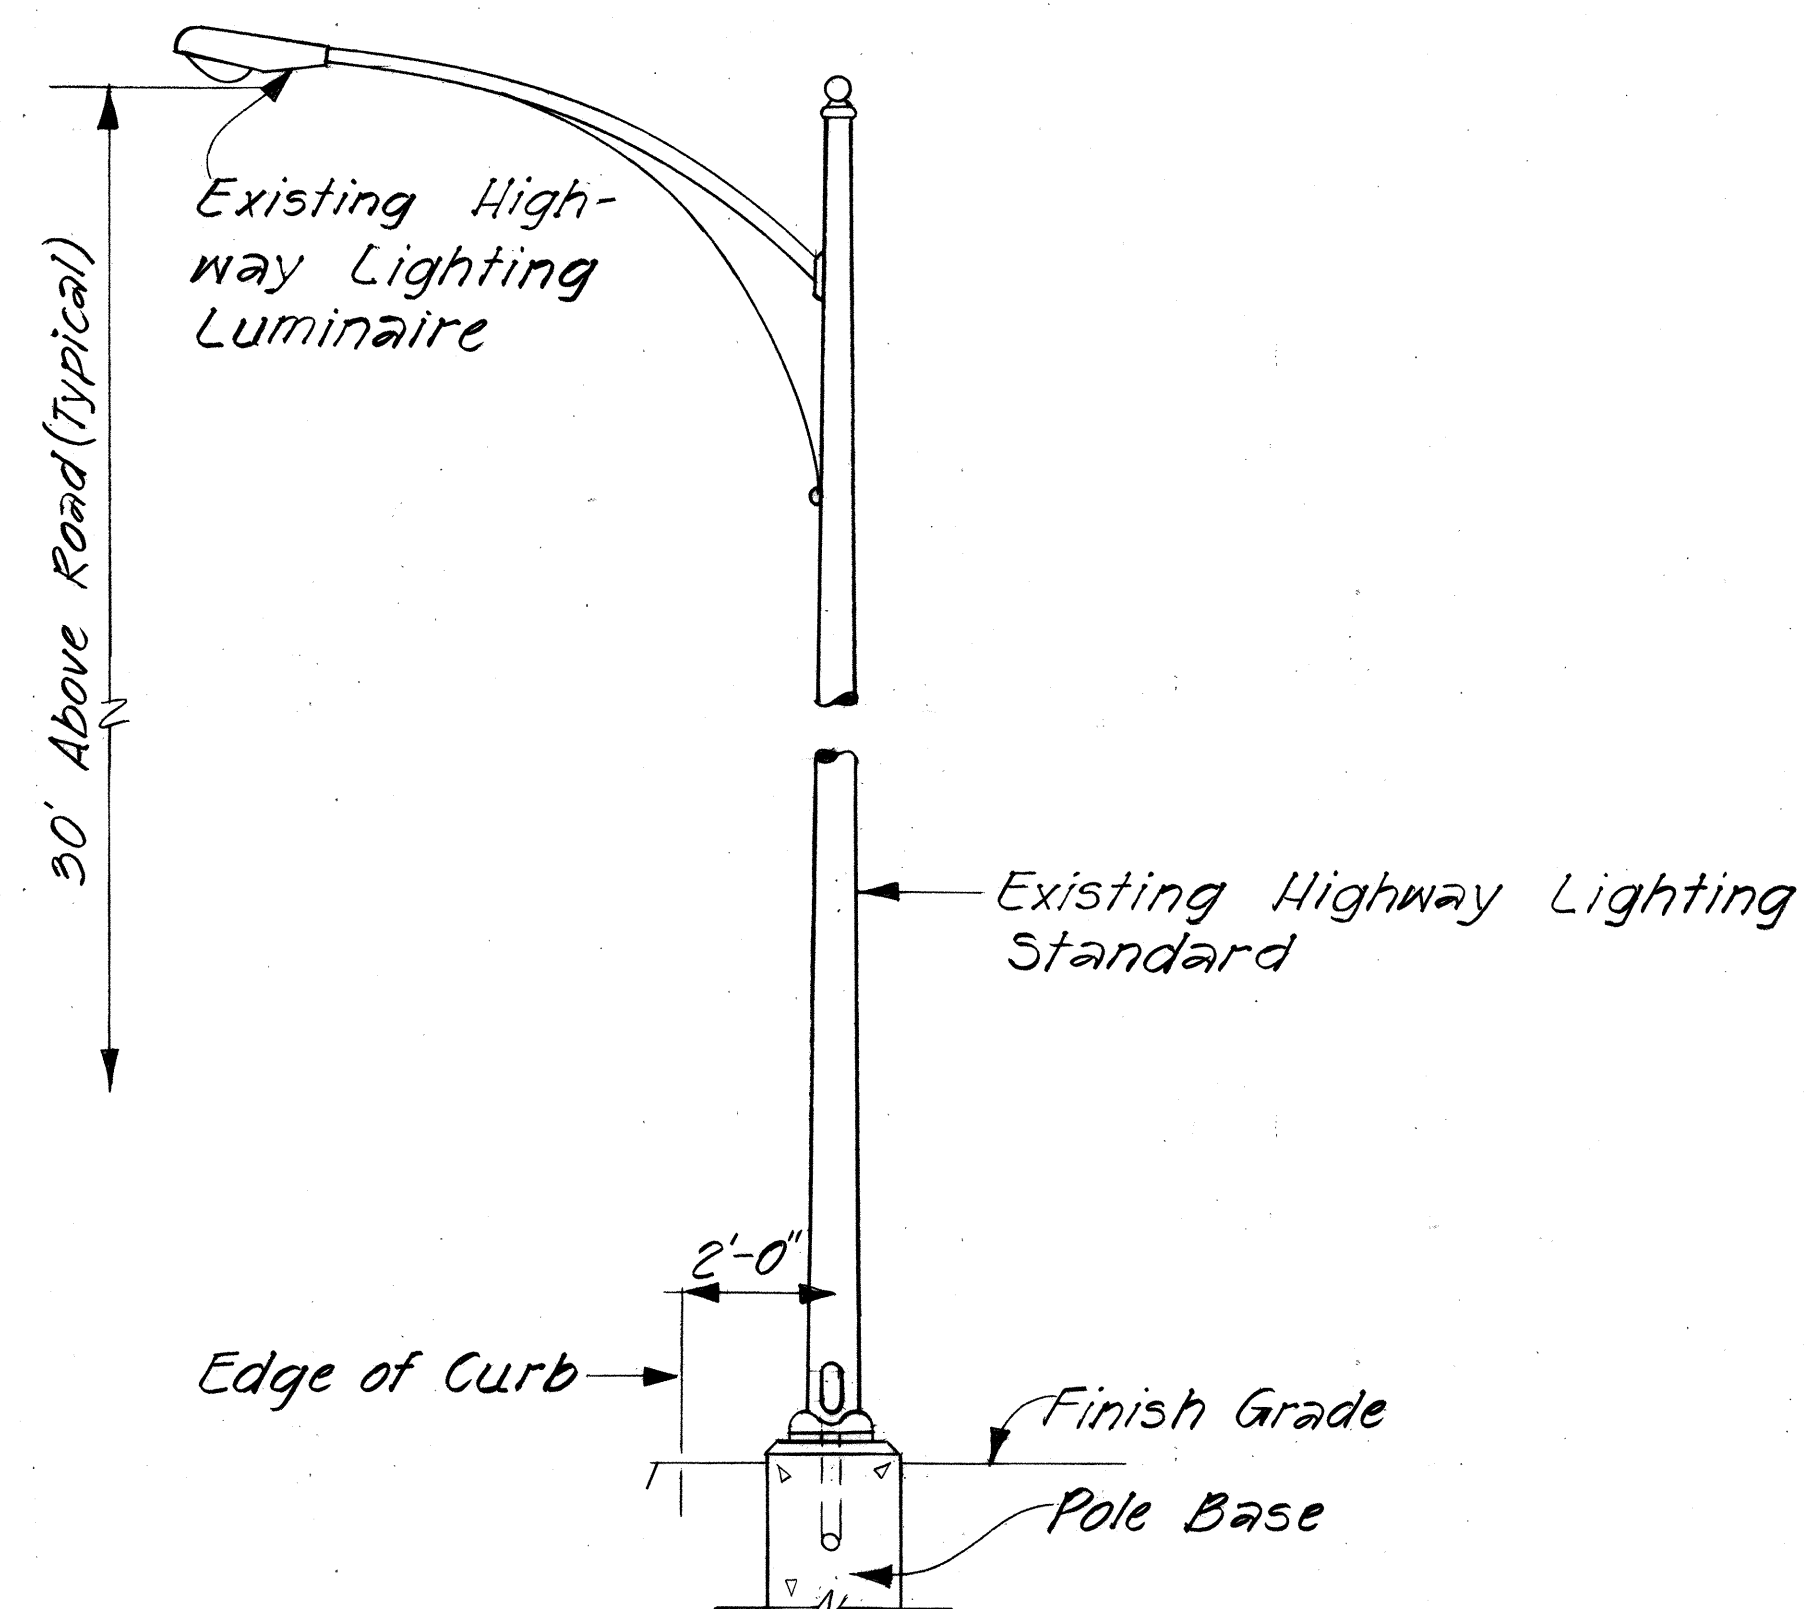

STREET LIGHT STANDARD DETAIL
SCALE: Not to Scale

STATE OF HAWAII DEPARTMENT OF TRANSPORTATION HIGHWAYS DIVISION	
HIGHWAY LIGHTING HIGHWAY STANDARD DETAILS	
GORE AREA IMPROVEMENTS F.A.I. PROJ. NO. ROS-0300(1)	
NOT TO SCALE	DATE:
SHEET NO. 2 OF 2 SHEETS	