

[illegible]

STATE OF HAWAII
DEPARTMENT OF TRANSPORTATION
HIGHWAYS DIVISION
HONOLULU, HAWAII
"AS - BUILT"
PLANS FOR
MIDDLE STREET TRAFFIC SIGNAL
IMPROVEMENTS
AT KAUA STREET AND AT NORTH KING STREET
FEDERAL AID PROJECT NO. HES-300 (25)
DISTRICT OF HONOLULU
ISLAND OF OAHU

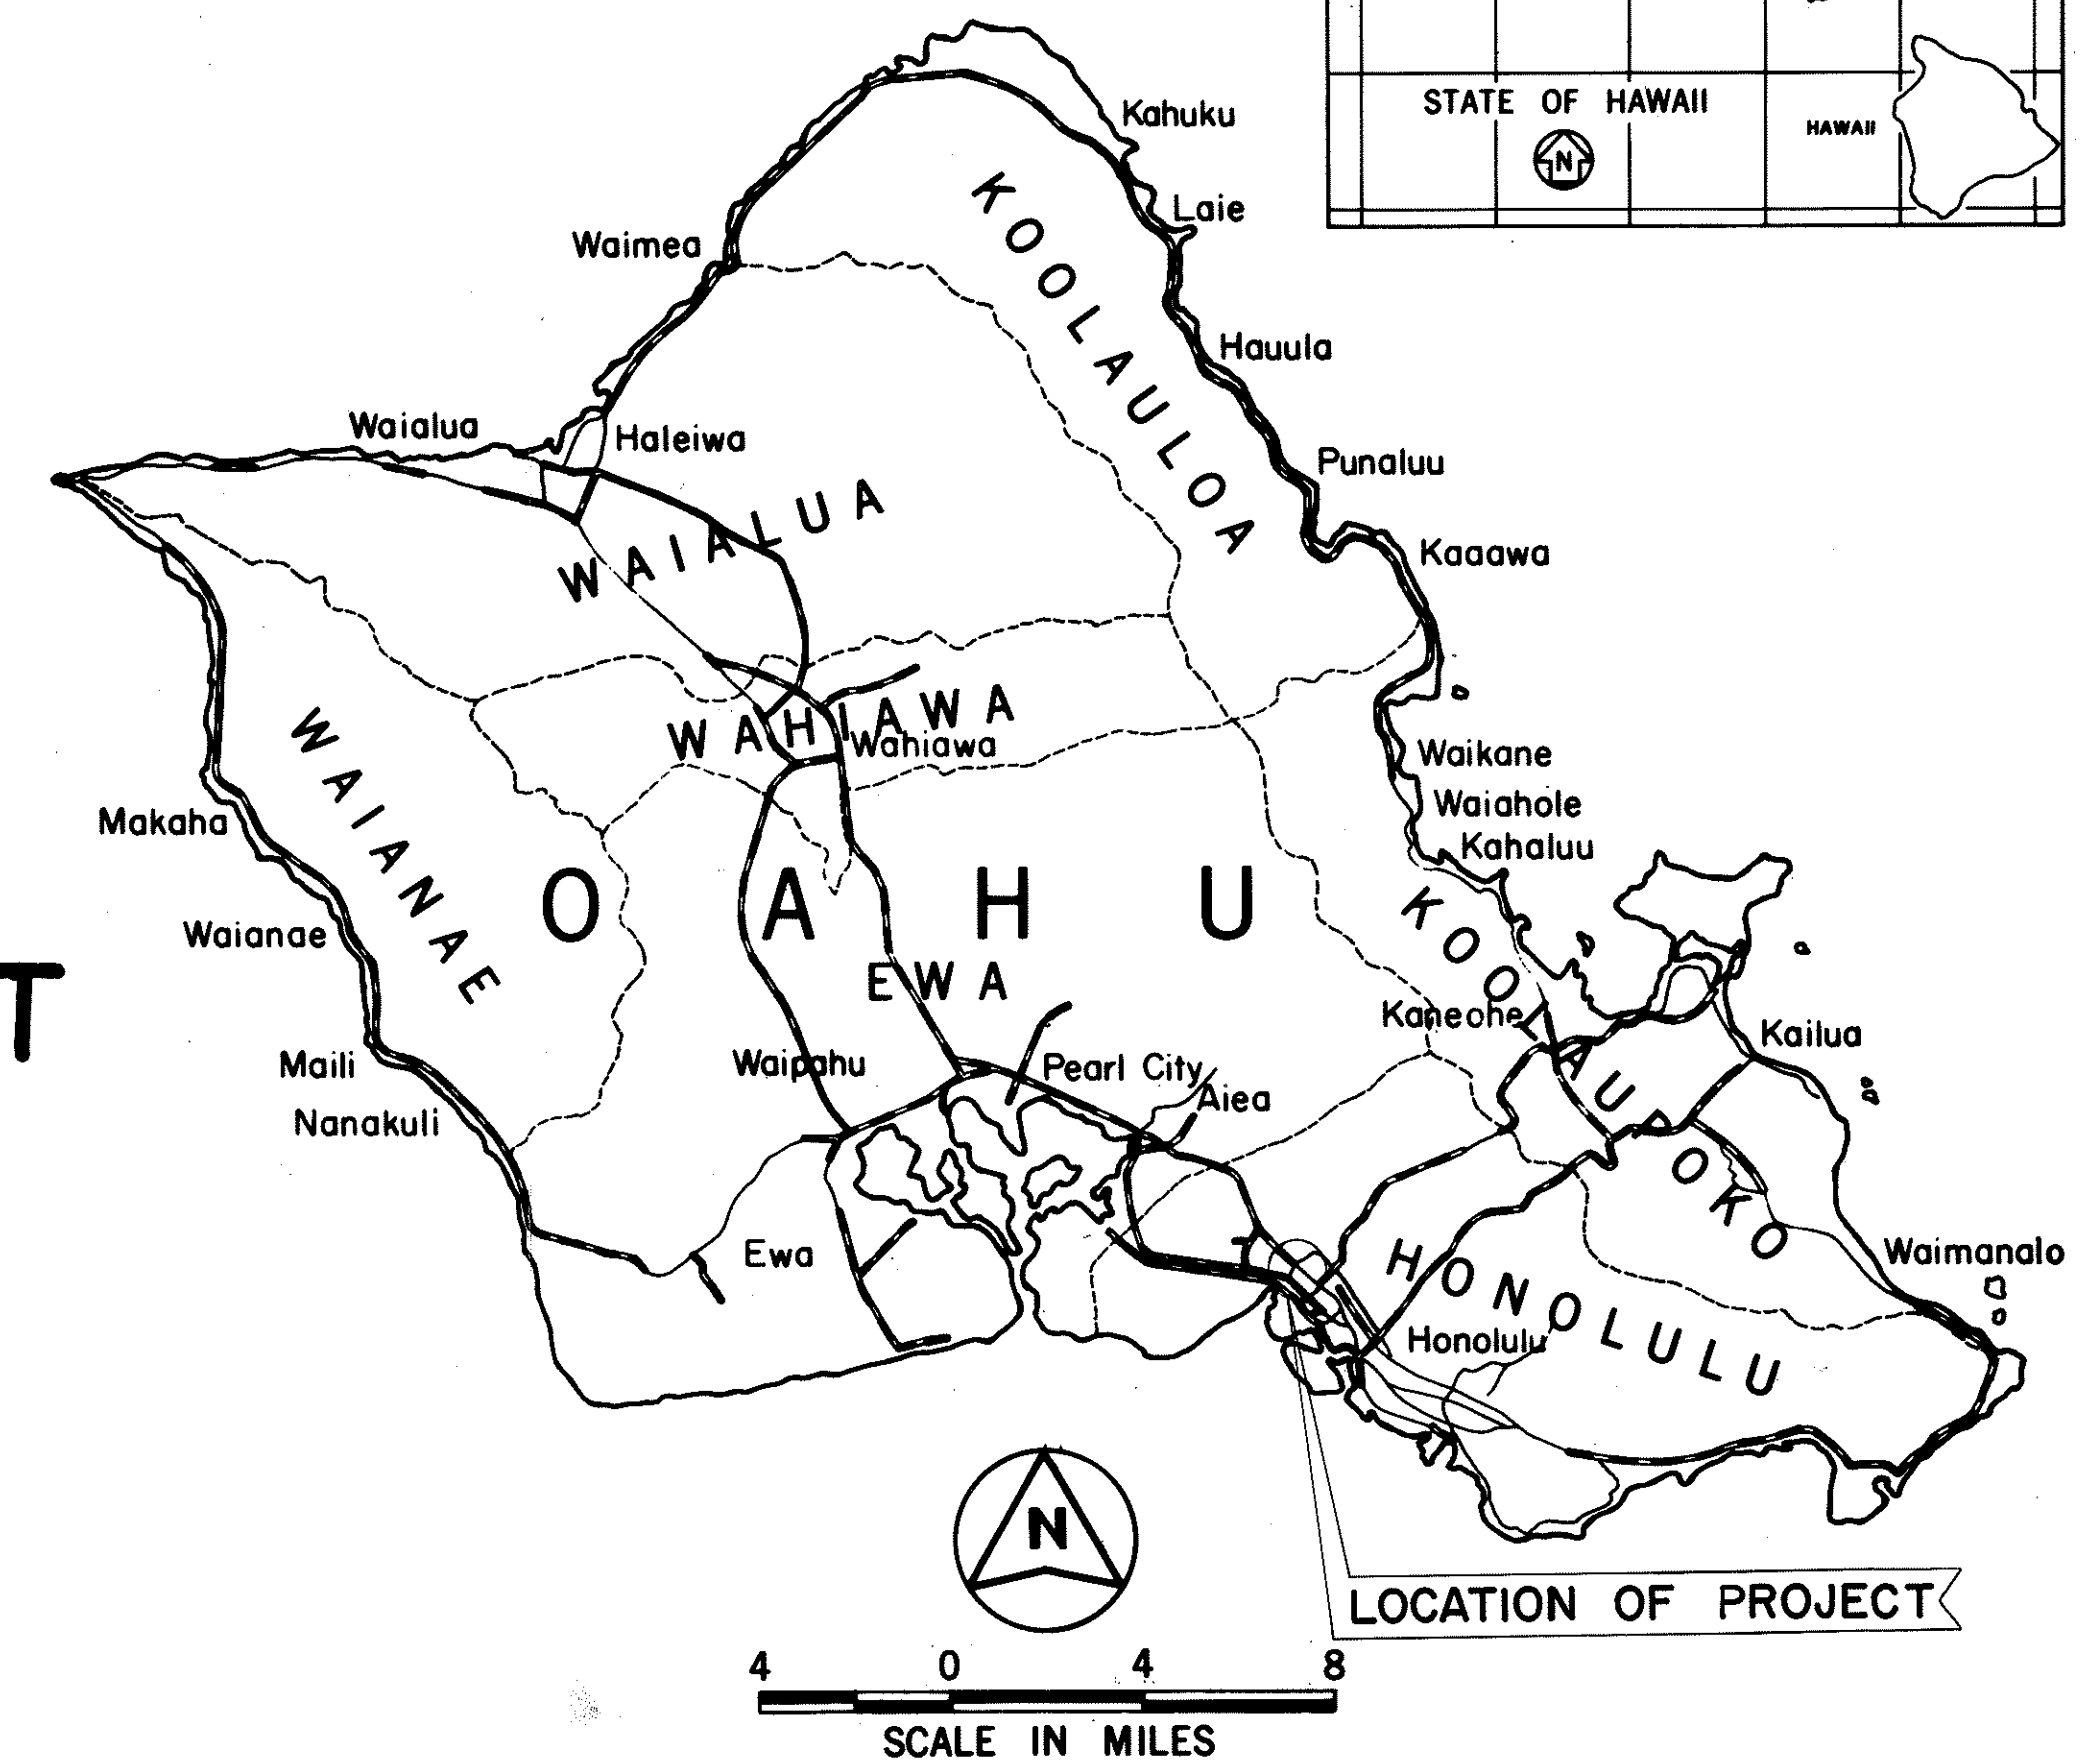


FEDERAL AID PROJECTS PREVIOUSLY CONSTRUCTED
OR UNDER CONSTRUCTION

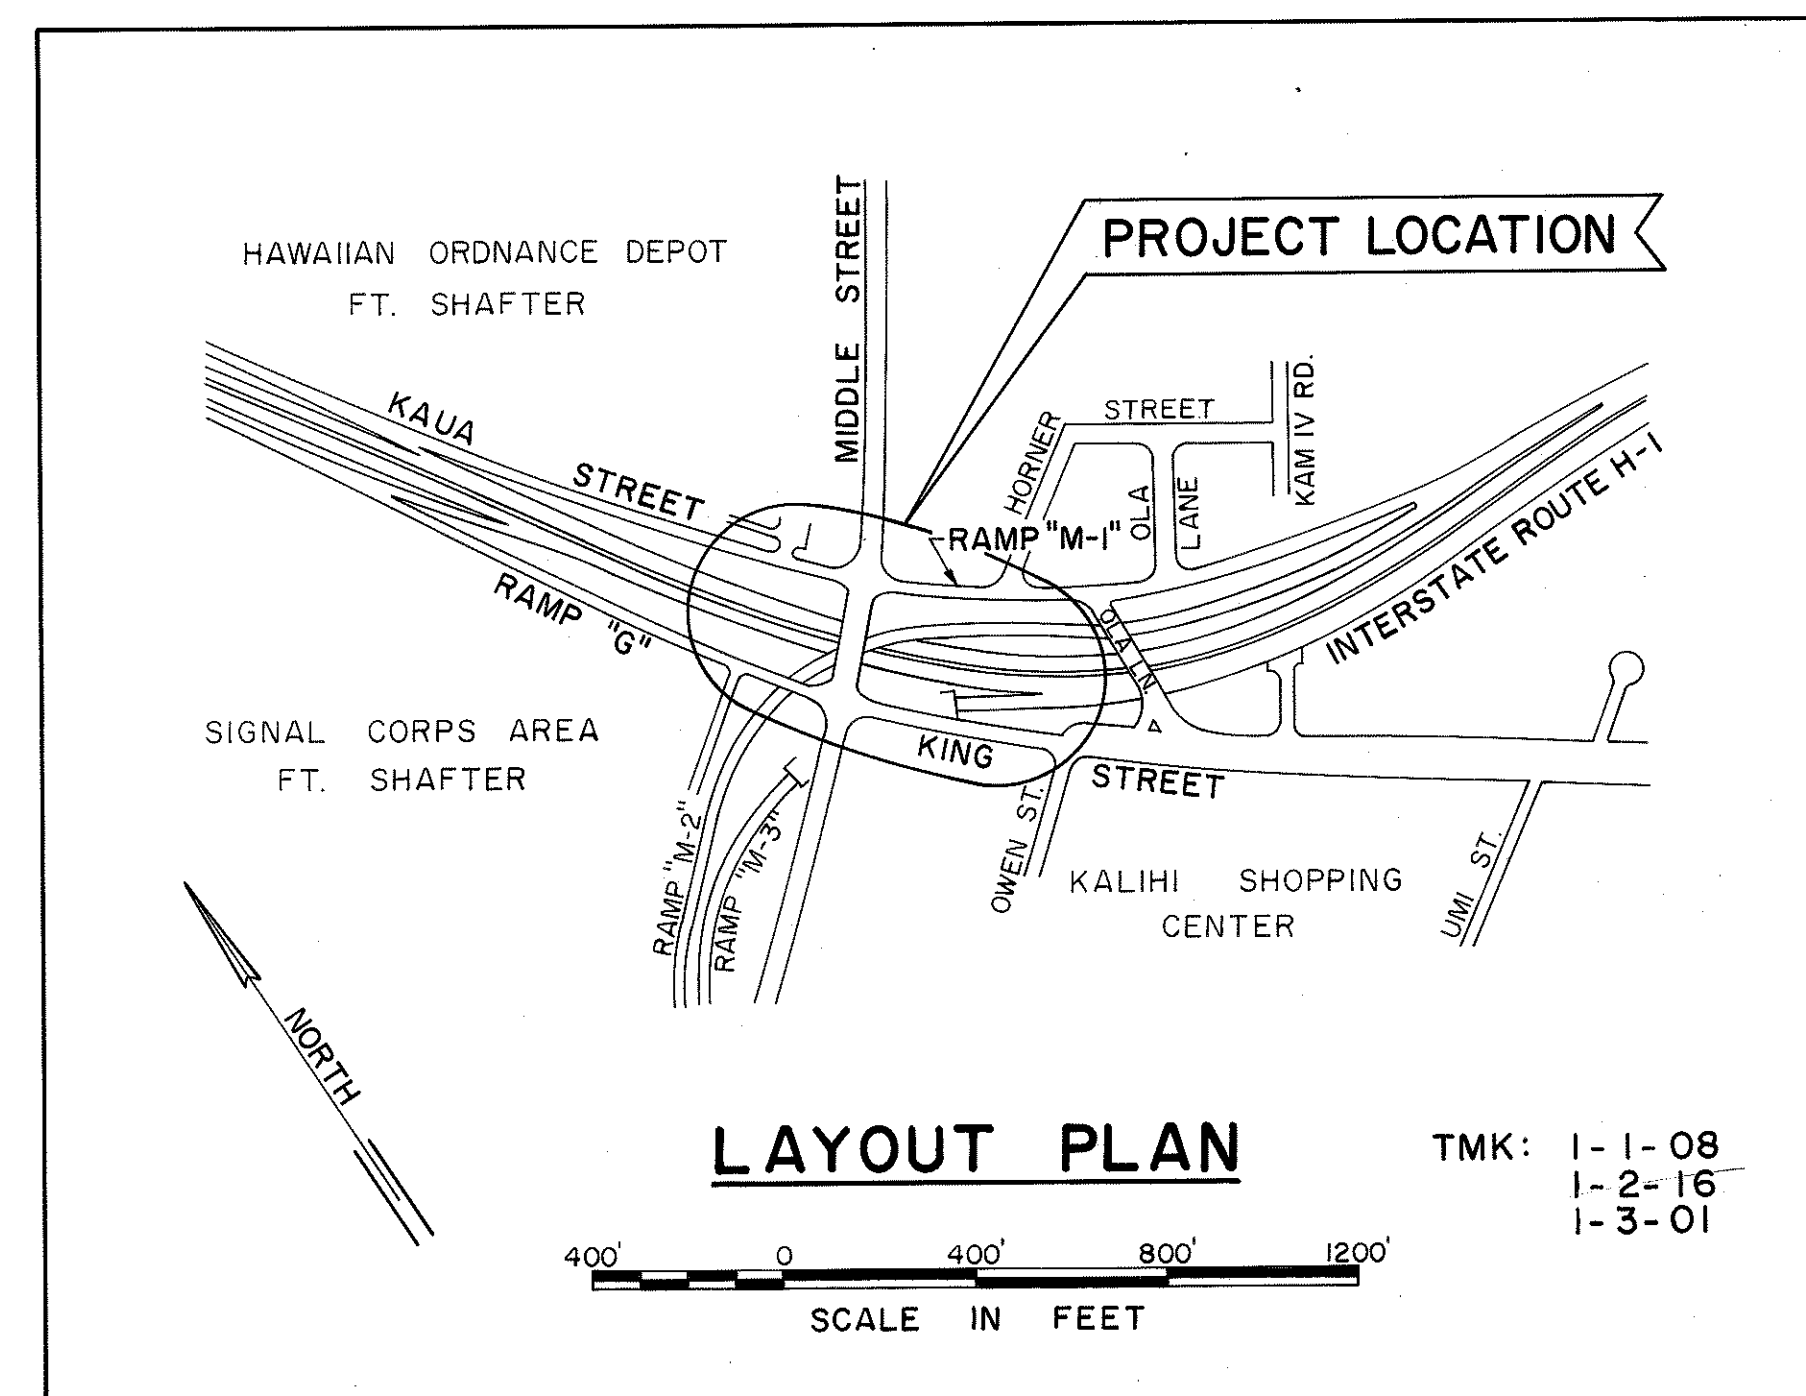

CHANGES MADE DURING CONSTRUCTION HAVE BEEN INCORPORATED ON THESE PLANS EXCEPT CHANGES IN THE ORIGINAL THEORETICAL QUANTITIES. FOR ACTUAL QUANTITIES, REFER TO PROJECT LEDGER AND/OR COMPUTATION BOOK.

Virgilio P. Gonzales
RESIDENT ENGINEER

9/26/88
DATE

DEPARTMENT OF TRANSPORTATION FEDERAL HIGHWAY ADMINISTRATION	
APPROVED: 	9/30/85
DIVISION ADMINISTRATOR	DATE

DEPARTMENT OF TRANSPORTATION STATE OF HAWAII	
APPROVED:	
<i>Cheryl D. Boon</i> DIR. OF TRANSPORTATION	9/16/85 DATE

SHIMABUKURO, ENDO & YOSHIKAZAKI, INC.
1126 12TH AVENUE - HONOLULU, HI

DESIGNED BY

FRED ABESHIMA

P. S. & E. BY

548 - 4042

PHONE

AUG. 30, 1985

DATE