,	INDEX TO DRAWINGS
SHEET NO.	DESCRIPTION
	TITLE SHEET
2	NOTES AND LEGEND
3	TRAFFIC SIGNALS, SIGNING AND
	STRIPING PLAN
4	TRAFFIC SIGNAL PLAN AND MISC.
	DETAILS
5-14	STANDARD DETAILS

STATE OF HAWAII

DEPARTMENT OF TRANSPORTATION


HIGHWAYS DIVISION HONOLULU, HAWAII


"AS-BUILT"

PLANS FOR

KAUA STREET TRAFFIC SIGNALS AT ALA MAHAMOE STREET PROJECT NO. HWY-0-01-85

DISTRICT OF HONOLULU ISLAND OF OAHU

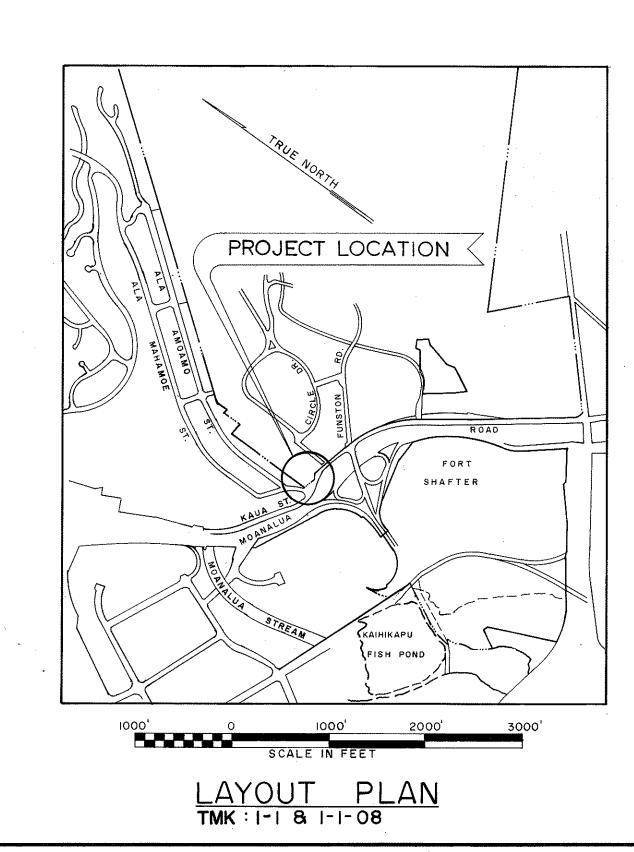

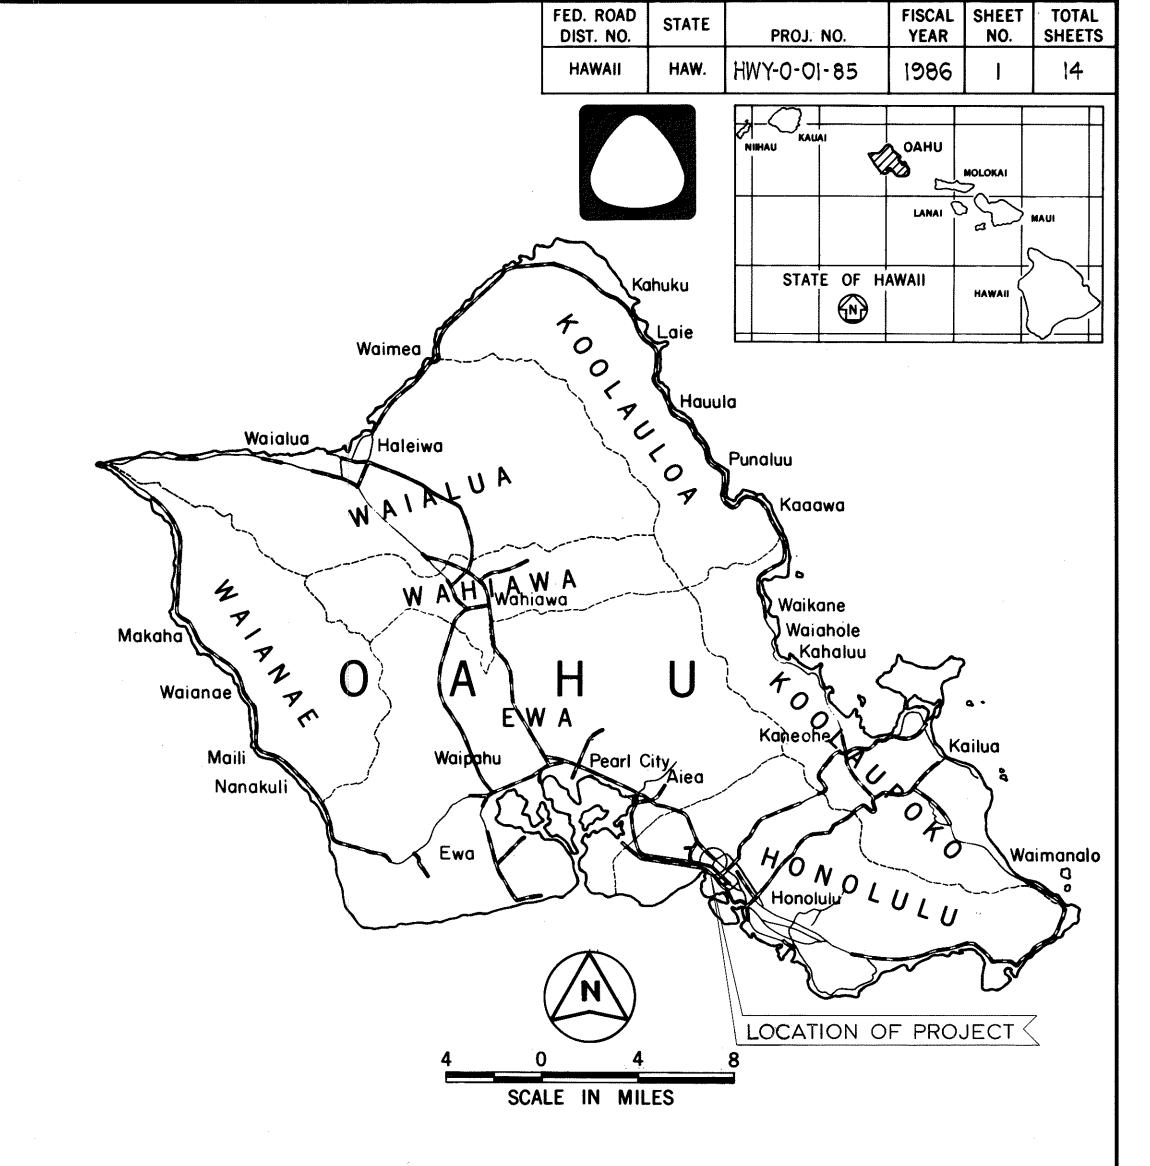

CHANGES MADE DURING CONSTRUCTION HAVE BEEN INCORPORATED ON THESE PLANS EXCEPT CHANGES IN THE ORIGINAL THEORETICAL QUANTITIES, FOR ACTUAL QUANTITIES, REFER TO PROJECT LEDGER AND/OR COMPUTATION BOOK.

RESIDENT ENGINEER

DEPARTMENT OF TRANSPORTATION
STATE OF HAWAII

APPROVED:

Chery O. Doon 1/13/86

MDIR. OF TRANSPORTATION DATE

DATE