

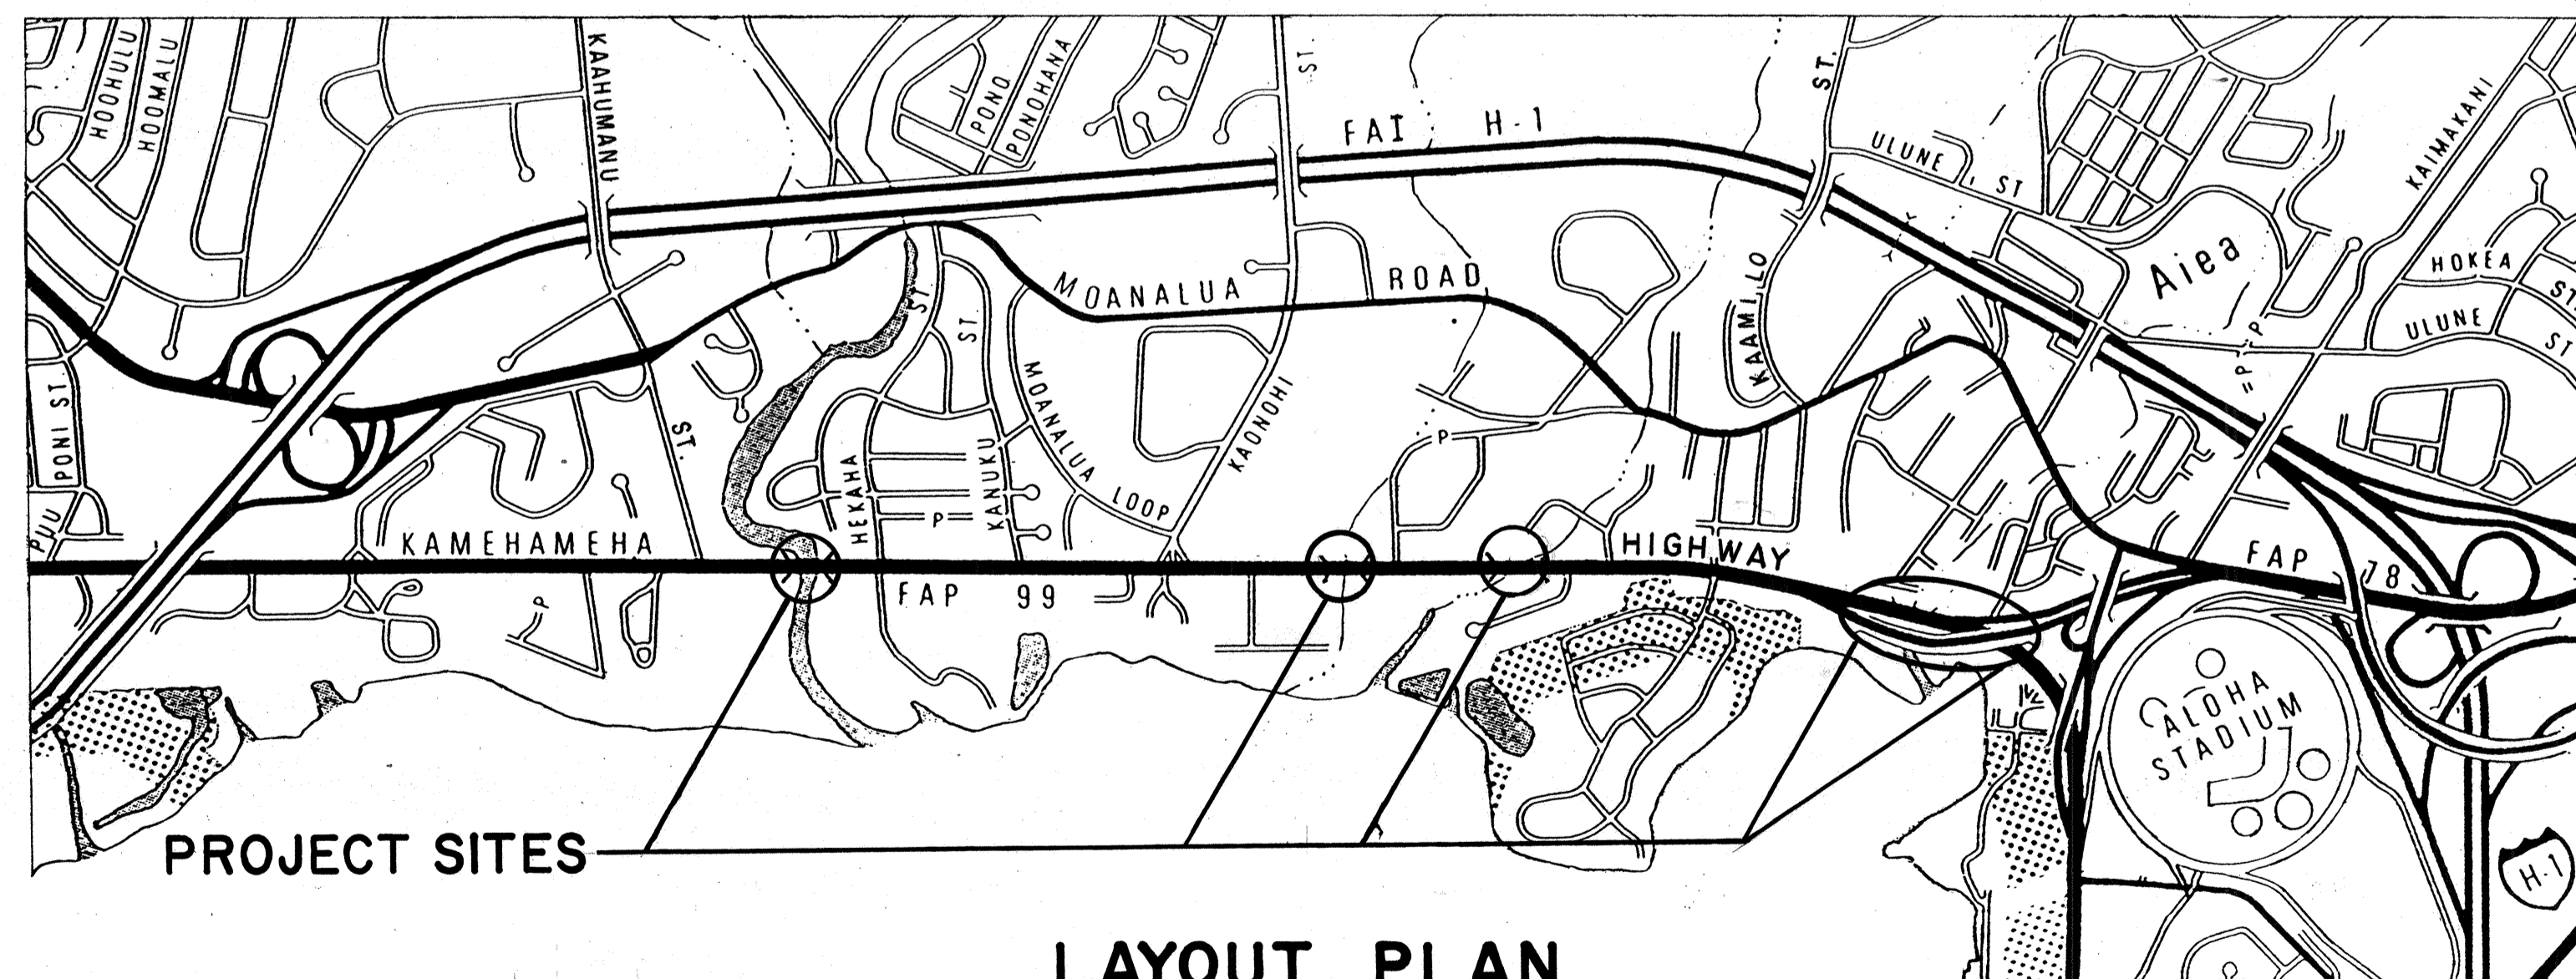
[illegible]

STATE OF HAWAII  
DEPARTMENT OF TRANSPORTATION  
HIGHWAYS DIVISION  
HONOLULU, HAWAII  
" AS BUILT "  
PLANS FOR



# RESURFACING BRIDGES AT VARIOUS LOCATIONS

(WAIMALU, KALAUAO SPRINGS AND KALAUAO BRIDGES  
AND AIEA I.C. STRUCTURE NO. 2)

DISTRICT OF EWA  
ISLAND OF OAHU

Inland B. Fore

RESIDENT ENGINEER

3/18/89  
DATE

0 2

SCALE IN THOUSAND FEET

## LAYOUT PLAN

**ROUTE 78**

AIEA I.C. STRUCTURE NO.2...M.P. 0.01

<u>ROUTE 99</u>	
WAIMALU BRIDGE . . . . .	M.P. 19.85
KALAUAO SPRINGS BRIDGE . . . . .	M.P. 20.51
KALAUAO BRIDGE . . . . .	M.P. 20.72

DEPARTMENT OF TRANSPORTATION  
STATE OF HAWAII

APPROVED:

Edmund L. W. 9/15/87  
DIR. OF TRANSPORTATION DATE

ALLAN T. NISHIMURA  
DESIGNED BY P. S. & E. BY  
548-7490 PHONE  
Sept., 1987 DATE