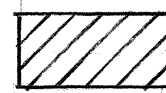
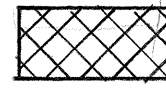



FED. ROAD DIST. NO.	STATE	PROJ. NO.	FISCAL YEAR	SHEET NO.	TOTAL SHEETS
HAWAII	HAW.	7310A-01-88M	1988	8	23

#Sta. 37+75 to #Sta. 38+25
Cold Plane 578 sq. yds.
For detail, see Plan Sht. No. 7

LEGEND

-  Cold Plane Area
-  Reconstruction Area

True North
Scale: 1"=40'

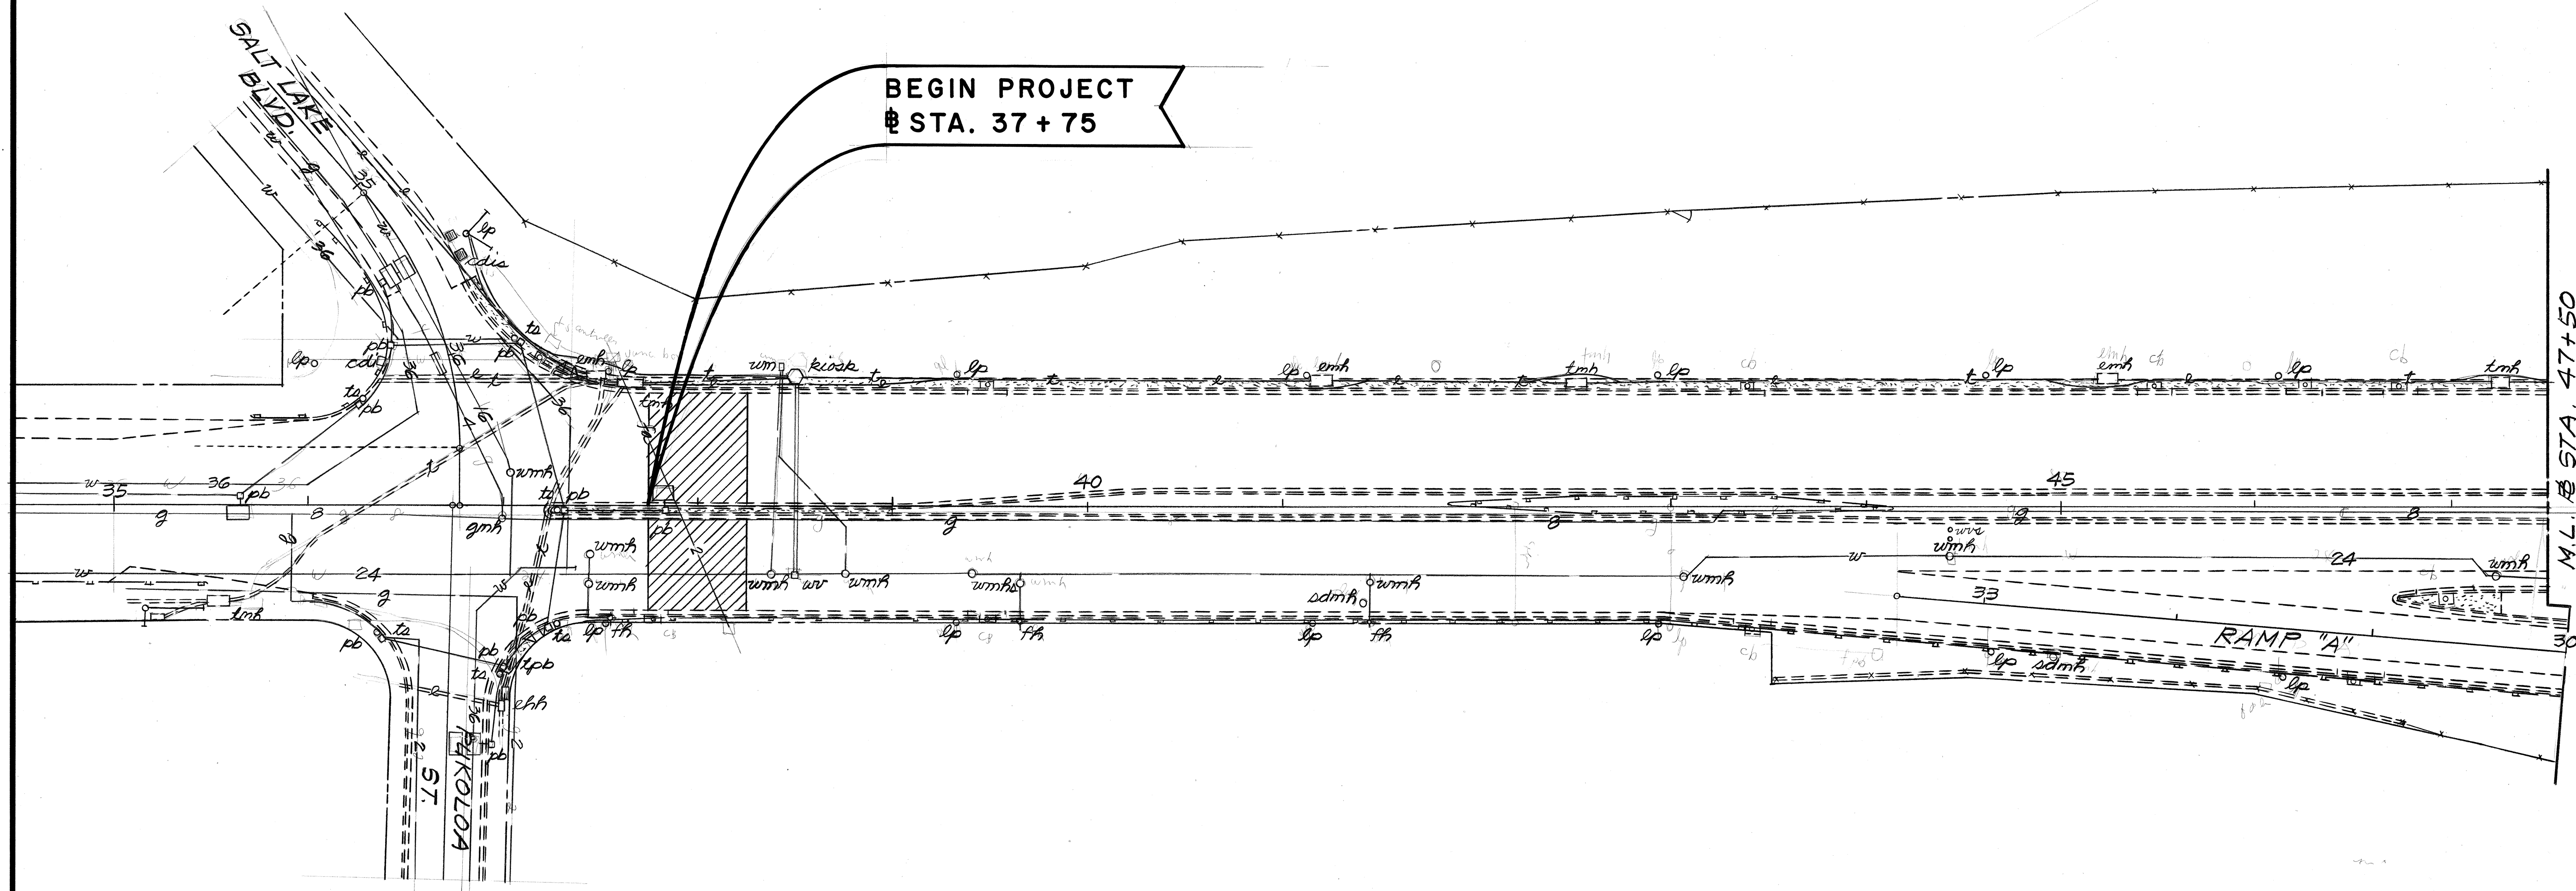

DATE	_____
SURVEY PLOTTED BY	_____
DRAWN BY	_____
DESIGNED BY	_____
CHECKED BY	_____
ORIGINAL PLAN	_____
NOTE BOOK	_____
No.	_____

STATE OF HAWAII
DEPARTMENT OF TRANSPORTATION
HIGHWAYS DIVISION

PLAN

**PUULOLOA ROAD RESURFACING
PIKOLOA ST. TO MAHIOLE ST.**
Project No. 7310A-01-88M

Scale: 1"=40' Date: March, 1988

SHEET NO. 1 OF 7 SHEETS

FED. ROAD DIST. NO.	STATE	PROJ. NO.	FISCAL YEAR	SHEET NO.	TOTAL SHEETS
HAWAII	HAW.	7310A-01-88M	1988	9	23

LEGEND

-  Cold Plane Area
-  Reconstruction Area

RAMP "G" Sta. 20+47 to Sta. 20+77

Cold Plane 114± Sq. Yds.
For Detail, see Plan Sht. No. 7.

RAMP "H" Sta. 19+35 to Sta. 19+65

Cold Plane 87± Sq. Yds.
For Detail, see Plan Sht. No. 7.

Sta. 54+57 to Sta. 55+07

Cold Plane 345± Sq. Yds.
For Detail, see Plan Sht. No. 7.


Sta. 53+88.10 PUKILOA RD
Sta. 9+14.30 RAMP "E"
Sta. 20+12.69 RAMP "H"

RAMP "E" Sta. 9+60 to Sta. 9+70
Cold Plane 84± Sq. Yds.
For Detail, see Plan Sht. No. 7.

RAMP "F" Sta. 9+45 to Sta. 9+75
Cold Plane 94± Sq. Yds.
For Detail, see Plan Sht. No. 7.

RAMP "A" Sta. 20+30 to Sta. 20+00

Cold Plane 118± Sq. Yds.
For Detail, see Plan Sht. No. 7.

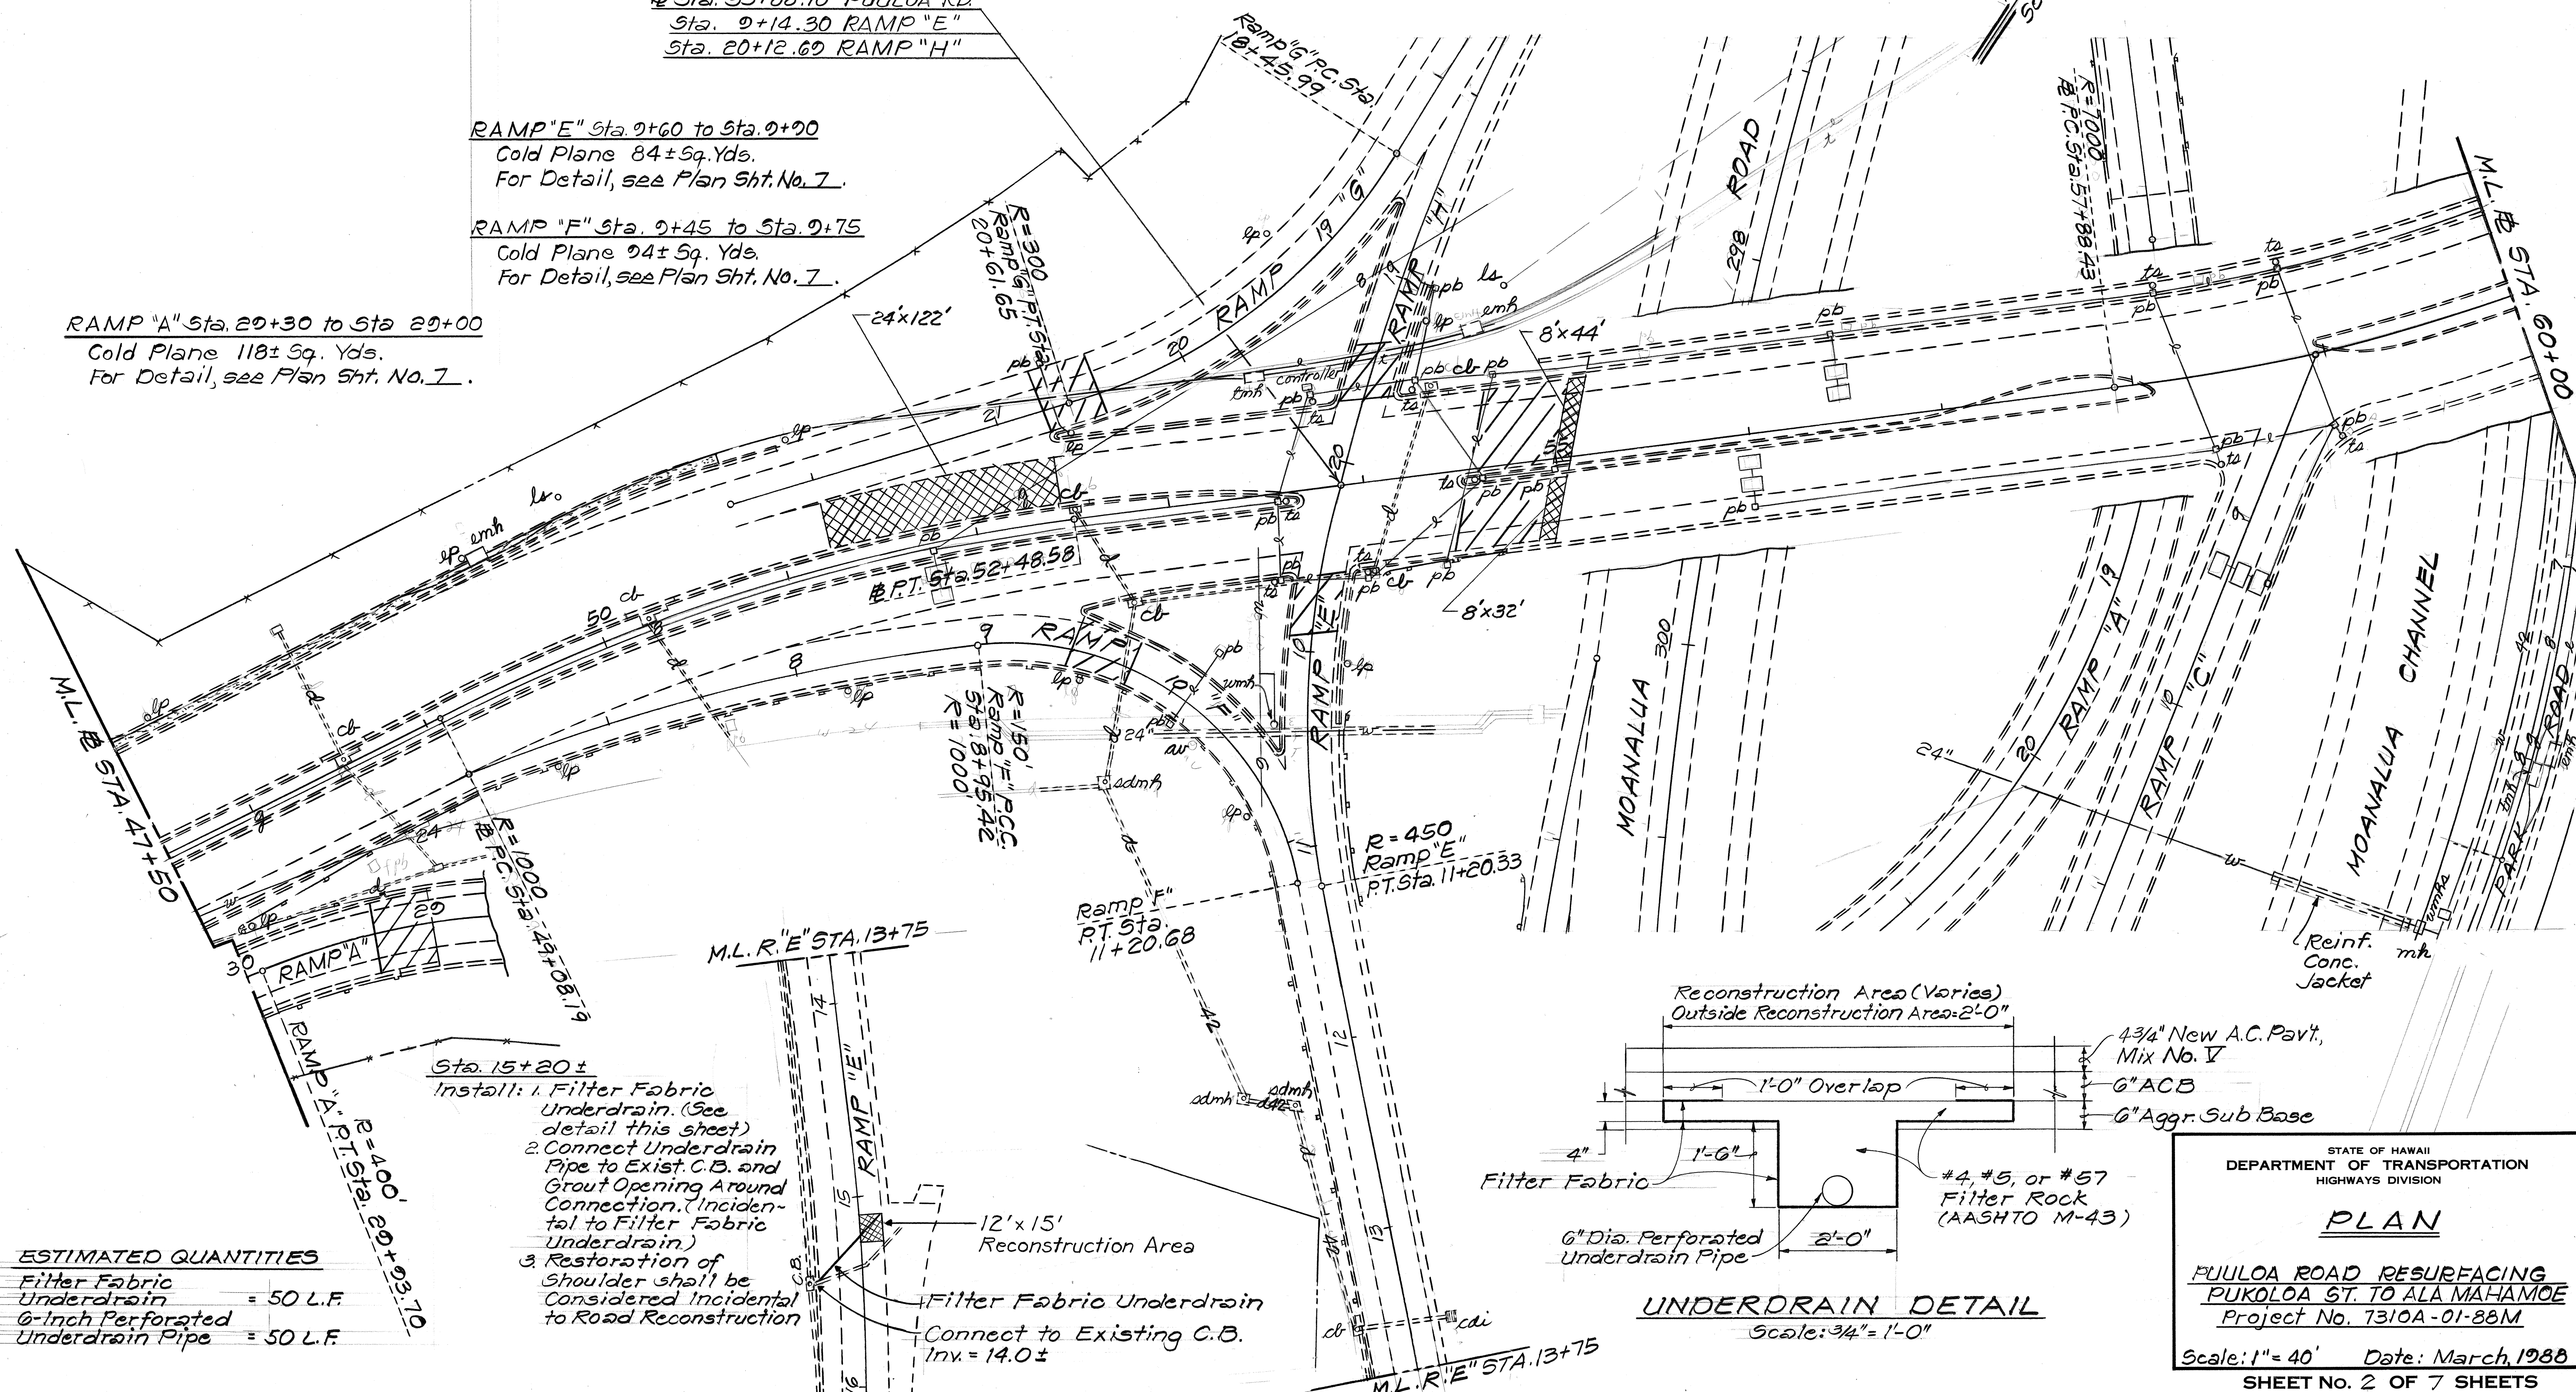

STATE OF HAWAII
DEPARTMENT OF TRANSPORTATION
HIGHWAYS DIVISION



PLAN

PUKILOA ROAD RESURFACING
PUKILOA ST. TO ALA MAHAMOE
Project No. 7310A-01-88M

Scale: 1"=40' Date: March, 1988

SHEET NO. 2 OF 7 SHEETS

FED. ROAD DIST. NO.	STATE	PROJ. NO.	FISCAL YEAR	SHEET NO.	TOTAL SHEETS
HAWAII	HAW.	7310A-01-88M	1988	10	23

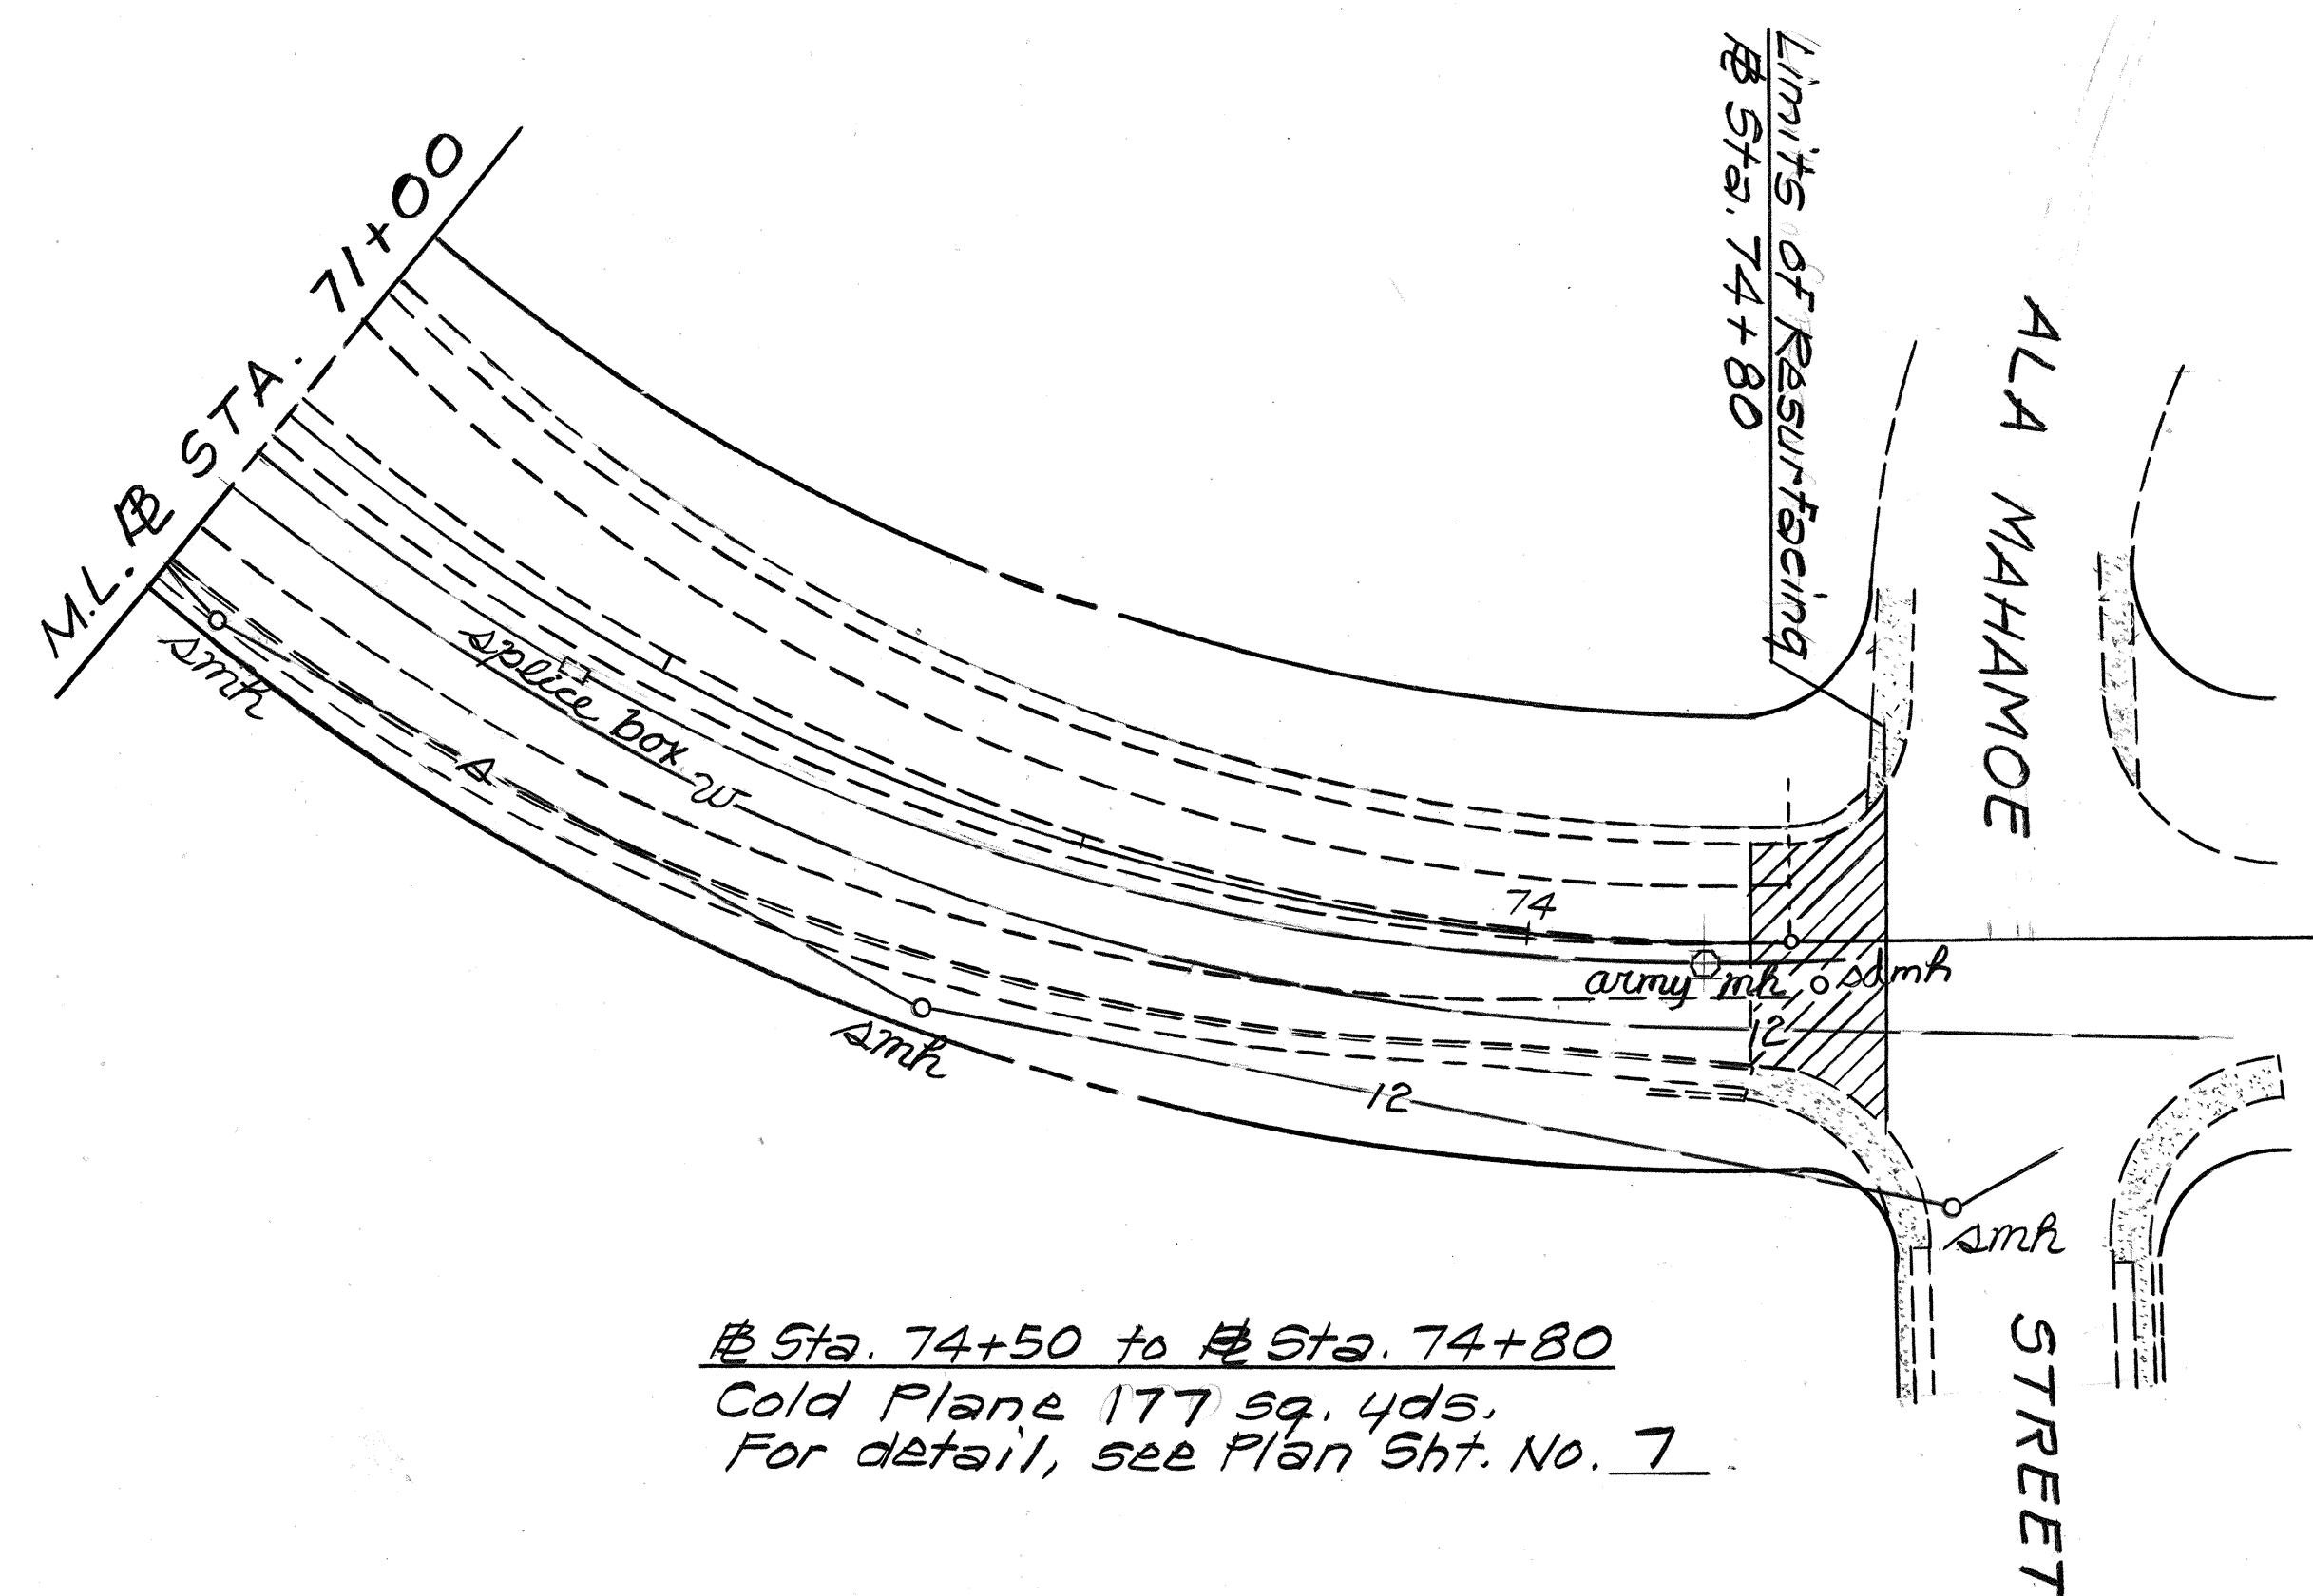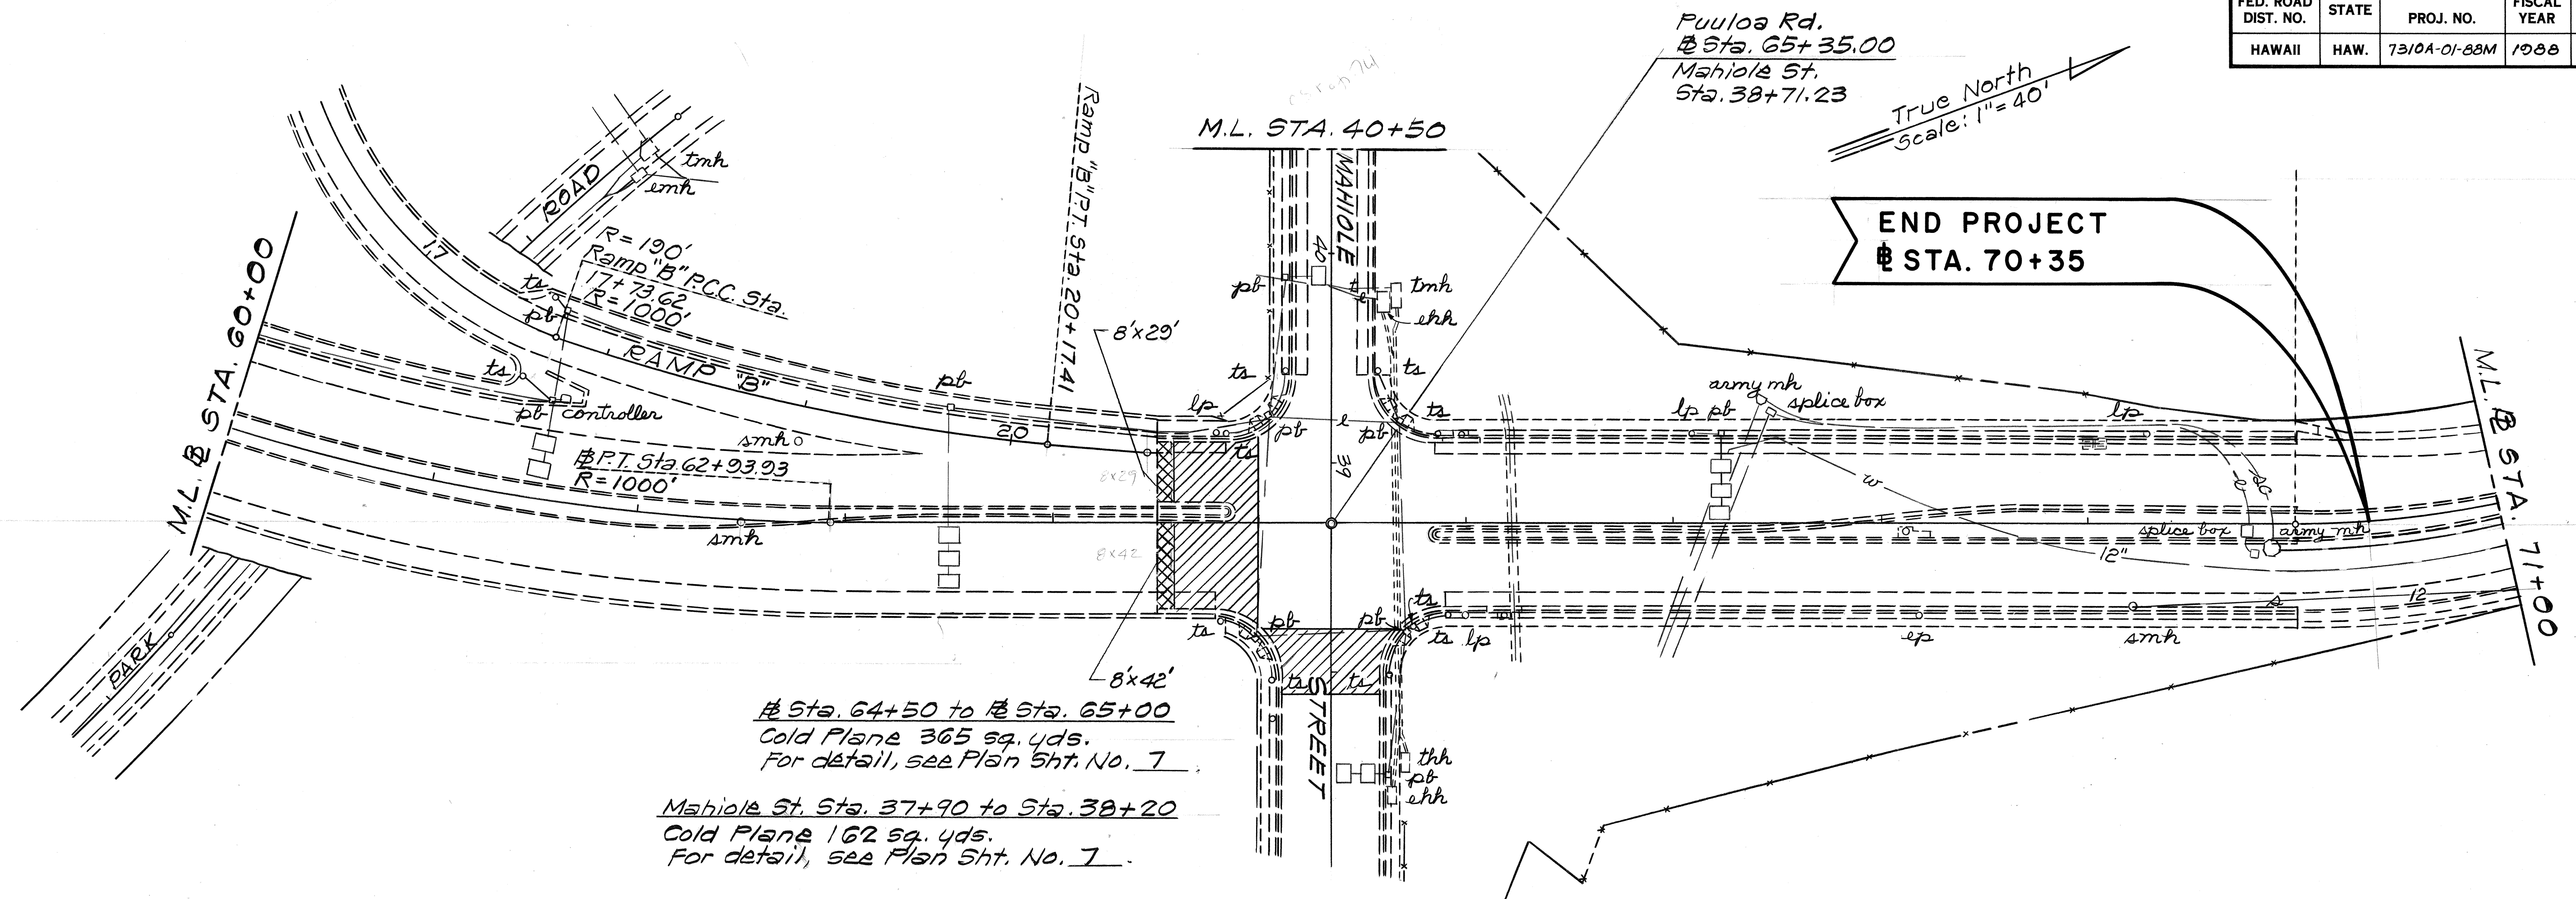

LEGEND

-  Cold Plane Area
 Reconstruction Area

STATE OF HAWAII
DEPARTMENT OF TRANSPORTATION
HIGHWAYS DIVISION

PLAN

PUULOA ROAD RESURFACING
PUKŌLOA ST. TO MAHIŌLE ST.
Project No. 7310A-01-88M



Scale: 1" = 40' Date: March, 1988

SHEET No. 3 OF 7 SHEETS

FED. ROAD DIST. NO.	STATE	PROJ. NO.	FISCAL YEAR	SHEET NO.	TOTAL SHEETS
HAWAII	HAW.	7310A-01-88M	1988	11	23

#Sta. 49+26 to #Sta. 49+36.55
Transition to exist. pav't.
For detail, see Plan Sht. No. 7

True North
Scale: 1" = 40'

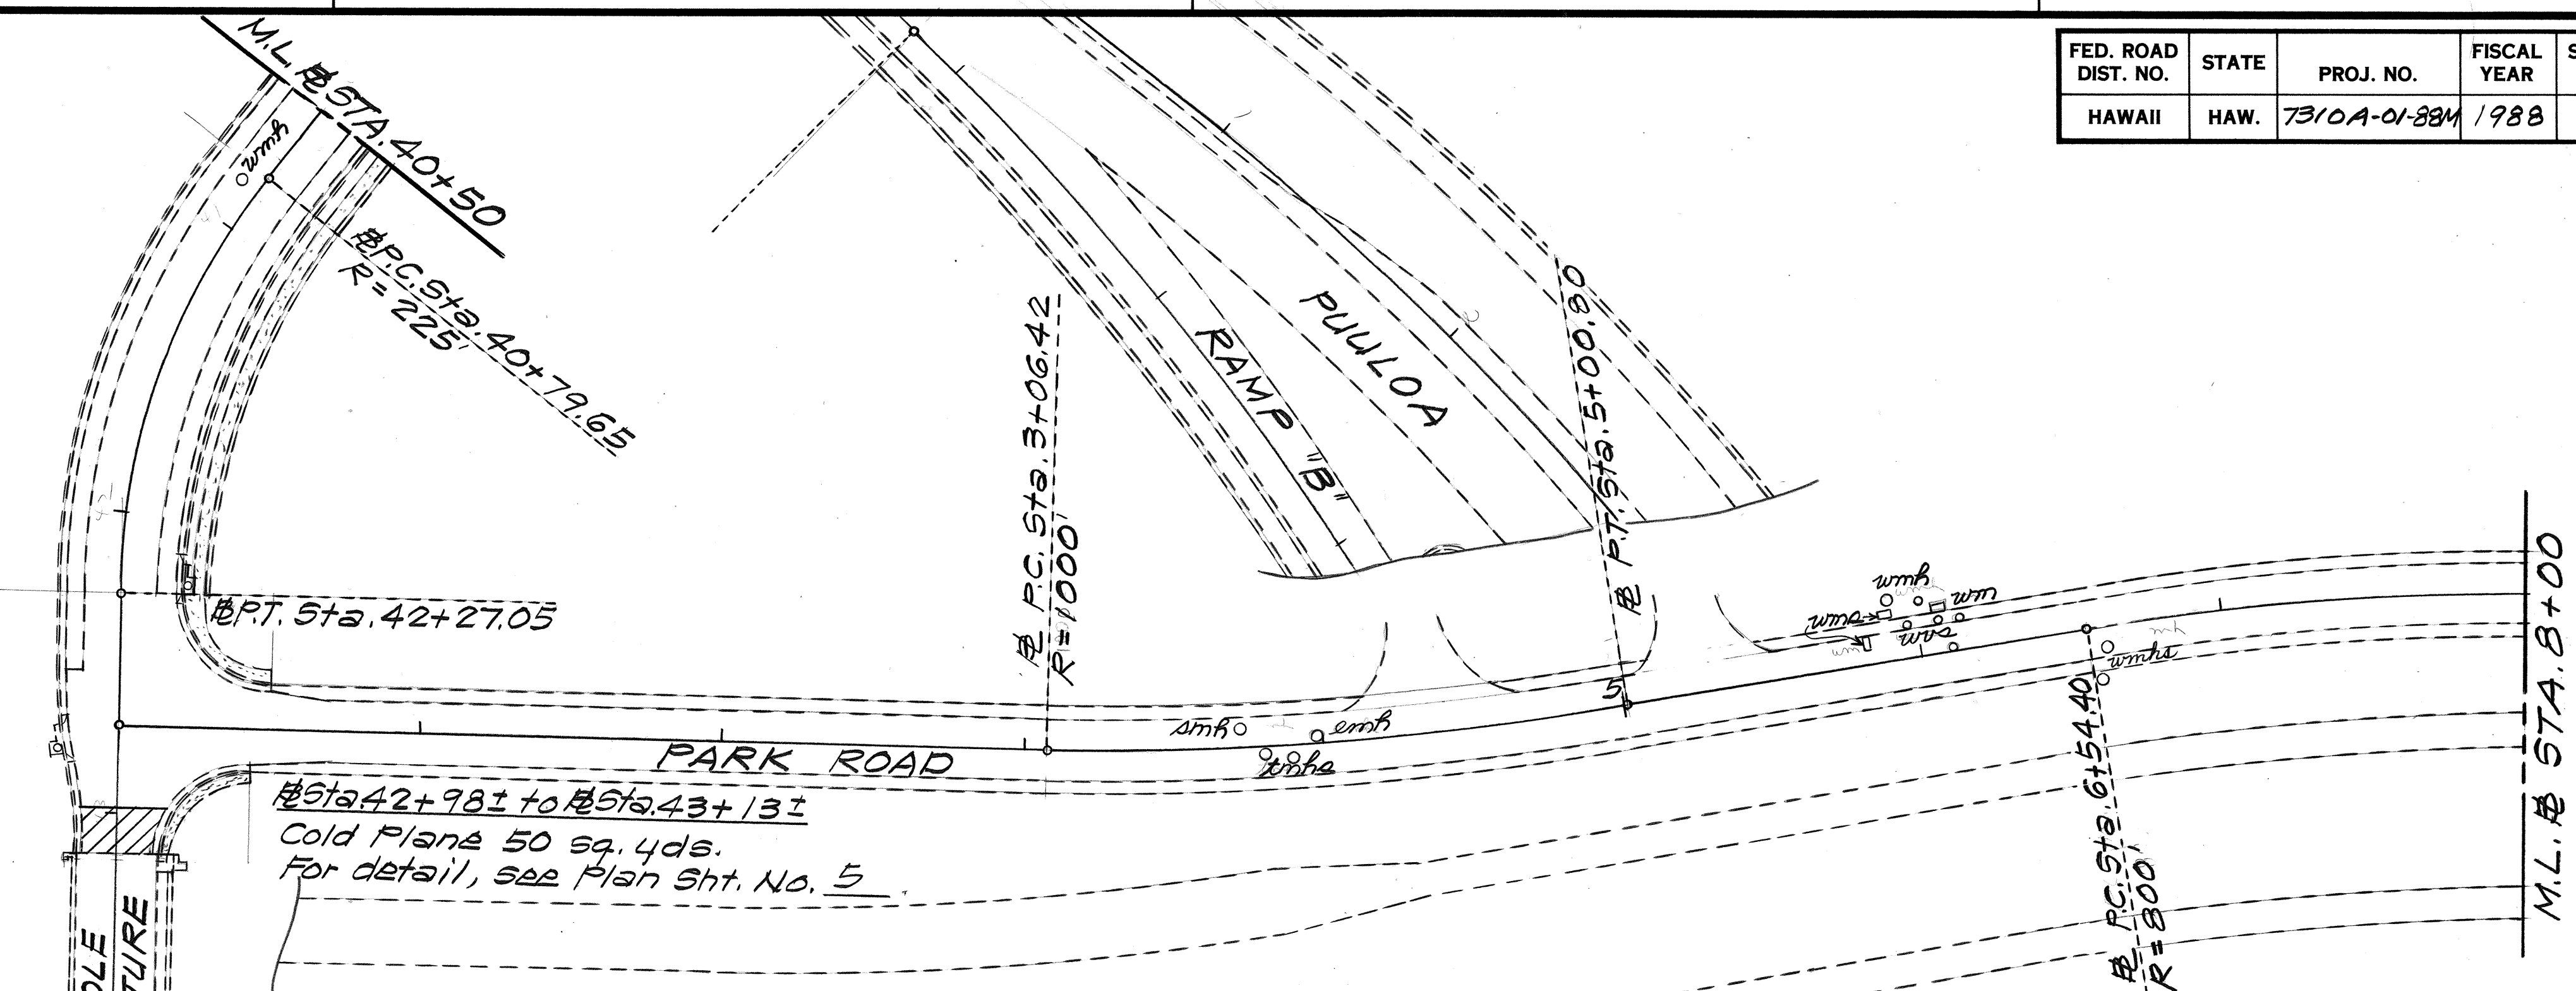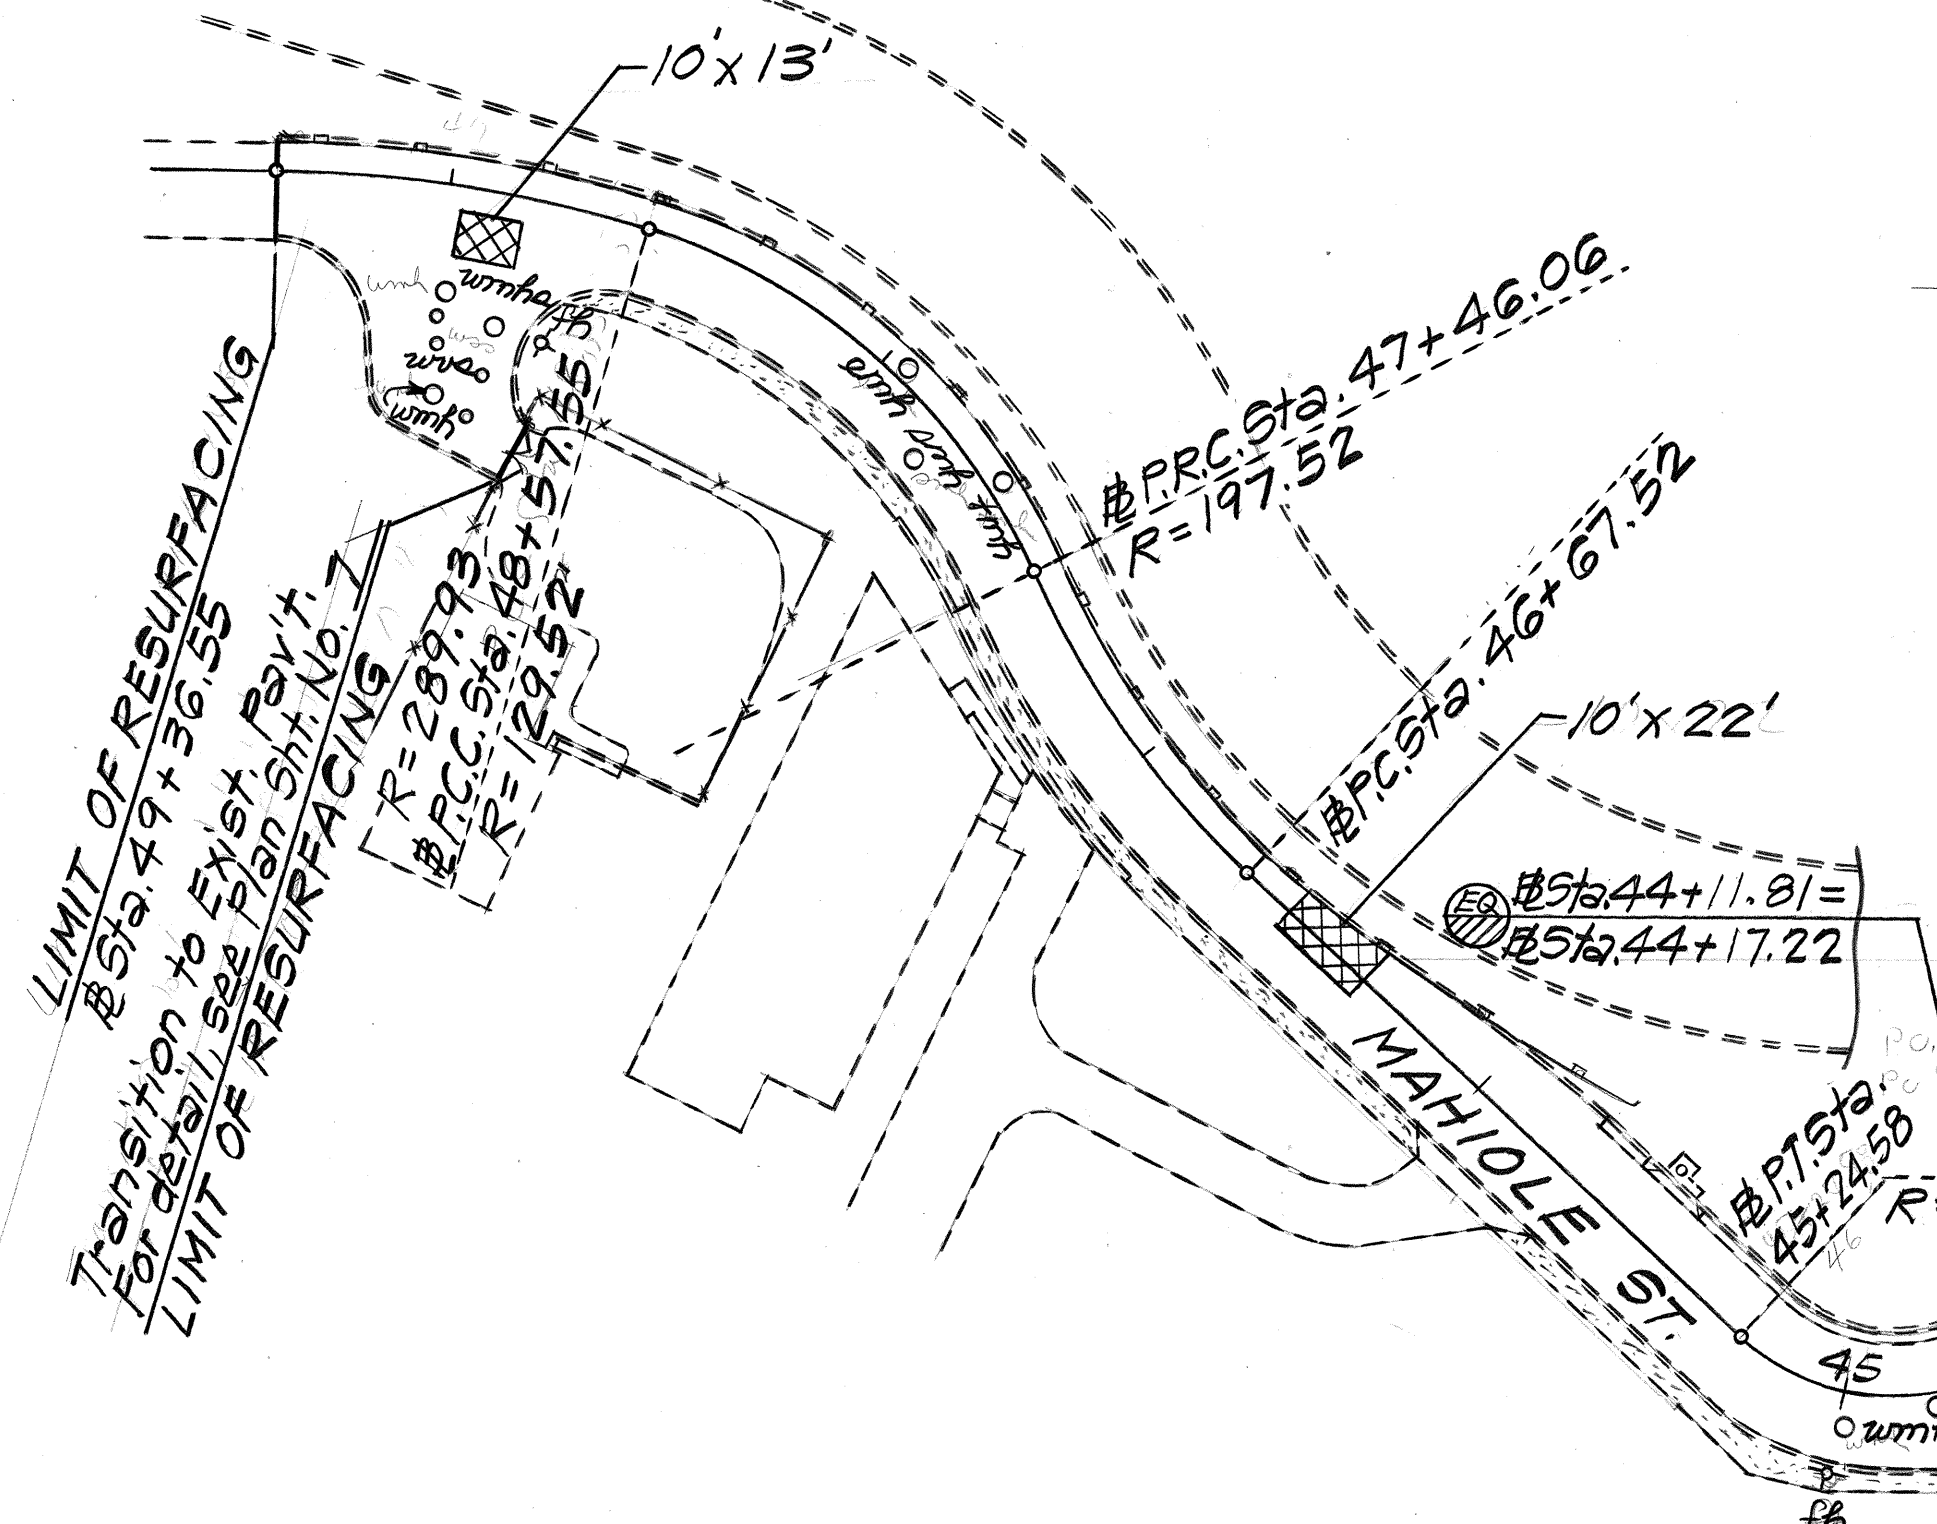

#Sta. 42+98± to #Sta. 43+13±
Cold Plane 50 sq. yds.
For detail, see Plan Sht. No. 5

#Sta. 44+18± to #Sta. 44+33±
Cold Plane 55 sq. yds.
For detail, see Plan Sht. No. 5

LIMIT OF RESURFACING
#Sta. 5+15± to #Sta. 5+40±
P.T. Sta. 3+25.01
R=255'


Existing Parking Lot

LEGEND

- Cold Plane Area
- Reconstruction Area

True North
Scale: 1" = 40'

#Sta. 13+30 to #Sta. 13+40
Transition to existing pav't.
For detail, see Plan Sht. No. 7

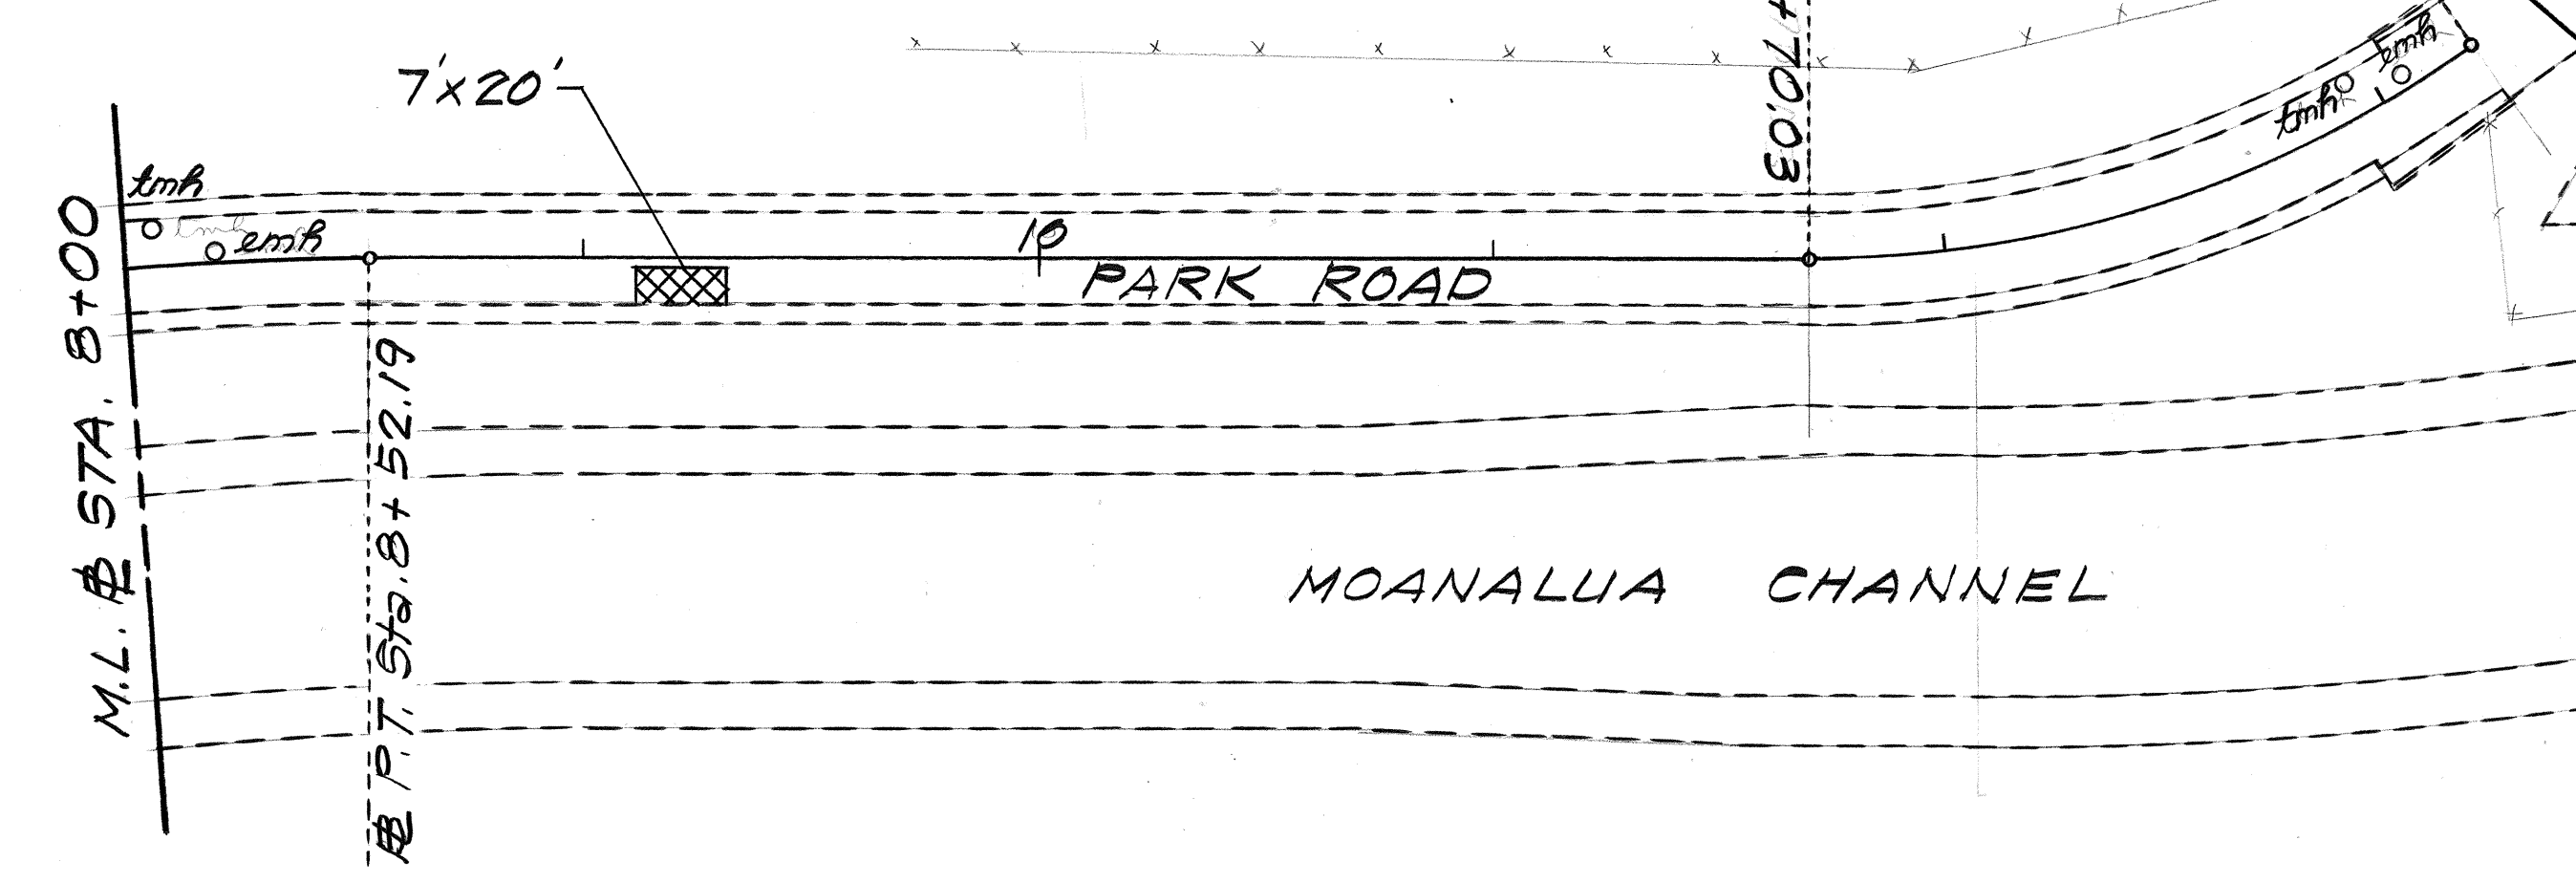


STATE OF HAWAII
DEPARTMENT OF TRANSPORTATION
HIGHWAYS DIVISION

PLAN

PULOLOA ROAD RESURFACING
PULOLOA ST. TO MAHIOLE ST.
Project No. 7310A-01-88M
Scale: 1" = 40' Date: Mar., 1988
SHEET NO. 4 OF 7 SHEETS

DATE	
DESIGNED BY	
DRAWN BY	
CHECKED BY	
ORIGINAL PLAN	
NOTE BOOK	
No.	

FED. ROAD DIST. NO.	STATE	PROJ. NO.	FISCAL YEAR	SHEET NO.	TOTAL SHEETS
HAWAII	HAW.	7310A-01-88M	1988	12	23

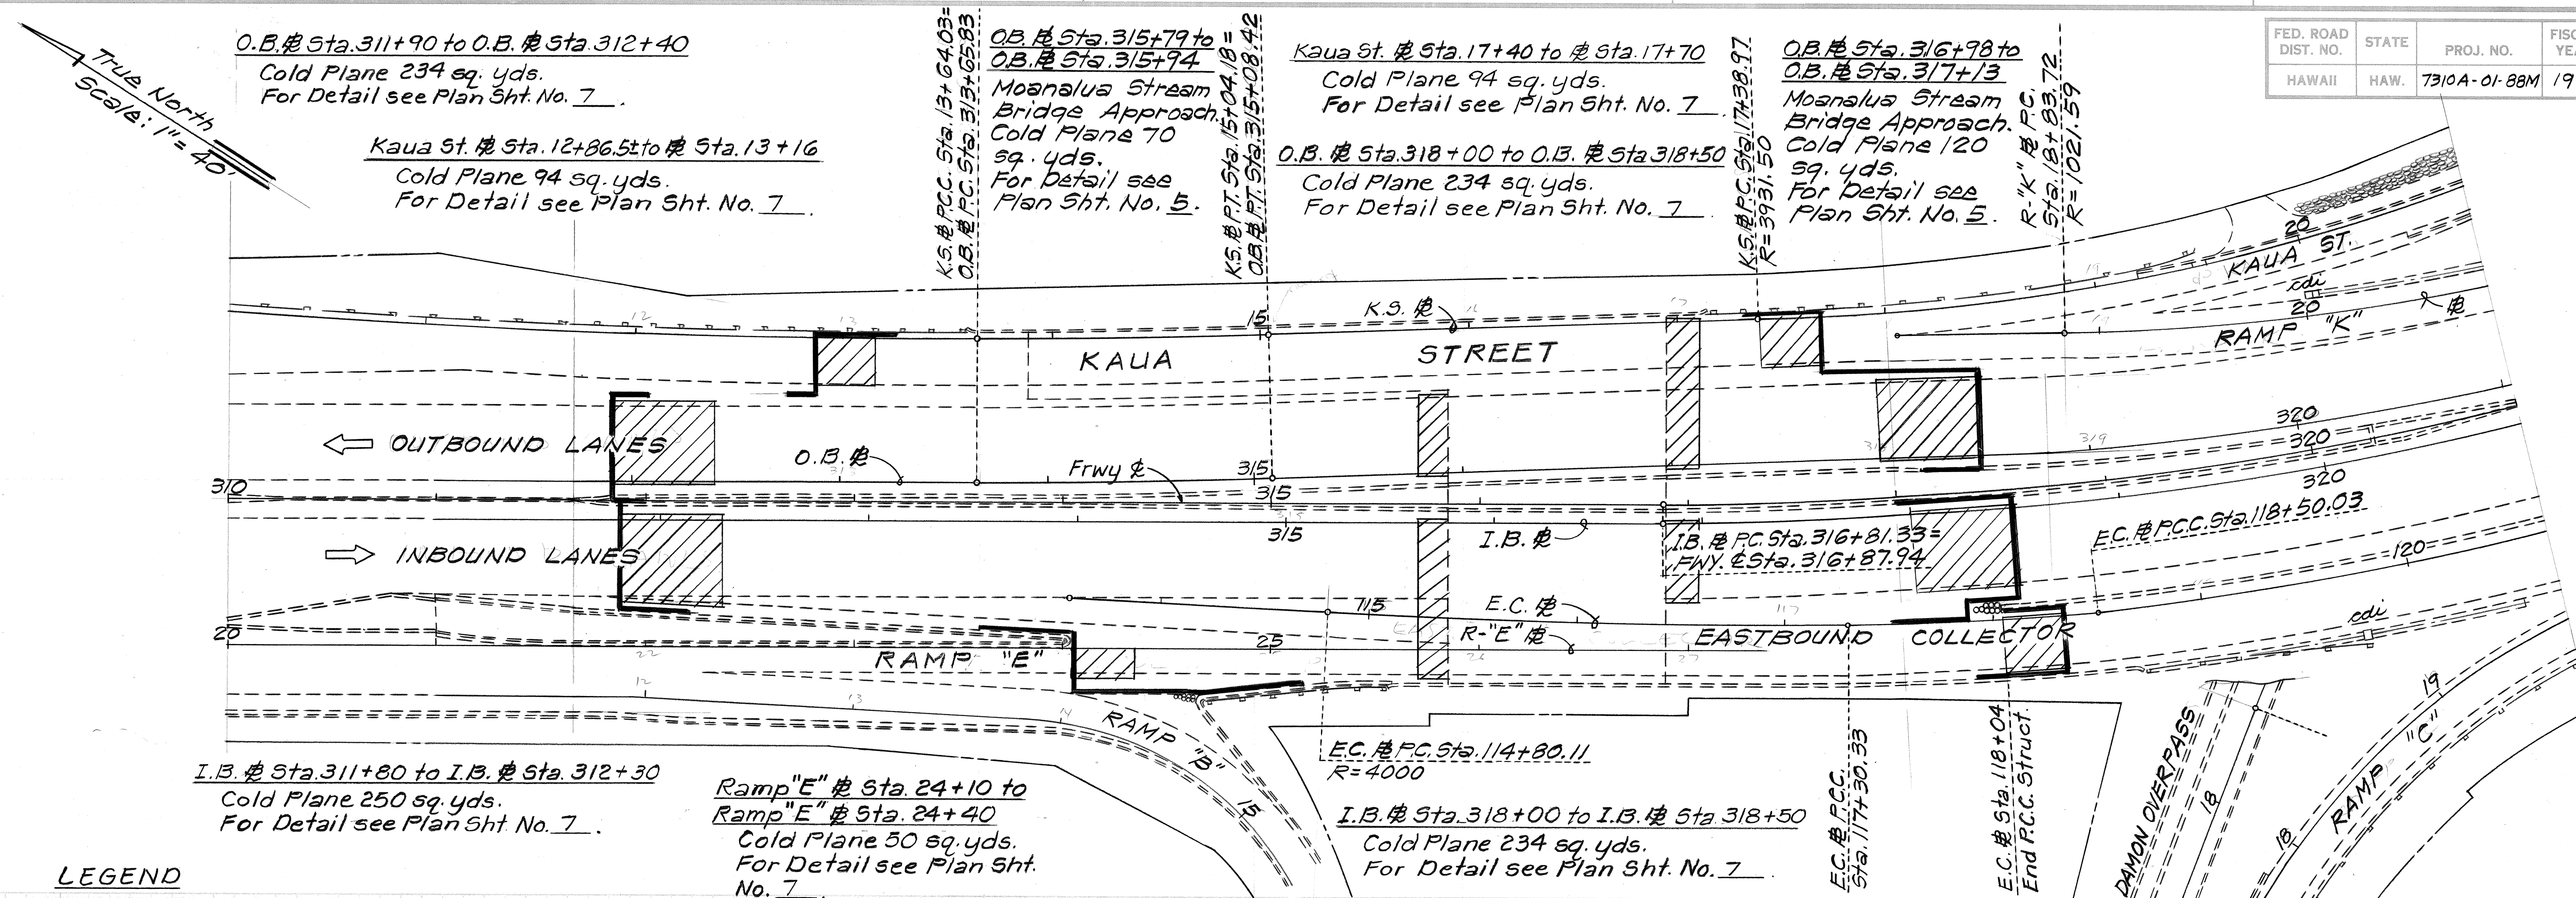

LEGEND


- Cold Planing Areas
- Resurfacing Limits

NOTE:

The Contractor shall exercise caution when adjusting the Portable Concrete Guardrail so as not to cause undue damages to the Guardrail and/or other improvements. Guardrail or guardrail components damaged as a result of the Contractor's operation will be replaced with new ones as called for by the Engineer. The Contractor shall be responsible for all cost of any damages to the guardrail and/or components as a result of the Contractor's operation, including but not limited to repairs and replacements.



ORIGINAL PLAN	SURVEY PLOTTED BY	DATE
NOTE BOOK	DRAWN BY	
	TRACED BY	
	CHECKED BY	
	QUANTITIES BY	

ORIGINAL PLAN	SURVEY PLOTTED BY _____	DATE _____
NOTE BOOK	DRAWN BY _____	" _____
	TRACED BY _____	" _____
	DESIGNED BY _____	" _____
	QUANTITIES BY _____	" _____
NO. _____	CHECKED BY _____	" _____

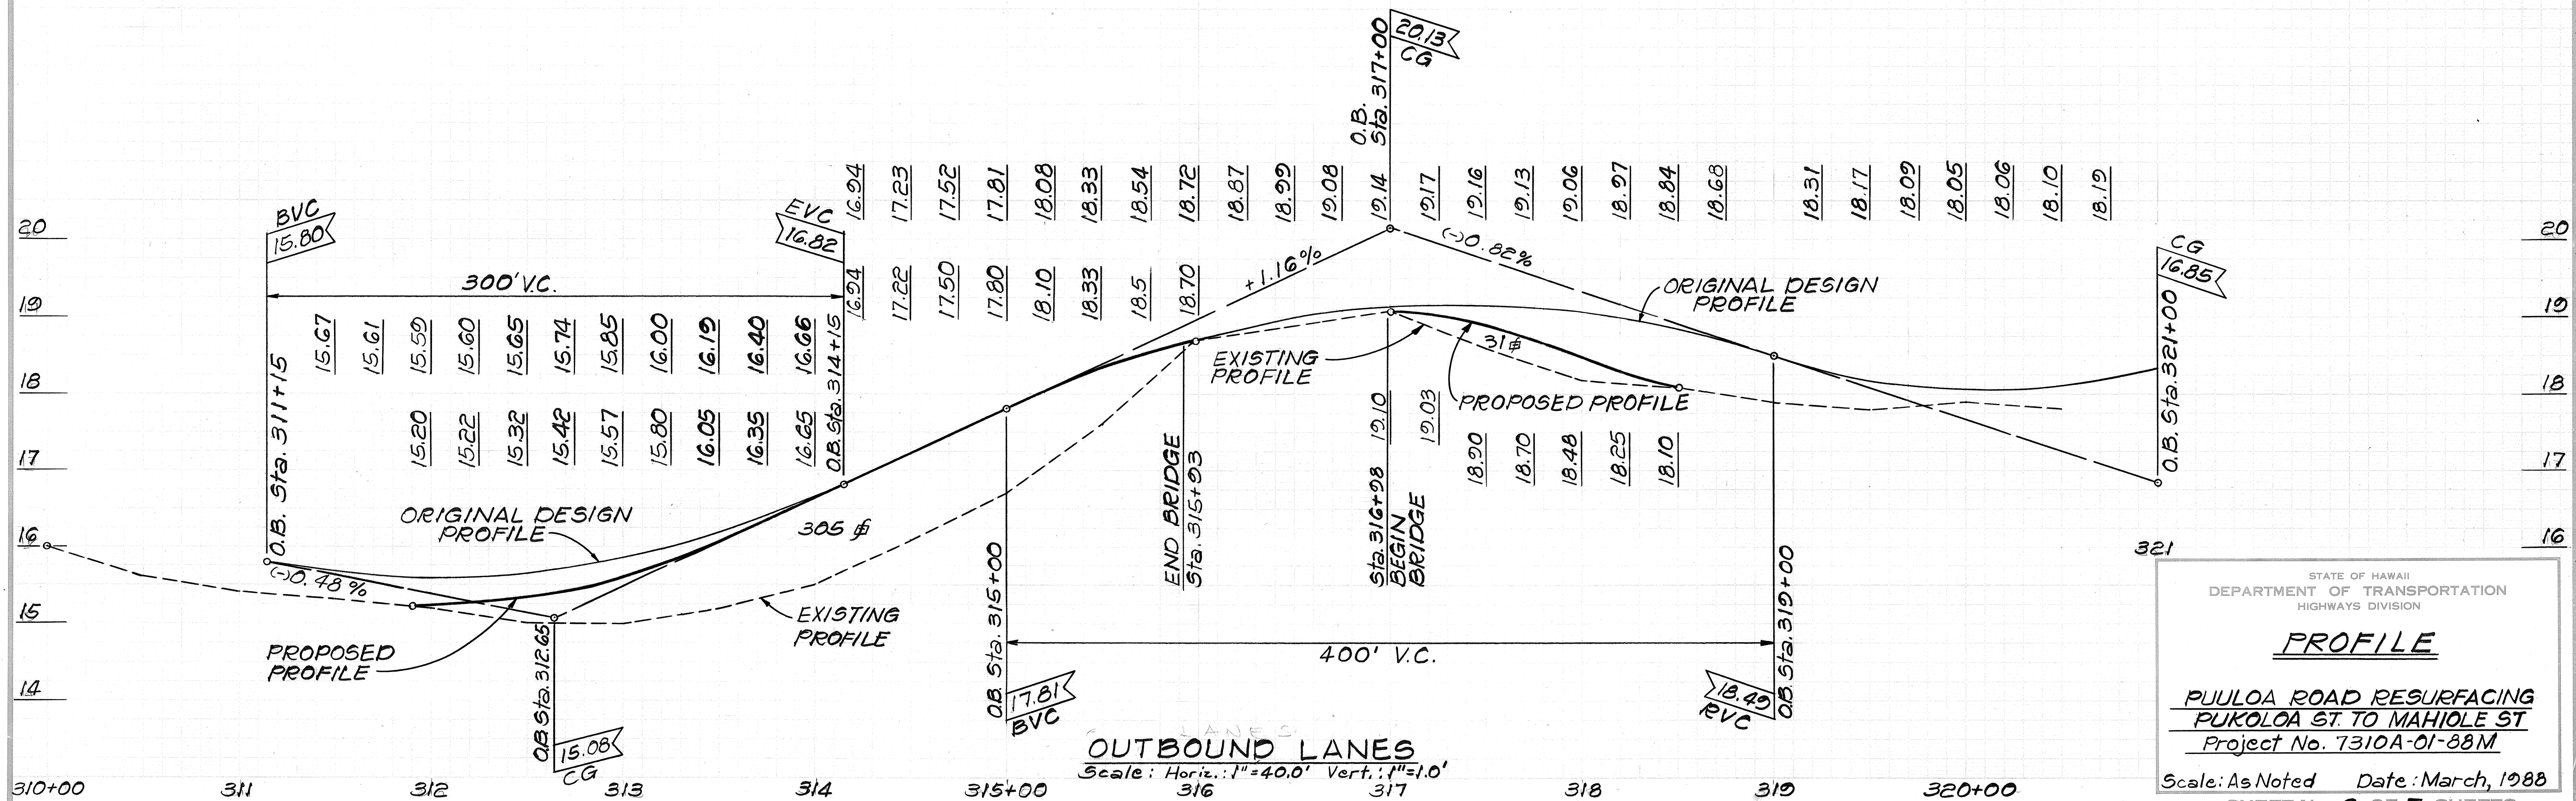

13

FED. ROAD DIST. NO.	STATE	PROJ. NO.	FISCAL YEAR	SHEET NO.	TOTAL SHEETS
HAWAII	HAW.	7310A-01-88M	1988	14	23

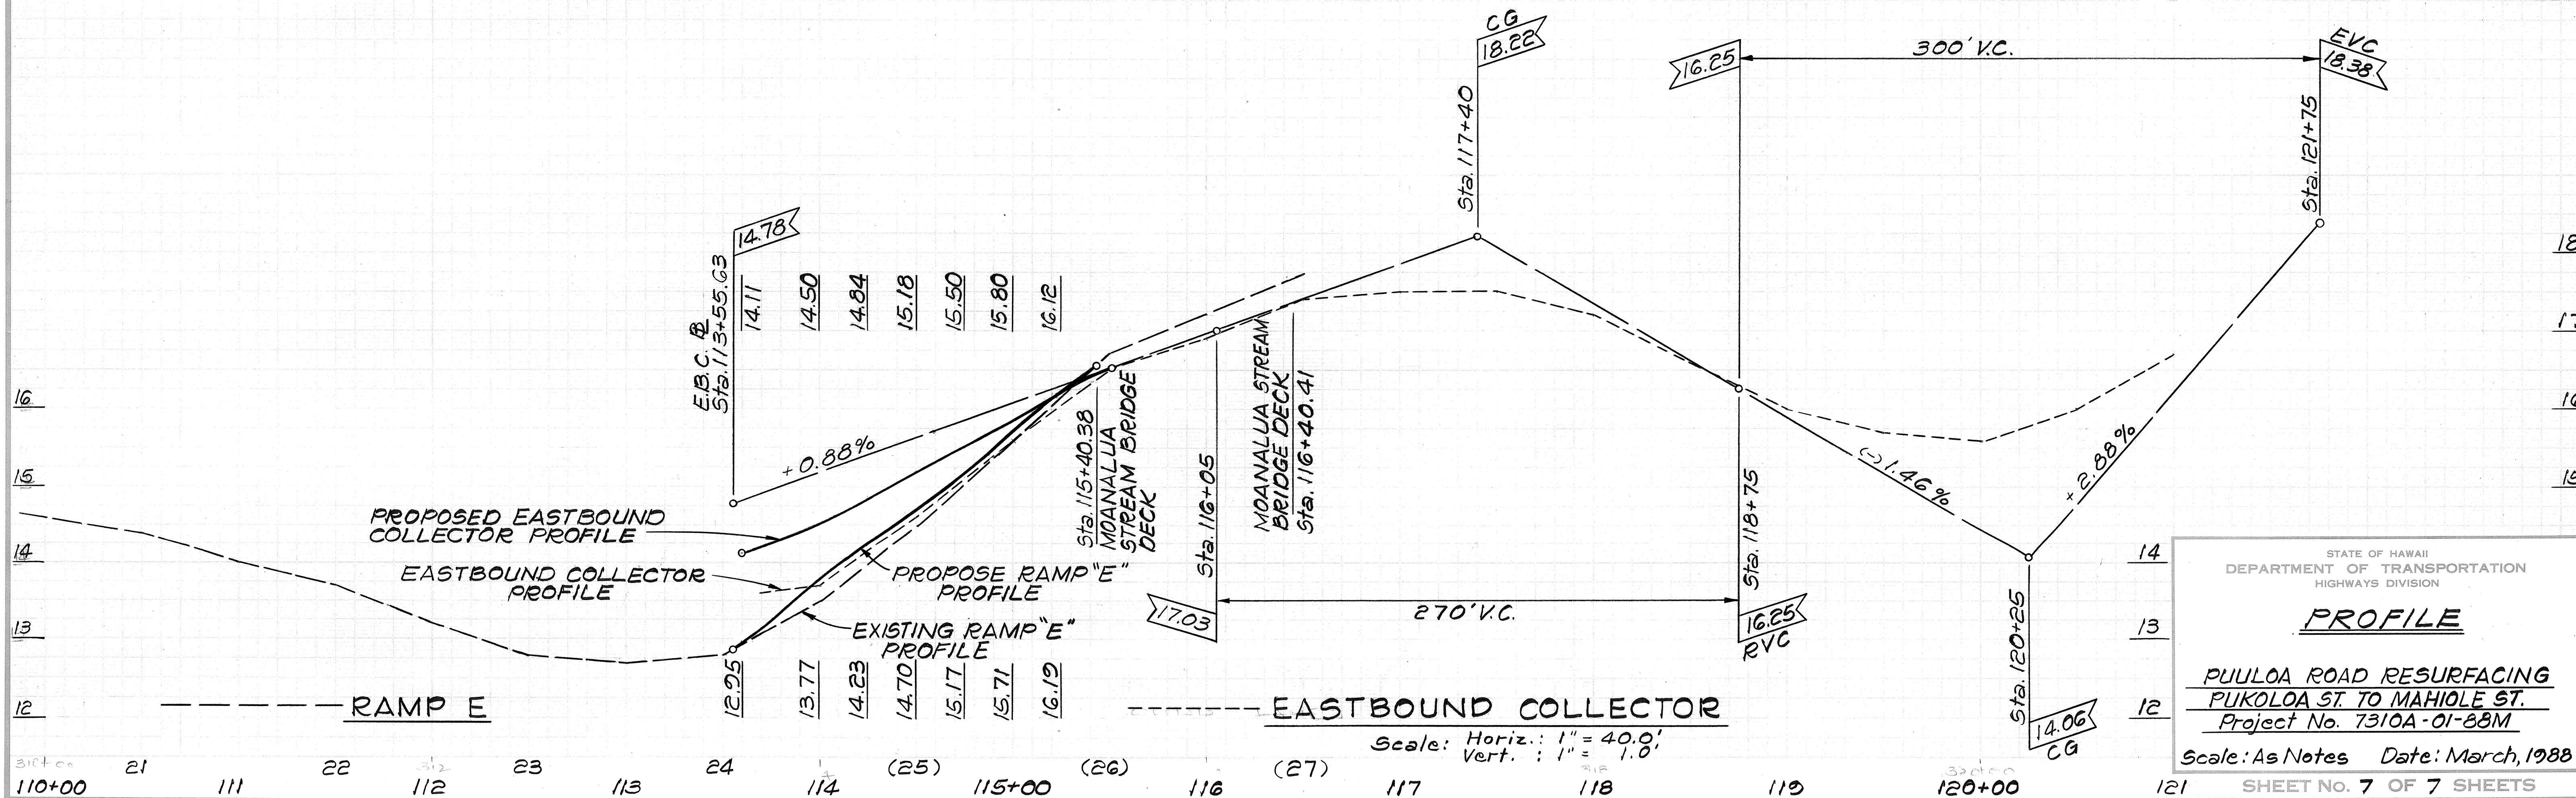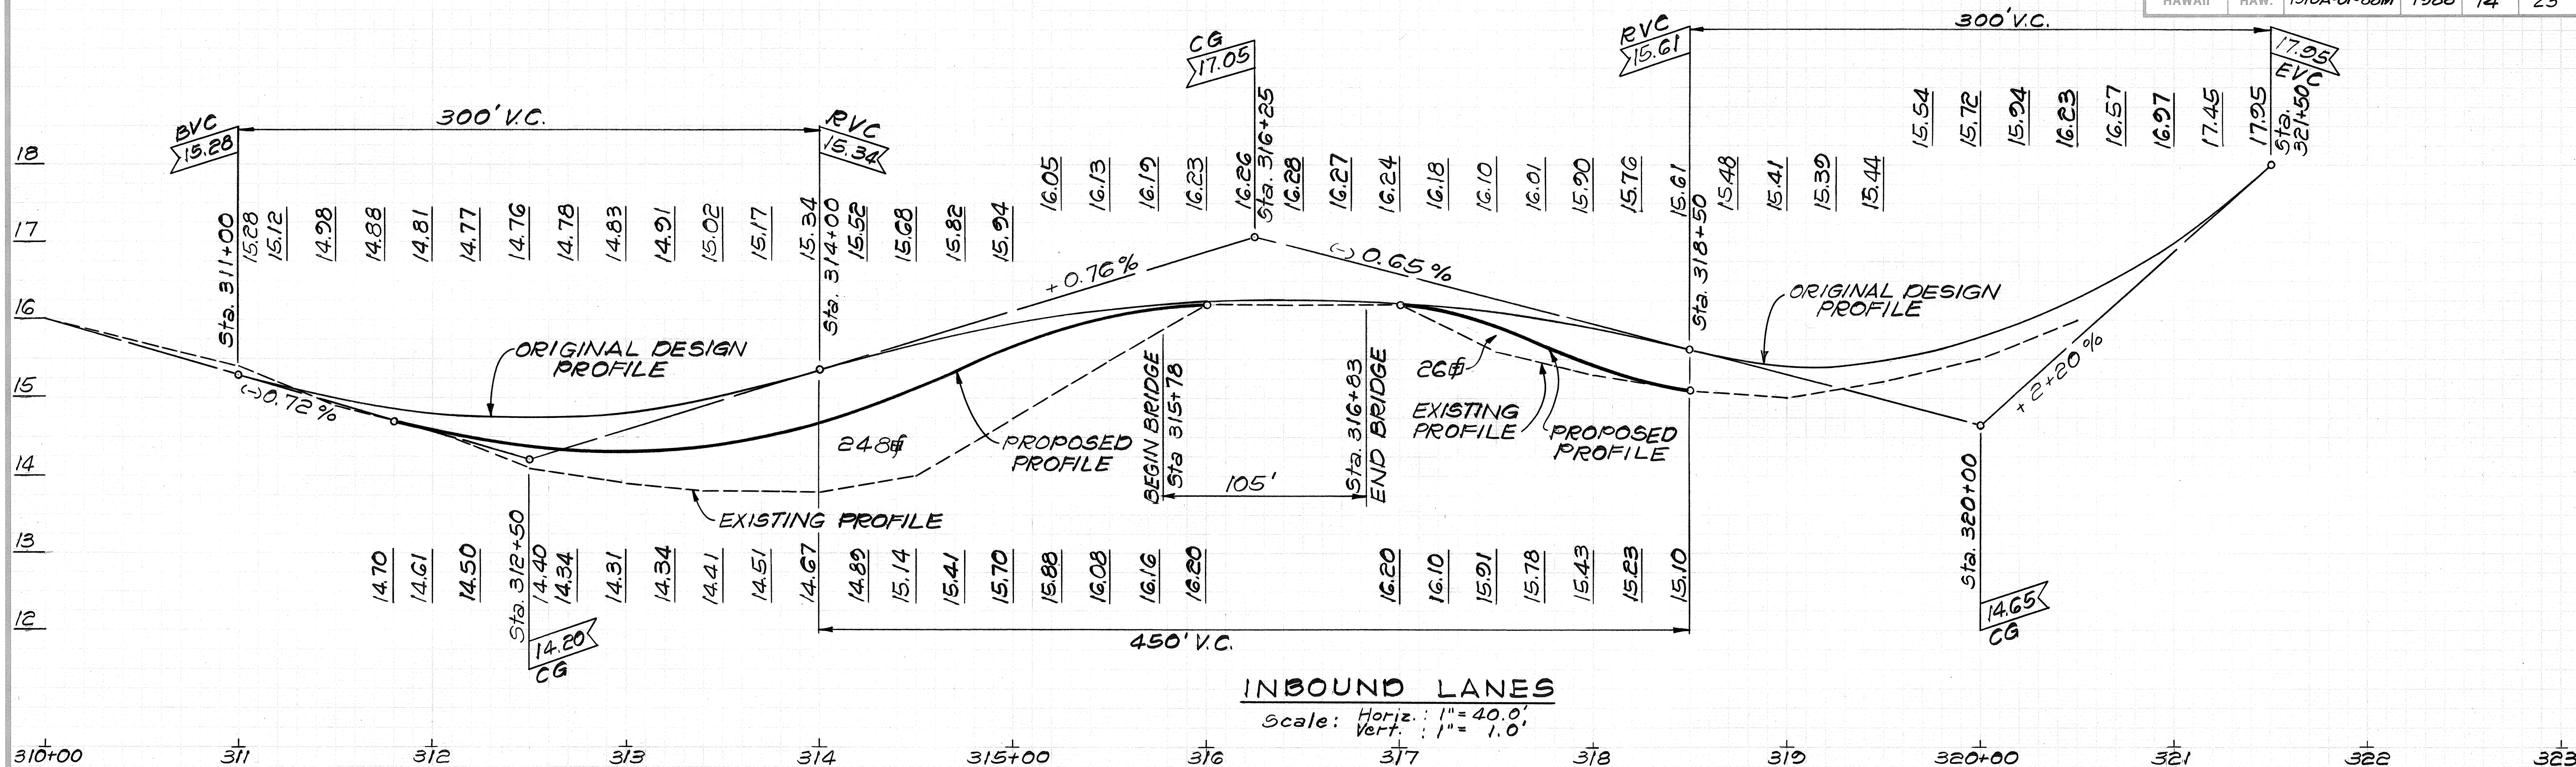

STATE OF HAWAII
DEPARTMENT OF TRANSPORTATION
HIGHWAYS DIVISION

PROFILE

PULUOA ROAD RESURFACING
PULUOA ST. TO MAHIOLE ST.
Project No. 7310A-01-88M

Scale: As Notes Date: March, 1988

SHEET NO. 7 OF 7 SHEETS

ORIGINAL PLAN	DATE
DRAWN BY	
CHECKED BY	
NOTE BOOK	
NO.	