
·	
	INDEX TO DRAWINGS
SHEET NO.	DESCRIPTION
1 1 1	TITLE SHEET
2	STANDARD PLANS SUMMARY
3	GENERAL NOTES
4 – 7	TYPICAL SECTIONS AND MISC. DETAILS
8 – 14	PLAN AND PROFILE
15 – 21	SIGNING & PAVEMENT MARKING PLANS AND DETAILS
22 + 23	END POST CONNECTION PLANS AND DETAILS
,	
-	
,	
	,


STATE OF HAWAII

DEPARTMENT OF TRANSPORTATION
HIGHWAYS DIVISION
HONOLULU, HAWAII
"AS-BUILT"
PLANS FOR

PUULOA ROAD RESURFACING
PUKOLOA STREET TO MAHIOLE STREET
PROJECT NO. 7310A - 01-88M

DISTRICT OF HONOLULU ISLAND OF OAHU

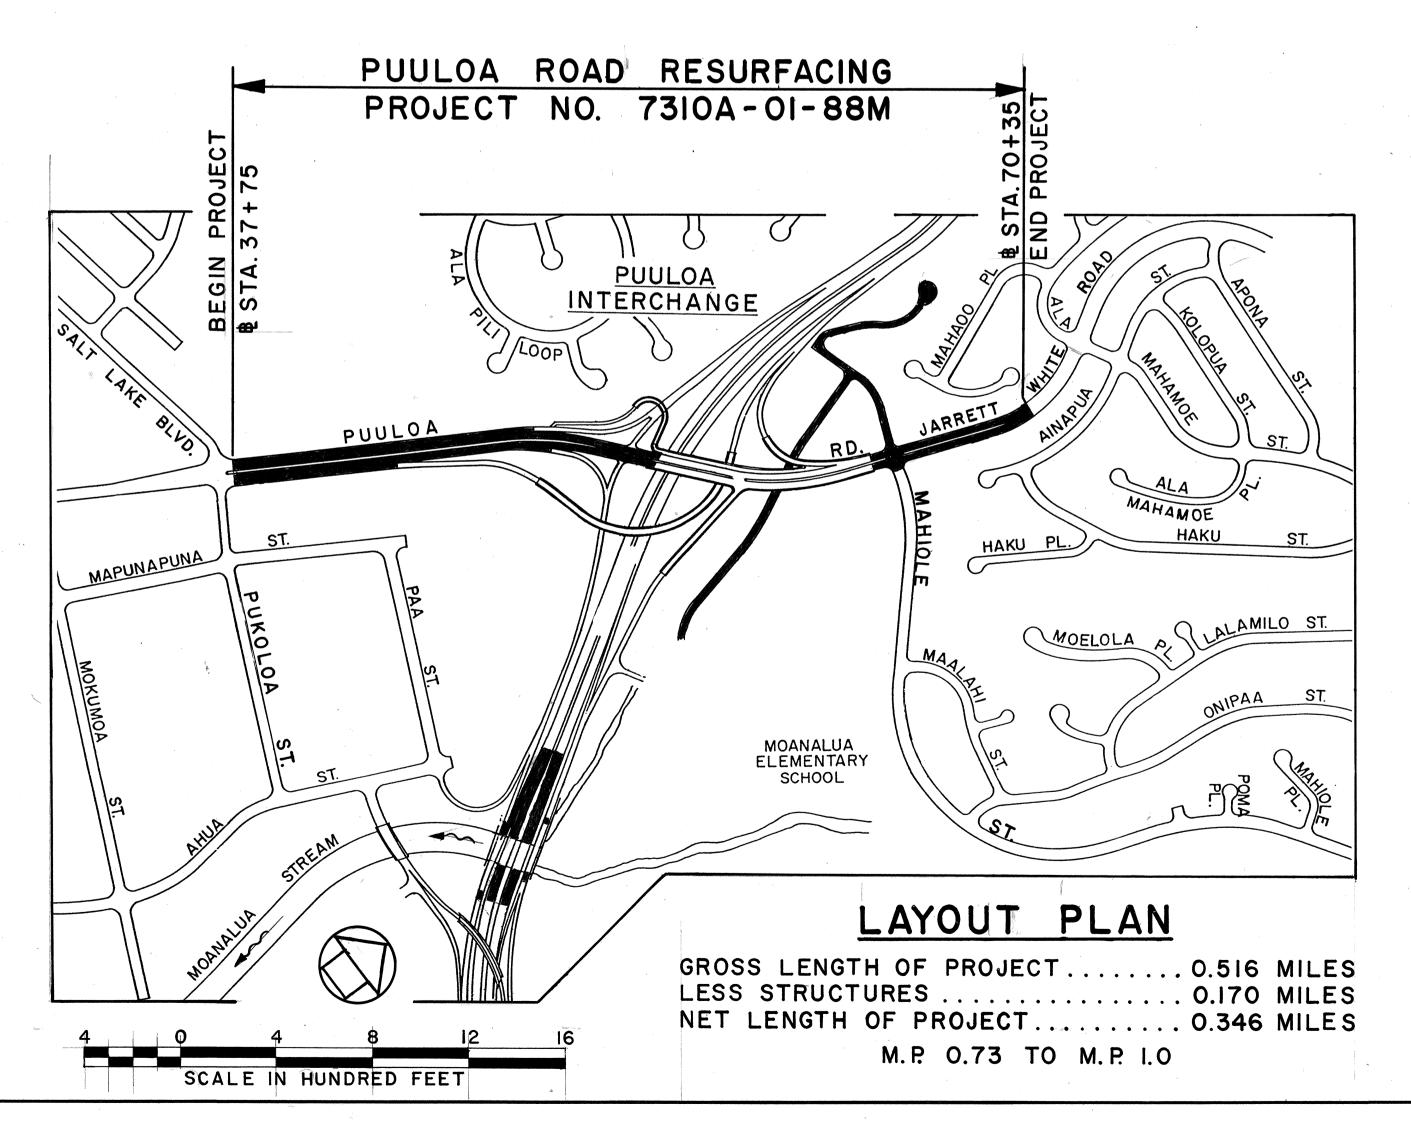

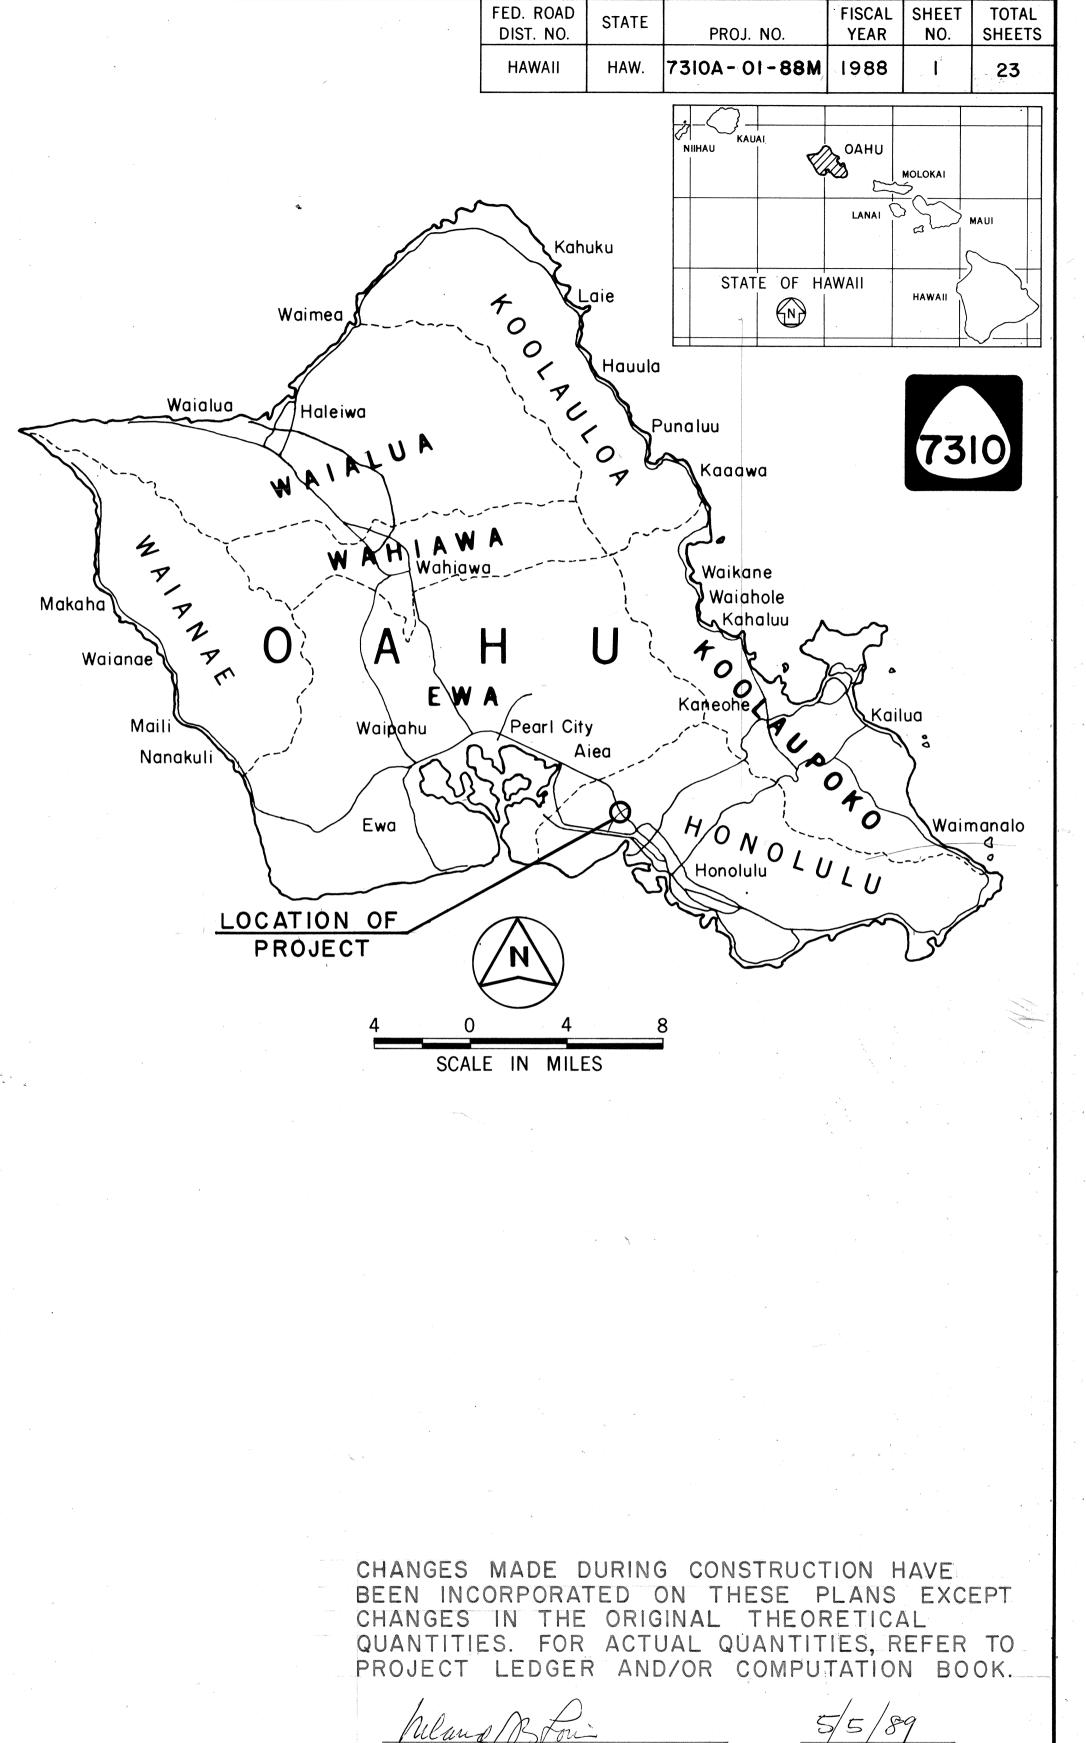

AN T. NISHIMURA 5

00-8-6-9

DEPARTMENT OF TRANSPORTATION STATE OF HAWAII

APPROVED: