
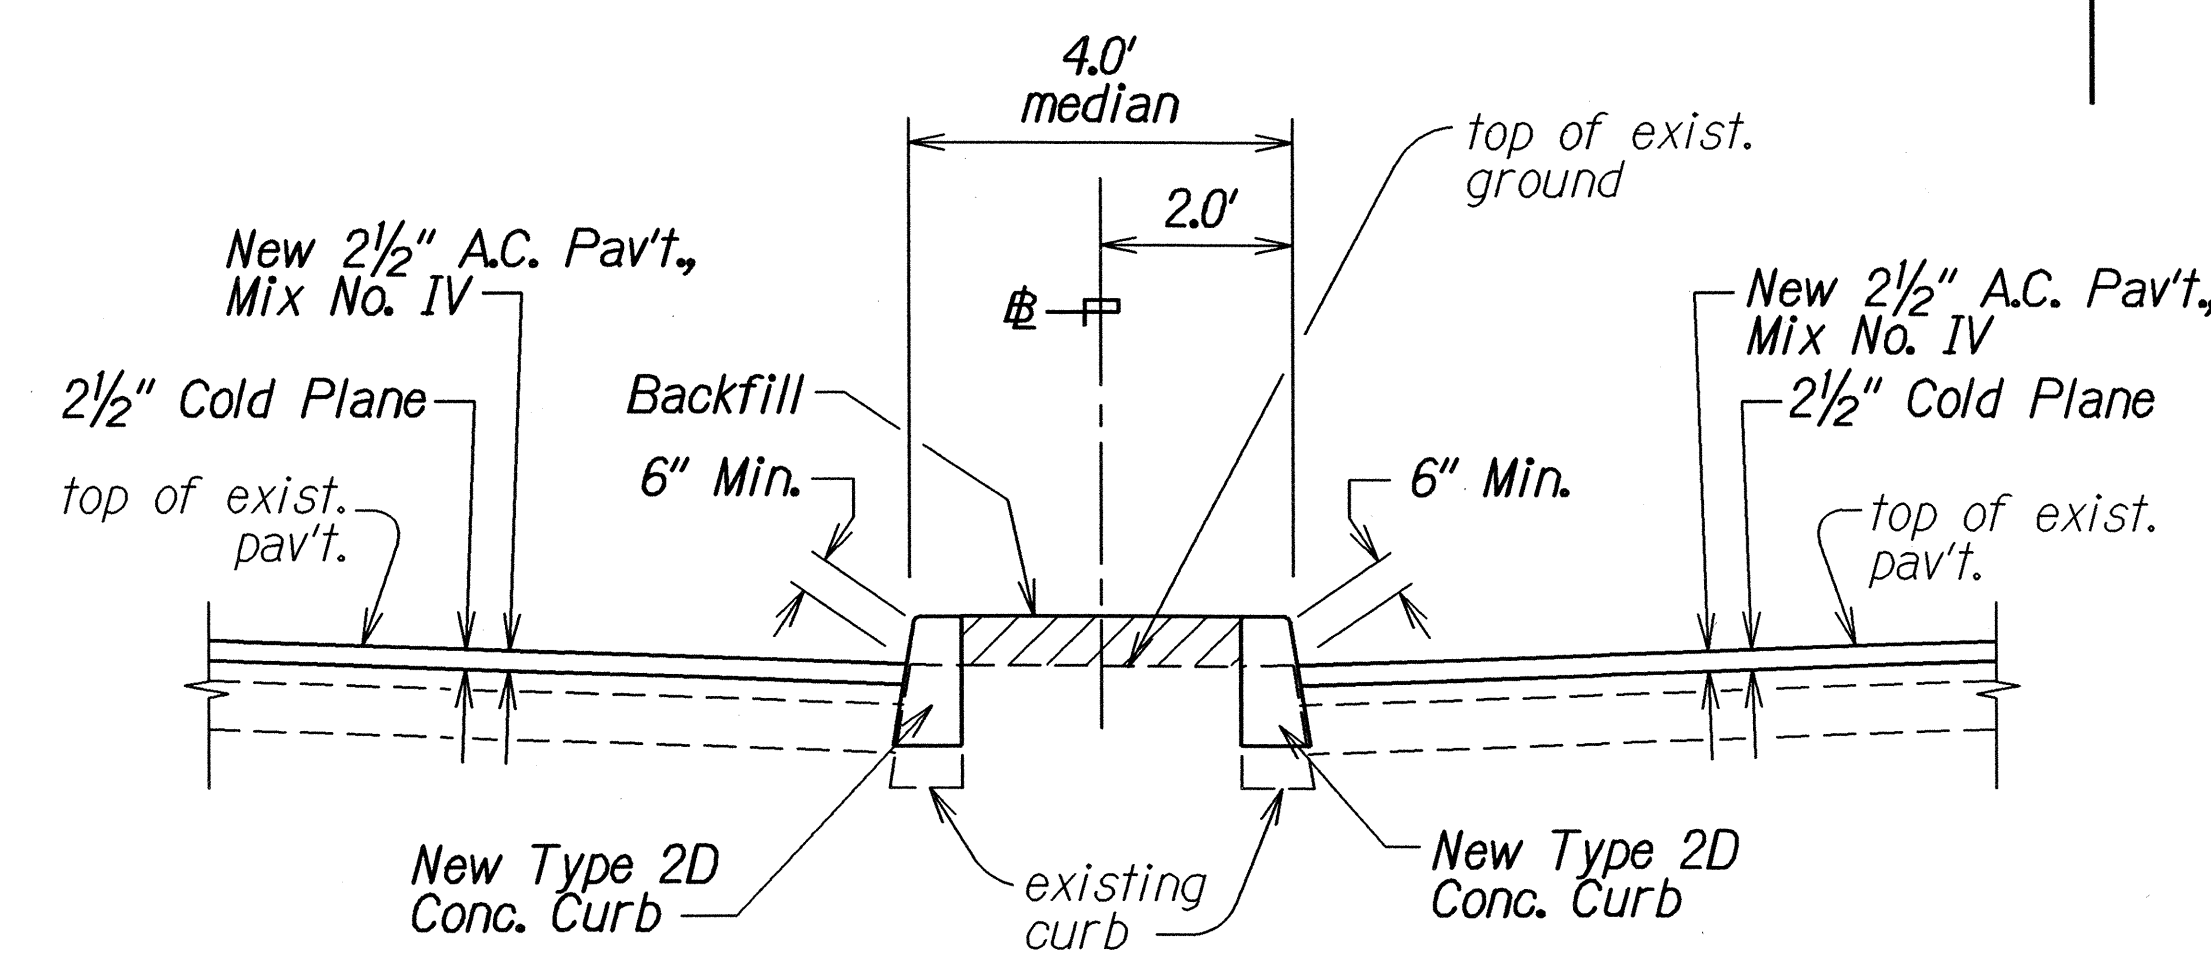
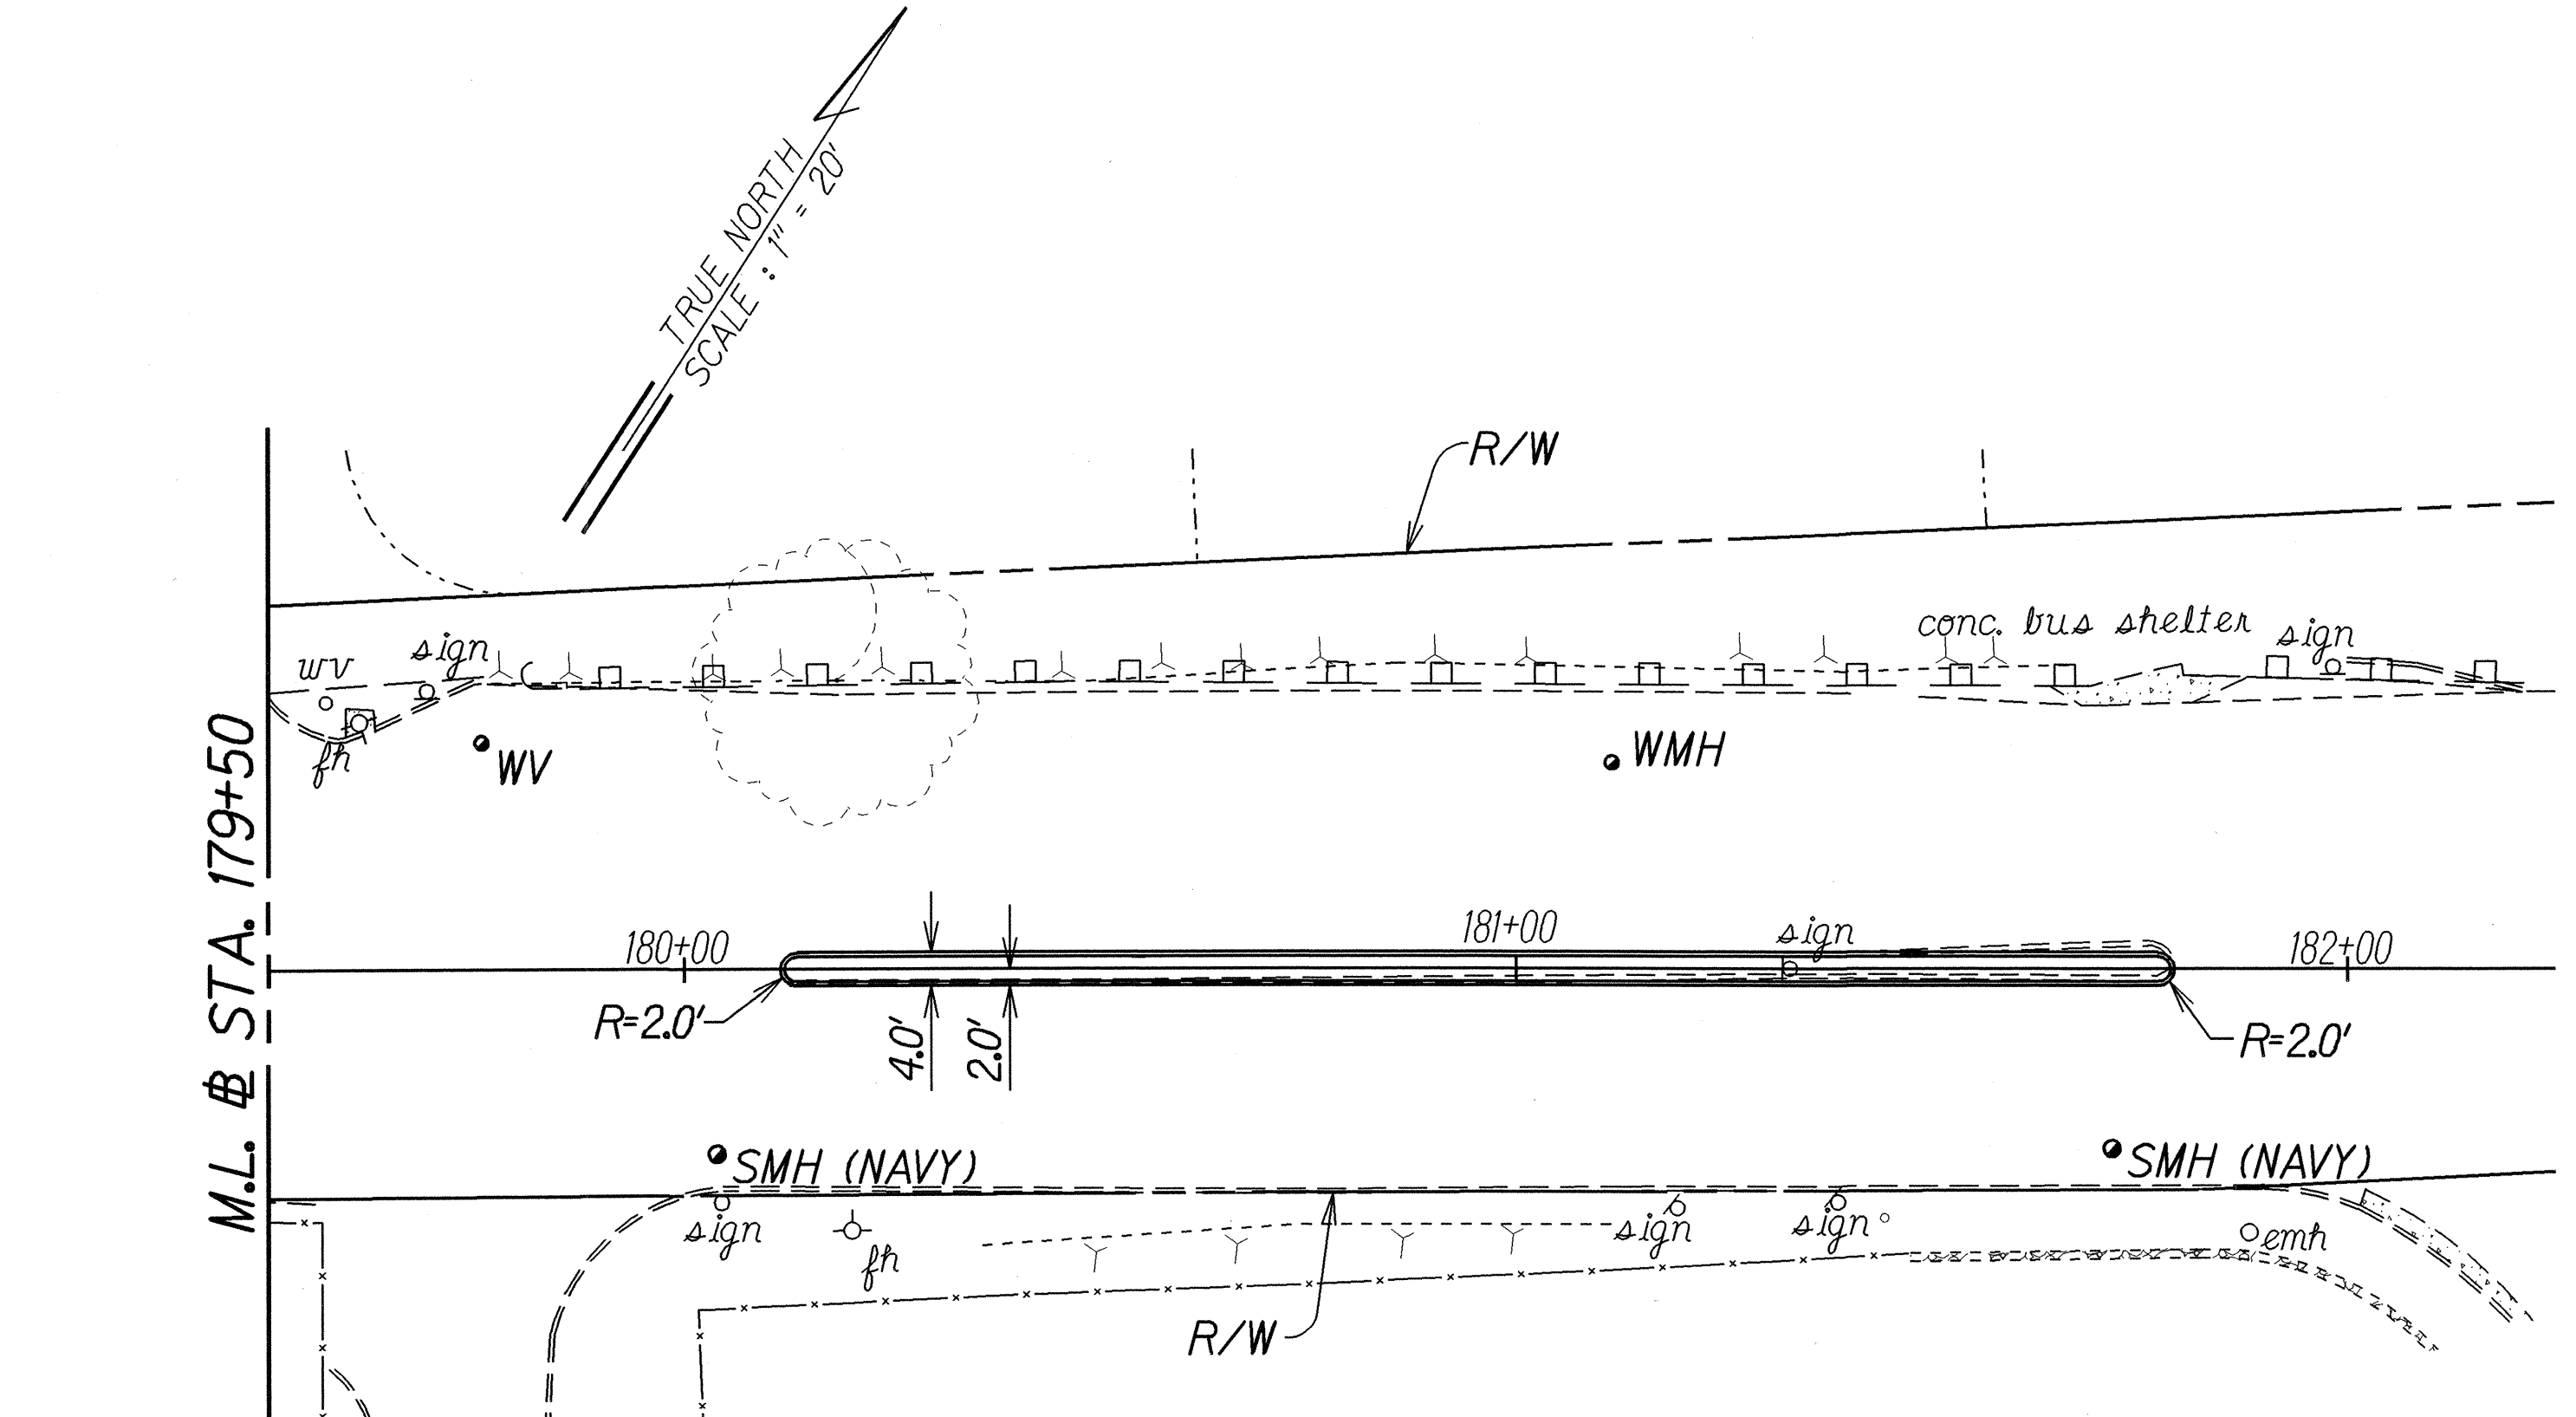


FED. ROAD DIST. NO.	STATE	PROJ. NO.	FISCAL YEAR	SHEET NO.	TOTAL SHEETS
HAWAII	HAW.	HWY-0-06-03M	2004	C.O.26	51



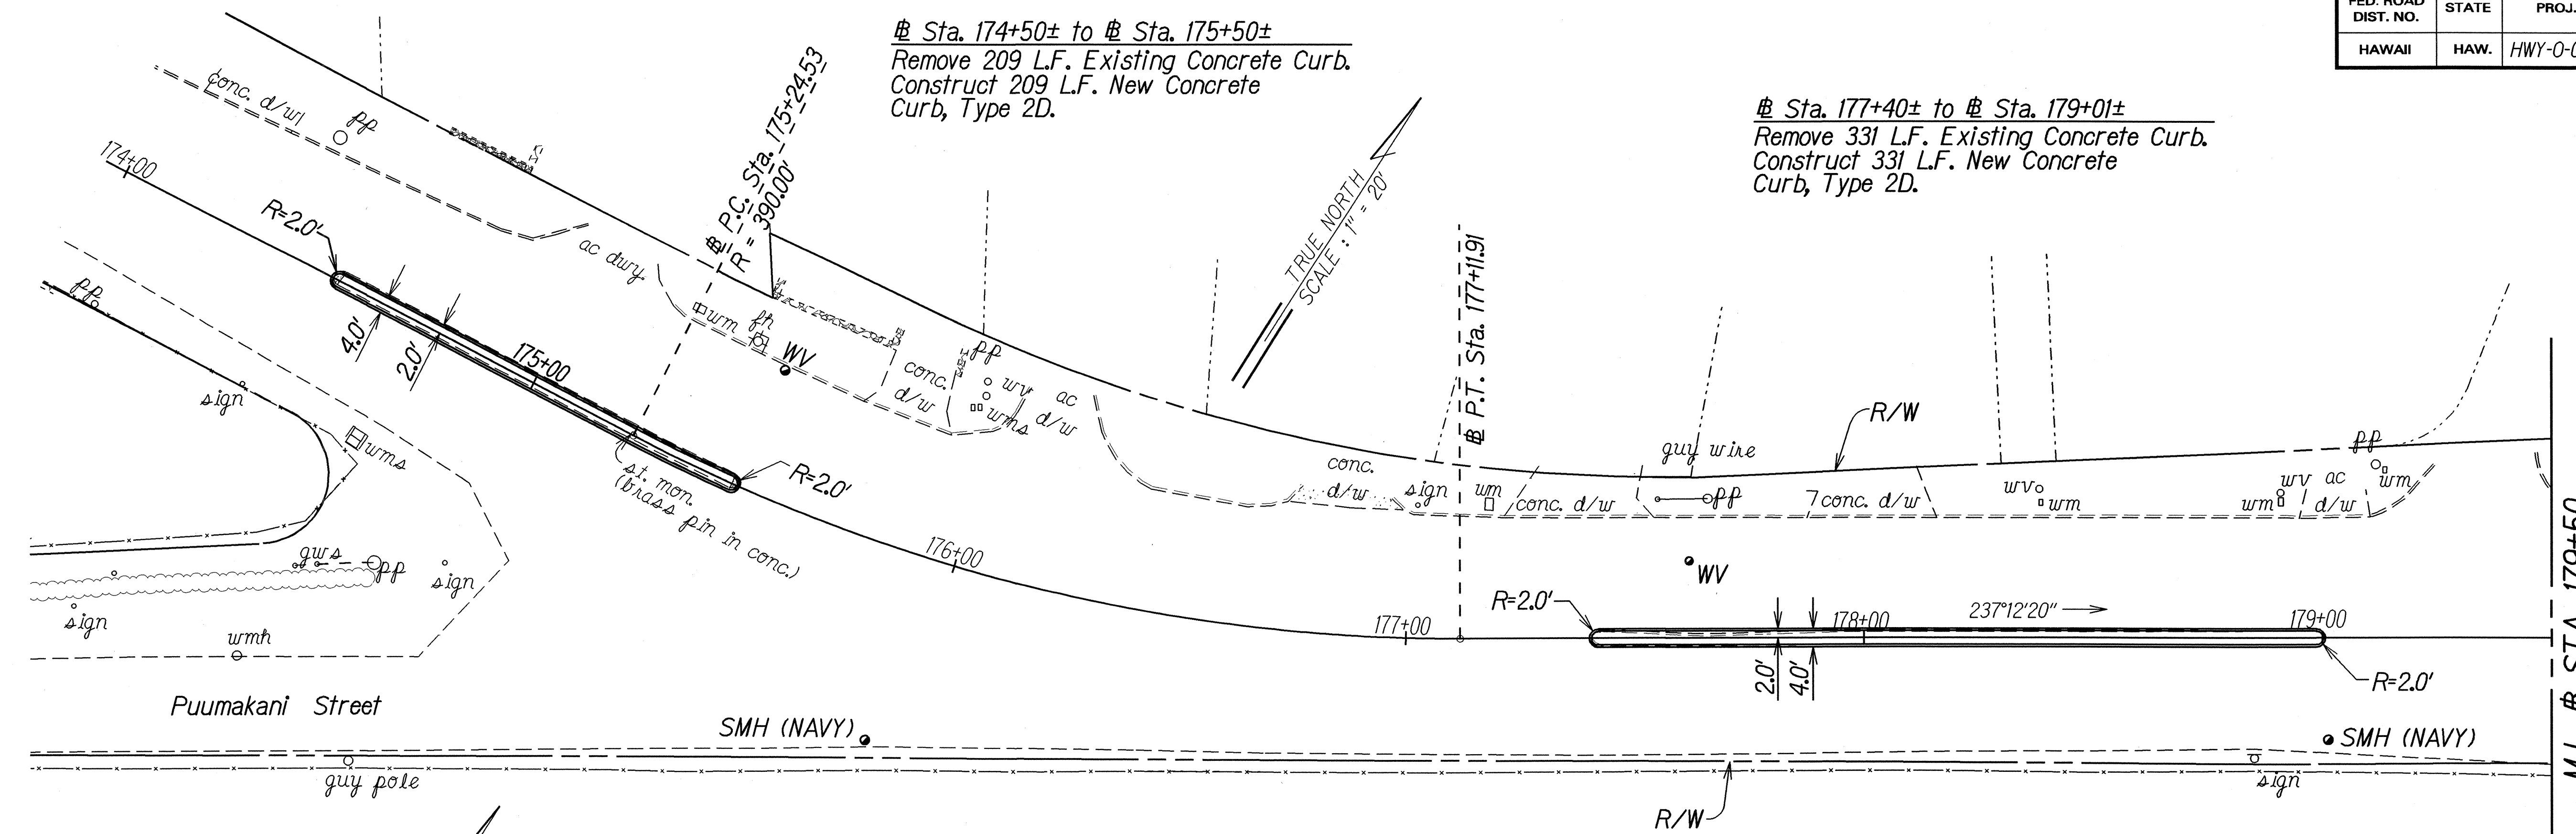


CURBED MEDIAN DETAIL
Scale: 1/2" = 1'-0"


ORIGINAL PLAN	SURVEY PLOTTED BY	DATE
NOTE BOOK	DRAWN BY	
dd3/stew	CHECKED BY	
N.26/misord01		

7/12/04	Show Existing Utilities to be Adjusted.
DATE	REVISION
STATE OF HAWAII DEPARTMENT OF TRANSPORTATION HIGHWAYS DIVISION DETAIL ROADWAY PLAN HALAWA HEIGHTS ROAD REHABILITATION Kikania Street to Fernridge Place and Kahuapaani Interchange, Moanalua Freeway, H201 Project No. HWY-0-06-03M Scale: As Shown Date: May, 2004 SHEET No. 1 OF 1 SHEETS	


FED. ROAD DIST. NO.	STATE	PROJ. NO.	FISCAL YEAR	SHEET NO.	TOTAL SHEETS
HAWAII	HAW.	HWY-0-06-03M	2004	ADD.27	51

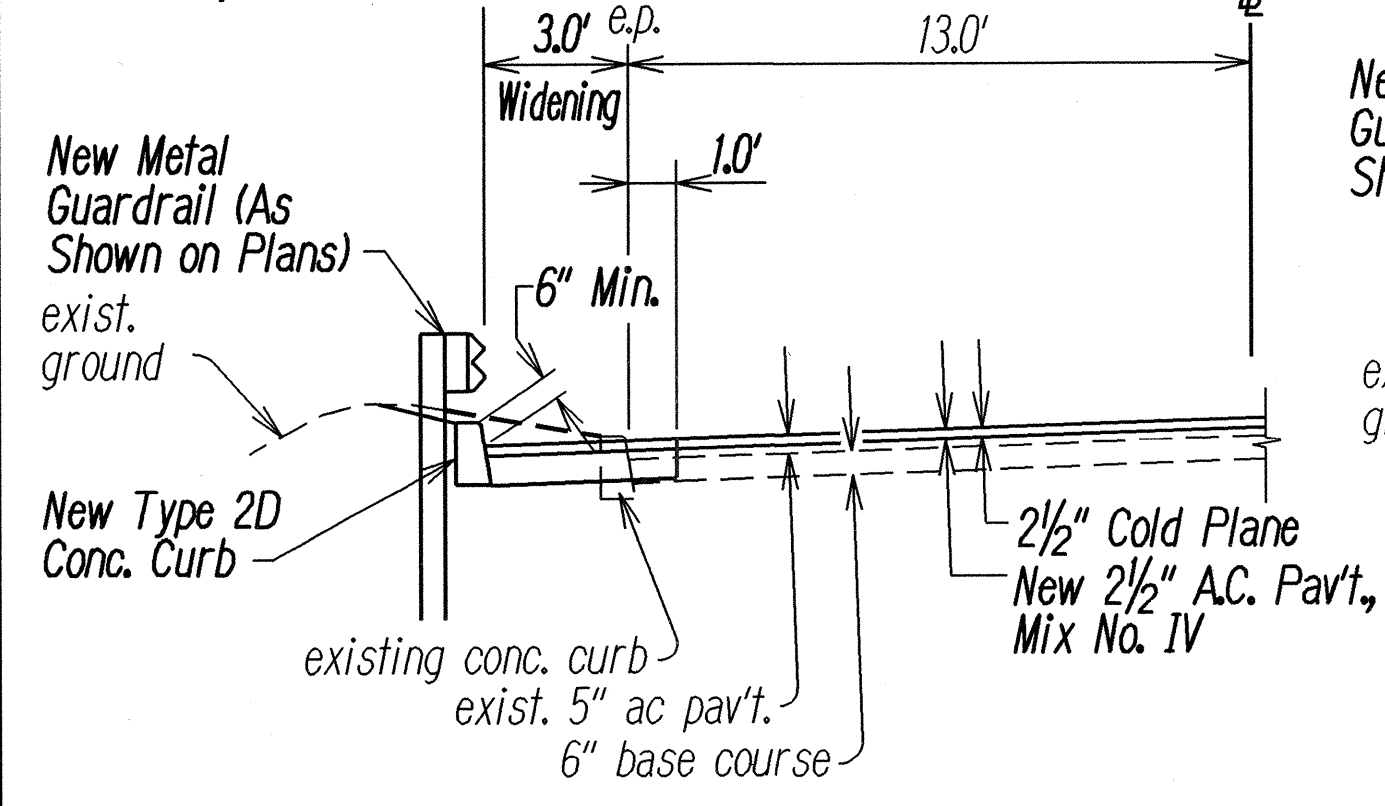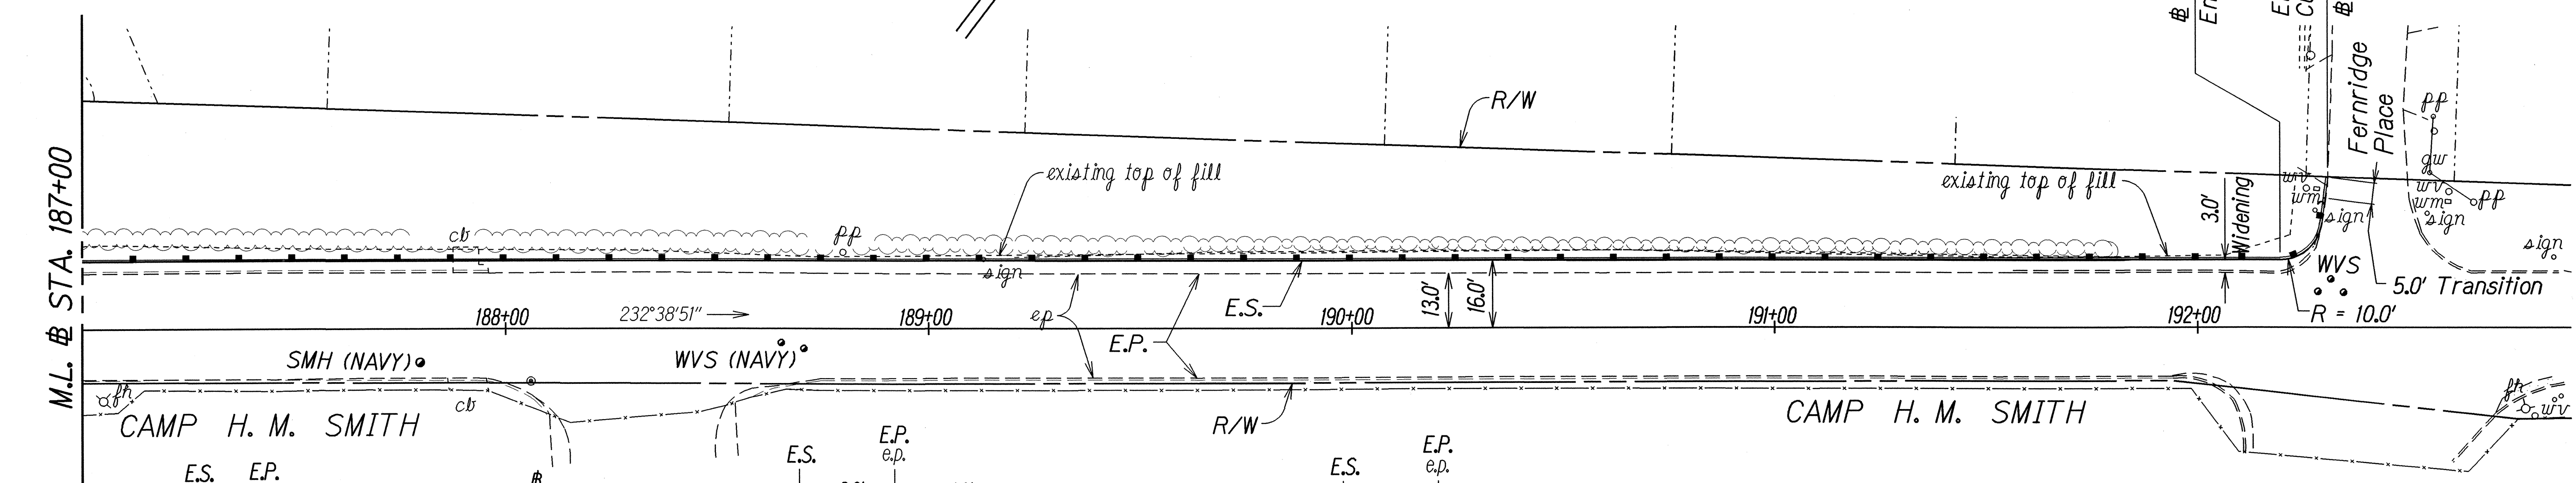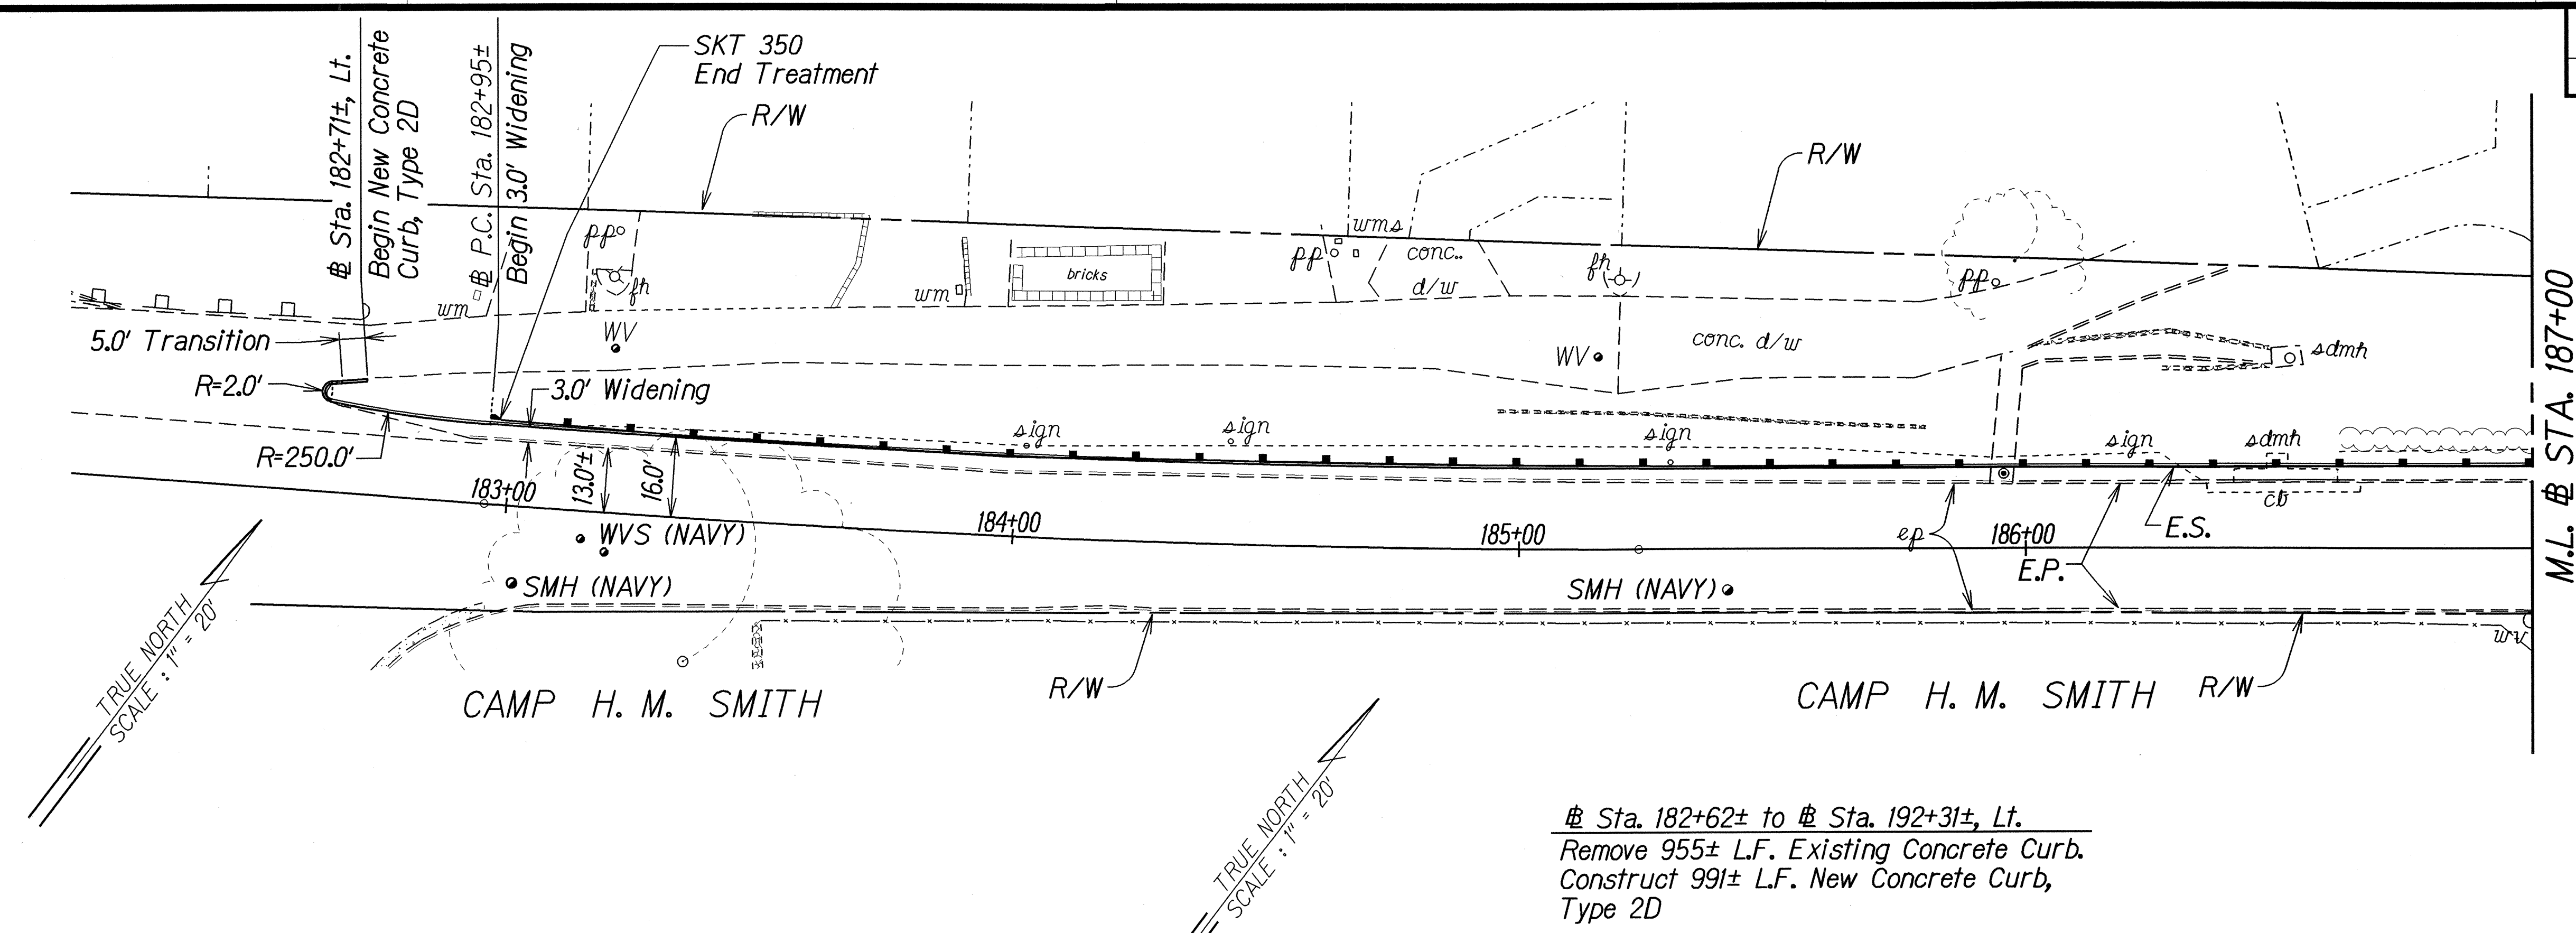

PARTIAL TYPICAL SECTION
 # STA. 183+00± to # STA. 192+31±, Lt.
 Scale: 1/4" = 1'-0"

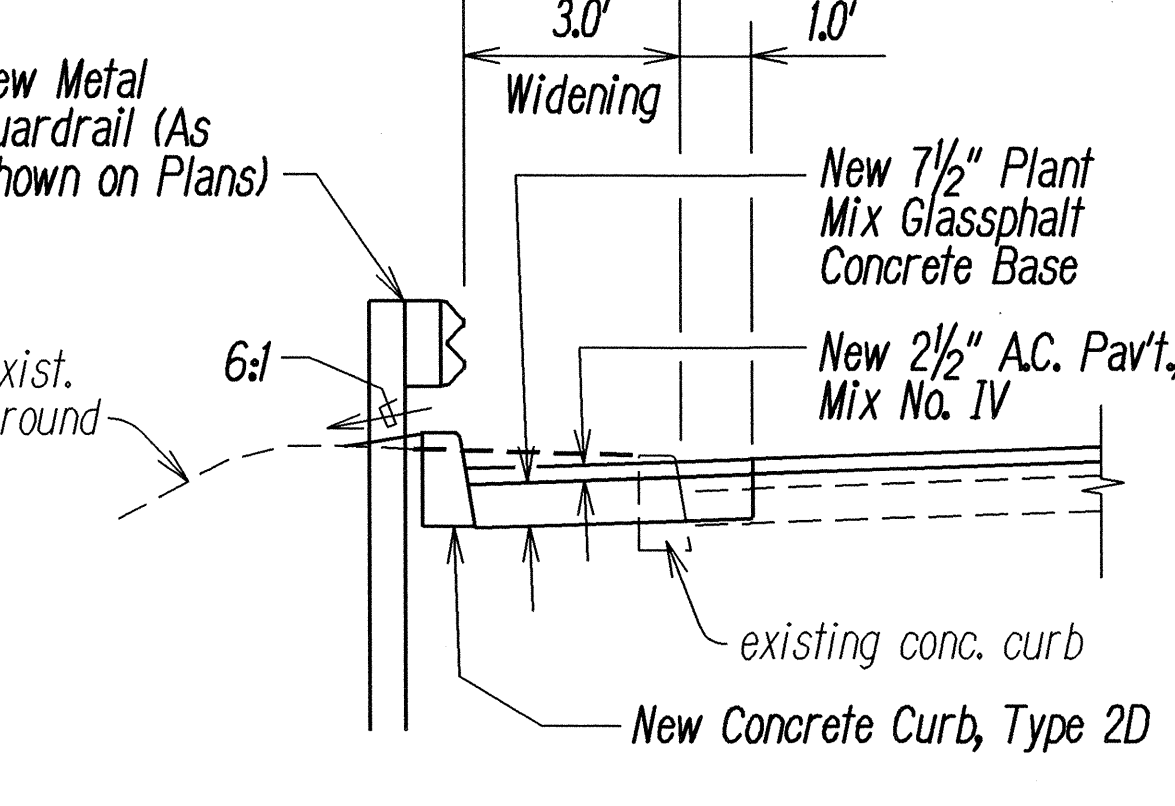

DETAIL
 Scale: 3/8" = 1'-0"

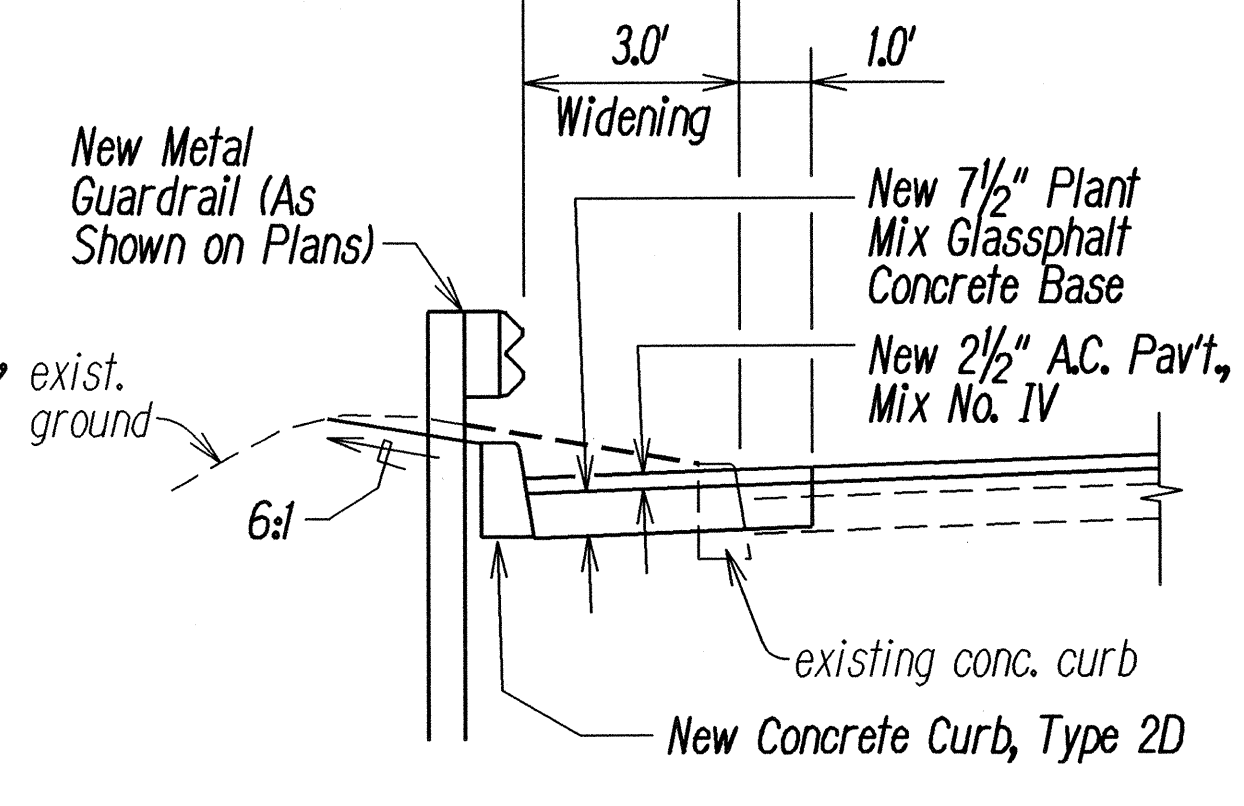

DETAIL
 Scale: 3/8" = 1'-0"

7/12/04	Show Existing Utilities to be Adjusted.
6/14/04	Revise Details and Guardrail End at Approaching End per Addendum No. 1.

DATE	REVISION
7/12/04	Show Existing Utilities to be Adjusted.
6/14/04	Revise Details and Guardrail End at Approaching End per Addendum No. 1.