

INDEX TO DRAWINGS	
SHEET NO.	DESCRIPTION
1	TITLE SHEET
2	STANDARD PLANS SUMMARY
3	GENERAL NOTES
4 - 5	EROSION CONTROL AND POLLUTION NOTES
6 - 12	TYPICAL SECTIONS AND DETAILS
13 - 19	GUARDRAIL NOTES AND DETAILS
20 - 25	ROADWAY PLANS
26 - 27	DETAIL ROADWAY PLANS
28 - 30	DRAINAGE PLANS
31 - 35	DRAINAGE DETAILS
36 - 41	HALAWA INTERCHANGE BRIDGE NO. 10 BRIDGE RAILING IMPROVEMENT PLANS
42	TRAFFIC NOTES
43	PAVEMENT MARKING LEGEND AND DETAIL
44 - 50	PAVEMENT MARKING AND SIGNING PLANS
51	LOOP DETECTORS PLAN

STATE OF HAWAII

DEPARTMENT OF TRANSPORTATION

HIGHWAYS DIVISION

HONOLULU, HAWAII

"AS-BUILT"

PLANS FOR

HALAWA HEIGHTS ROAD

REHABILITATION


KIKANIA STREET TO FERNRIDGE PLACE

AND

KAHUAPAANI INTERCHANGE

MOANALUA FREEWAY, H201

PROJECT NO. HWY-O-06-03M




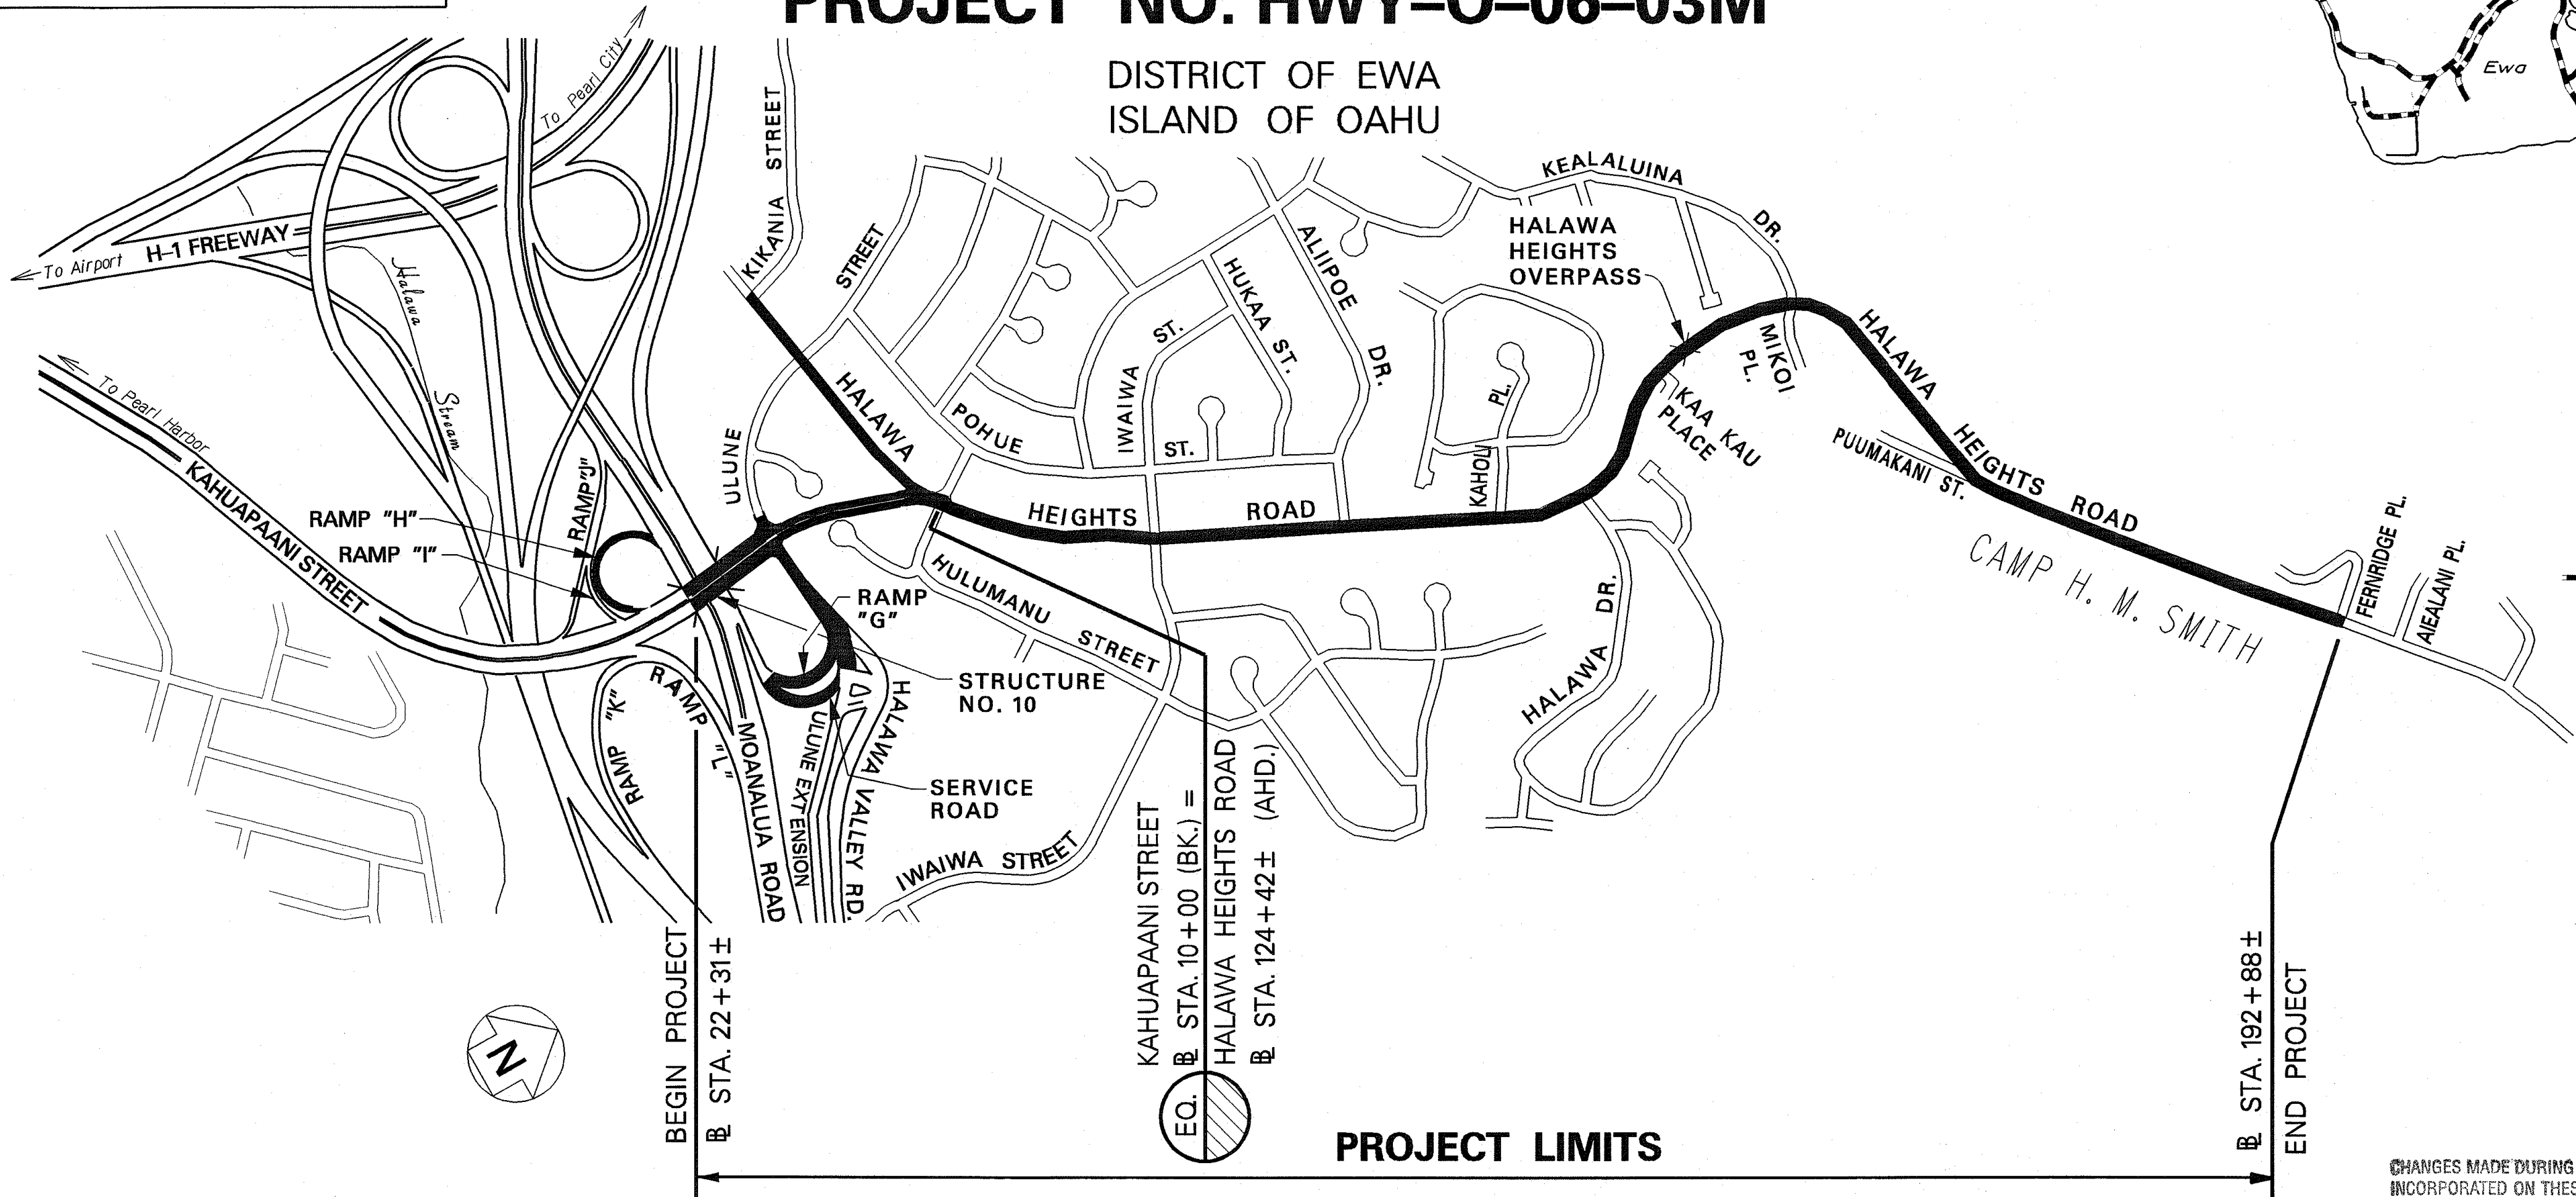


LAYOUT PLAN

LENGTH OF PROJECT.....1.52 MILES



FED. ROAD DIST. NO.	STATE	PROJ. NO.	FISCAL YEAR	SHEET NO.	TOTAL SHEETS
HAWAII	HAW.	HWY-O-06-03M	2004	1	51

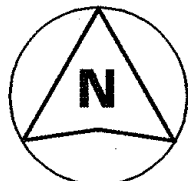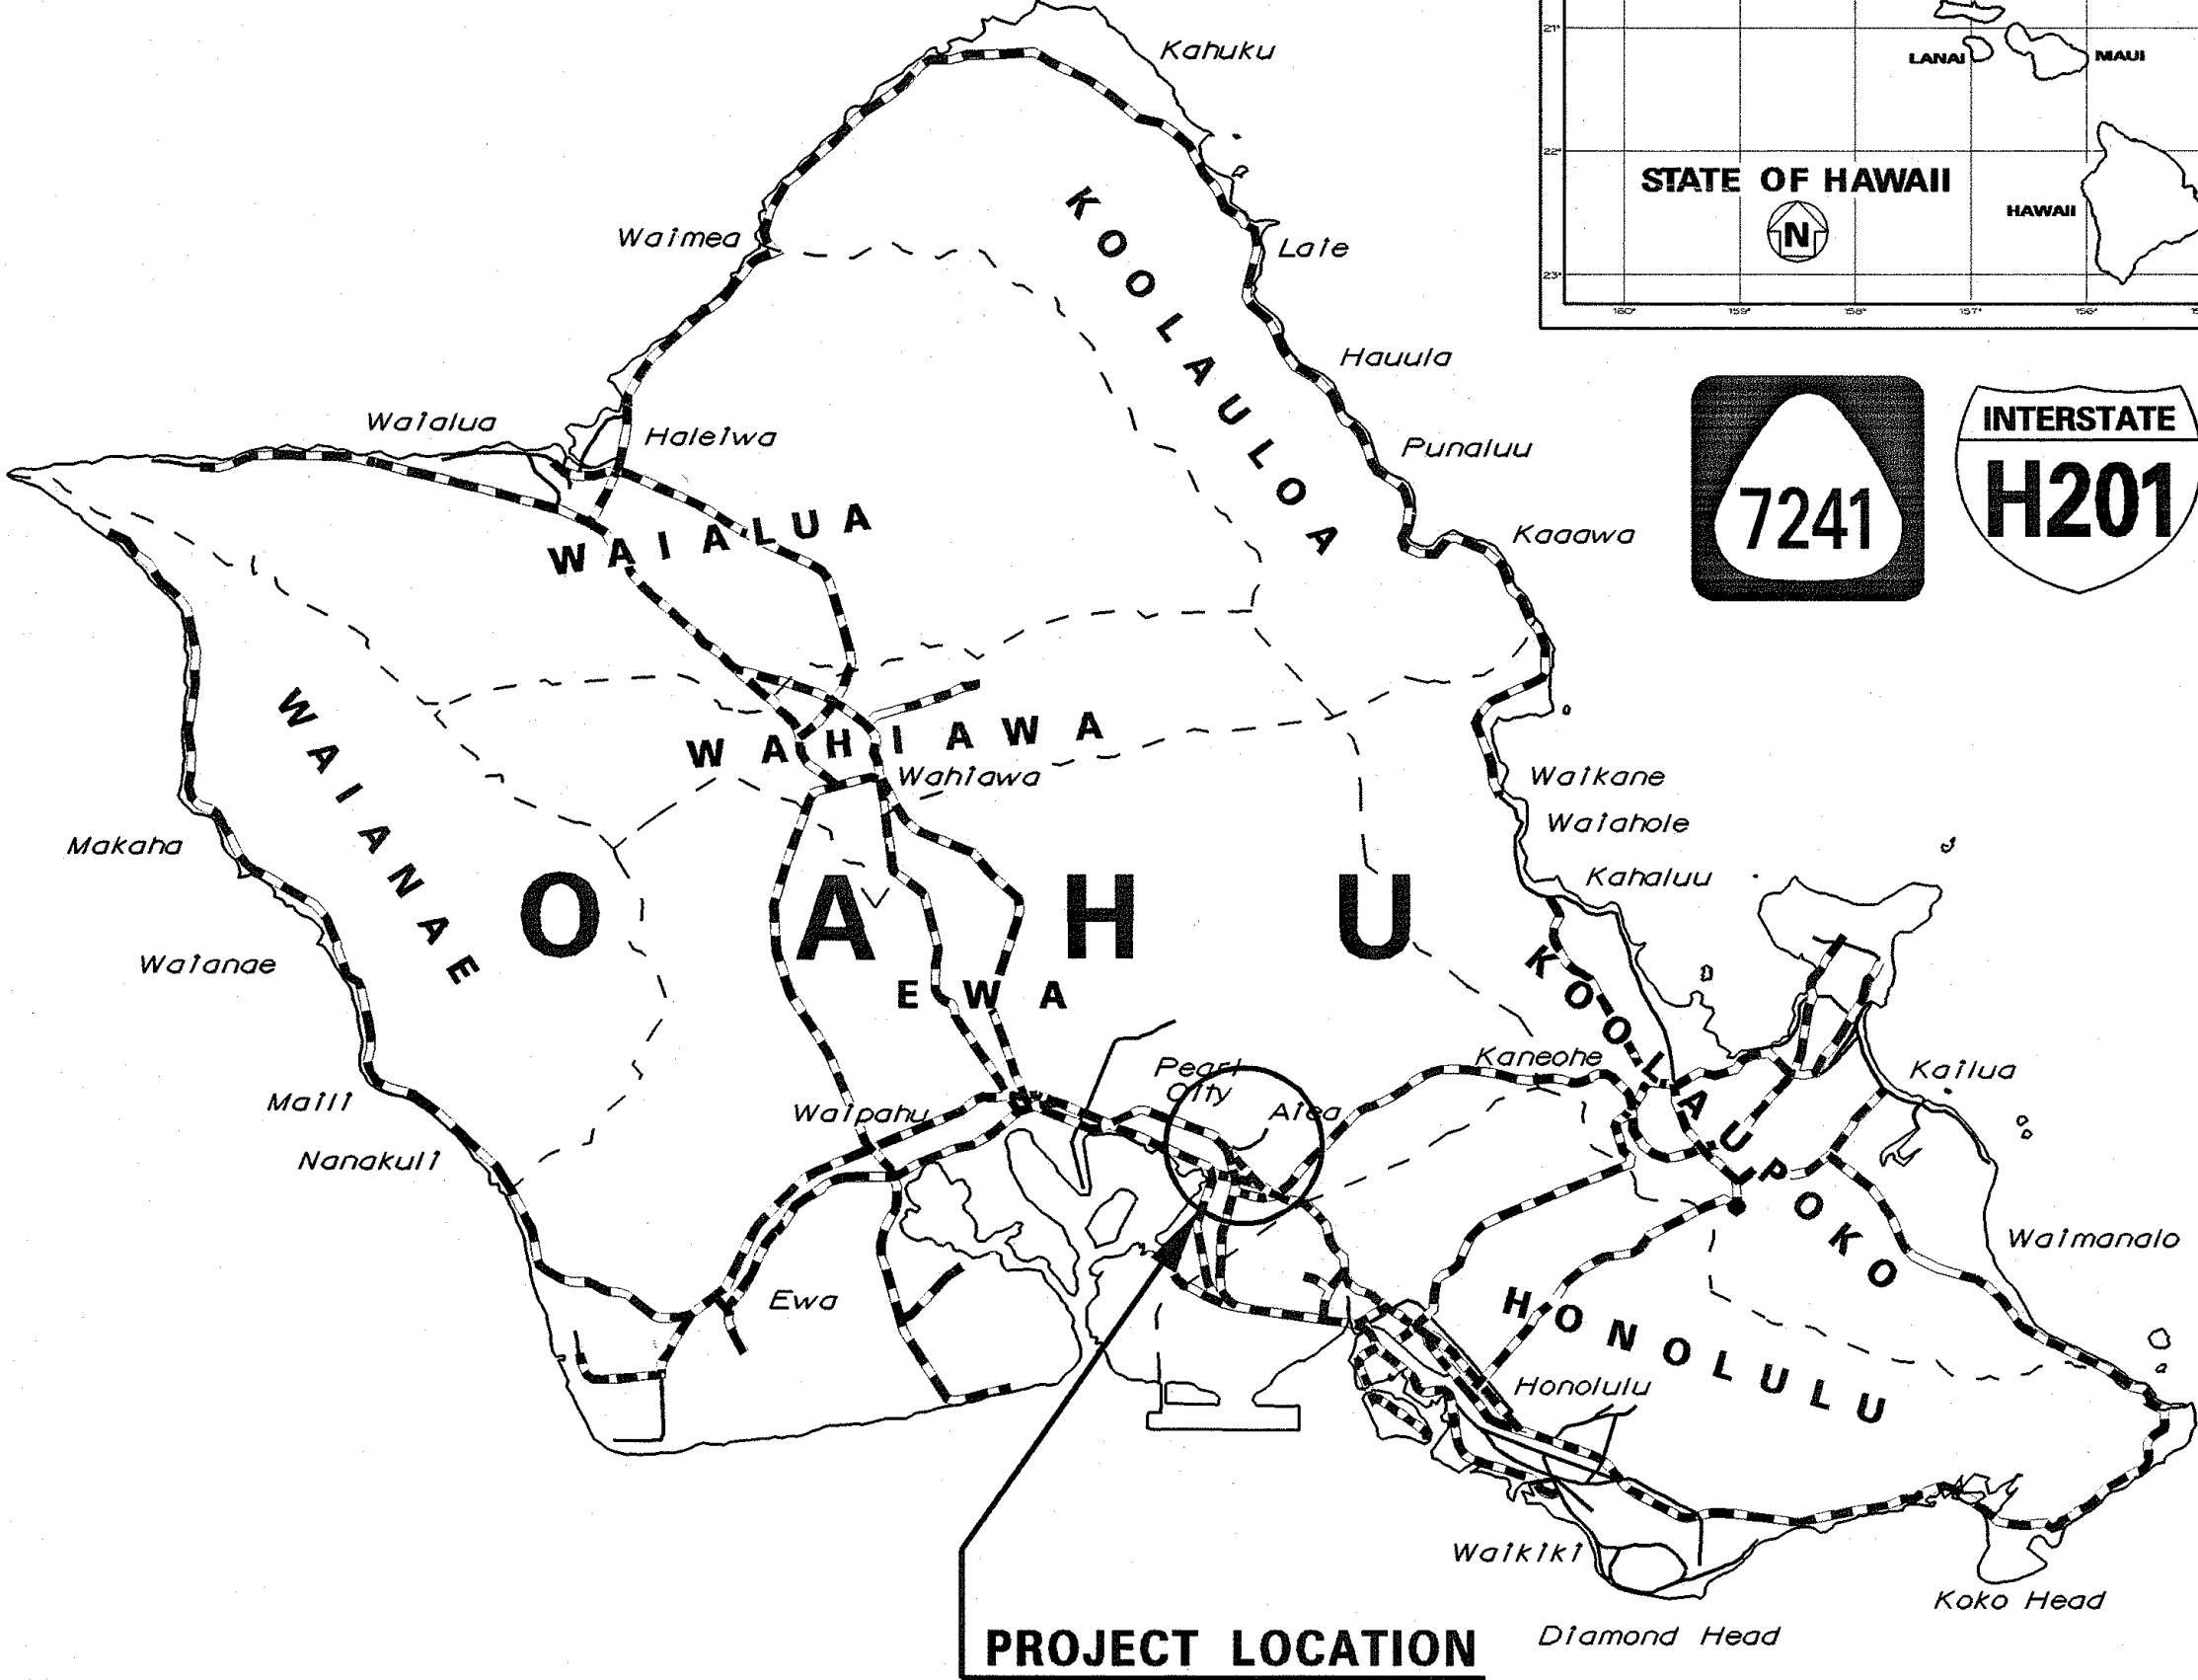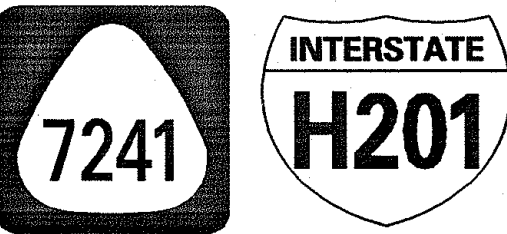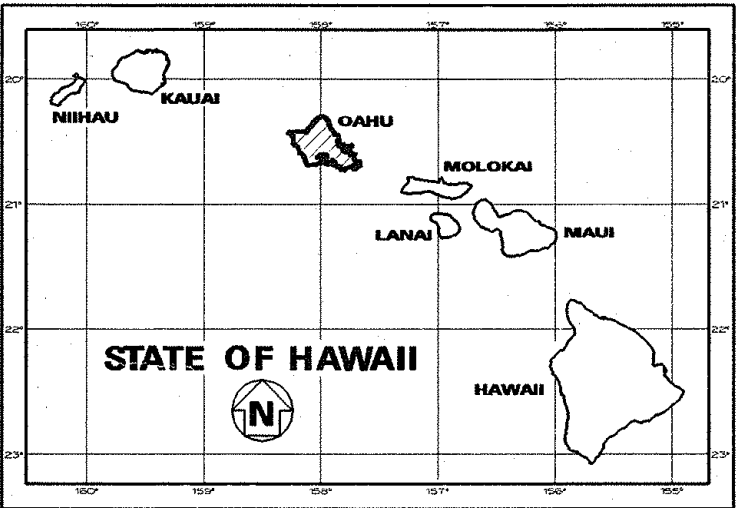

FEDERAL AID INTERSTATE PROJECTS PREVIOUSLY
CONSTRUCTED OR UNDER CONSTRUCTION

MILE POST 0.80 TO MILE POST 2.32

CHANGES MADE DURING CONSTRUCTION HAVE BEEN
INCORPORATED ON THESE PLANS EXCEPT CHANGES
IN THE ORIGINAL THEORETICAL QUANTITIES. FOR
ACTUAL QUANTITIES, REFER TO PROJECT LEDGER
AND/OR COMPUTATION BOOK.

Kelly Lee Set 4/27/09
RESIDENT ENGINEER DATE

DEPARTMENT OF TRANSPORTATION STATE OF HAWAII	
APPROVED:	
<i>[Signature]</i> DIR. OF TRANSPORTATION	6.1.04 DATE

HWY-D
DESIGNED BY

HWY-DD
MANAGED BY

692-7570
PHONE

JUNE 2004
DATE