


8/2/2016 7:19:00 PM \\denpwp01\pwwcs\jobs596\212229\205370_14\T09-611SpecialA HA.dgn User: DENPWP01\$

STATE	PROJECT	SHEET NO.
HI	HI STP H1(1)	T9

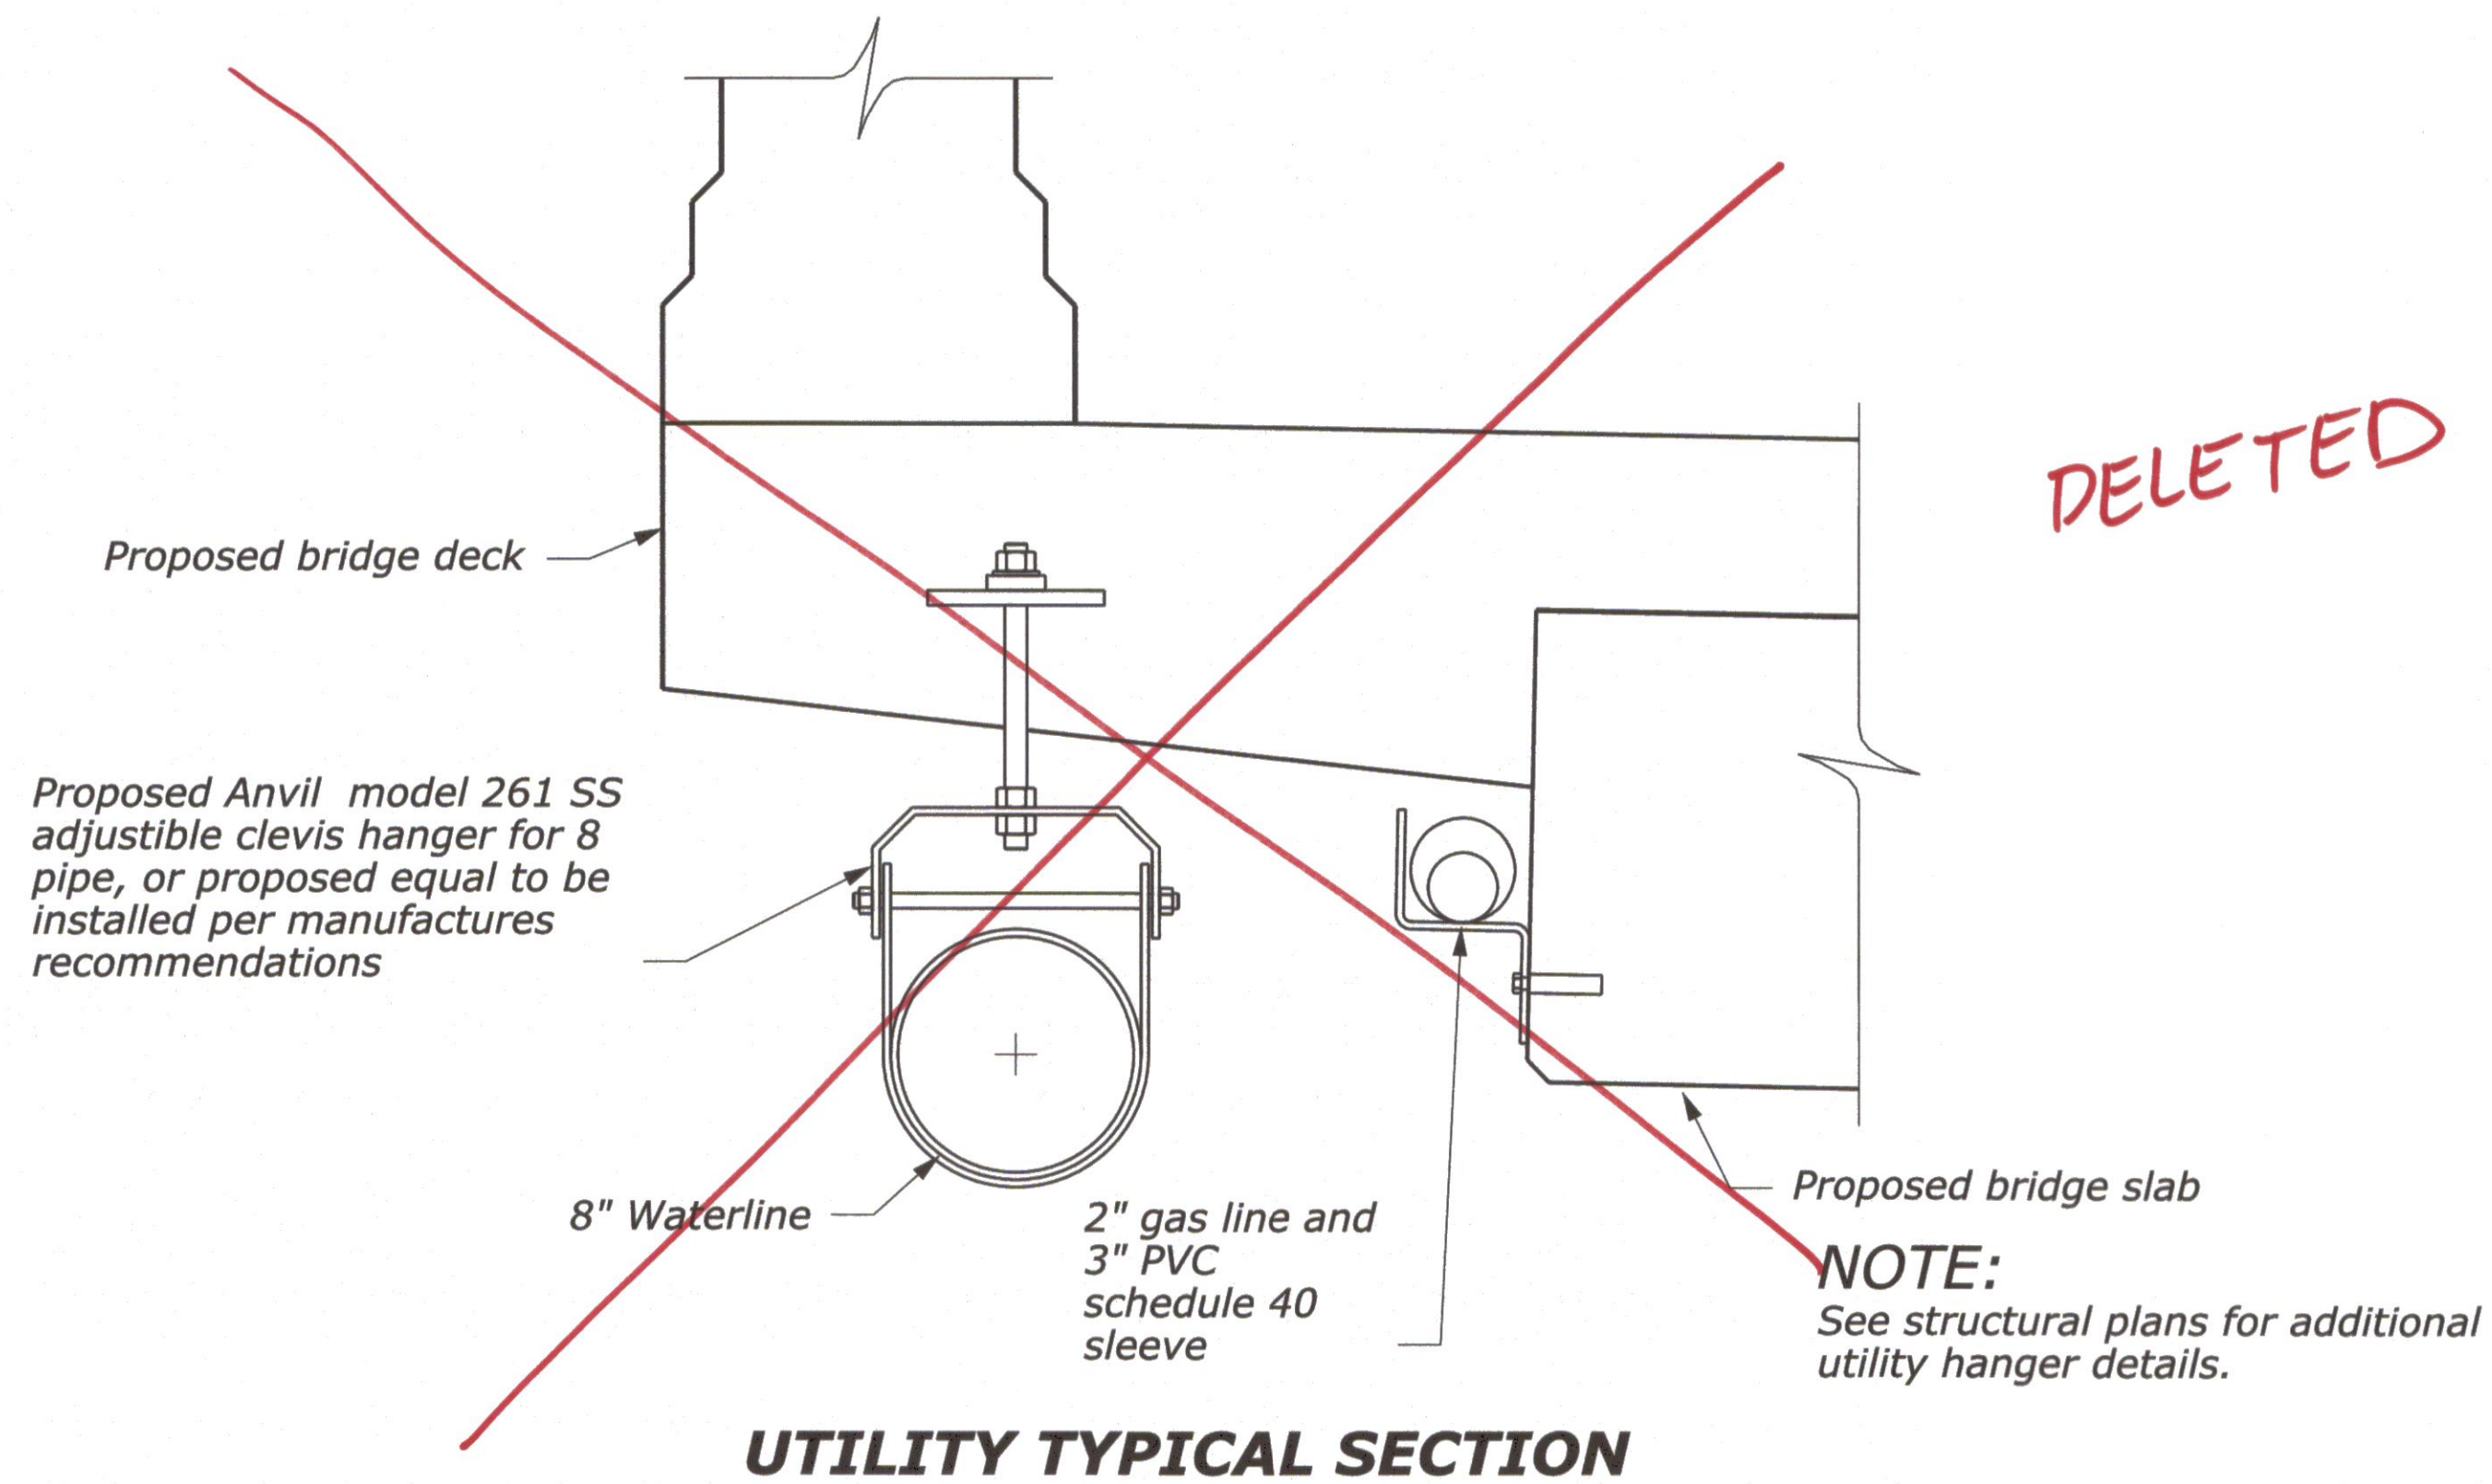

THIS WORK WAS PREPARED BY ME OR UNDER MY SUPERVISION.

Jason Y. Kage 04/30/2018
Signature Expiration Date of the License

NO SCALE

U.S. DEPARTMENT OF TRANSPORTATION
FEDERAL HIGHWAY ADMINISTRATION
CENTRAL FEDERAL LANDS HIGHWAY DIVISION

U.S. CUSTOMARY SPECIAL

WATERLINE DETAILS

SPECIAL
611-A