



FED. ROAD DIST. NO.	STATE	FED. AID PROJ. NO.	FISCAL YEAR	SHEET NO.	TOTAL SHEETS
HAWAII	HAW.	HWY-02-73	1974	3	3



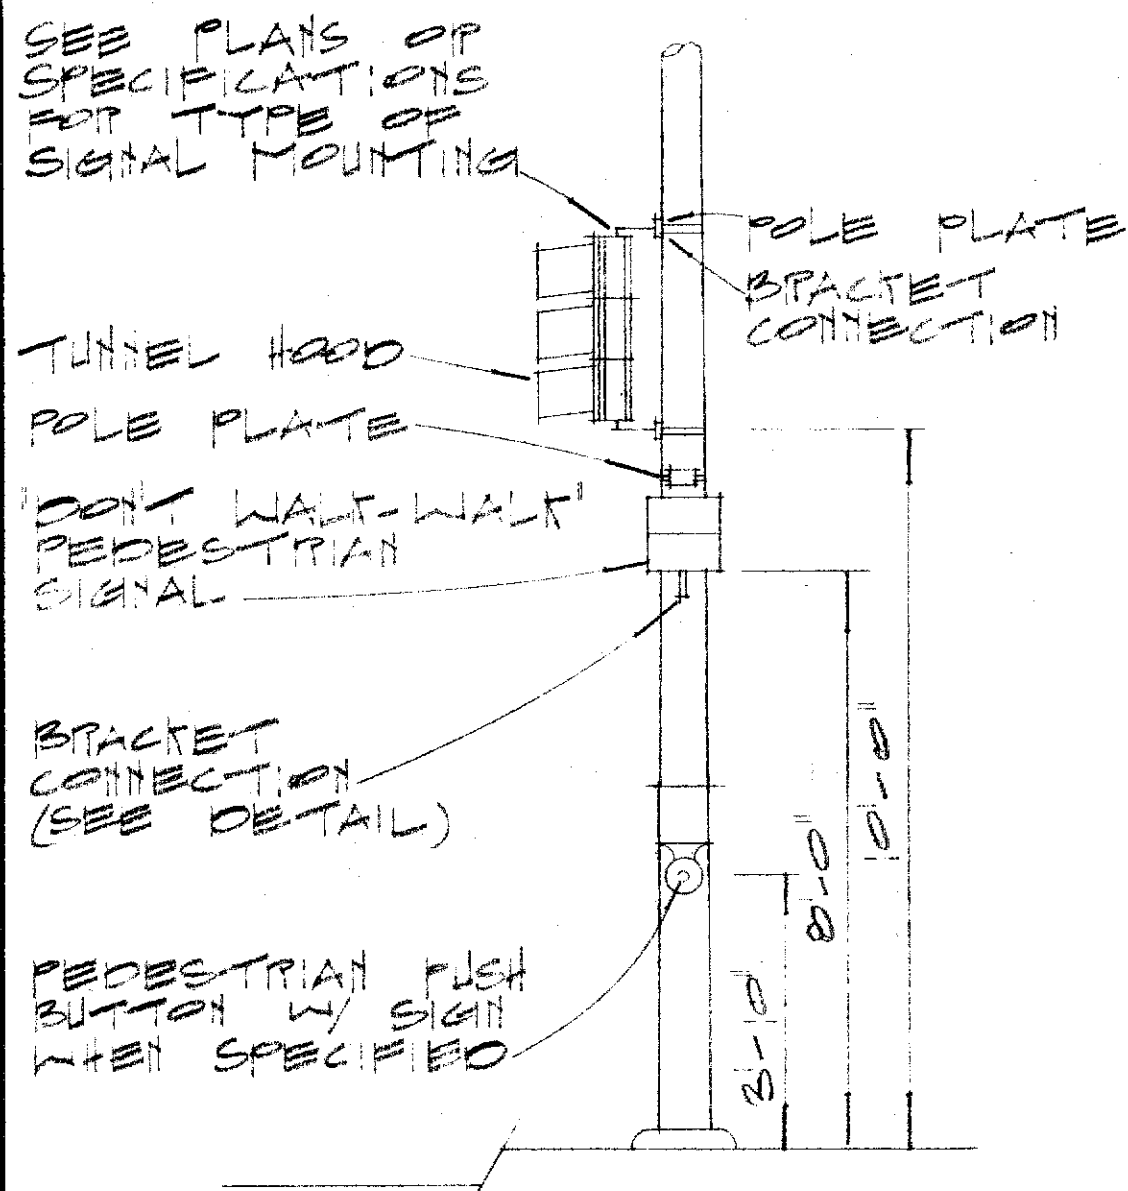


ON TYPE I STANDARD

TYPICAL EQUIPMENT MOUNTINGS

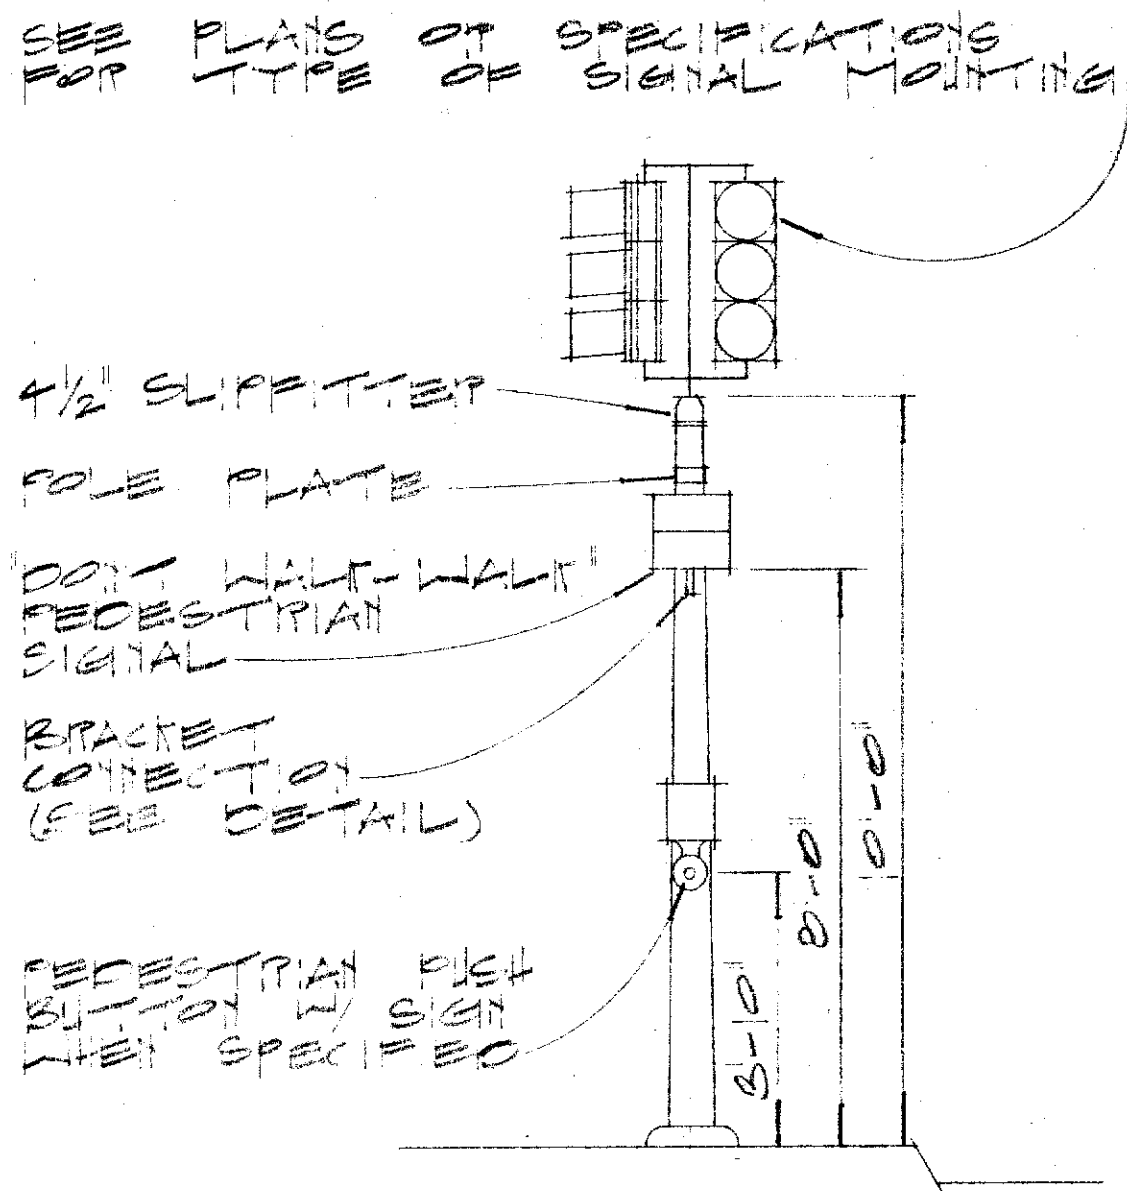



ON TYPE I STANDARD

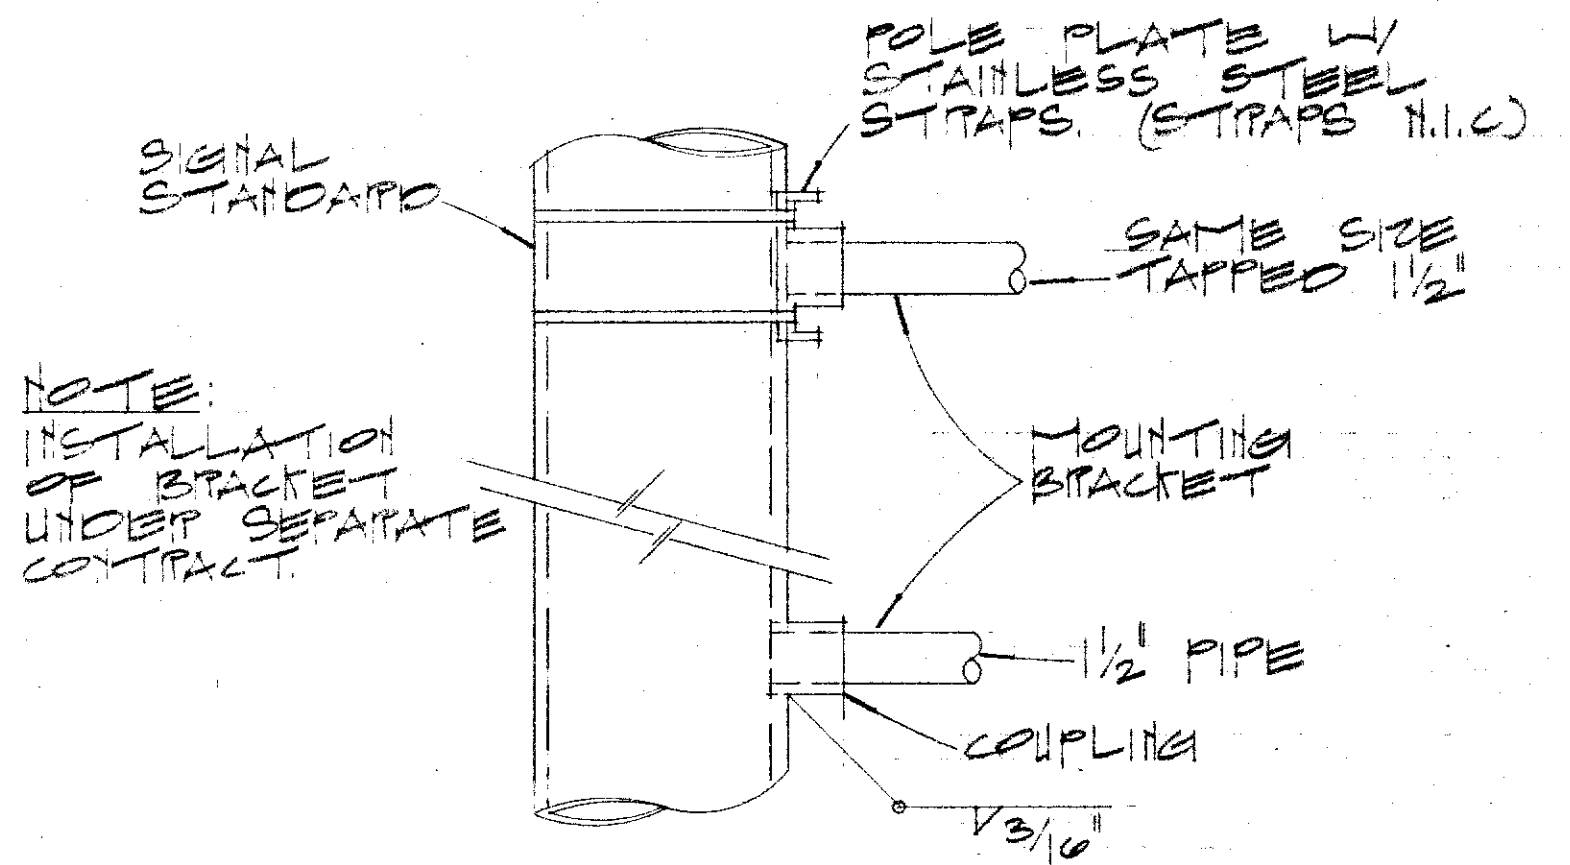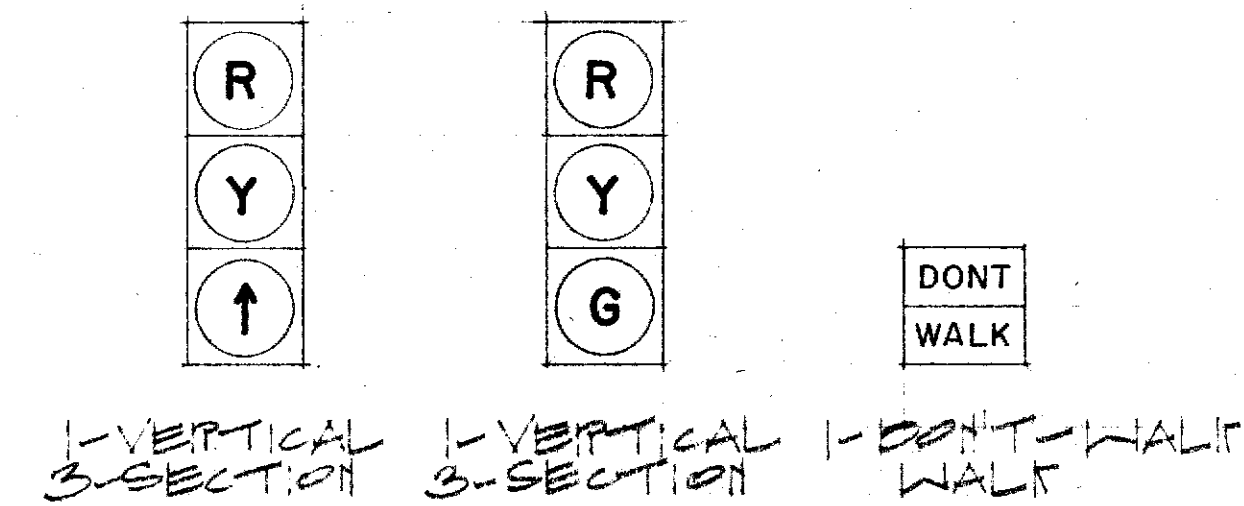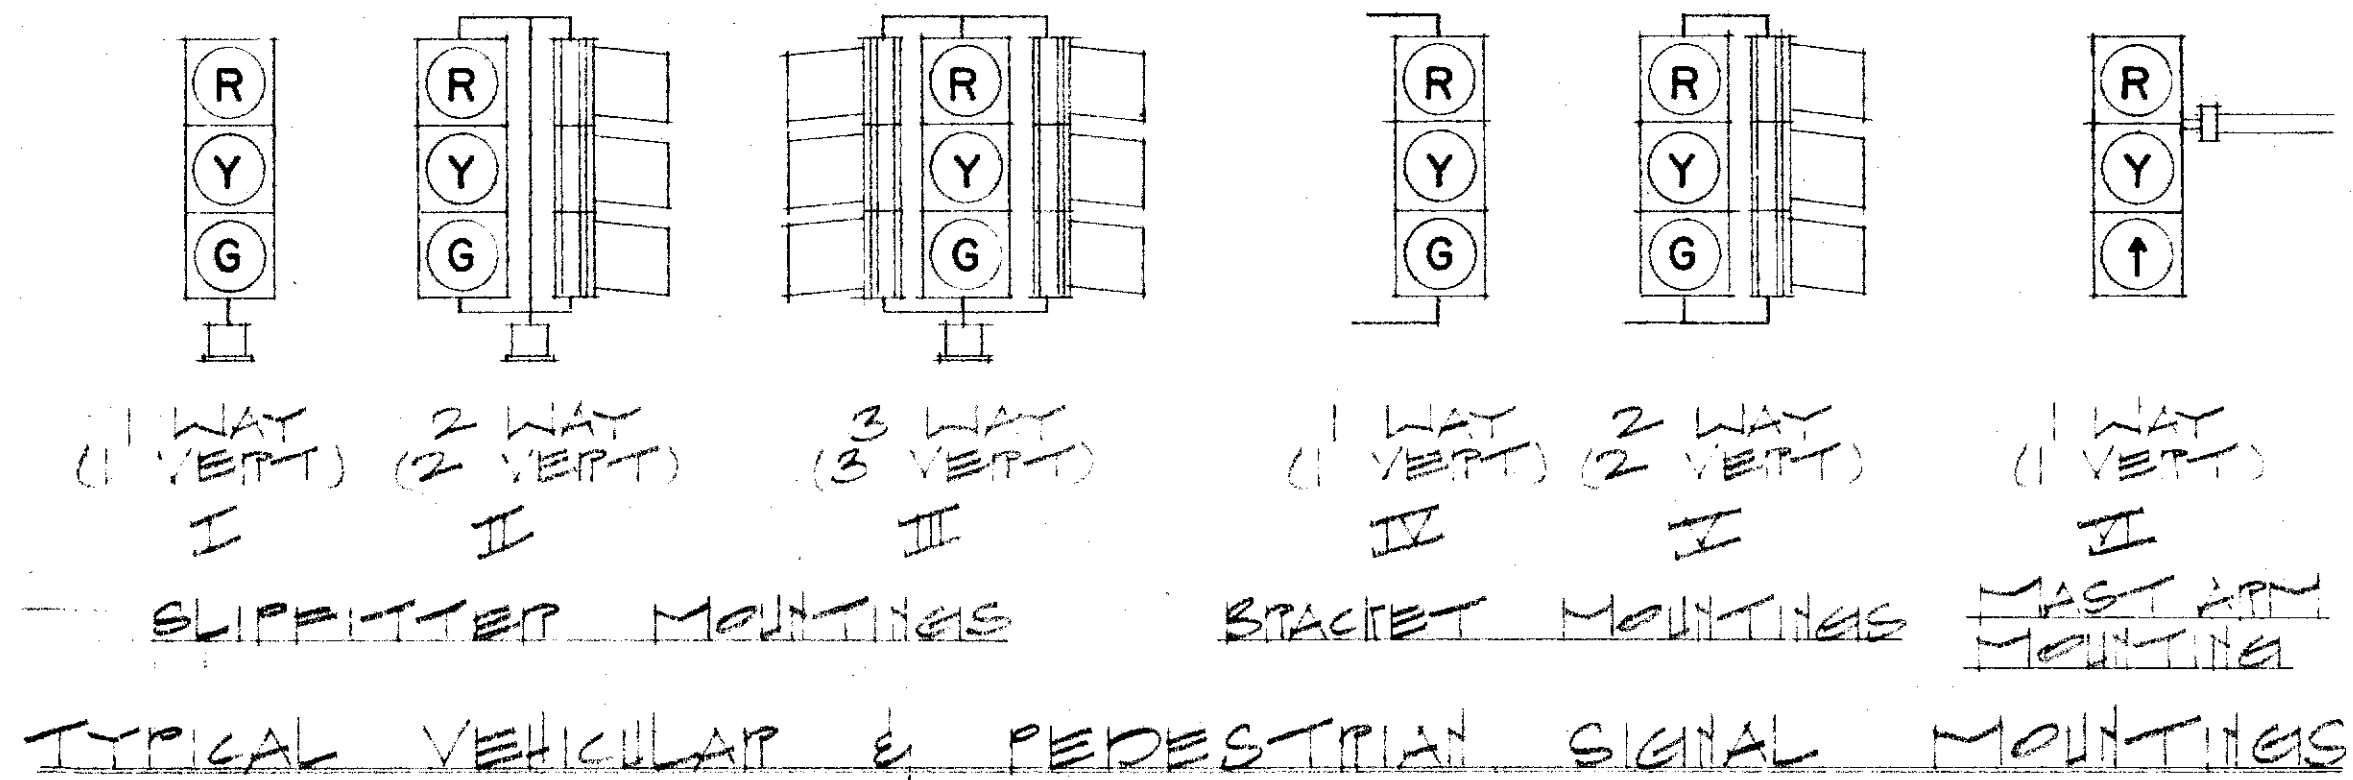

DETAIL OF BRACKET CONNECTION & POLE PLATE

GENERAL NOTES

- ALL TRAFFIC SIGNAL CONTROLLER EQUIPMENT SHALL BE COMPLETELY WIPED IN THE CABINET & SHALL CONTROL THE TRAFFIC SIGNAL LIGHTS AS CALLED FOR IN THE PLANS.
- SIGNAL INDICATIONS DURING CLEARANCE INTERVAL:
 - IF A SIGNAL IS G OR P & WILL REMAIN G OR P DURING THE NEXT PHASE, IT SHALL BE G OR P DURING THE CLEARANCE INTERVAL.
 - IF A SIGNAL IS G OR P & WILL BECOME Y DURING THE NEXT PHASE, IT SHALL BE Y DURING THE CLEARANCE INTERVAL.
 - IF A SIGNAL IS P & WILL REMAIN P OR BECOME G DURING THE NEXT PHASE, IT SHALL REMAIN P DURING THE CLEARANCE INTERVAL.
- LOOP DETECTOR SENSING ELEMENTS (LOOPS W/RES) WILL NOT BE INCLUDED UNDER THIS CONTRACT.

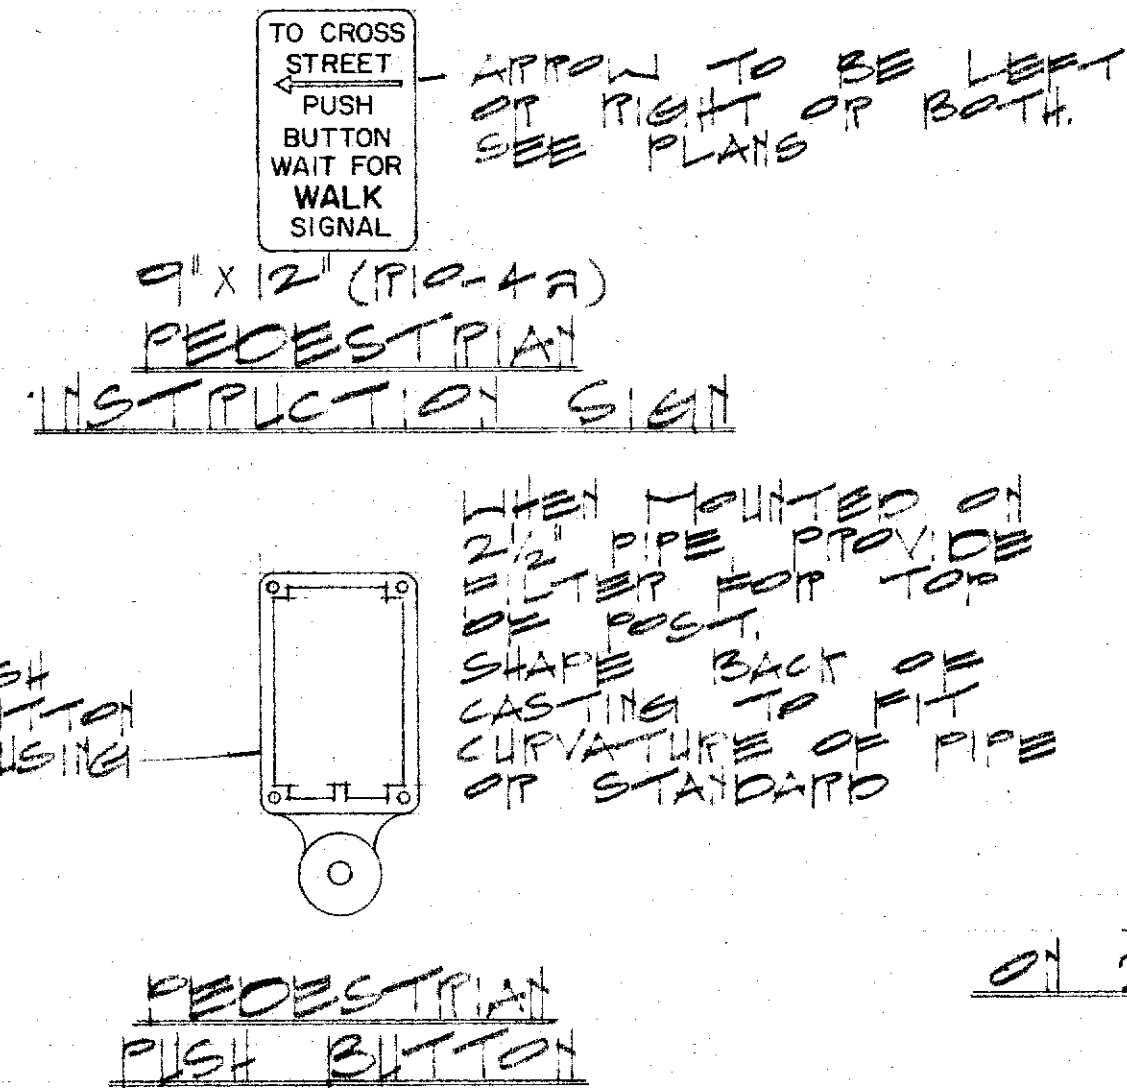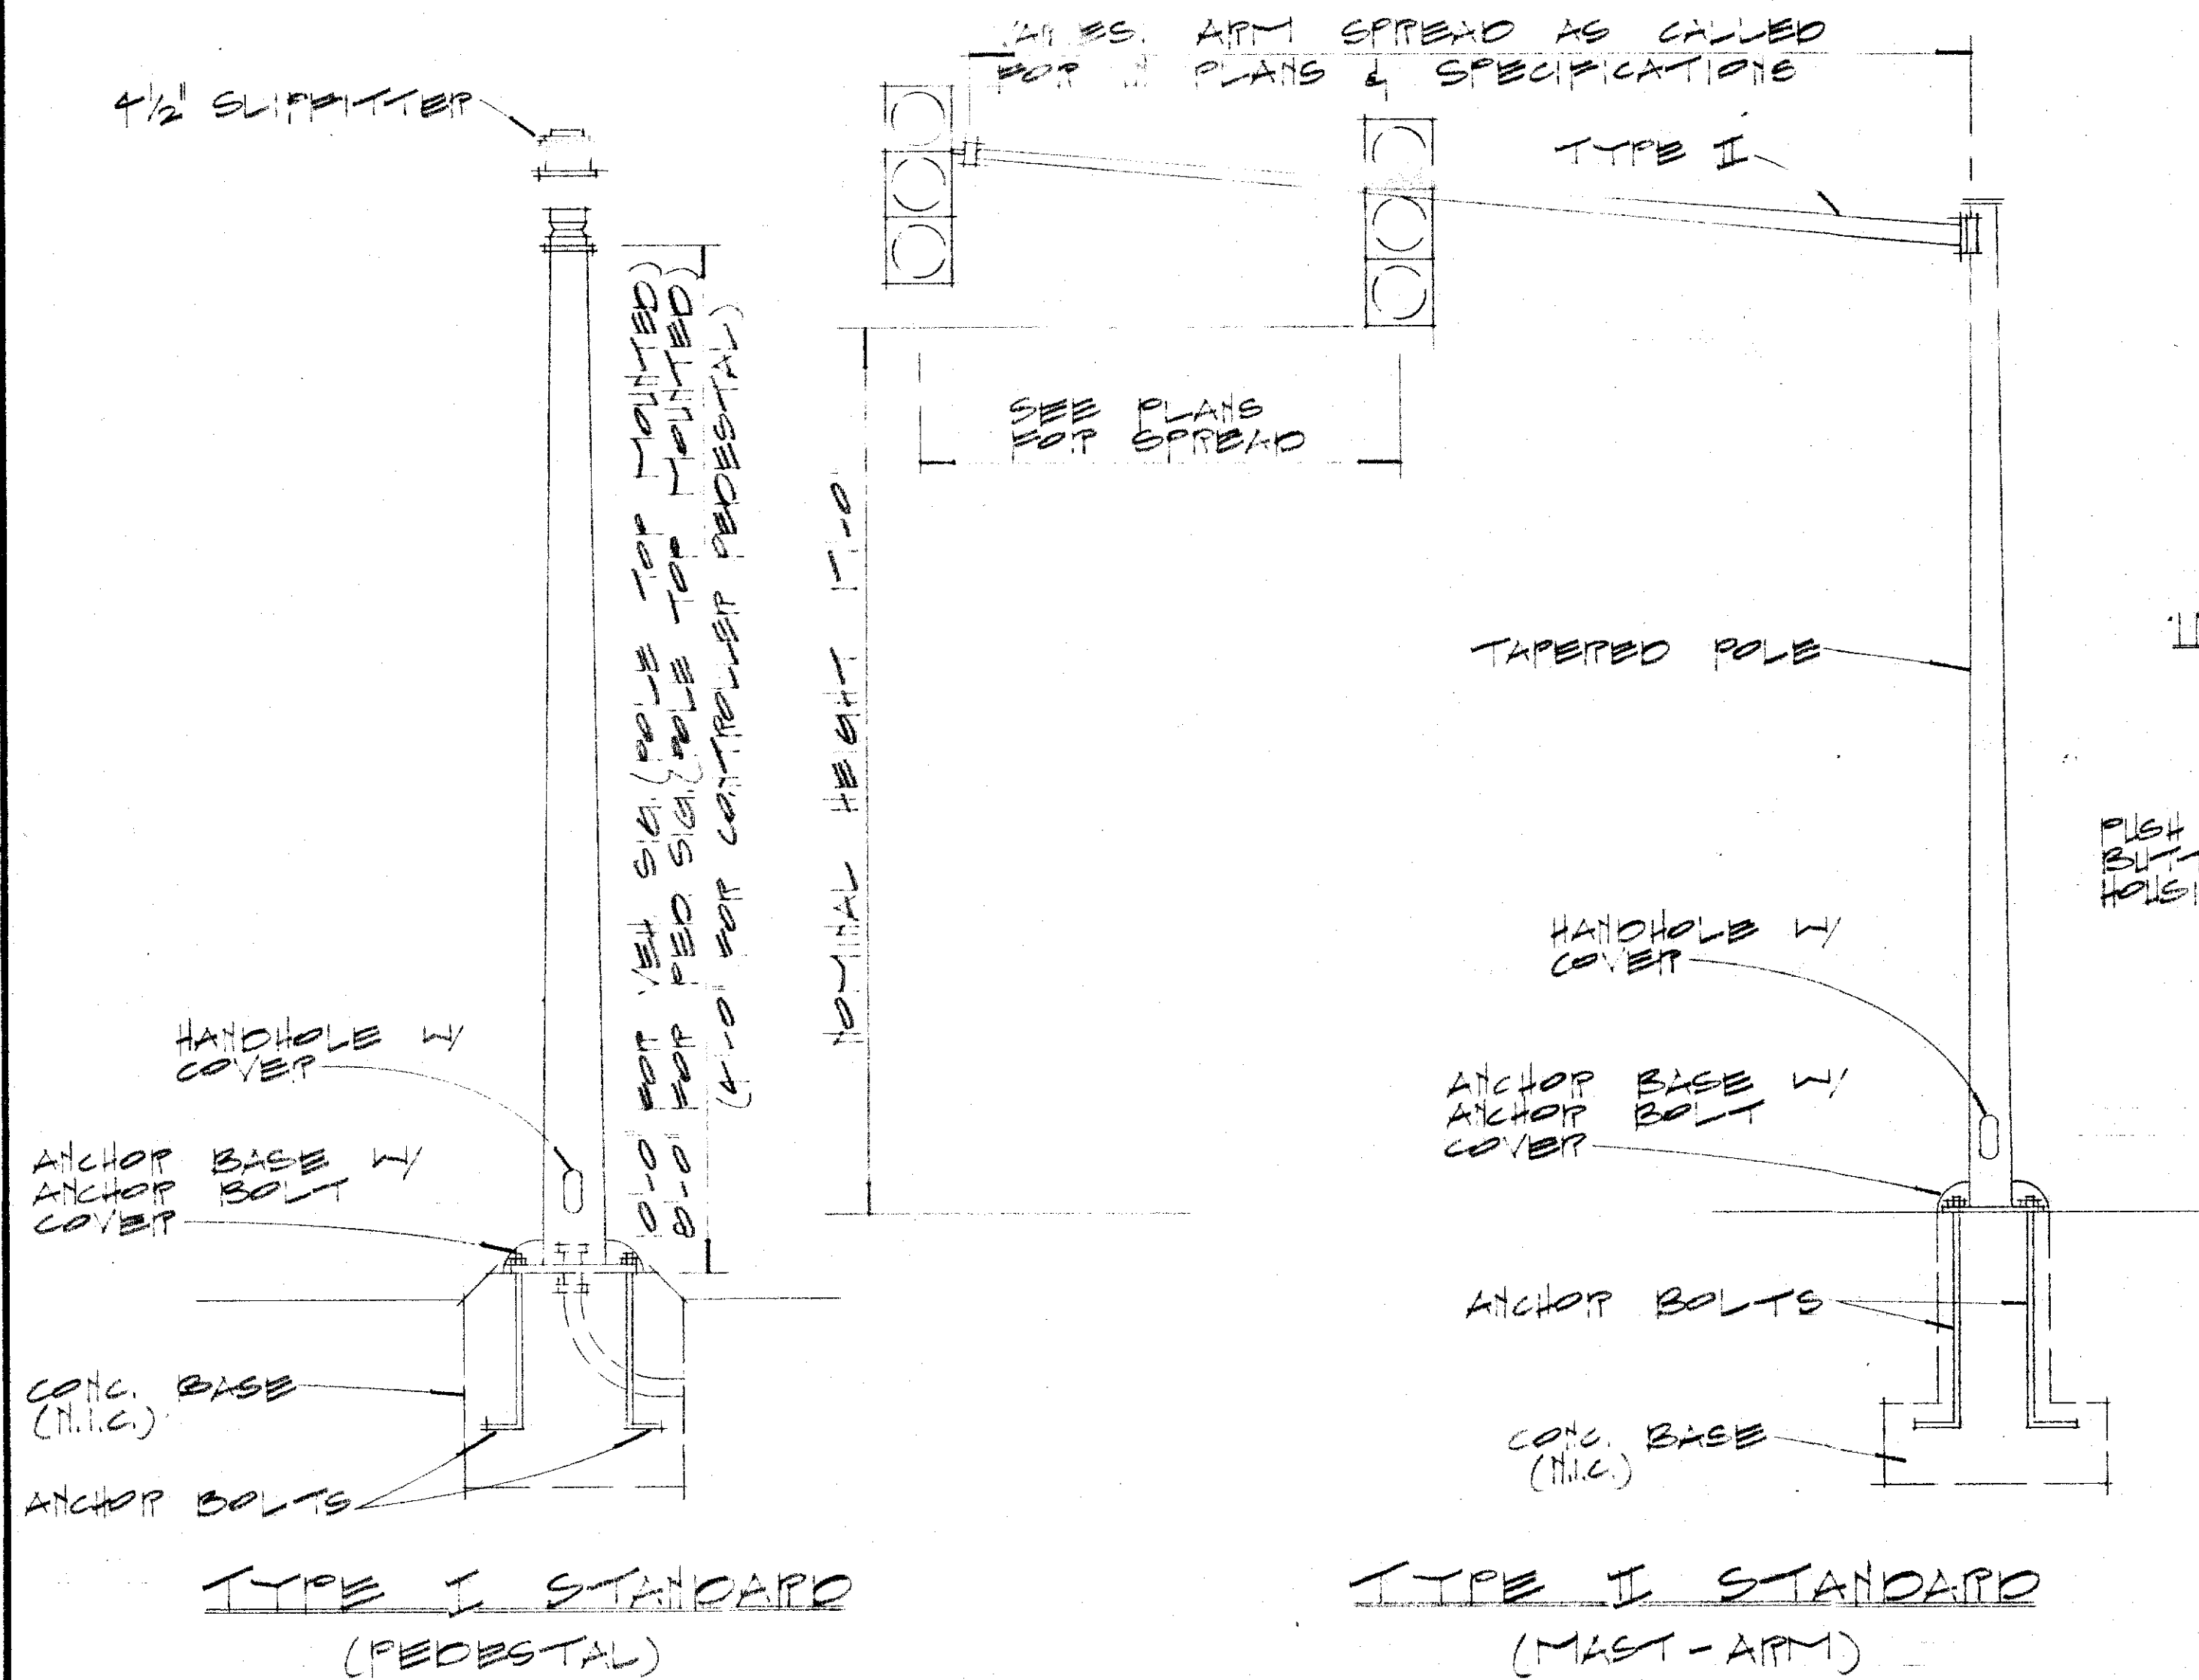

STATE OF HAWAII
DEPARTMENT OF TRANSPORTATION
HIGHWAYS DIVISION

TRAFFIC SIGNAL
DETAILS & NOTES

Project No. HWY-02-73

Scale: As Shown July 1973

SHEET No. 3 OF 3 SHEETS

DATE	REVISION
1974	1
1974	2
1974	3
1974	100