IN	DEX TO DRAWINGS
SHEET NO.	
l	TITLE SHEET
2	PLAN
3	DETAILS & NOTES
-	·
18	
: :	
	į.
·	



STATE OF HAWAII

DEPARTMENT OF TRANSPORTATION HIGHWAYS DIVISION

HONOLULU, HAWAII


PLANS FOR

FURNISHING AND DELIVERING TRAFFIC SIGNAL EQUIPMENT

FOR

SIX INTERSECTIONS
STATEWIDE

PROJECT No. HWY-02-73

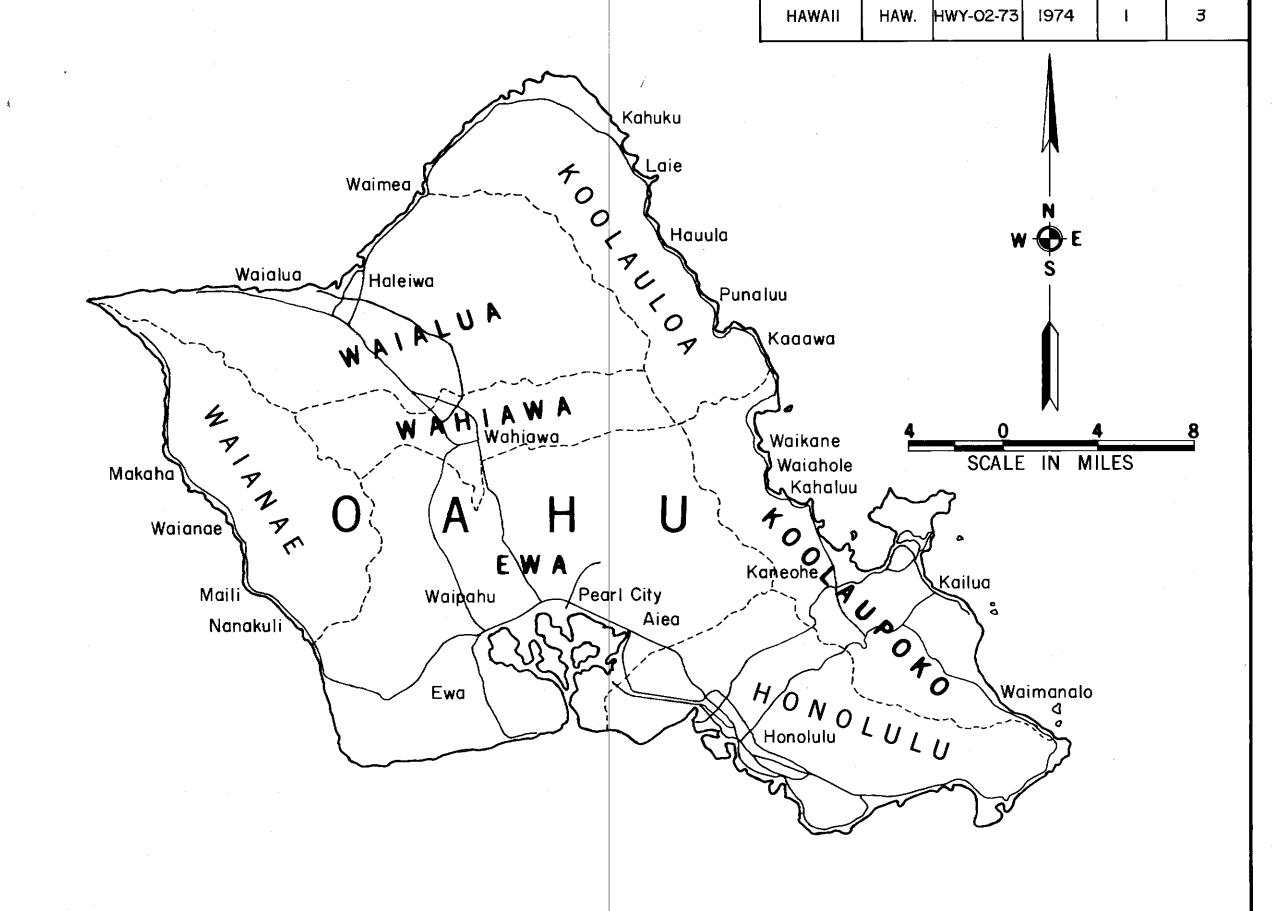

NO "AS-BUILT" CHANGES MADE

DEPARTMENT OF TRANSPORTATION
STATE OF HAWAII

APPROVED:

Dougland Salemoti
DIR OF TRANSPORTATION

DATE

FISCAL SHEET TOTAL YEAR NO. SHEETS

 AT - DT
 D. BEVIER
 948-7537
 July 17, 1973

 DESIGNED BY
 P. S. & E. BY
 PHONE
 DATE