


FED. ROAD DIST. NO.	STATE	FEDERAL AID PROJ. NO.	FISCAL YEAR	SHEET NO.	TOTAL SHEETS
HAWAII	HAW.	IM-0300(115)	2009	7	36

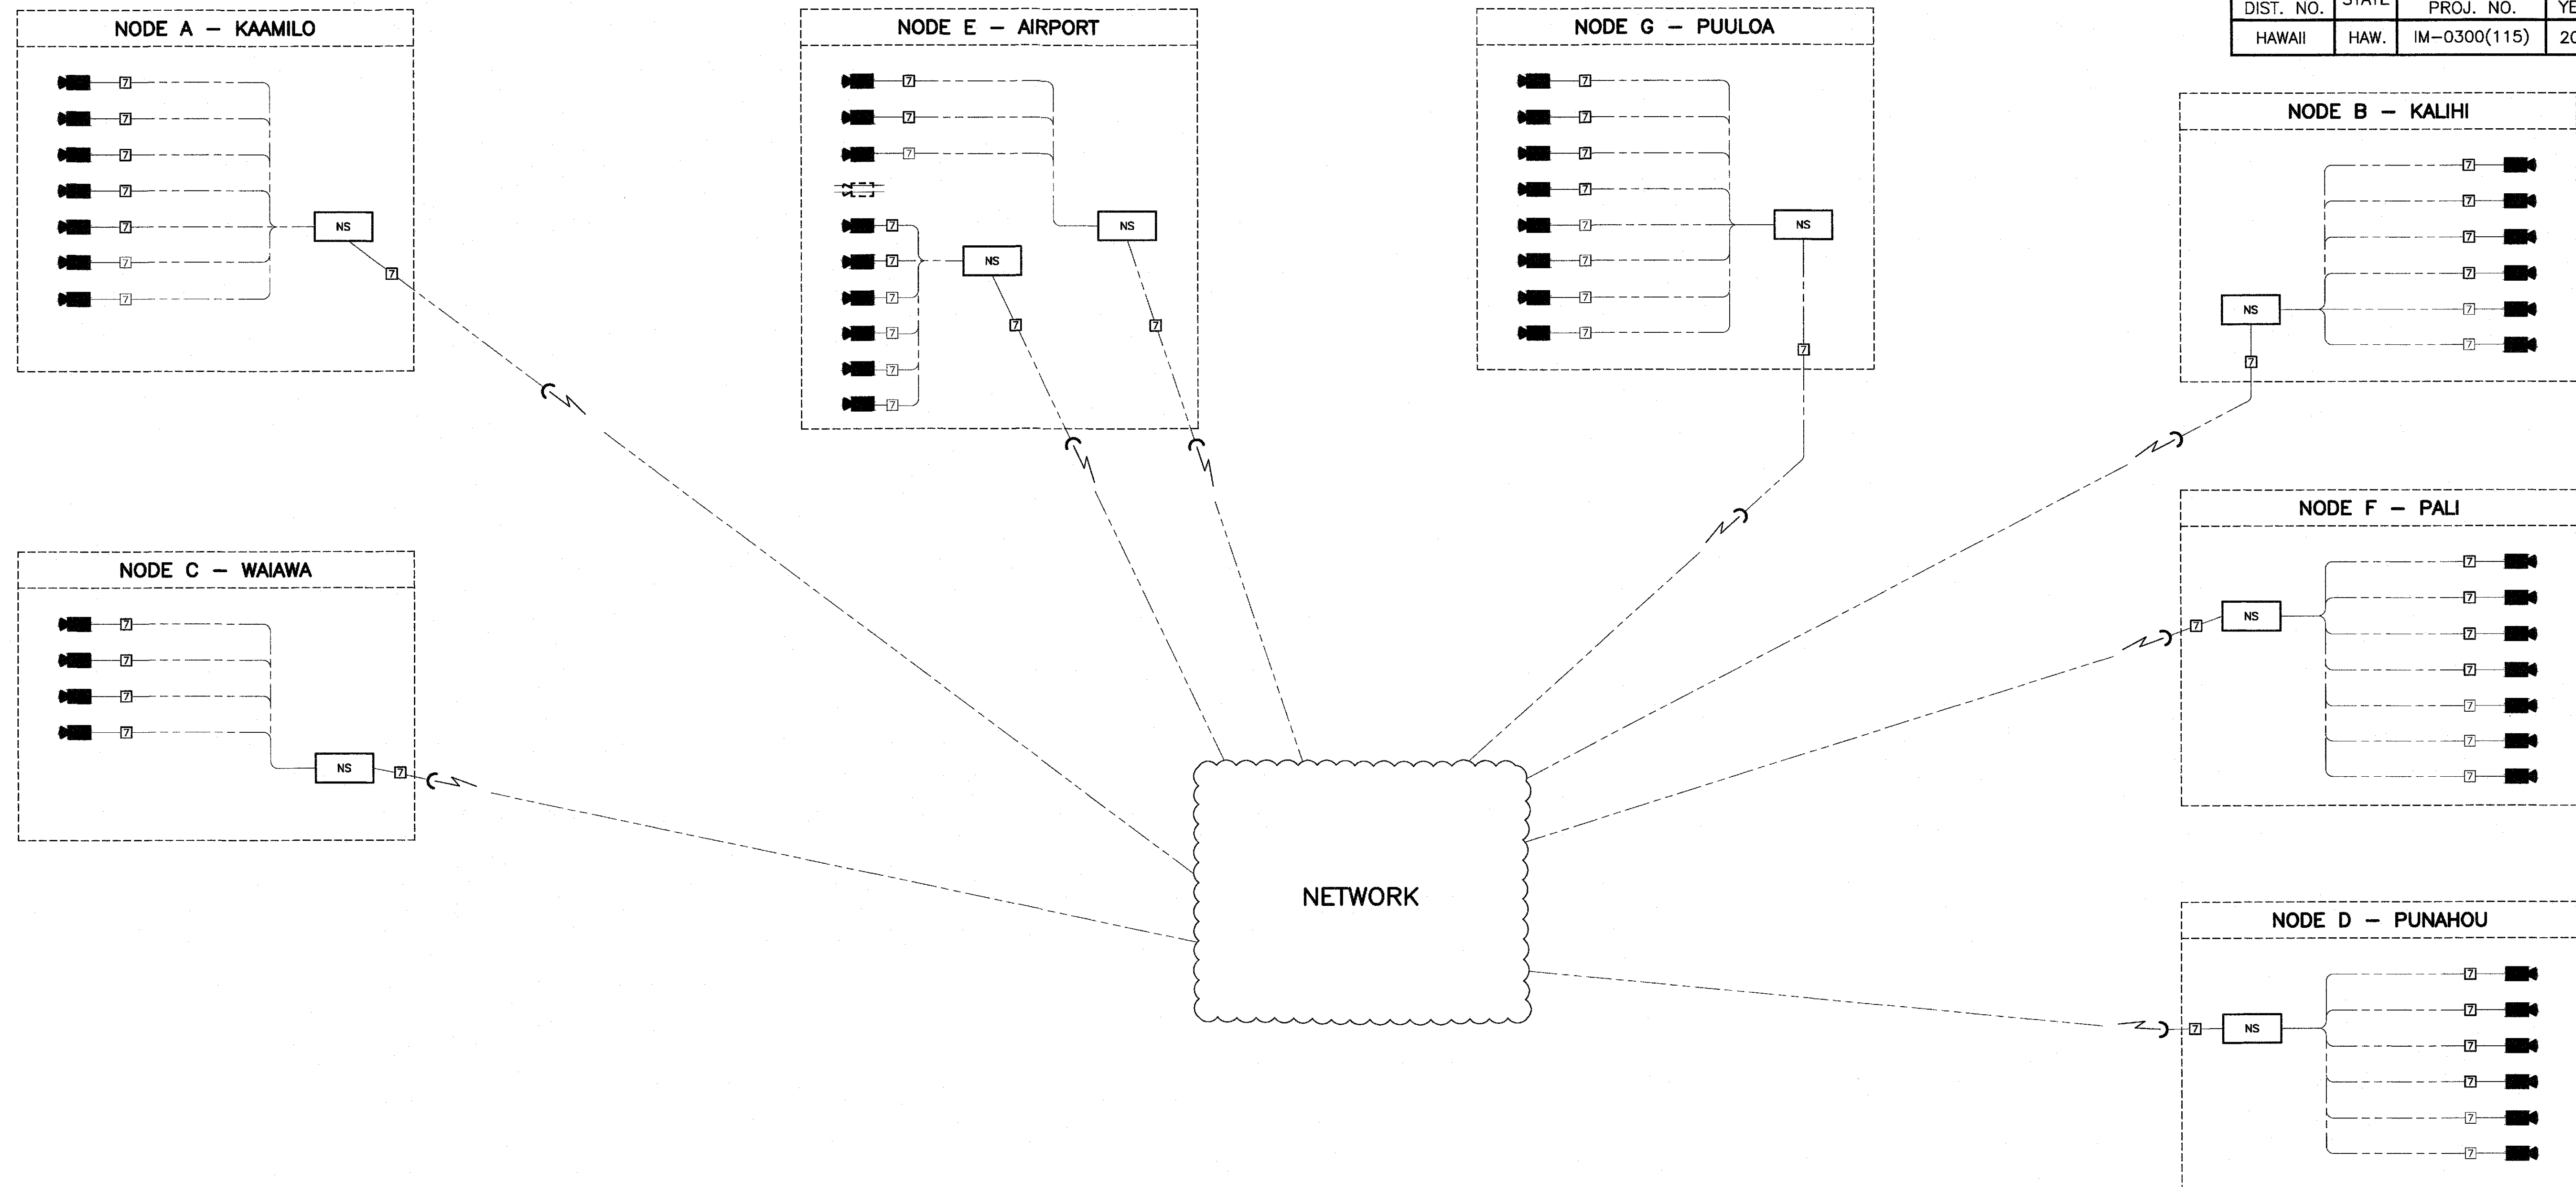

LEGEND FOR AS-BUILT POSTINGS

~~~~~ Squiggly line for as-built deletion

100,000 Double line for as-built deletion

Roadway Text for as-built posting

**NOTES:**

1. REFER TO CONSTRUCTION NOTES FOR CABLE LEGEND AND CONDUCTOR SUMMARY.

ALL EQUIPMENT IS PROPOSED  
UNLESS NOTED OTHERWISE

STATE OF HAWAII  
DEPARTMENT OF TRANSPORTATION  
HIGHWAYS DIVISION


**BLOCK DIAGRAM**

FREEWAY MANAGEMENT SYSTEM PHASE 1B  
TRAVELER INFORMATION SYSTEM, UNIT 3  
ITS EQUIPMENT INSTALLATION

F.A.P. NO. IM-0300(115)

SCALE: NONE DATE: DEC 2008

**SHEET No. E-01 OF 36 SHEETS**

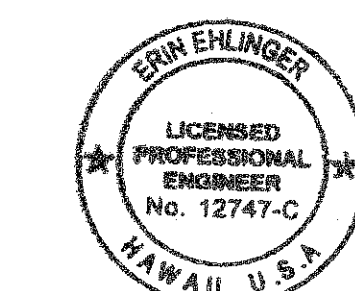

Erin Ehlinger  
THIS WORK WAS PREPARED BY ME  
OR UNDER MY SUPERVISION

"AS-BUILT"