
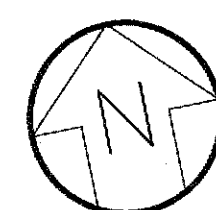


INDEX TO DRAWINGS	
SHEET No.	DESCRIPTION
1	TITLE SHEET
2	STATE STANDARD PLAN SUMMARY
3	CONSTRUCTION NOTES & ABBREVIATIONS
4-5	CONSTRUCTION NOTES
6	LEGEND, NOMENCLATURE AND NOTES
7	BLOCK DIAGRAM
8-10	NODE A - KAAMILO
11-13	NODE B - KALIHI
14-17	NODE C - WAIAWA
18-20	NODE D - PUNAHOU
21-25	NODE E - AIRPORT
26-29	NODE F - PALI
30-32	NODE G - PUULOA
33-34	CABINET DETAILS
35	LPR CAMERA MOUNTING - DETAILS
36	SPOT SPEED SENSOR - DETAILS

CHANGES MADE DURING CONSTRUCTION
HAVE BEEN INCORPORATED ON THESE
PLANS EXCEPT CHANGES IN THE
ORIGINAL THEORETICAL QUANTITIES FOR
ACTUAL QUANTITIES, REFER TO PROJECT
LEDGER AND/OR COMPUTATION BOOK.

Kevin Akagawa
RESIDENT ENGINEER
DATE 6-20-19

ICx TG
DESIGNED BY
HWY-TO
P. S. & E. BY
692-7673
PHONE
DEC 2008
DATE

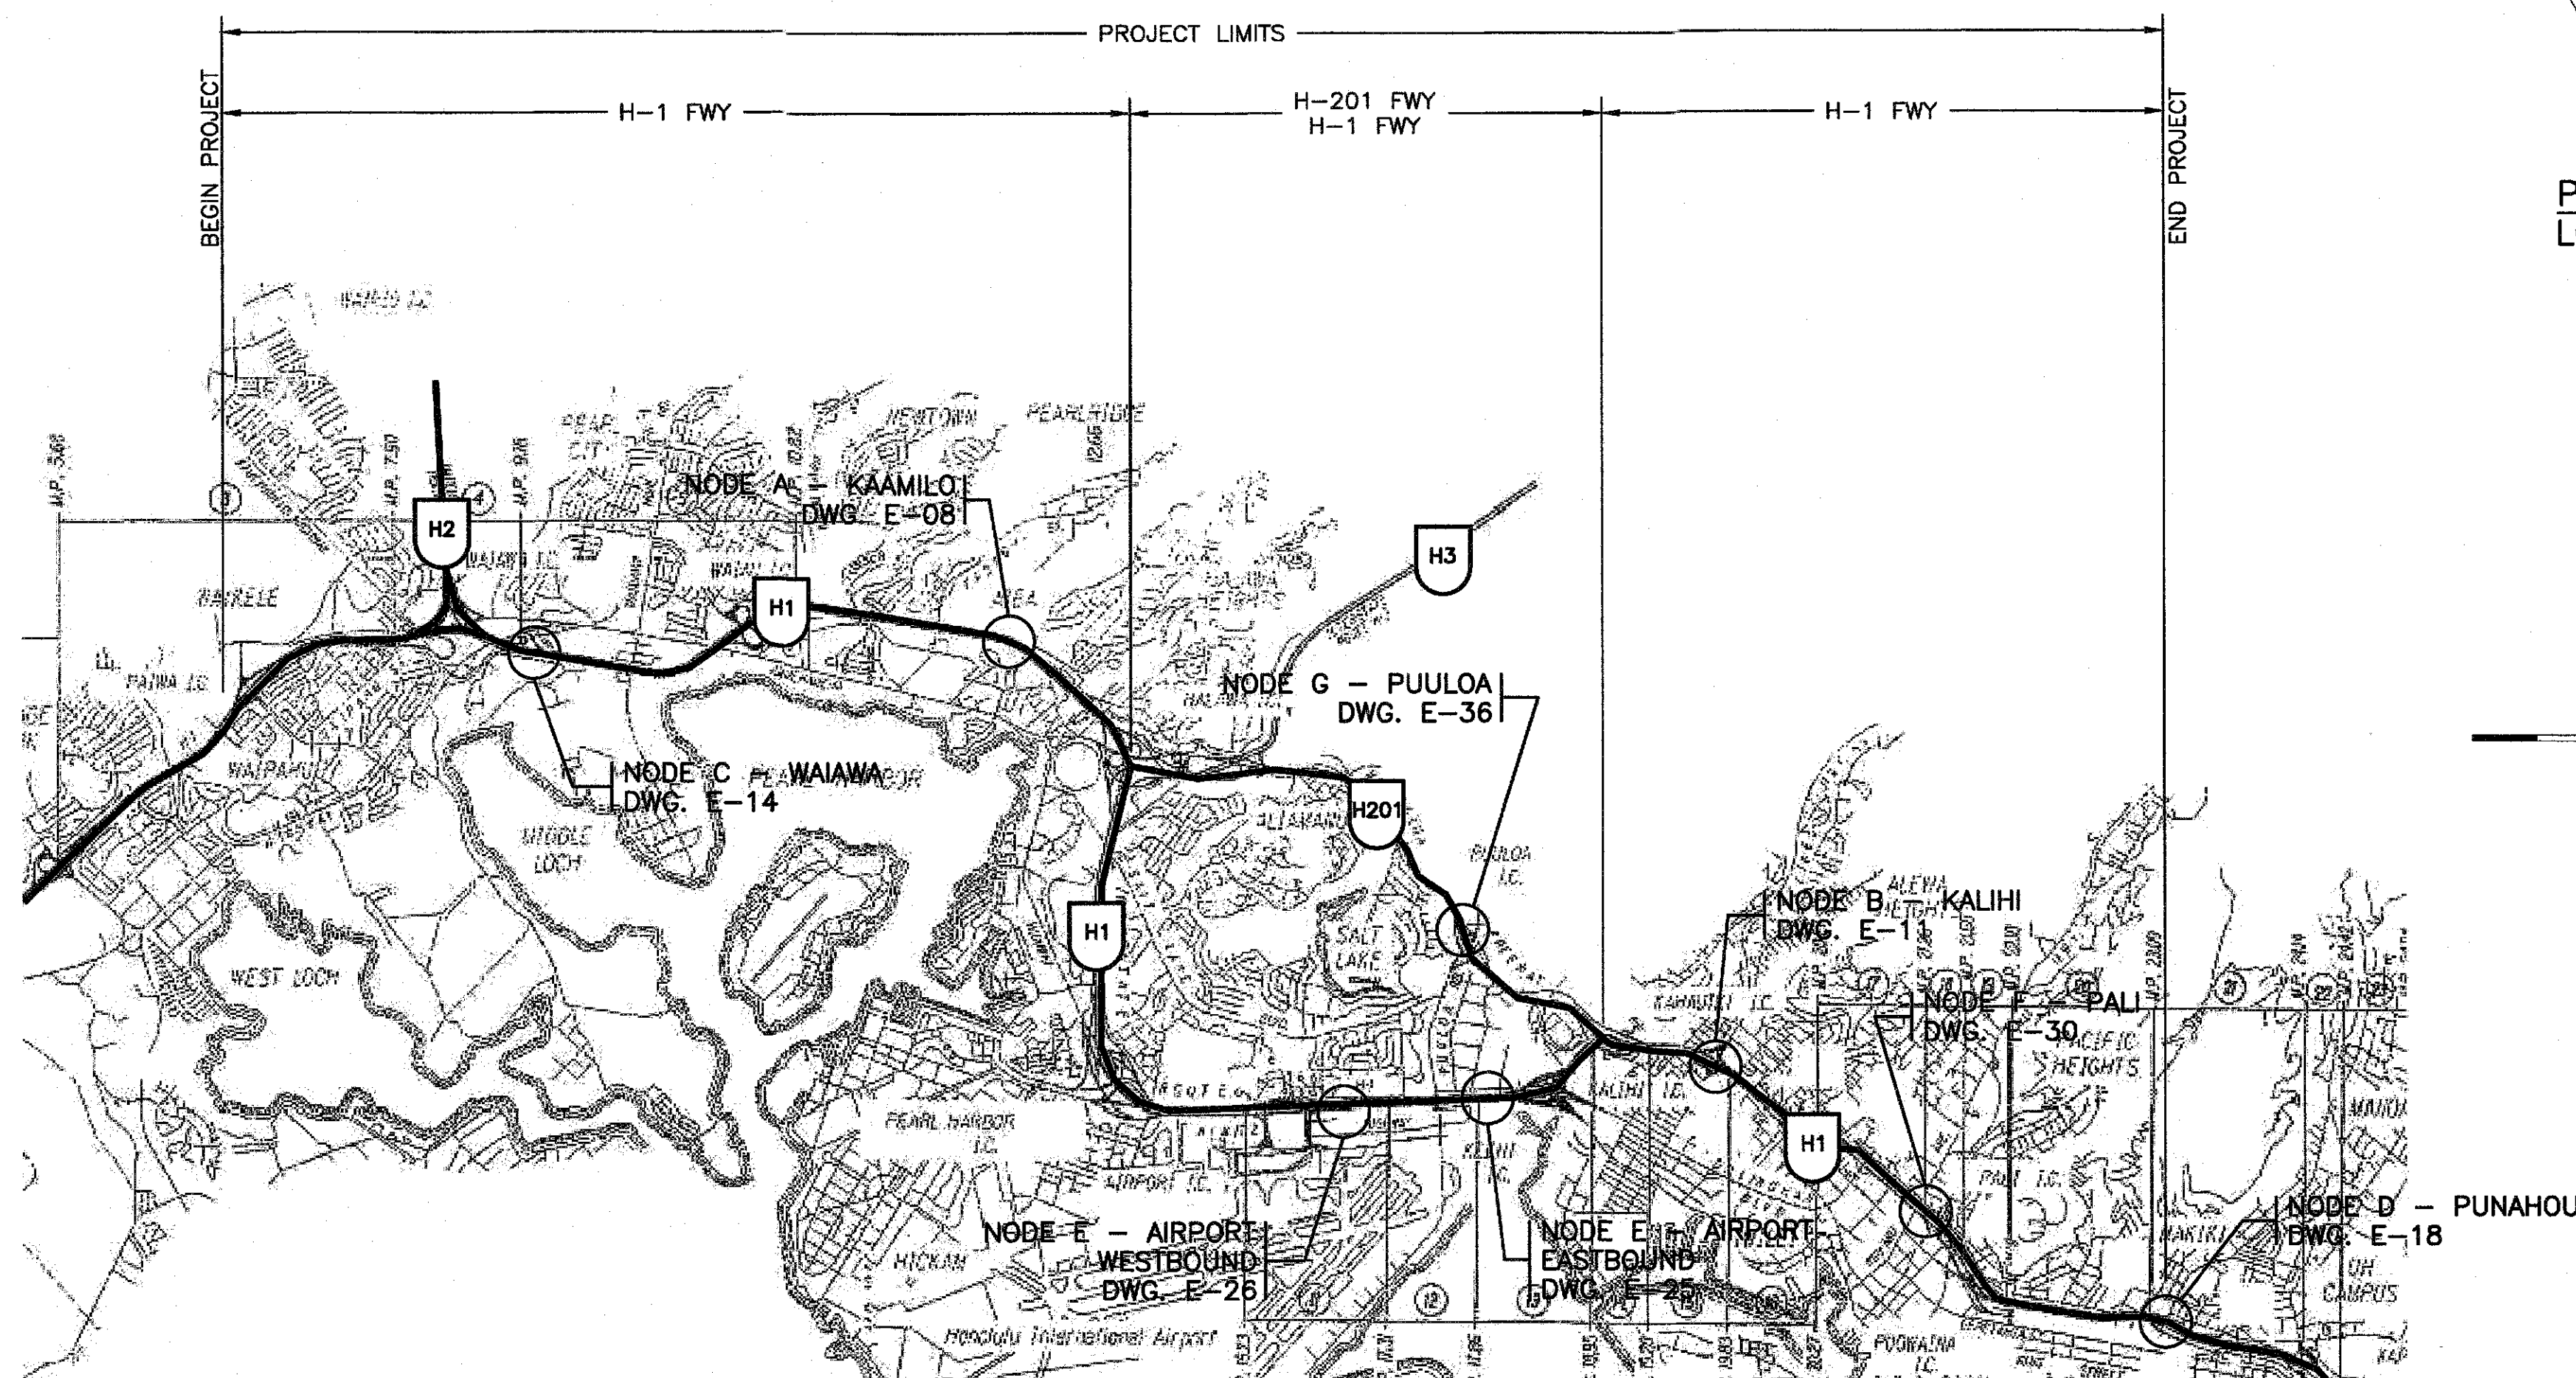

LAYOUT PLAN
NOT TO SCALE

○ PROJECT SITES

— FEDERAL AID PROJECTS PREVIOUSLY CONSTRUCTED
OR UNDER CONSTRUCTION

H1
MILE POST 9.1 TO MILE POST 23.2

H201
MILE POST 2.8 TO MILE POST 2.9

DEPARTMENT OF TRANSPORTATION STATE OF HAWAII	
APPROVED:	DATE
<i>[Signature]</i> DIR. OF TRANSPORTATION	1-12-09

STATE OF HAWAII

DEPARTMENT OF TRANSPORTATION

HIGHWAYS DIVISION
HONOLULU, HAWAII

"AS-BUILT" PLANS FOR
FREEWAY MANAGEMENT SYSTEM PHASE 1B
TRAVELER INFORMATION SYSTEM, UNIT 3
ITS EQUIPMENT INSTALLATION

FEDERAL-AID PROJECT No. IM-0300(115)

DISTRICTS OF HONOLULU AND EWA
ISLAND OF OAHU

FED. ROAD DIST. NO.	STATE	FEDERAL AID PROJ. NO.	FISCAL YEAR	SHEET NO.	TOTAL SHEETS
HAWAII	HAW.	IM-0300(115)	2009	1	36

