
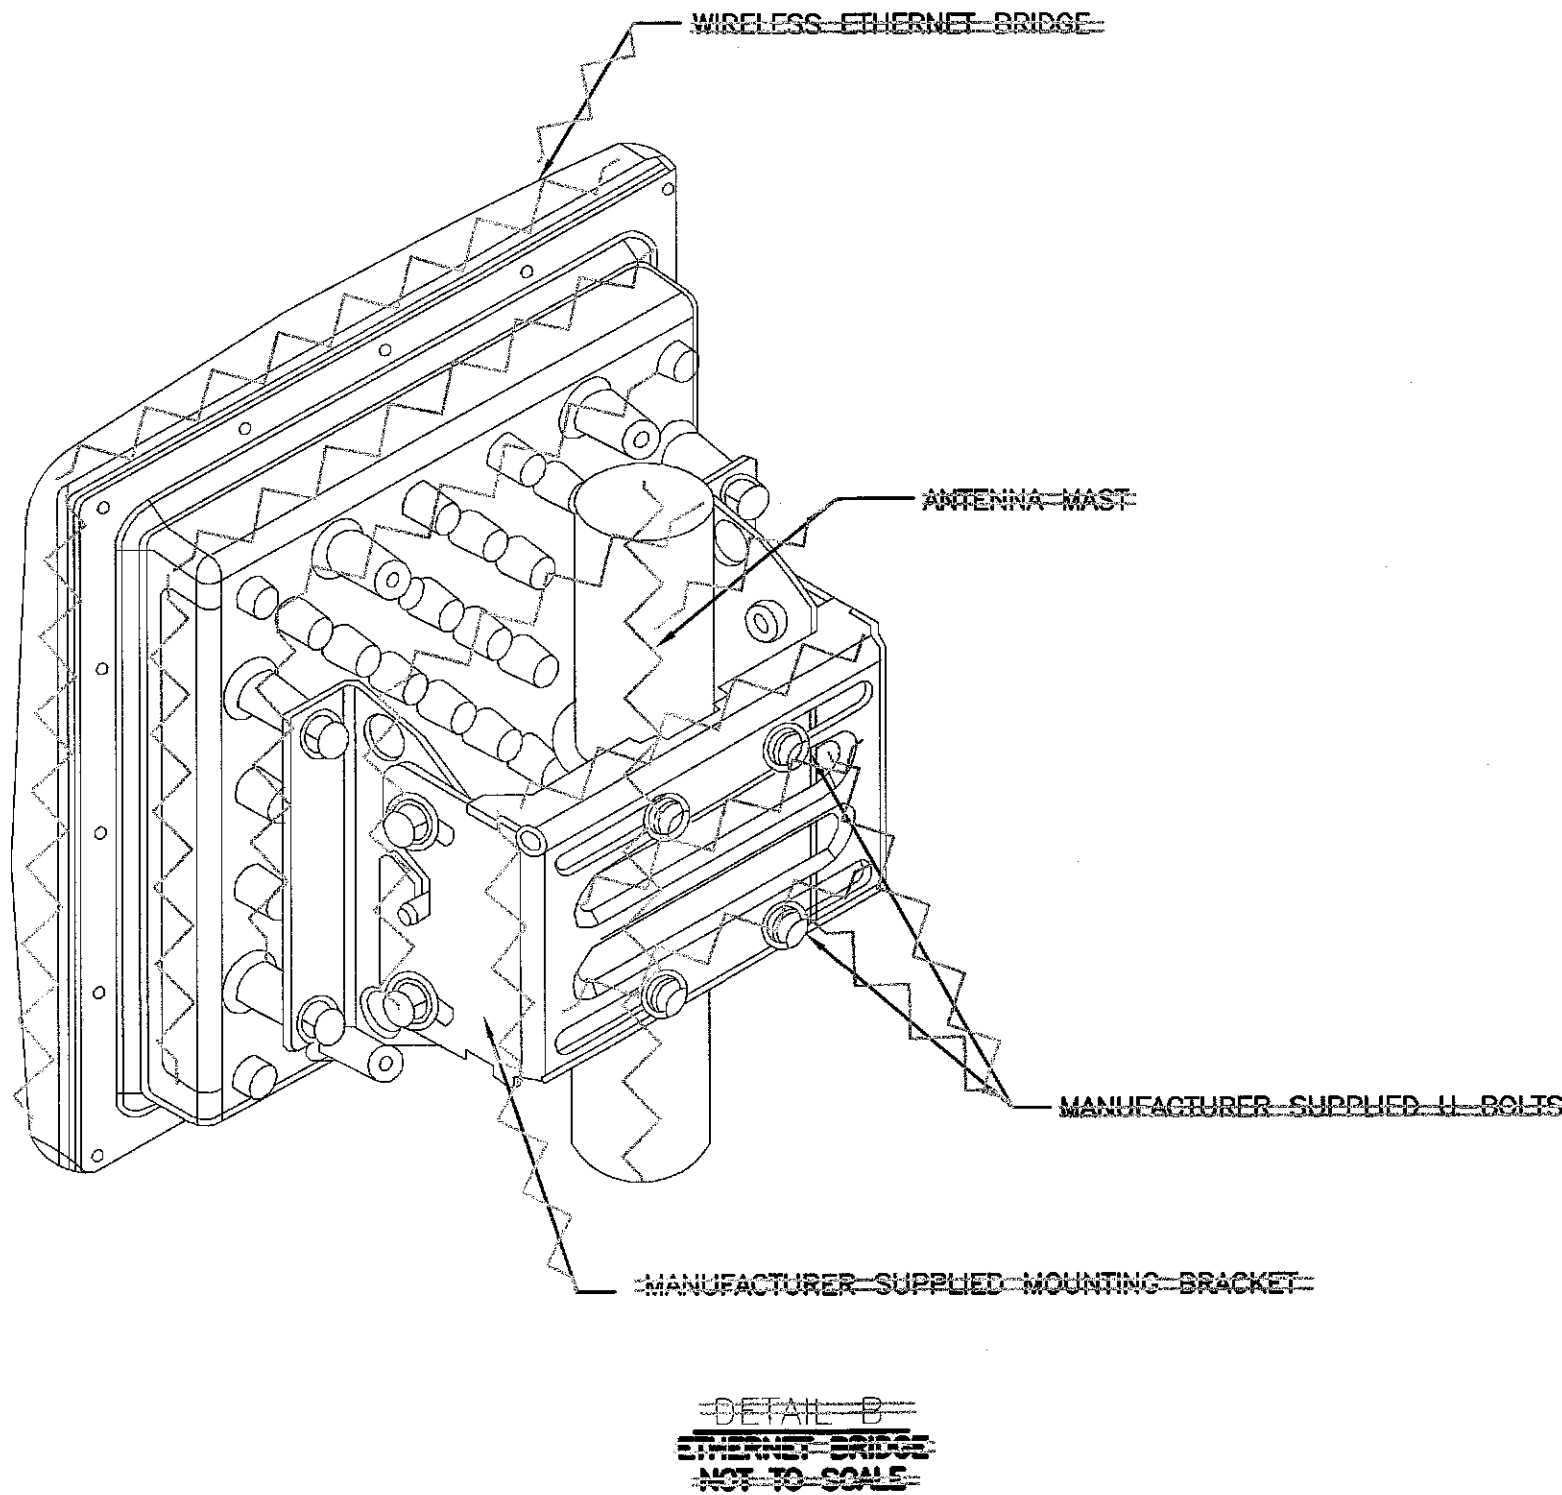
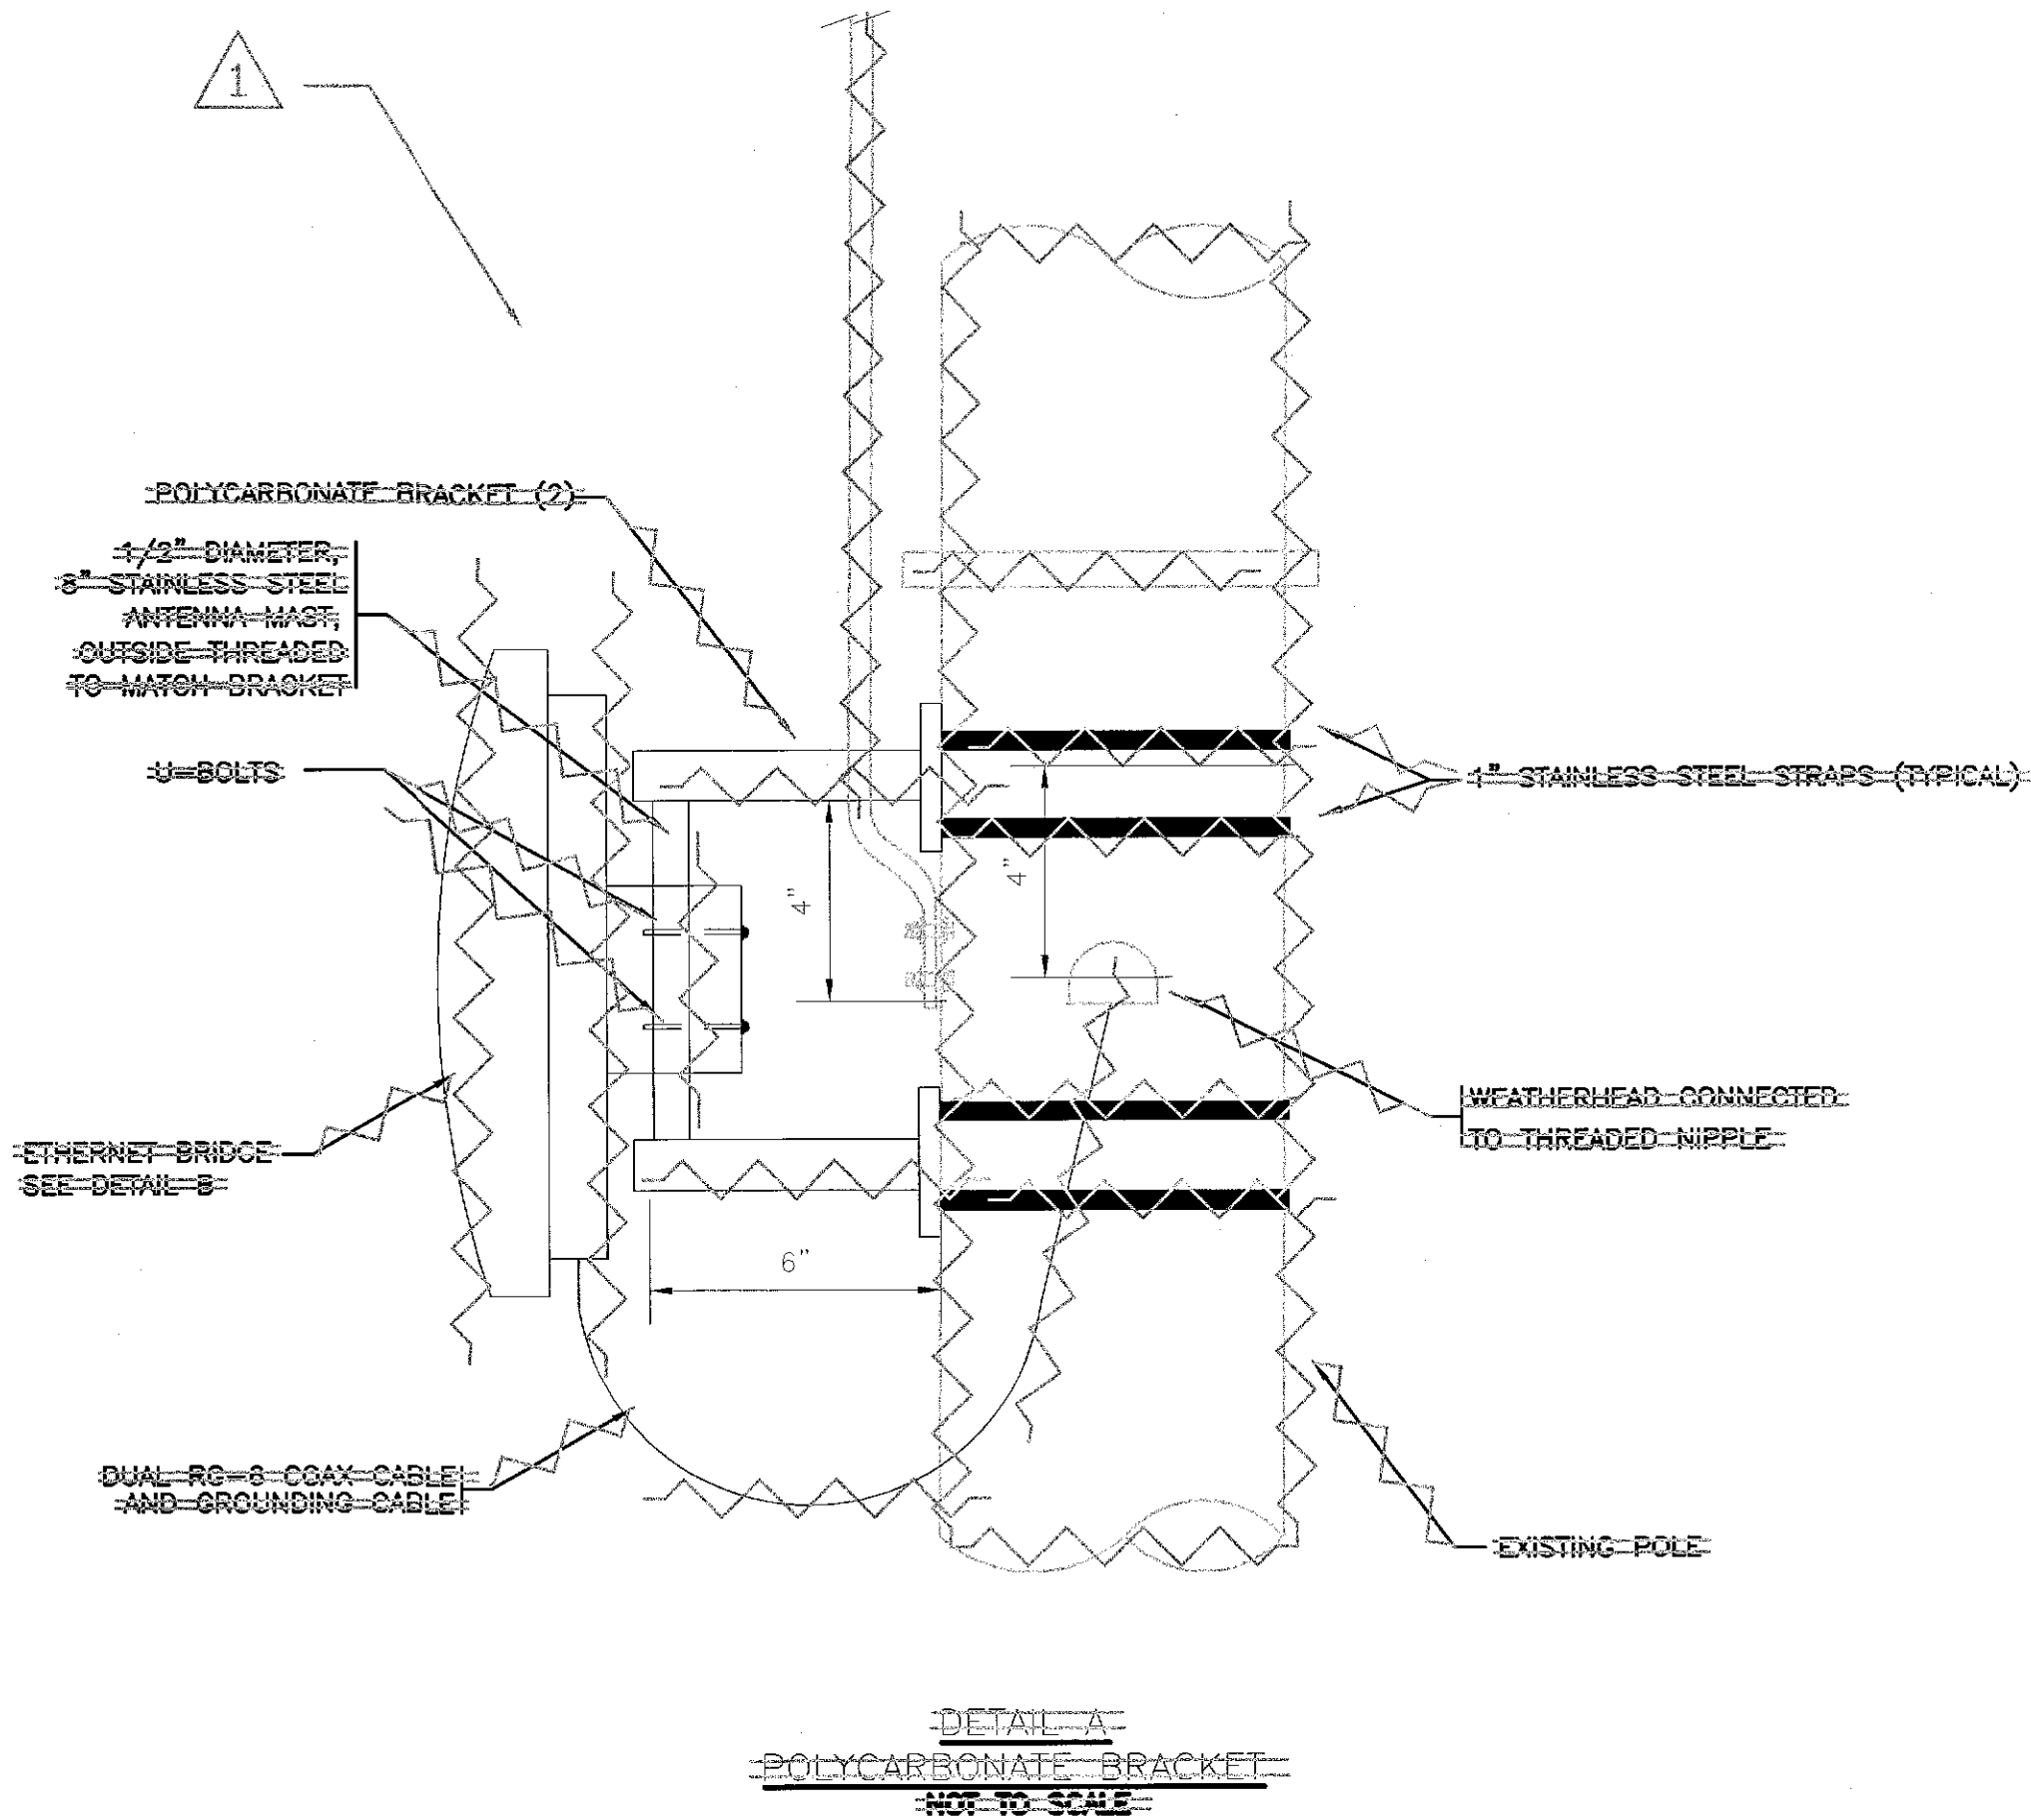


FED. ROAD DIST. NO.	STATE	FEDERAL AID PROJ. NO.	FISCAL YEAR	SHEET NO.	TOTAL SHEETS
HAWAII	HAW.	STP-0300(145)	2016	17	20

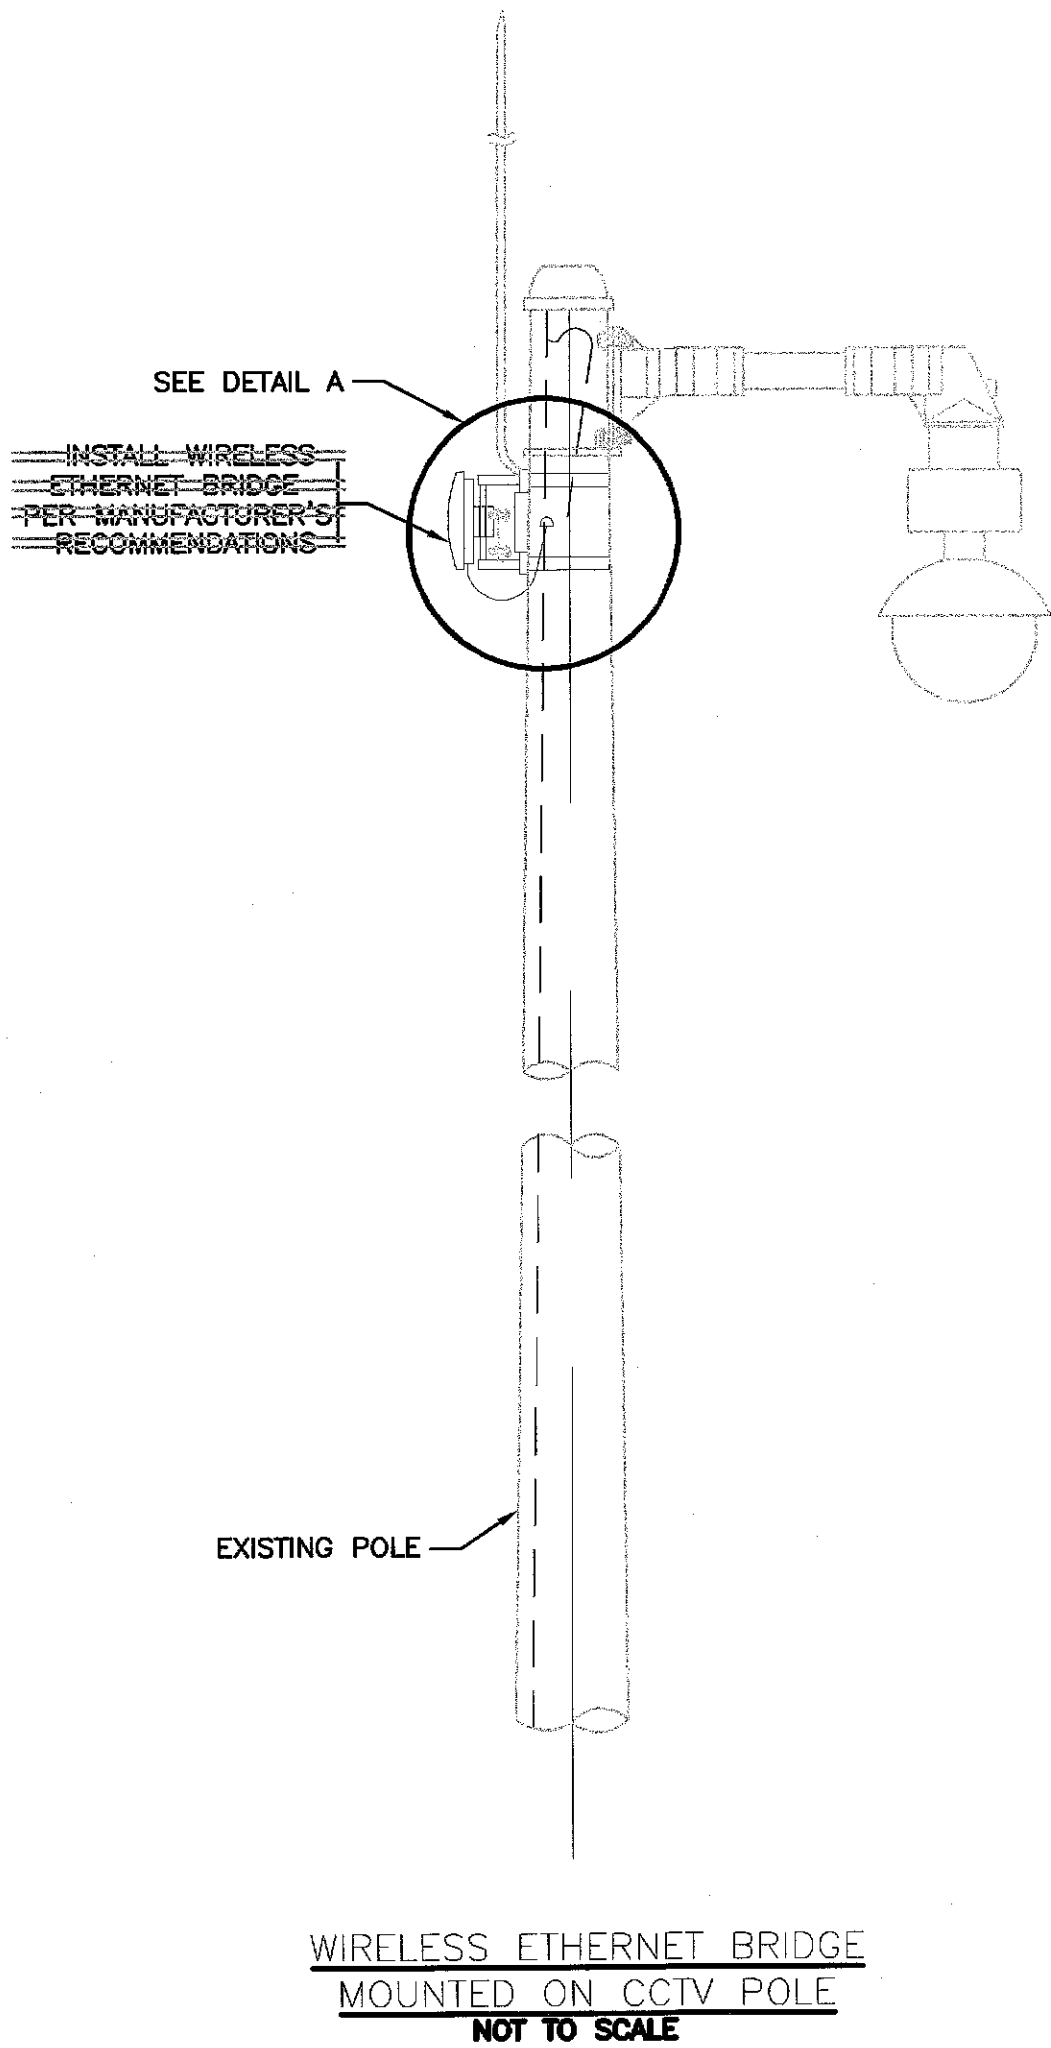


NOTE:

- Recently installed and existing Wireless Ethernet Bridges (WEB) were removed due to Health and Safety concerns. Existing mounting brackets were corroding and in some instances, falling to the ground.
- Eight (8) units removed; Ala Napunani/Aolani, Ala Kapuna, Red Hill, Halawa Interchange (Ulune On-ramp), Damon Overpass (Kaua-Ahua), Funston/Ft Shafter, Puuloa and Middle Street.

LEGEND FOR AS-BUILT POSTINGS

- Squiggly line for as-built deletions
- Double line for as-built deletions
- Roadway Text for as-built deletions

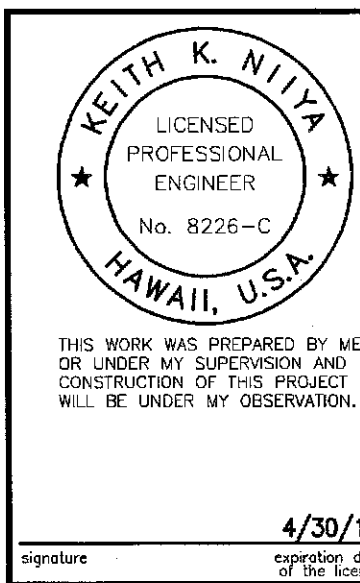

STATE OF HAWAII
DEPARTMENT OF TRANSPORTATION
HIGHWAYS DIVISION
CCTV WIRELESS BRIDGE REPLACEMENT
Freeway Management System
Phase 1C, Part 3a
Data Expansion
Various Locations
Federal Aid Project No. STP-0300(145)
Scale: As Noted

4/30/18
Date: May 2016

