



FED. ROAD DIST. NO.	STATE	FEDERAL AID PROJ. NO.	FISCAL YEAR	SHEET NO.	TOTAL SHEETS
HAWAII	HAW.	STP-0300(145)	2016	11	20

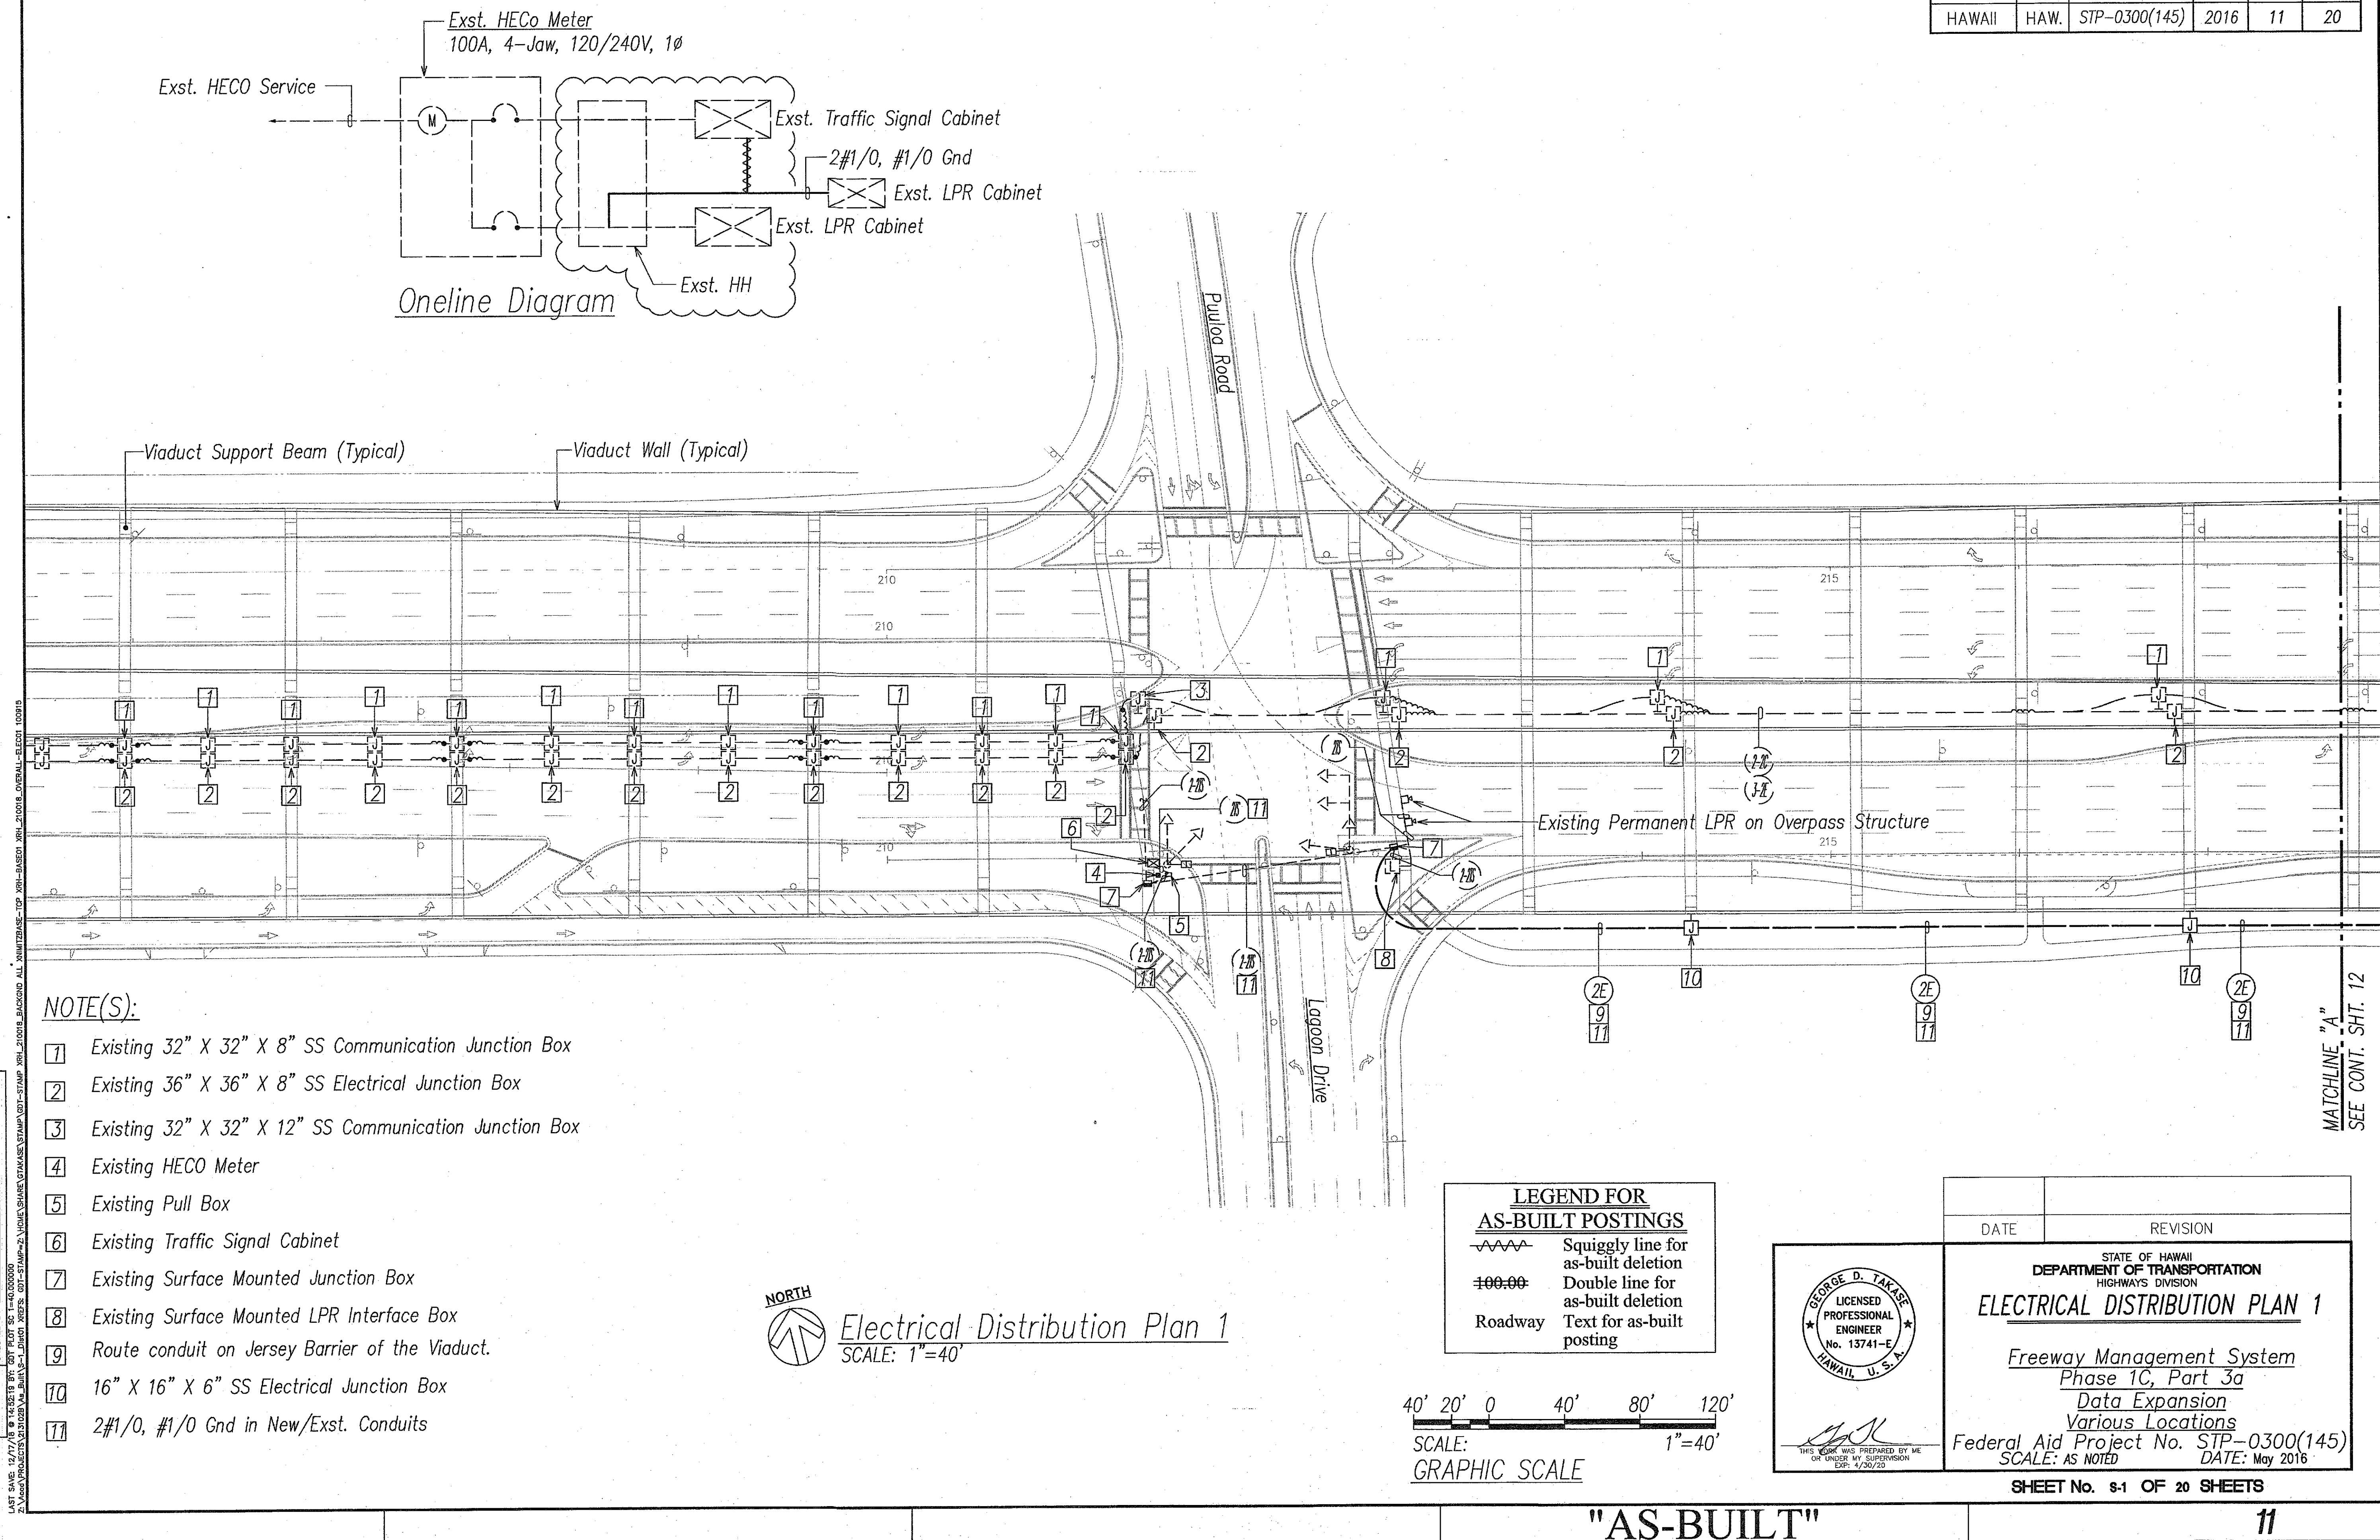

FED. ROAD DIST. NO.	STATE	FEDERAL AID PROJ. NO.	FISCAL YEAR	SHEET NO.	TOTAL SHEETS
HAWAII	HAW.	STP-0300(145)	2016	12	20

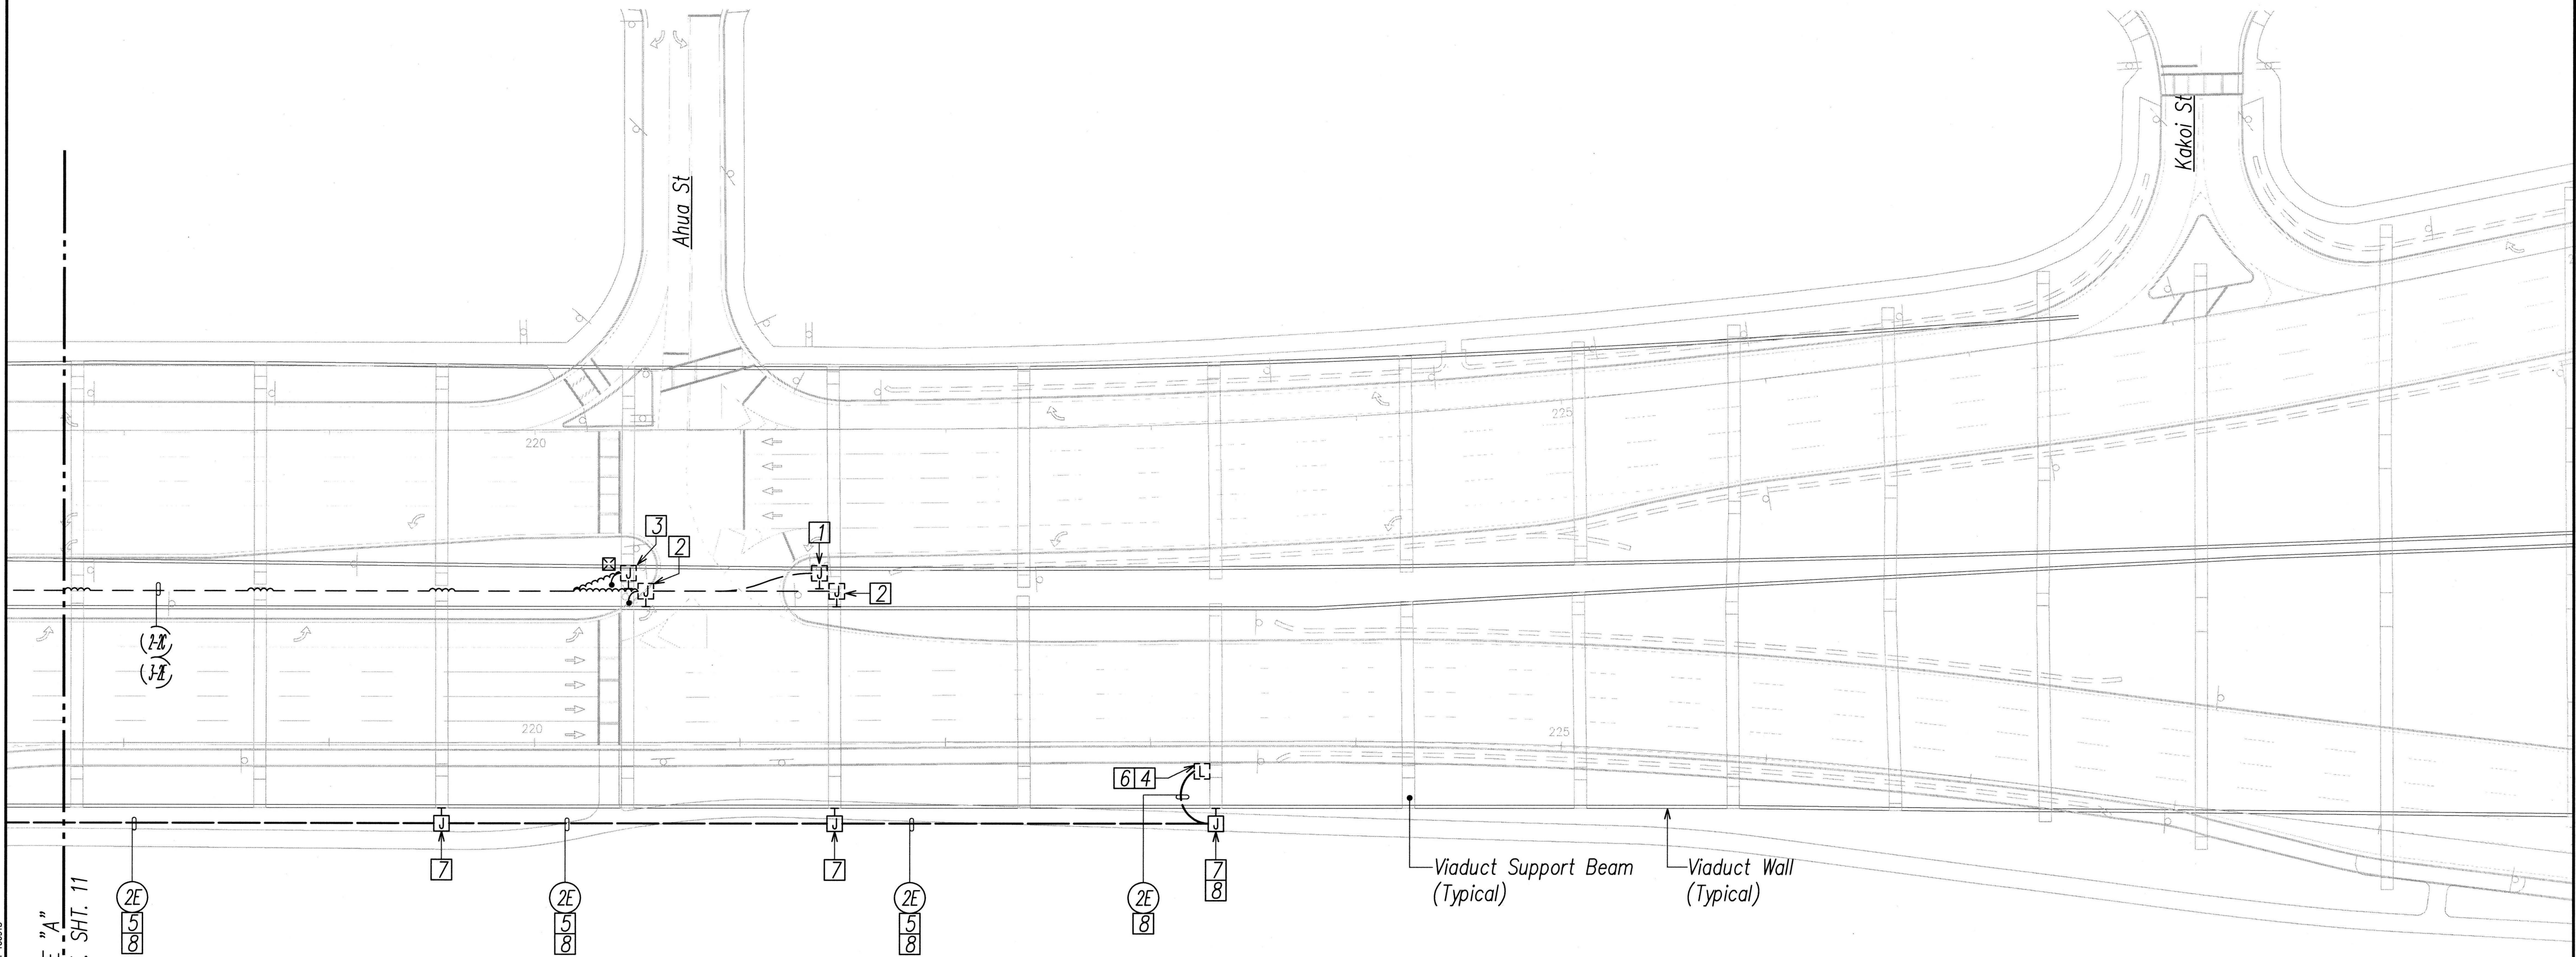


NOTE(S):

- 1 Existing 32" X 32" X 8" SS Communication Junction Box
- 2 Existing 36" X 36" X 8" SS Electrical Junction Box
- 3 Existing 32" X 32" X 12" SS Communication Junction Box
- 4 Existing Surface Mounted VMS Sign with LPR.
- 5 Route conduit on Jersey Barrier of the Viaduct.
- 6 Contractor to remove existing VMS electrical connection and reconnect to panel at Lagoon Drive.
- 7 16" X 16" X 6" SS Electrical Junction Box
- 8 2#1/0, #1/0 Gnd in New/Exst. Conduits



Electrical Distribution Plan 2
SCALE: 1"=40'

40' 20' 0 40' 80' 120'
SCALE: 1"=40'
GRAPHIC SCALE

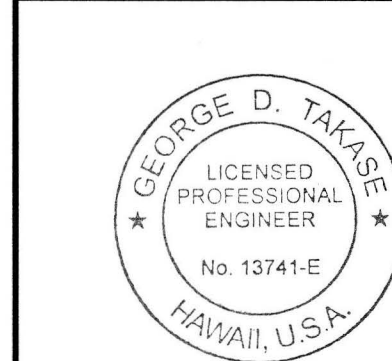

THIS WORK WAS PREPARED BY ME
OR UNDER MY SUPERVISION
DATE: 4/30/16

DATE	REVISION
STATE OF HAWAII DEPARTMENT OF TRANSPORTATION HIGHWAYS DIVISION ELECTRICAL DISTRIBUTION PLAN 2 Freeway Management System Phase 1C, Part 3a Data Expansion Various Locations Federal Aid Project No. STP-0300(145) SCALE: AS NOTED DATE: May 2016	

SHEET No. 12 OF 20 SHEETS