






Spot Speed Locations

DEVICE ID	APPR	RECD	ROUTE	INST LOC	DESCRIPTION	APPROX LAT (DEG MIN)	APPROX LONG (DEG MIN)	LANE / SHLDR CLOSURE REQD
H-3-1	EB	WB	H-3	EB	FOR BOTH EB AND WB DIRECTIONS Street light pole	N21°22.464'	W157°54.548'	SHOULDER CLOSURE ONLY
H-3-2	EB	WB	H-3	EB	FOR BOTH EB AND WB DIRECTIONS Street light pole	N21°23.086'	W157°53.922'	SHOULDER CLOSURE ONLY
H-3-3	EB	WB	H-3	EB	FOR BOTH EB AND WB DIRECTIONS Street light pole at emergency call box	N21°23.685'	W157°53.281'	SHOULDER CLOSURE ONLY
H-3-4	EB	WB	H-3	EB	FOR BOTH EB AND WB DIRECTIONS Street light pole	N21°24.111'	W157°52.464'	SHOULDER CLOSURE ONLY
H-3-5	N/A	WB	H-3	WB	FOR WB DIRECTION ONLY Street light pole	N21°24.401'	W157°51.605'	SHOULDER CLOSURE ONLY
H-3-6	EB	N/A	H-3	EB	FOR EB DIRECTION ONLY Street light pole	N21°24.379'	W157°51.602'	SHOULDER CLOSURE ONLY
H-3-7	EB	WB	H-3	EB	FOR EB DIRECTION ONLY Street light pole near tunnel going in inbound direction	N21°24.282'	W157°51.064'	SHOULDER CLOSURE ONLY
H-3-8	WB	WB	H-3	WB	FOR WB DIRECTION ONLY Street light pole near tunnel going in outbound direction	N21°24.294'	W157°51.016'	SHOULDER CLOSURE ONLY
H-3-9	EB	N/A	H-3	EB	FOR EB DIRECTION ONLY Street light pole near tunnel going in outbound direction	N21°24.199'	W157°50.089'	SHOULDER CLOSURE ONLY
H-3-10	WB	N/A	H-3	WB	FOR WB DIRECTION ONLY Street light pole near tunnel going in inbound direction	N21°24.240' N21°24.235'	W157°50.083' W157°50.094'	SHOULDER CLOSURE ONLY
H-3-11	WB	N/A	H-3	WB	FOR WB DIRECTION ONLY Street light pole	N21°24.233' N21°24.258'	W157°49.037' W157°49.068'	SHOULDER CLOSURE ONLY
H-3-12	EB	N/A	H-3	EB	FOR EB DIRECTION ONLY Street light pole	N21°24.248'	W157°49.088'	SHOULDER CLOSURE ONLY
H-3-13	EB	WB	H-3	EB	FOR BOTH EB AND WB DIRECTIONS Street light pole near emergency escape ramps	N21°23.341'	W157°48.806'	SHOULDER CLOSURE ONLY
H-3-14	EB	WB	H-3	EB	FOR BOTH EB AND WB DIRECTIONS Street light pole	N21°22.822'	W157°47.779'	SHOULDER CLOSURE ONLY
H-3-15	EB	WB	H-3	EB	FOR BOTH EB AND WB DIRECTIONS Street light pole	N21°23.116' N21°23.114'	W157°47.275' W157°47.272'	SHOULDER CLOSURE ONLY
H-3-16	WB	EB	H-3	WB	FOR BOTH EB AND WB DIRECTIONS Street light pole	N21°24.208' N21°24.335'	W157°46.091' W157°45.993'	SHOULDER CLOSURE ONLY
H-3-17	WB	EB	H-3	WB	FOR BOTH EB AND WB DIRECTIONS Destination sign	N21°24.907'	W157°45.766'	SHOULDER CLOSURE ONLY
H-3-18	WB	EB	H-3	WB	FOR BOTH EB AND WB DIRECTIONS Street light pole	N21°25.564'	W157°45.639'	SHOULDER CLOSURE ONLY
L-1	EB	WB	Likeline	MEDIAN	FOR BOTH EB AND WB DIRECTIONS Street light pole in the median	N21°21.563'	W157°51.390'	LEFT LANE CLOSURE
L-2	EB	WB	Likeline	EB	FOR BOTH EB AND WB DIRECTIONS Street light pole	N21°21.985'	W157°50.572'	LEFT LANE CLOSURE
L-3	EB	WB	Likeline	WB	FOR BOTH EB AND WB DIRECTIONS Street light pole	N21°22.299'	W157°49.648'	LEFT LANE CLOSURE
L-4	EB	N/A	Likeline	EB	FOR EB DIRECTION ONLY Street light pole near tunnel going in inbound direction	N21°22.532'	W157°49.132'	SHOULDER CLOSURE ONLY

DEVICE ID	APPR	RECD	ROUTE	INST LOC	DESCRIPTION	APPROX LAT (DEG MIN)	APPROX LONG (DEG MIN)	LANE / SHLDR CLOSURE REQD
L-5	WB	N/A	Likeline	WB	FOR WB DIRECTION ONLY Street light pole near tunnel going in outbound direction	N21°22.540'	W157°49.139'	SHOULDER CLOSURE ONLY
L-6	EB	N/A	Likeline	EB	FOR EB DIRECTION ONLY Street light pole near tunnel going in outbound direction	N21°22.801'	W157°48.692'	LEFT LANE CLOSURE
L-7	WB	N/A	Likeline	WB	FOR WB DIRECTION ONLY Street light pole near tunnel going in inbound direction	N21°22.803'	W157°48.696'	LEFT LANE CLOSURE
L-8	WB	EB	Likeline	MEDIAN	FOR BOTH EB AND WB DIRECTIONS street light pole in the median	N21°23.386'	W157°49.012'	LEFT LANE CLOSURE
L-9	WB	EB	Likeline	MEDIAN	FOR BOTH EB AND WB DIRECTIONS street light pole in the median	N21°24.113'	W157°48.520'	LEFT LANE CLOSURE
P-1	EB	WB	Pali	MEDIAN	FOR BOTH EB AND WB DIRECTIONS Street light pole in the median toward the beginning of the divided highway portion of Pali and near P-B12	N21°20.884'	W157°49.660'	LEFT LANE CLOSURE
P-2	EB	WB	Pali	MEDIAN	FOR BOTH EB AND WB DIRECTIONS Street light pole in the median	N21°21.173'	W157°49.150'	LEFT LANE CLOSURE
P-3	EB	WB	Pali	MEDIAN	FOR BOTH EB AND WB DIRECTIONS Street light pole in the median	N21°21.510'	W157°48.365'	LEFT LANE CLOSURE
P-4	EB	N/A	Pali	EB	FOR EB DIRECTION ONLY Street light pole near tunnel going in inbound direction	N21°21.930'	W157°47.683'	LEFT LANE CLOSURE
P-5	WB	N/A	Pali	WB	FOR WB DIRECTION ONLY Street light pole near tunnel going in outbound direction	N21°21.934'	W157°47.686'	LEFT LANE CLOSURE
P-6	EB	N/A	Pali	EB	FOR EB DIRECTION ONLY Street light pole near tunnel going in outbound direction	N21°22.103'	W157°47.392'	LEFT LANE CLOSURE
P-7	WB	N/A	Pali	WB	FOR WB DIRECTION ONLY Street light pole near tunnel going in inbound direction	N21°22.112'	W157°47.396'	RIGHT LANE CLOSURE
P-8	WB	EB	Pali	MEDIAN	FOR BOTH EB AND WB DIRECTIONS Street light pole in the median	N21°21.893'	W157°46.912'	LEFT LANE CLOSURE
P-9	WB	EB	Pali	MEDIAN	FOR BOTH EB AND WB DIRECTIONS Street light pole in the median	N21°22.402'	W157°46.908'	LEFT LANE CLOSURE

LEGEND FOR AS-BUILT POSTINGS	
	Squiggly line for as-built deletions
	Double line for as-built deletions
	Roadway Text for as-built postings

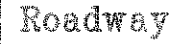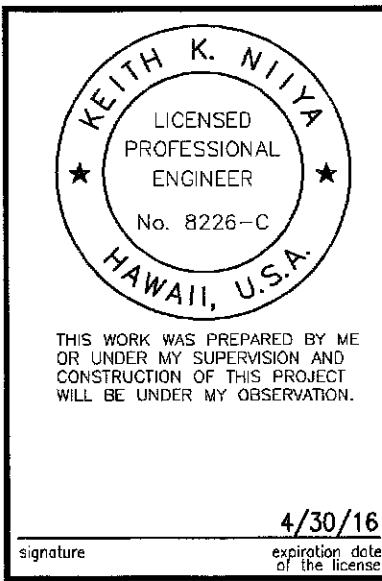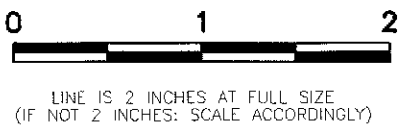

STATE OF HAWAII
DEPARTMENT OF TRANSPORTATION
HIGHWAYS DIVISION

SPOT SPEED LOCATIONS
Freeway Management System
Phase 1C, Part 3a
Data Expansion
Various Locations
Federal Aid Project No. STP-0300(145)
Scale: As Noted Date: May 2016