
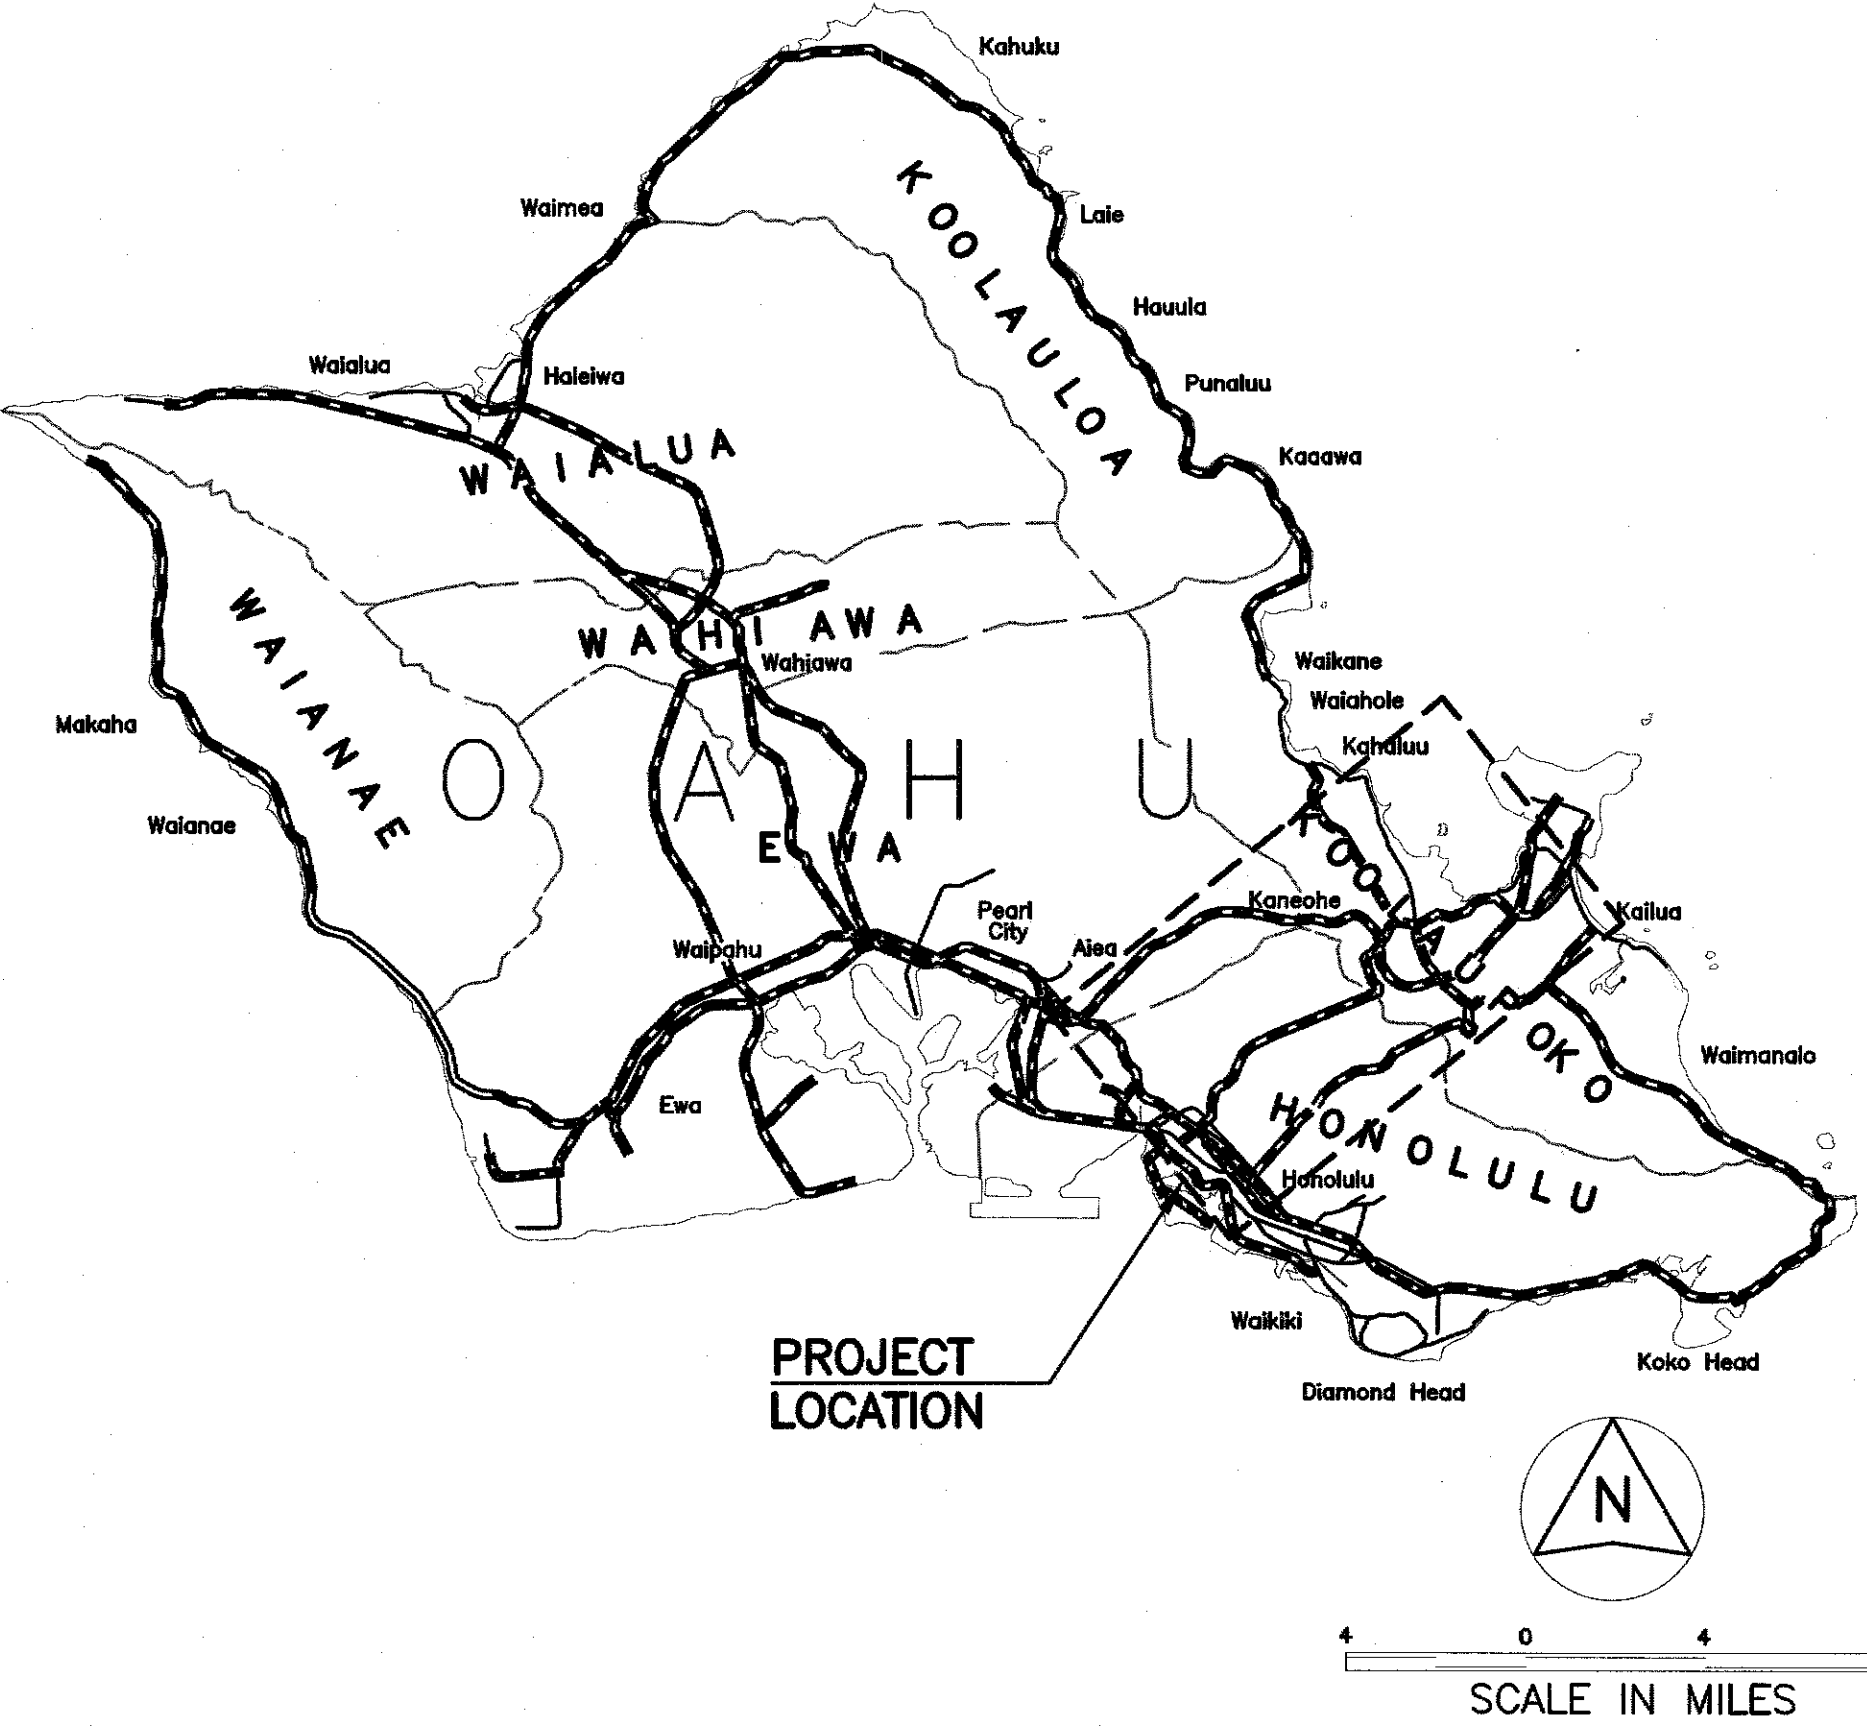
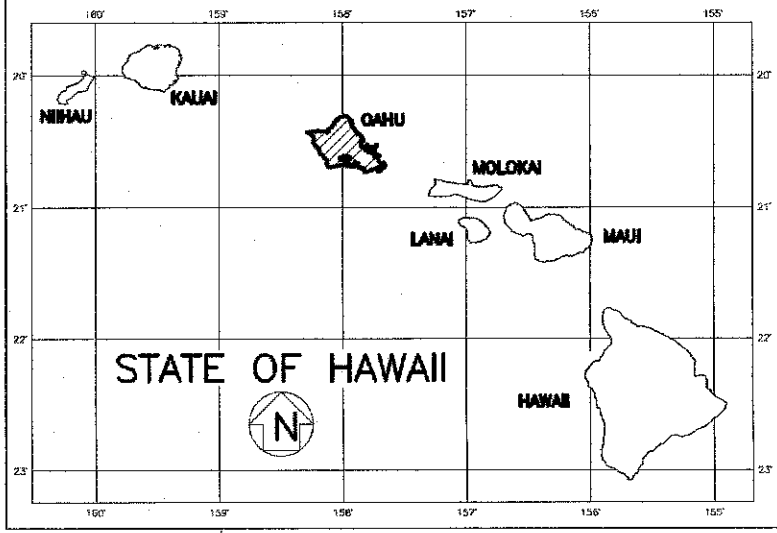


INDEX TO DRAWINGS	
SHEET No.	DESCRIPTION
1	TITLE SHEET
2-3	STATE STANDARD PLAN SUMMARY
4-10	CONSTRUCTION NOTES & ABBREVIATIONS
11-12	ELECTRICAL DISTRIBUTION PLANS
13-14	CCTV CAMERA REPLACEMENT LOCATIONS
15	SPOT SPEED DEVICE LOCATIONS
16	MAC ADDRESS READER LOCATIONS
17	CCTV WIRELESS BRIDGE DETAILS
18	CCTV POLE DETAILS
19	SPOT SPEED SENSOR DETAILS
20	MAC ADDRESS READER DETAILS


STATE OF HAWAII
DEPARTMENT OF TRANSPORTATION
HIGHWAYS DIVISION
HONOLULU, HAWAII
"AS-BUILT"
PLANS FOR
FREEWAY MANAGEMENT SYSTEM
PHASE 1C, PART 3a
DATA EXPANSION
VARIOUS LOCATION
FEDERAL-AID PROJECT NO. STP-0300(145)
DISTRICTS OF HONOLULU AND KOOLAUPOKO
ISLAND OF OAHU

FED. ROAD DIST. NO.	STATE	FEDERAL AID PROJ. NO.	FISCAL YEAR	SHEET NO.	TOTAL SHEETS
HAWAII	HAW.	STP-0300(145)	2016	1	20

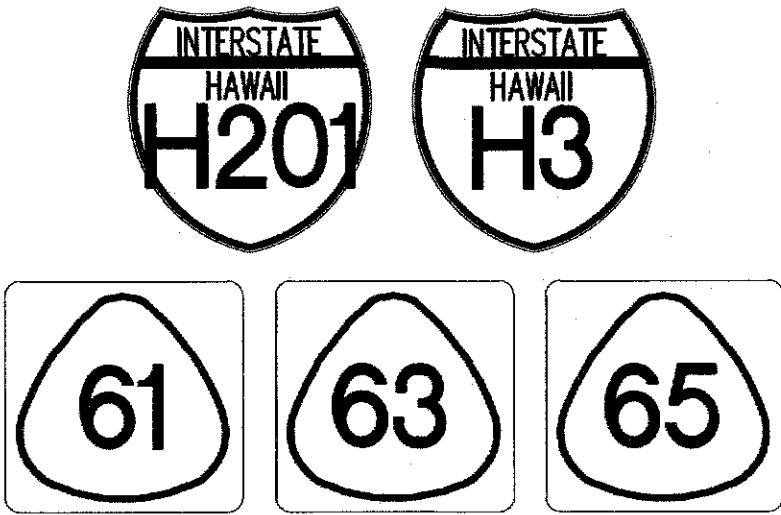

CHANGES MADE DURING CONSTRUCTION HAVE BEEN INCORPORATED ON THESE PLANS EXCEPT CHANGES IN THE ORIGINAL THEORETICAL QUANTITIES. FOR ACTUAL QUANTITIES, REFER TO PROJECT LEADER AND/OR COMPUTATION BOOK.
Kelvin Akasawa 6-20-19
FOR RESIDENT ENGINEER DATE

H-201	MILE POST	0	TO MILE POST	1.6
H3	MILE POST	0	TO MILE POST	14.68
ROUTE 61	MILE POST	0	TO MILE POST	8.5
ROUTE 63	MILE POST	1.15	TO MILE POST	8.28
ROUTE 65	MILE POST	0	TO MILE POST	0.2

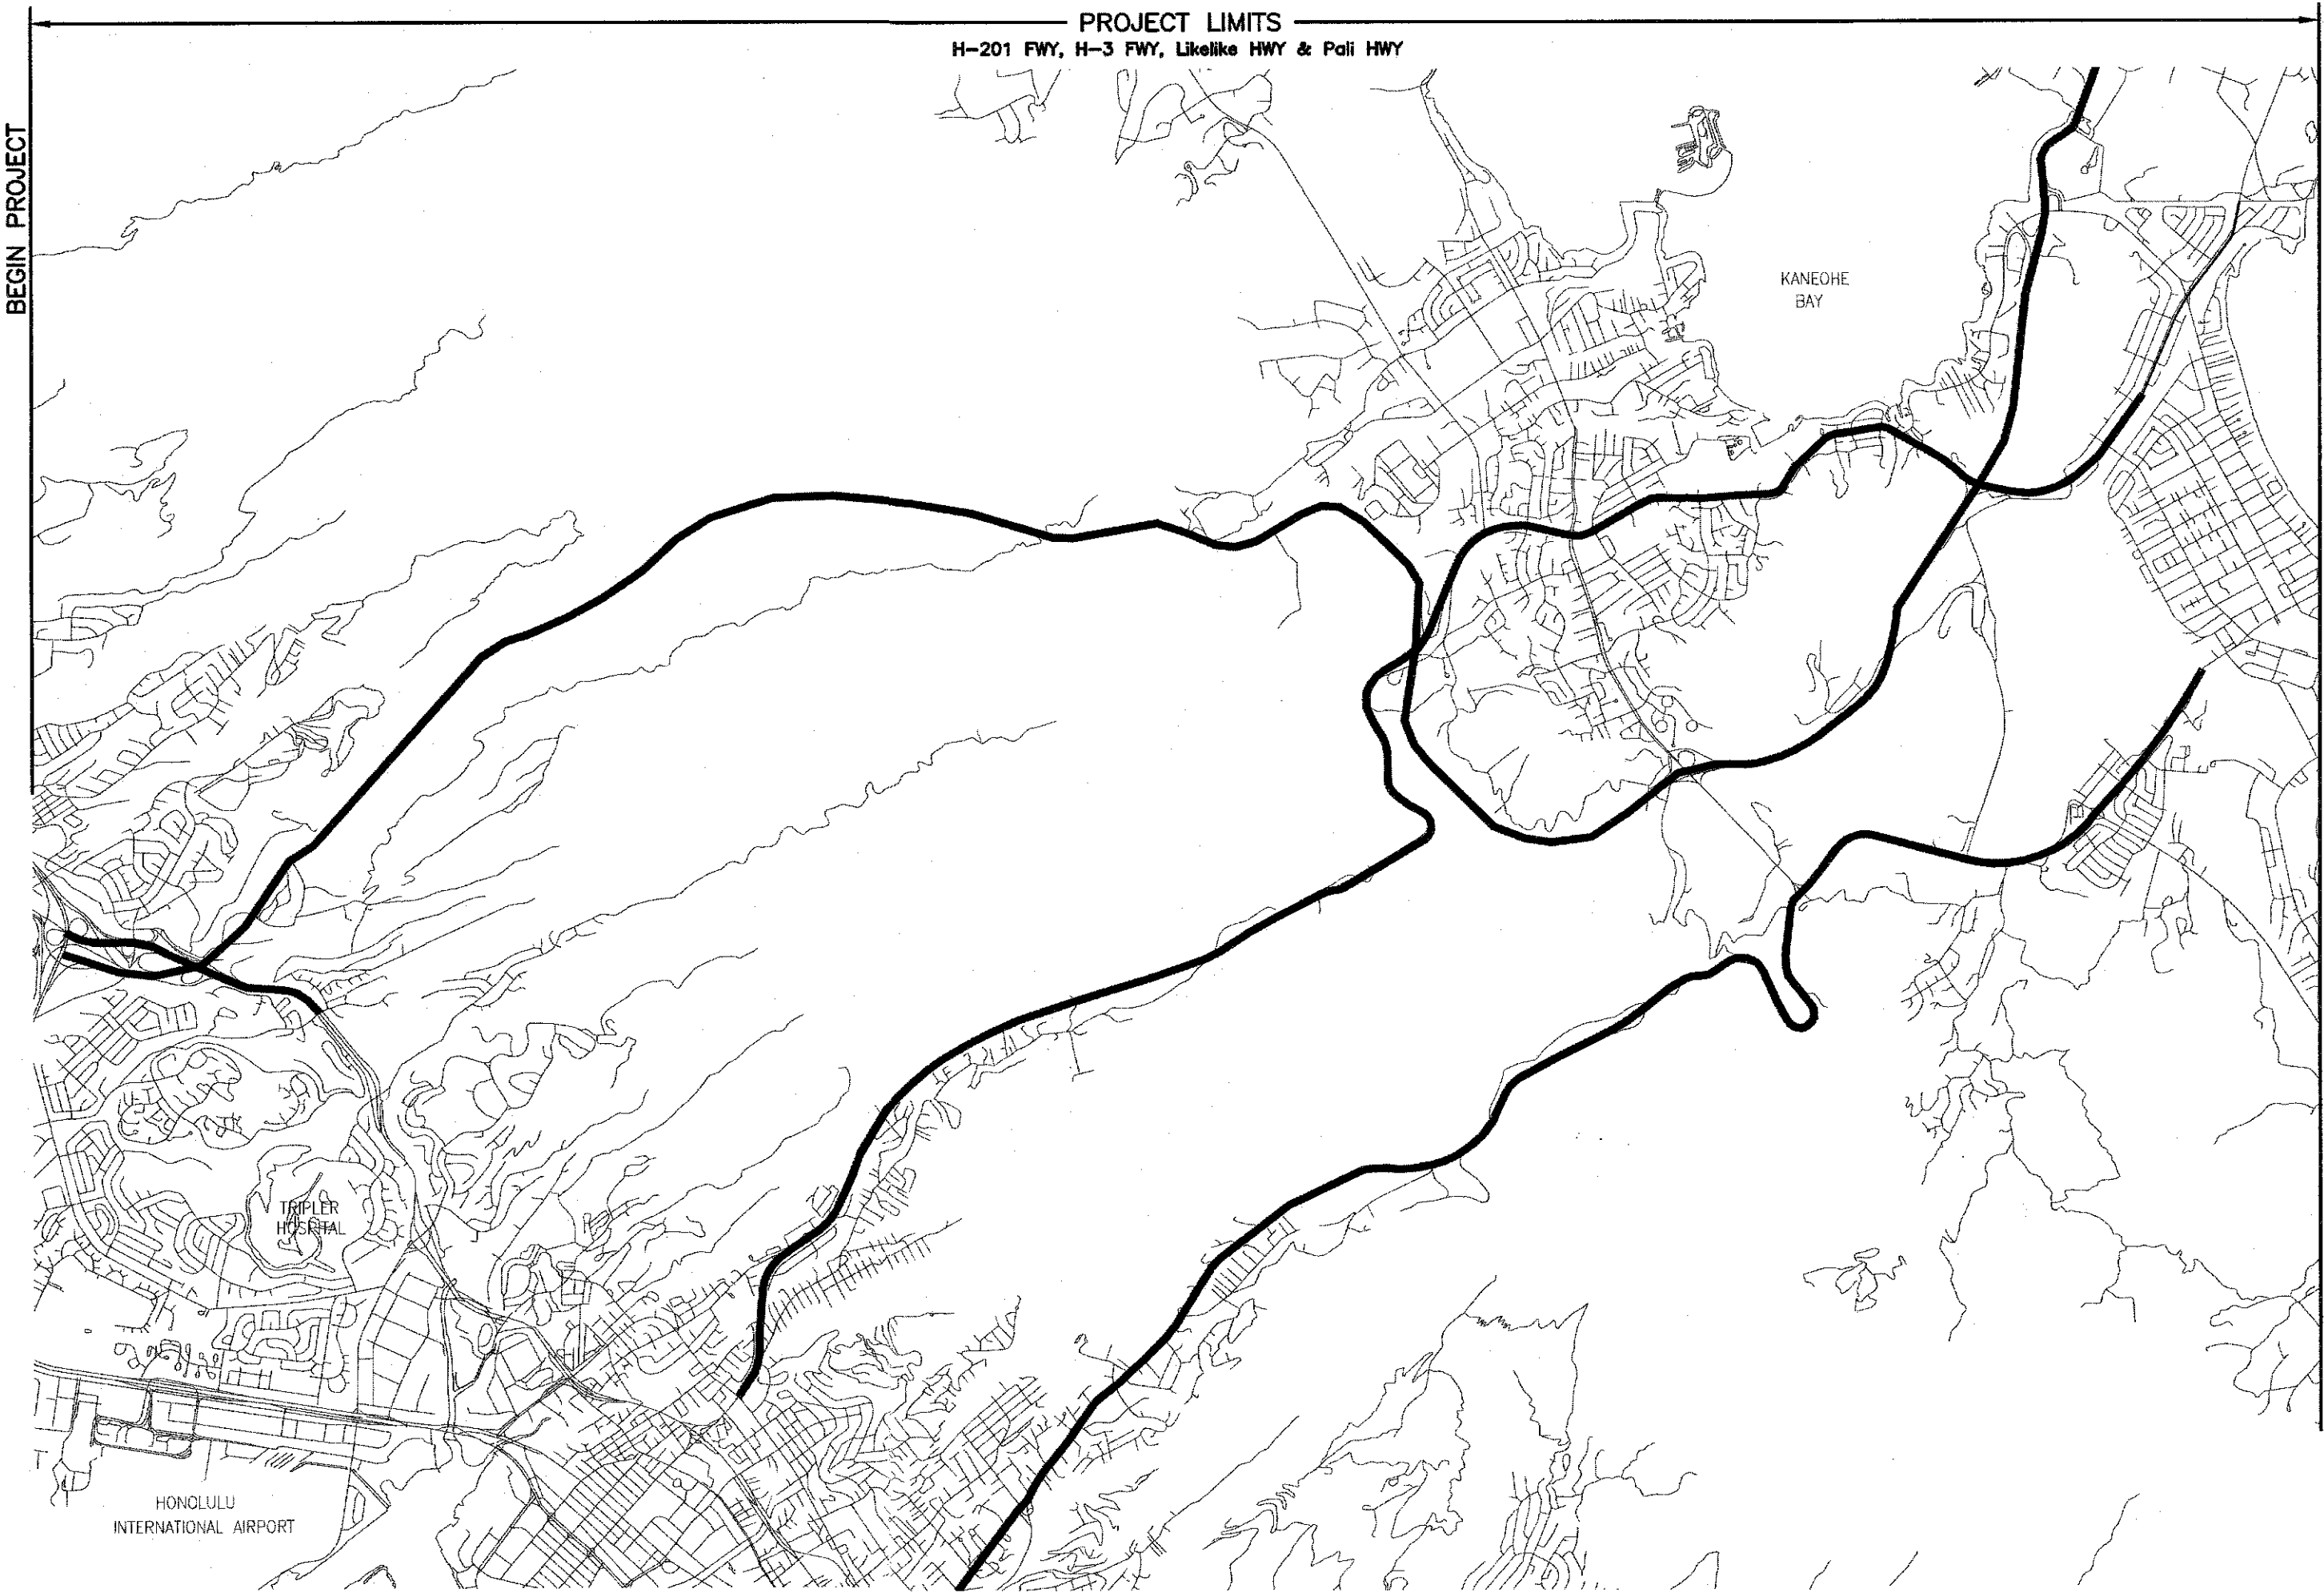

LAYOUT PLAN
NOT TO SCALE

DEPARTMENT OF TRANSPORTATION STATE OF HAWAII	
APPROVED: <i>[Signature]</i>	DATE: 7/22/16
BY DIR. OF TRANSPORTATION	DATE

ICXTG DESIGNED BY _____
HWY-TO P. S. & E. BY _____
692-7674 PHONE _____
MAY 10, 2016 DATE _____