


APPENDIX C: SELECTED PROJECT SITE PLANS

This Page Left Blank Intentionally

DIST. NO.	STATE	PROJ. NO.	FISCAL YEAR	SHEET NO.	TOTAL SHEETS
OAHU	HAW.	STP-0300(152)	2020		

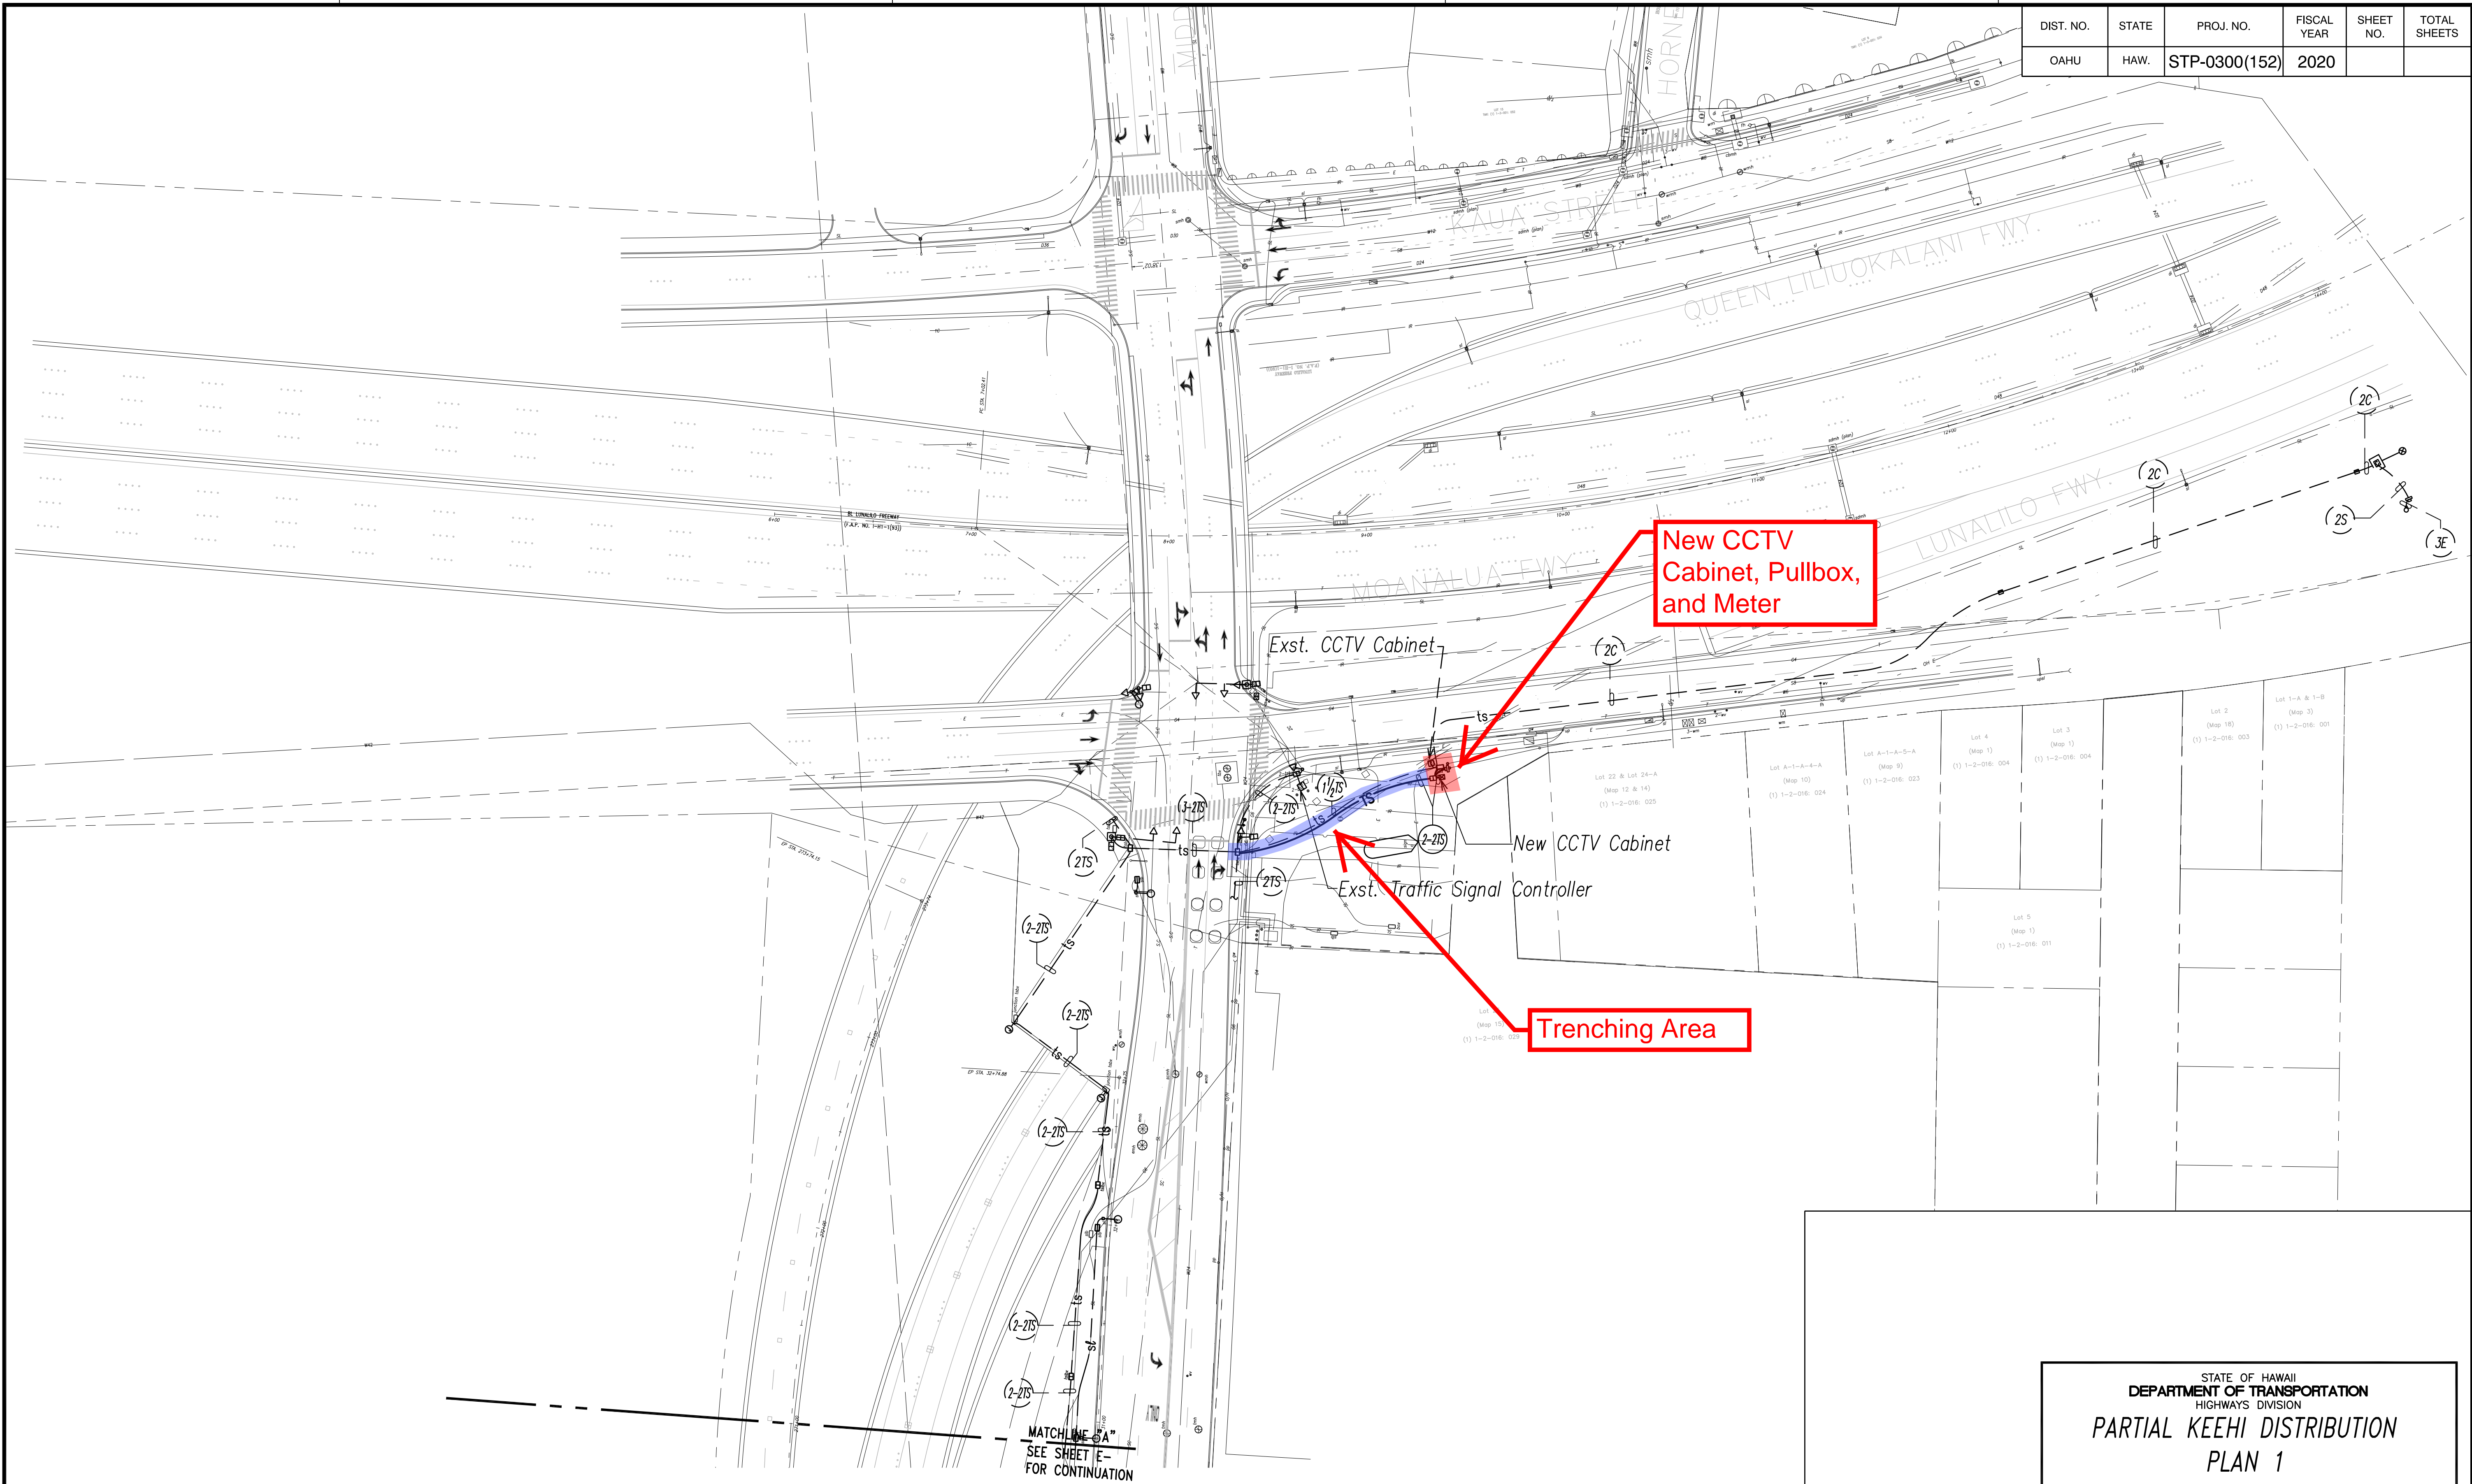


ORIGINAL PLAN	DATE
DRAWN BY	
DESIGNED BY	
NOTED BY	
CHECKED BY	



PARTIAL KEEHI ELECTRICAL DISTRIBUTION PLAN 1

SCALE: 1"=40'

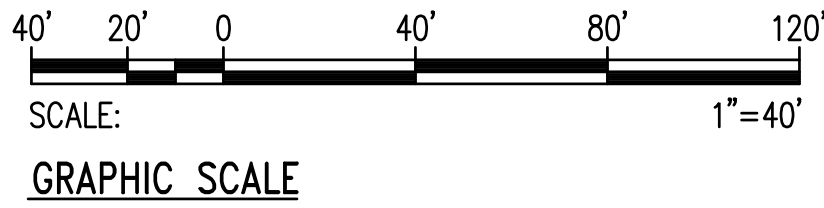

THIS WORK WAS PREPARED BY ME OR UNDER MY SUPERVISION AND CONSTRUCTION OF THIS PROJECT WILL BE UNDER MY OBSERVATION AS DEFINED IN HAWAII TITLE 16, CHAPTER 115, RULES OF THE BOARD OF PROFESSIONAL ENGINEERS, ARCHITECTS AND SURVEYORS, STATE OF HAWAII

APRIL 30, 2020
LIC. EXP. DATE

STATE OF HAWAII
DEPARTMENT OF TRANSPORTATION
HIGHWAYS DIVISION


PARTIAL KEEHI DISTRIBUTION
PLAN 1

Freeway Management System
Phase 3, Unit 1
Federal Aid Project No.
STP-0300(152)

Scale: As Noted Date:

SHEET NO. E- OF SHEETS

DIST. NO.	STATE	PROJ. NO.	FISCAL YEAR	SHEET NO.	TOTAL SHEETS
OAHU	HAW.	STP-0300(152)	2020		

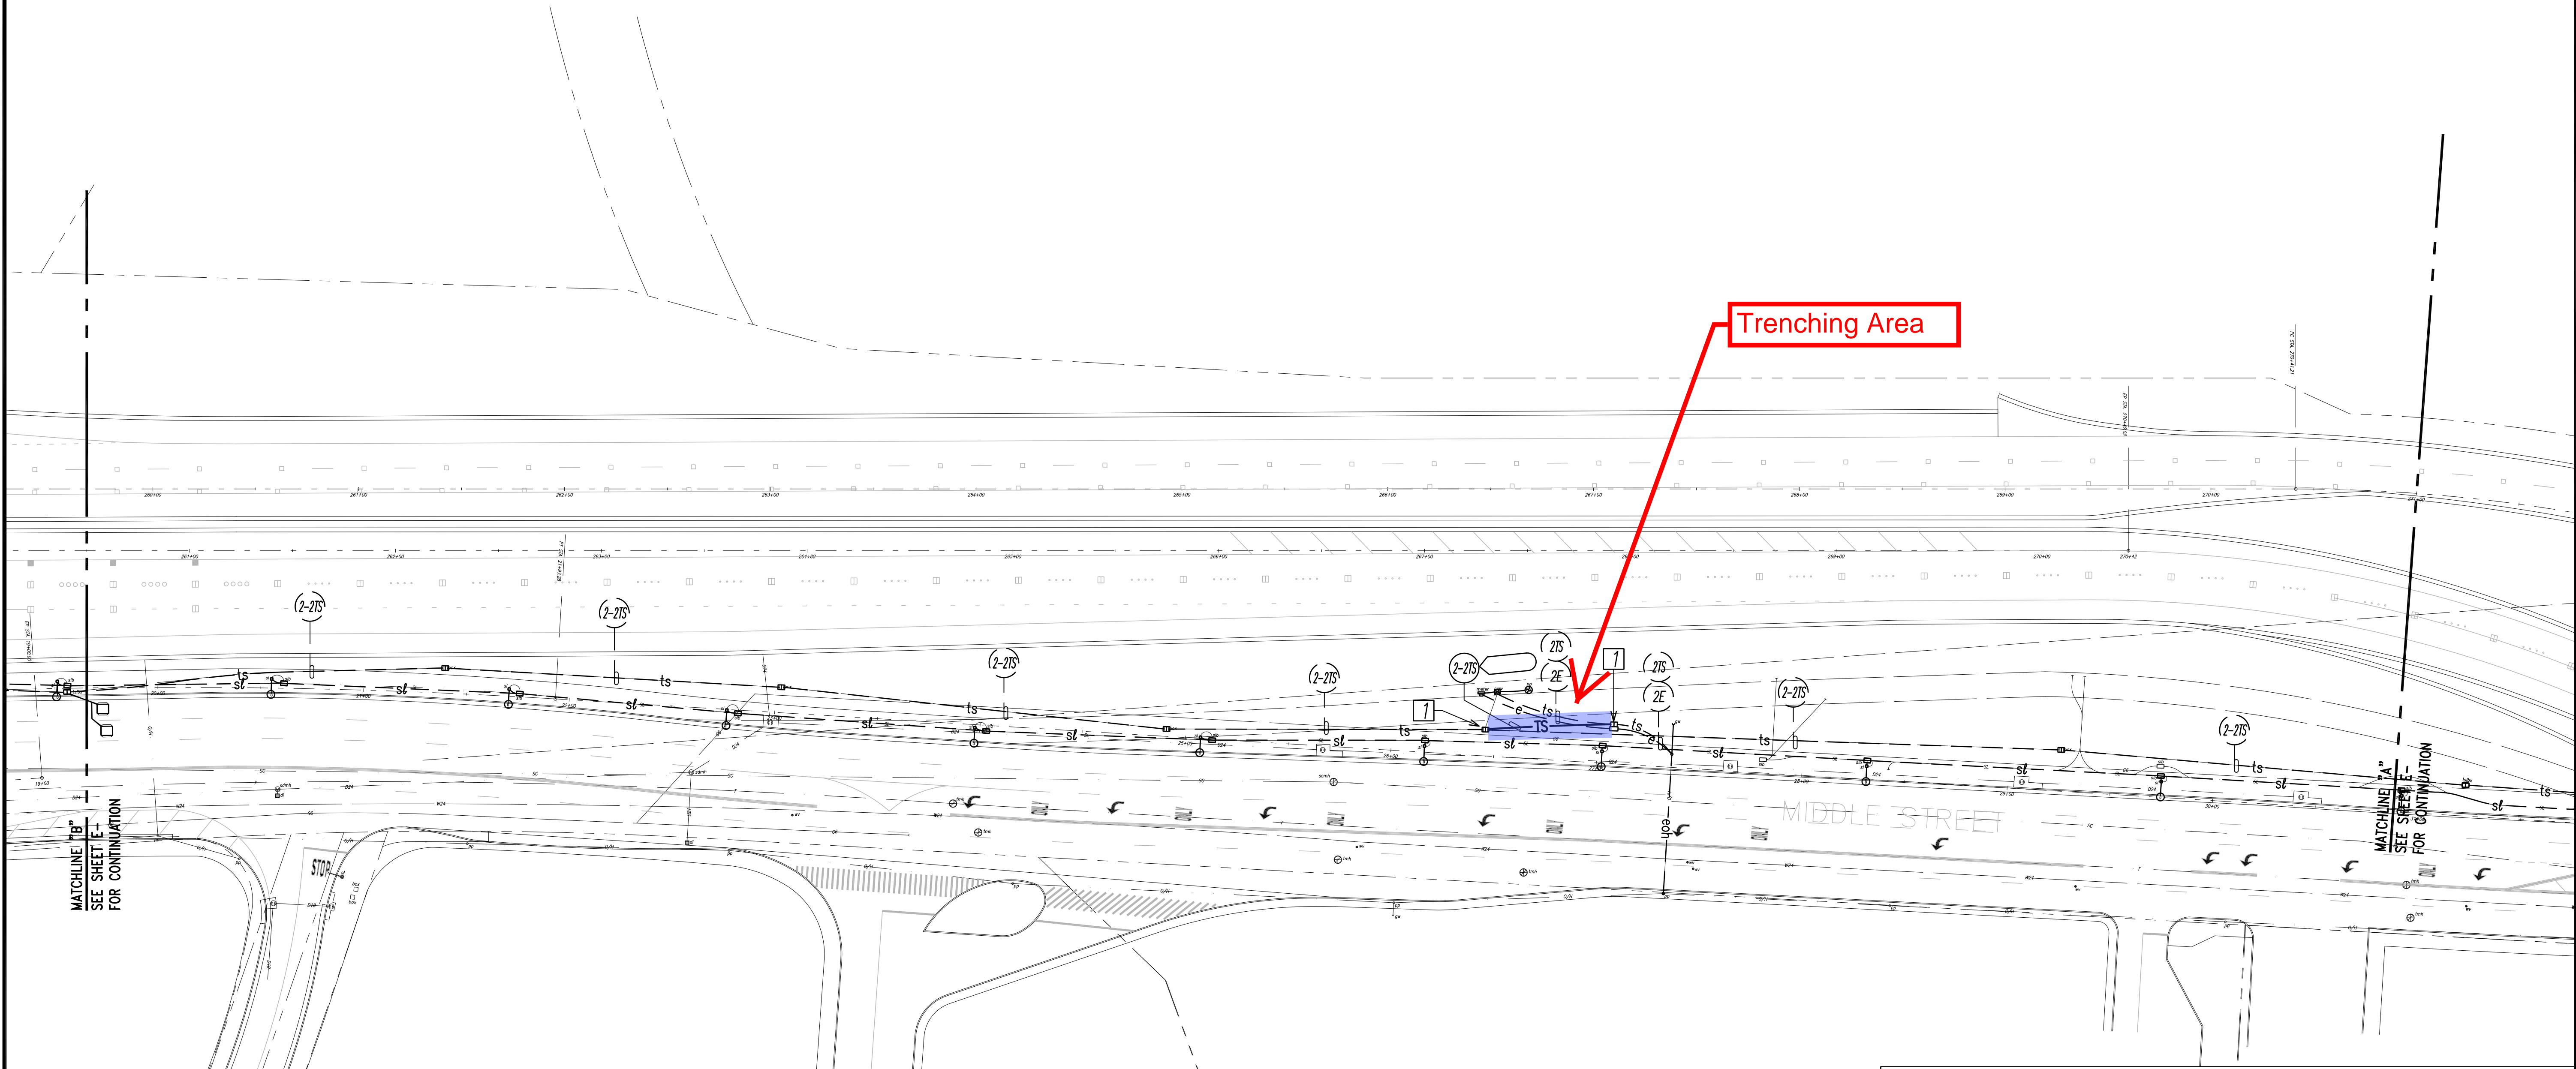

MATCHLINE "B"
SEE SHEET "E"
FOR CONTINUATION

MATCHLINE "A"
SEE SHEET "E"
FOR CONTINUATION


NOTE(S):

- 1 Penetrate Existing Pullbox to Accommodate Conduit Installation.



PARTIAL KEEHI ELECTRICAL DISTRIBUTION PLAN 2

SCALE: 1"=40'

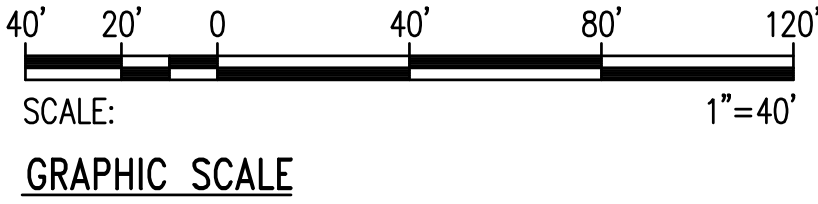

THIS WORK WAS PREPARED BY ME OR UNDER MY SUPERVISION AND CONSTRUCTION OF THIS PROJECT WILL BE UNDER MY OBSERVATION AS DEFINED IN HAR TITLE 16, CHAPTER 115, RULES OF THE BOARD OF PROFESSIONAL ENGINEERS, ARCHITECTS AND SURVEYORS, STATE OF HAWAII

APRIL 30, 2020
LIC. EXP. DATE

STATE OF HAWAII
DEPARTMENT OF TRANSPORTATION
HIGHWAYS DIVISION
**PARTIAL KEEHI DISTRIBUTION
PLAN 2**
*Freeway Management System
Phase 3, Unit 1
Federal Aid Project No.
STP-0300(152)*

Scale: As Noted Date:

SHEET NO. **E-** OF SHEETS

