


CAD User: ASPASIONJR File Last Updated: February 09, 2021 12:45:12pm Plot Date: February 09, 2021 - 3:16:42pm
File: T:\Drafting\Working\6891-30(A)_Freeway_Management_System_-_Phase_3\6891-30ASitePlans.dwg(2.1 SP4
Plotter: DWG To PDF-Geo.pc3 Plotstyle: GEO-No Dithering Blue-Boiling.ctb



LEGEND:

 APPROXIMATE BORING LOCATION

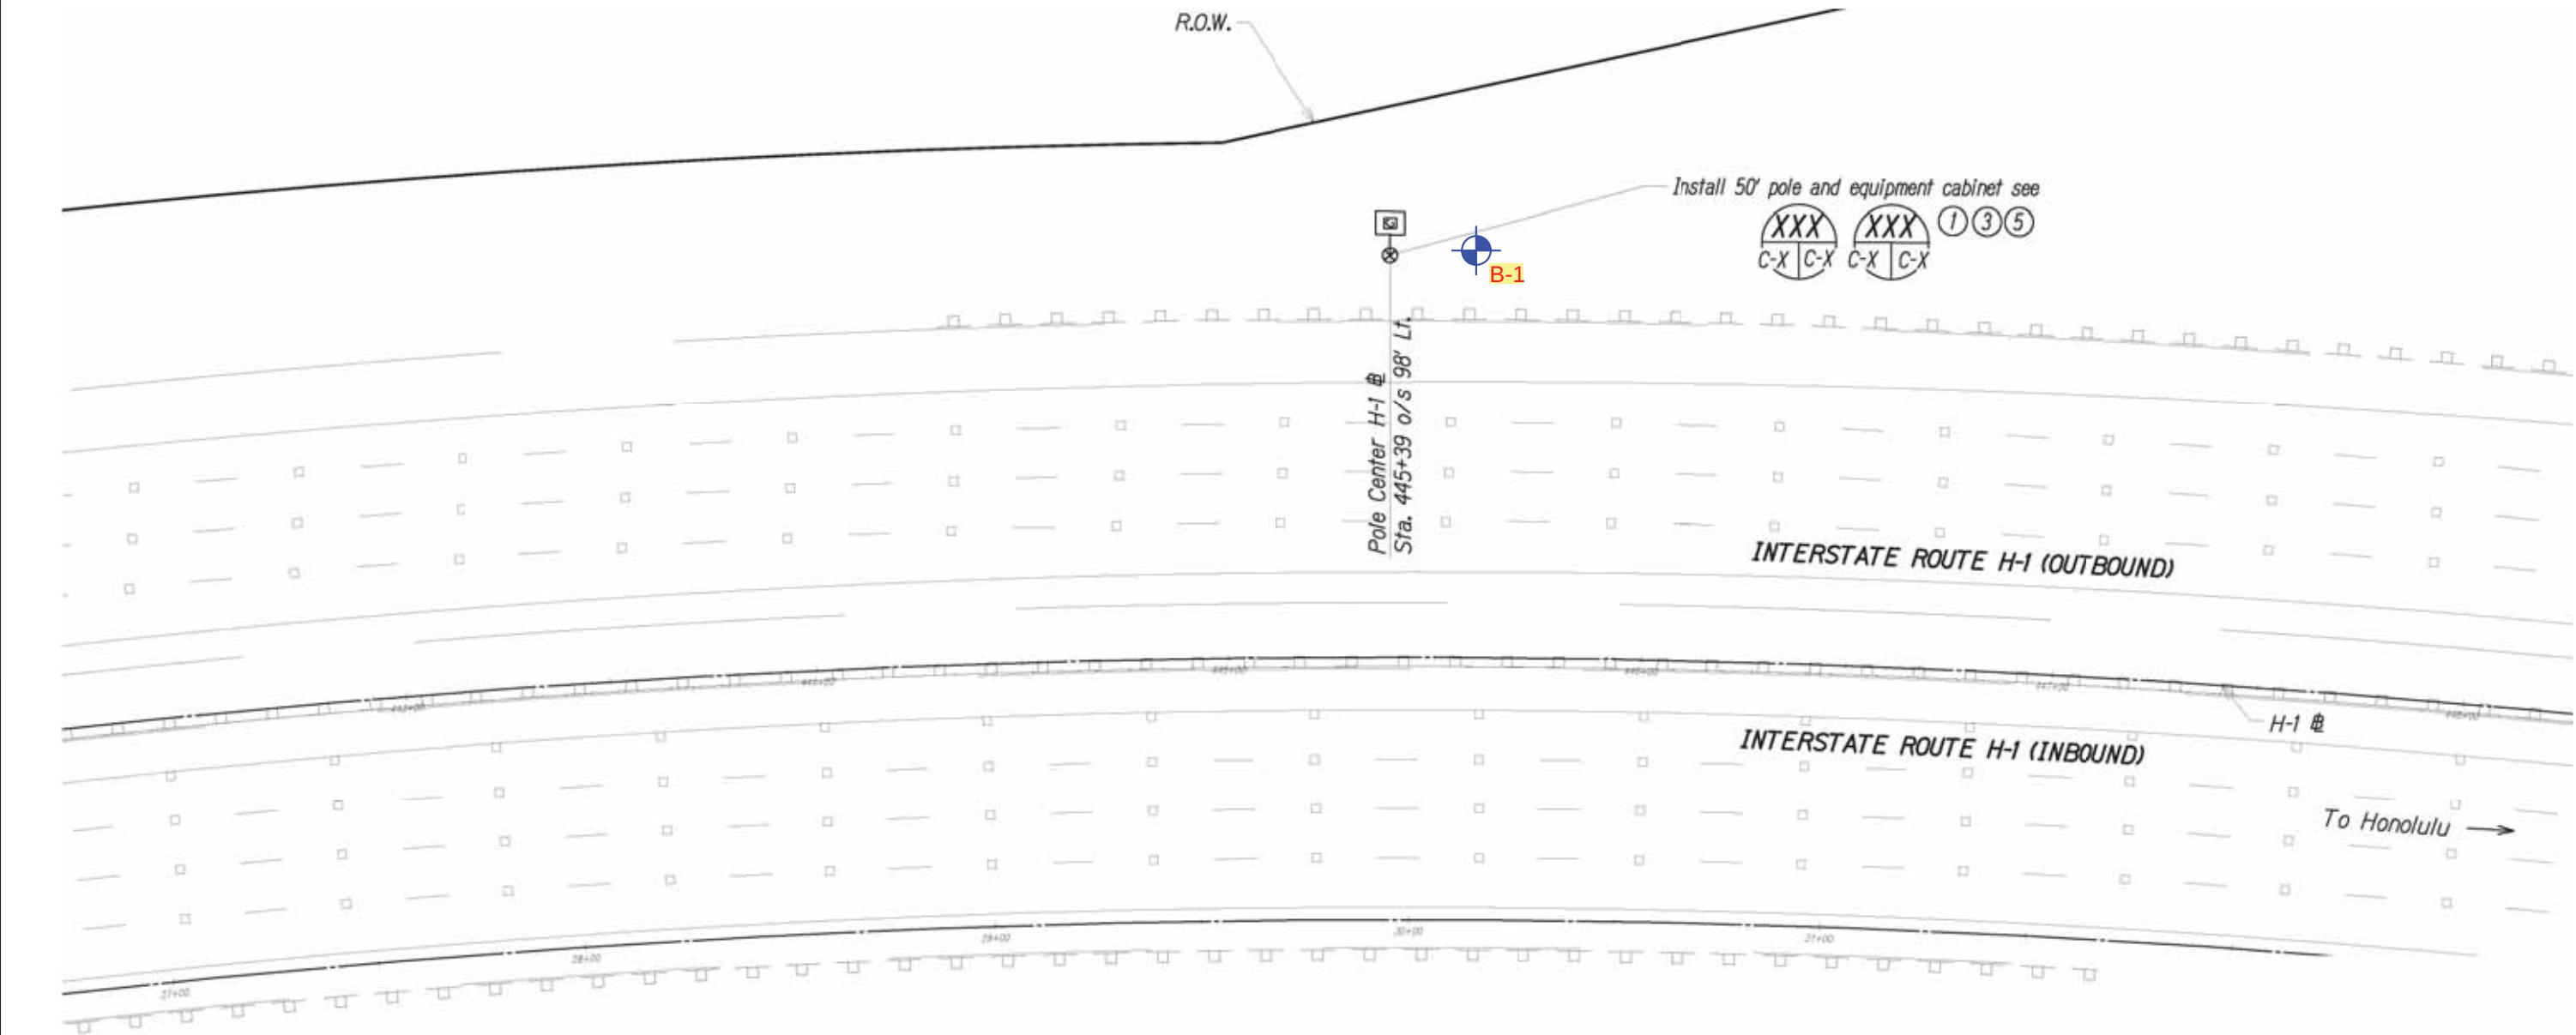


SITE PLAN
 FREEWAY MANAGEMENT SYSTEM
 PHASE 3, UNITS 1 AND 2, IM-0300(152)
 INTERSTATE ROUTES H-1 AND H-2 FREEWAYS
 DISTRICTS OF HONOLULU AND EWA, OAHU, HAWAII

GEOLABS, INC.		
Geotechnical Engineering		
DATE SEPTEMBER 2020	DRAWN BY ASP	PLATE 2.1
SCALE 1" = 40'	W.O. 6891-30(A)	

REFERENCE: WAIKELE CCTV SITE PLAN TRANSMITTED BY AUSTIN, TSUTSUMI & ASSOCIATES, INC. ON MAY 29, 2020.

CAD User: ASPASIONJR File Last Updated: February 09, 2021 12:45:12pm Plot Date: February 09, 2021 - 3:17:39pm
File: T:\Drafting\Working\6891-30(A) Freeway Management System - Phase 3\6891-30A Site Plans.dwg 2.2 SP3
Plotter: DWG To PDF-GEO.pc3 Plotstyle: GEO-No Dithering Blue-Boring.ctb

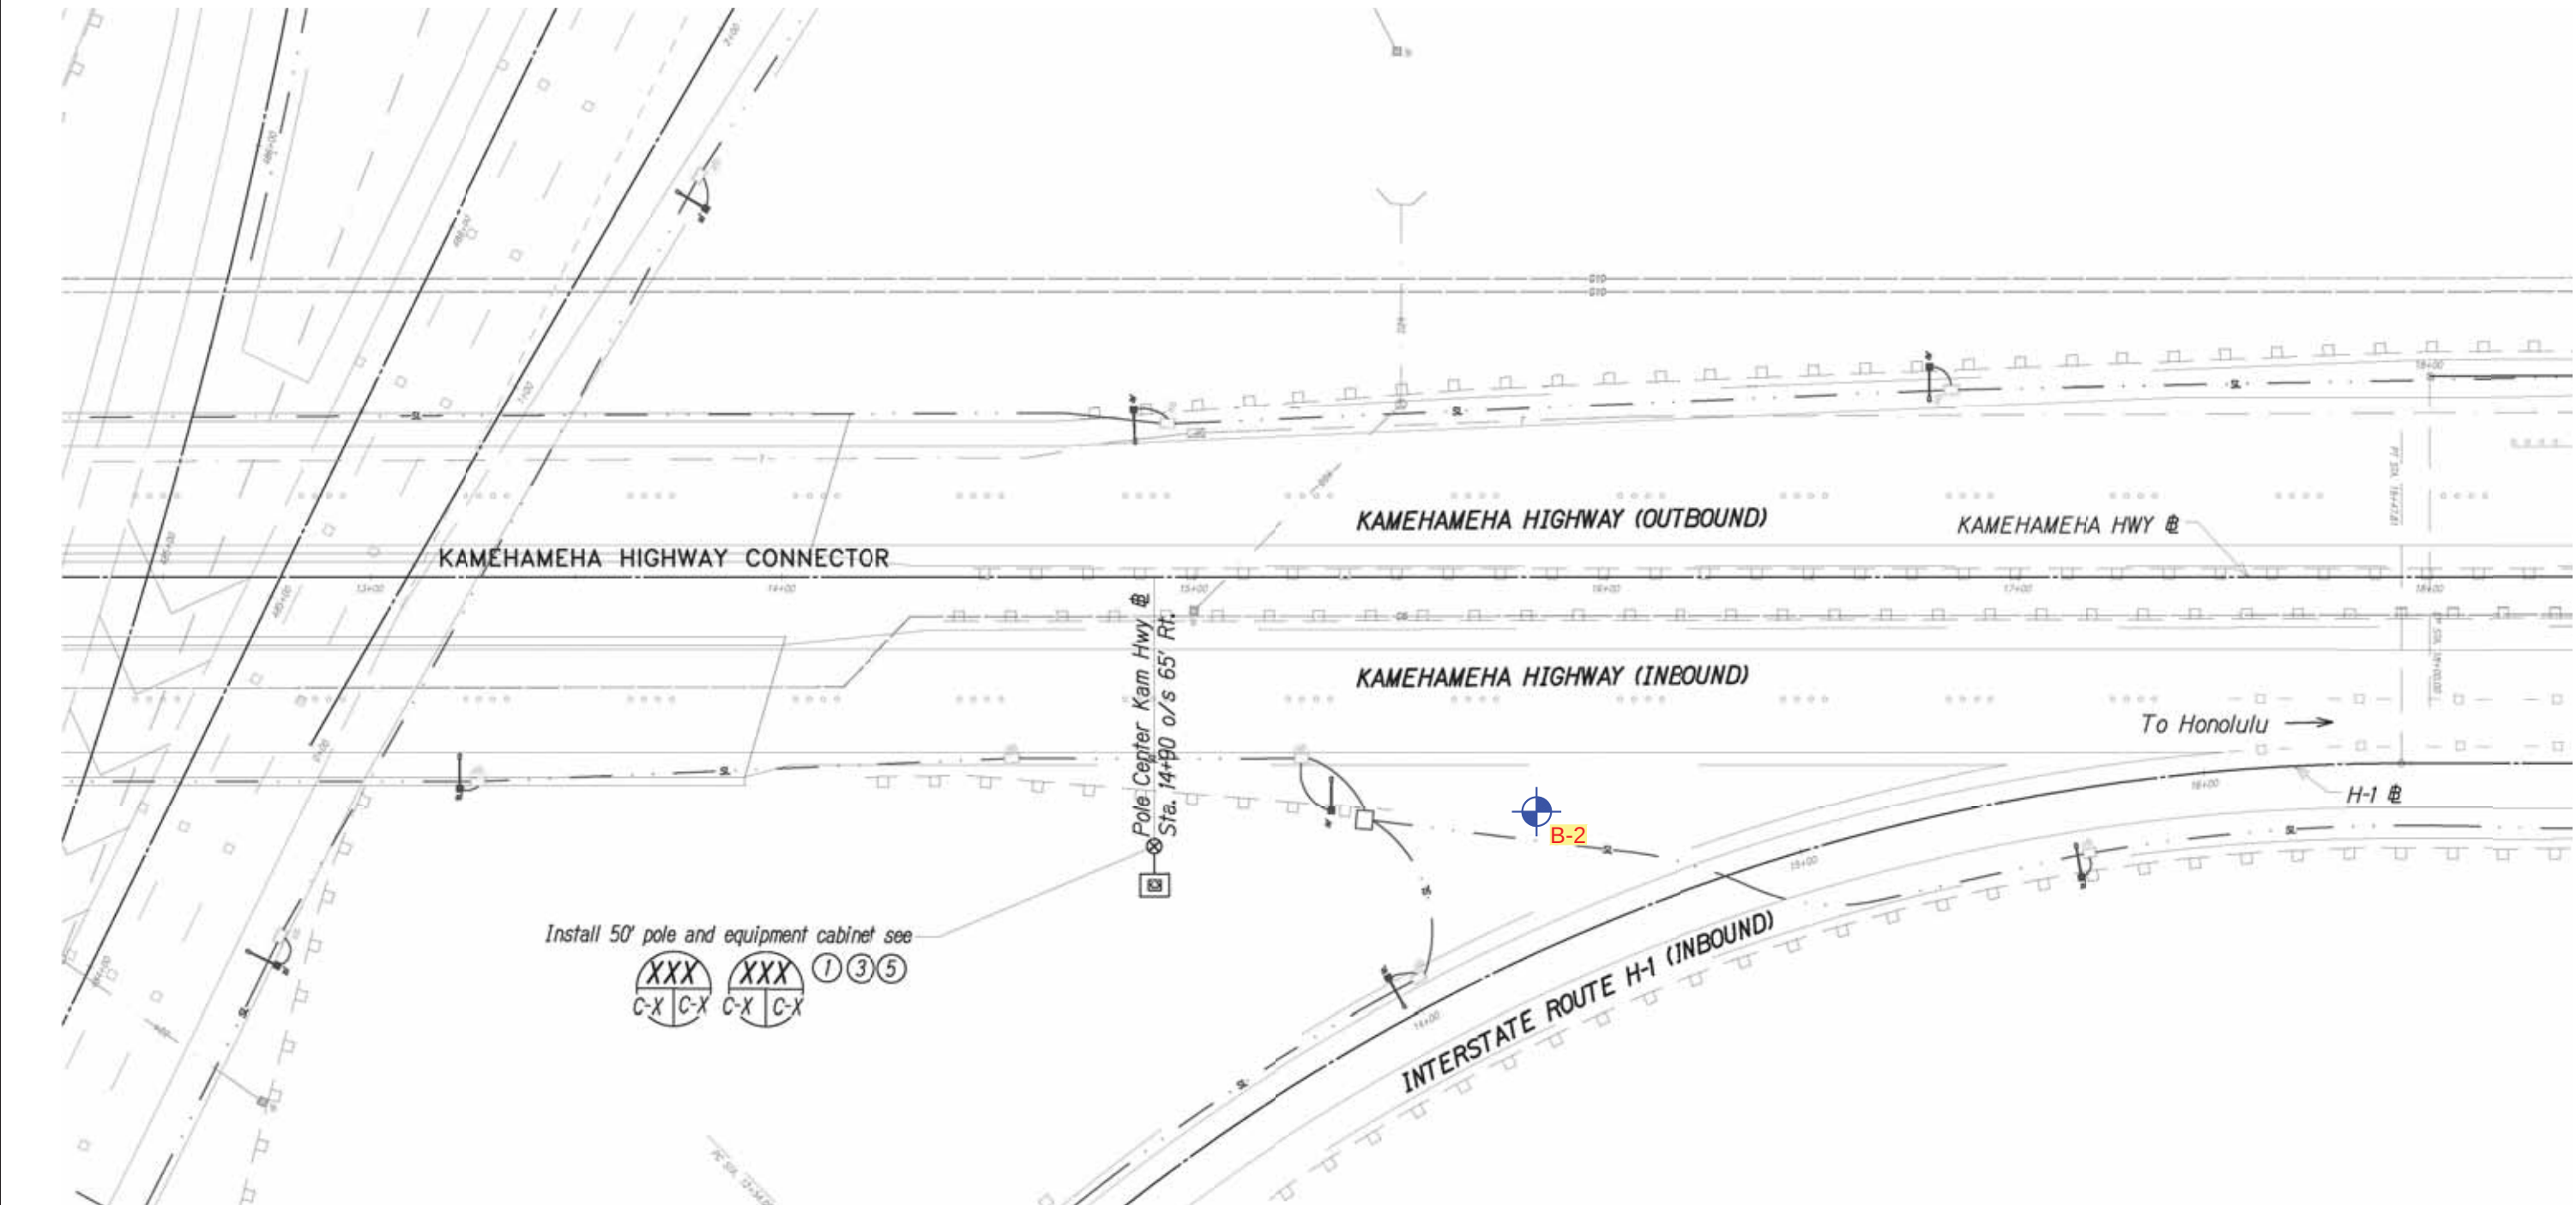

LEGEND:

APPROXIMATE BORING LOCATION

REFERENCE: WAIAWA IC CCTV SITE PLAN TRANSMITTED BY AUSTIN, TSUTSUMI & ASSOCIATES, INC. ON MAY 29, 2020.




SITE PLAN

FREEWAY MANAGEMENT SYSTEM
 PHASE 3, UNITS 1 AND 2, IM-0300(152)
 INTERSTATE ROUTES H-1 AND H-2 FREEWAYS
 DISTRICTS OF HONOLULU AND EWA, OAHU, HAWAII

GEOLABS, INC. Geotechnical Engineering		
DATE SEPTEMBER 2020	DRAWN BY ASP	PLATE 2.2
SCALE 1" = 40'	W.O. 6891-30(A)	


CAD User: ASPASIONJR File Last Updated: February 09, 2021 12:45:12pm Plot Date: February 09, 2021 - 3:18:42pm
File: T:\Drafting\Working\6891-30(A) Freeway Management System - Phase 3\6891-30ASitePlans.dwg(2.3 SP1
Plotter: DWG To PDF-GEOPLOT3 Plotstyle: GEO-No Differing Blue-Boring.ctb

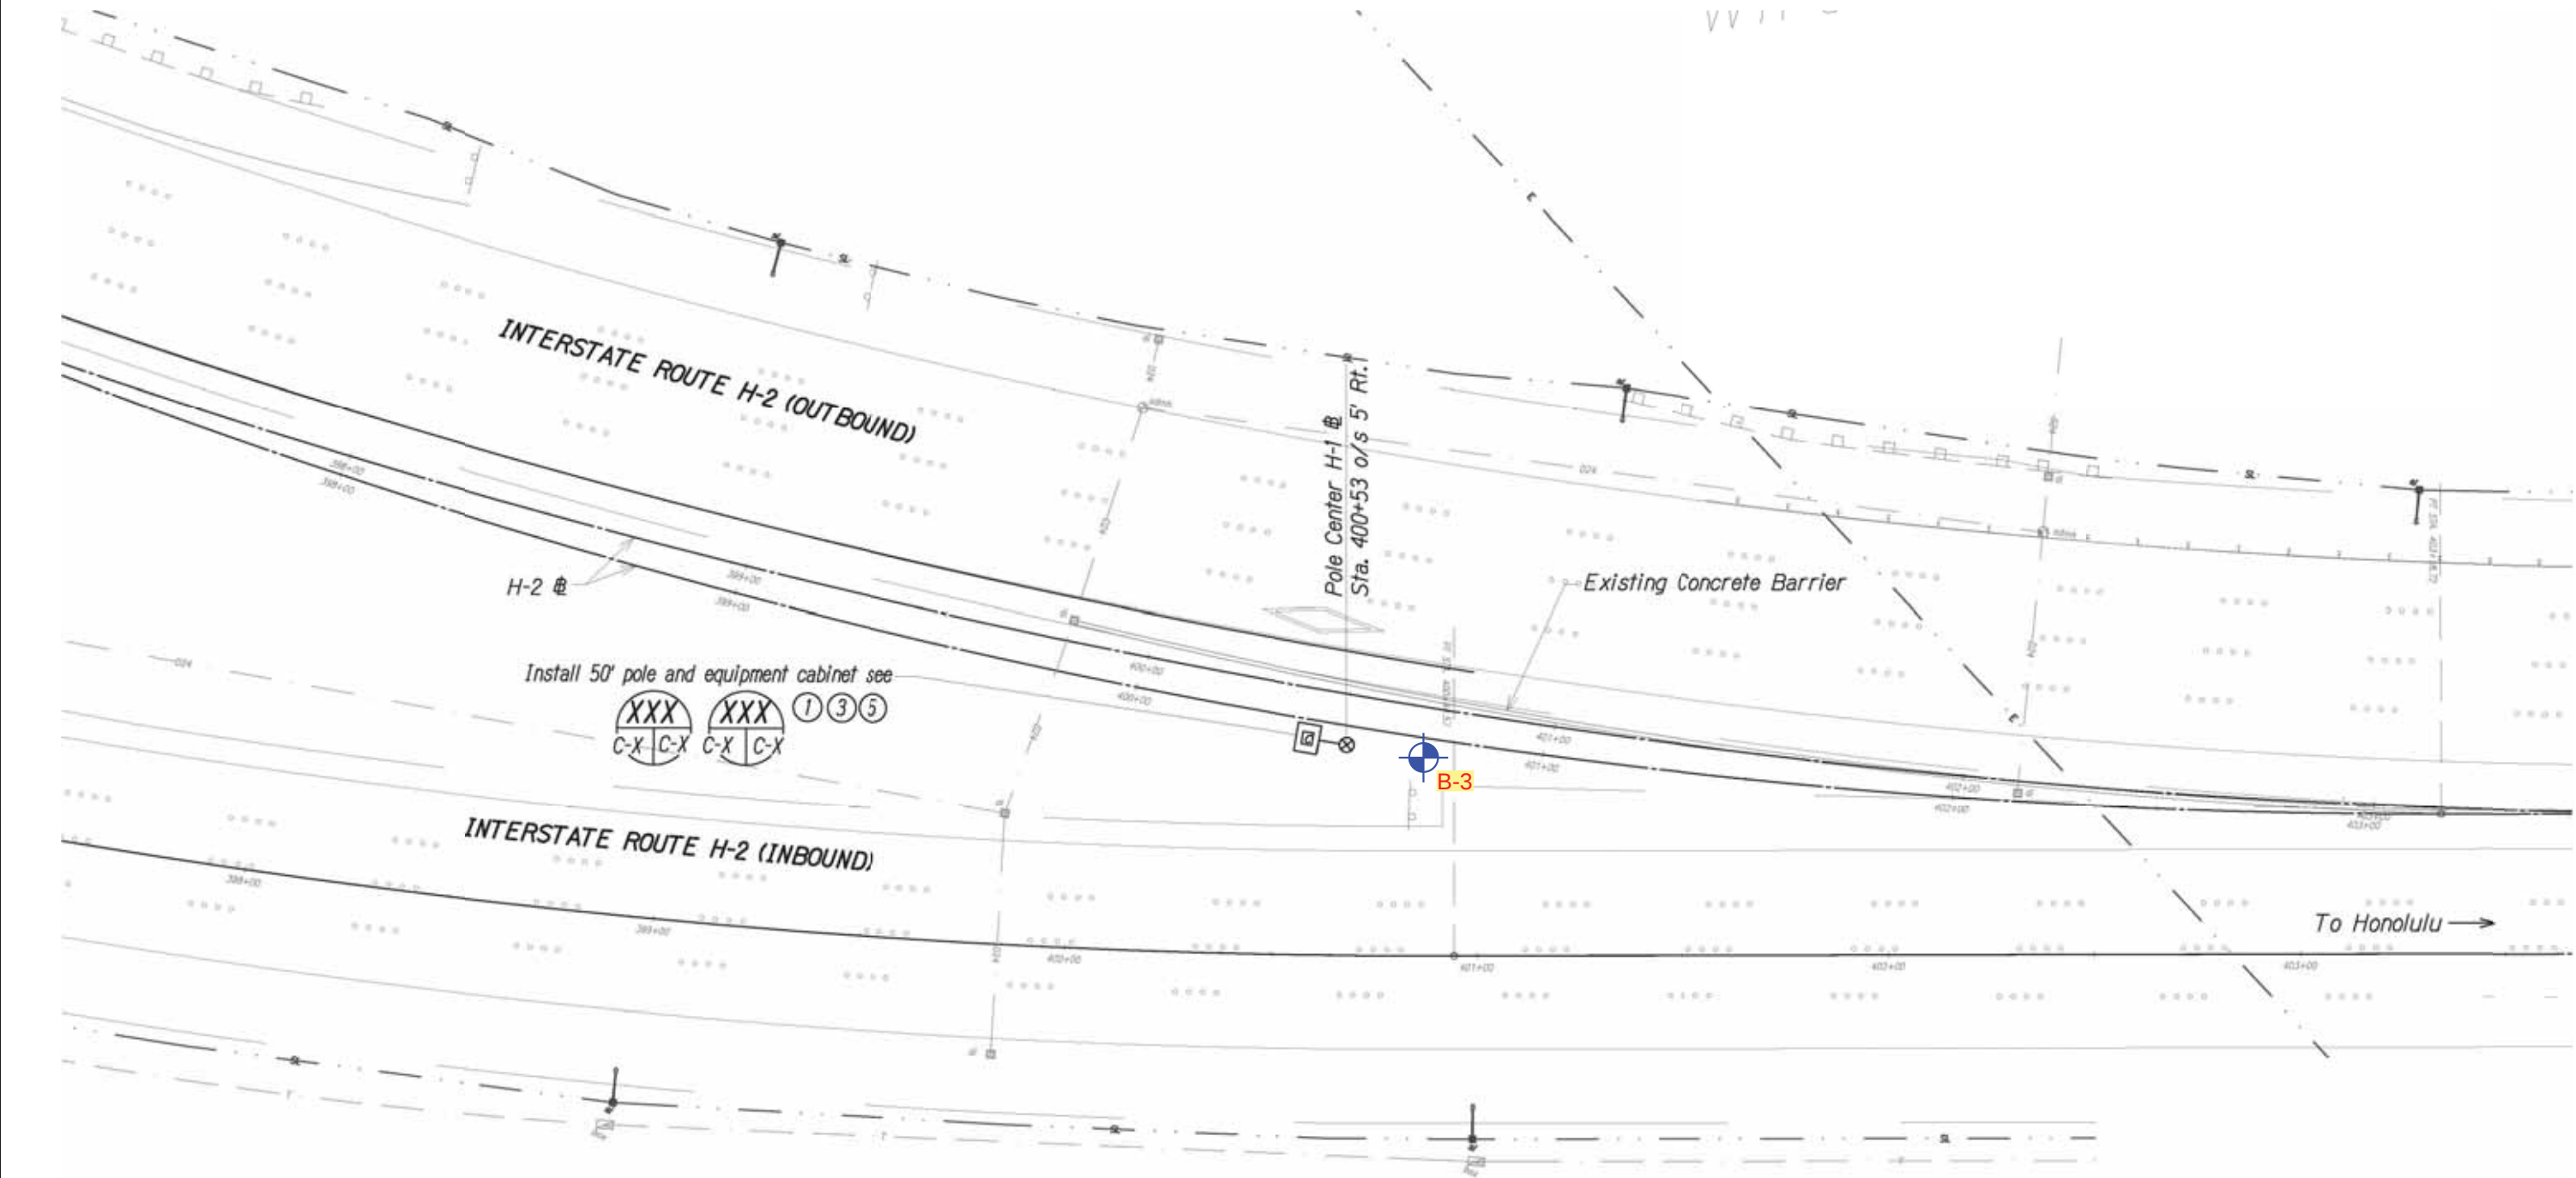

LEGEND:

 APPROXIMATE BORING LOCATION

REFERENCE: H-2 NORTH CCTV SITE PLAN TRANSMITTED BY AUSTIN, TSUTSUMI & ASSOCIATES, INC. ON MAY 29, 2020.

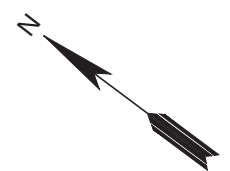


SITE PLAN

FREEWAY MANAGEMENT SYSTEM
PHASE 3, UNITS 1 AND 2, IM-0300(152)
INTERSTATE ROUTES H-1 AND H-2 FREEWAYS
DISTRICTS OF HONOLULU AND EWA, OAHU, HAWAII



GEOLABS, INC.		
Geotechnical Engineering		
DATE SEPTEMBER 2020	DRAWN BY ASP	PLATE 2.3
SCALE 1" = 40'	W.O. 6891-30(A)	

CAD User: ASPASIONJR File Last Updated: February 09, 2021 12:45:12pm Plot Date: February 09, 2021 - 3:19:30pm
File: T:\Drafting\Working\6891-30(A) Freeway Management System - Phase 3\6891-30ASitePlans.dwg\2.4 SP2
Plotter: DWG To PDF-Geo.pc3 Plotstyle: GEO-No Dithering Blue-Boiling.ctb

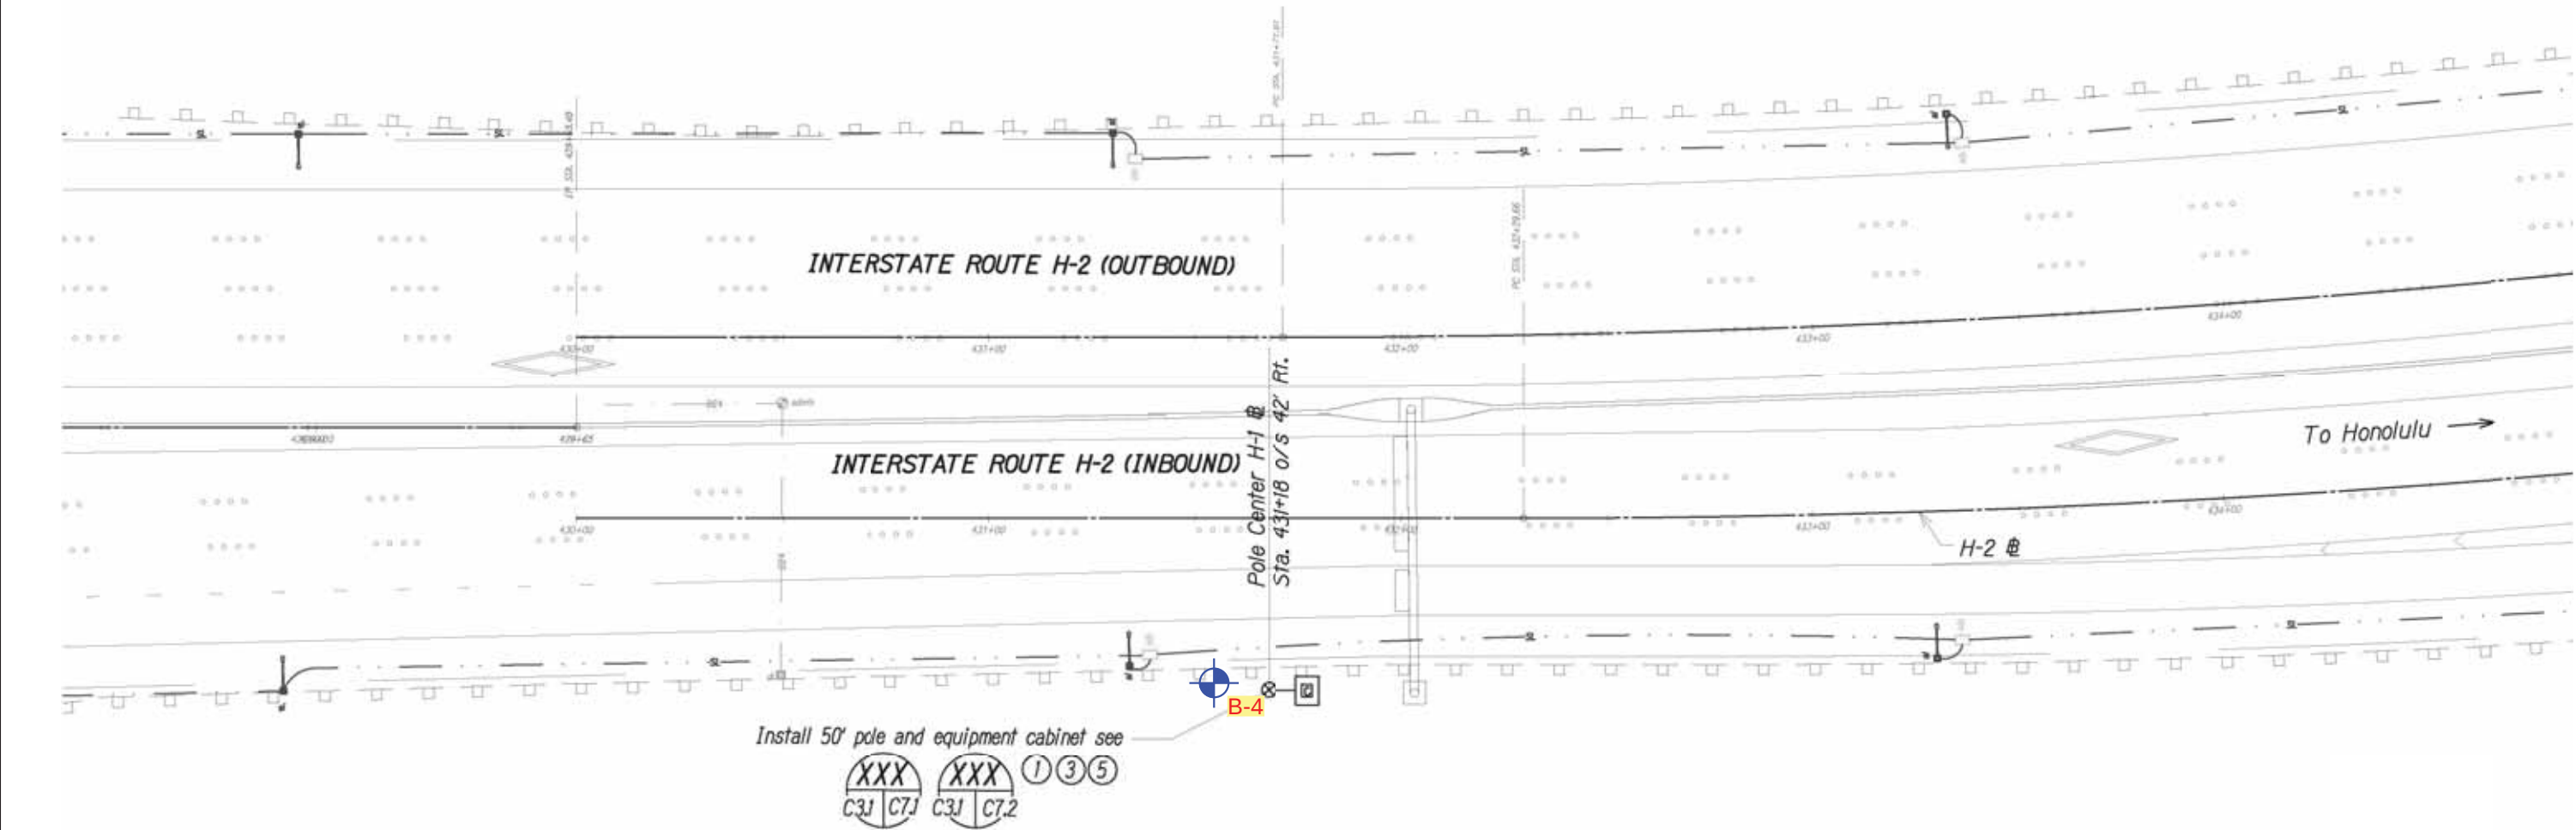

LEGEND:

APPROXIMATE BORING LOCATION

REFERENCE: H-2 SOUTH CCTV SITE PLAN TRANSMITTED BY AUSTIN, TSUTSUMI & ASSOCIATES, INC. ON MAY 29, 2020.



SITE PLAN
FREEWAY MANAGEMENT SYSTEM
PHASE 3, UNITS 1 AND 2, IM-0300(152)
INTERSTATE ROUTES H-1 AND H-2 FREEWAYS
DISTRICTS OF HONOLULU AND EWA, OAHU, HAWAII

GEOLABS, INC.		
Geotechnical Engineering		
DATE SEPTEMBER 2020	DRAWN BY ASP	PLATE 2.4
SCALE 1" = 40'	W.O. 6891-30(A)	

CAD User: ASPASIONJR File Last Updated: February 09, 2021 12:45:12pm Plot Date: February 09, 2021 - 3:20:39pm
File: T:\Drafting\Working\6891-30(A)_Freeway_Management_System_-_Phase_3\6891-30ASitePlans.dwg 2.5 SPS
Plotter: DWG To PDF-GEO.pc3 Plotstyle: GEO-No Dithering Blue-Boiling.ctb

REFERENCE: FARRINGTON HWY CCTV SITE PLAN TRANSMITTED BY AUSTIN, TSUTSUMI & ASSOCIATES, INC. ON MAY 29, 2020.

LEGEND:




APPROXIMATE BORING LOCATION

Install 50' pole and equipment cabinet see



GRAPHIC SCALE

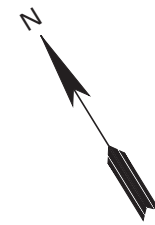

SITE PLAN

FREEWAY MANAGEMENT SYSTEM
PHASE 3, UNITS 1 AND 2, IM-0300(152)
INTERSTATE ROUTES H-1 AND H-2 FREEWAYS
DISTRICTS OF HONOLULU AND EWA, OAHU, HAWAII

GEOLABS, INC.		
Geotechnical Engineering		
DATE	DRAWN BY	PLATE
SEPTEMBER 2020	ASP	
SCALE	W.O.	2.5
1" = 40'	6891-30(A)	