

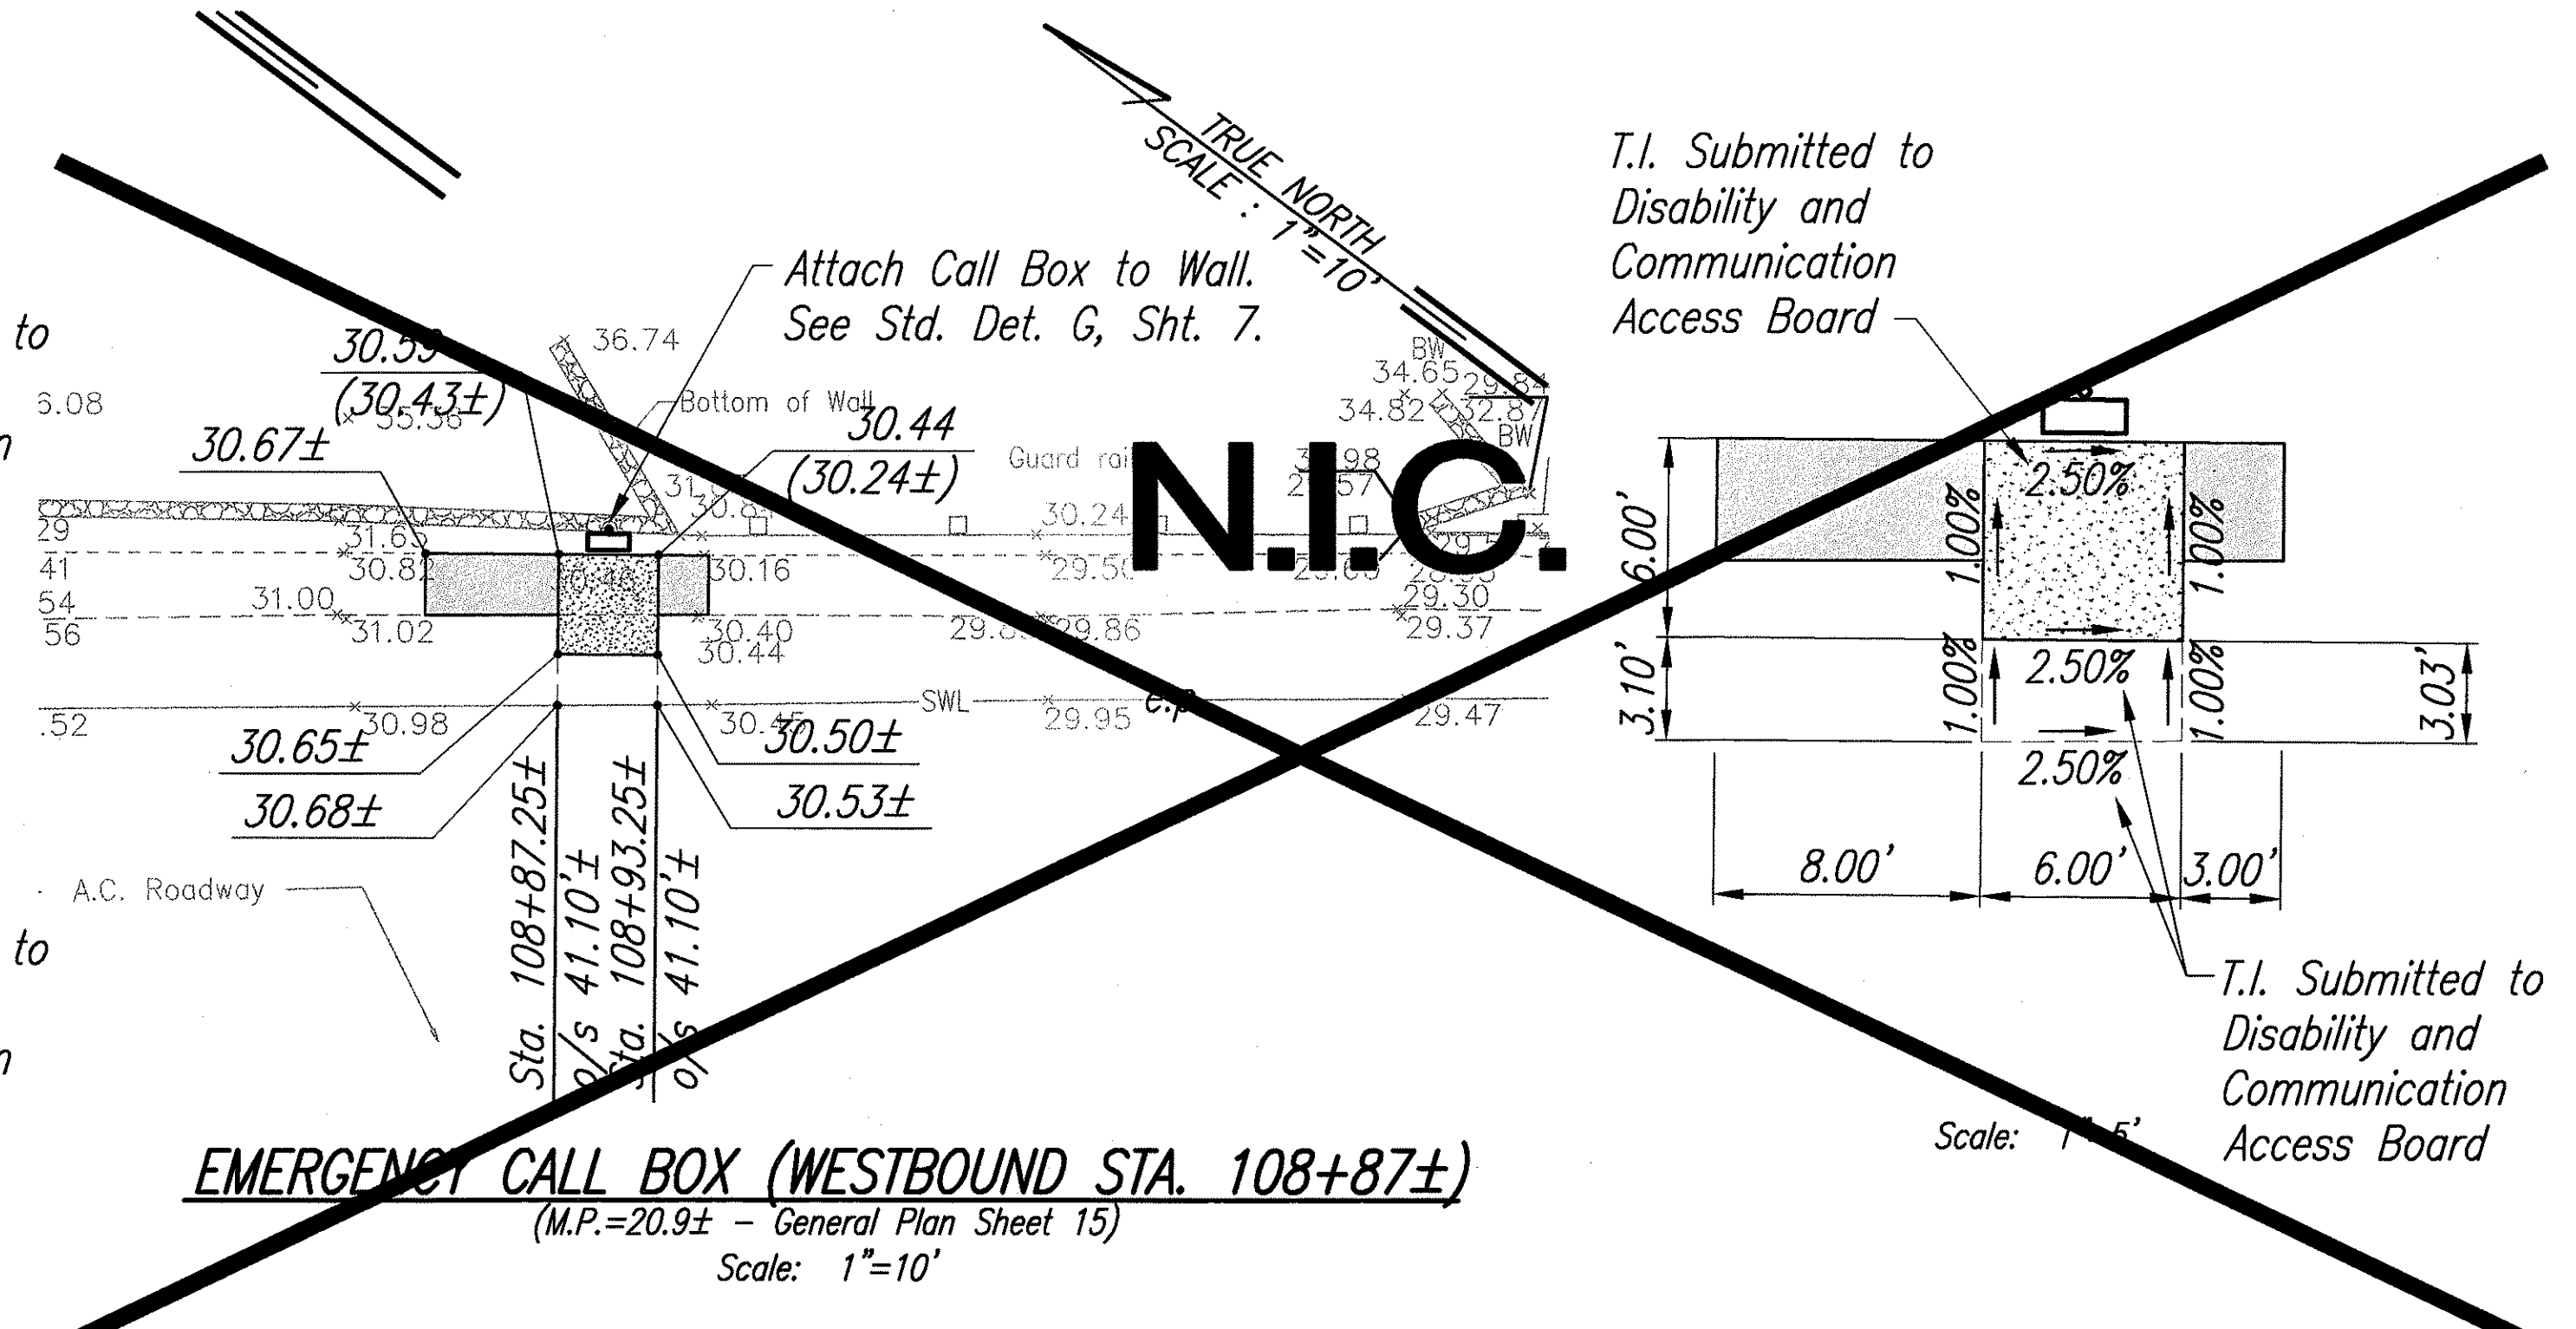
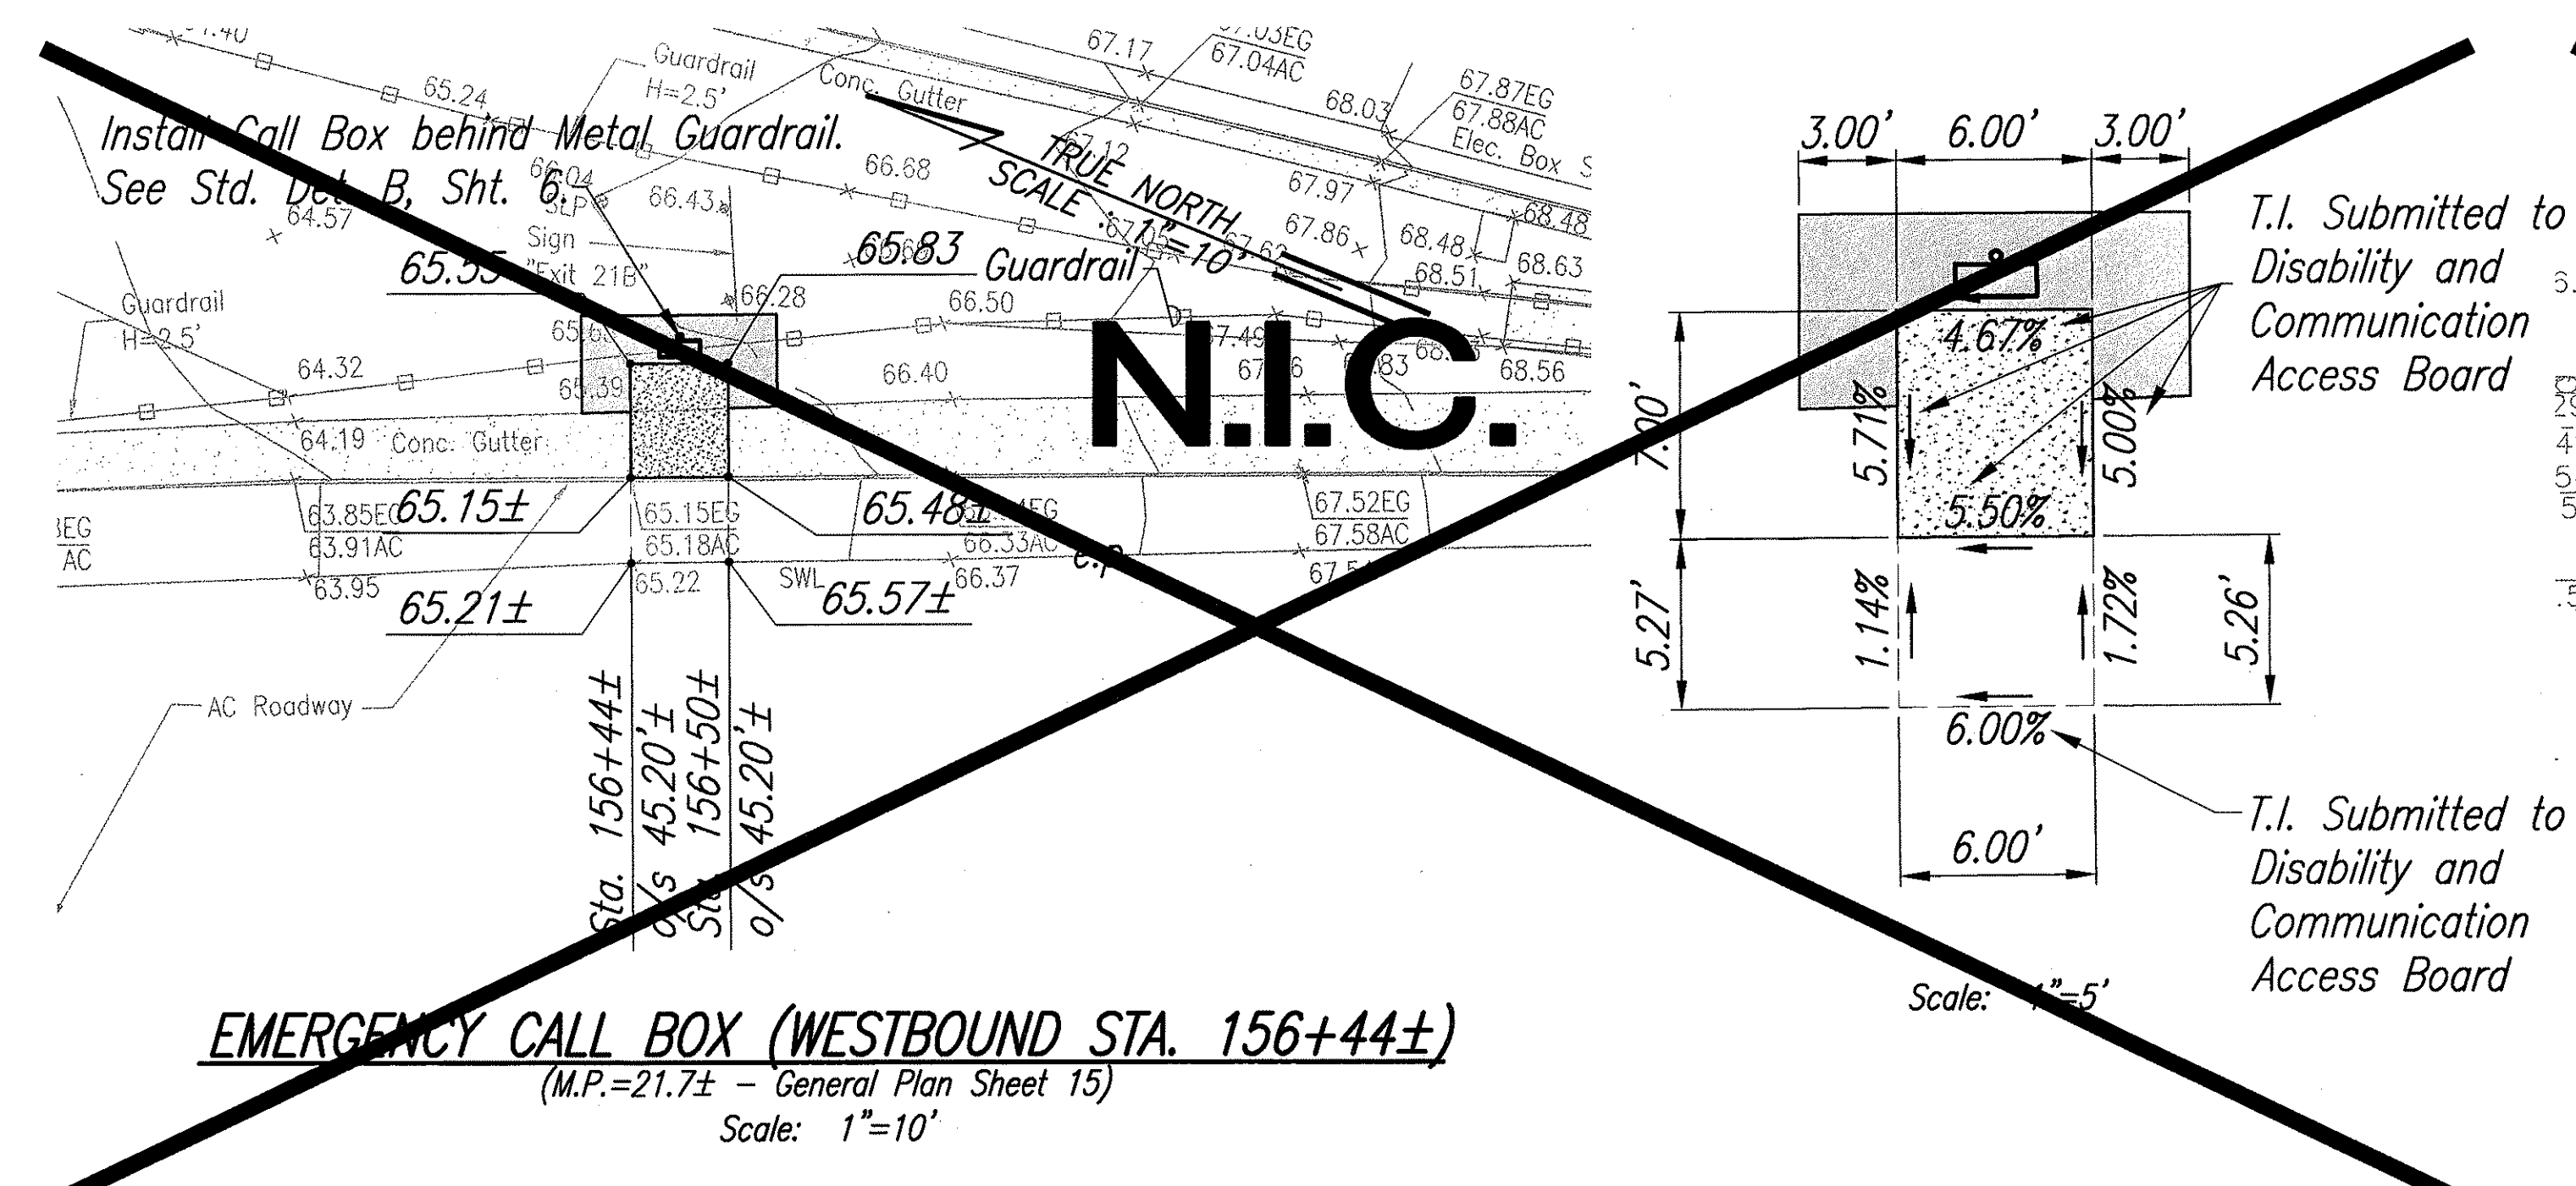
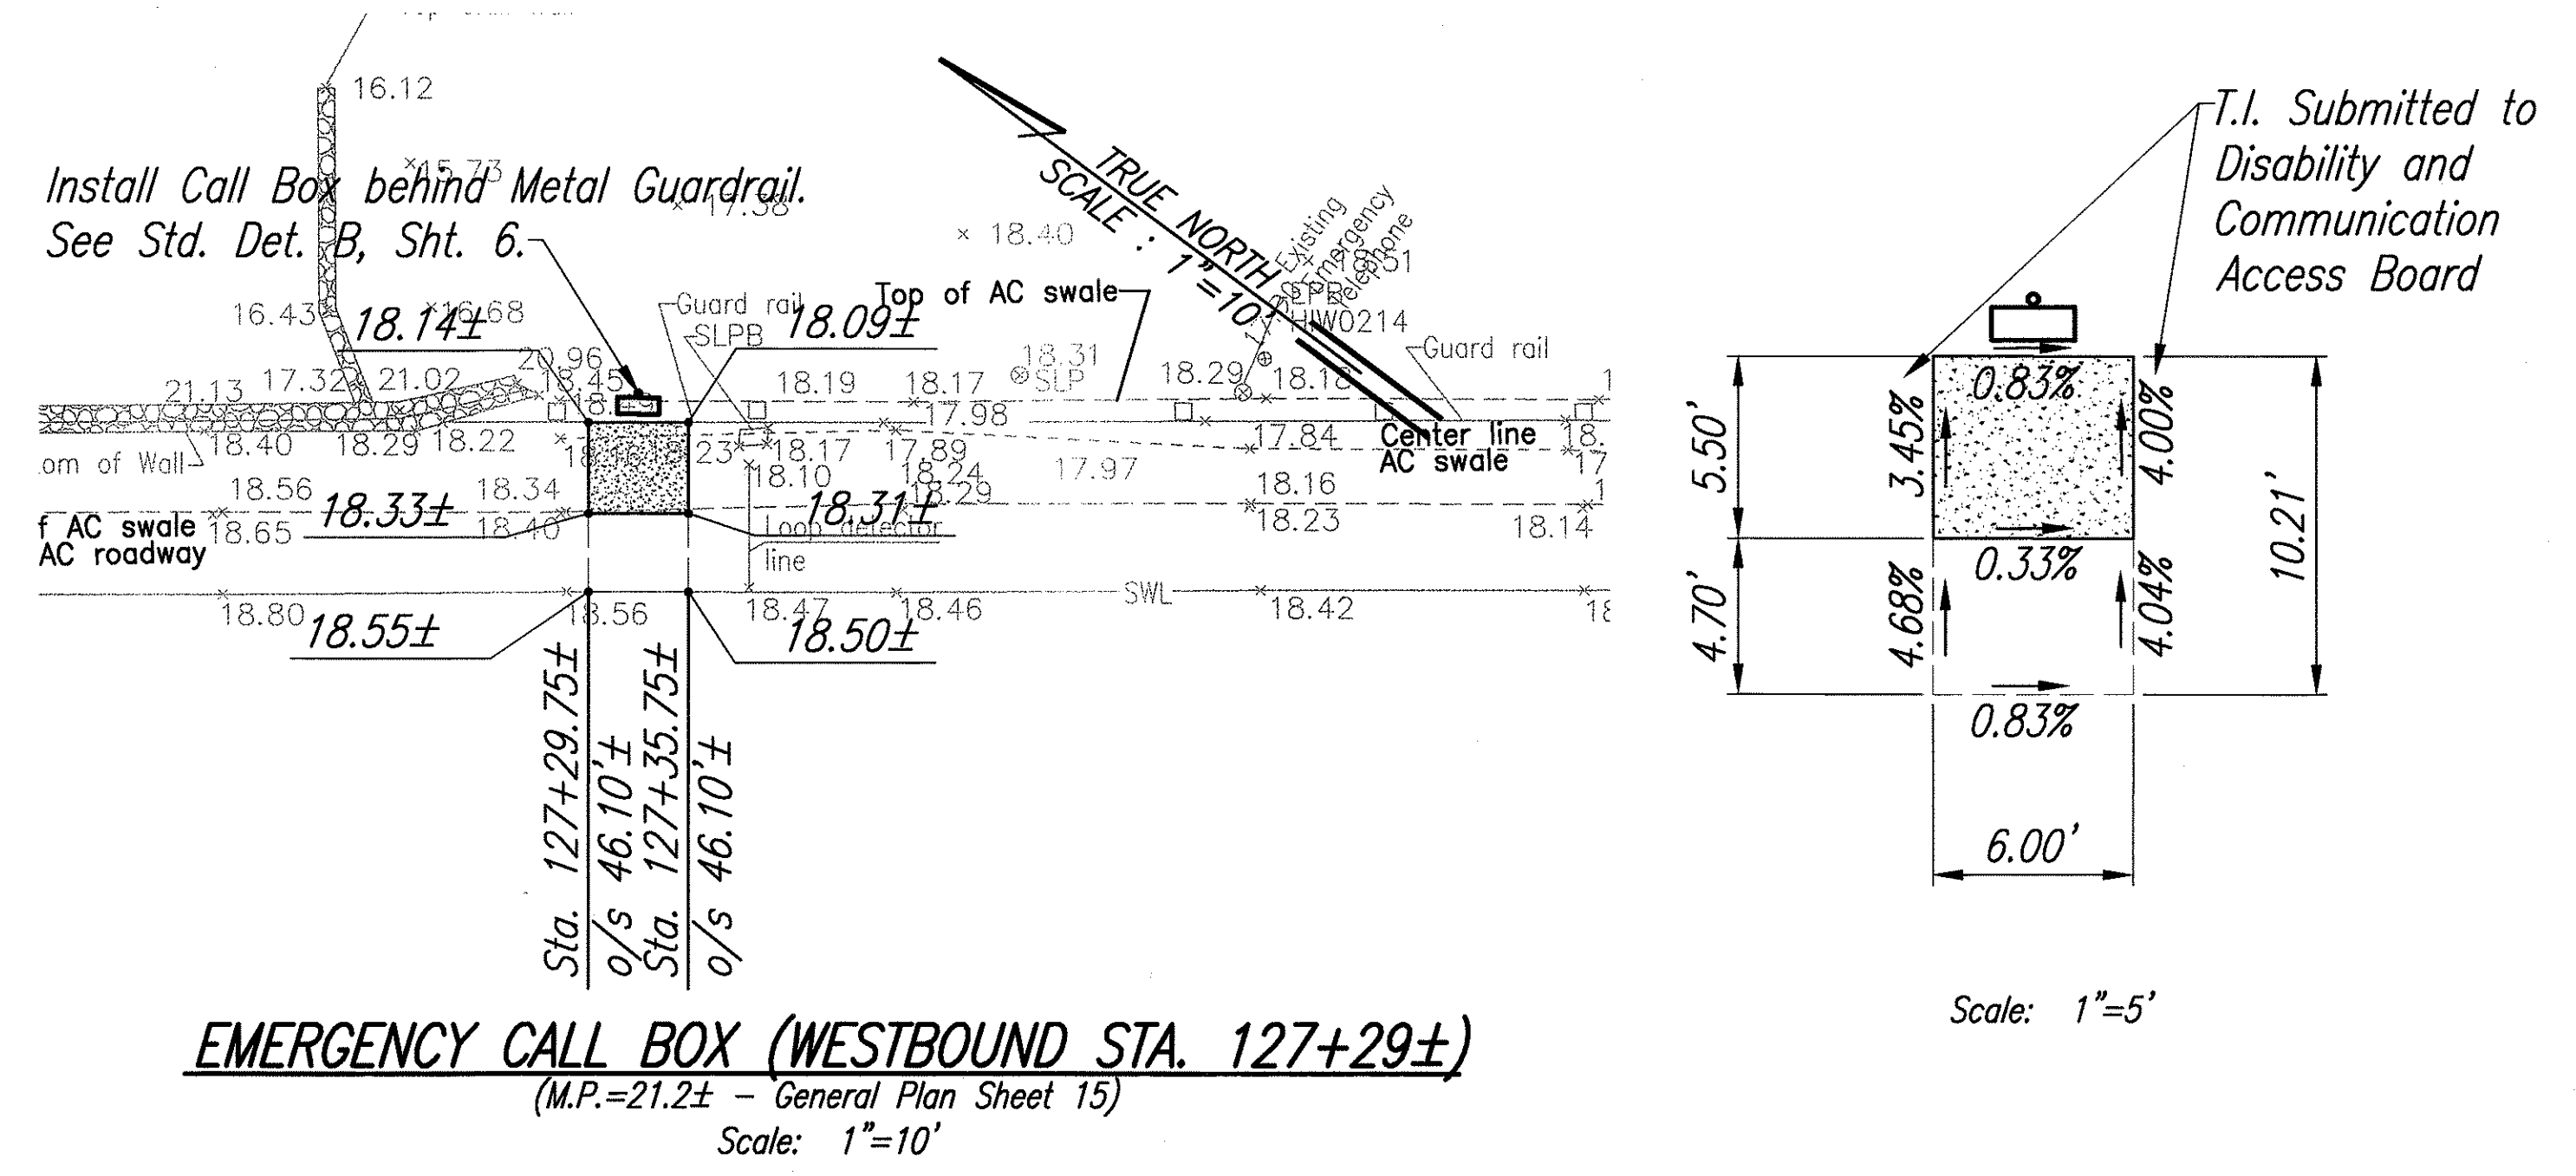


FED. ROAD DIST. NO.	STATE	FED. AID. PROJ. NO.	FISCAL YEAR	SHEET NO.	TOTAL SHEETS
HAWAII	HAW.	NH-300(86)R	2004	26	45

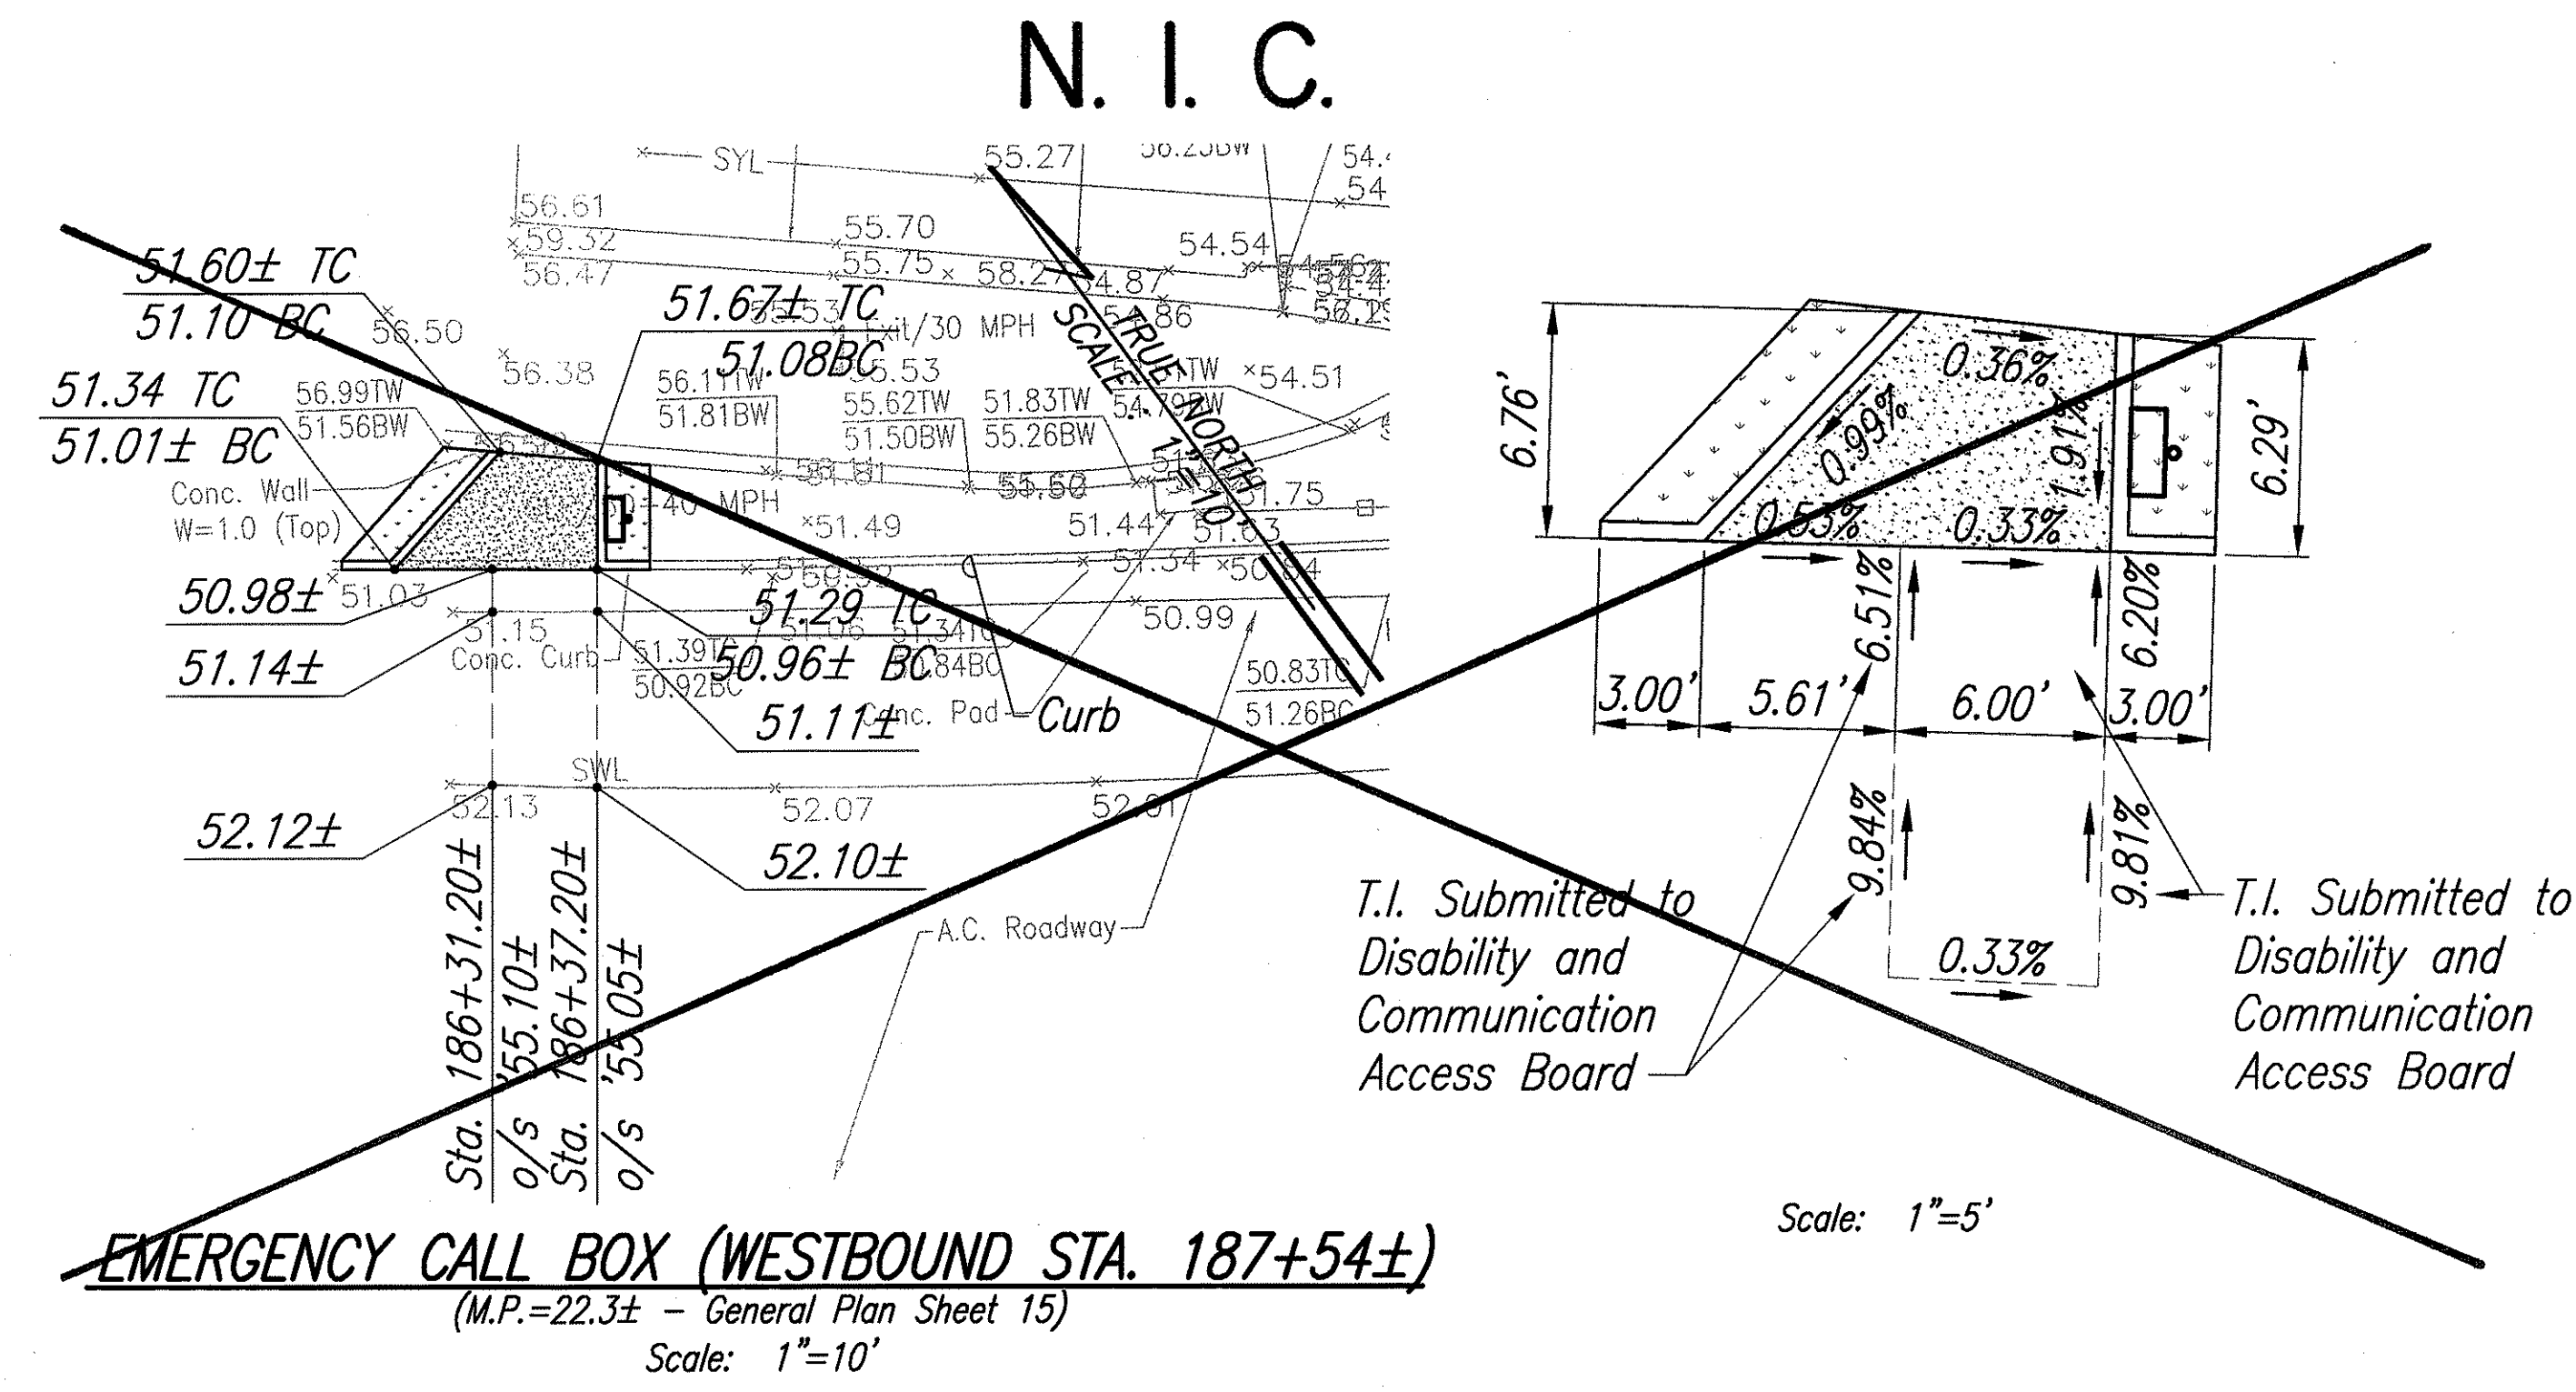

SURVEY PLOTTED BY	DATE
DRAWN BY	
DESIGNED BY	
QUANTITIES BY	
CHECKED BY	

ORIGINAL PLAN	NOTE BOOK
No.	No.

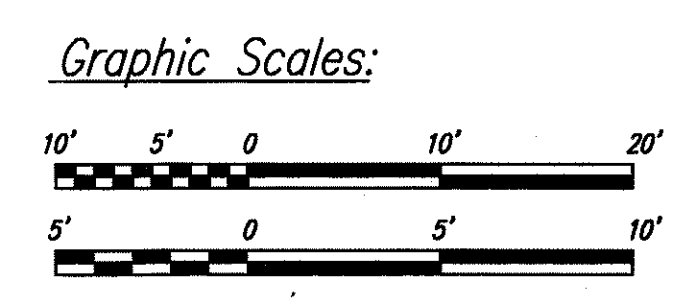

ALAN Y. TOMITA
LICENSED PROFESSIONAL ENGINEER
NO. 4129-C
HAWAII, U.S.A.

THIS WORK WAS PREPARED BY ME
OR UNDER MY SUPERVISION.

Alan Y. Tomita

STATE OF HAWAII
DEPARTMENT OF TRANSPORTATION
HIGHWAYS DIVISION


**INTERSTATE ROUTE H-1
GRADING PLAN-WESTBOUND**

**INTERSTATE ROUTE H-1
EMERGENCY TELEPHONE ACCESSIBLE ROUTES**
F.A. Project No. NH-300(86)R



Scale: As Shown Date: September 2003

SHEET No. 3 OF 7 SHEETS



FED. ROAD DIST. NO.	STATE	FED. AID. PROJ. NO.	FISCAL YEAR	SHEET NO.	TOTAL SHEETS
HAWAII	HAW.	NH-300(86)R	2004	27	45

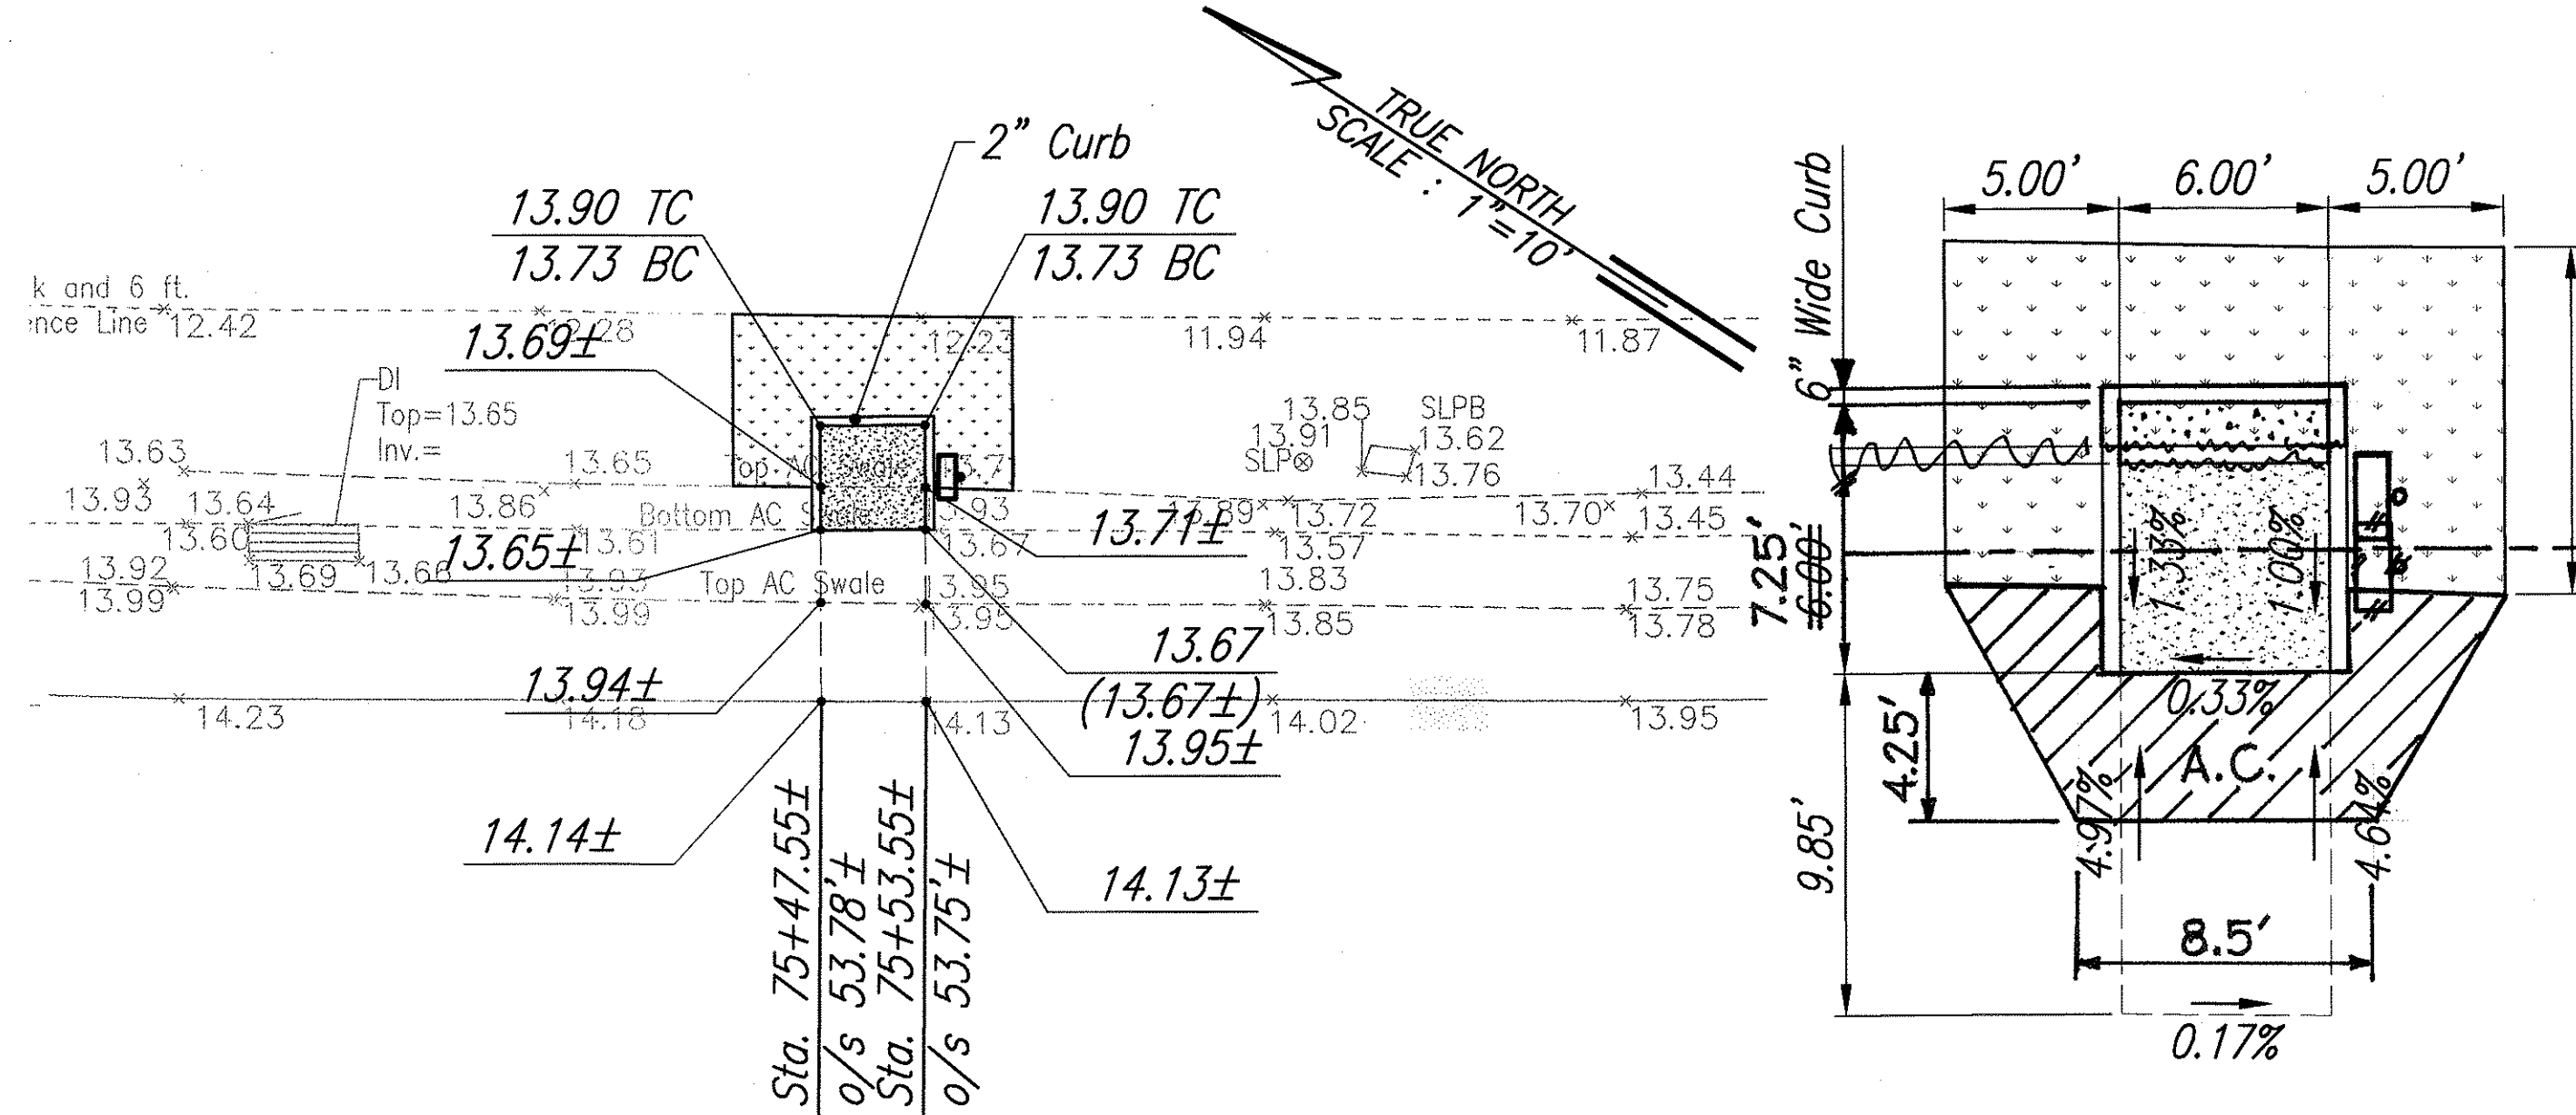



EMERGENCY CALL BOX (WESTBOUND STA. 75+48±)
(M.P.=20.2± - General Plan Sheet 15)
Scale: 1"=10'

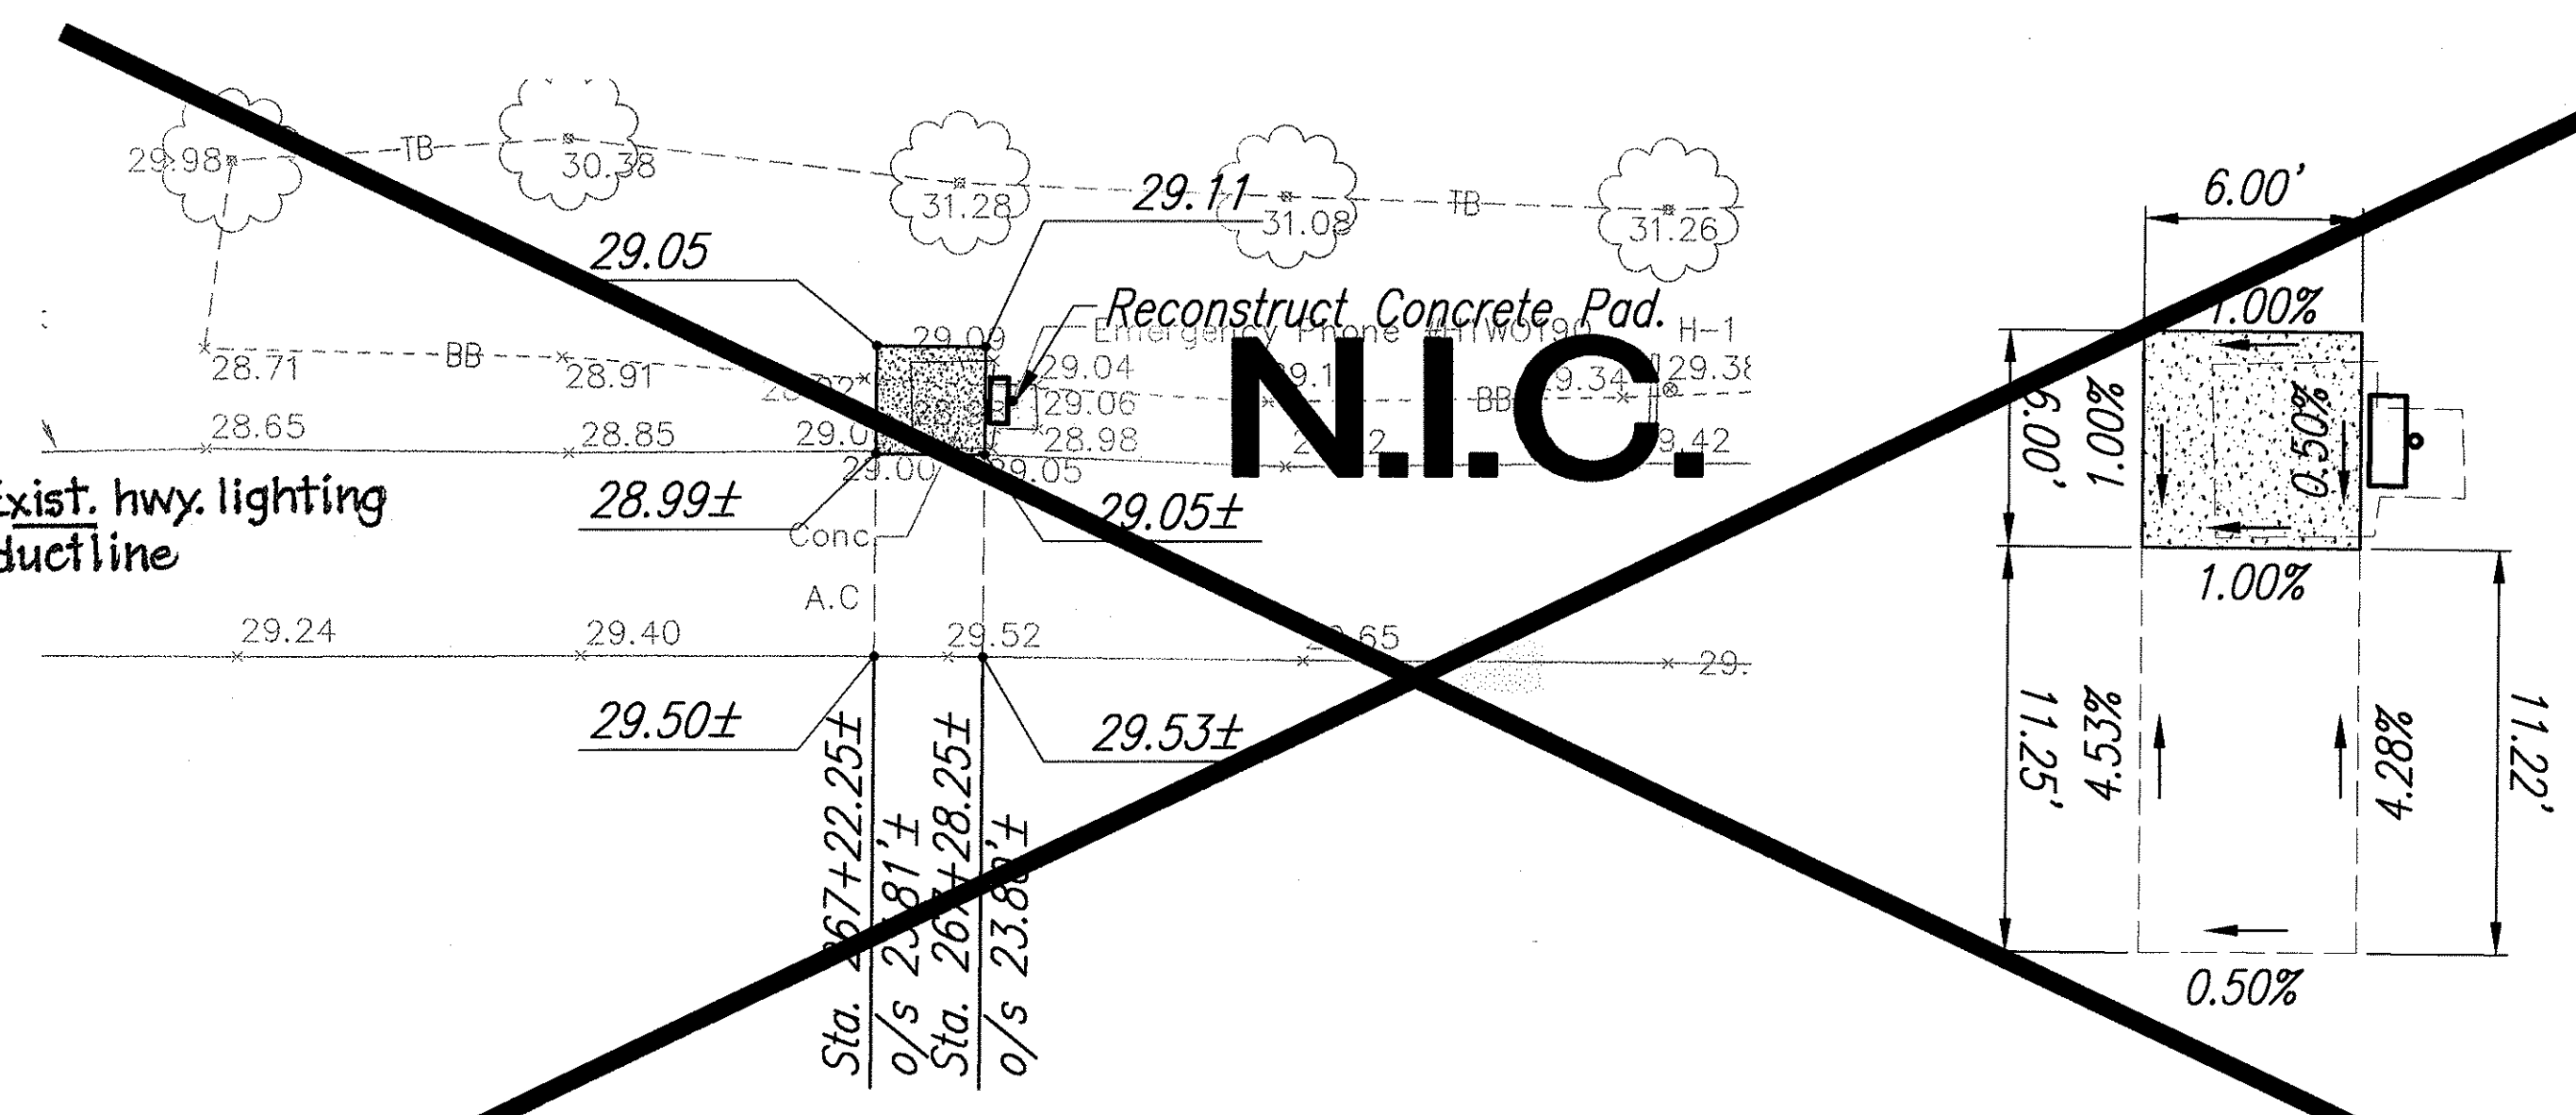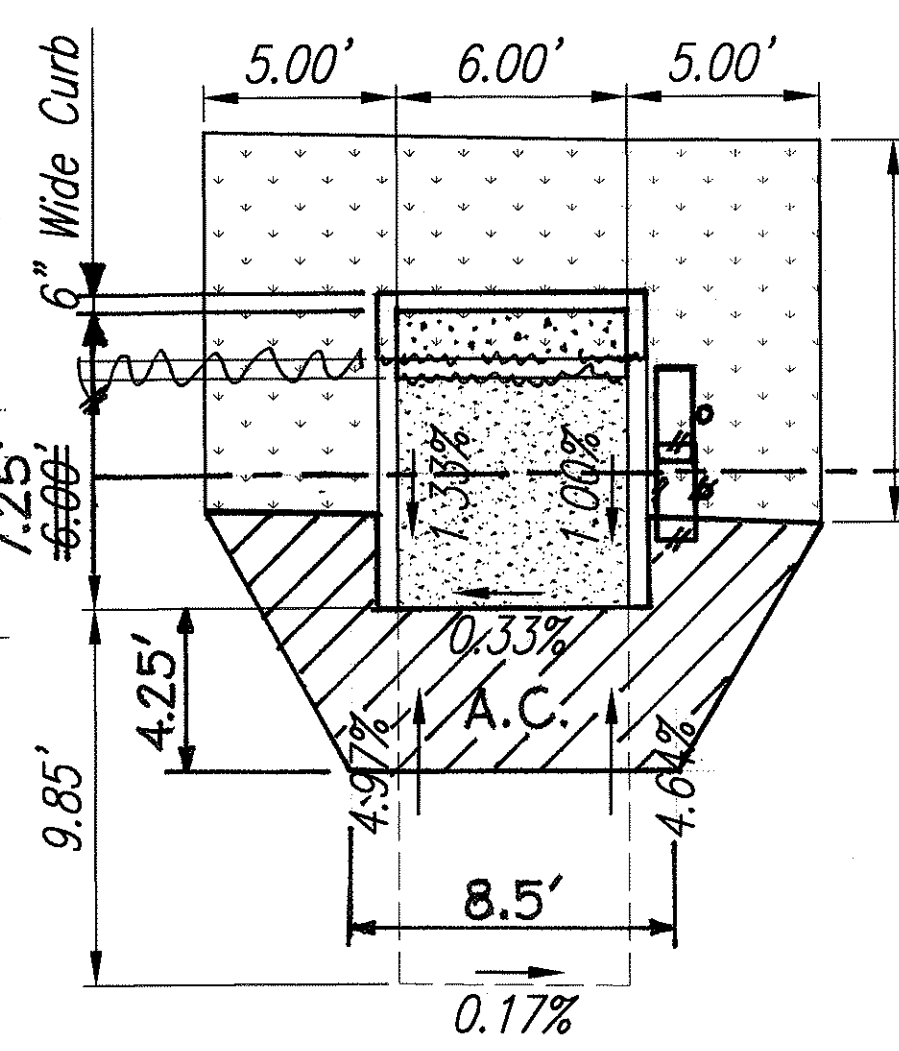


EMERGENCY CALL BOX (WESTBOUND STA. 267+22±)
(M.P.=18.8± - General Plan Sheet 14)
Scale: 1"=10'

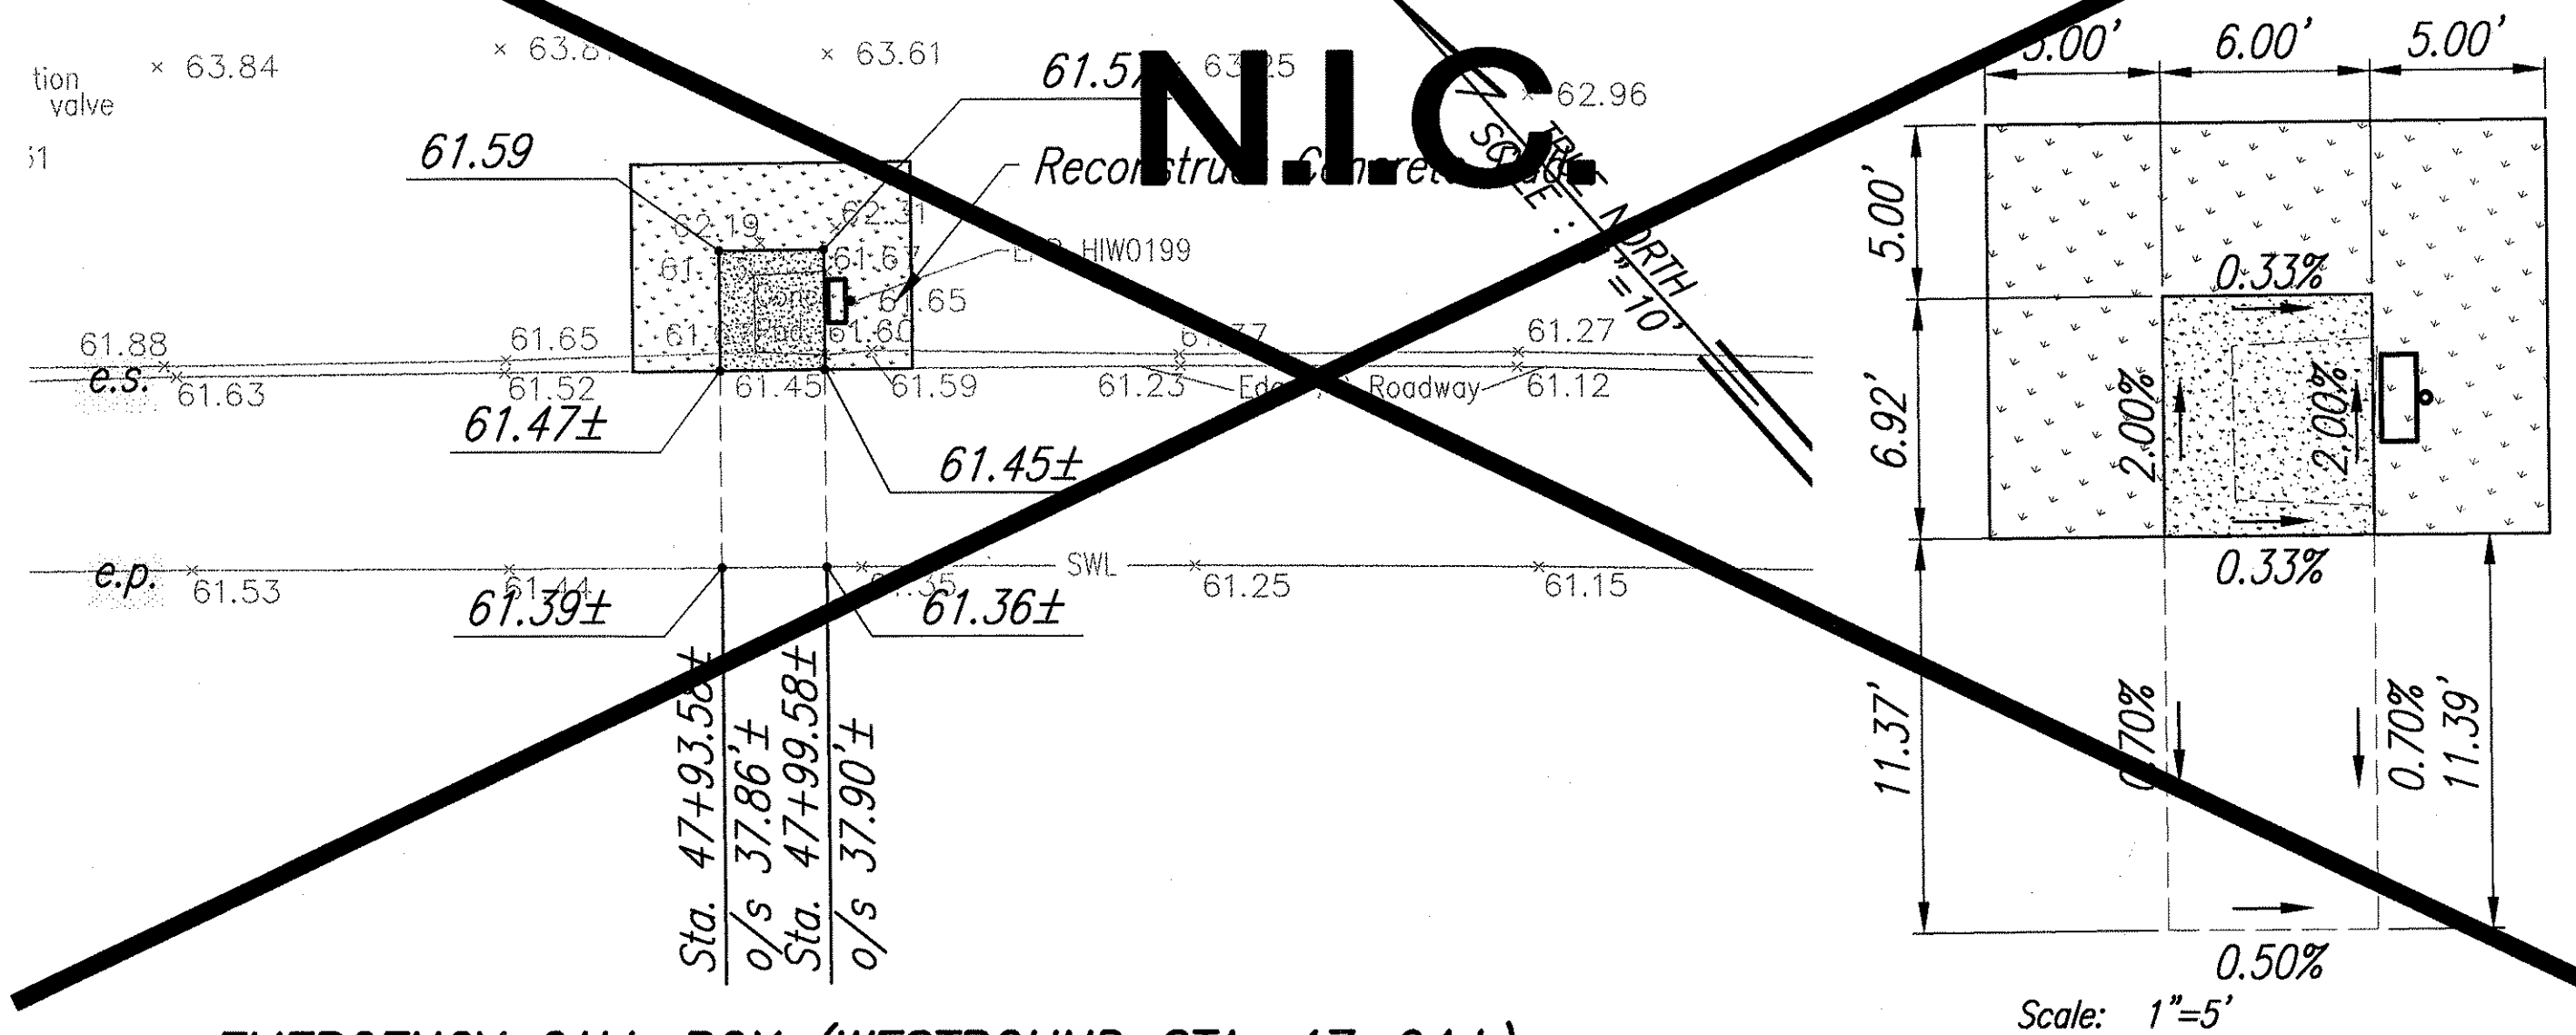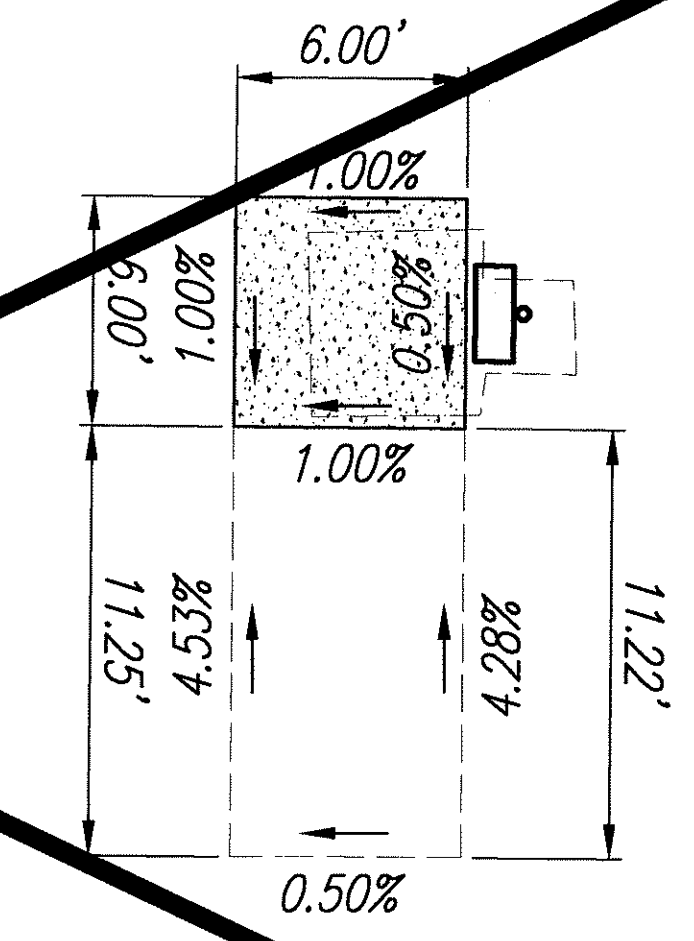



EMERGENCY CALL BOX (WESTBOUND STA. 47+94±)
(M.P.=19.7± - General Plan Sheet 14)
Scale: 1"=10'

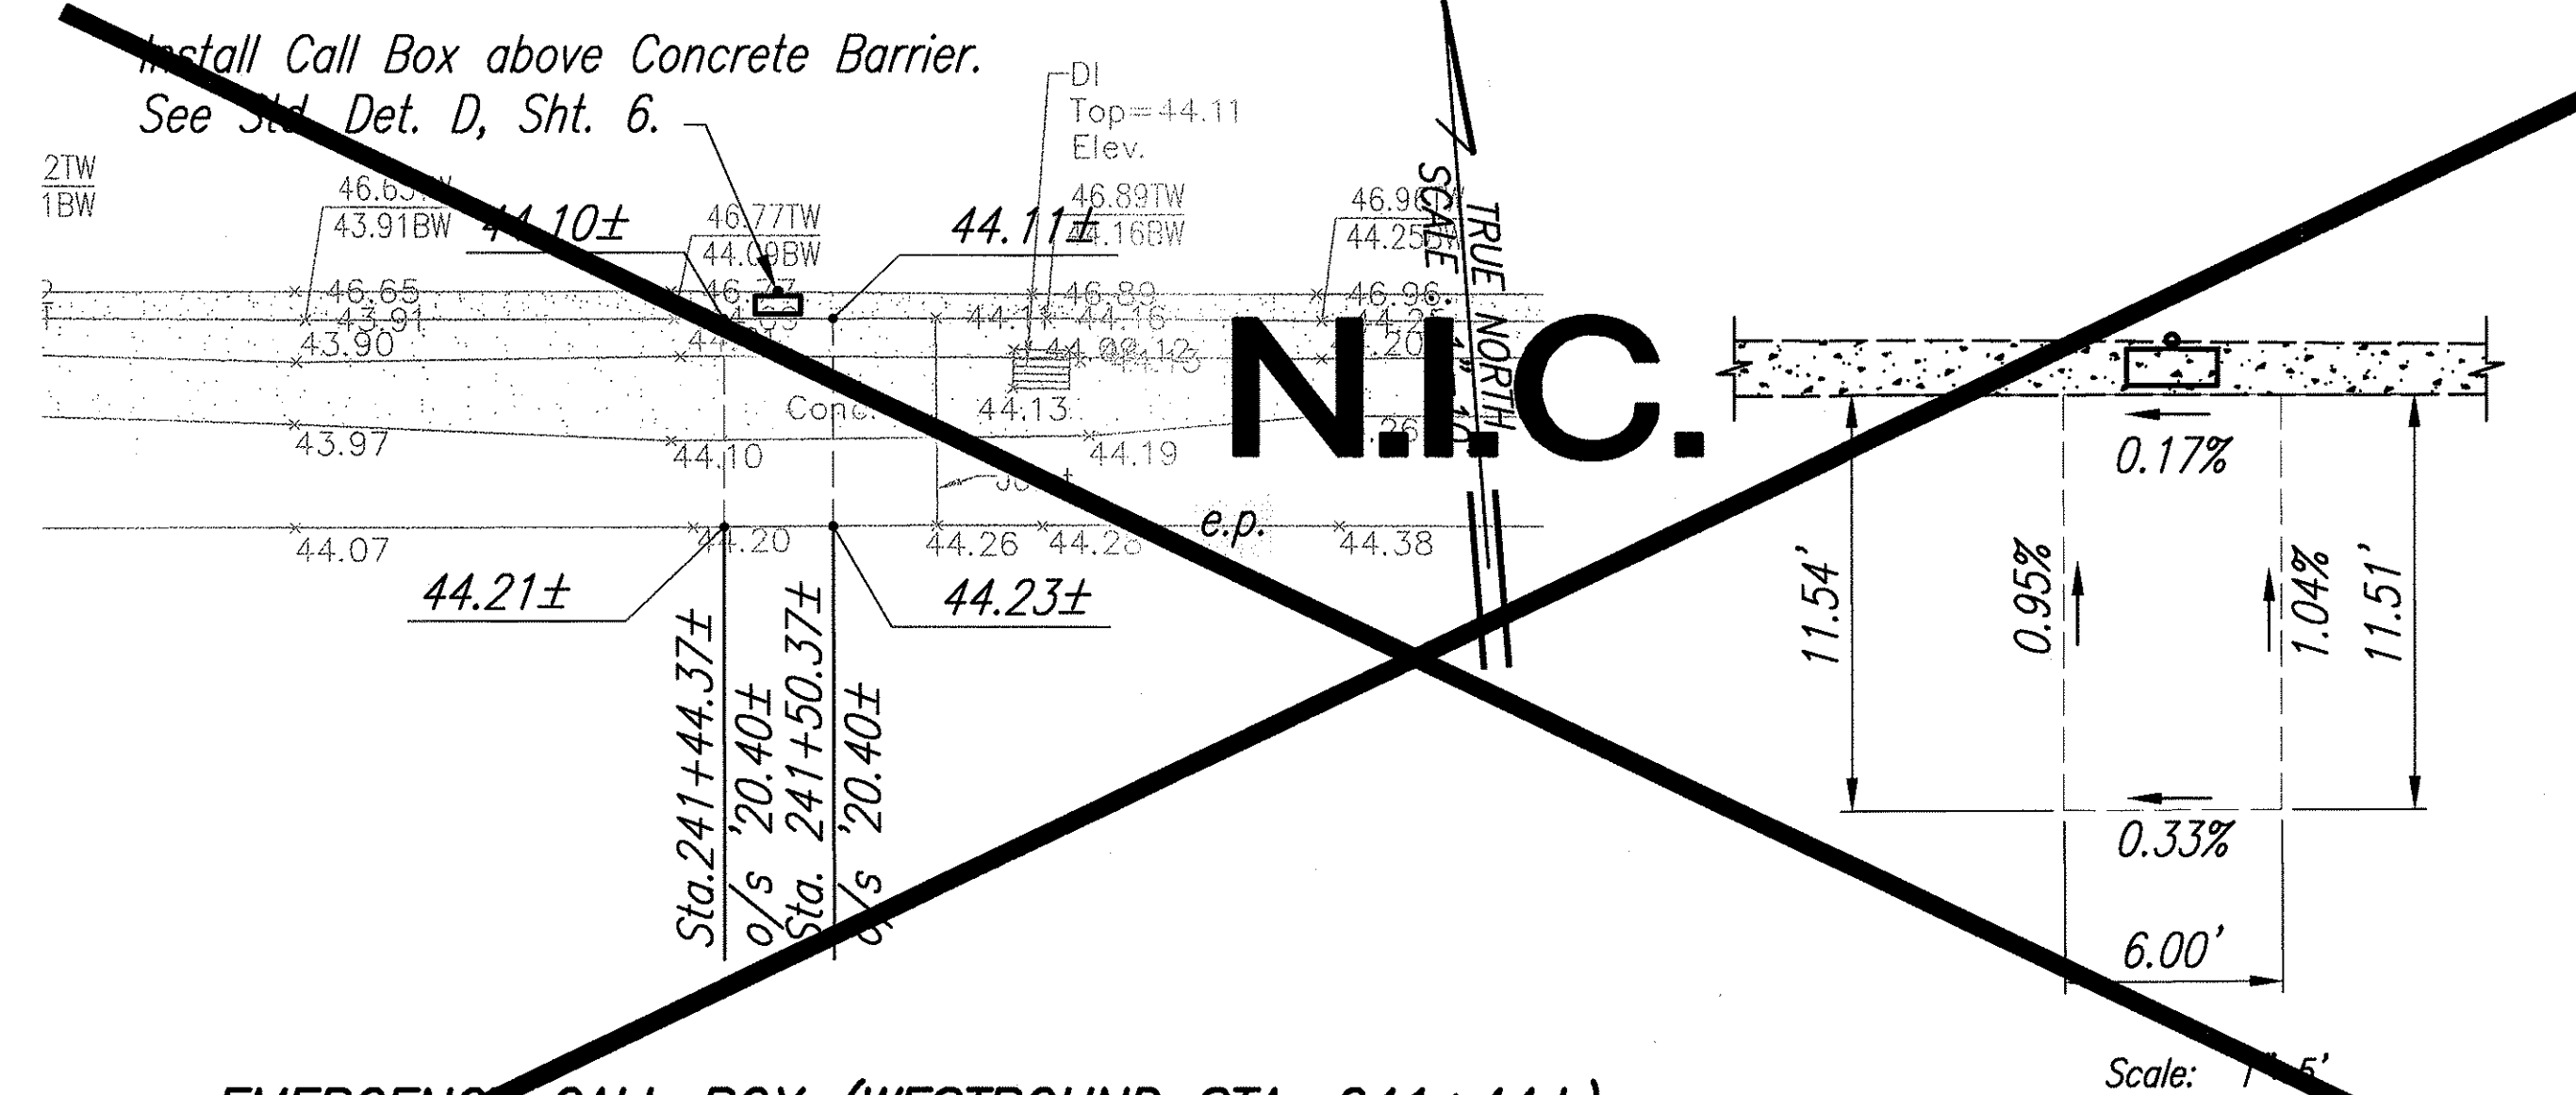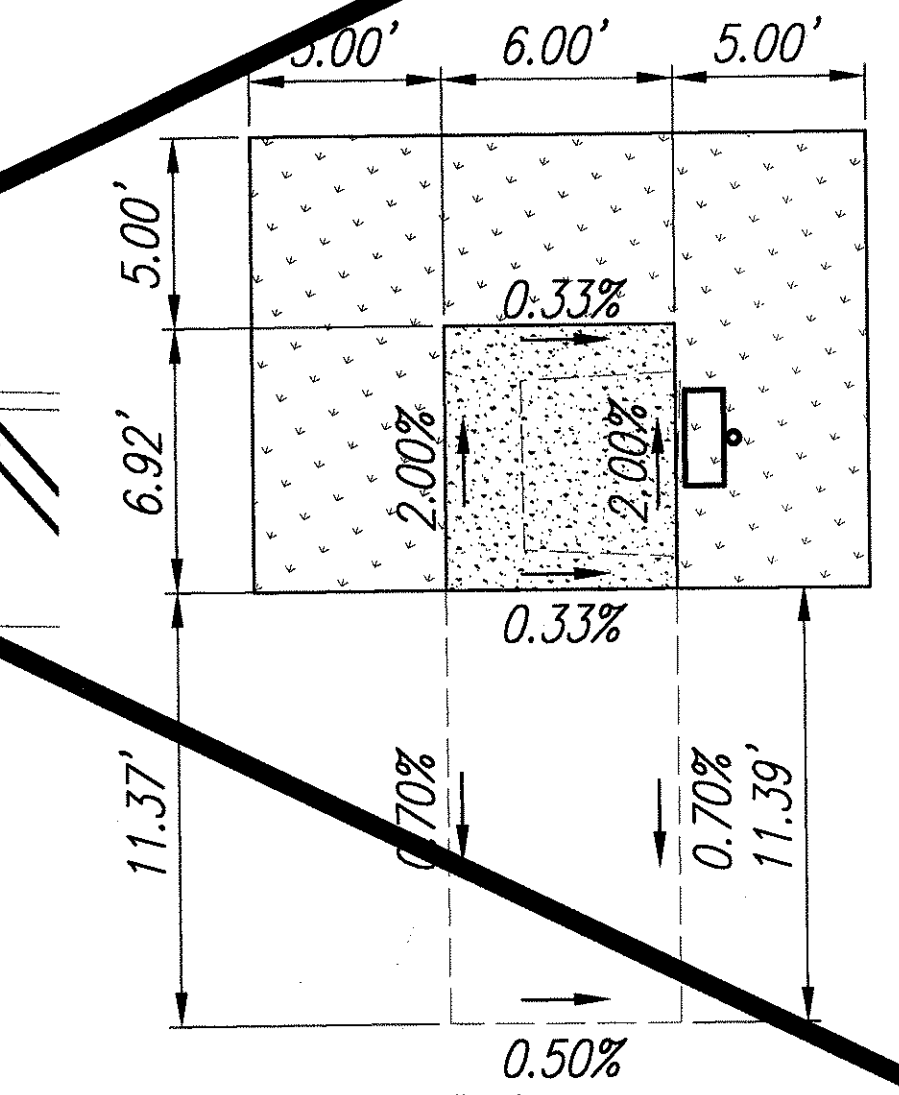

EMERGENCY CALL BOX (WESTBOUND STA. 241+44±)
(M.P.=18.3± - General Plan Sheet 14)
Scale: 1"=10'

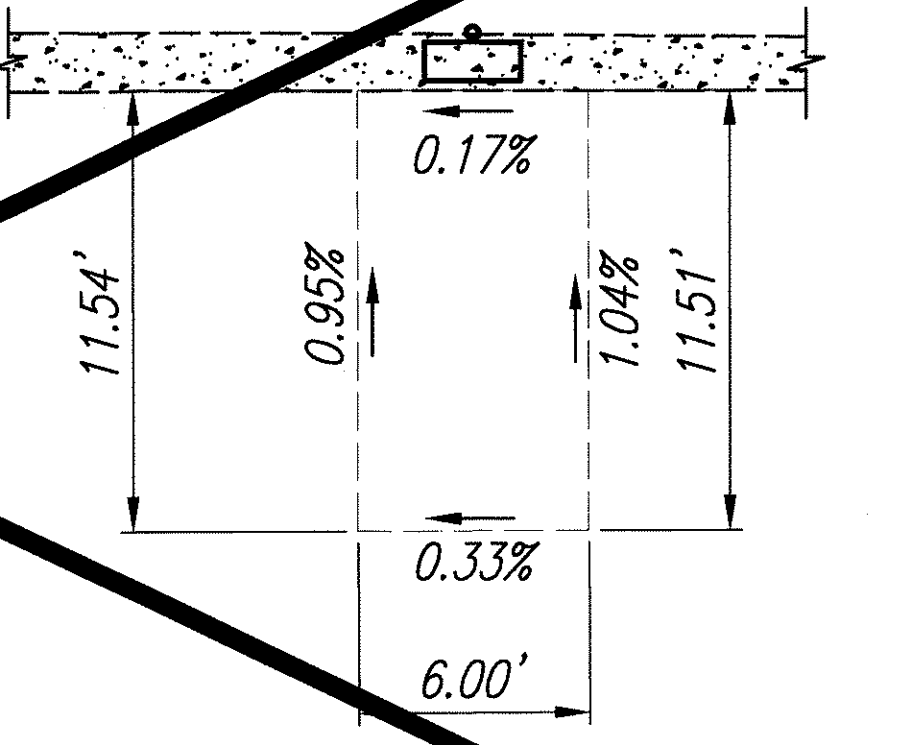

Note:
Existing Call Box to remain. Contractor shall ensure all existing call boxes, remaining in use, satisfy ADA height requirements and shall adjust where necessary, typ.

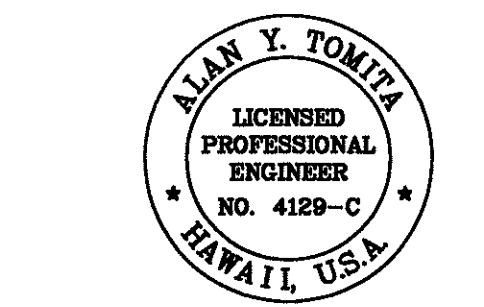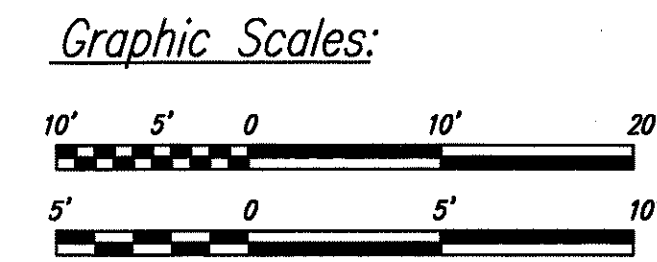





THIS WORK WAS PREPARED BY ME OR UNDER MY SUPERVISION.
Alan Y. Tomita

STATE OF HAWAII
DEPARTMENT OF TRANSPORTATION
HIGHWAYS DIVISION
**INTERSTATE ROUTE H-1
GRADING PLAN-WESTBOUND**
**INTERSTATE ROUTE H-1
EMERGENCY TELEPHONE ACCESSIBLE ROUTES**
E.A. Project No. NH-300(86)R
Scale: As Shown Date: September 2003
SHEET No. 4 OF 7 SHEETS

27



FED. ROAD DIST. NO.	STATE	FED. AID. PROJ. NO.	FISCAL YEAR	SHEET NO.	TOTAL SHEETS
HAWAII	HAW.	NH-300(86)R	2004	28	45

Note:
Existing Call Box to remain. Contractor shall ensure all existing call boxes, remaining in use, satisfy ADA height requirements and shall adjust where necessary, typ.

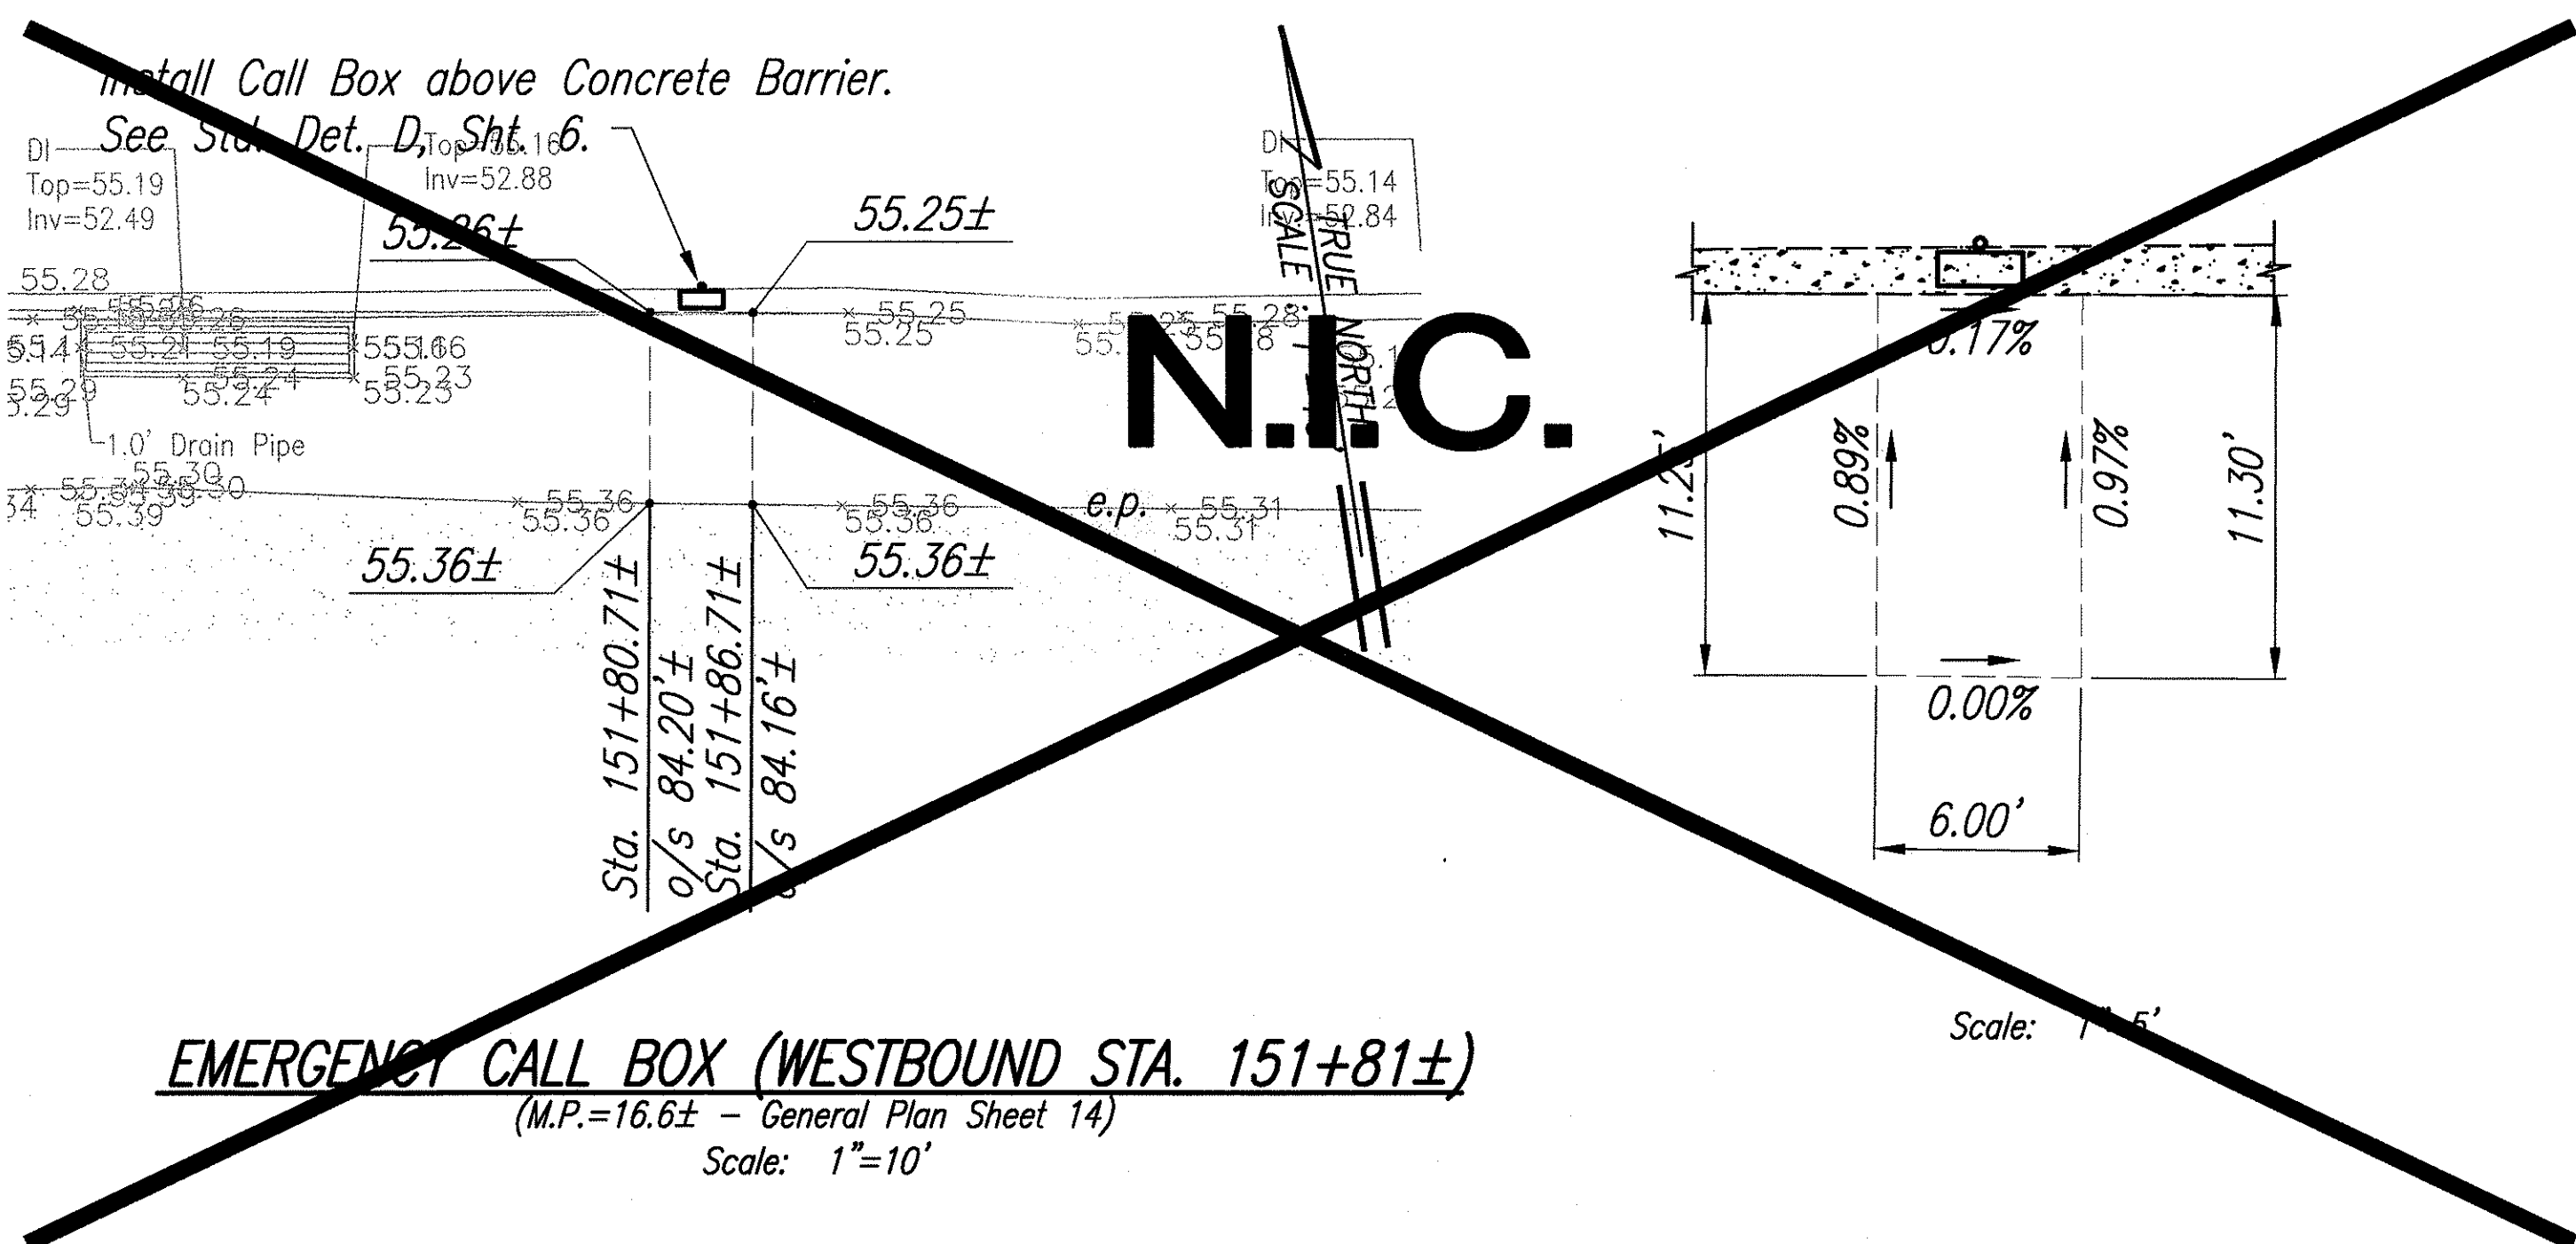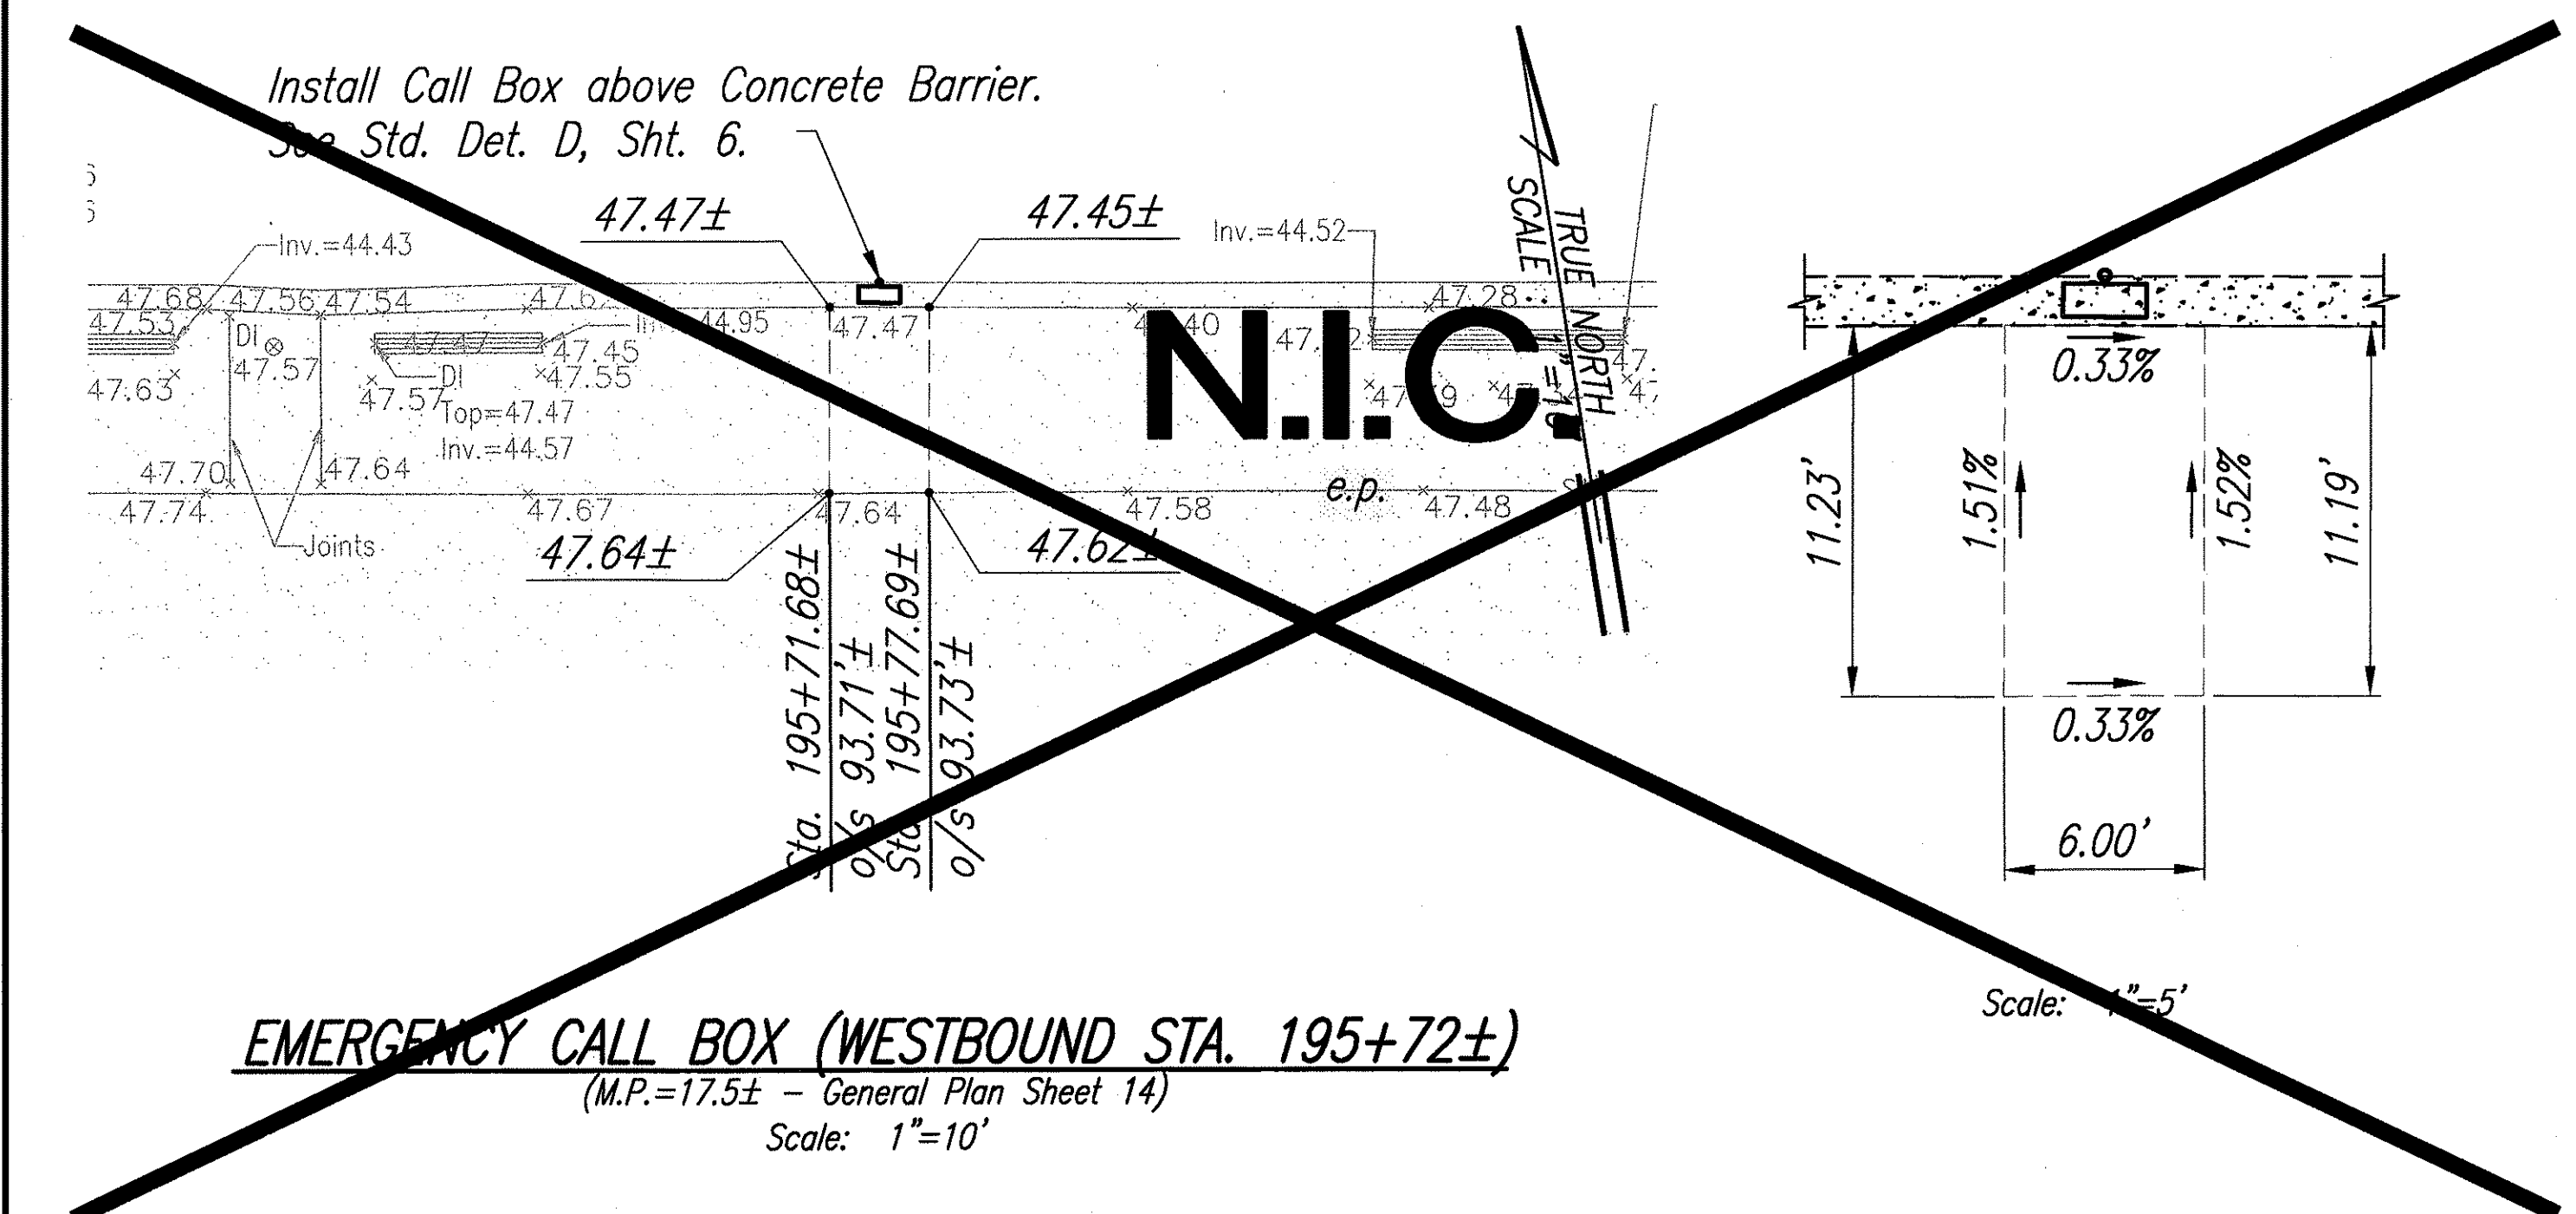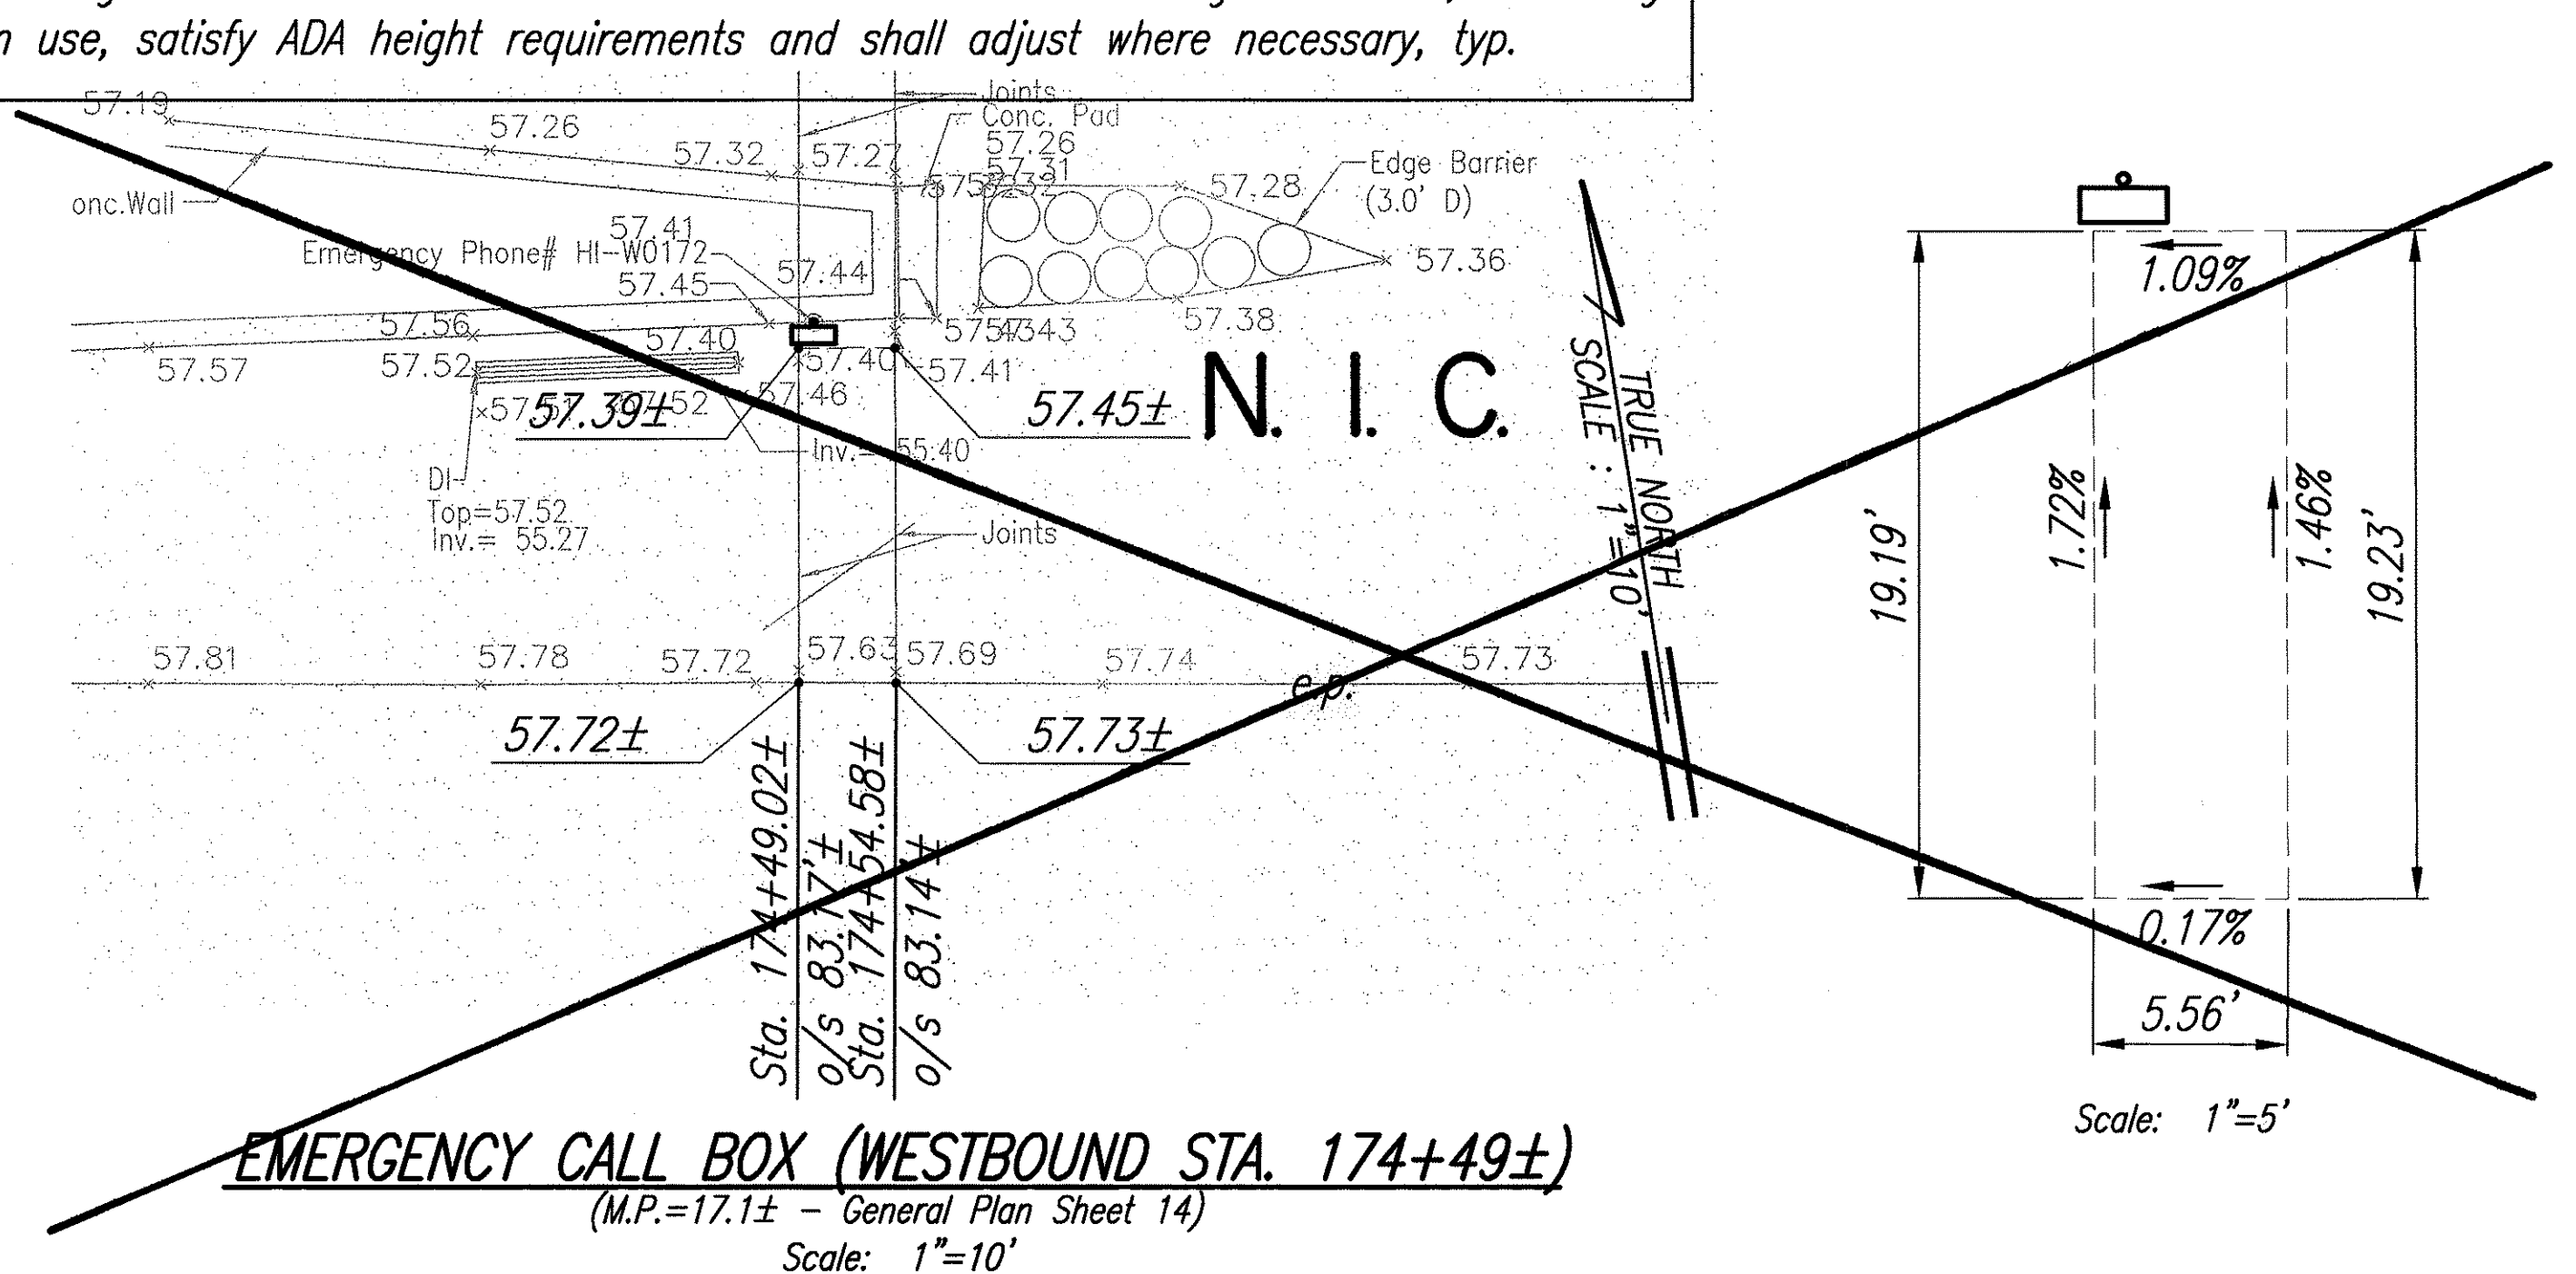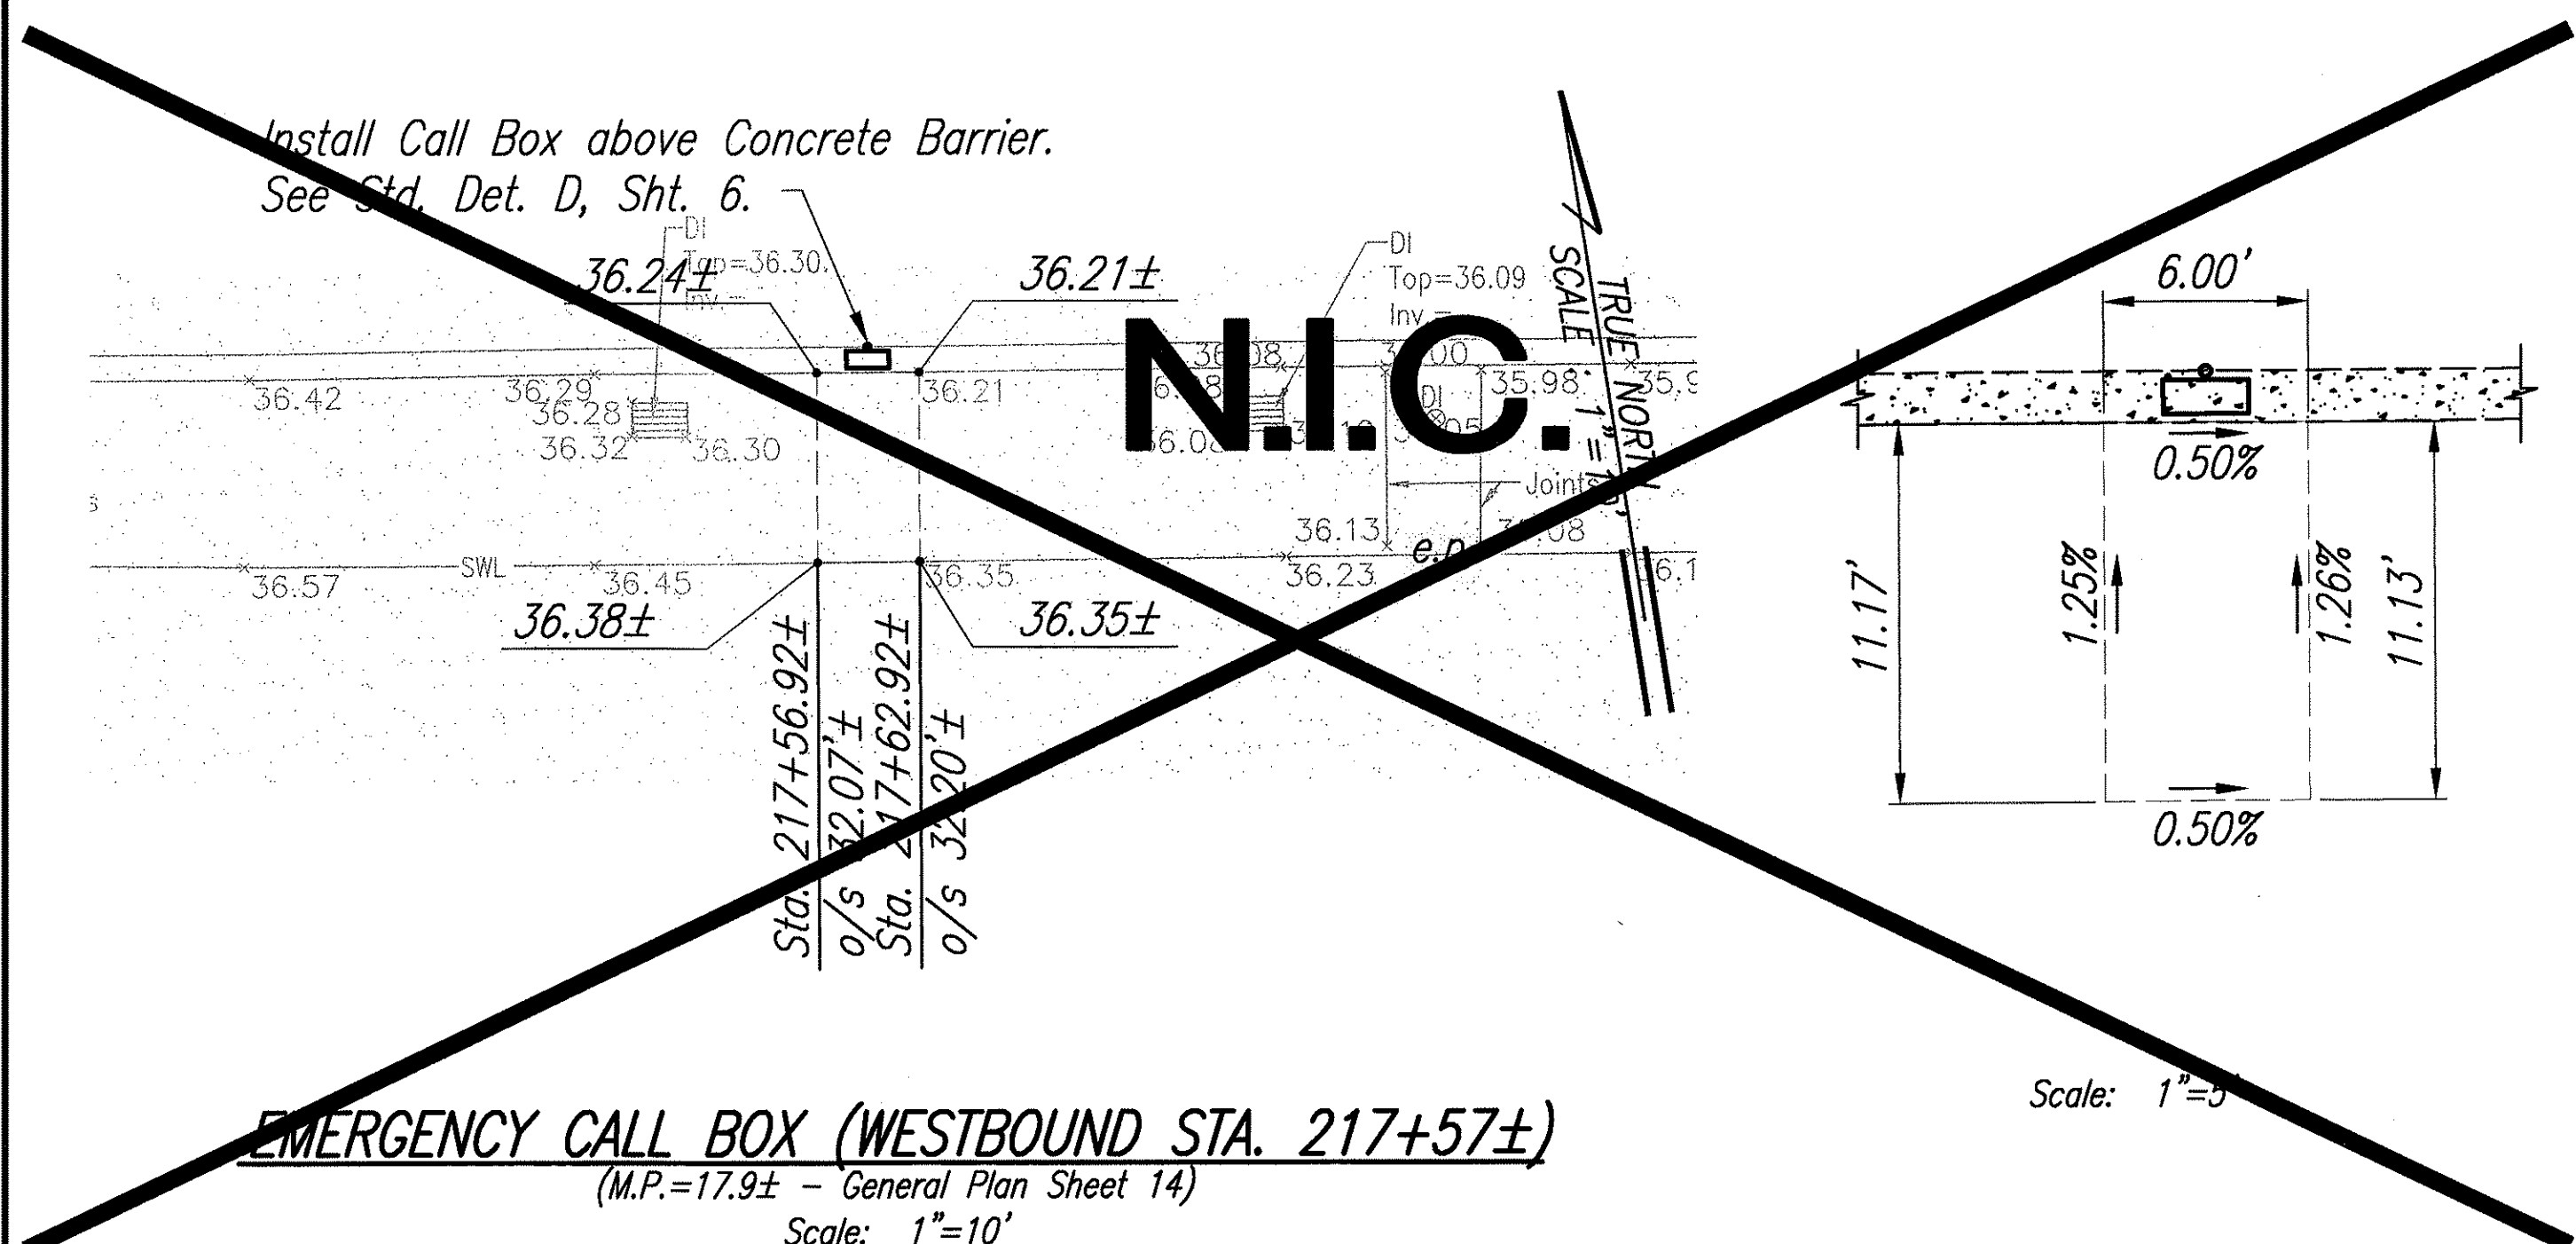

SURVEY PLOTTED BY	DATE
DRAWN BY	
DESIGNED BY	
QUANTITIES BY	
CHECKED BY	

ORIGINAL PLAN	NOTE BOOK
No.	No.

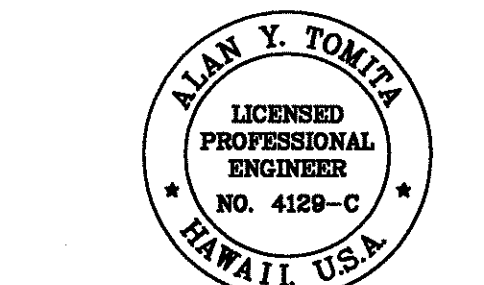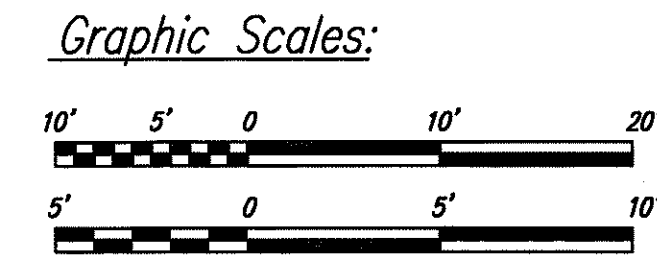

THIS WORK WAS PREPARED BY ME
OR UNDER MY SUPERVISION.

Alan Y. Tomita

STATE OF HAWAII
DEPARTMENT OF TRANSPORTATION
HIGHWAYS DIVISION



**INTERSTATE ROUTE H-1
GRADING PLAN-WESTBOUND**

**INTERSTATE ROUTE H-1
EMERGENCY TELEPHONE ACCESSIBLE ROUTES**
F.A. Project No. NH-300(86)R

Scale: As Shown Date: September 2003

SHEET No. 5 OF 7 SHEETS

FED. ROAD DIST. NO.	STATE	FED. AID. PROJ. NO.	FISCAL YEAR	SHEET NO.	TOTAL SHEETS
HAWAII	HAW.	NH-300(86)R	2004	30	45

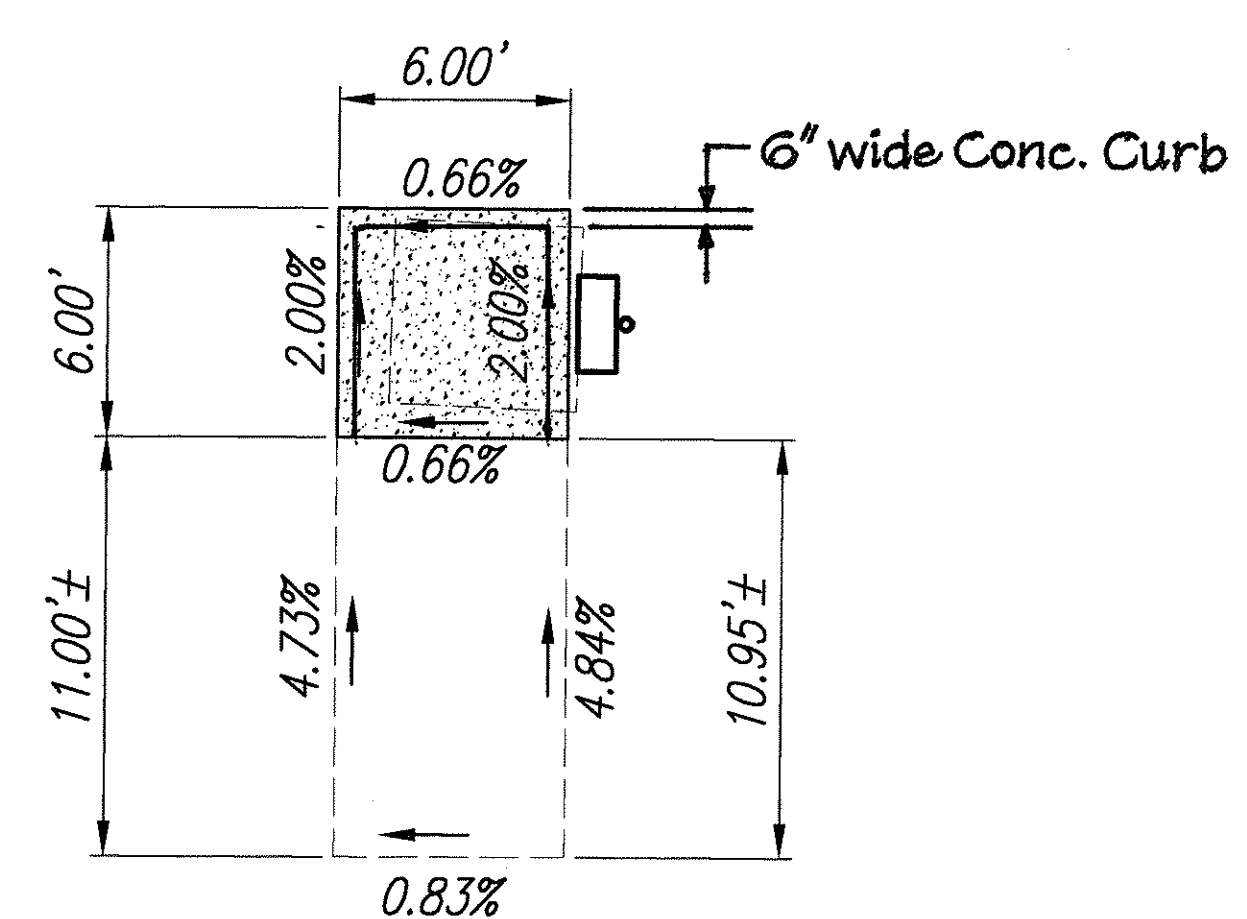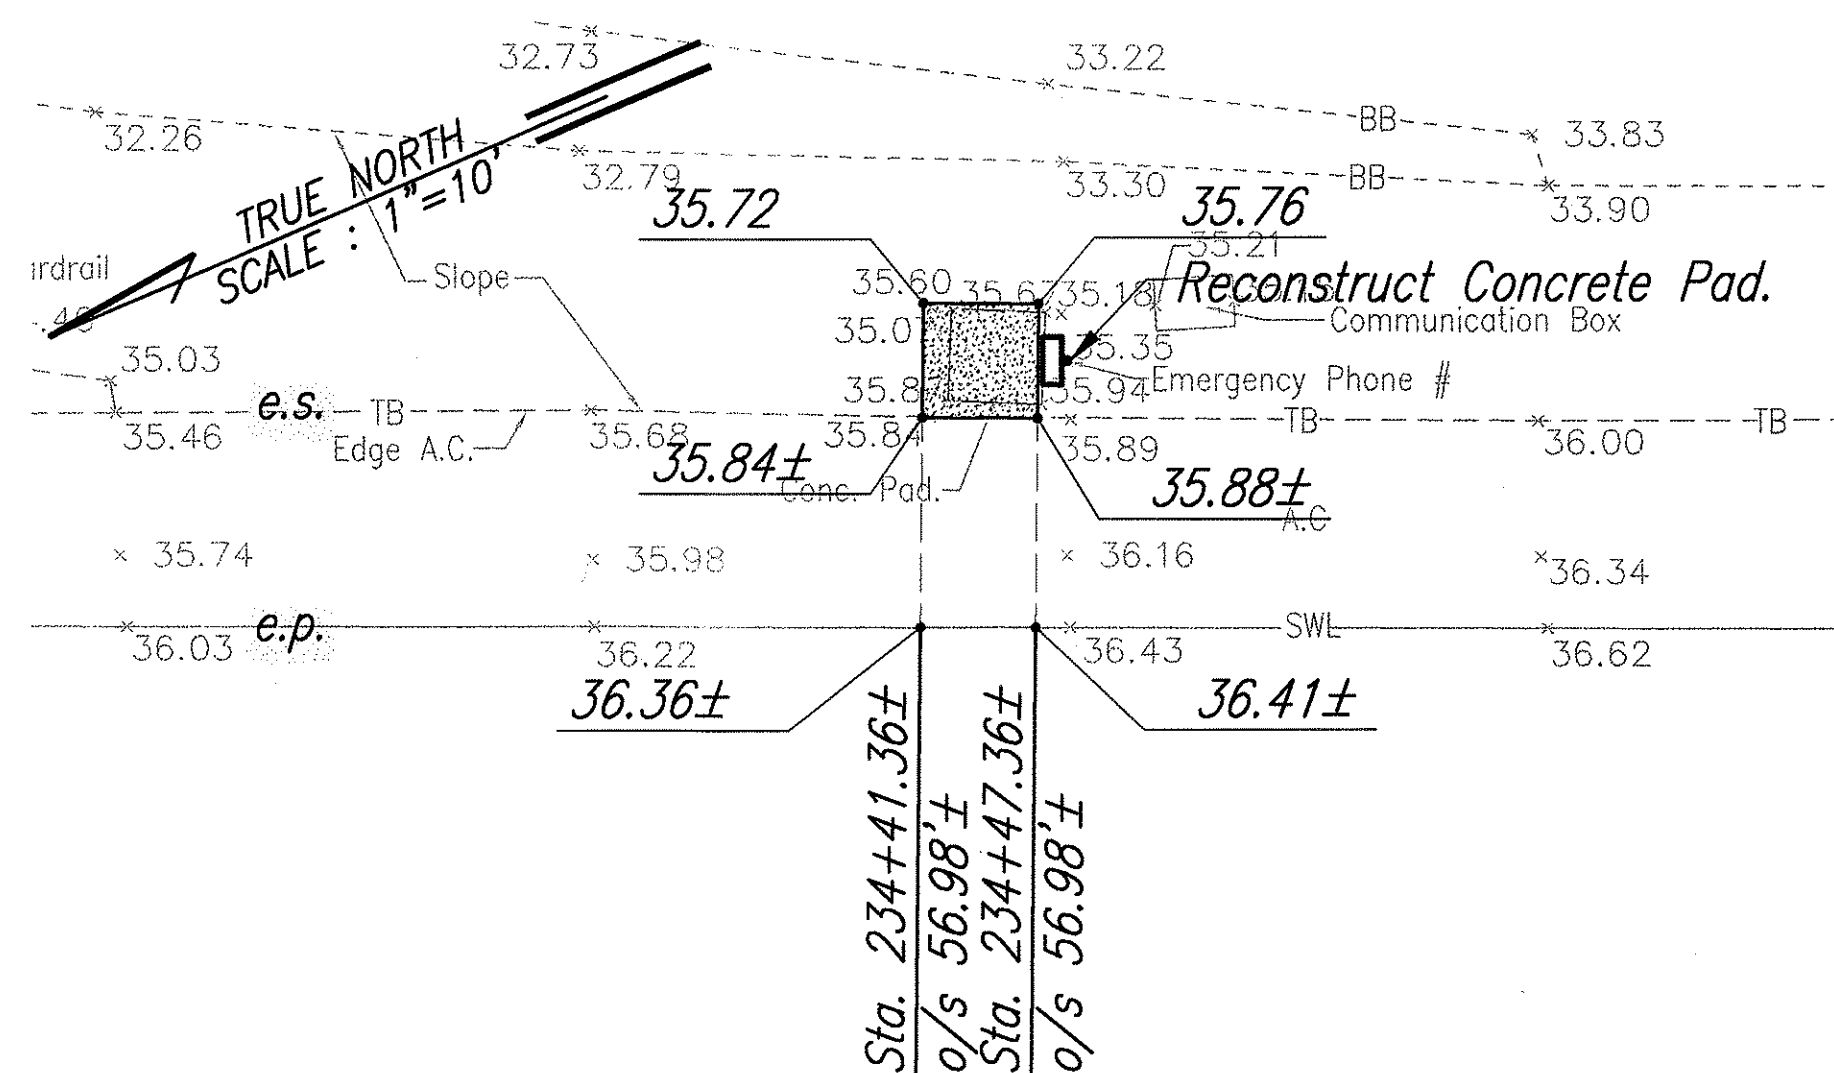



Scale: 1"=5'

EMERGENCY CALL BOX (WESTBOUND STA. 234+41±)
(M.P.=13.7± - General Plan Sheet 13)
Scale: 1"=10'

Note:
Existing Call Box to remain. Contractor shall ensure all existing call boxes, remaining in use, satisfy ADA height requirements and shall adjust where necessary, typ.

SURVEY PLOTTED BY	DATE
DRAWN BY	
DESIGNED BY	
QUANTITIES BY	
CHECKED BY	

ORIGINAL PLAN	NOTE BOOK
No.	No.

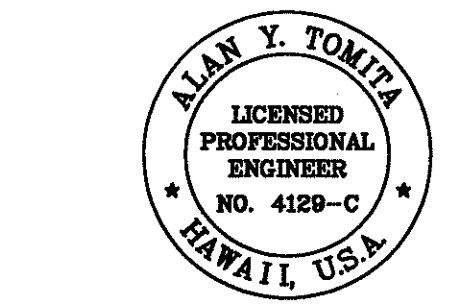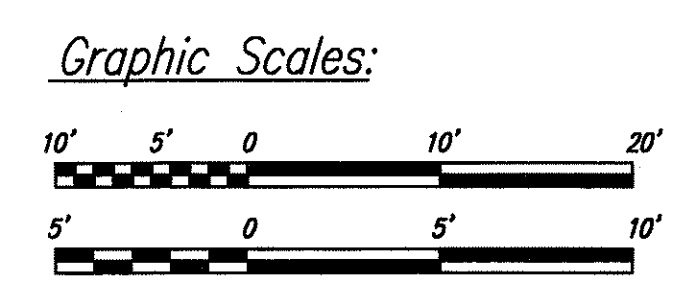

THIS WORK WAS PREPARED BY ME OR UNDER MY SUPERVISION.

Alan Y. Tomita

STATE OF HAWAII
DEPARTMENT OF TRANSPORTATION
HIGHWAYS DIVISION

**INTERSTATE ROUTE H-1
GRADING PLAN-WESTBOUND**

**INTERSTATE ROUTE H-1
EMERGENCY TELEPHONE ACCESSIBLE ROUTES**
F.A. Project No. NH-300(86)R

Scale: As Shown Date: September 2003

SHEET No. 7 OF 7 SHEETS