

FED. ROAD DIST. NO.	STATE	FED. AID. PROJ. NO.	FISCAL YEAR	SHEET NO.	TOTAL SHEETS
HAWAII	HAW.	NH-300(86)R	2004	14	45

~~N.I.C.
ECB-Westbound
Sta. 151+81± Lt.
M.P.=0.0±
See Grading Plan
Sheet 28~~

~~N.I.C.
ECB-Westbound
Sta. 174+49± Lt.
M.P.=17.4±
See Grading Plan
Sheet 28~~

~~N.I.C.
ECB-Eastbound
Sta. 135+00± Rt.
M.P.=0.0±
See Grading Plan
Sheet 18~~

~~N.I.C.
ECB-Eastbound
Sta. 162+20± Rt.
M.P.=0.0±
See Grading Plan
Sheet 18~~

~~N.I.C.
ECB-Eastbound
Sta. 180+22± Rt.
M.P.=17.2±
See Grading Plan
Sheet 19~~

~~N.I.C.
ECB-Westbound
Sta. 195+72± Lt.
M.P.=19.5±
See Grading Plan
Sheet 28~~

~~N.I.C.
ECB-Westbound
Sta. 217+57± Lt.
M.P.=21.7±
See Grading Plan
Sheet 28~~

~~N.I.C.
ECB-Westbound
Sta. 241+44± Lt.
M.P.=24.1±
See Grading Plan
Sheet 27~~

~~N.I.C.
ECB-Eastbound
Sta. 205+50± Rt.
M.P.=20.5±
See Grading Plan
Sheet 19~~

~~N.I.C.
ECB-Westbound
Sta. 47+94± Lt.
M.P.=0.0±
See Grading Plan
Sheet 27~~

~~N.I.C.
ECB-Eastbound
Sta. 244+05± Rt.
M.P.=24.4±
See Grading Plan
Sheet 19~~



~~N.I.C.
ECB-Eastbound
Sta. 47+50± Rt.
M.P.=0.0±
See Grading Plan
Sheet 20~~

~~N.I.C.
ECB-Eastbound
Sta. 25+45± Rt.
M.P.=0.0±
See Grading Plan
Sheet 20~~

~~N.I.C.
ECB-Westbound
Sta. 267+22± Lt.
M.P.=26.7±
See Grading Plan
Sheet 27~~

~~N.I.C.
ECB-Eastbound
Sta. 267+97± Rt.
M.P.=26.8±
See Grading Plan
Sheet 19~~

SURVEY PLOTTED BY	DATE
DRAWN BY	
DESIGNED BY	
QUANTITIES BY	
CHECKED BY	
ORIGINAL PLAN	
NOTE BOOK	
No.	

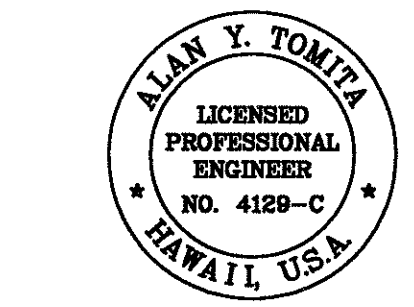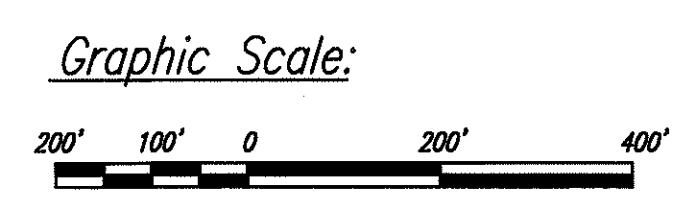

THIS WORK WAS PREPARED BY ME
OR UNDER MY SUPERVISION.

Alan Y. Tomita

STATE OF HAWAII
DEPARTMENT OF TRANSPORTATION
HIGHWAYS DIVISION


**INTERSTATE ROUTE H-1
GENERAL PLAN**

**INTERSTATE ROUTE H-1
EMERGENCY TELEPHONE ACCESSIBLE ROUTES**
F.A. Project No. NH-300(86)R

Scale: As Shown Date: September 2003

SHEET No. 2 OF 4 SHEETS

FED. ROAD DIST. NO.	STATE	FED. AID. PROJ. NO.	FISCAL YEAR	SHEET NO.	TOTAL SHEETS
HAWAII	HAW.	NH-300(86)R	2004	16	45

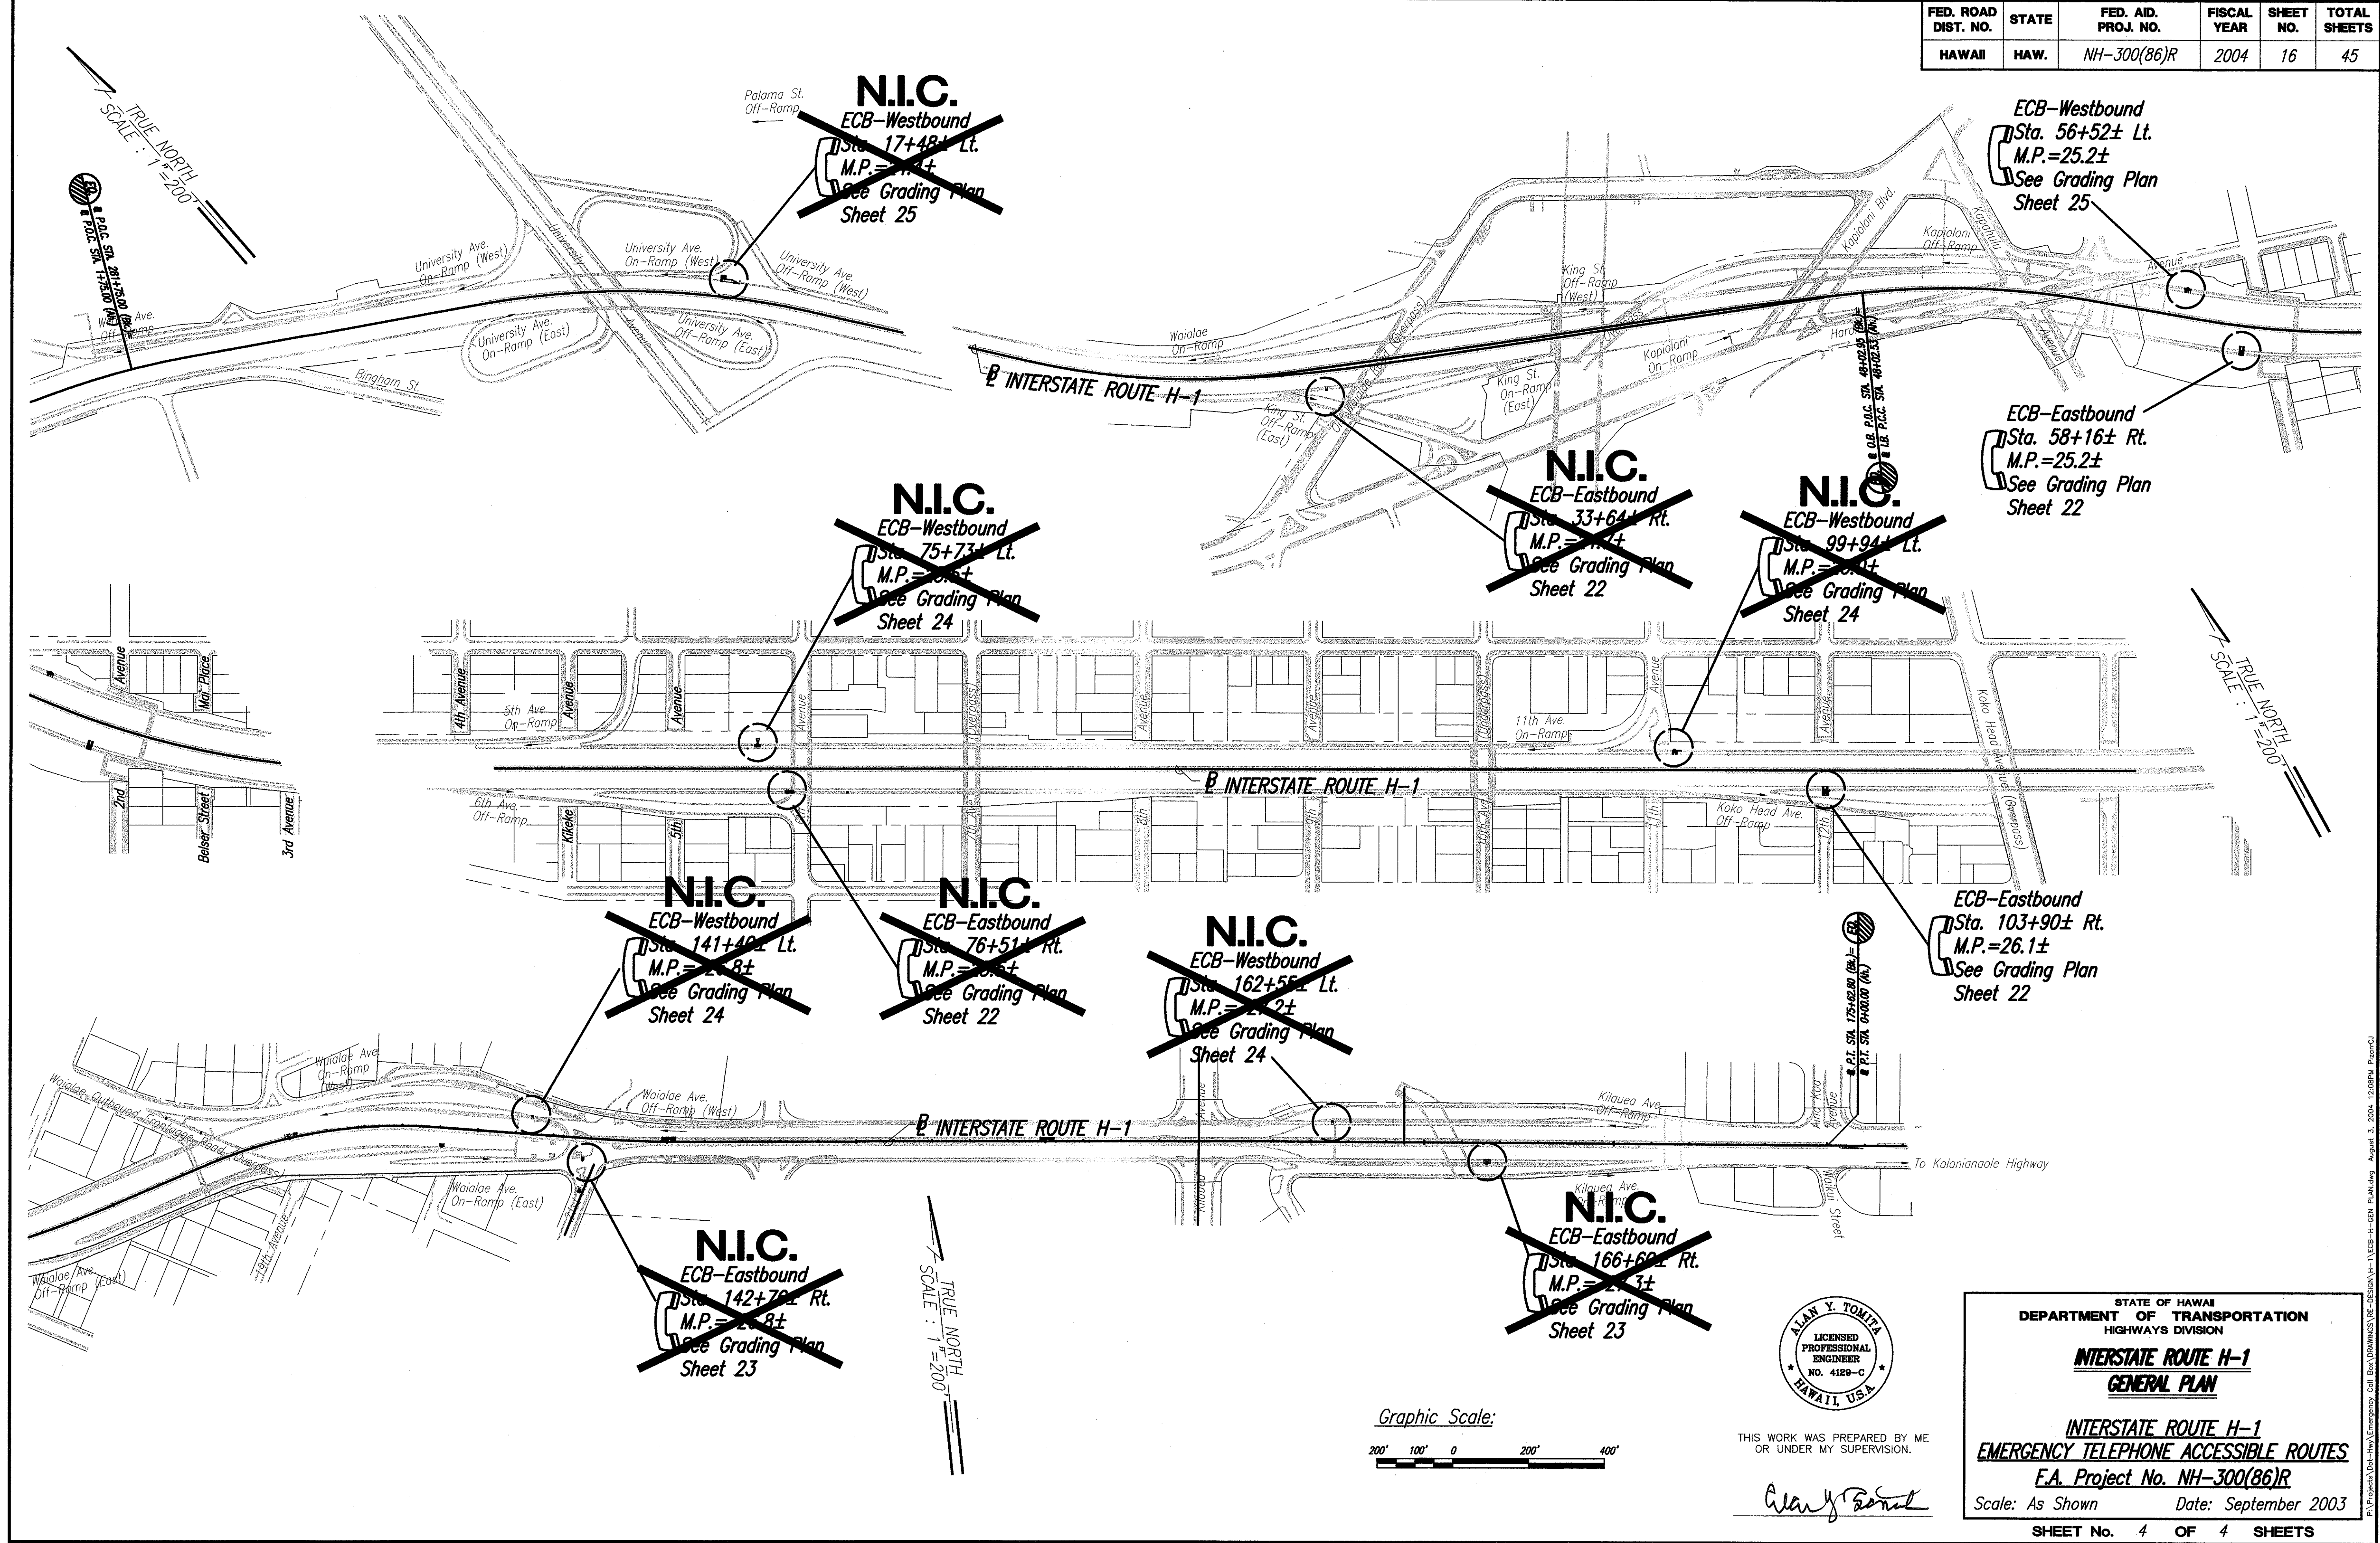

SURVEY PLOTTED BY	DATE
DRAWN BY	
DESIGNED BY	
QUANTITIES BY	
CHECKED BY	
ORIGINAL PLAN	
NOTE BOOK	
NO.	