

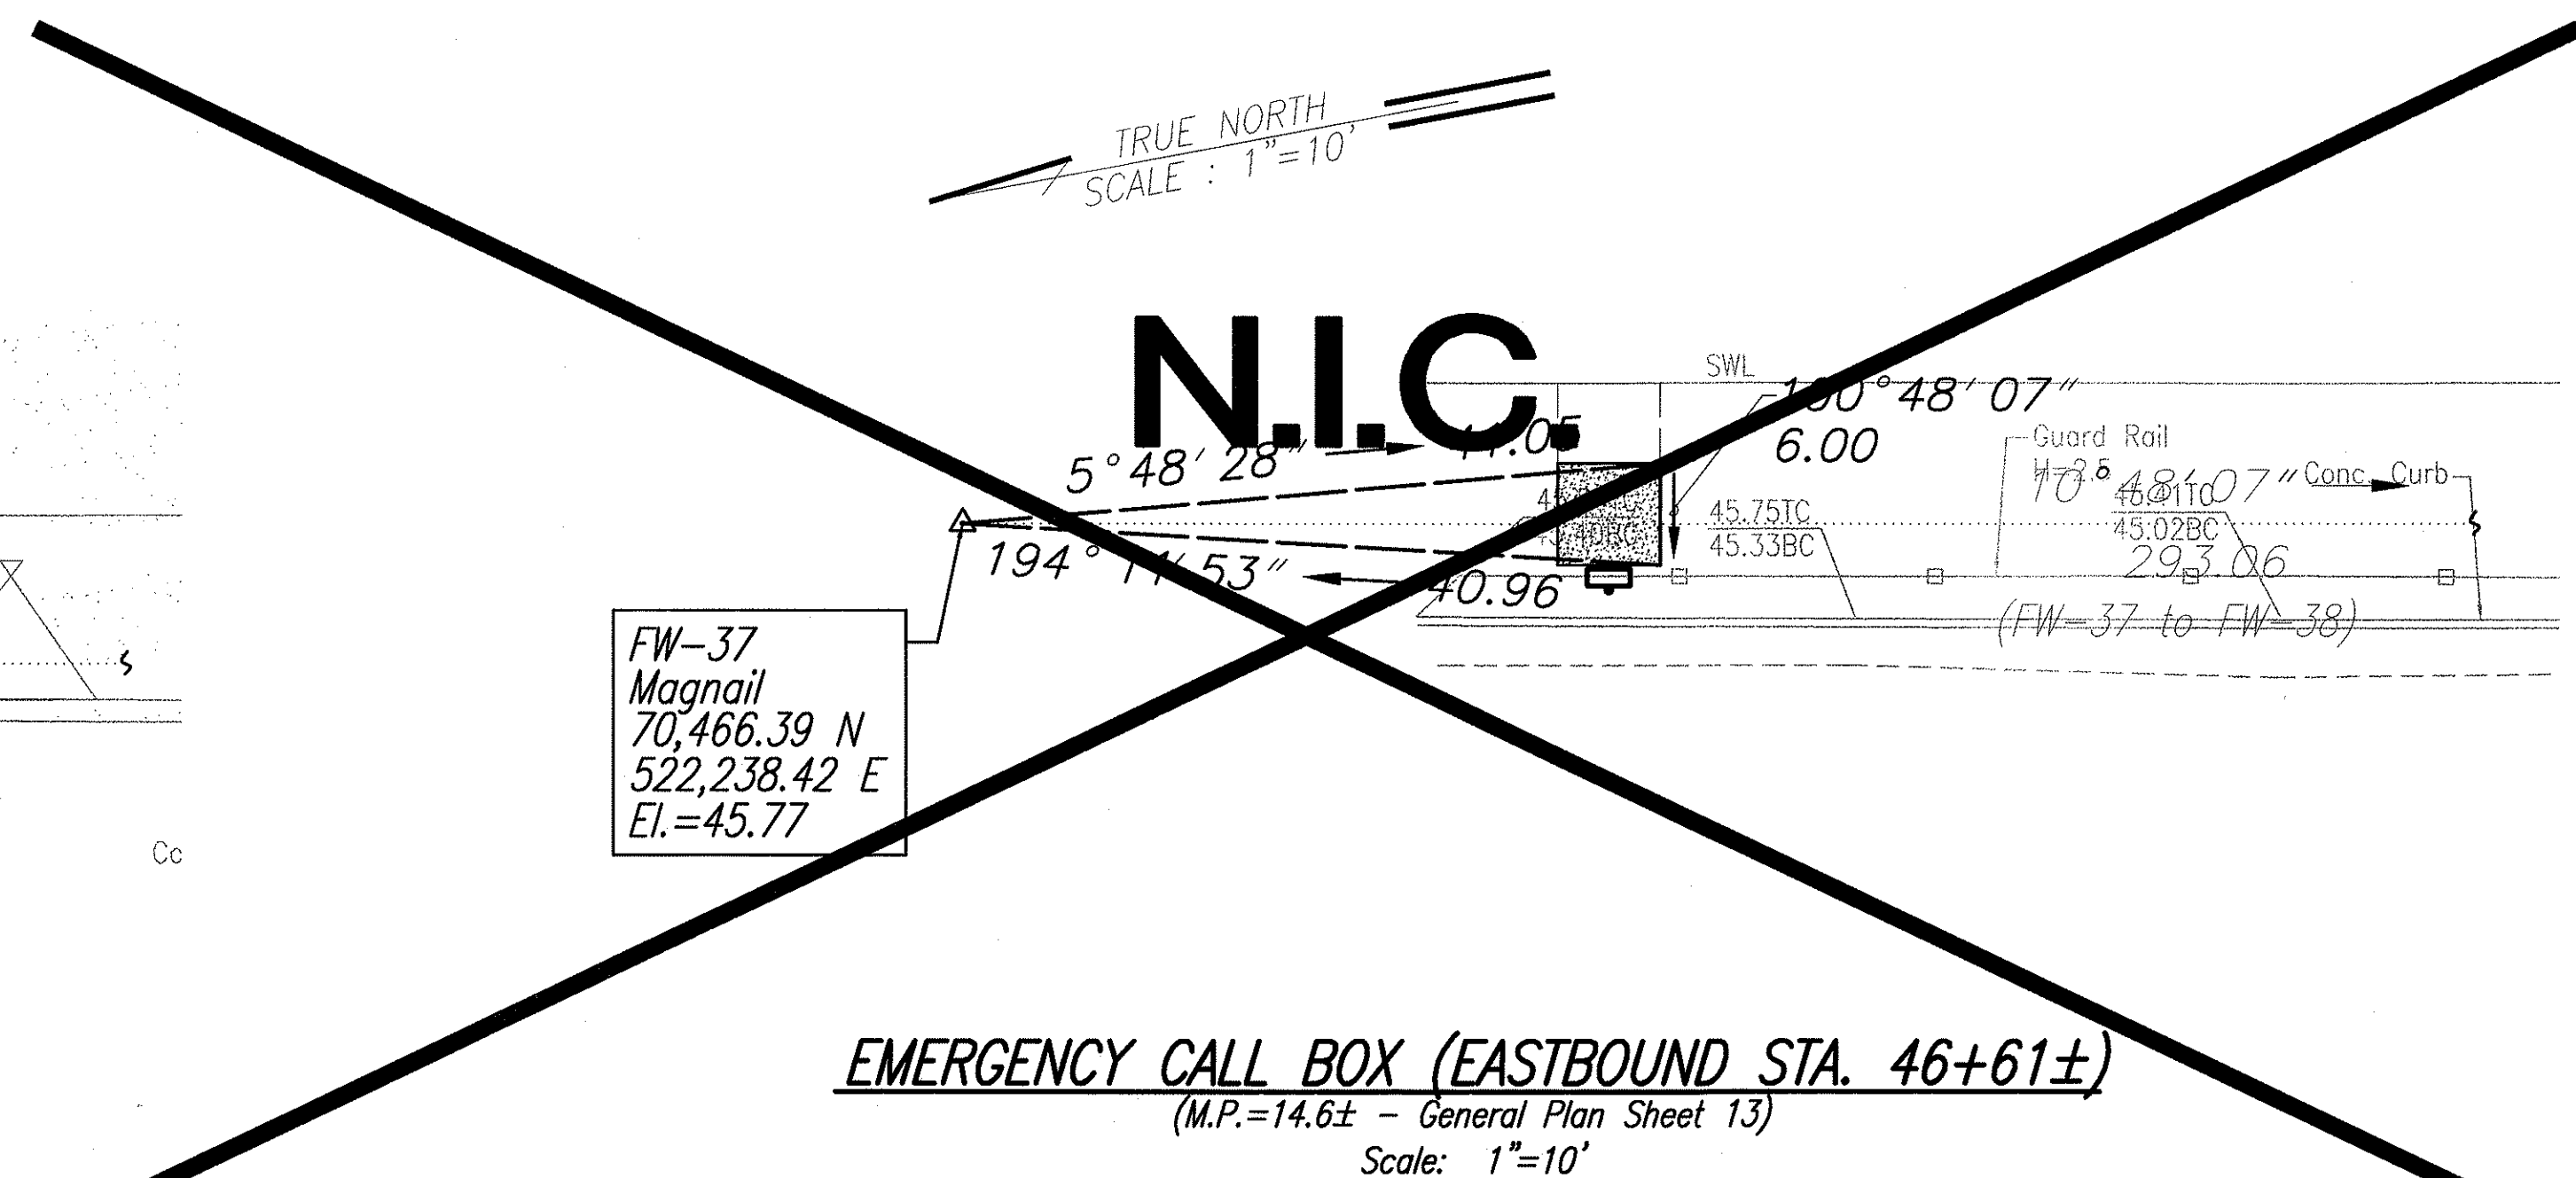
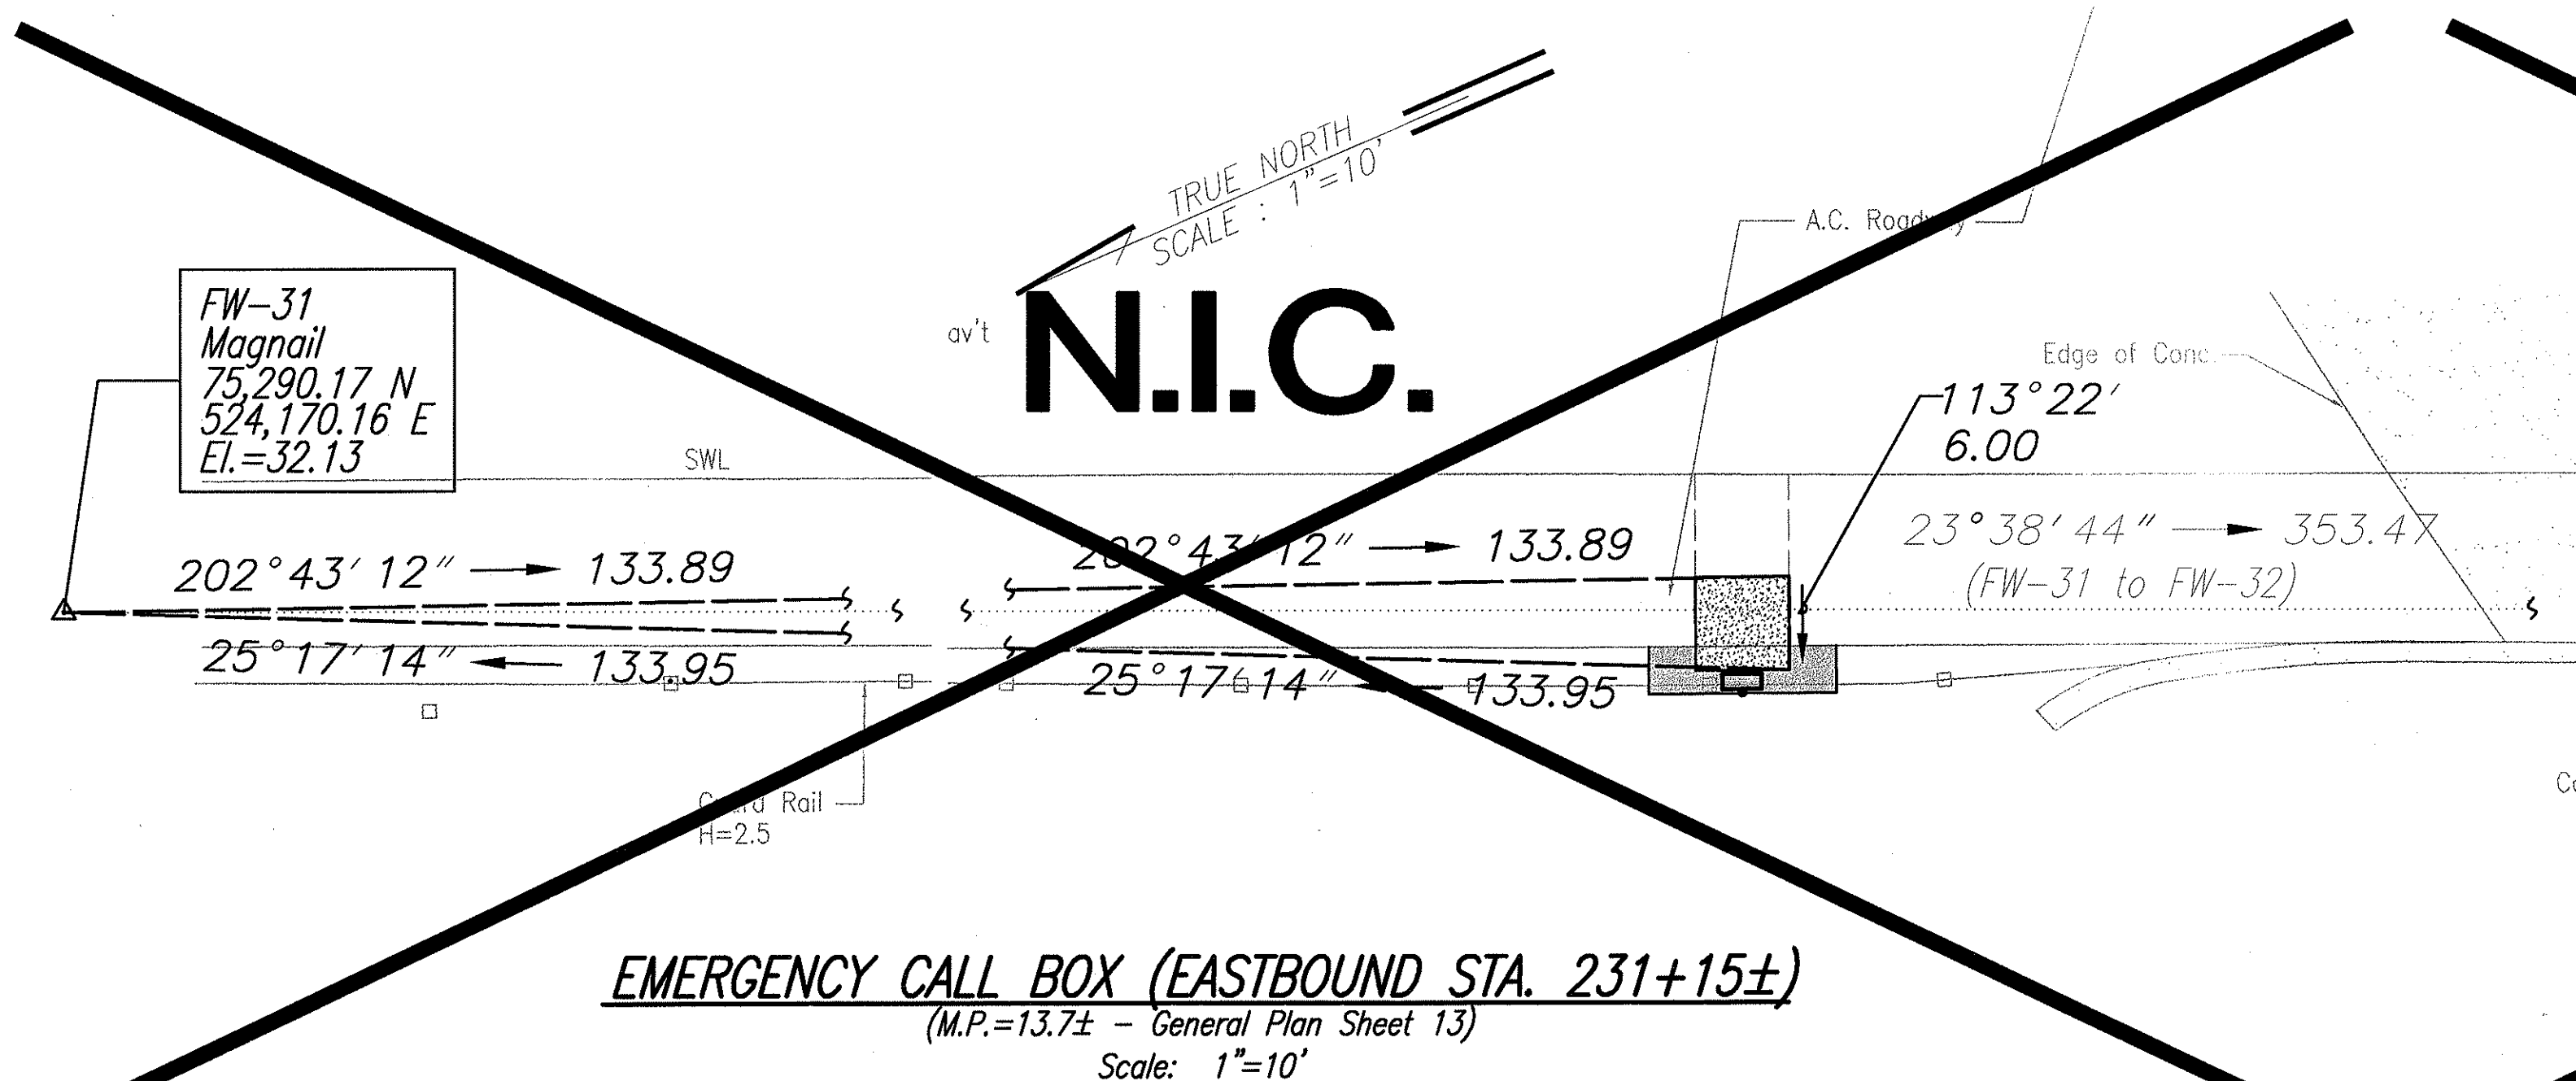
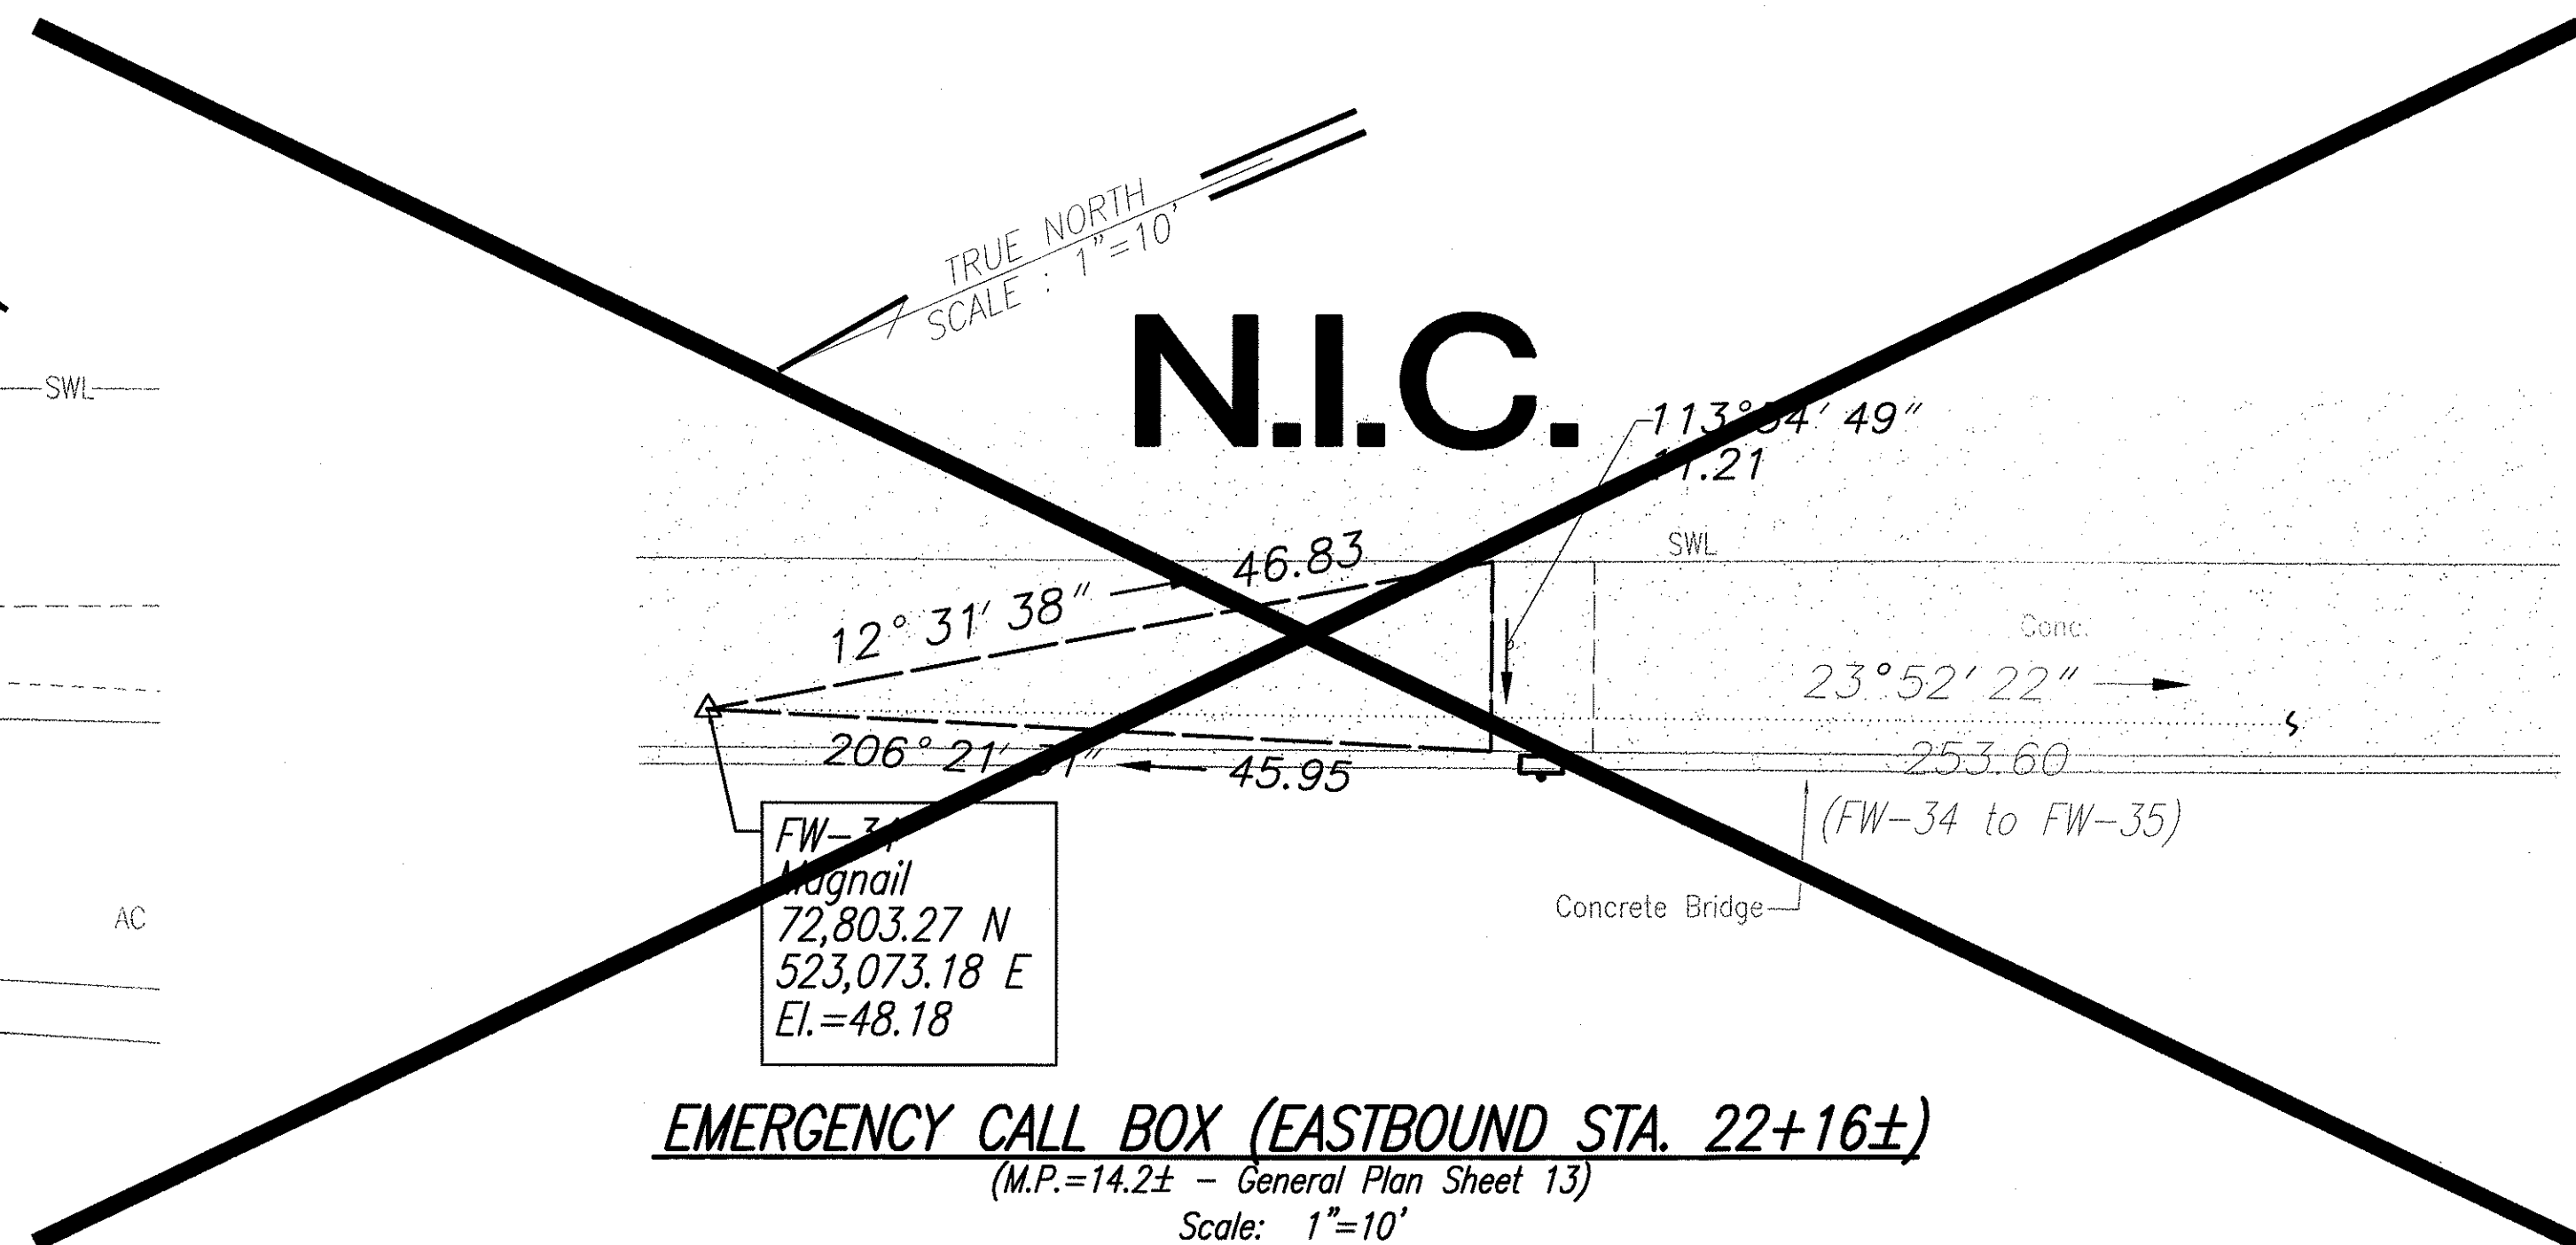
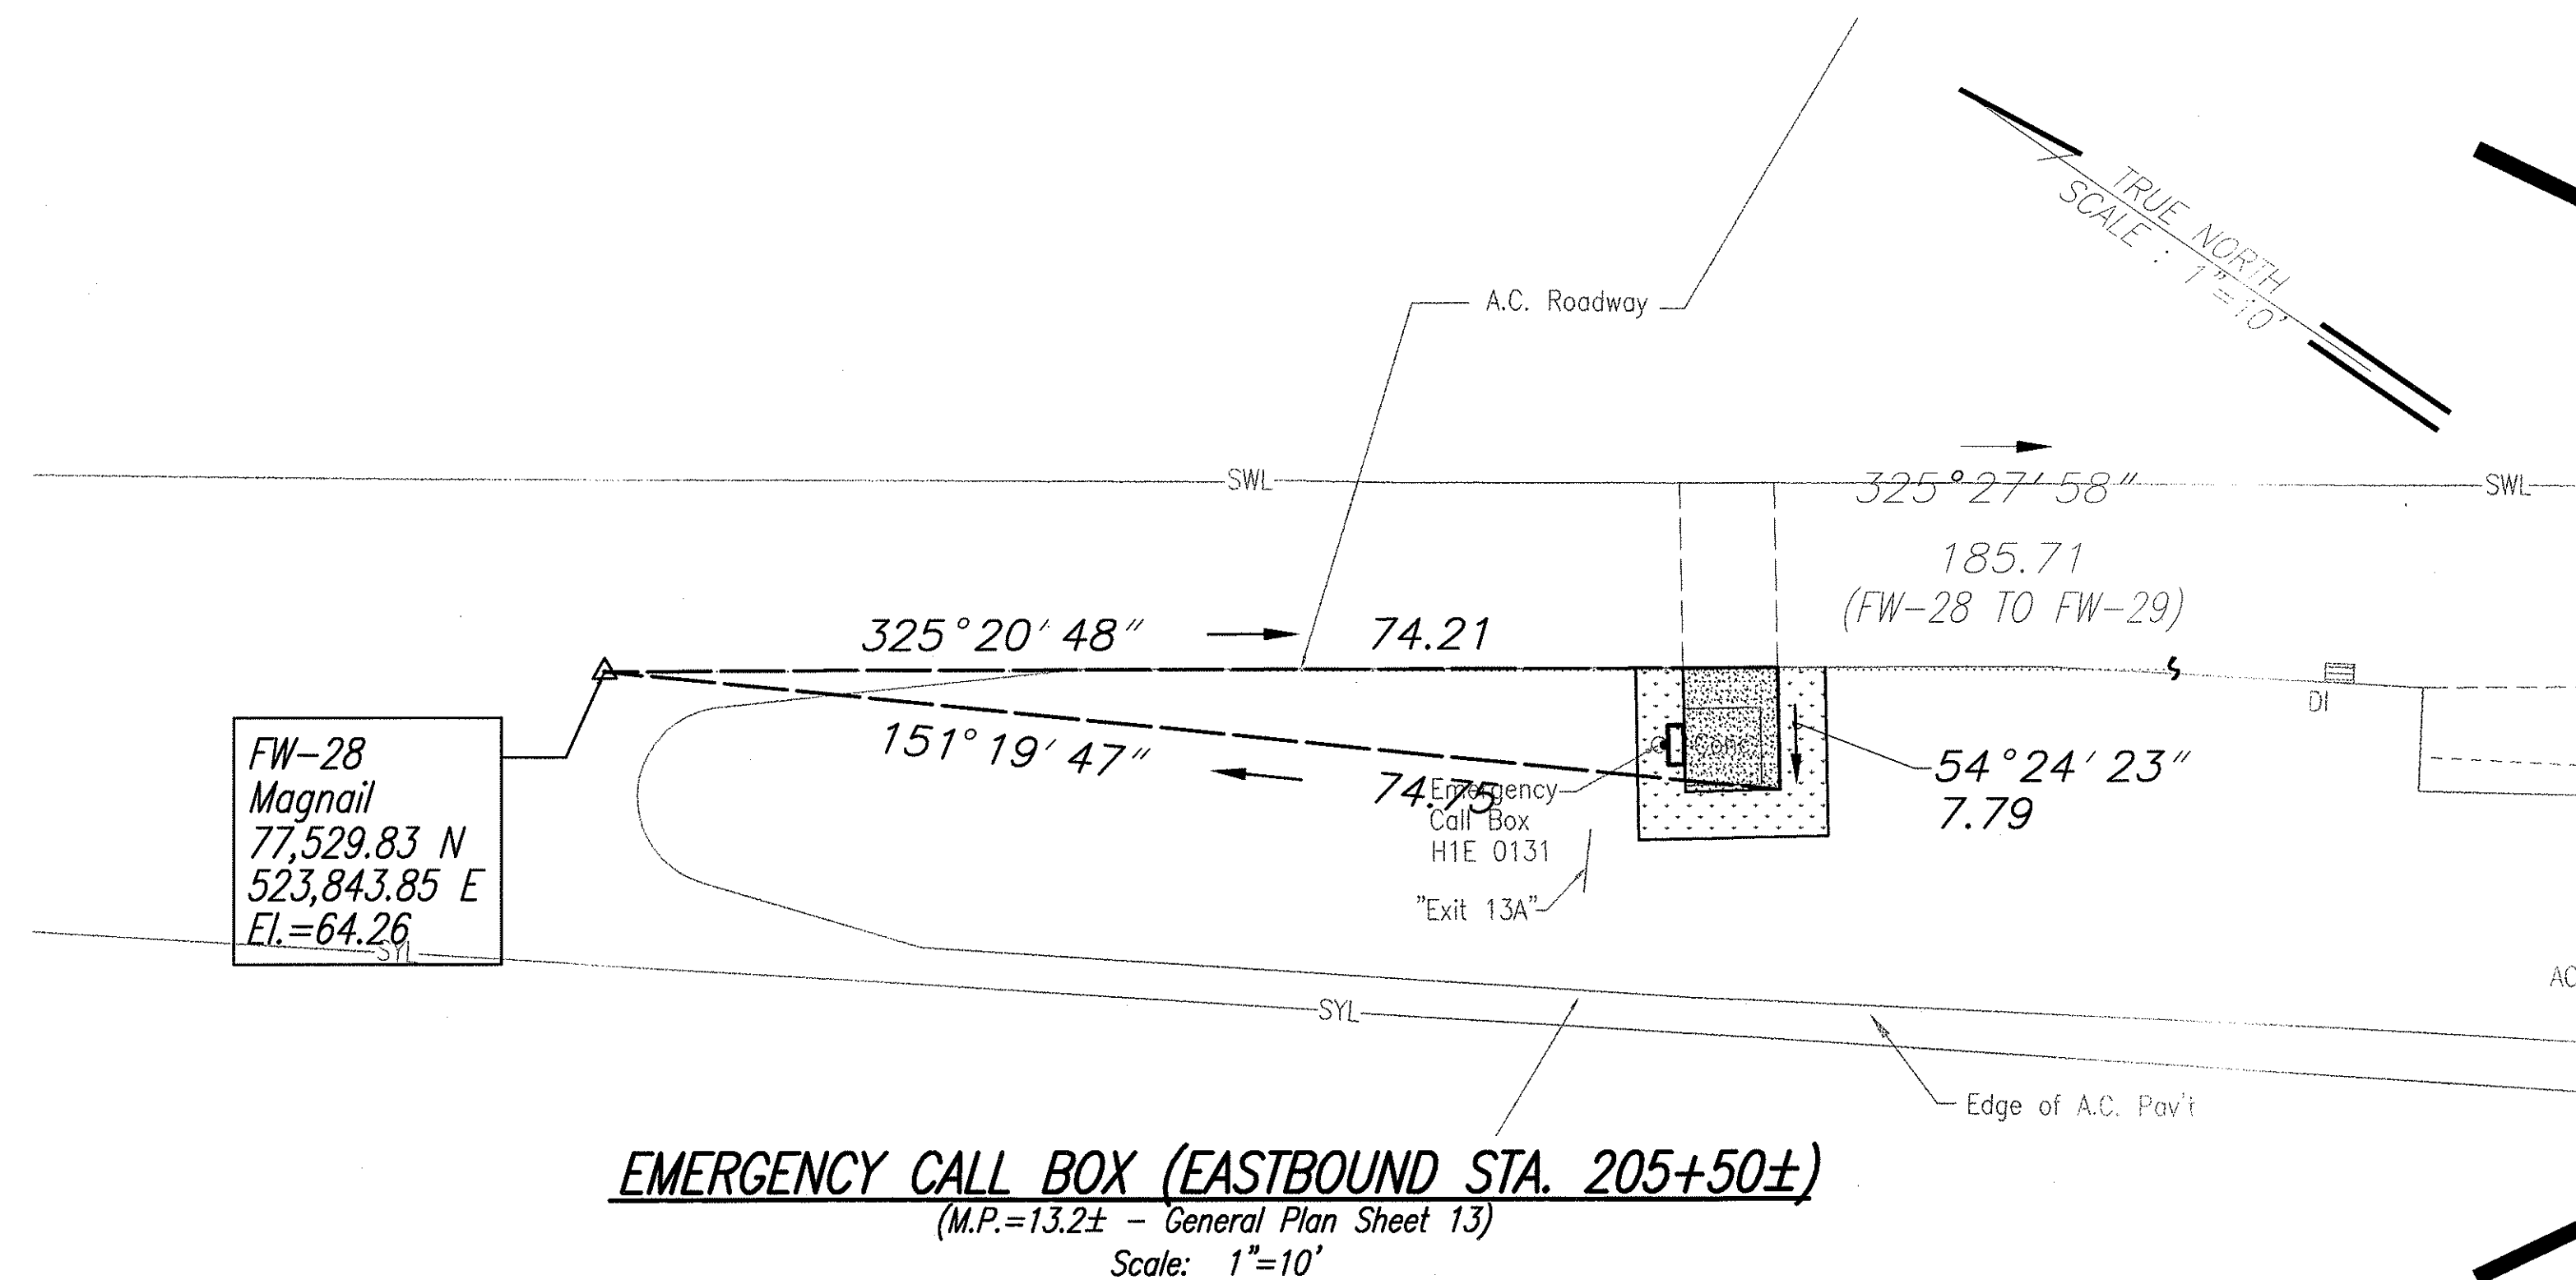


FED. ROAD DIST. NO.	STATE	FED. AID. PROJ. NO.	FISCAL YEAR	SHEET NO.	TOTAL SHEETS
HAWAII	HAW.	NH-300(86)R	2004	31	45

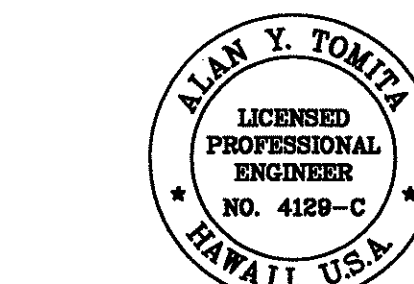

SURVEY PLOTTED BY	DATE
DRAWN BY	
DESIGNED BY	
QUANTITIES BY	
CHECKED BY	
ORIGINAL PLAN	
NOTE BOOK	
No.	

Note:
Coordinates and azimuths
referenced to State Plane
Coordinate System Hawaii Zone 3,
Nad 1927.

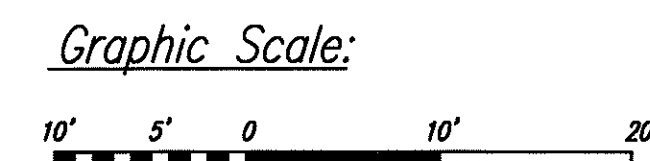

THIS WORK WAS PREPARED BY ME
OR UNDER MY SUPERVISION.

Alan Y. Tomita

STATE OF HAWAII
DEPARTMENT OF TRANSPORTATION
HIGHWAYS DIVISION

**INTERSTATE ROUTE H-1
PAD TIEDOWN-EASTBOUND**





**INTERSTATE ROUTE H-1
EMERGENCY TELEPHONE ACCESSIBLE ROUTES**
F.A. Project No. NH-300(86)R

Scale: As Shown Date: September 2003

SHEET No. 1 OF 7 SHEETS



P:\Projects\dot-hwy\Emergency Call Box\DRAWINGS\RE-DESIGN\H-1\ECB-H-TIES.dwg September 11, 2003 11:40AM Rfzrncd

FED. ROAD DIST. NO.	STATE	FED. AID. PROJ. NO.	FISCAL YEAR	SHEET NO.	TOTAL SHEETS
HAWAII	HAW.	NH-300(86)R	2004	32	45

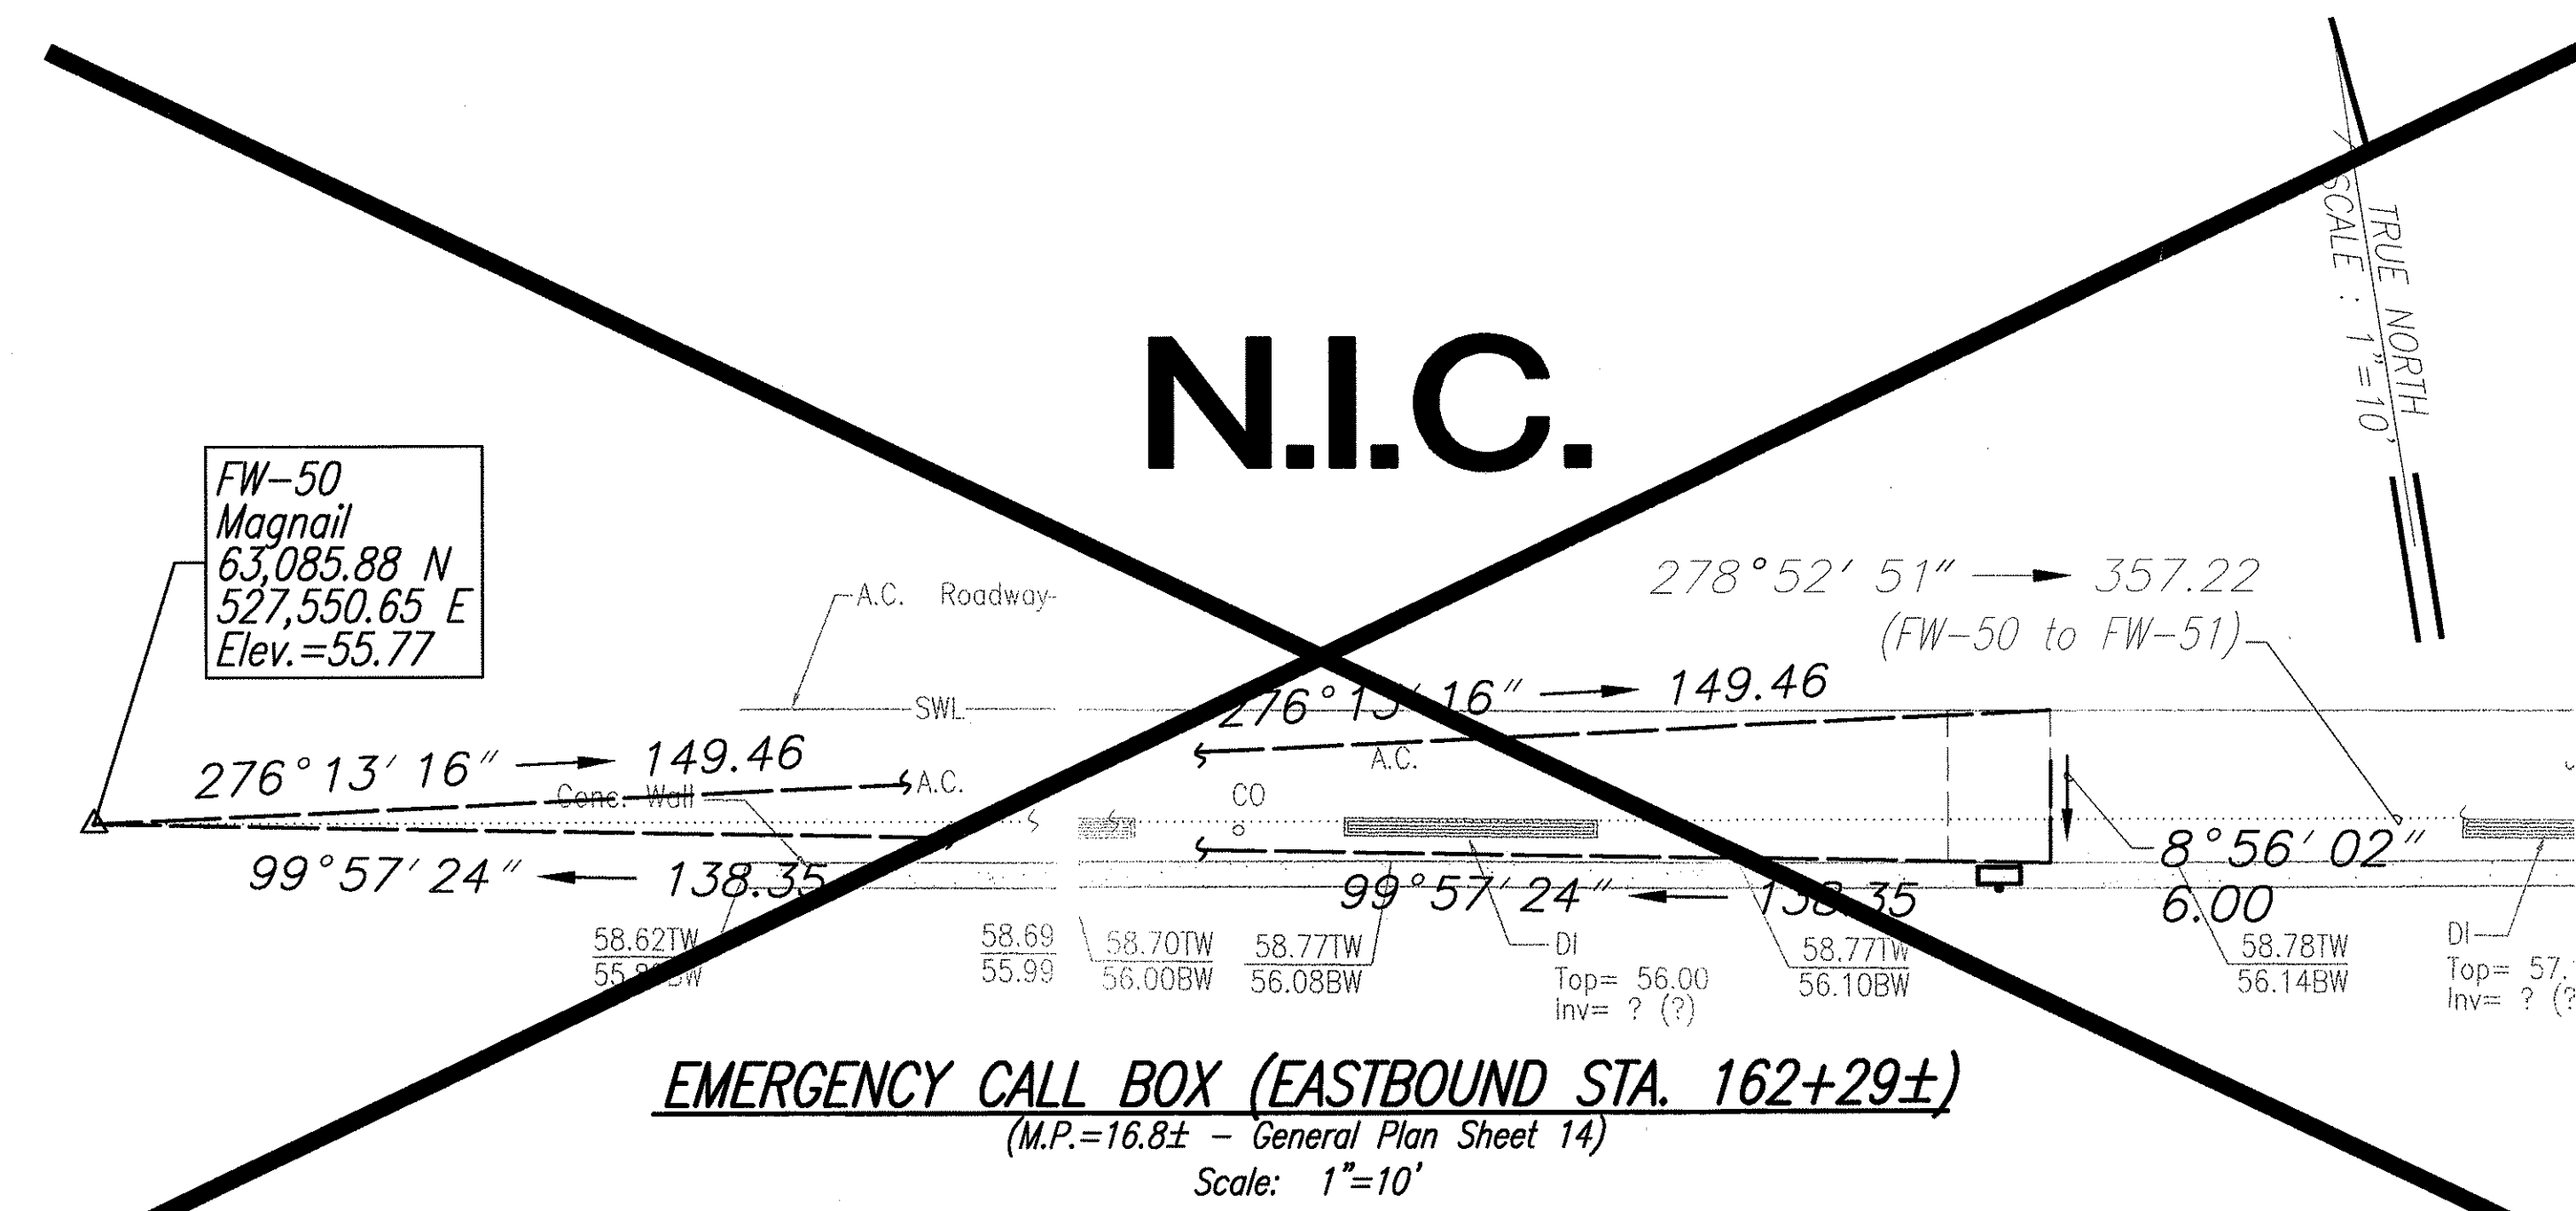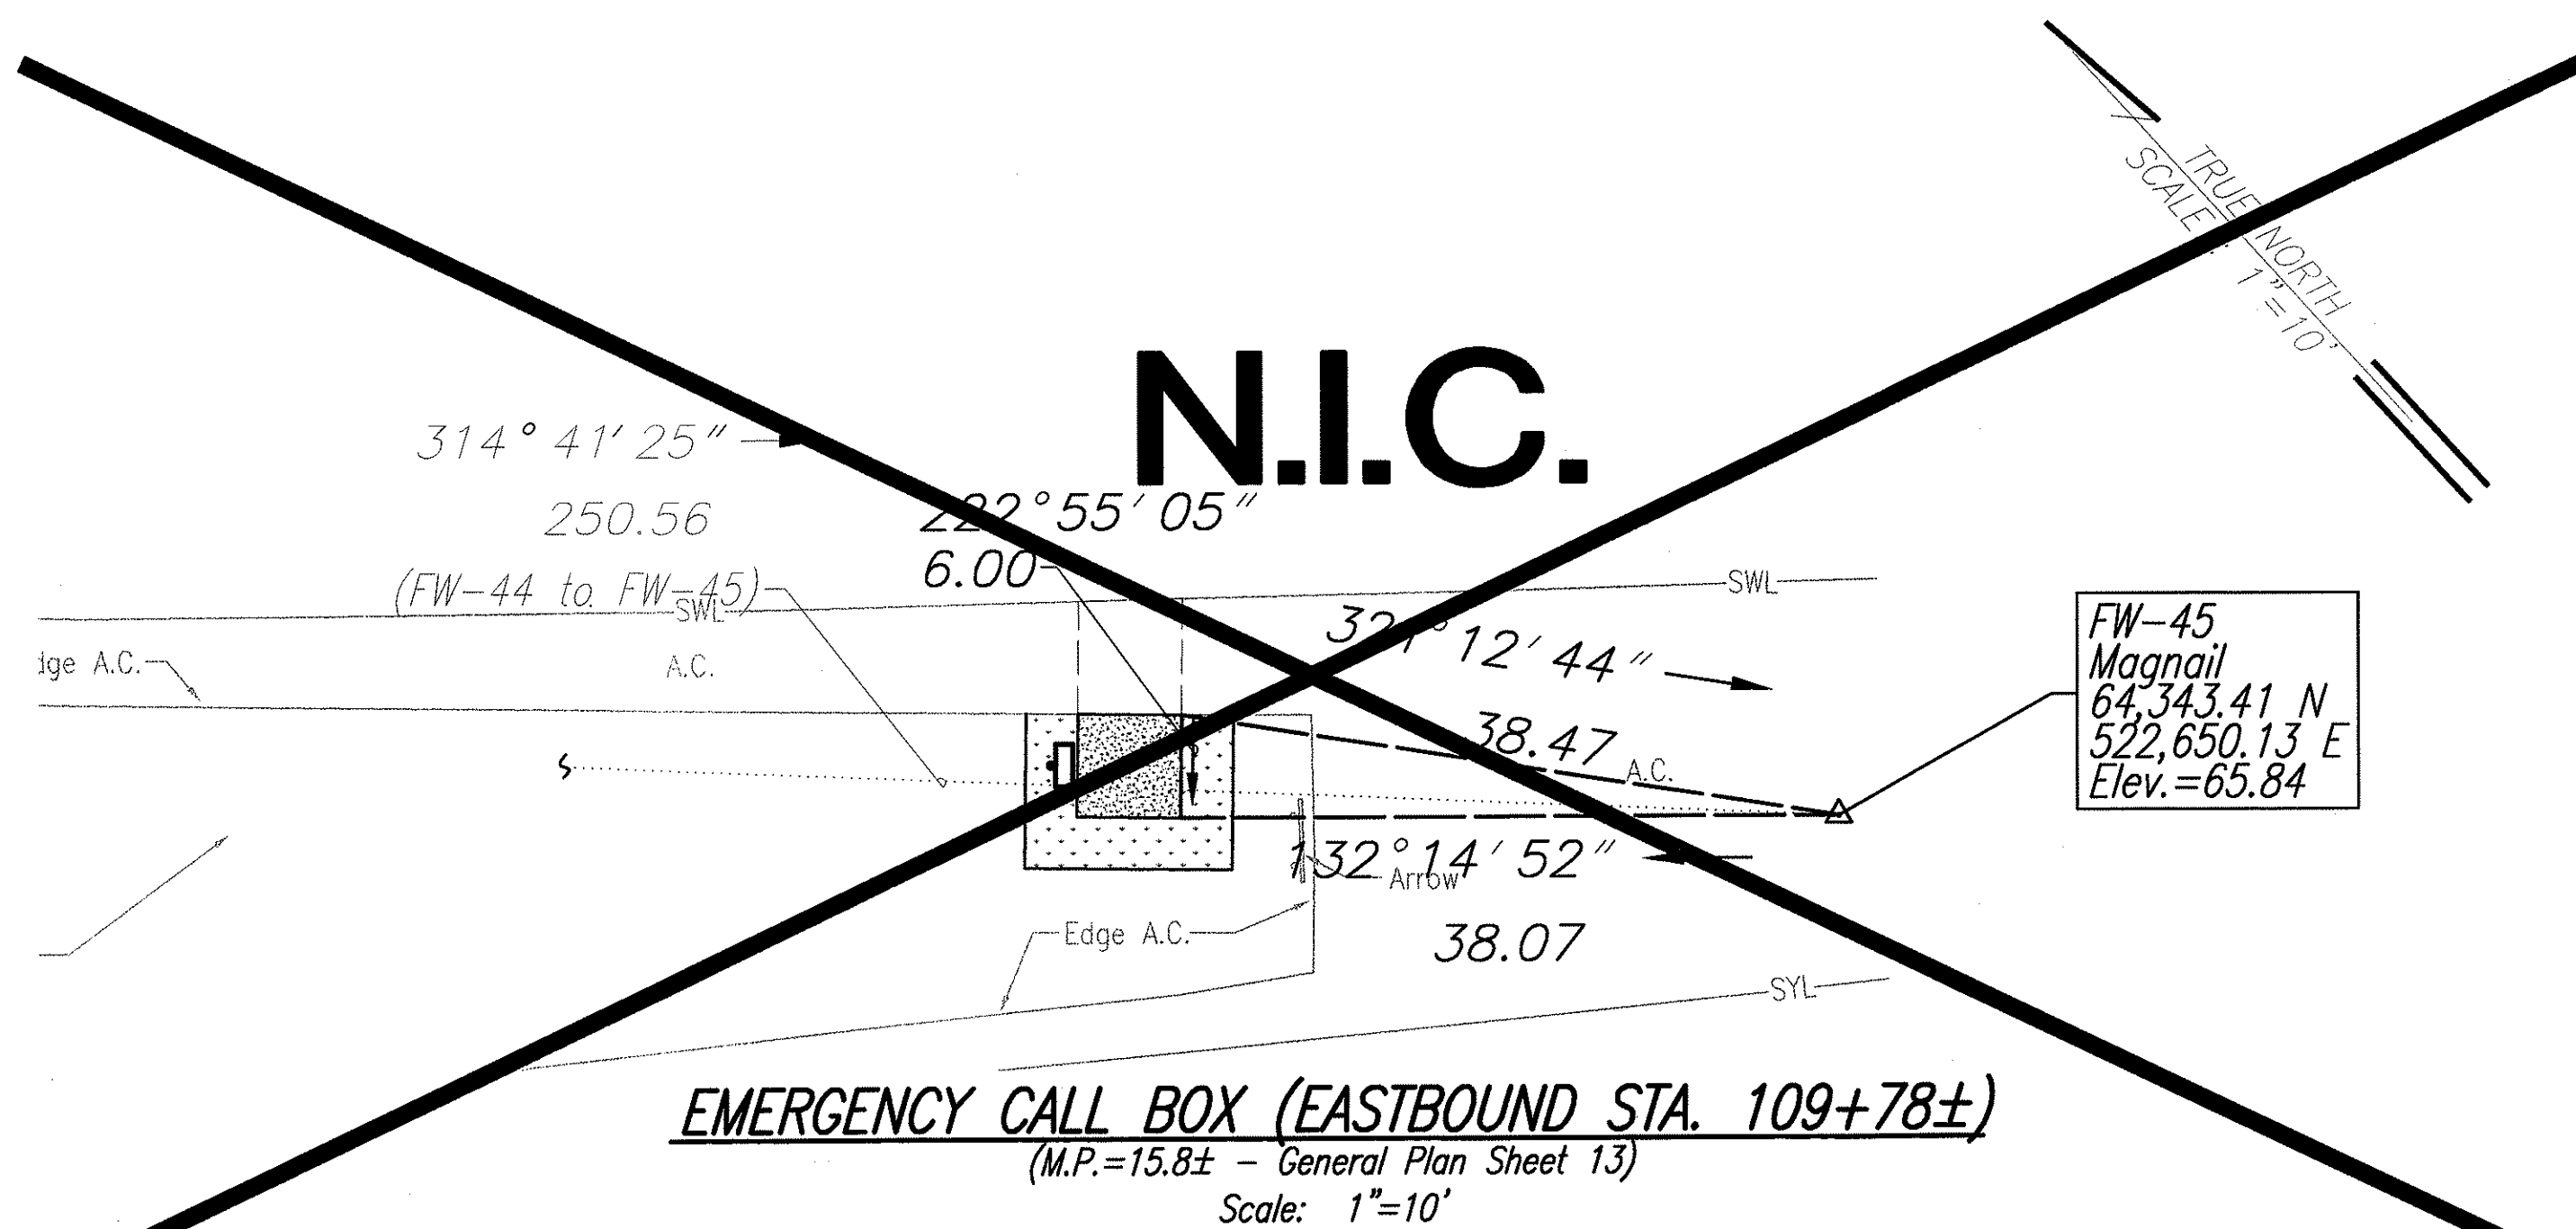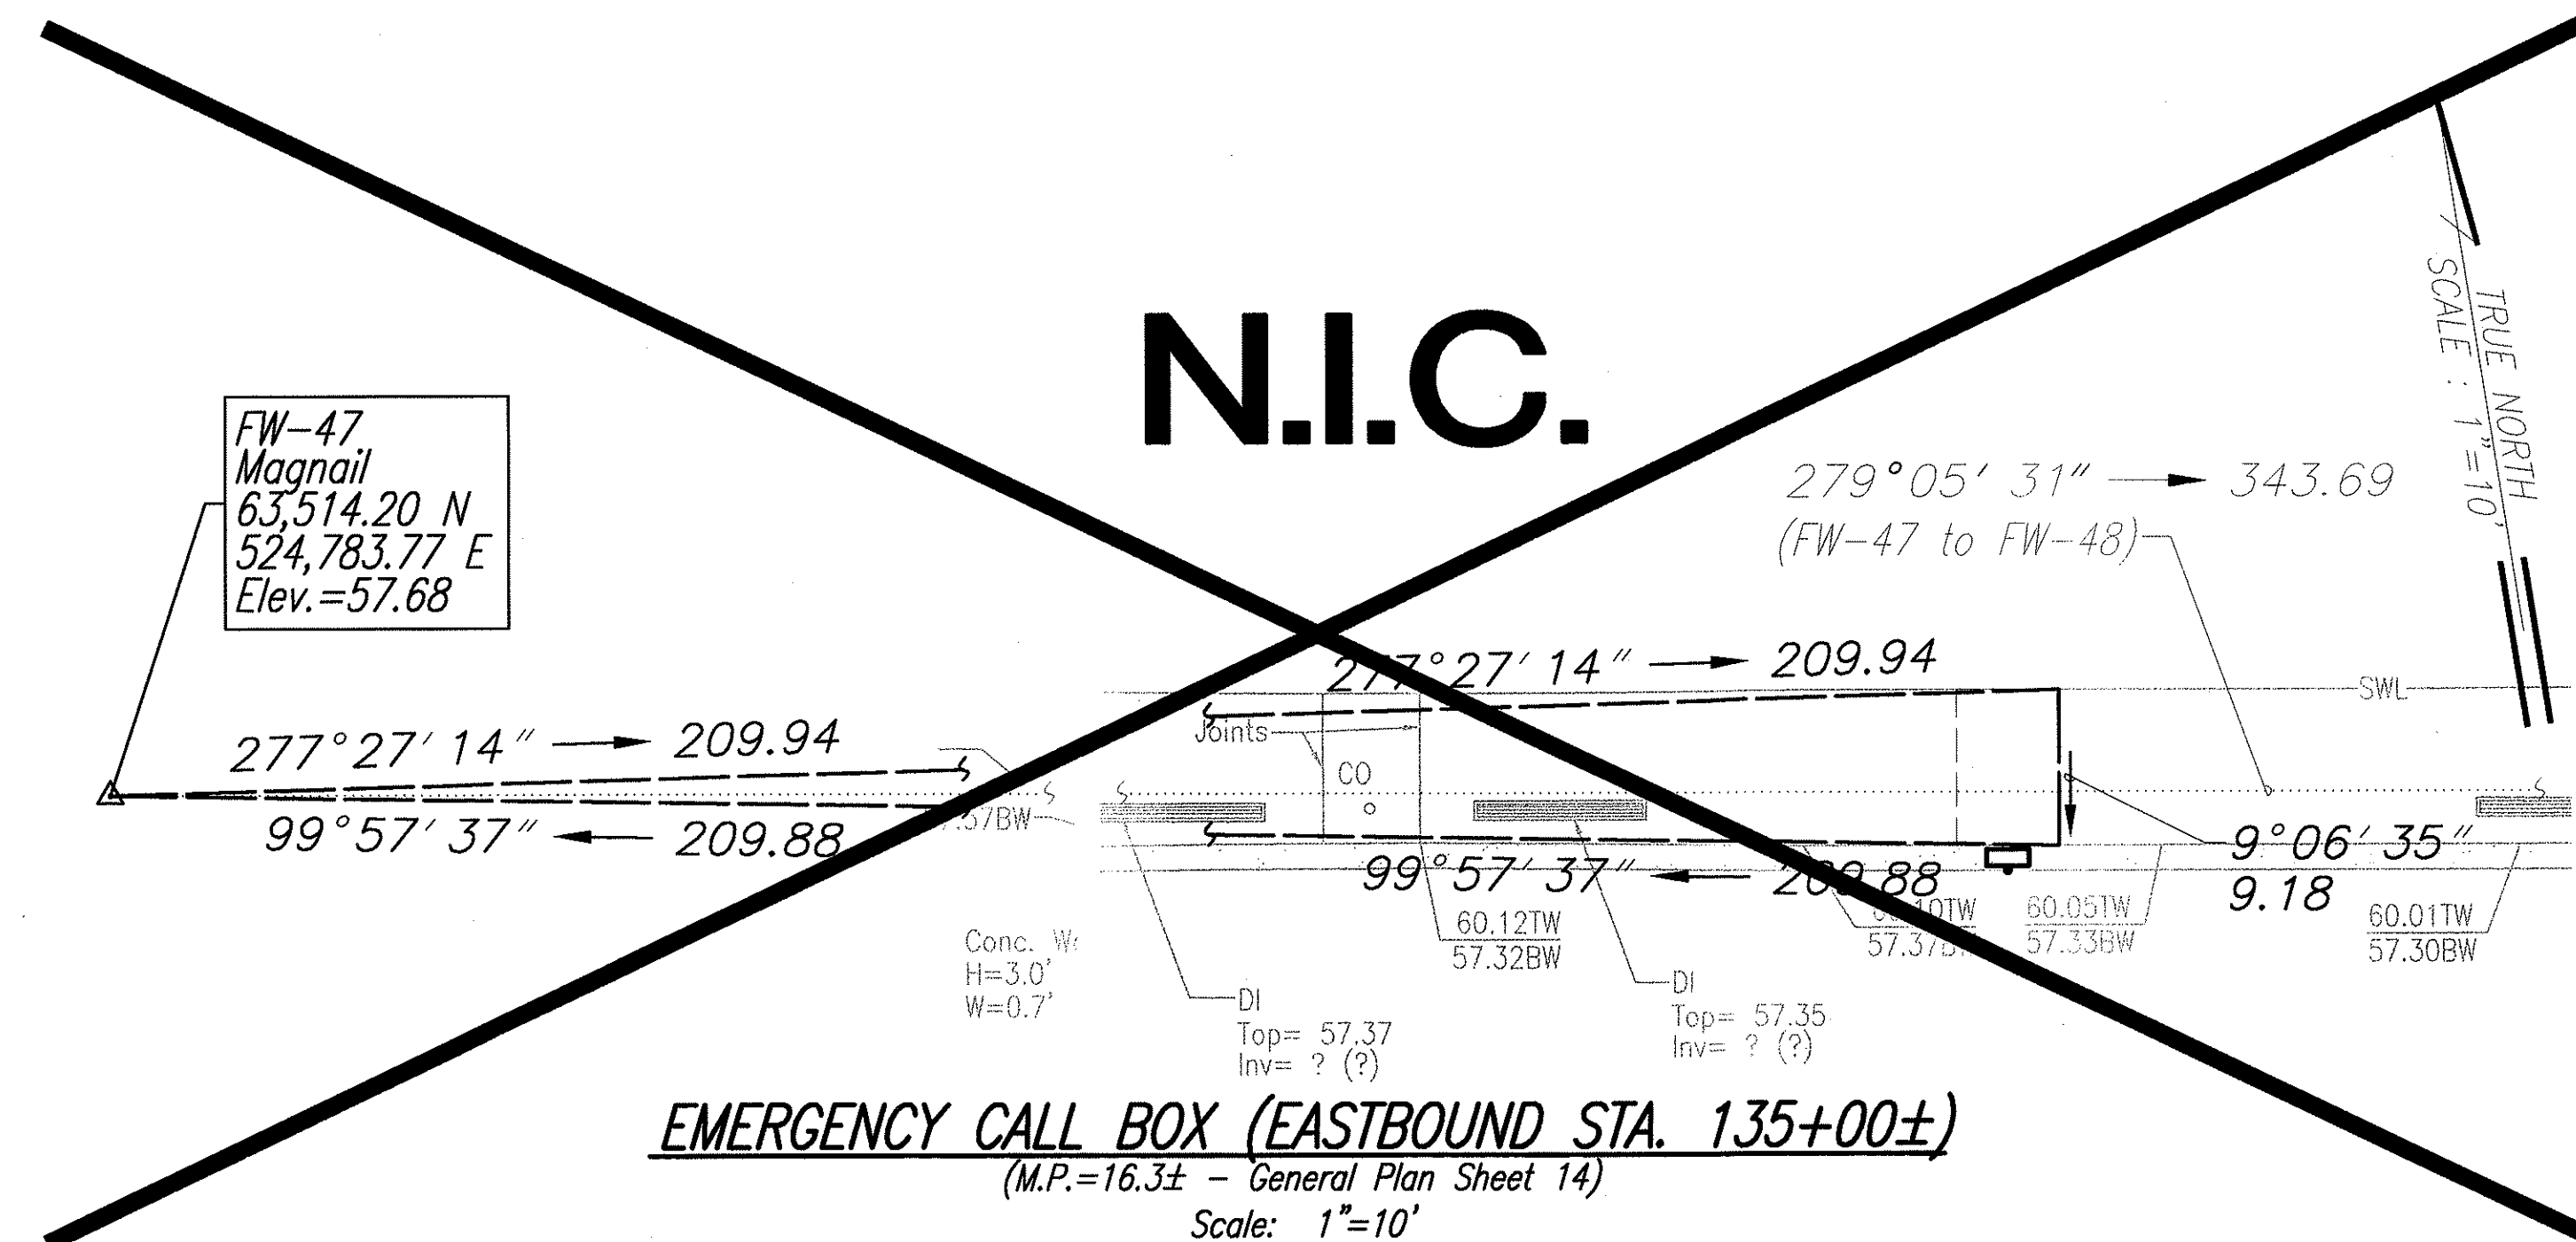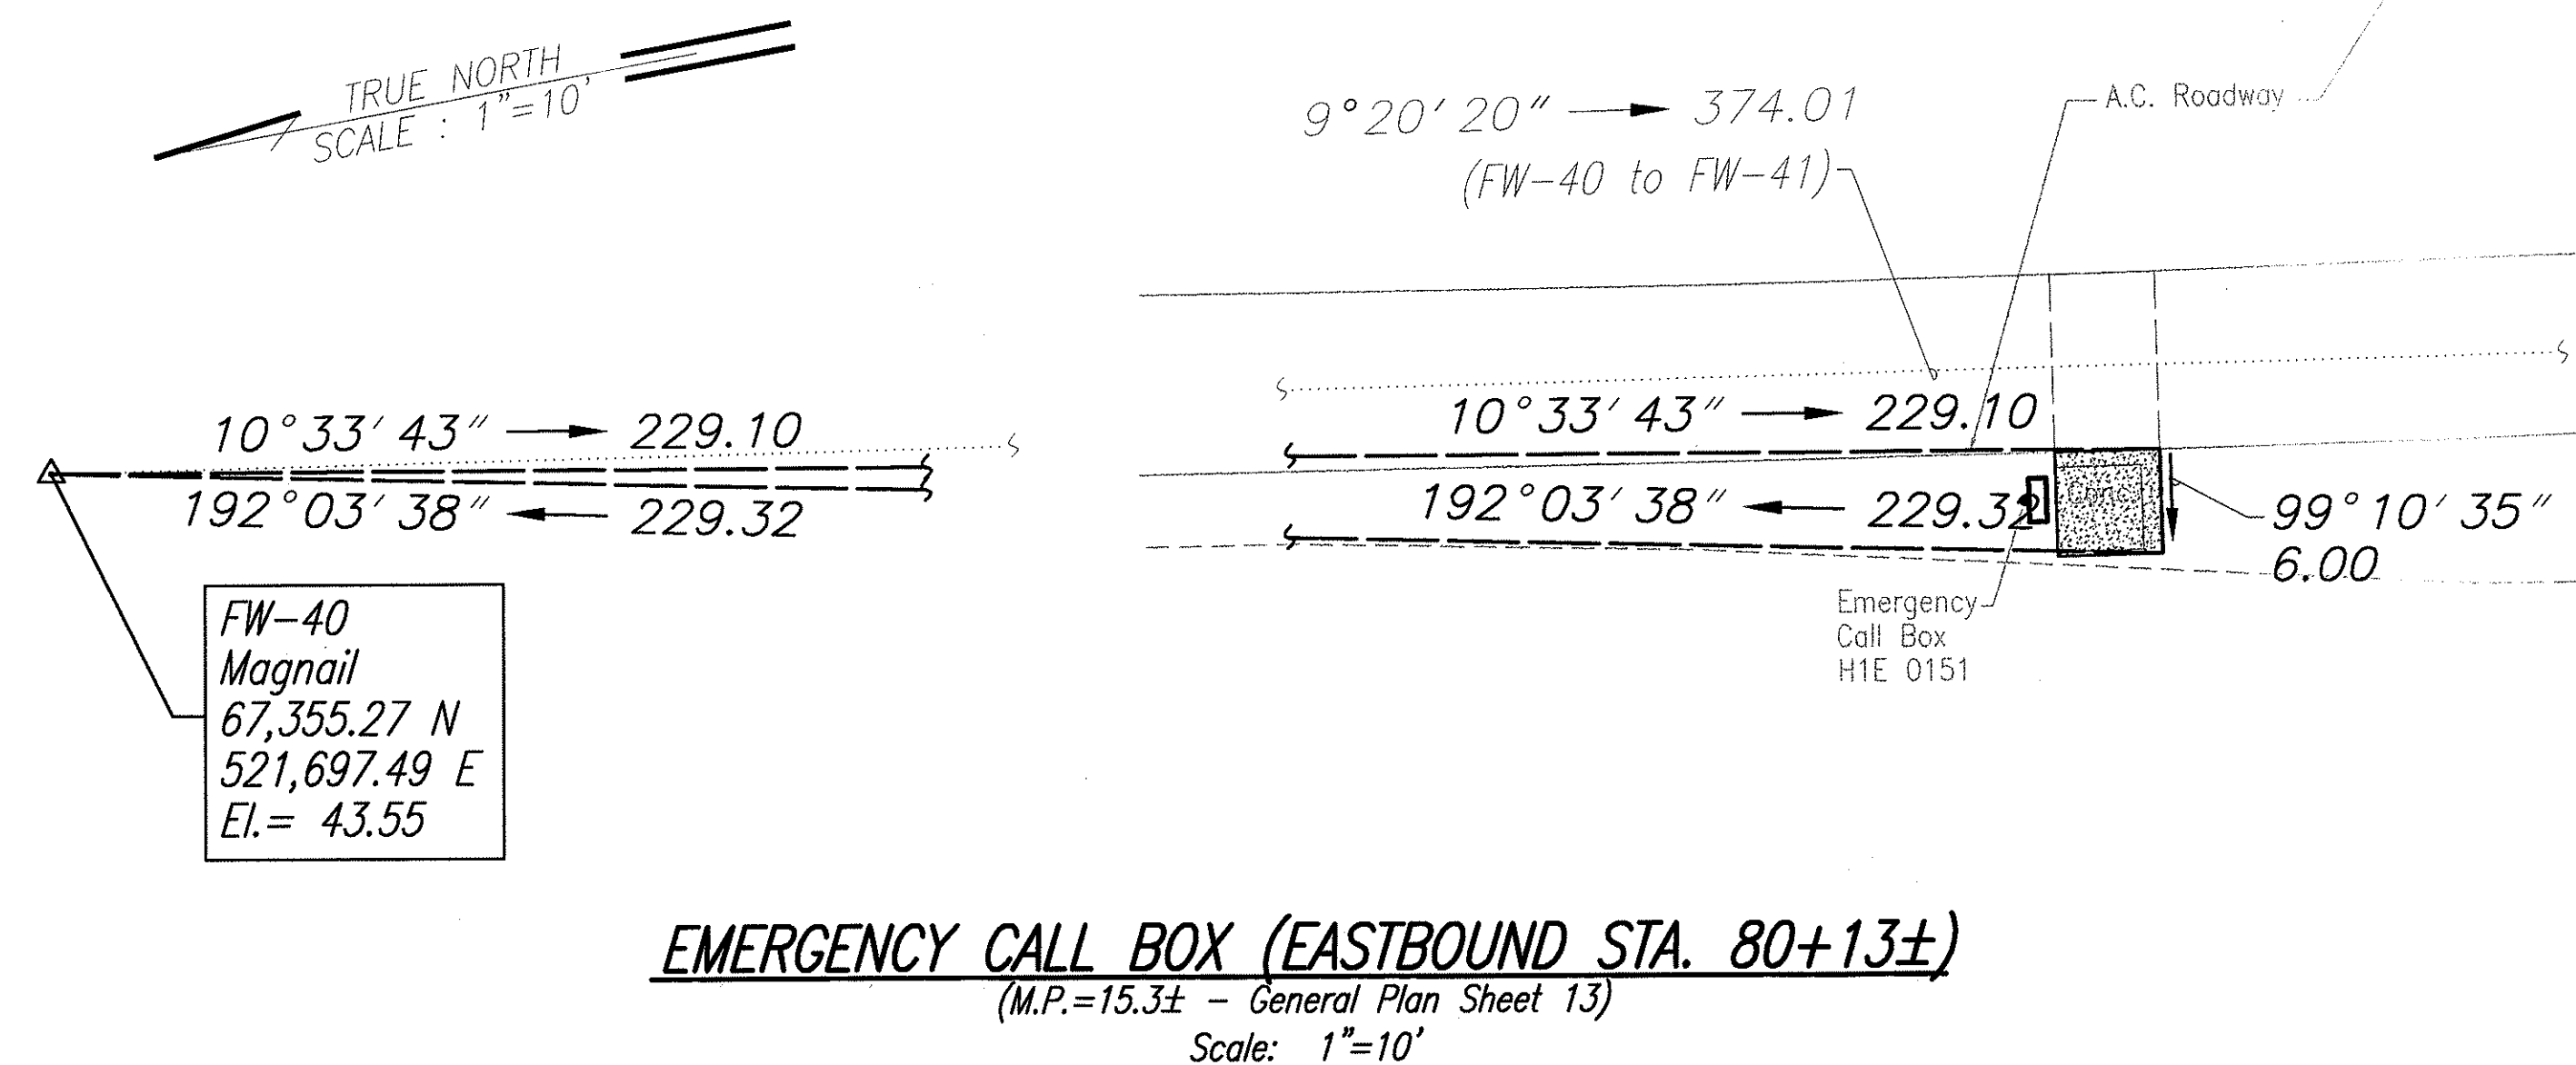

SURVEY PLOTTED BY	DATE
DRAWN BY	
TRACED BY	
CHECKED BY	
NOTE BOOK	
No.	

Note:
Coordinates and azimuths
referenced to State Plane
Coordinate System Hawaii Zone 3,
Nad 1927.

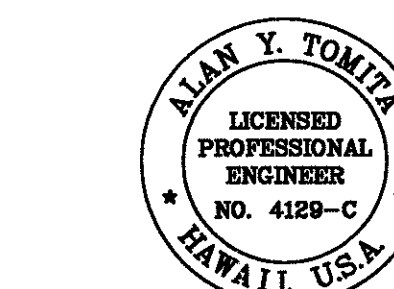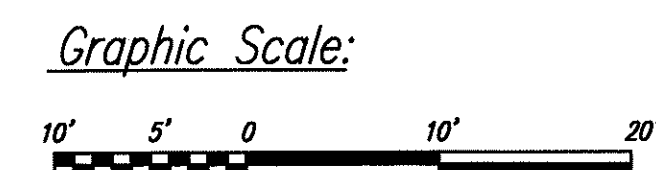

THIS WORK WAS PREPARED BY ME
OR UNDER MY SUPERVISION.

Alan Y. Tomita





STATE OF HAWAII
DEPARTMENT OF TRANSPORTATION
HIGHWAYS DIVISION

**INTERSTATE ROUTE H-1
PAD TIEDOWN-EASTBOUND**

**INTERSTATE ROUTE H-1
EMERGENCY TELEPHONE ACCESSIBLE ROUTES**
E.A. Project No. NH-300(86)R
Scale: As Shown Date: September 2003

SHEET No. 2 OF 7 SHEETS


FED. ROAD DIST. NO.	STATE	FED. AID. PROJ. NO.	FISCAL YEAR	SHEET NO.	TOTAL SHEETS
HAWAII	HAW.	NH-300(86)R	2004	33	45

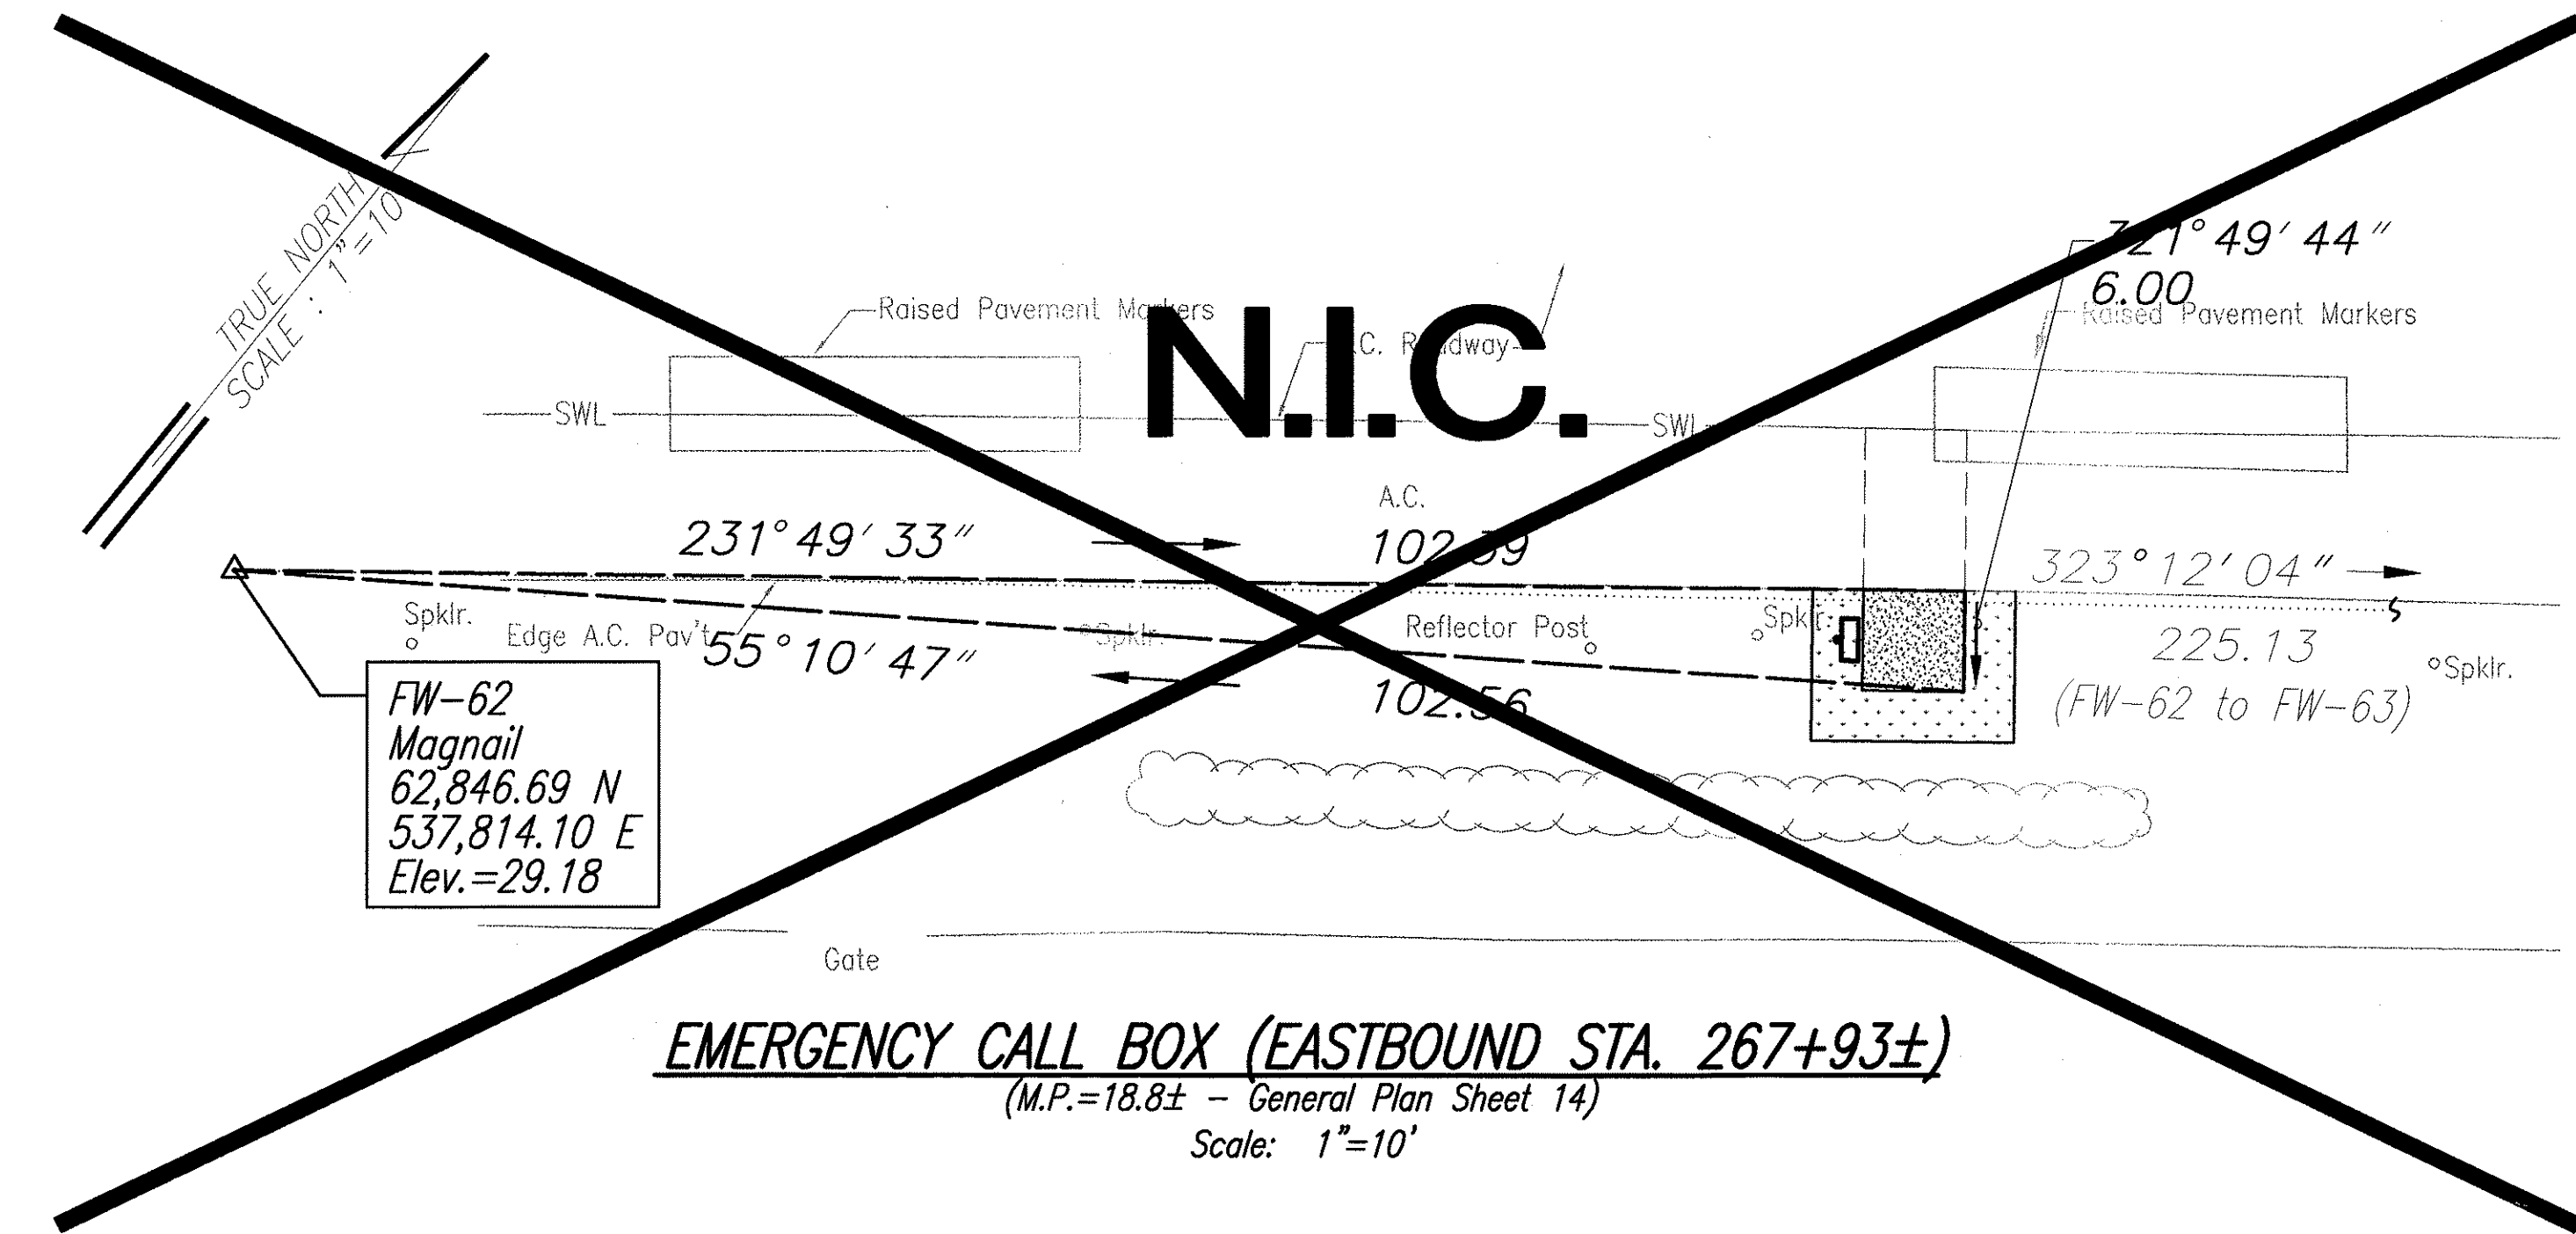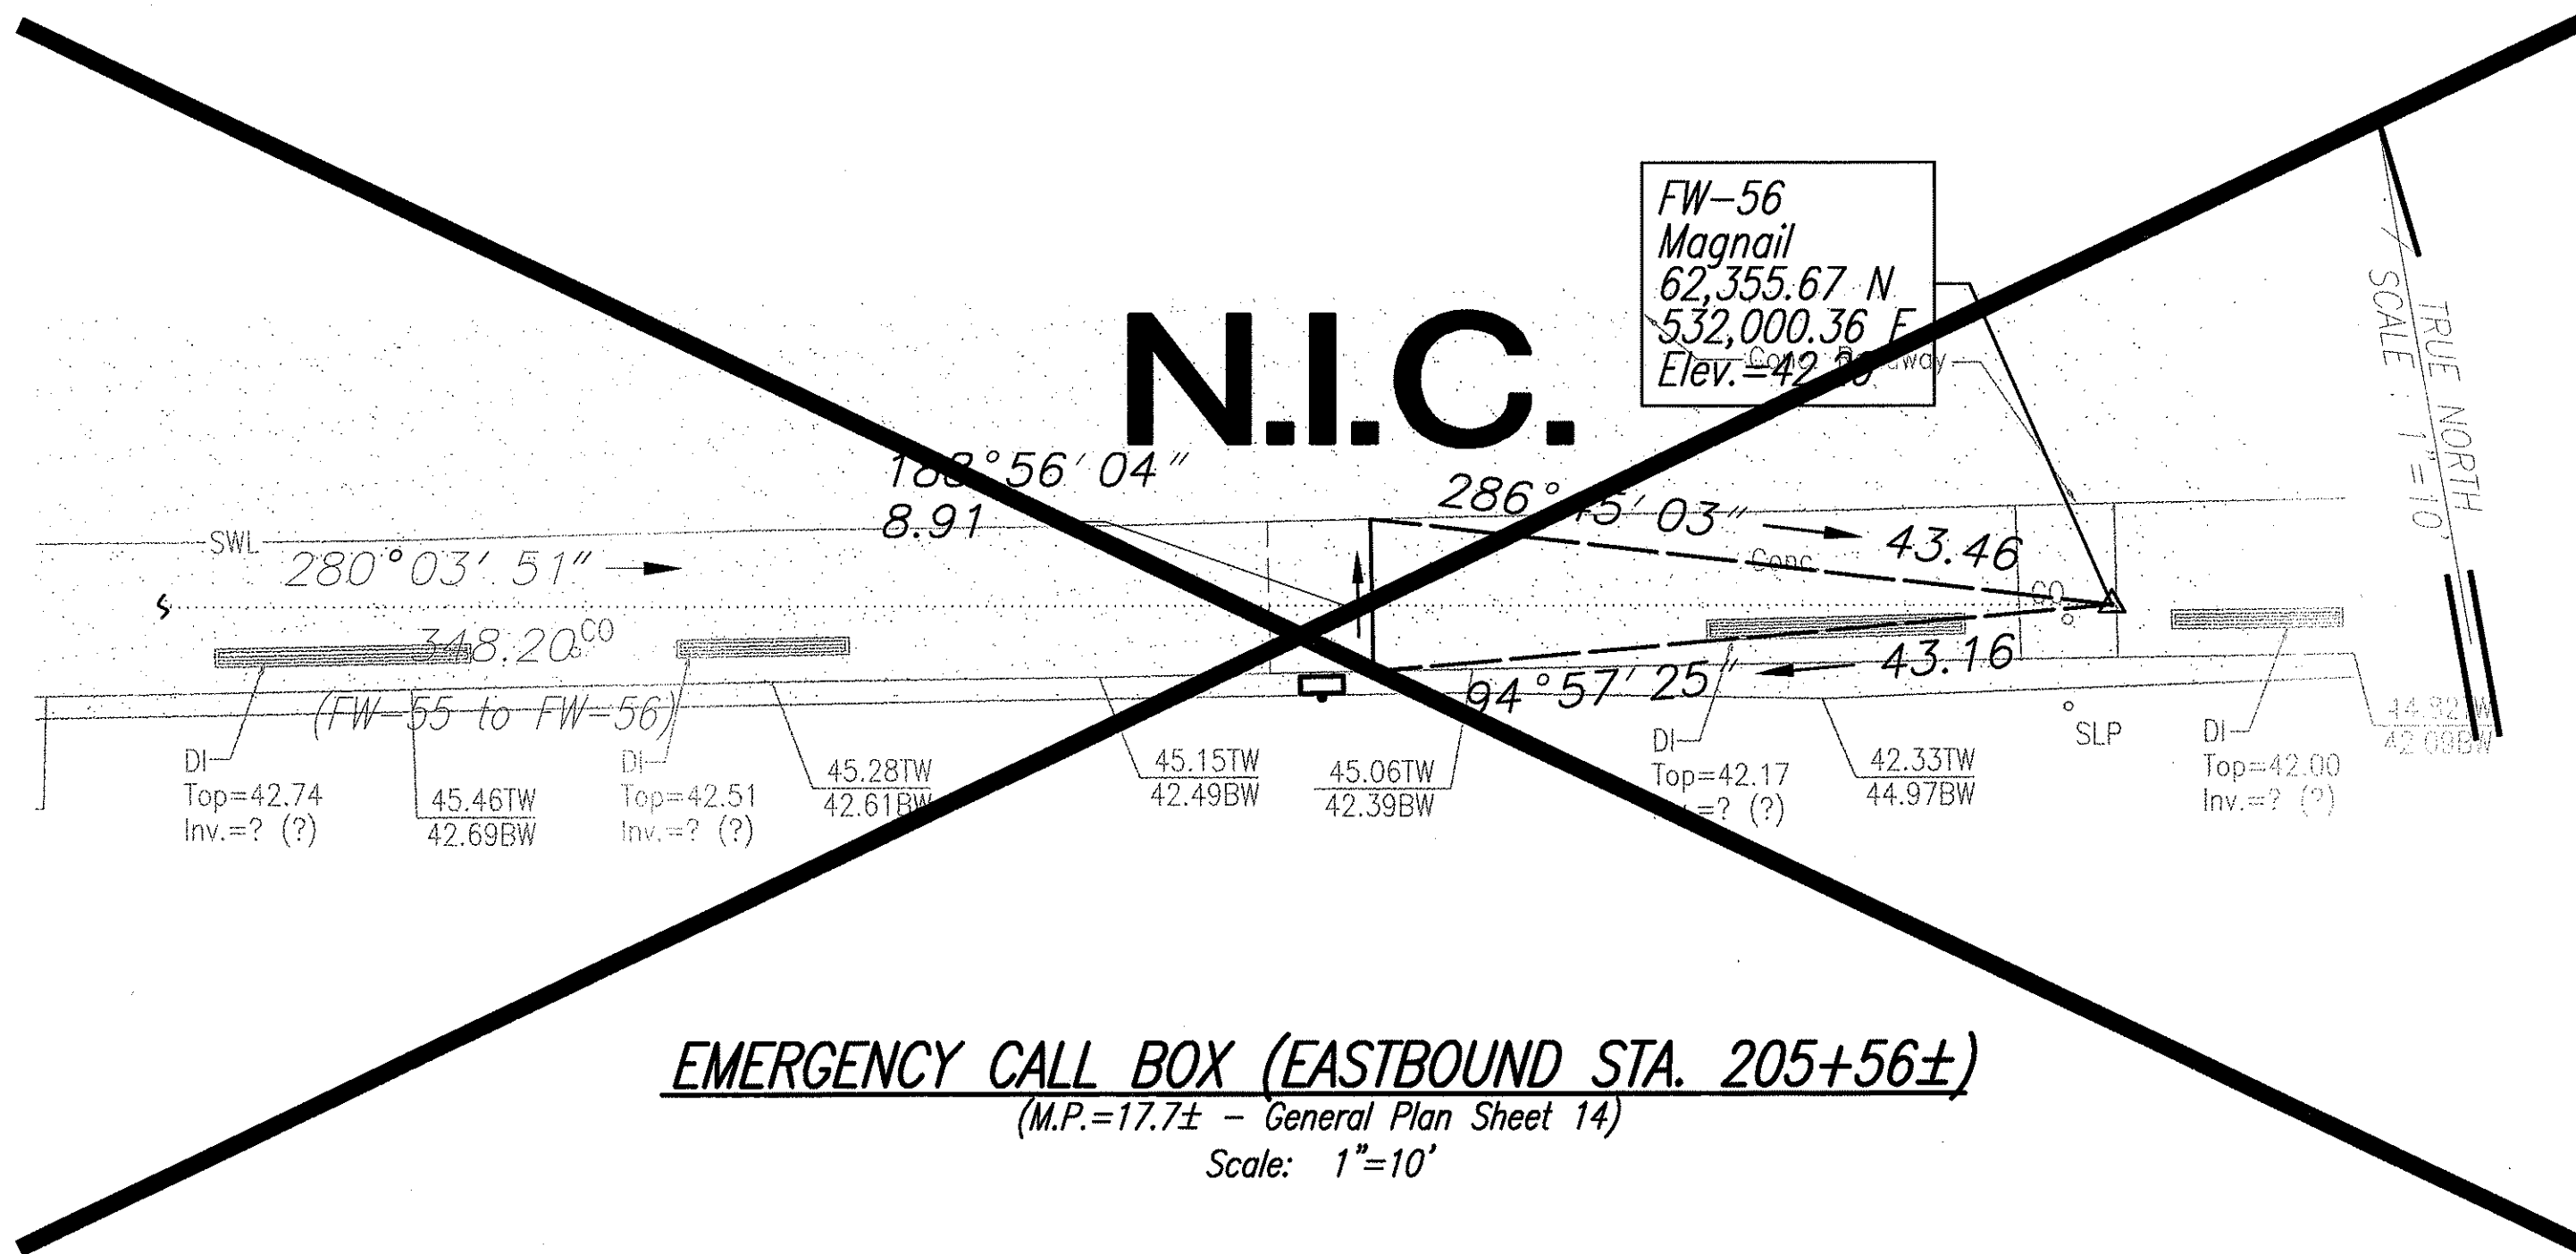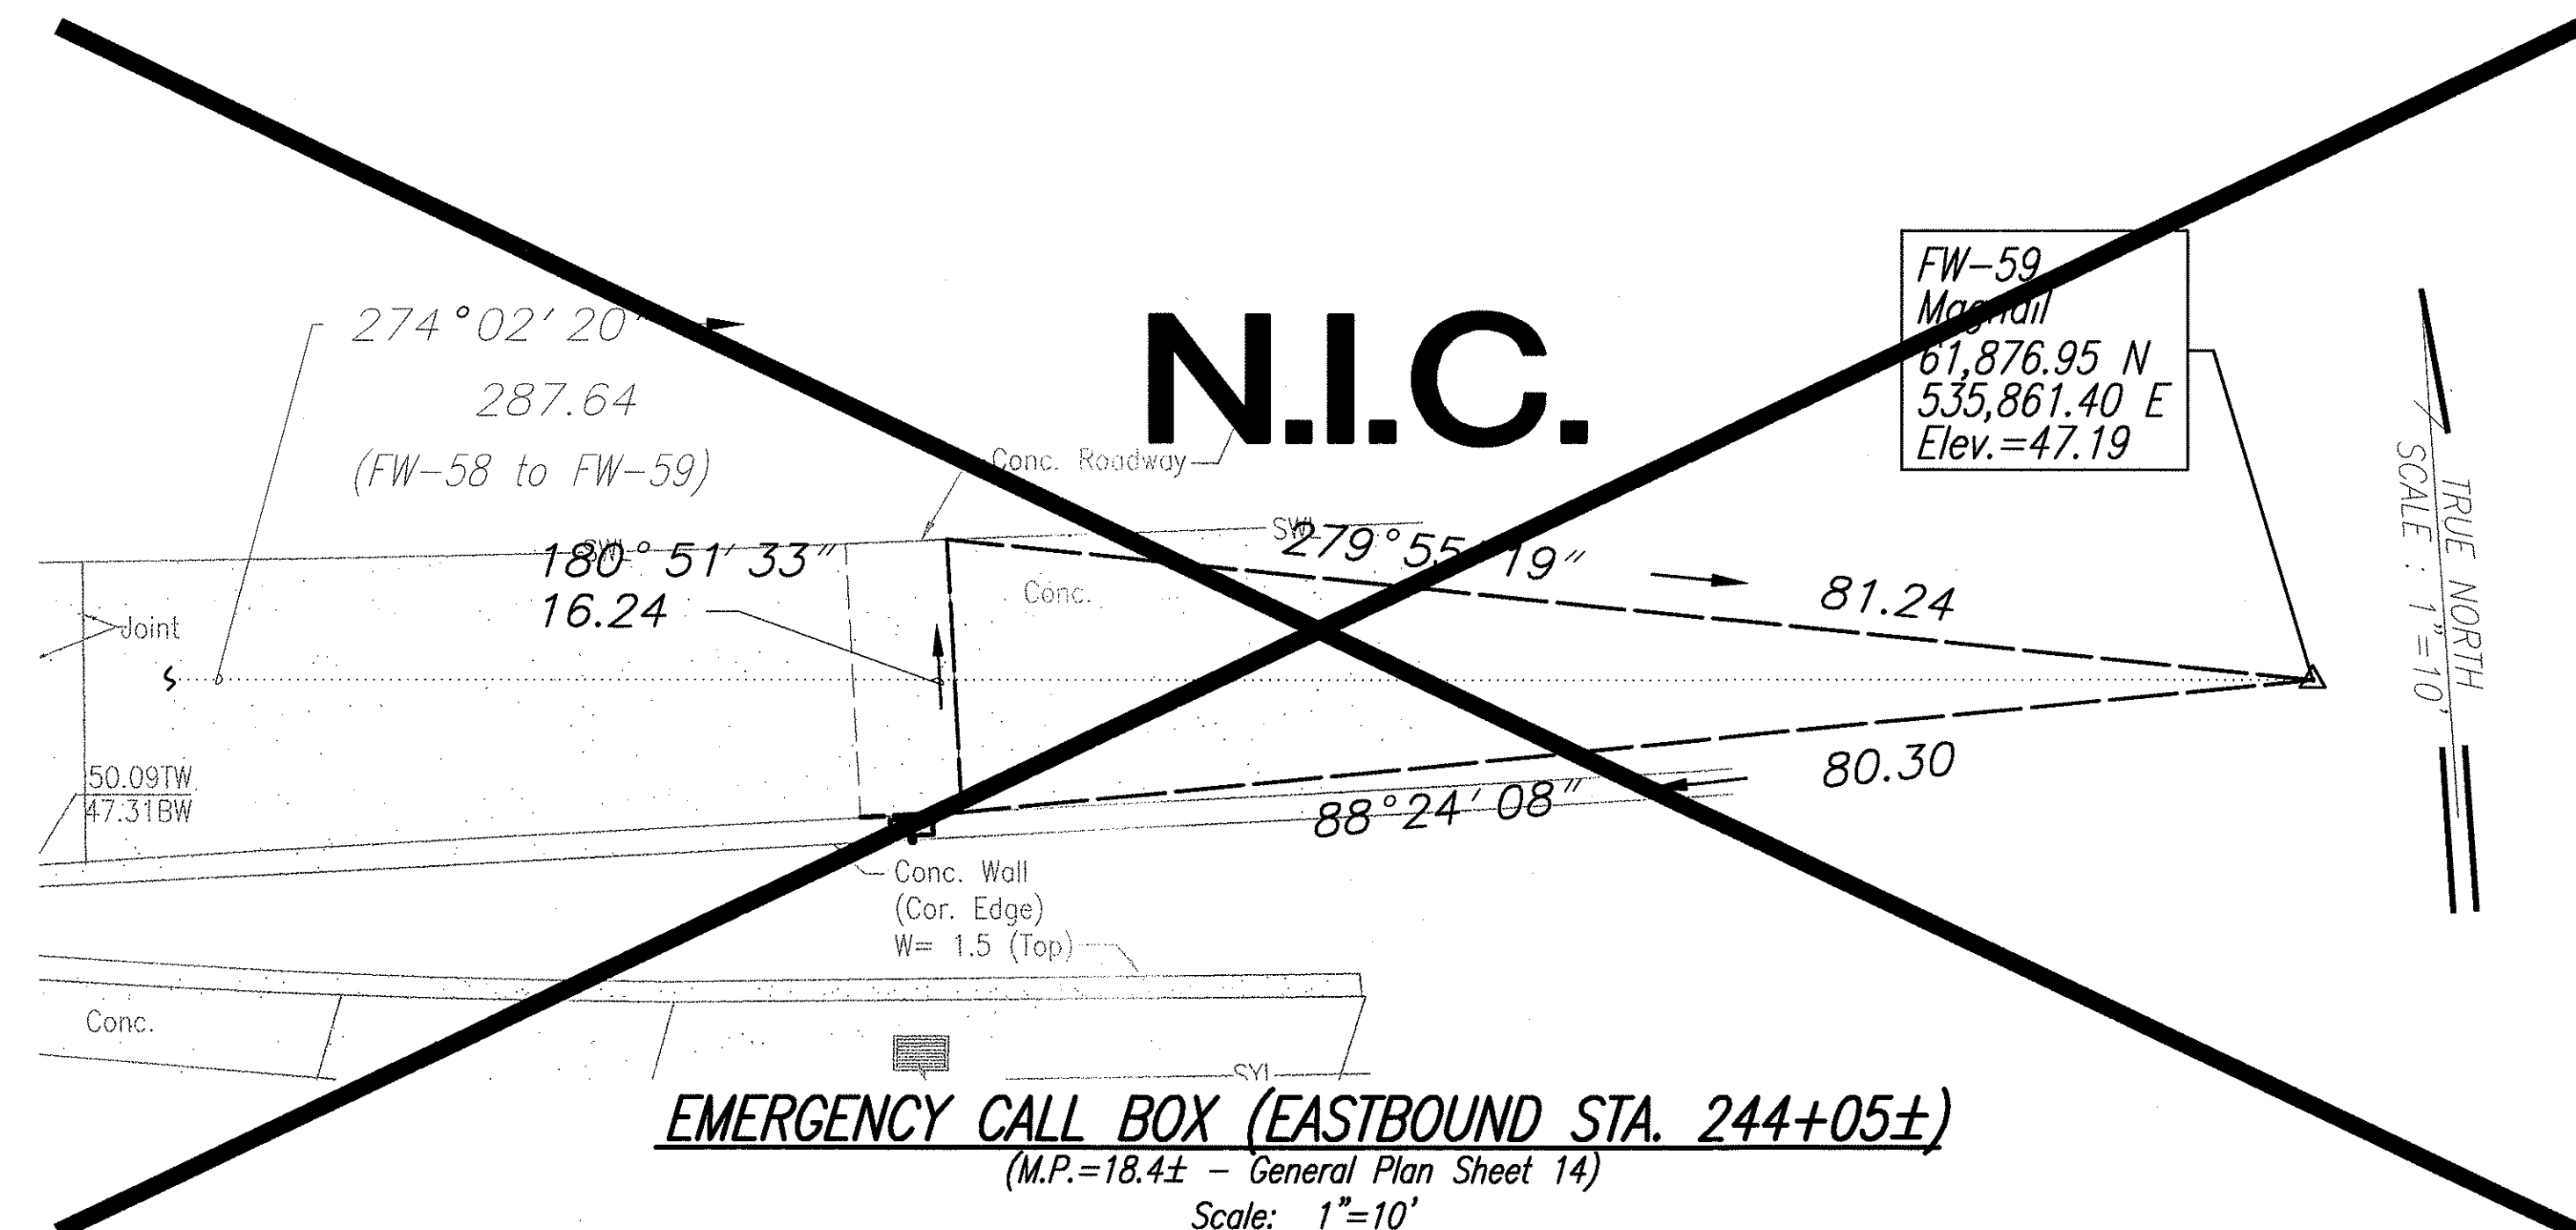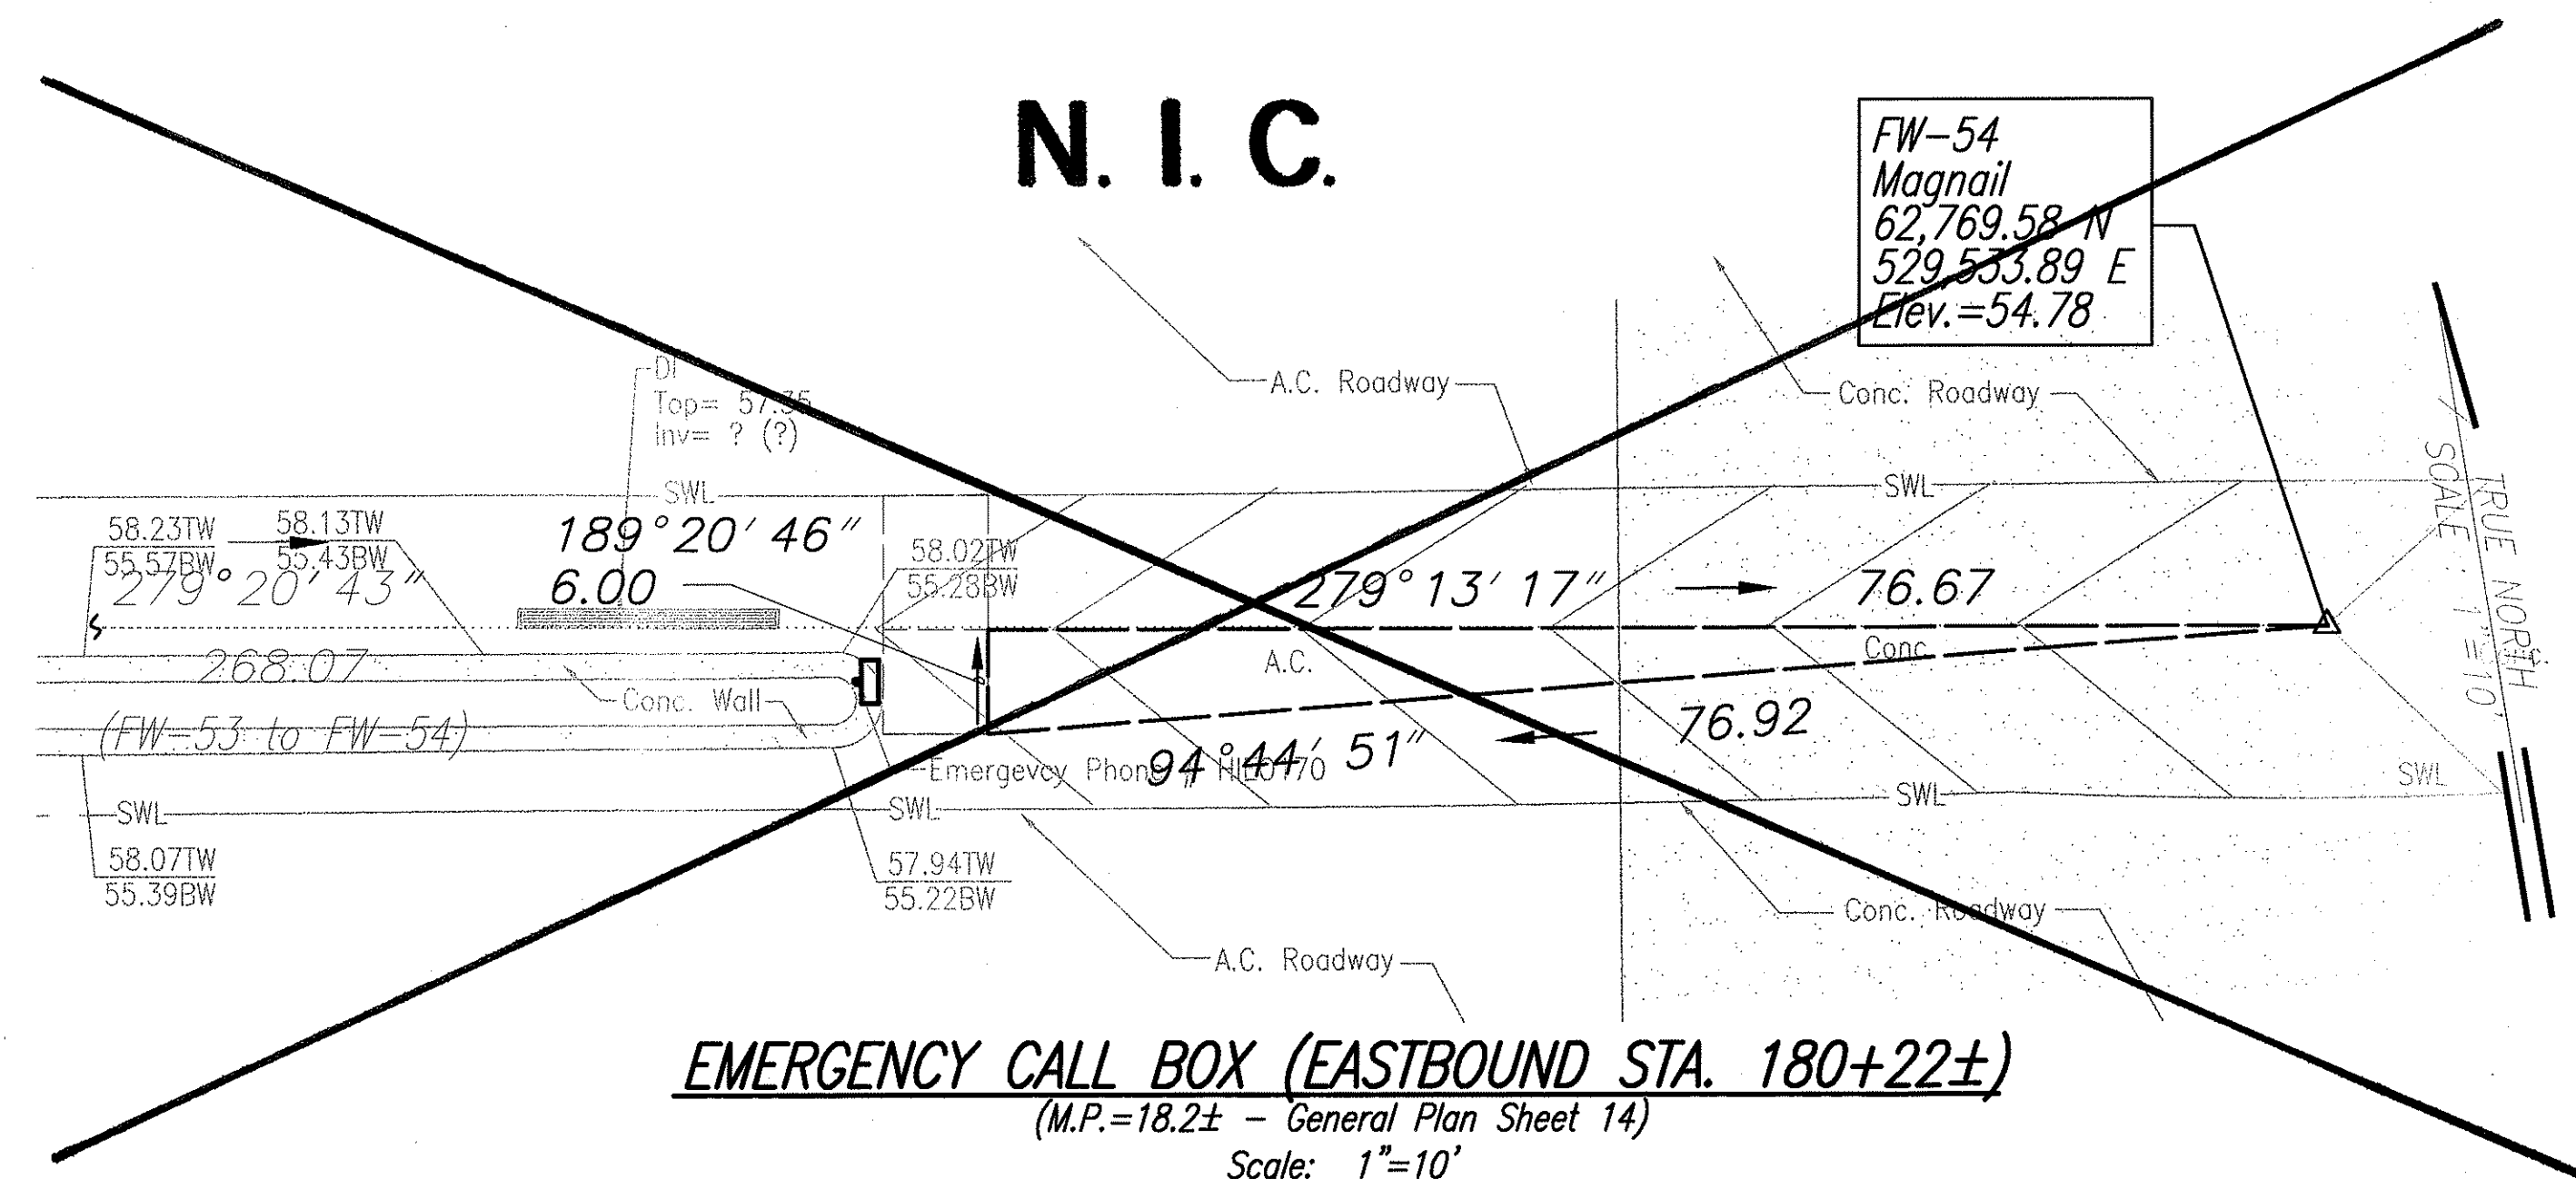

ORIGINAL PLAN	SURVEY PLOTTED BY	DATE
NOTE BOOK	DRAWN BY	
	DESIGNED BY	
	QUANTITIES BY	
	CHECKED BY	
No.		

Note:
Coordinates and azimuths
referenced to State Plane
Coordinate System Hawaii Zone 3,
Nad 1927.

Graphic Scale:

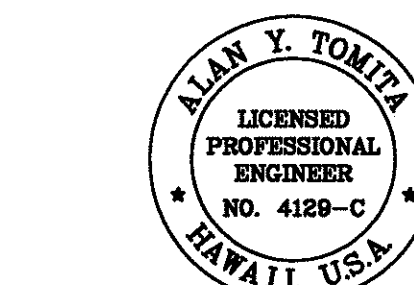

THIS WORK WAS PREPARED BY ME
OR UNDER MY SUPERVISION.

Alan Y. Tomita

STATE OF HAWAII
DEPARTMENT OF TRANSPORTATION
HIGHWAYS DIVISION





**INTERSTATE ROUTE H-1
PAD TIEDOWN-EASTBOUND**

**INTERSTATE ROUTE H-1
EMERGENCY TELEPHONE ACCESSIBLE ROUTES**
F.A. Project No. NH-300(86)R

Scale: As Shown Date: September 2003

SHEET No. 3 OF 7 SHEETS


FED. ROAD DIST. NO.	STATE	FED. AID. PROJ. NO.	FISCAL YEAR	SHEET NO.	TOTAL SHEETS
HAWAII	HAW.	NH-300(86)R	2004	34	45

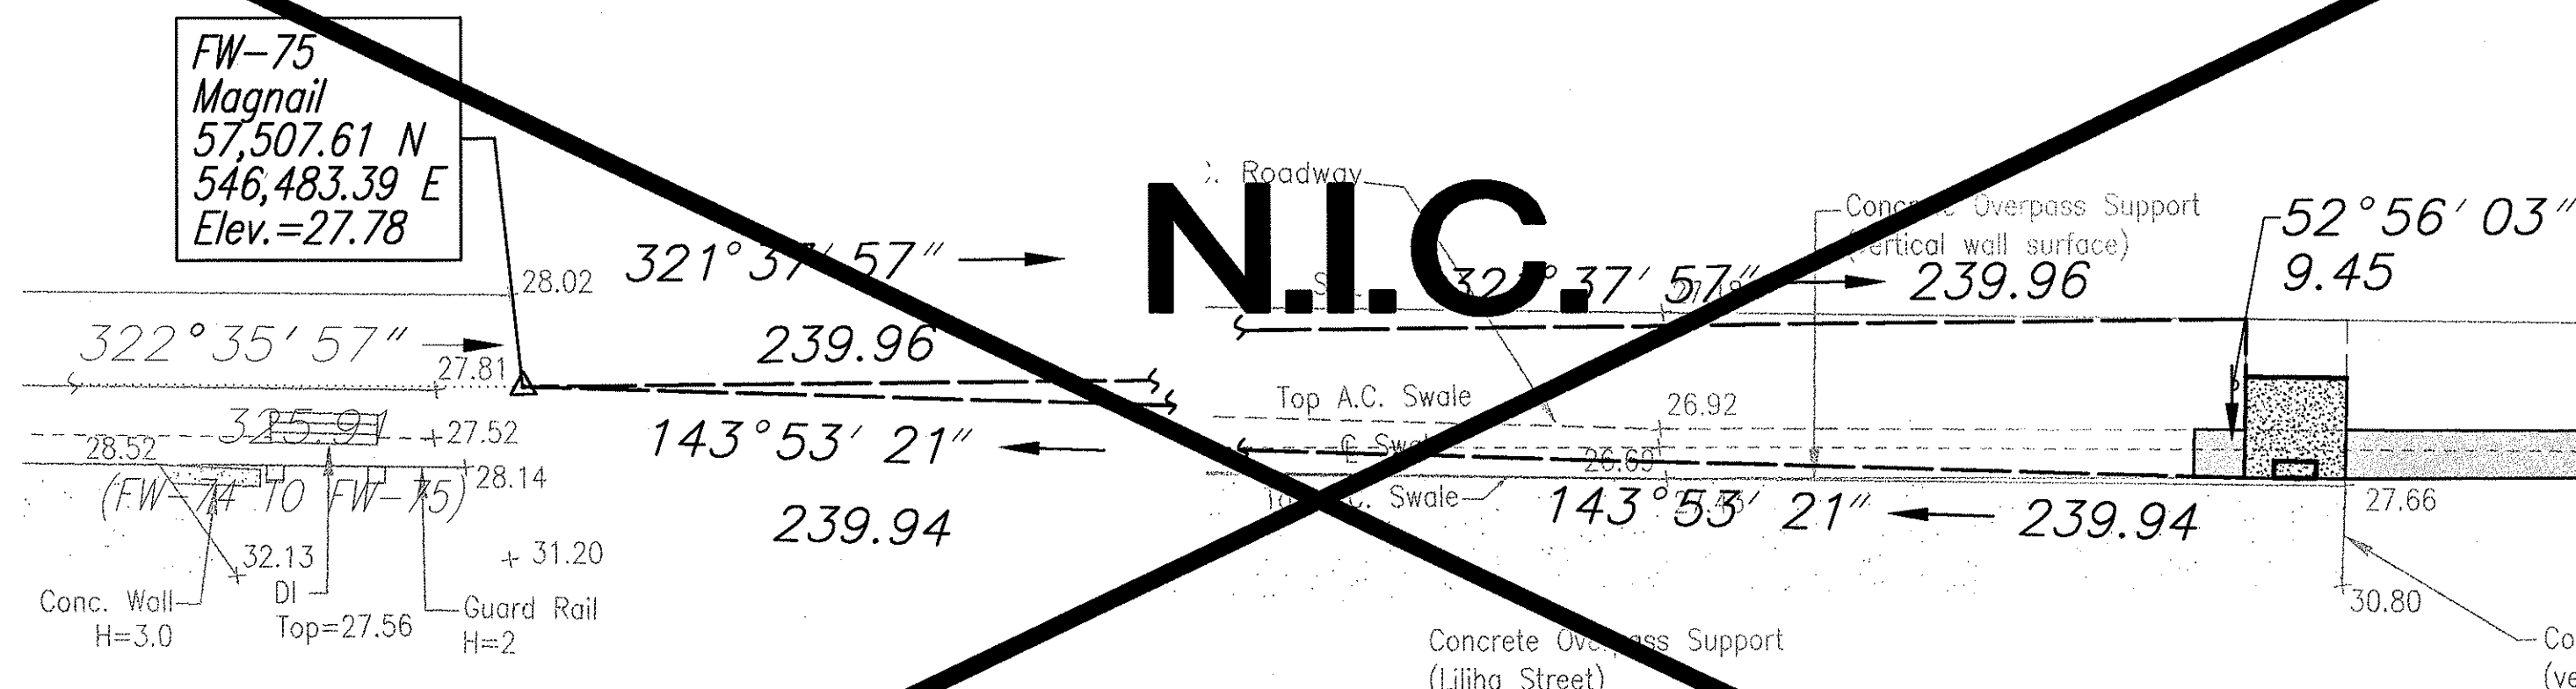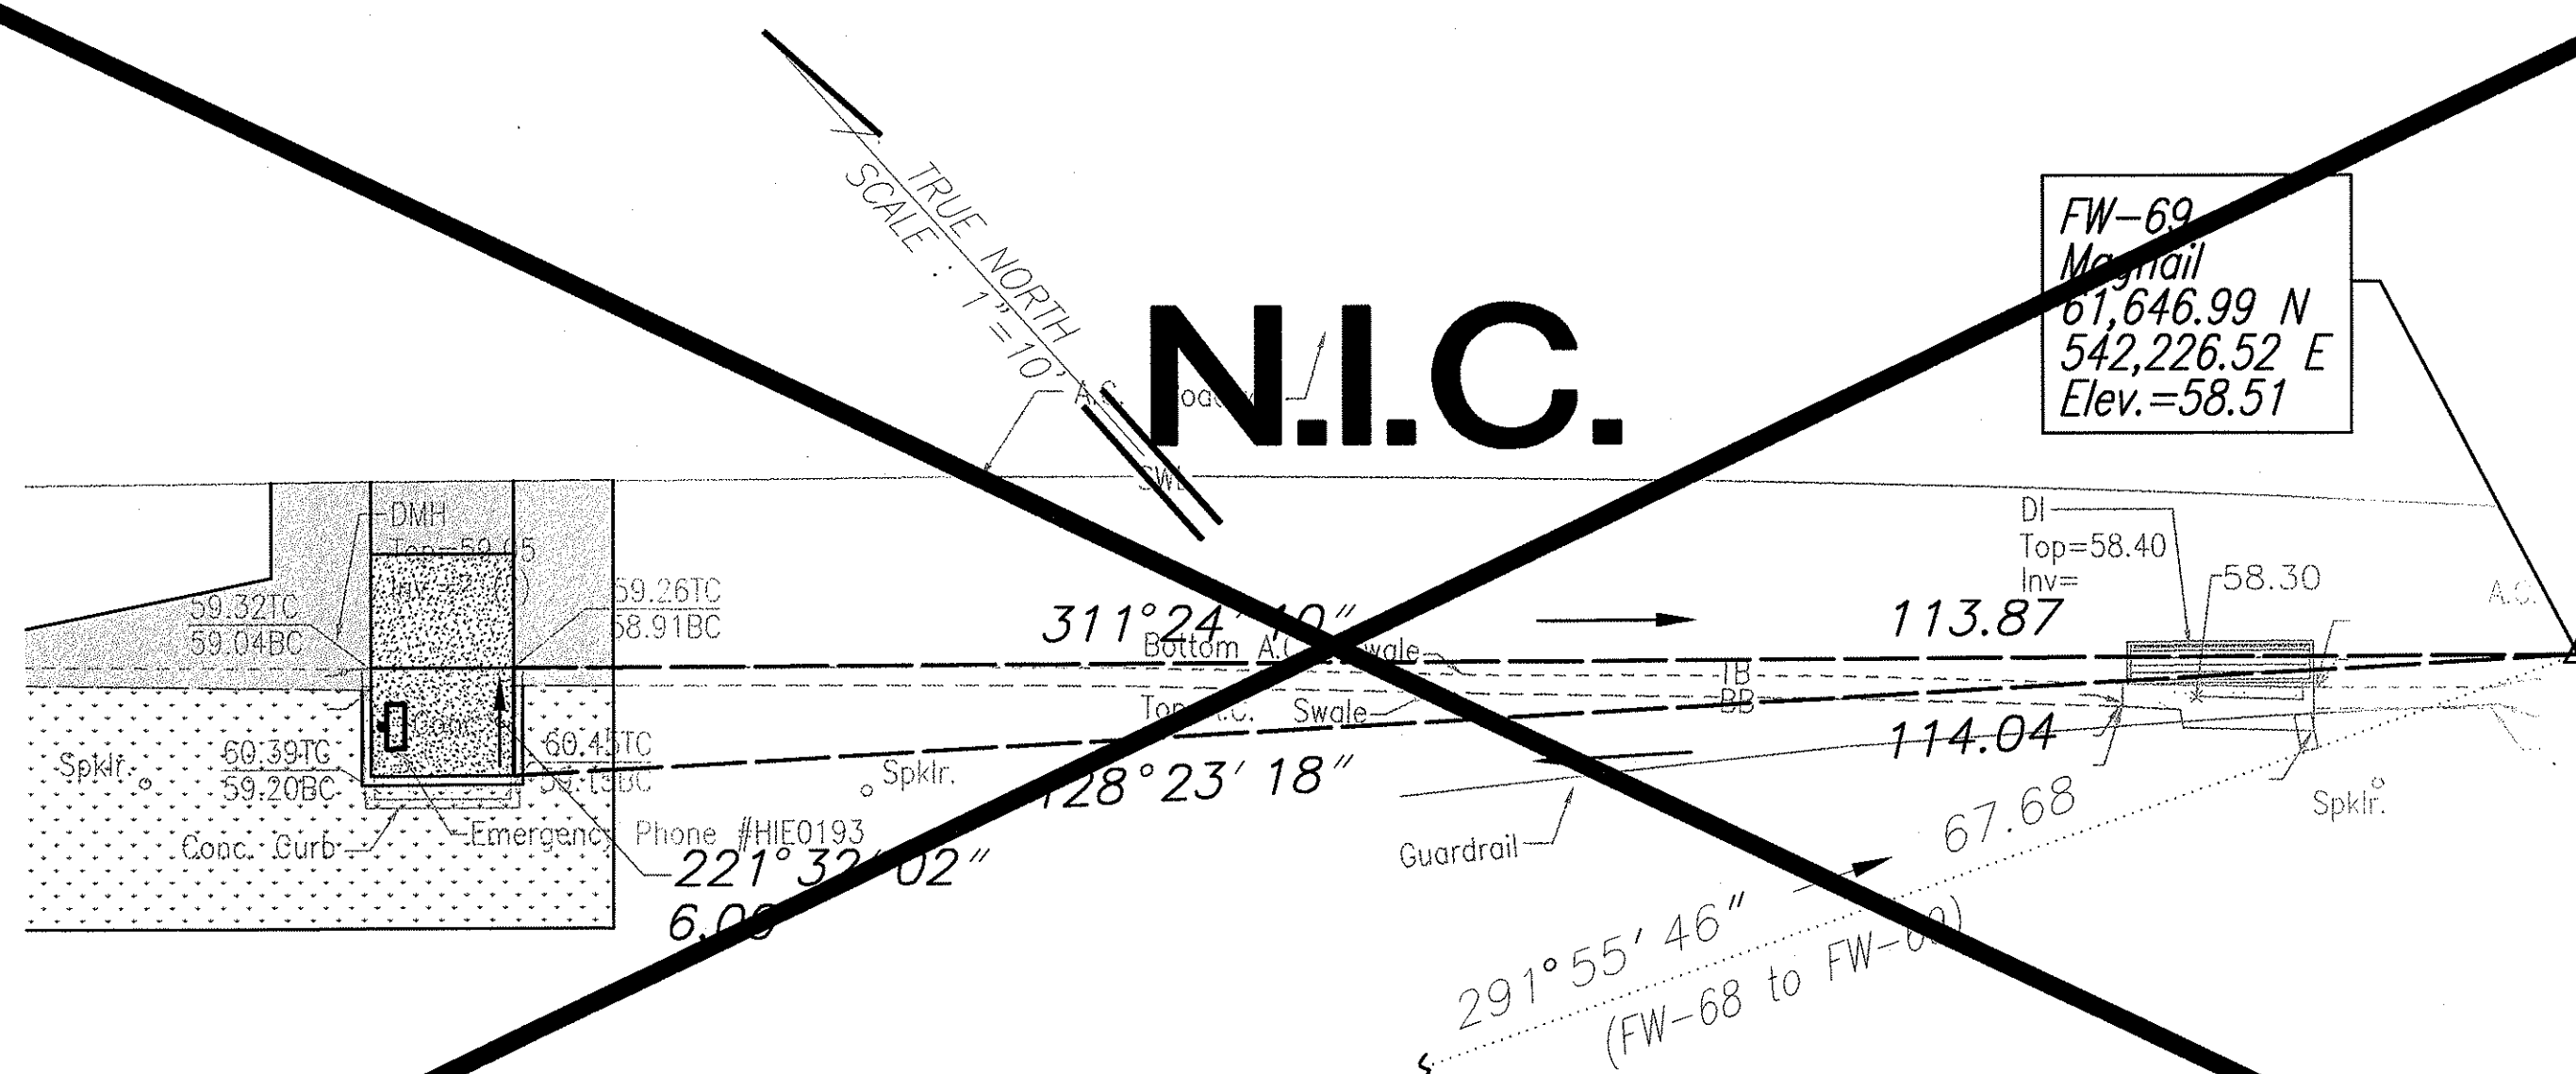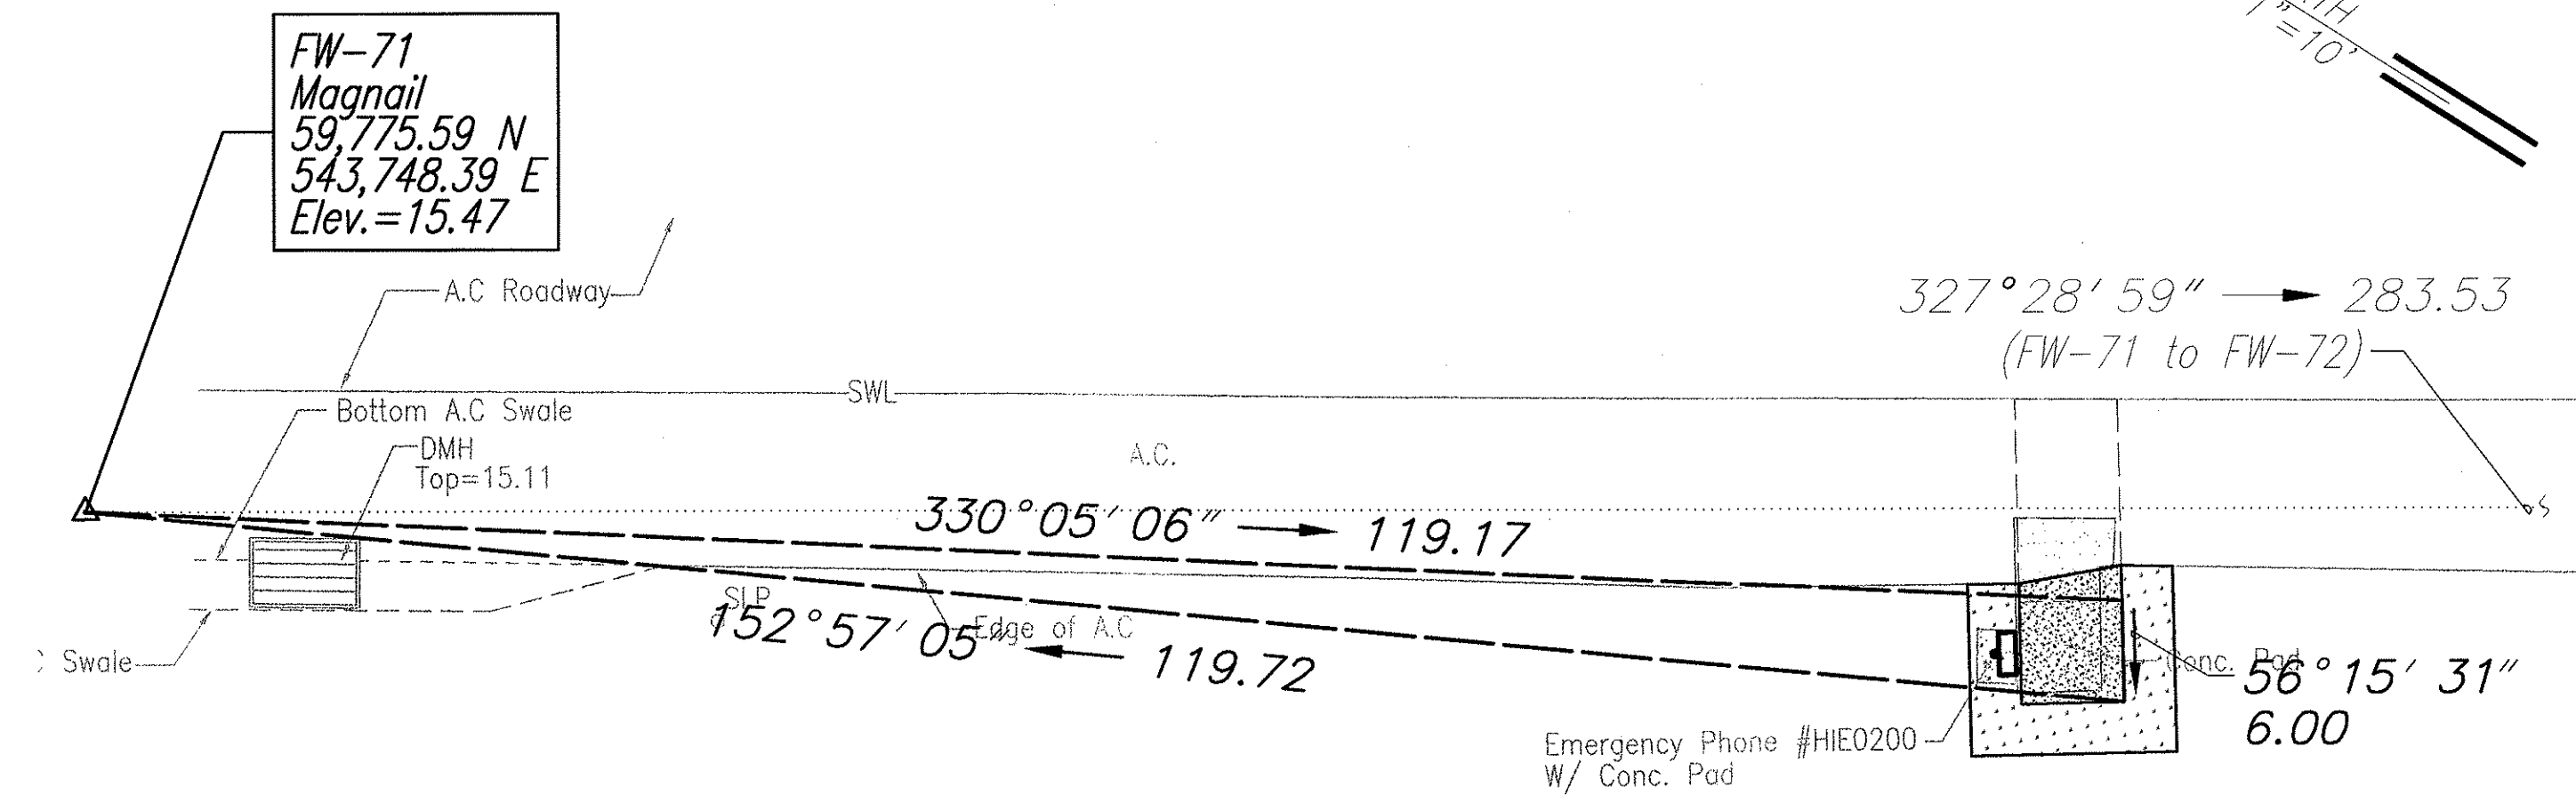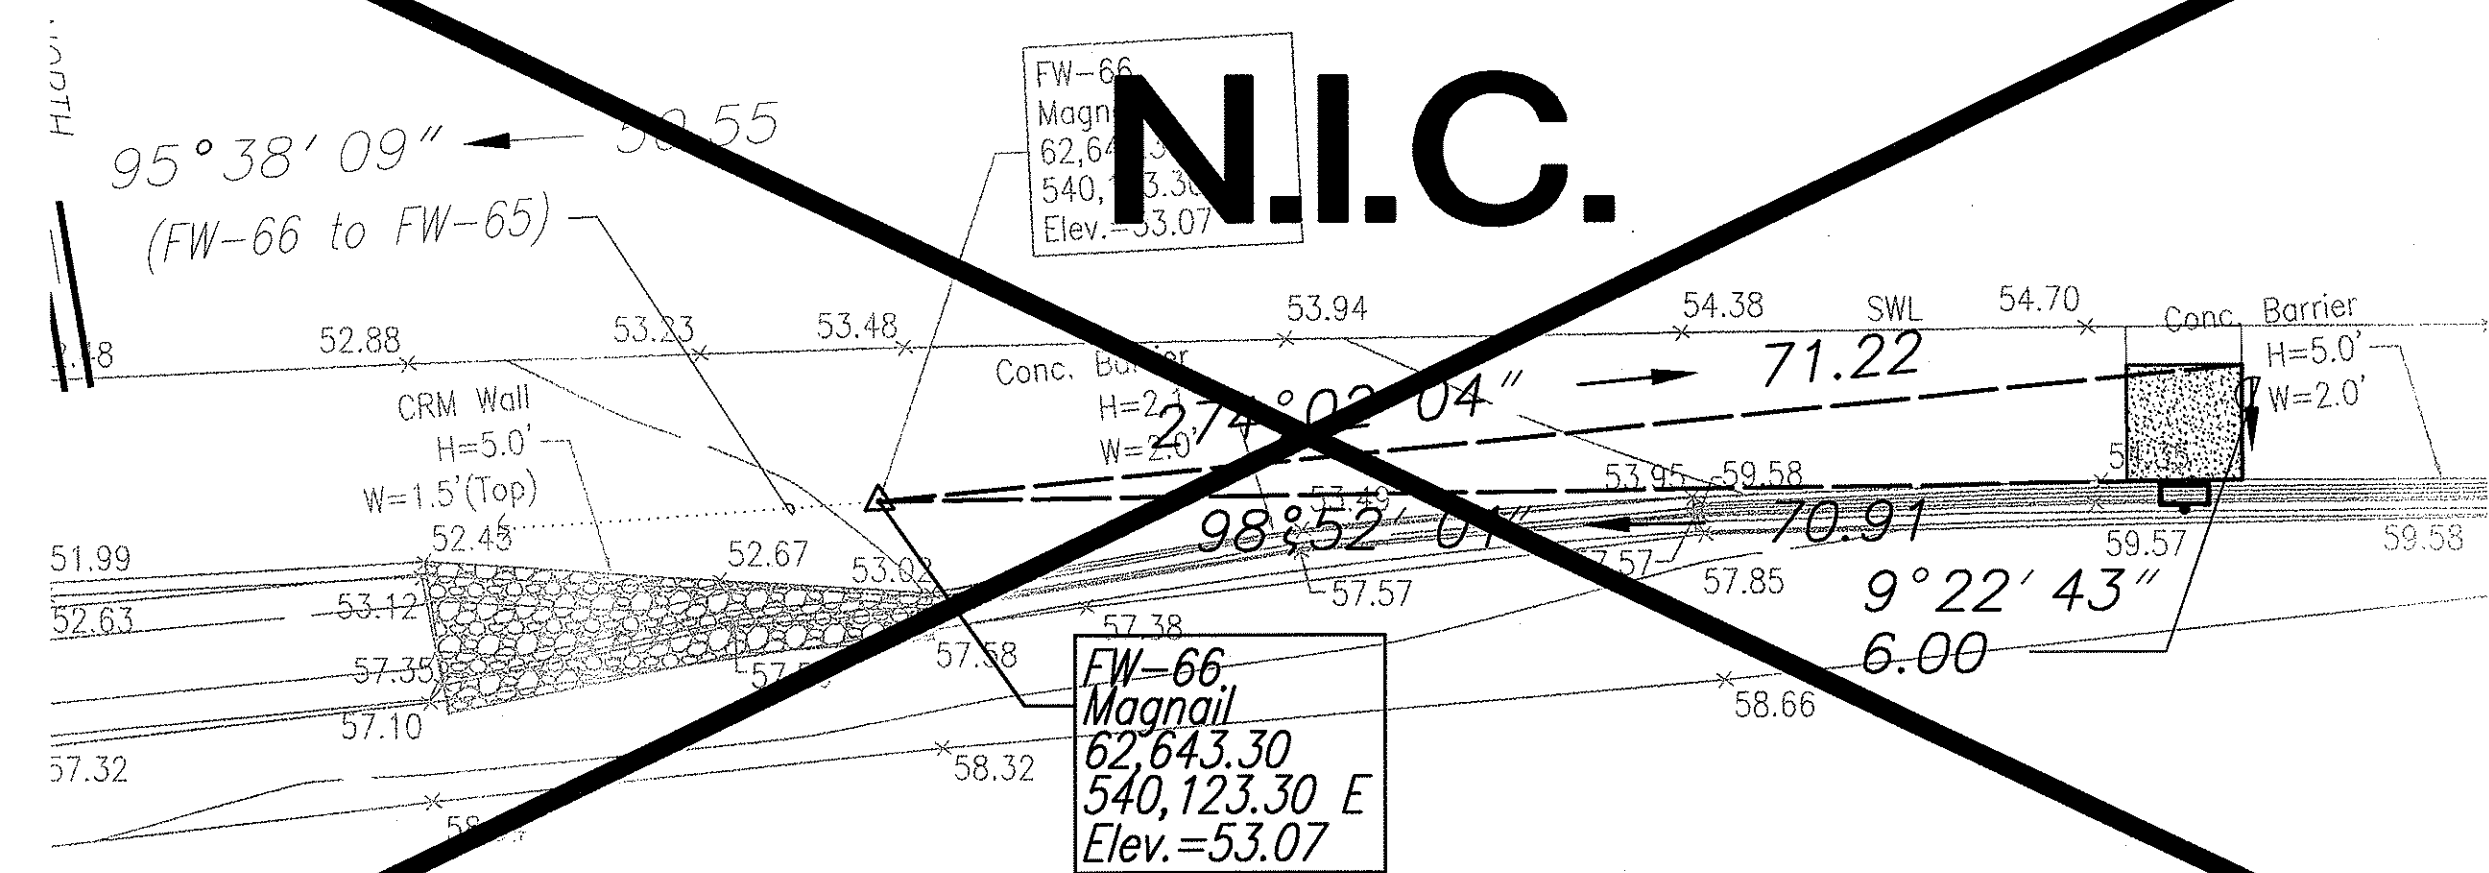

SURVEY PLOTTED BY	DATE
DRAWN BY	
TRACED BY	
QUANTITIES BY	
CHECKED BY	
ORIGINAL PLAN	
NOTE BOOK	
No.	

Note:
Coordinates and azimuths
referenced to State Plane
Coordinate System Hawaii Zone 3,
Nad 1927.

Graphic Scale:

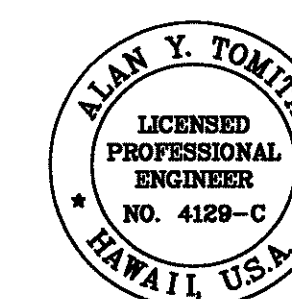

THIS WORK WAS PREPARED BY ME
OR UNDER MY SUPERVISION.

Alan Y. Tomita

STATE OF HAWAII
DEPARTMENT OF TRANSPORTATION
HIGHWAYS DIVISION


**INTERSTATE ROUTE H-1
PAD TIEDOWN-EASTBOUND**

**INTERSTATE ROUTE H-1
EMERGENCY TELEPHONE ACCESSIBLE ROUTES**
E.A. Project No. NH-300(86)R


Scale: As Shown Date: September 2003

SHEET No. 4 OF 7 SHEETS


FED. ROAD DIST. NO.	STATE	FED. AID. PROJ. NO.	FISCAL YEAR	SHEET NO.	TOTAL SHEETS
HAWAII	HAW.	NH-300(86)R	2004	35	45

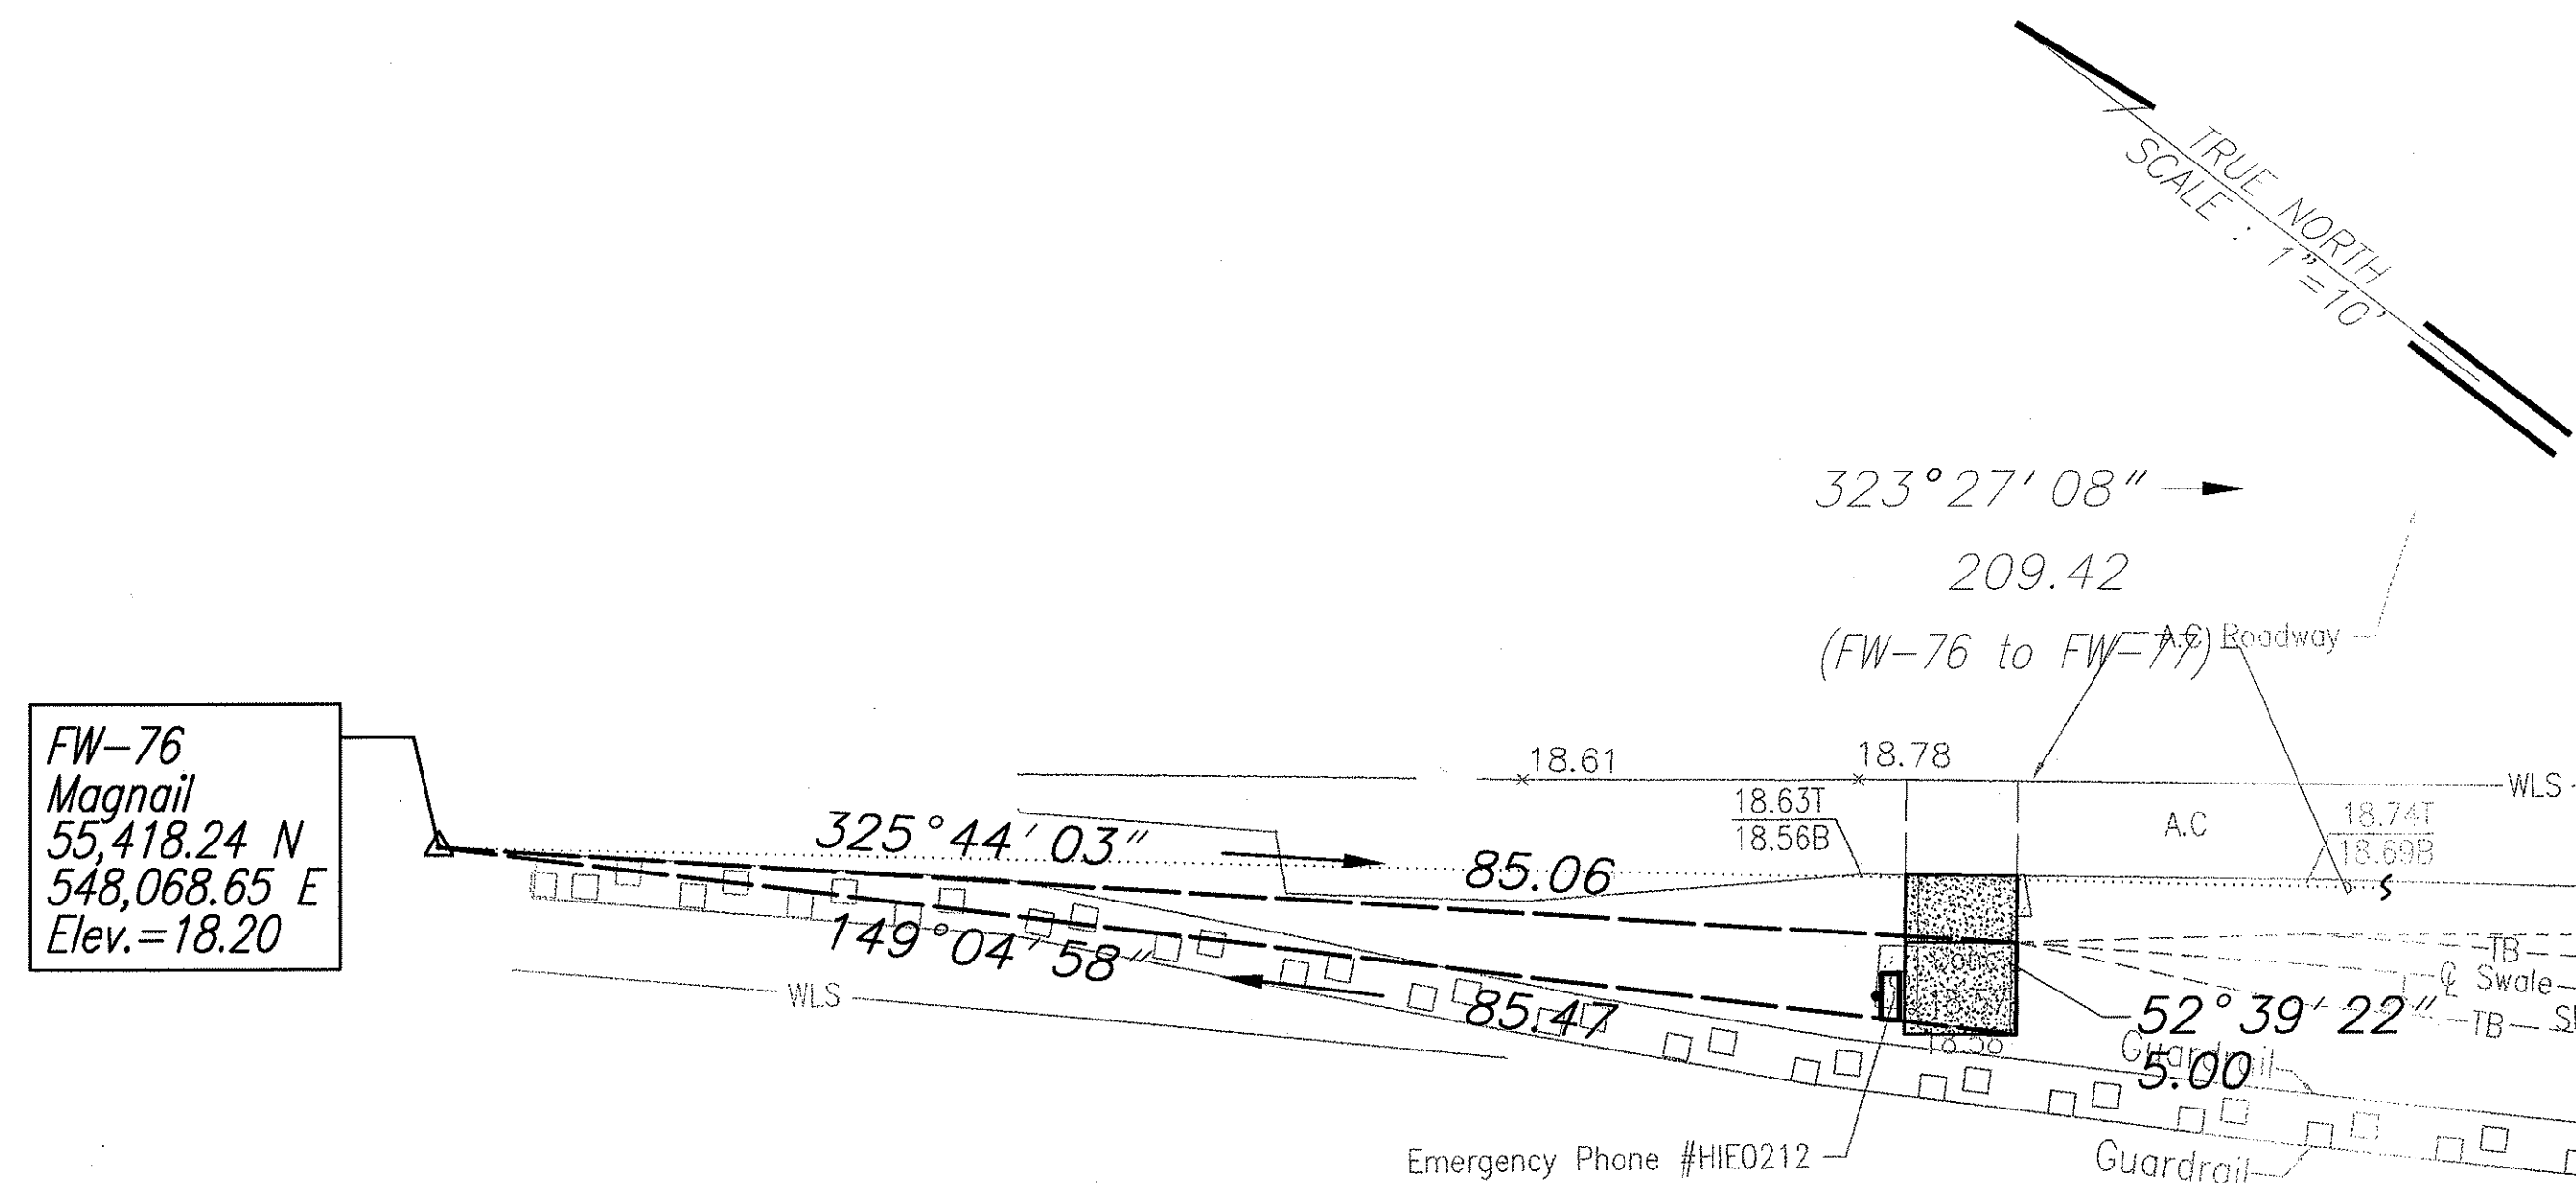


EMERGENCY CALL BOX (EASTBOUND STA. 137+72±)
(M.P.=21.4± - General Plan Sheet 15)
Scale: 1"=10'

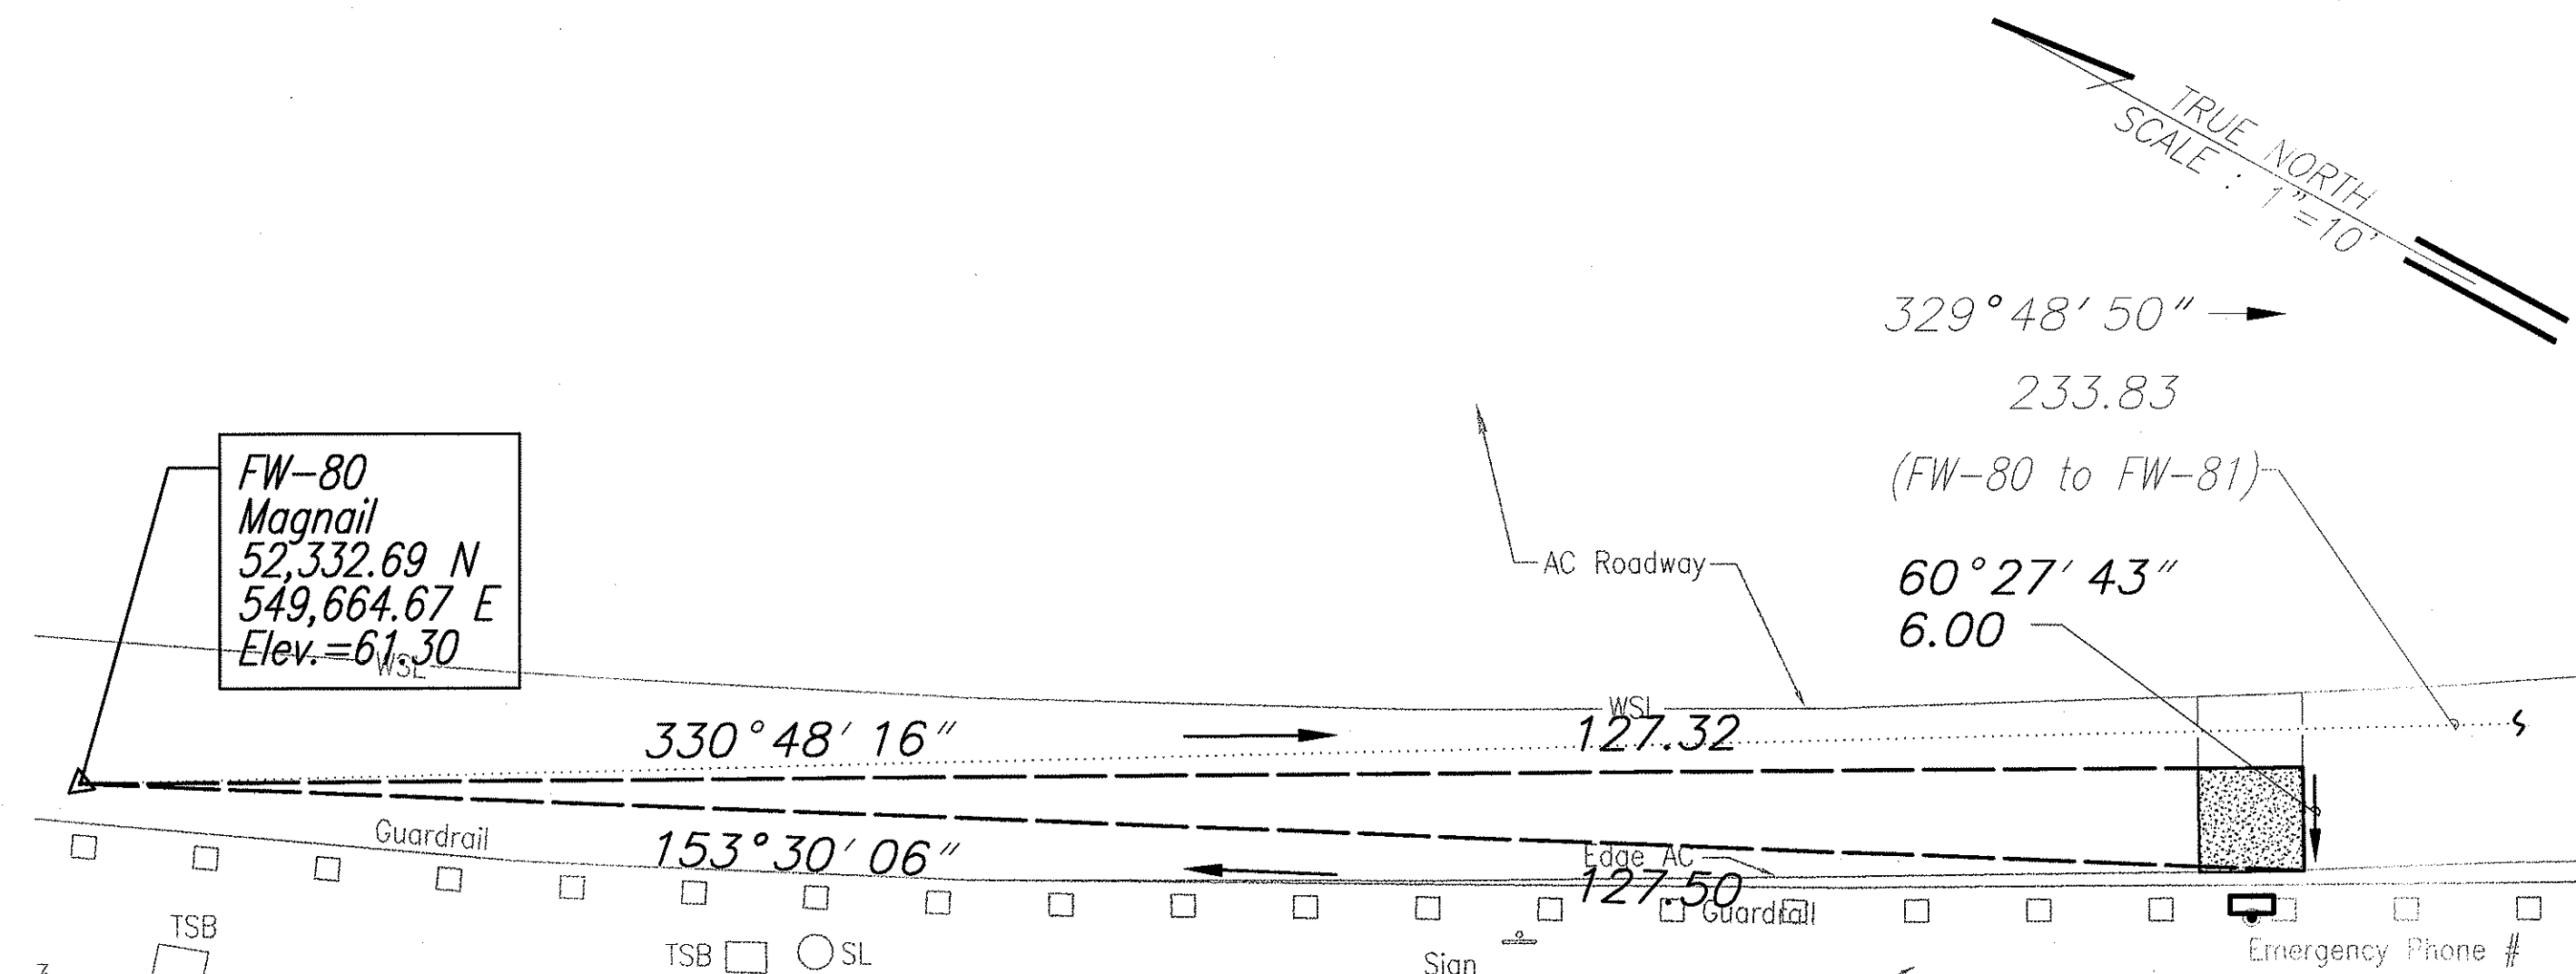

EMERGENCY CALL BOX (INBOUND STA. 181+30±)
(M.P.=22.2± - General Plan Sheet 15)
Scale: 1"=10'

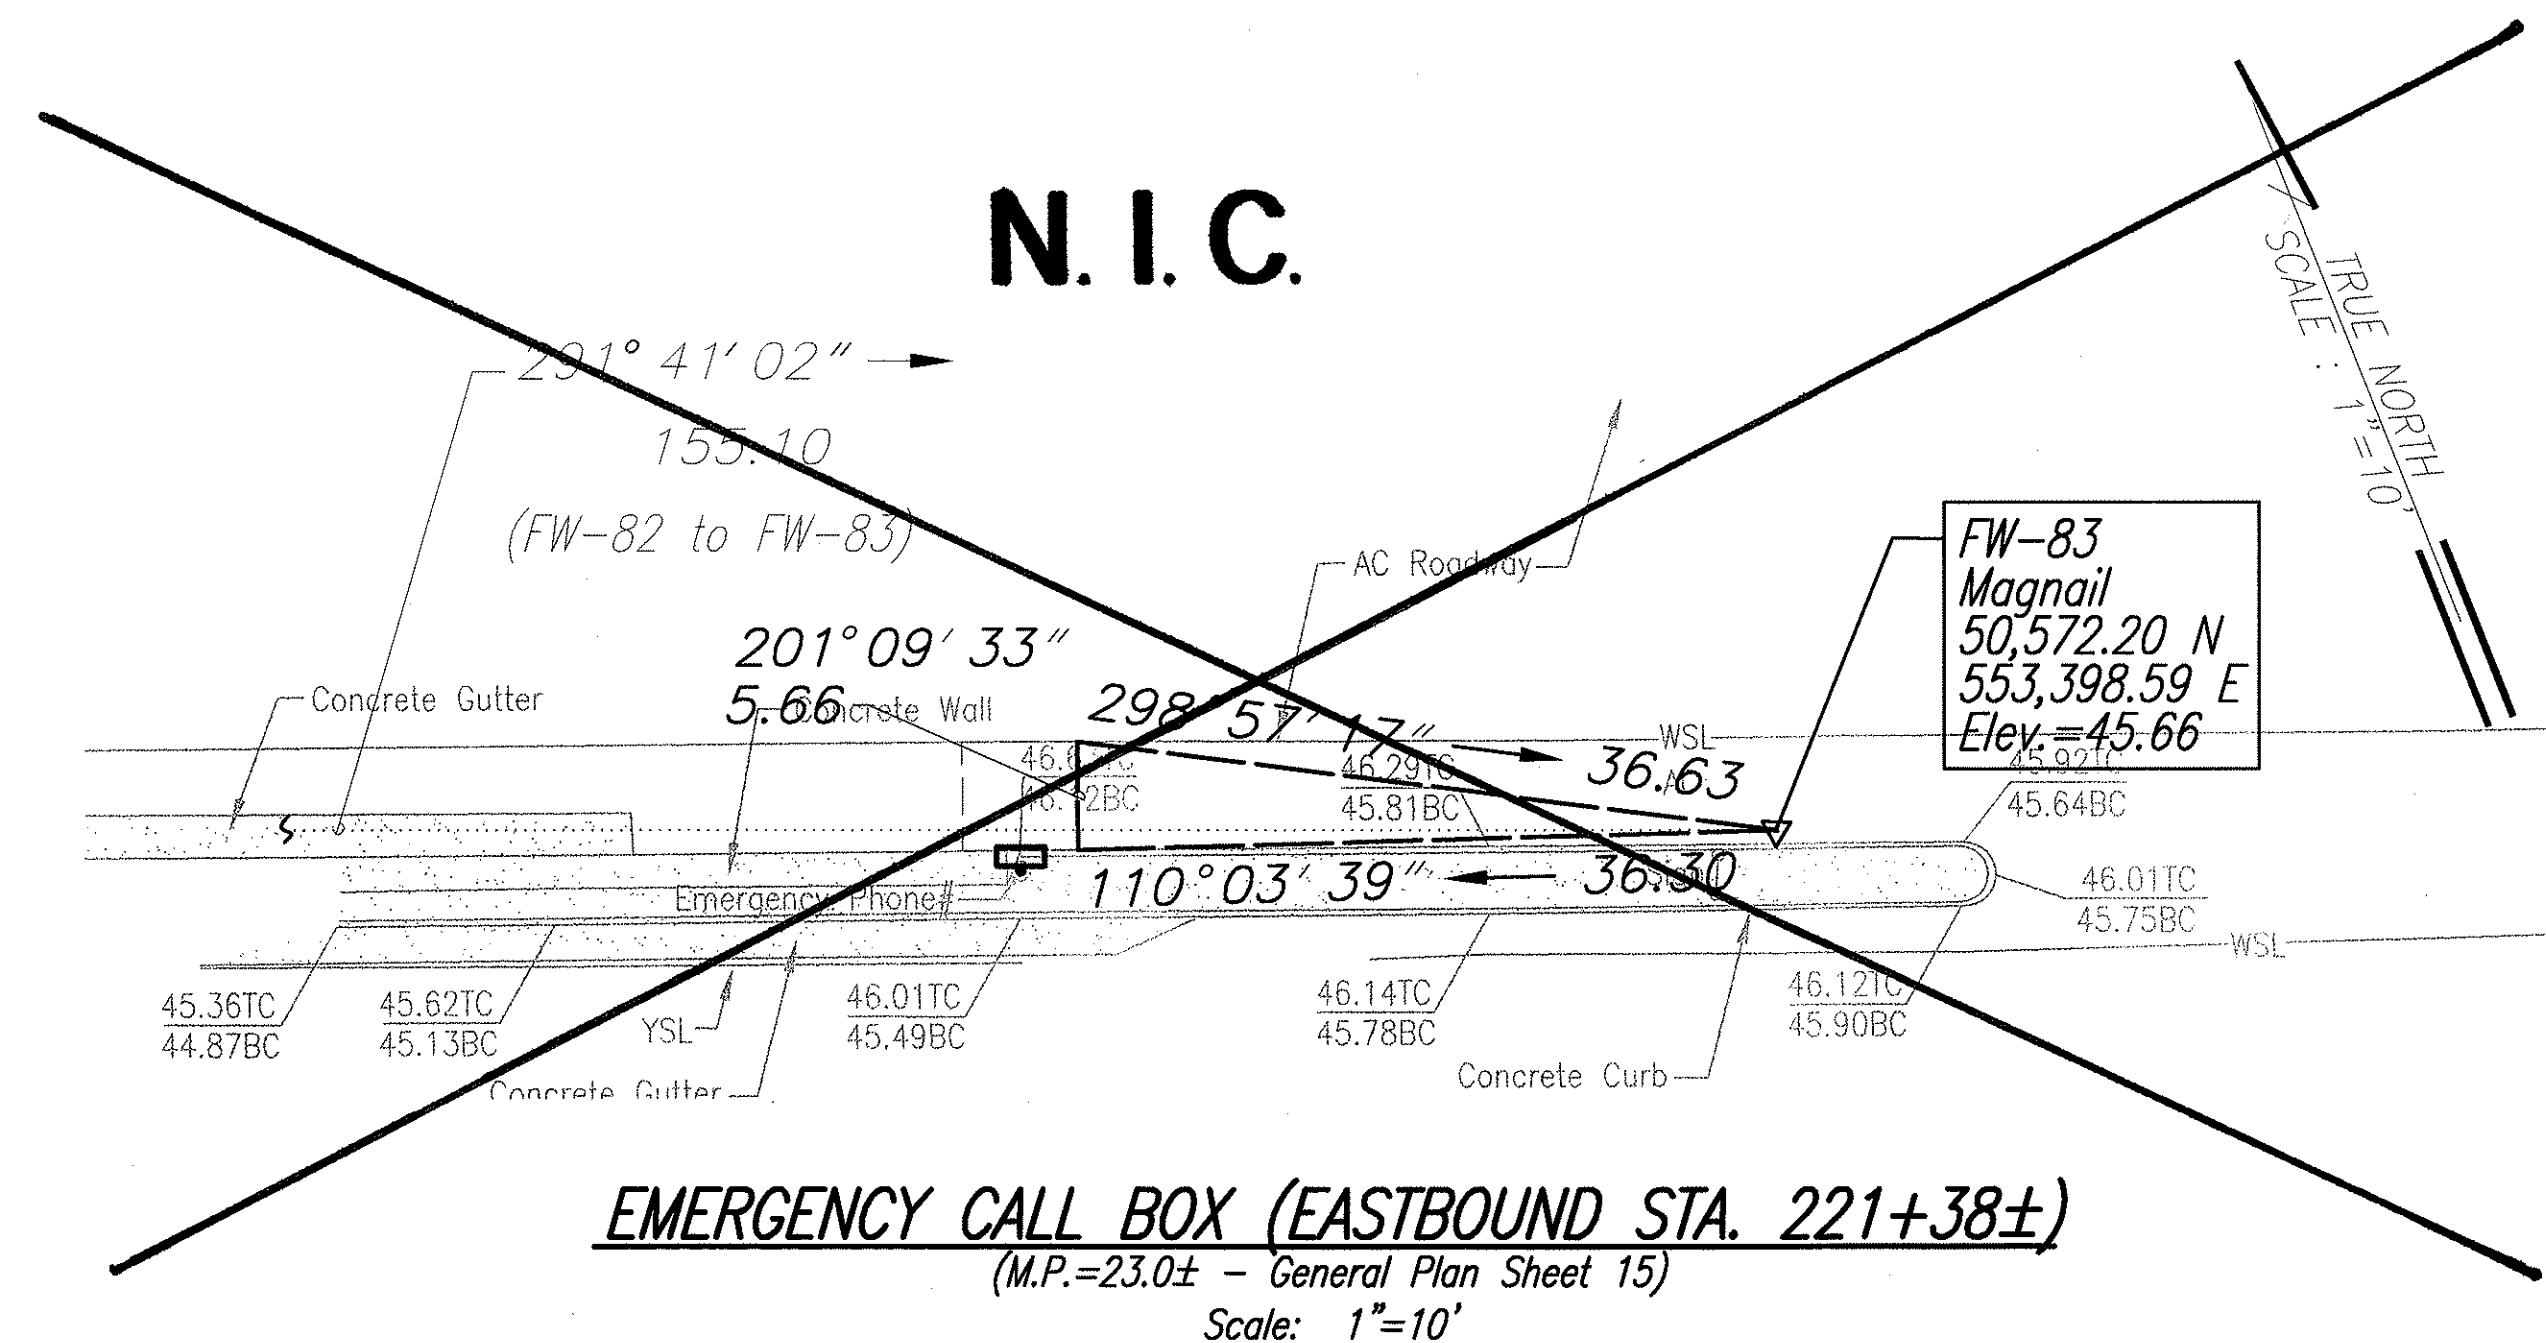

EMERGENCY CALL BOX (EASTBOUND STA. 221+38±)
(M.P.=23.0± - General Plan Sheet 15)
Scale: 1"=10'

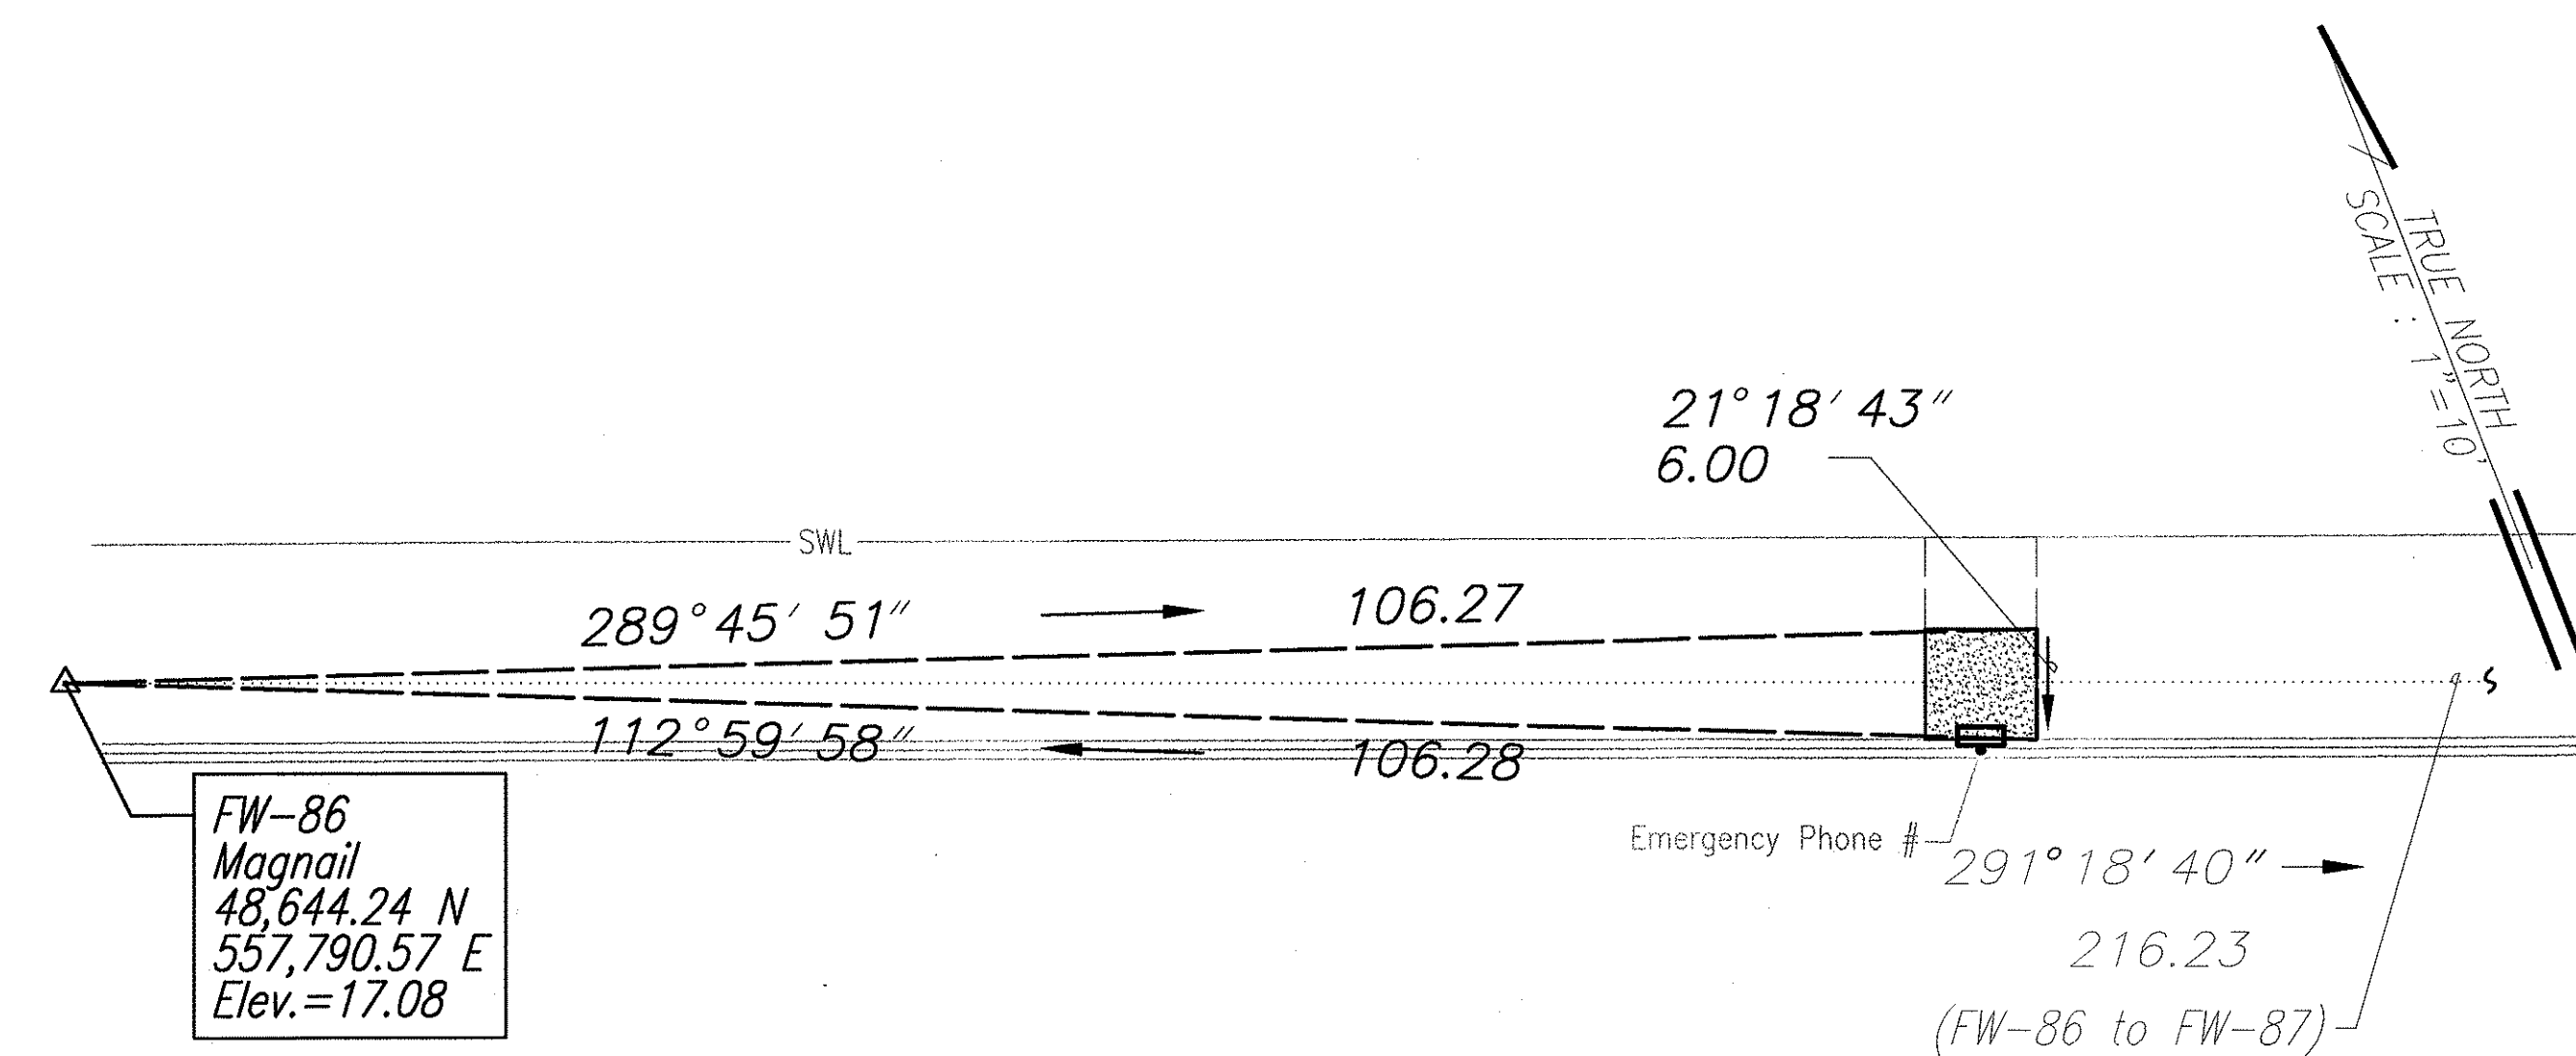


EMERGENCY CALL BOX (EASTBOUND STA. 271+63±)
(M.P.=23.9± - General Plan Sheet 15)
Scale: 1"=10'

SURVEY PLOTTED BY	DATE
DRAWN BY	
DESIGNED BY	
QUANTITIES BY	
CHECKED BY	
ORIGINAL PLAN	
NOTE BOOK	
No.	

Note:
Coordinates and azimuths
referenced to State Plane
Coordinate System Hawaii Zone 3,
Nad 1927.

Graphic Scale:
10' 5' 0' 10' 20'

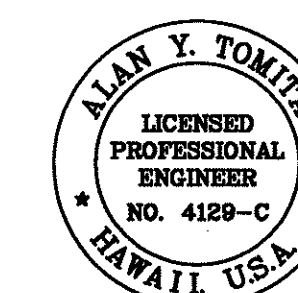

THIS WORK WAS PREPARED BY ME
OR UNDER MY SUPERVISION.

Alan Y. Tomita

STATE OF HAWAII
DEPARTMENT OF TRANSPORTATION
HIGHWAYS DIVISION

**INTERSTATE ROUTE H-1
PAD TIEDOWN-EASTBOUND**


**INTERSTATE ROUTE H-1
EMERGENCY TELEPHONE ACCESSIBLE ROUTES**
F.A. Project No. NH-300(86)R

Scale: As Shown Date: September 2003


SHEET No. 5 OF 7 SHEETS

FED. ROAD DIST. NO.	STATE	FED. AID. PROJ. NO.	FISCAL YEAR	SHEET NO.	TOTAL SHEETS
HAWAII	HAW.	NH-300(86)R	2004	36	45

N.I.C.

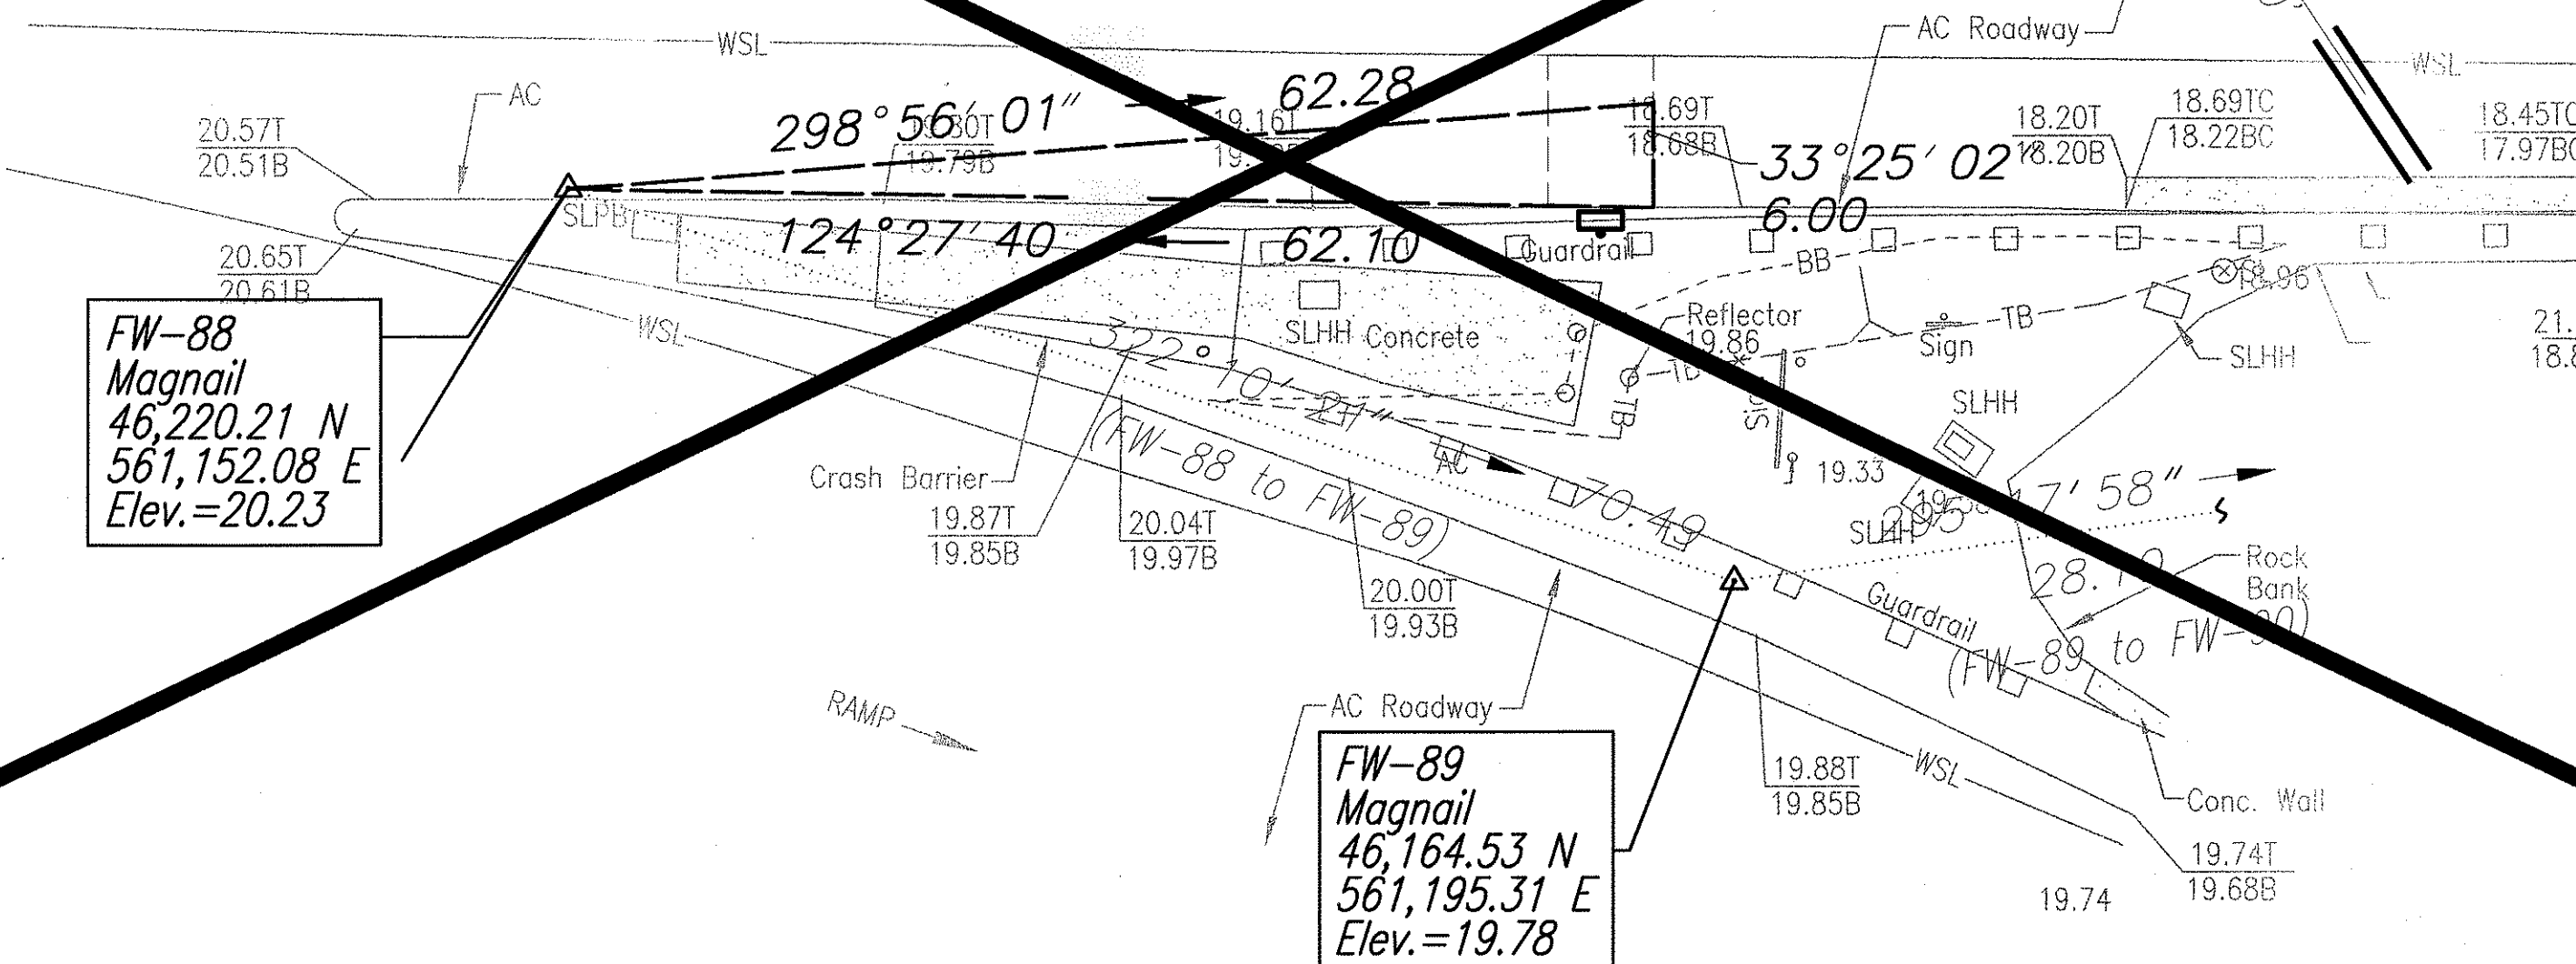


EMERGENCY CALL BOX (EASTBOUND STA. 33+64±)
(M.P.=24.7± - General Plan Sheet 16)
Scale: 1"=10'

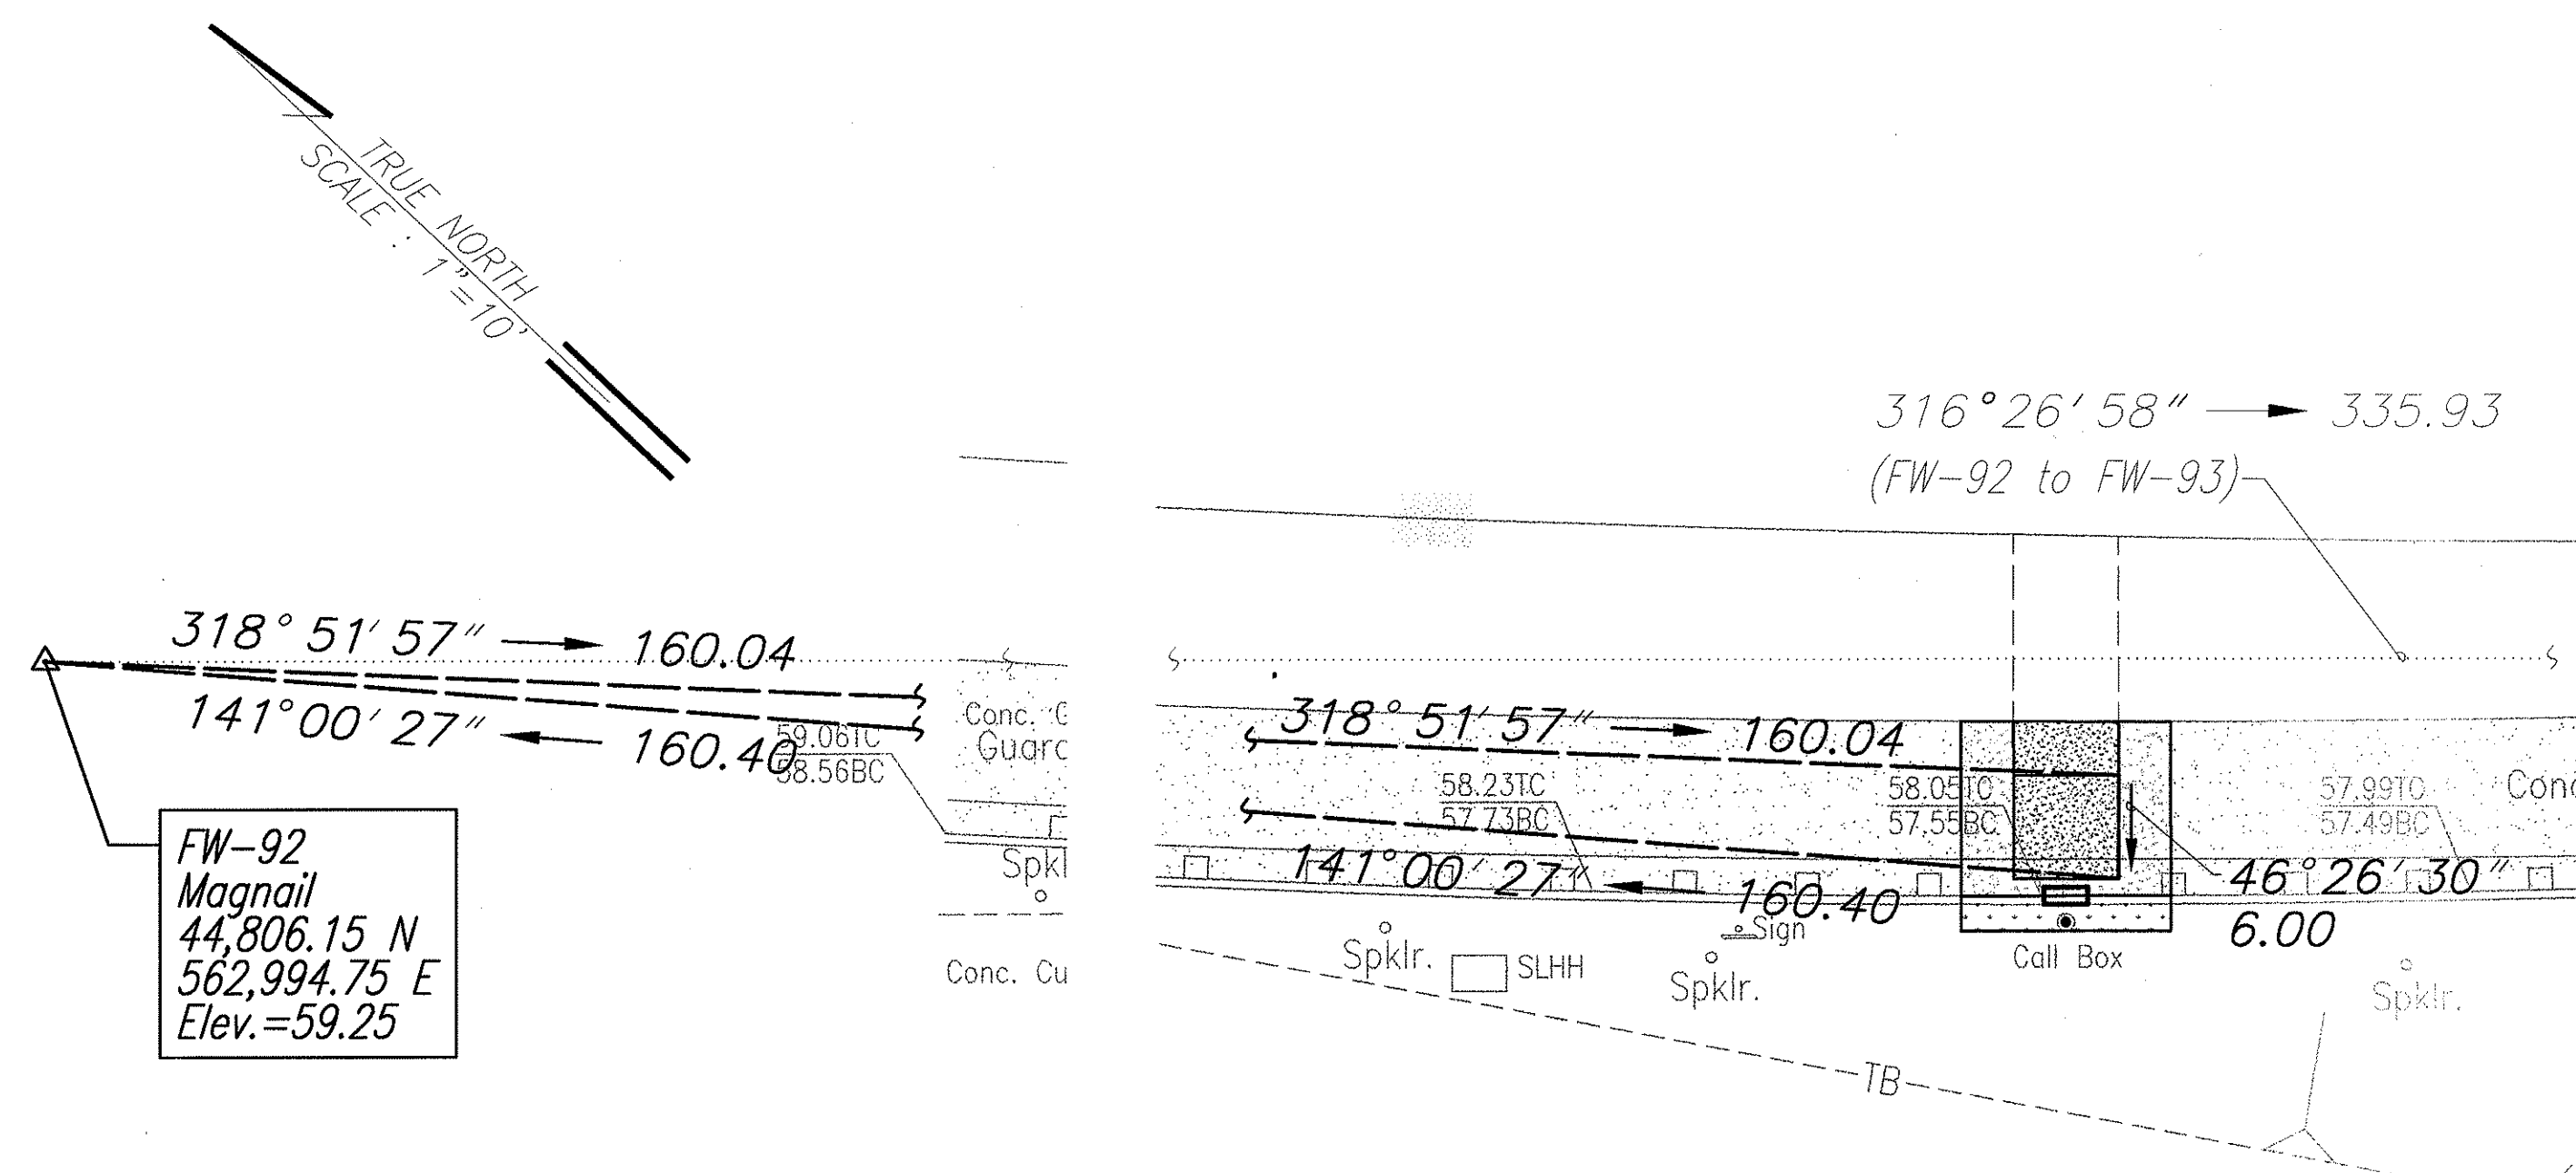


EMERGENCY CALL BOX (EASTBOUND STA. 58+16±)
(M.P.=25.2± - General Plan Sheet 16)
Scale: 1"=10'

N.I.C.

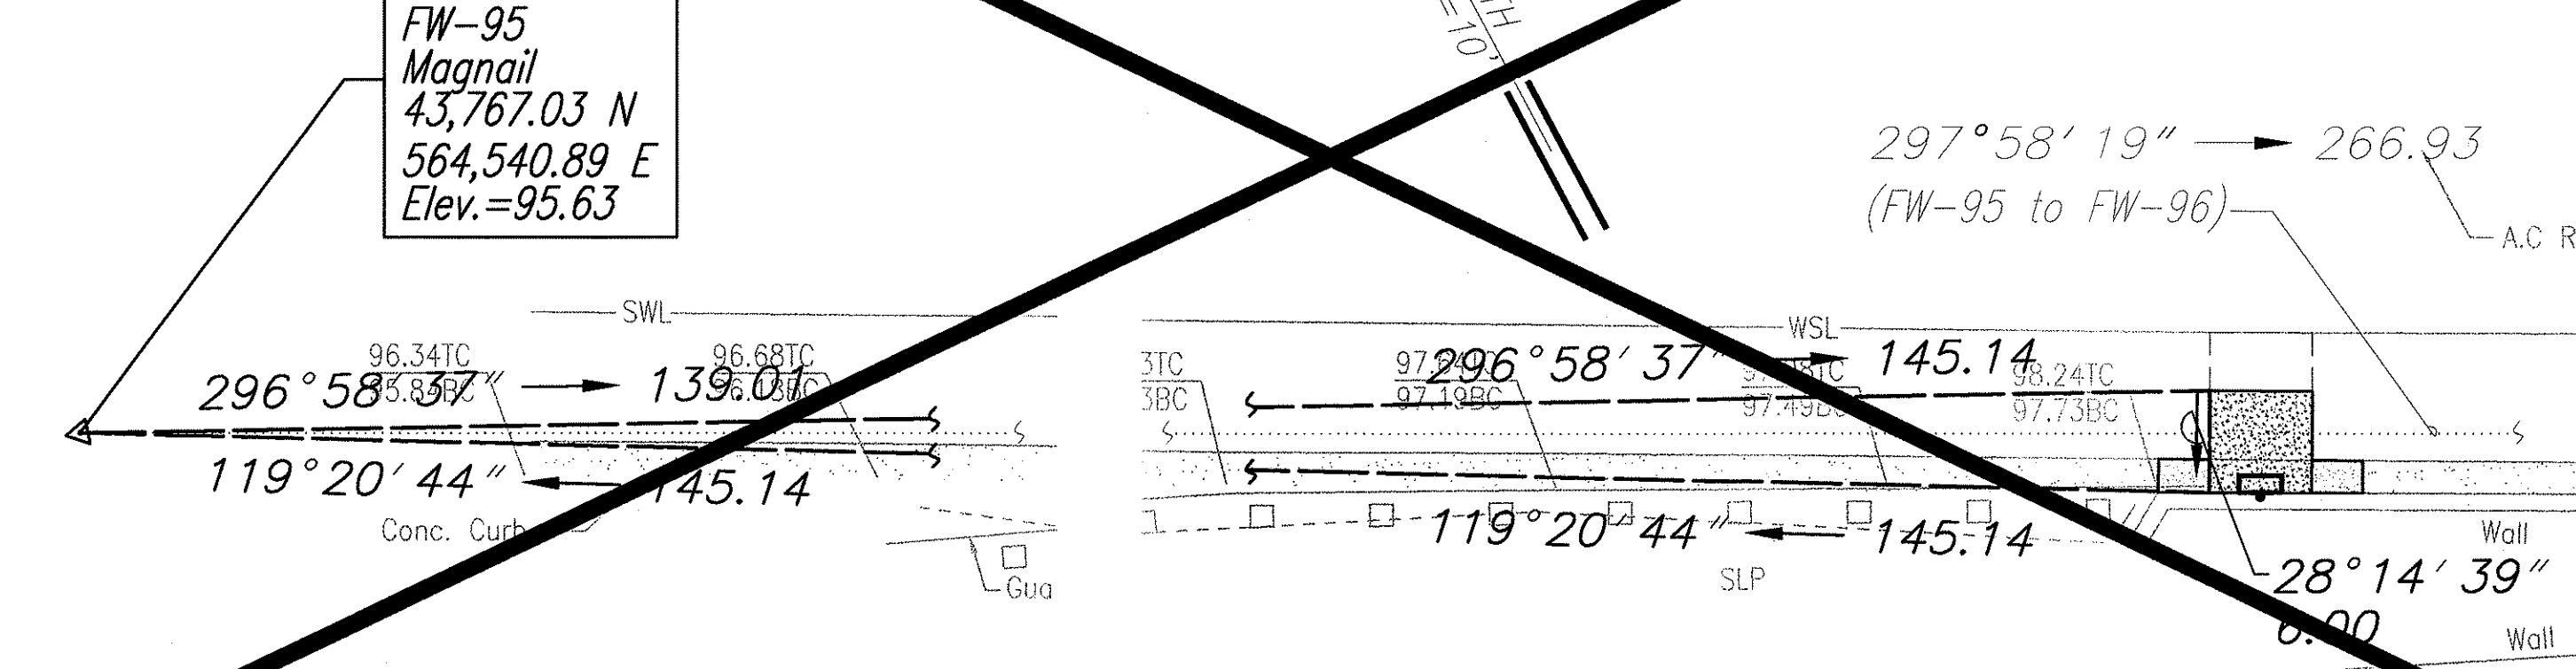


EMERGENCY CALL BOX (EASTBOUND STA. 76+51±)
(M.P.=25.5± - General Plan Sheet 16)
Scale: 1"=10'

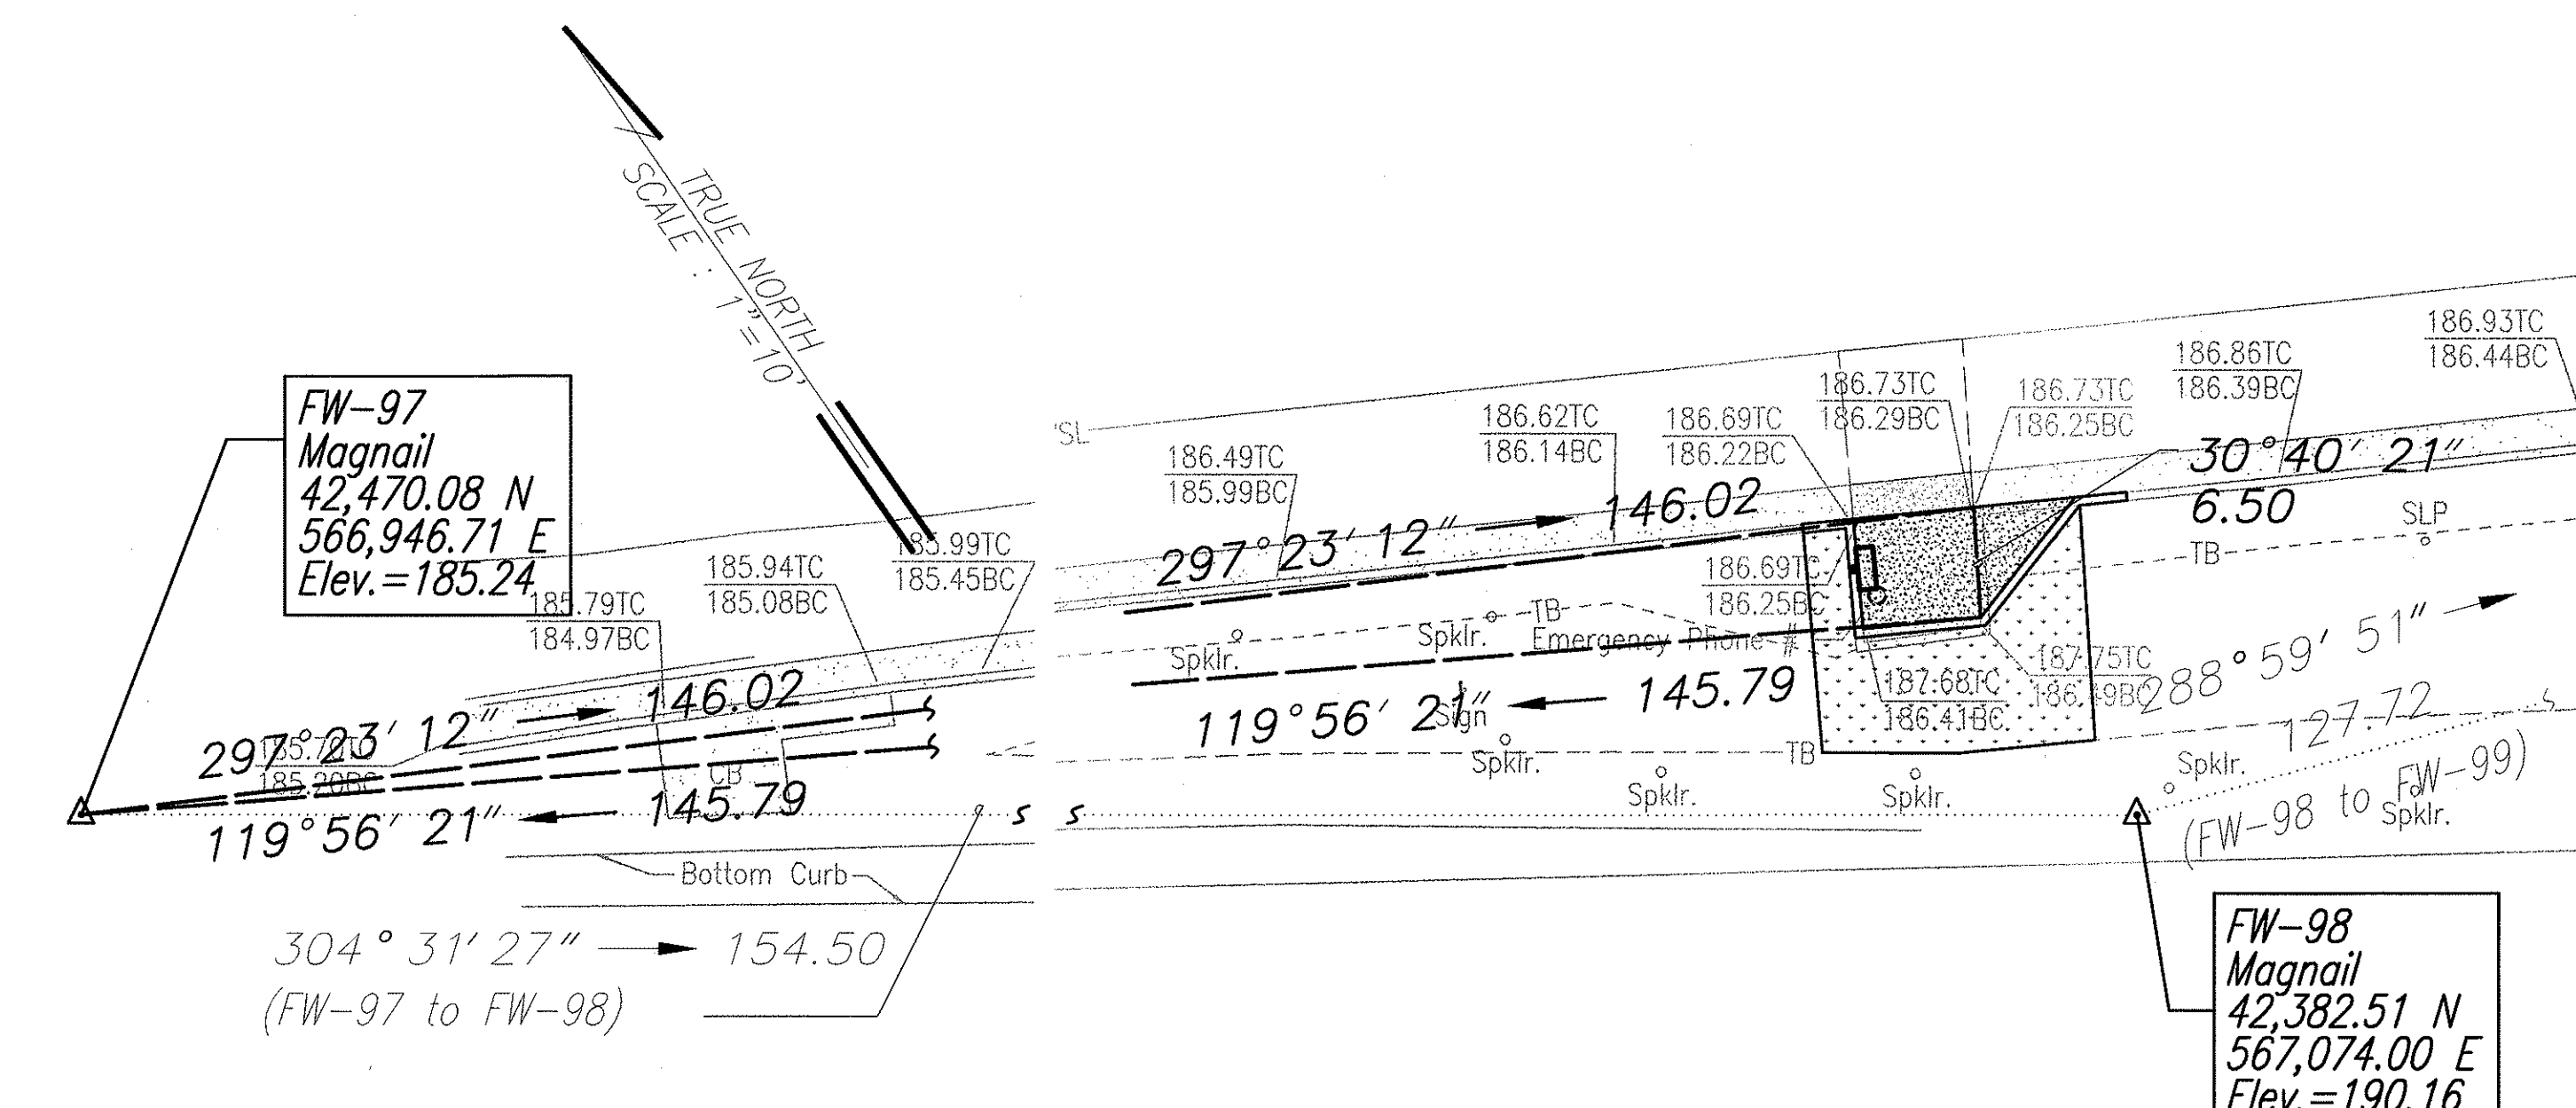

EMERGENCY CALL BOX (EASTBOUND STA. 103+90±)
(M.P.=26.1± - General Plan Sheet 16)
Scale: 1"=10'

Note:
Coordinates and azimuths
referenced to State Plane
Coordinate System Hawaii Zone 3,
Nad 1927.

Graphic Scale:

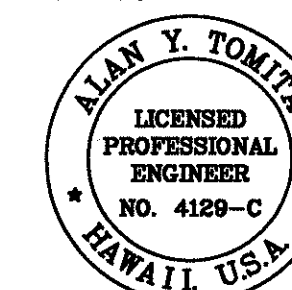

THIS WORK WAS PREPARED BY ME
OR UNDER MY SUPERVISION.

Alan Y. Tomita

STATE OF HAWAII
DEPARTMENT OF TRANSPORTATION
HIGHWAYS DIVISION


**INTERSTATE ROUTE H-1
PAD TIEDOWN-EASTBOUND**

**INTERSTATE ROUTE H-1
EMERGENCY TELEPHONE ACCESSIBLE ROUTES**
F.A. Project No. NH-300(86)R


Scale: As Shown Date: September 2003

SHEET No. 6 OF 7 SHEETS

FED. ROAD DIST. NO.	STATE	FED. AID. PROJ. NO.	FISCAL YEAR	SHEET NO.	TOTAL SHEETS
HAWAII	HAW.	NH-300(86)R	2004	37	45

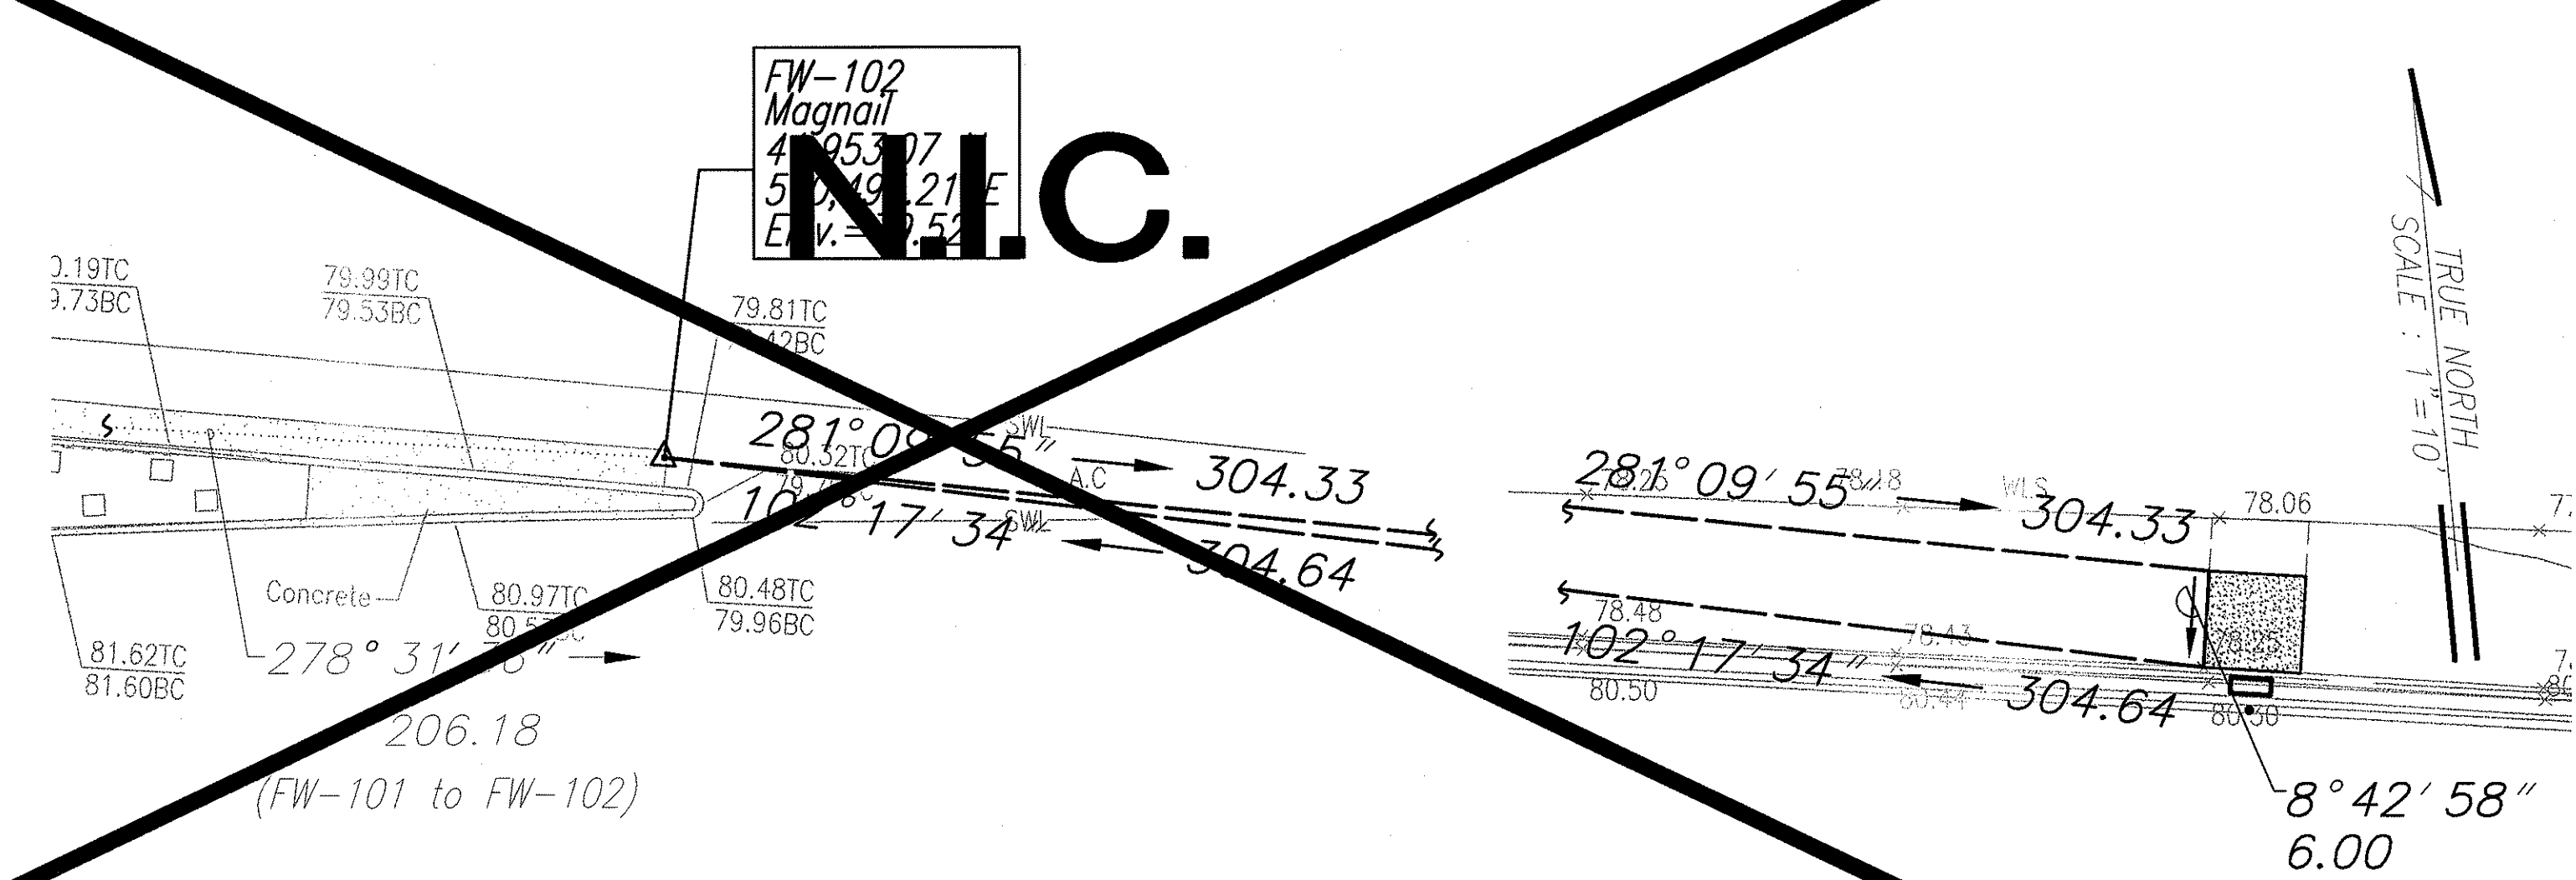

EMERGENCY CALL BOX (EASTBOUND STA. 142+76±)
(M.P.=26.8± - General Plan Sheet 16)
Scale: 1"=10'

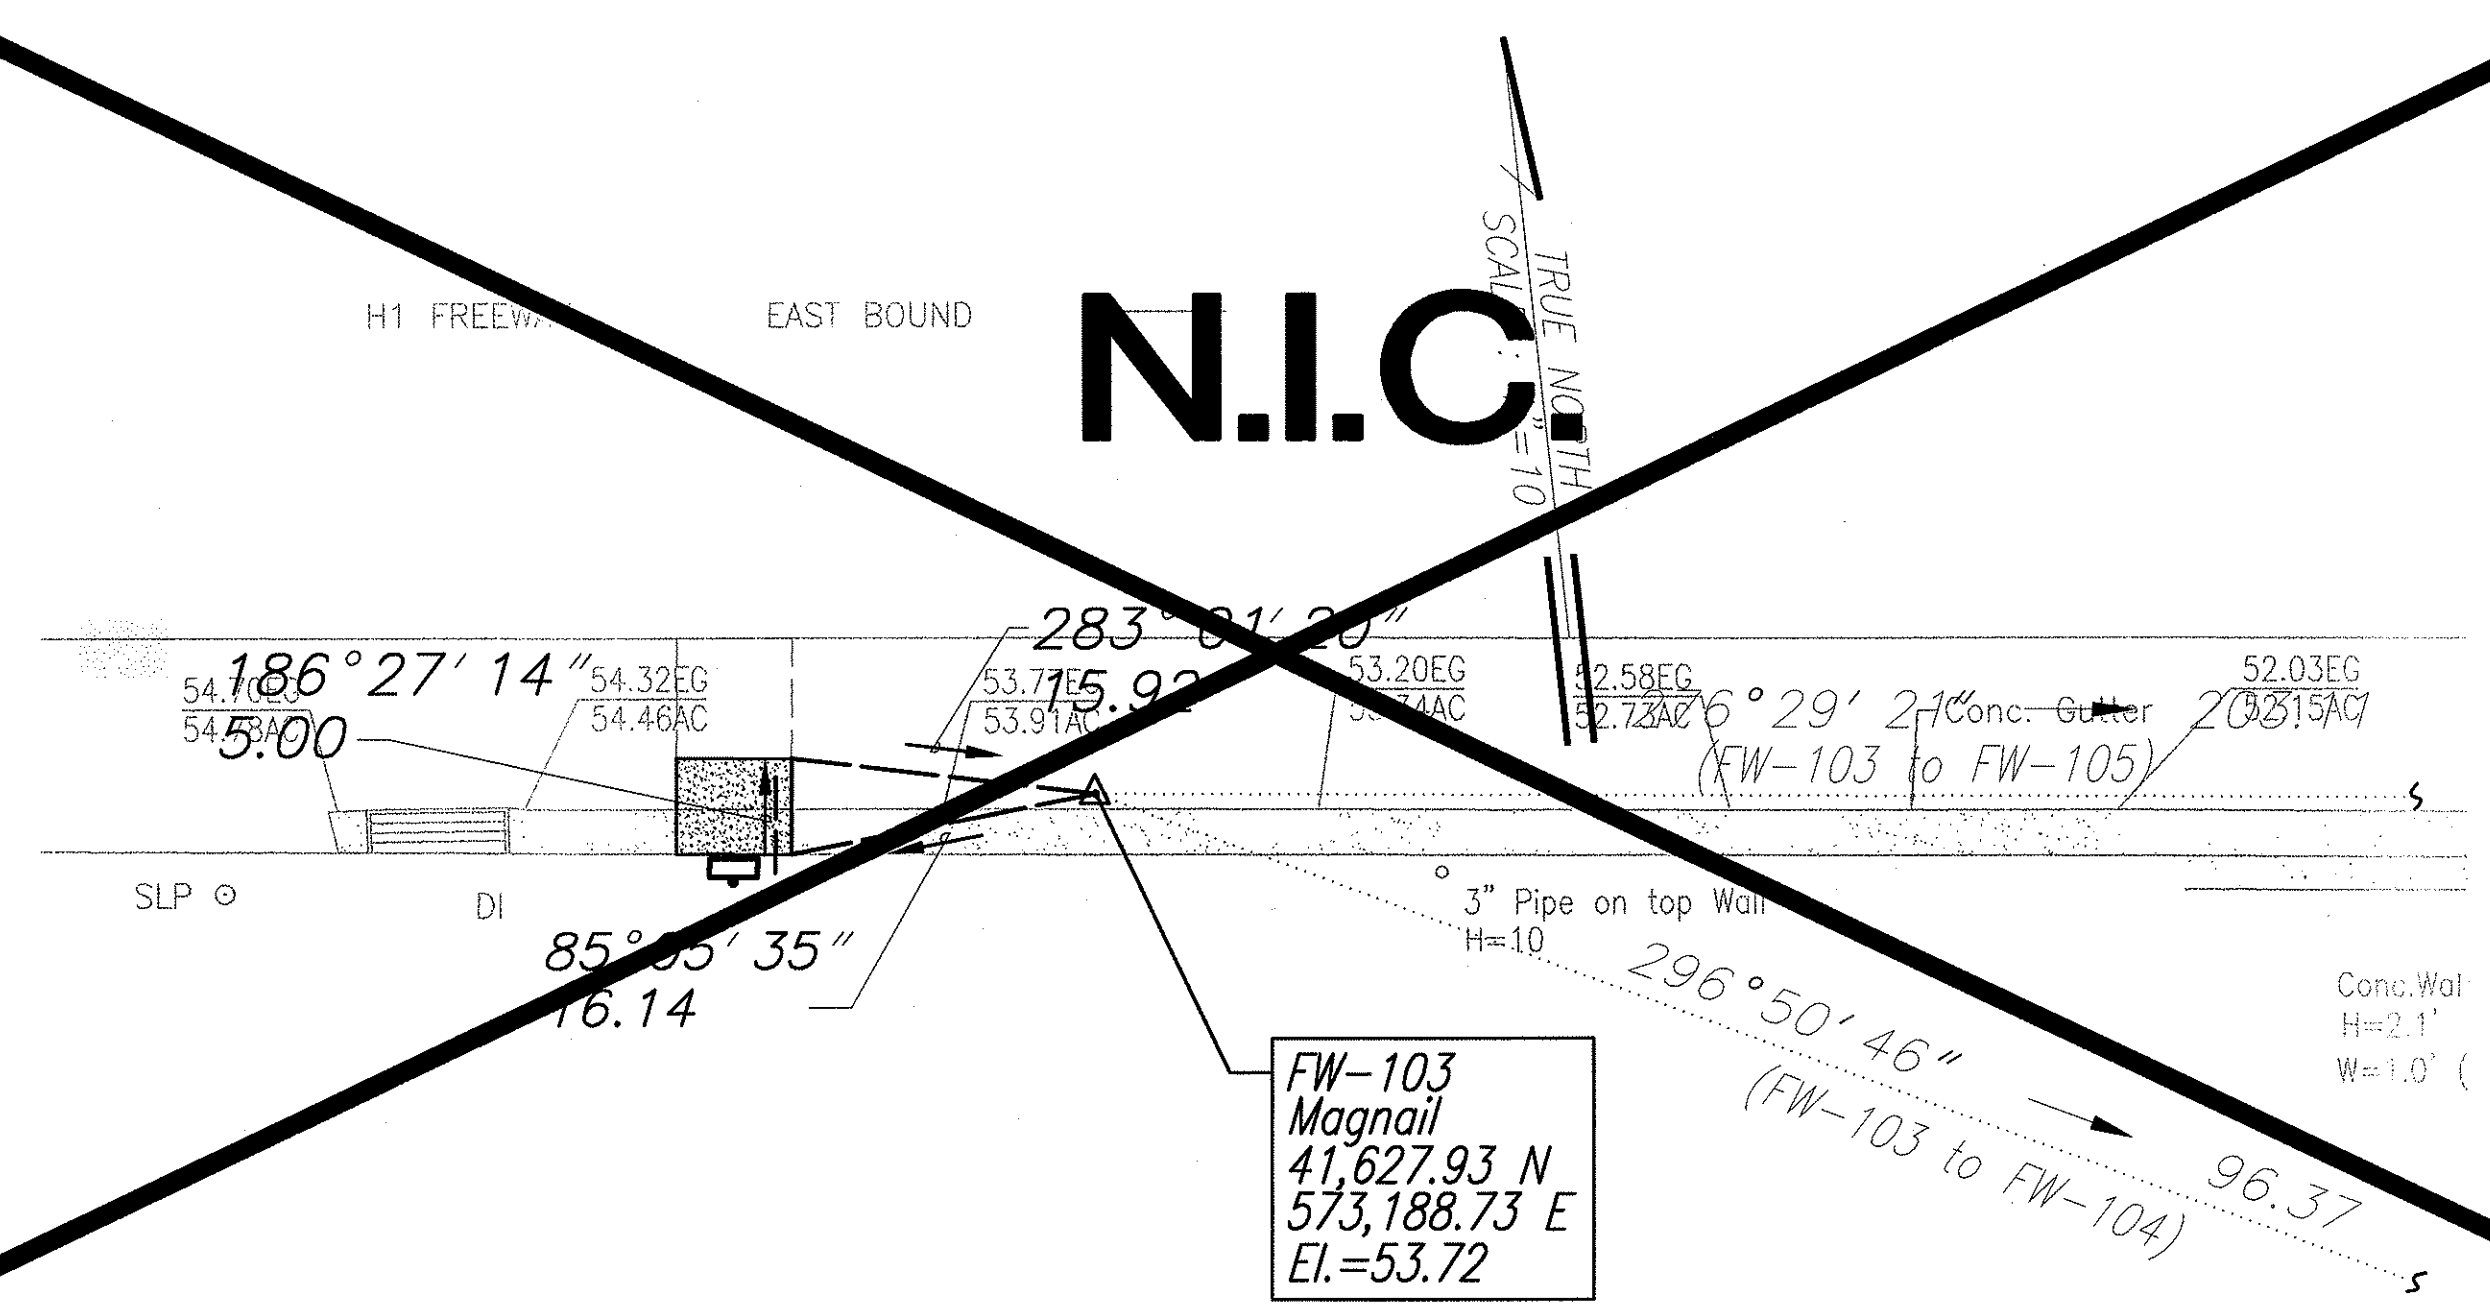

EMERGENCY CALL BOX (EASTBOUND STA. 166+60±)
(M.P.=27.3± - General Plan Sheet 16)
Scale: 1"=10'

Note:
Coordinates and azimuths
referenced to State Plane
Coordinate System Hawaii Zone 3,
Nad 1927.

Graphic Scale:



ALAN Y. TOMITA
LICENSED
PROFESSIONAL
ENGINEER
NO. 4129-C
HAWAII, U.S.A.

THIS WORK WAS PREPARED BY ME
OR UNDER MY SUPERVISION.

Alan Y. Tomita

STATE OF HAWAII
DEPARTMENT OF TRANSPORTATION
HIGHWAYS DIVISION

**INTERSTATE ROUTE H-1
PAD TIEDOWN-EASTBOUND**

**INTERSTATE ROUTE H-1
EMERGENCY TELEPHONE ACCESSIBLE ROUTES**
F.A. Project No. NH-300(86)R

Scale: As Shown Date: September 2003

SHEET No. 7 OF 7 SHEETS

SURVEY PLOTTED BY	DATE
DRAWN BY	
DESIGNED BY	
QUANTITIES BY	
CHECKED BY	
ORIGINAL PLAN	
NOTE BOOK	
No.	

P:\Projects\Dot-Hwy\Emergency Call Box Drawings\RE-DESIGN H-1\ESB-H-TIES.dwg September 11, 2003 11:40AM RlsanrCJ